



- GENERAL NOTES - FENCING
1. ALL EXISTING POSTS, FABRIC, AND GATES IN GOOD CONDITION SHALL BE USED FOR THE TEMPORARY FENCE, OR ALL EXCESS MATERIALS SHALL BE SALVAGED TO A LOCATION ON THE AIRPORT, AS DIRECTED BY THE ENGINEER.
 2. CONTRACTOR SHALL USE REASONABLE CAUTION WHEN REMOVING POSTS SO AS TO PREVENT UNNECESSARY DAMAGE. ALL CONCRETE SHALL BE REMOVED FROM POSTS BEFORE REUSING OR SALVAGING. DAMAGED POSTS, AS APPROVED BY THE ENGINEER, SHALL BE DISPOSED OF BY THE CONTRACTOR.
 3. ALL HOLES CREATED BY REMOVING POSTS SHALL BE FILLED AND COMPACTED WITH APPROVED MATERIAL.
 4. THE CONCRETE FOOTING SHALL BE CONSIDERED INCIDENTAL TO THE UNIT COST BID FOR "INSTALL FENCE".
 5. CONTRACTOR SHALL REMOVE AND REINSTALL "KEEP OUT" SIGNS AS DIRECTED BY THE ENGINEER. (INCIDENTAL)

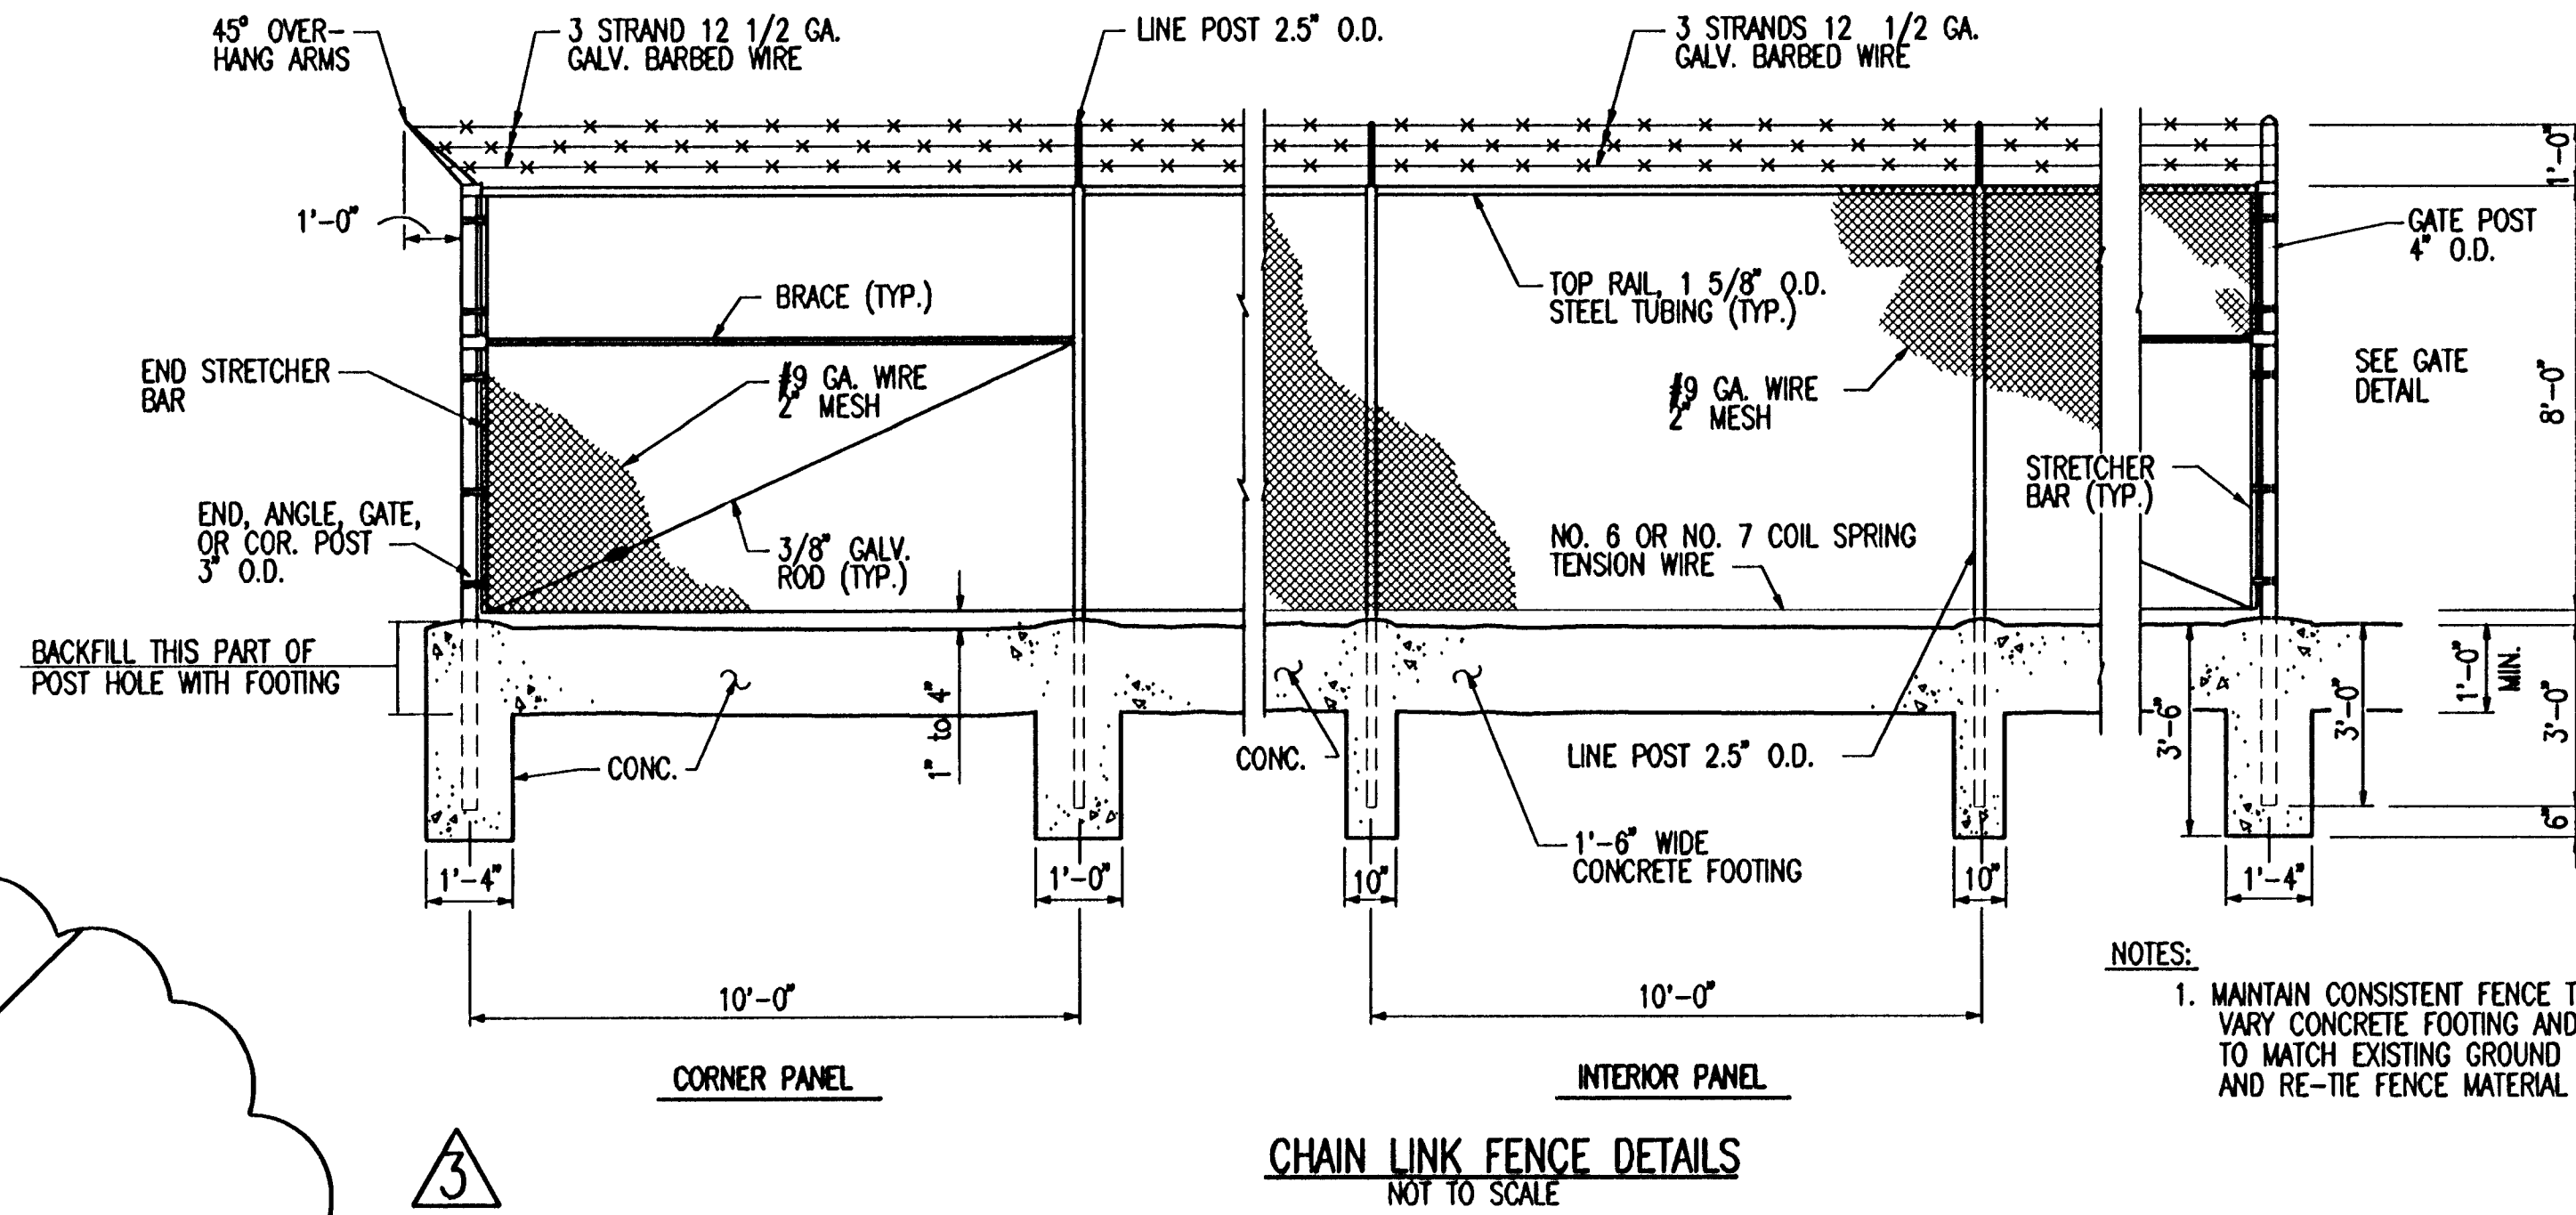


- NOTES:
1. MAINTAIN CONSISTENT FENCE TOP PROFILE. VARY CONCRETE FOOTING AND FENCE BOTTOM TO MATCH EXISTING GROUND PROFILE. CUT AND RE-TIE FENCE MATERIAL AS REQUIRED.

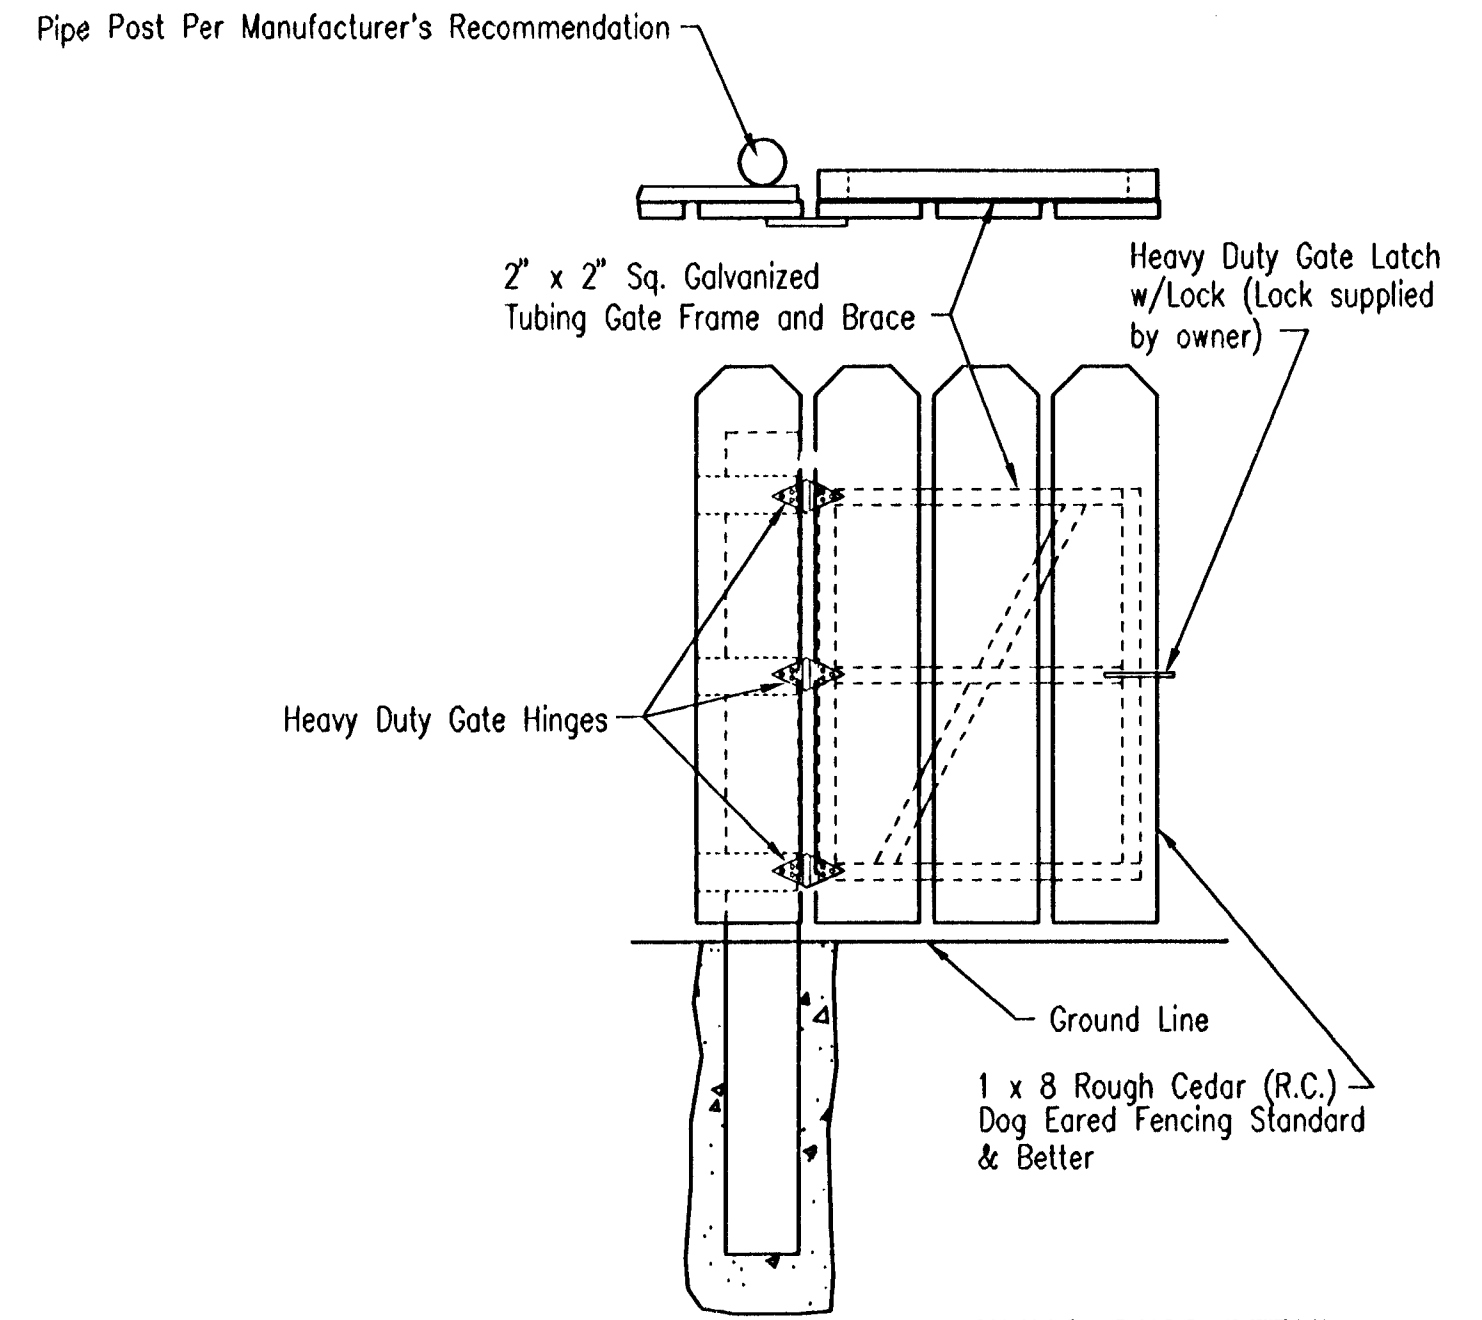

SWING GATE DETAIL
NO SCALE



- NOTES:
- PROVIDE PEDESTAL SUPPORT ON LATCHED ENDS OF GATE. ALL GATES SHALL BE PROVIDED WITH A HOLD OPEN DEVICE.
- TERMINAL AND LINE POSTS SHALL BE 2.875\"/>

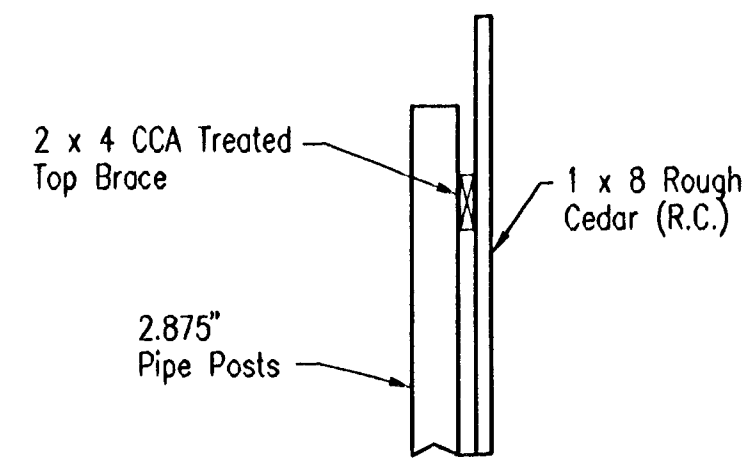

GATE CROSS SECTION

ADD. #3
ITEM NO. 6 SHEET CF1.1 - FENCE DETAILS

- A. DELETE CONCRETE MOW STRIP DETAIL. CONCRETE MOW STRIP WILL NOT BE REQUIRED ON TEMPORARY FENCE. SEE CHAIN LINK FENCE DETAIL FOR CONCRETE FOOTING ON PERMANENT FENCE.
- B. CHAIN LINK FENCE DETAILS, ADD THE FOLLOWING NOTE:
"TWO (2) NO 5 BARS SHALL BE INSTALLED IN THE CONCRETE FOOTING. THE REBAR SHALL BE SPACED 1'-0\"/>

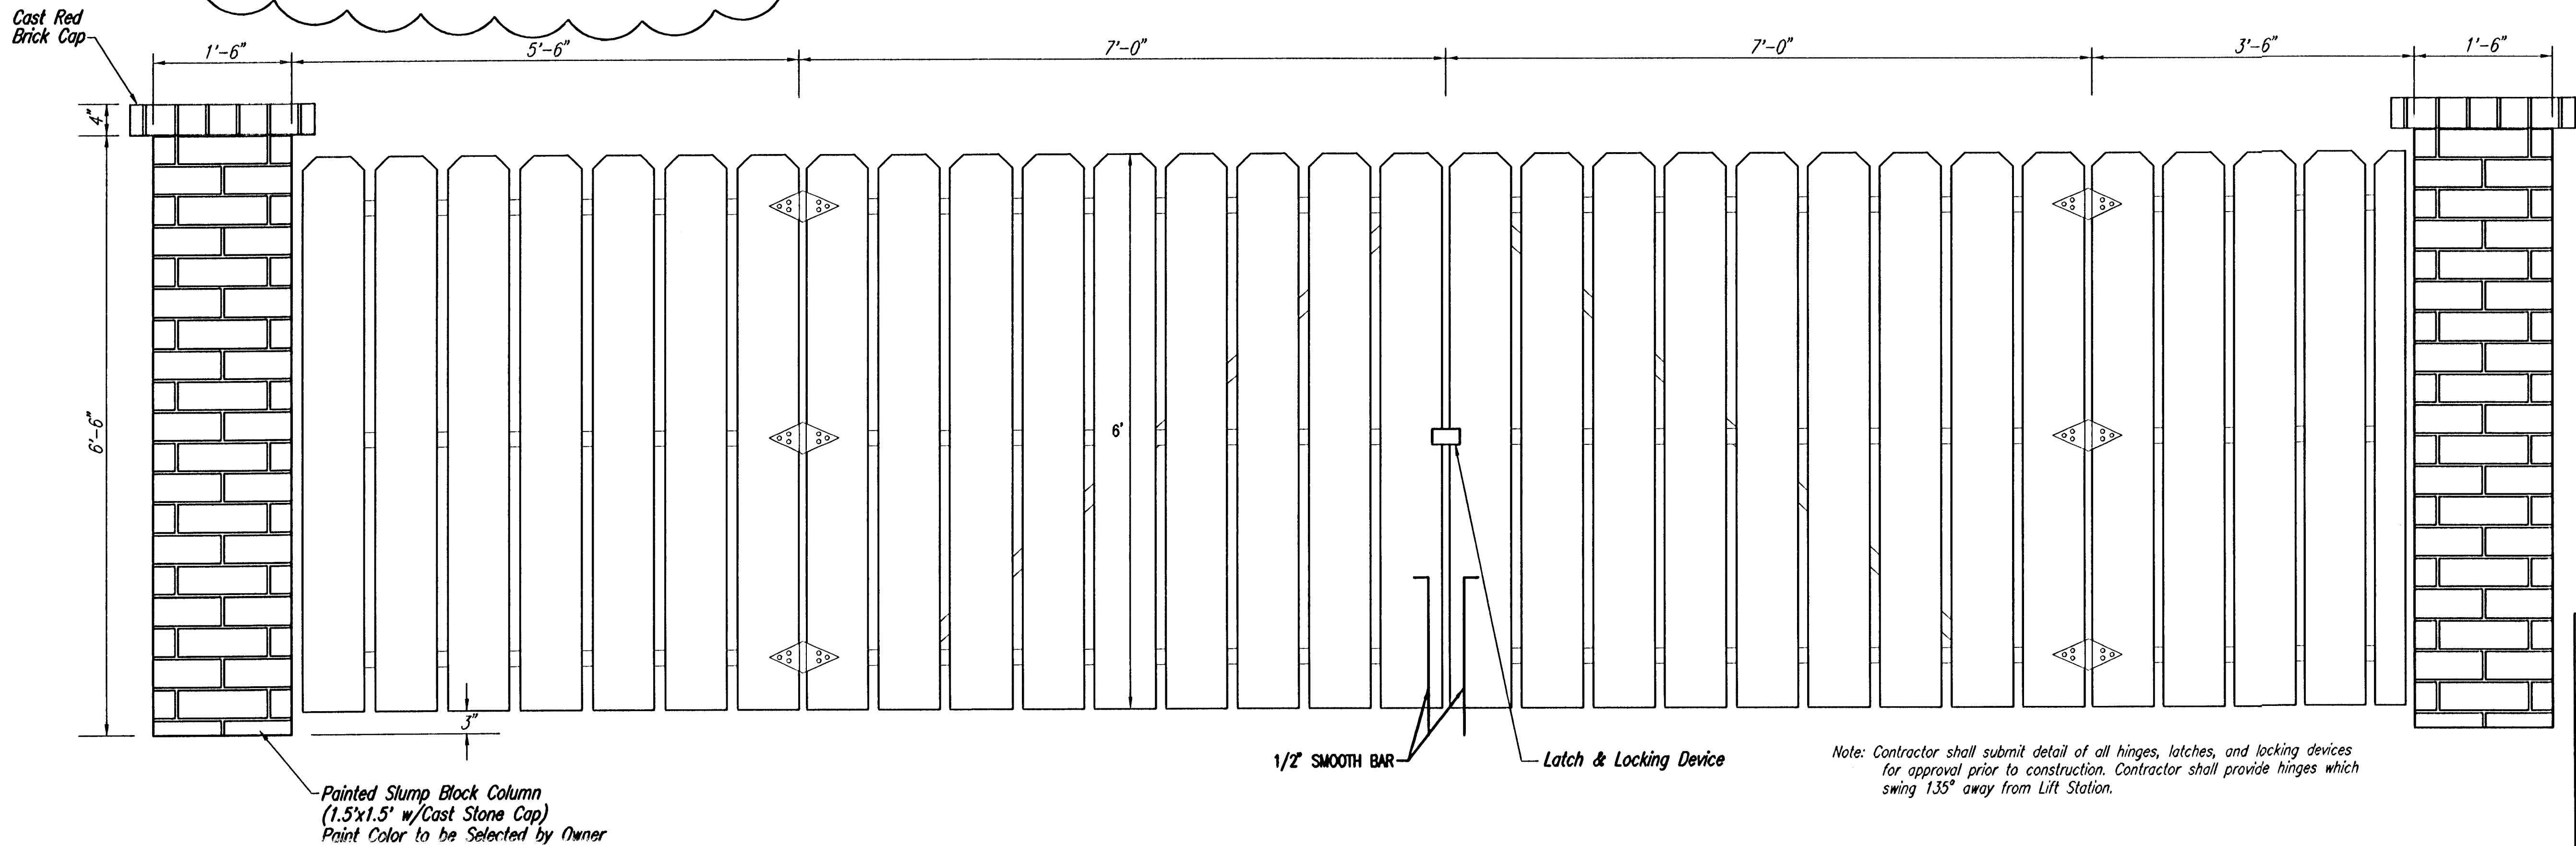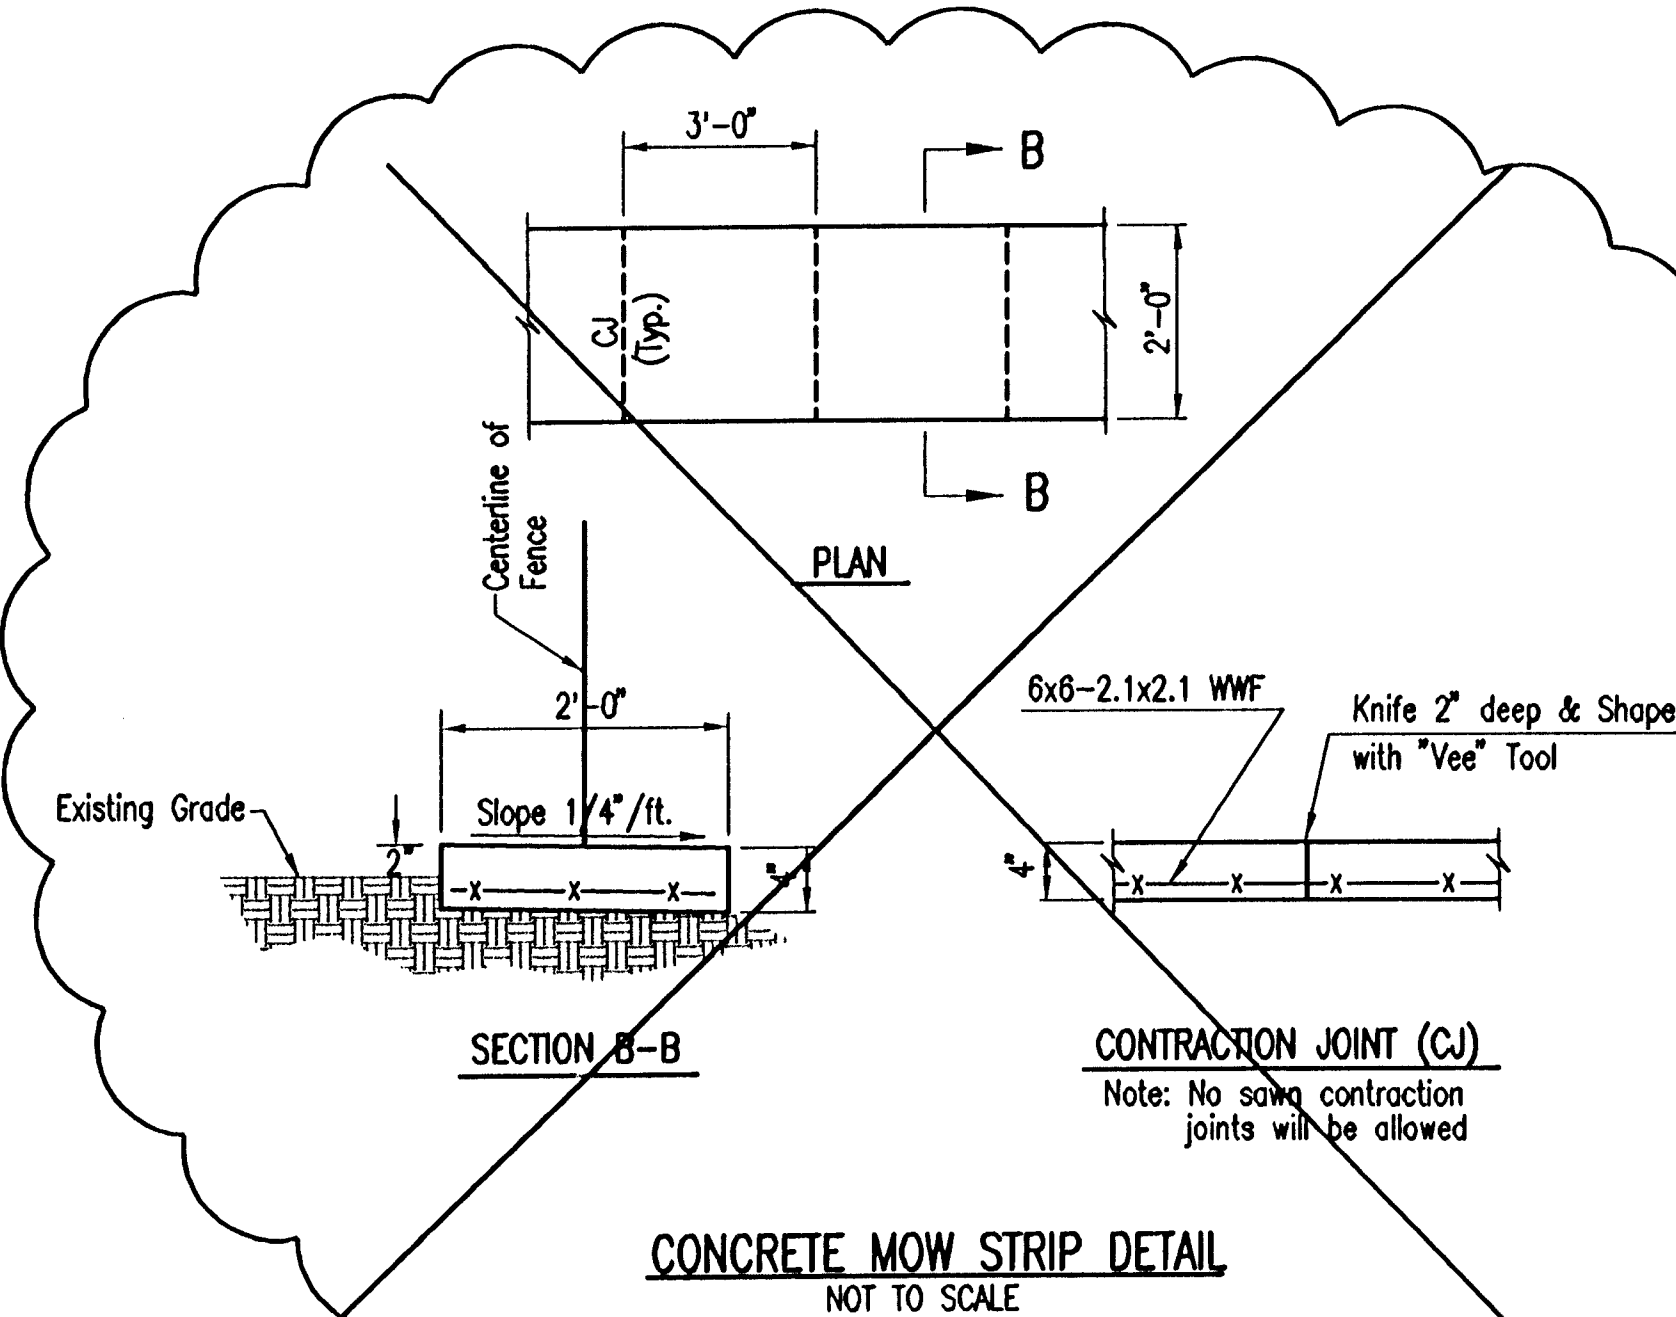

Note: Contractor shall submit detail of all hinges, latches, and locking devices for approval prior to construction. Contractor shall provide hinges which swing 135° away from Lift Station.

RECORD DRAWING

ADDENDUM #3

THE WICHITA AIRPORT AUTHORITY
COLONEL JAMES JABARA AIRPORT

FENCE DETAILS

SANITARY SEWER AND WATER DISTRIBUTION SYSTEM
SOUTHWEST AREA SITE DEVELOPMENT IMPROVEMENTS

Professional Engineering Consultants, P.A.
303 S. TOPEKA • WICHITA, KANSAS 67202
316-262-2691 • FAX 316-262-3003

Date SEPTEMBER 2005 Job No. 05471-019