

# SANITARY SEWER EXTENSION SERVING

Lots 11 & 12, Block 2, SOUTHWEST INDUSTRIAL ADDITION

PRIVATE PROJECT NUMBER  
468-76-245-80001-000-000-064

APRIL 1986


INDEX OF SHEETS

SHEET NO.	DESCRIPTION
1	TITLE SHEET
2	PLAN & PROFILE
3-6	STANDARDS

NOTIFY THE FOLLOWING COMPANIES PRIOR TO ANY TRENCHING.

ARKA GAS CO.	942-8350
BELL TELEPHONE	268-3087
CABLEVISION	266-6817
KPL GAS SERVICE	263-7511
KANSAS GAS & ELEC.	261-6248
KANSAS ONE-CALL	1-800-DIG-SAFE
CALL BEFORE YOU DIG	1-800-571-2115

THE CONTRACTOR SHALL BE RESPONSIBLE FOR PRESERVING PROPERTY IRONS. THE CONTRACTOR SHALL BE REQUIRED TO RE-ESTABLISH ANY PROPERTY IRONS WHICH ARE DAMAGED OR DESTROYED BY HIS CONSTRUCTION OPERATIONS. SUCH IRONS SHALL BE RE-ESTABLISHED BY A LICENSED LAND SURVEYOR OR A LICENSED PROFESSIONAL ENGINEER IN ACCORDANCE WITH STATE LAWS.

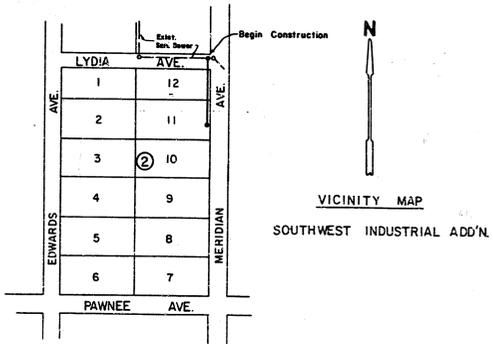



APPROVED AS NOTED  
By CITY ENGINEER OF WICHITA  
Sanitary Sewers EDB #16100  
Storm Sewers \_\_\_\_\_  
Driveway Approaches \_\_\_\_\_  
Water Mains \_\_\_\_\_  
Paving \_\_\_\_\_

NOTE TO CONTRACTOR

This project will be constructed under the supervision of the CITY ENGINEER and conforming to the SPECIFICATIONS of the CITY OF WICHITA. The CONTRACTOR will pay the City of Wichita for all costs of plan review, inspection and booking per contract.


MOEHRING & ASSOCIATES  
CONSULTING ENGINEERS  
WICHITA



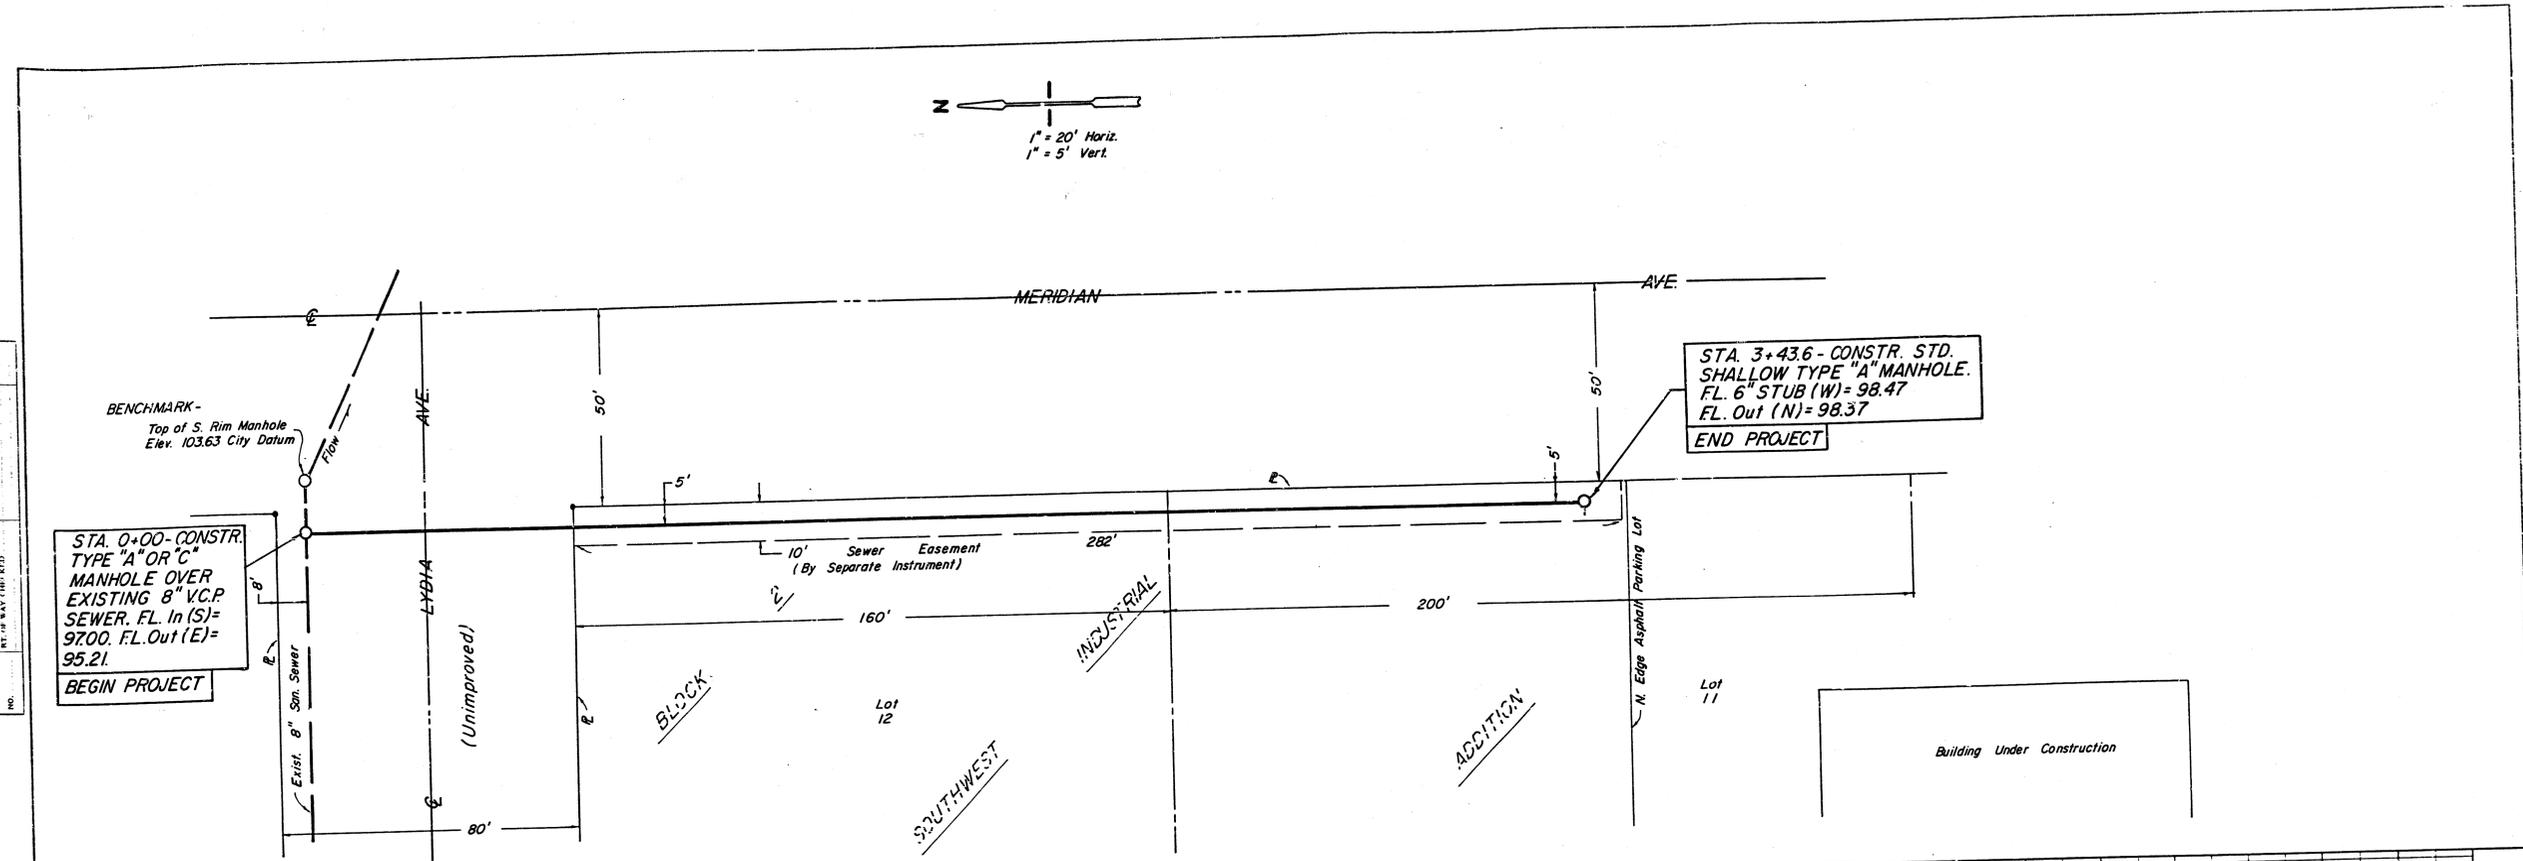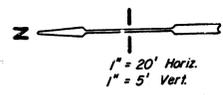

STA. 0+00- CONSTR. TYPE "A" OR "C" MANHOLE OVER EXISTING 8" V.C.P. SEWER. FL. In (S) = 97.00. FL. Out (E) = 95.21.  
**BEGIN PROJECT**

STA. 3+43.6- CONSTR. STD. SHALLOW TYPE "A" MANHOLE. FL. 6" STUB (W) = 98.47. FL. Out (N) = 98.37.  
**END PROJECT**

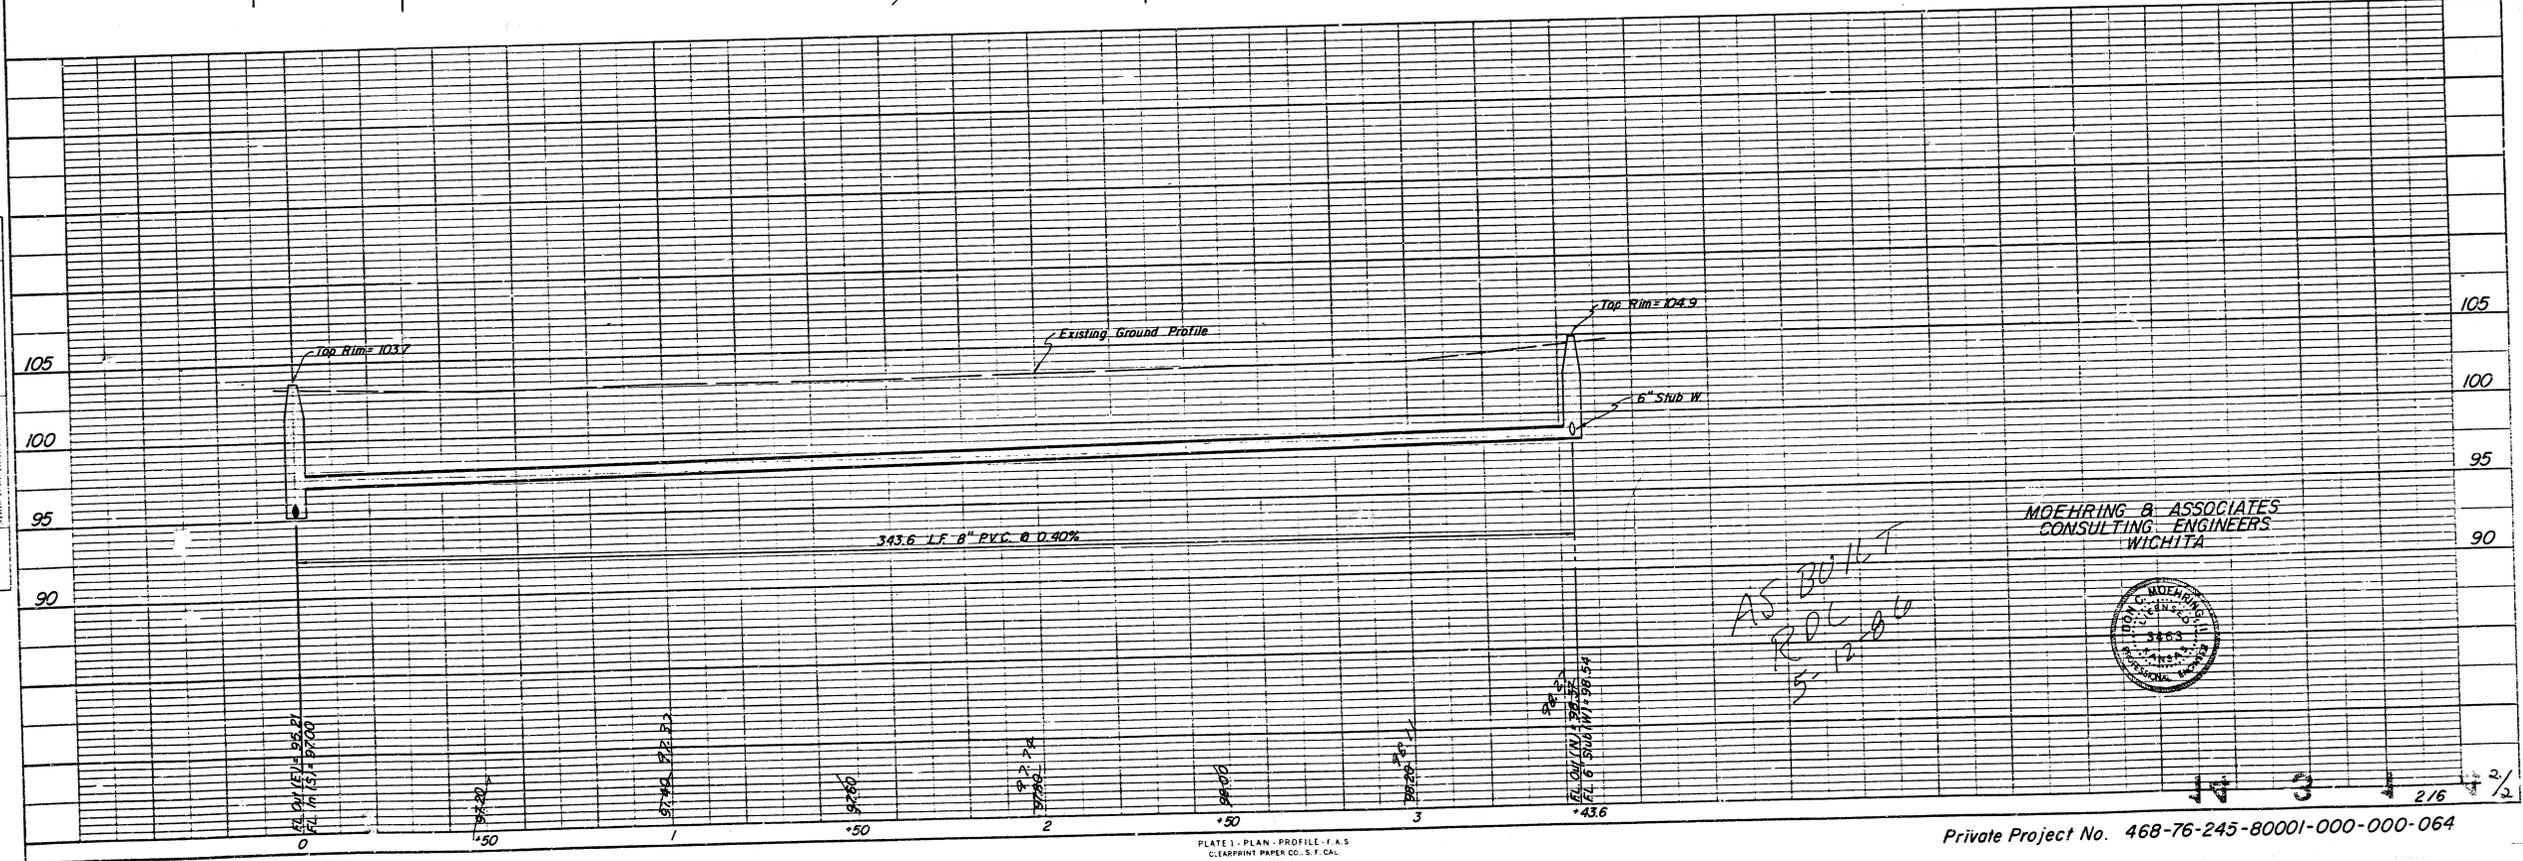

AS BUILT  
 RDC  
 5-12-06

MOEHRING & ASSOCIATES  
 CONSULTING ENGINEERS  
 WICHITA



PLAN

DATE	
BY	
REVISIONS	
NO.	
DESCRIPTION	

PROFILE

DATE	
BY	
REVISIONS	
NO.	
DESCRIPTION	