




LAT. 31, MAIN 5-A, WAR INDUSTRIES SEWER
 CITY OF WICHITA, KANSAS
 R. W. LINN - CITY ENGINEER
 SEPT. 1973, PROJECT NO. DBKL 573046

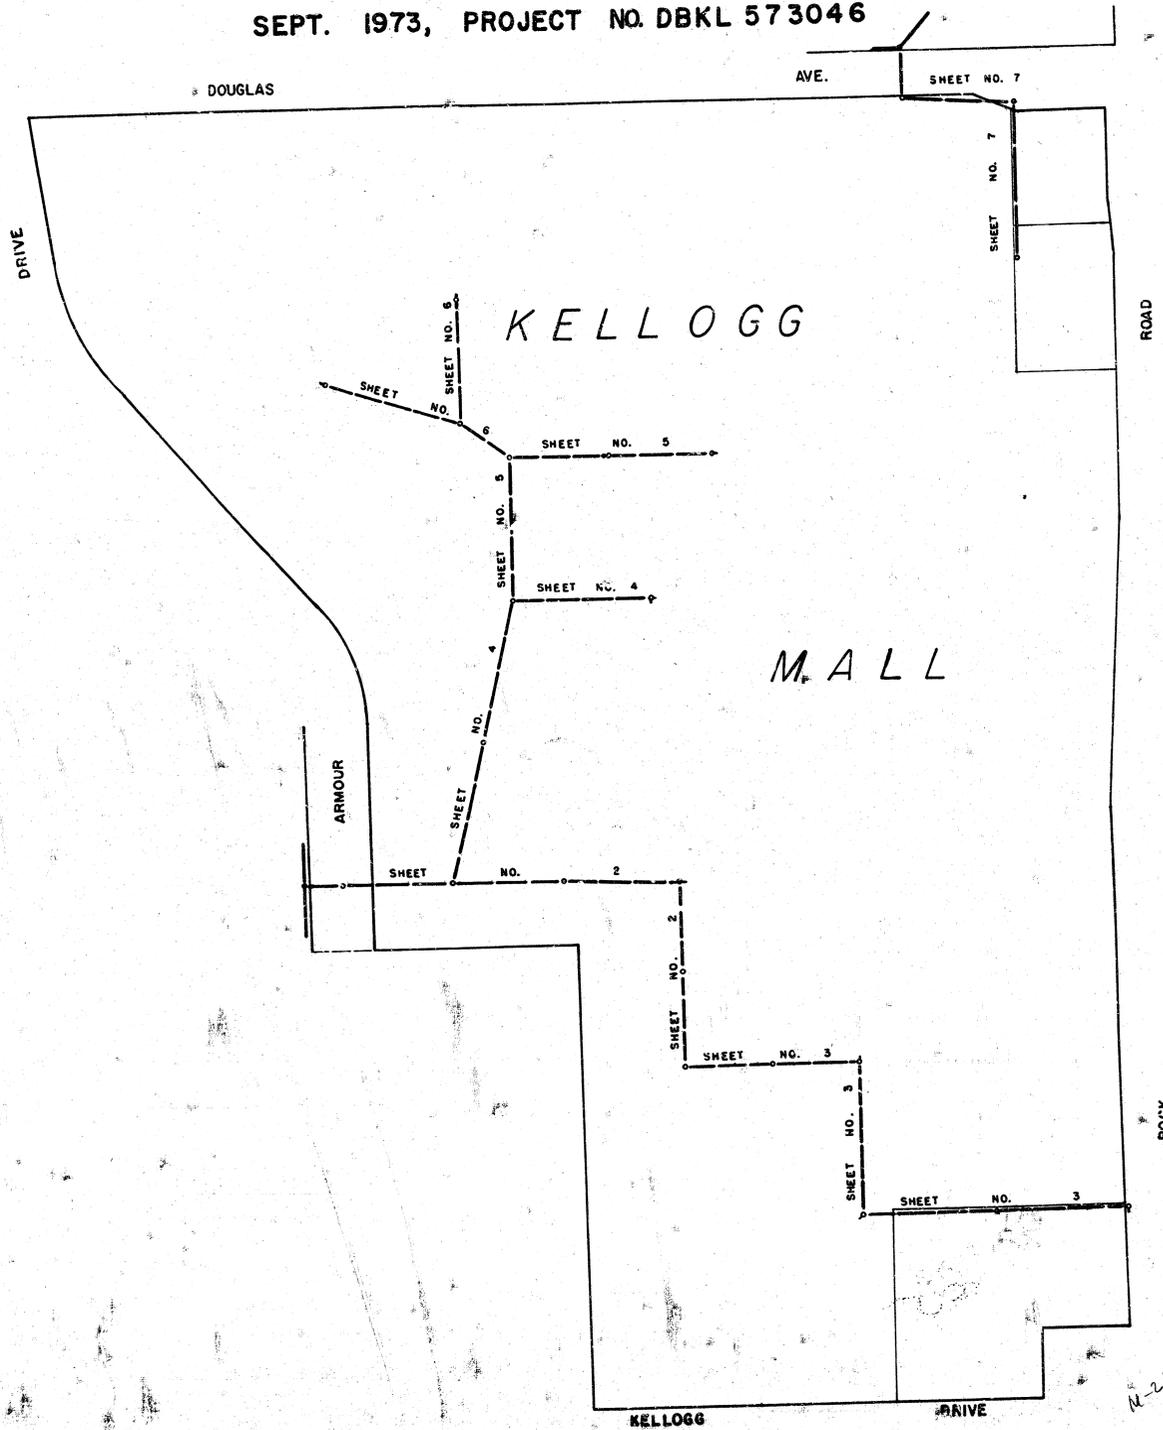


As Built Per Plan
 I-4-83

Sheet No. 6 Revised 9-11-73
 Sheet No. 7 Revised 10-4-73
LAT. 31, MAIN 5-A, W. I. S.
PROJECT NO. DBKL 57 3046

N-210

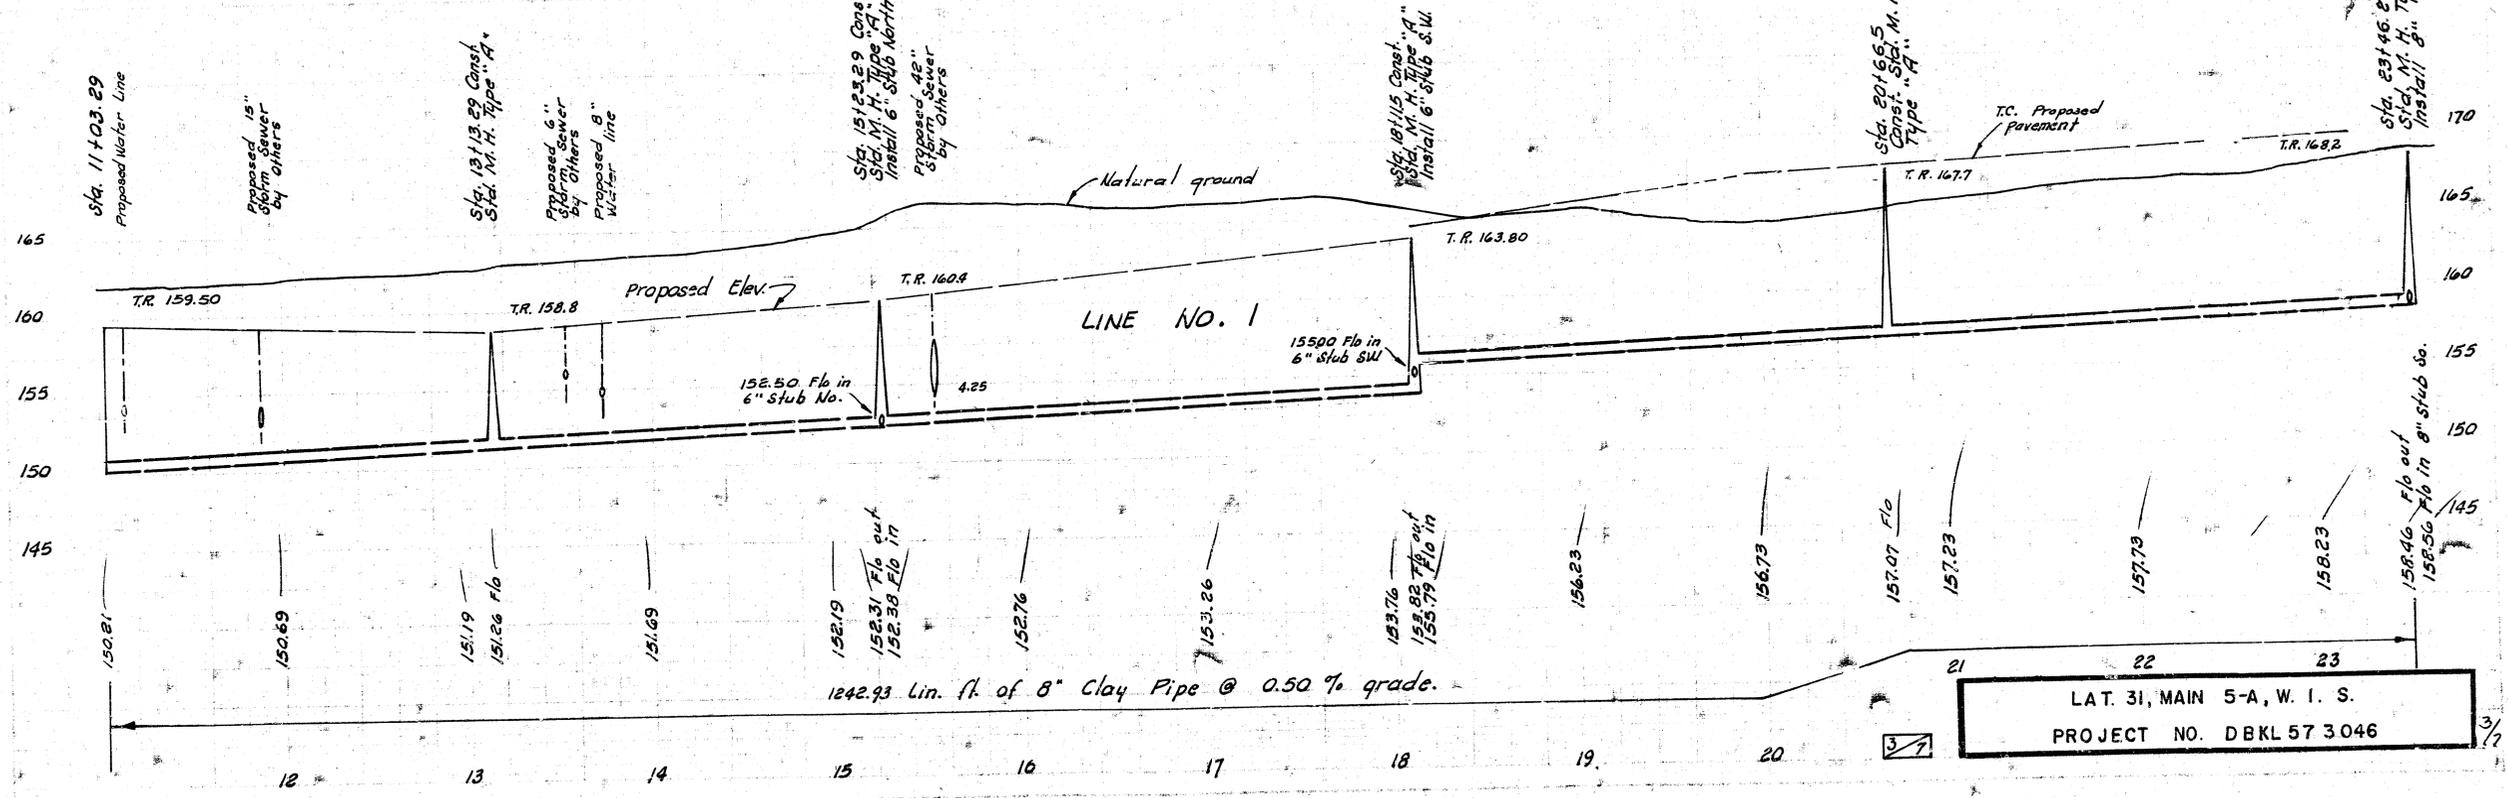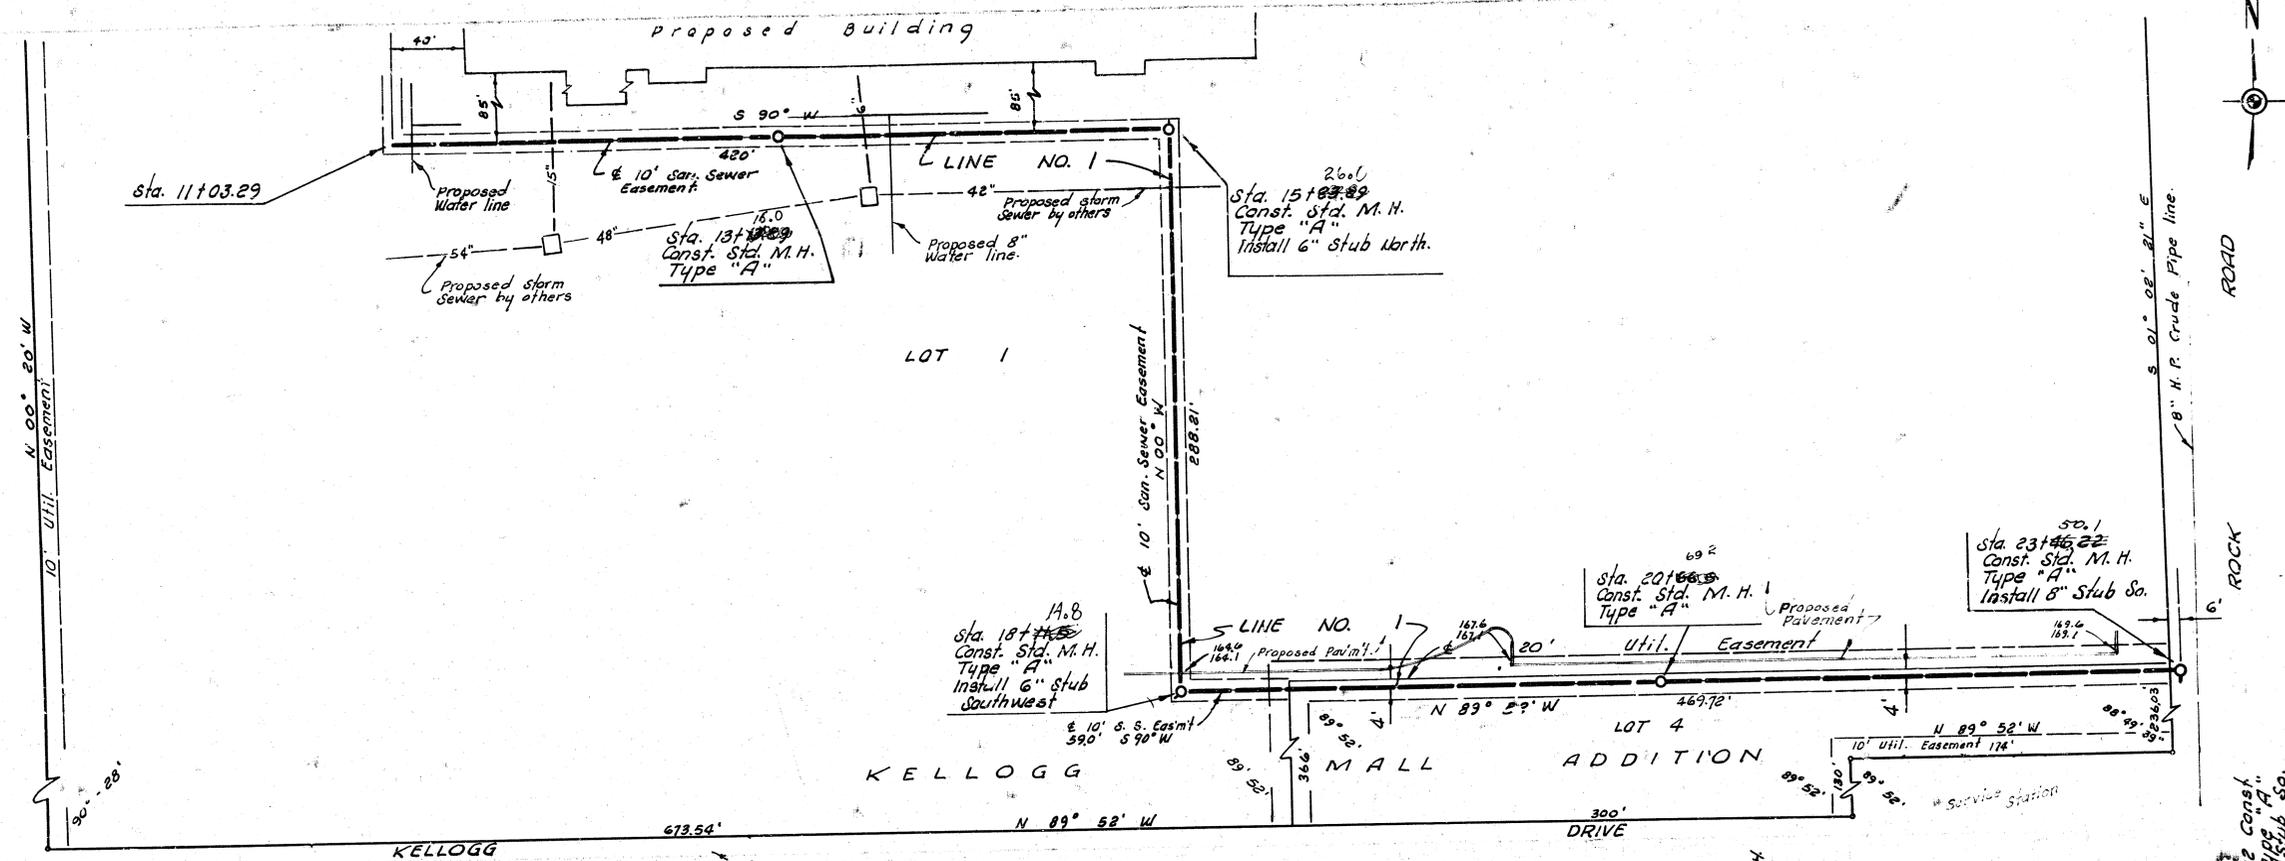

LAT. 31, MAIN 5-A, W. I. S.
PROJECT NO. DBKL 57 3046

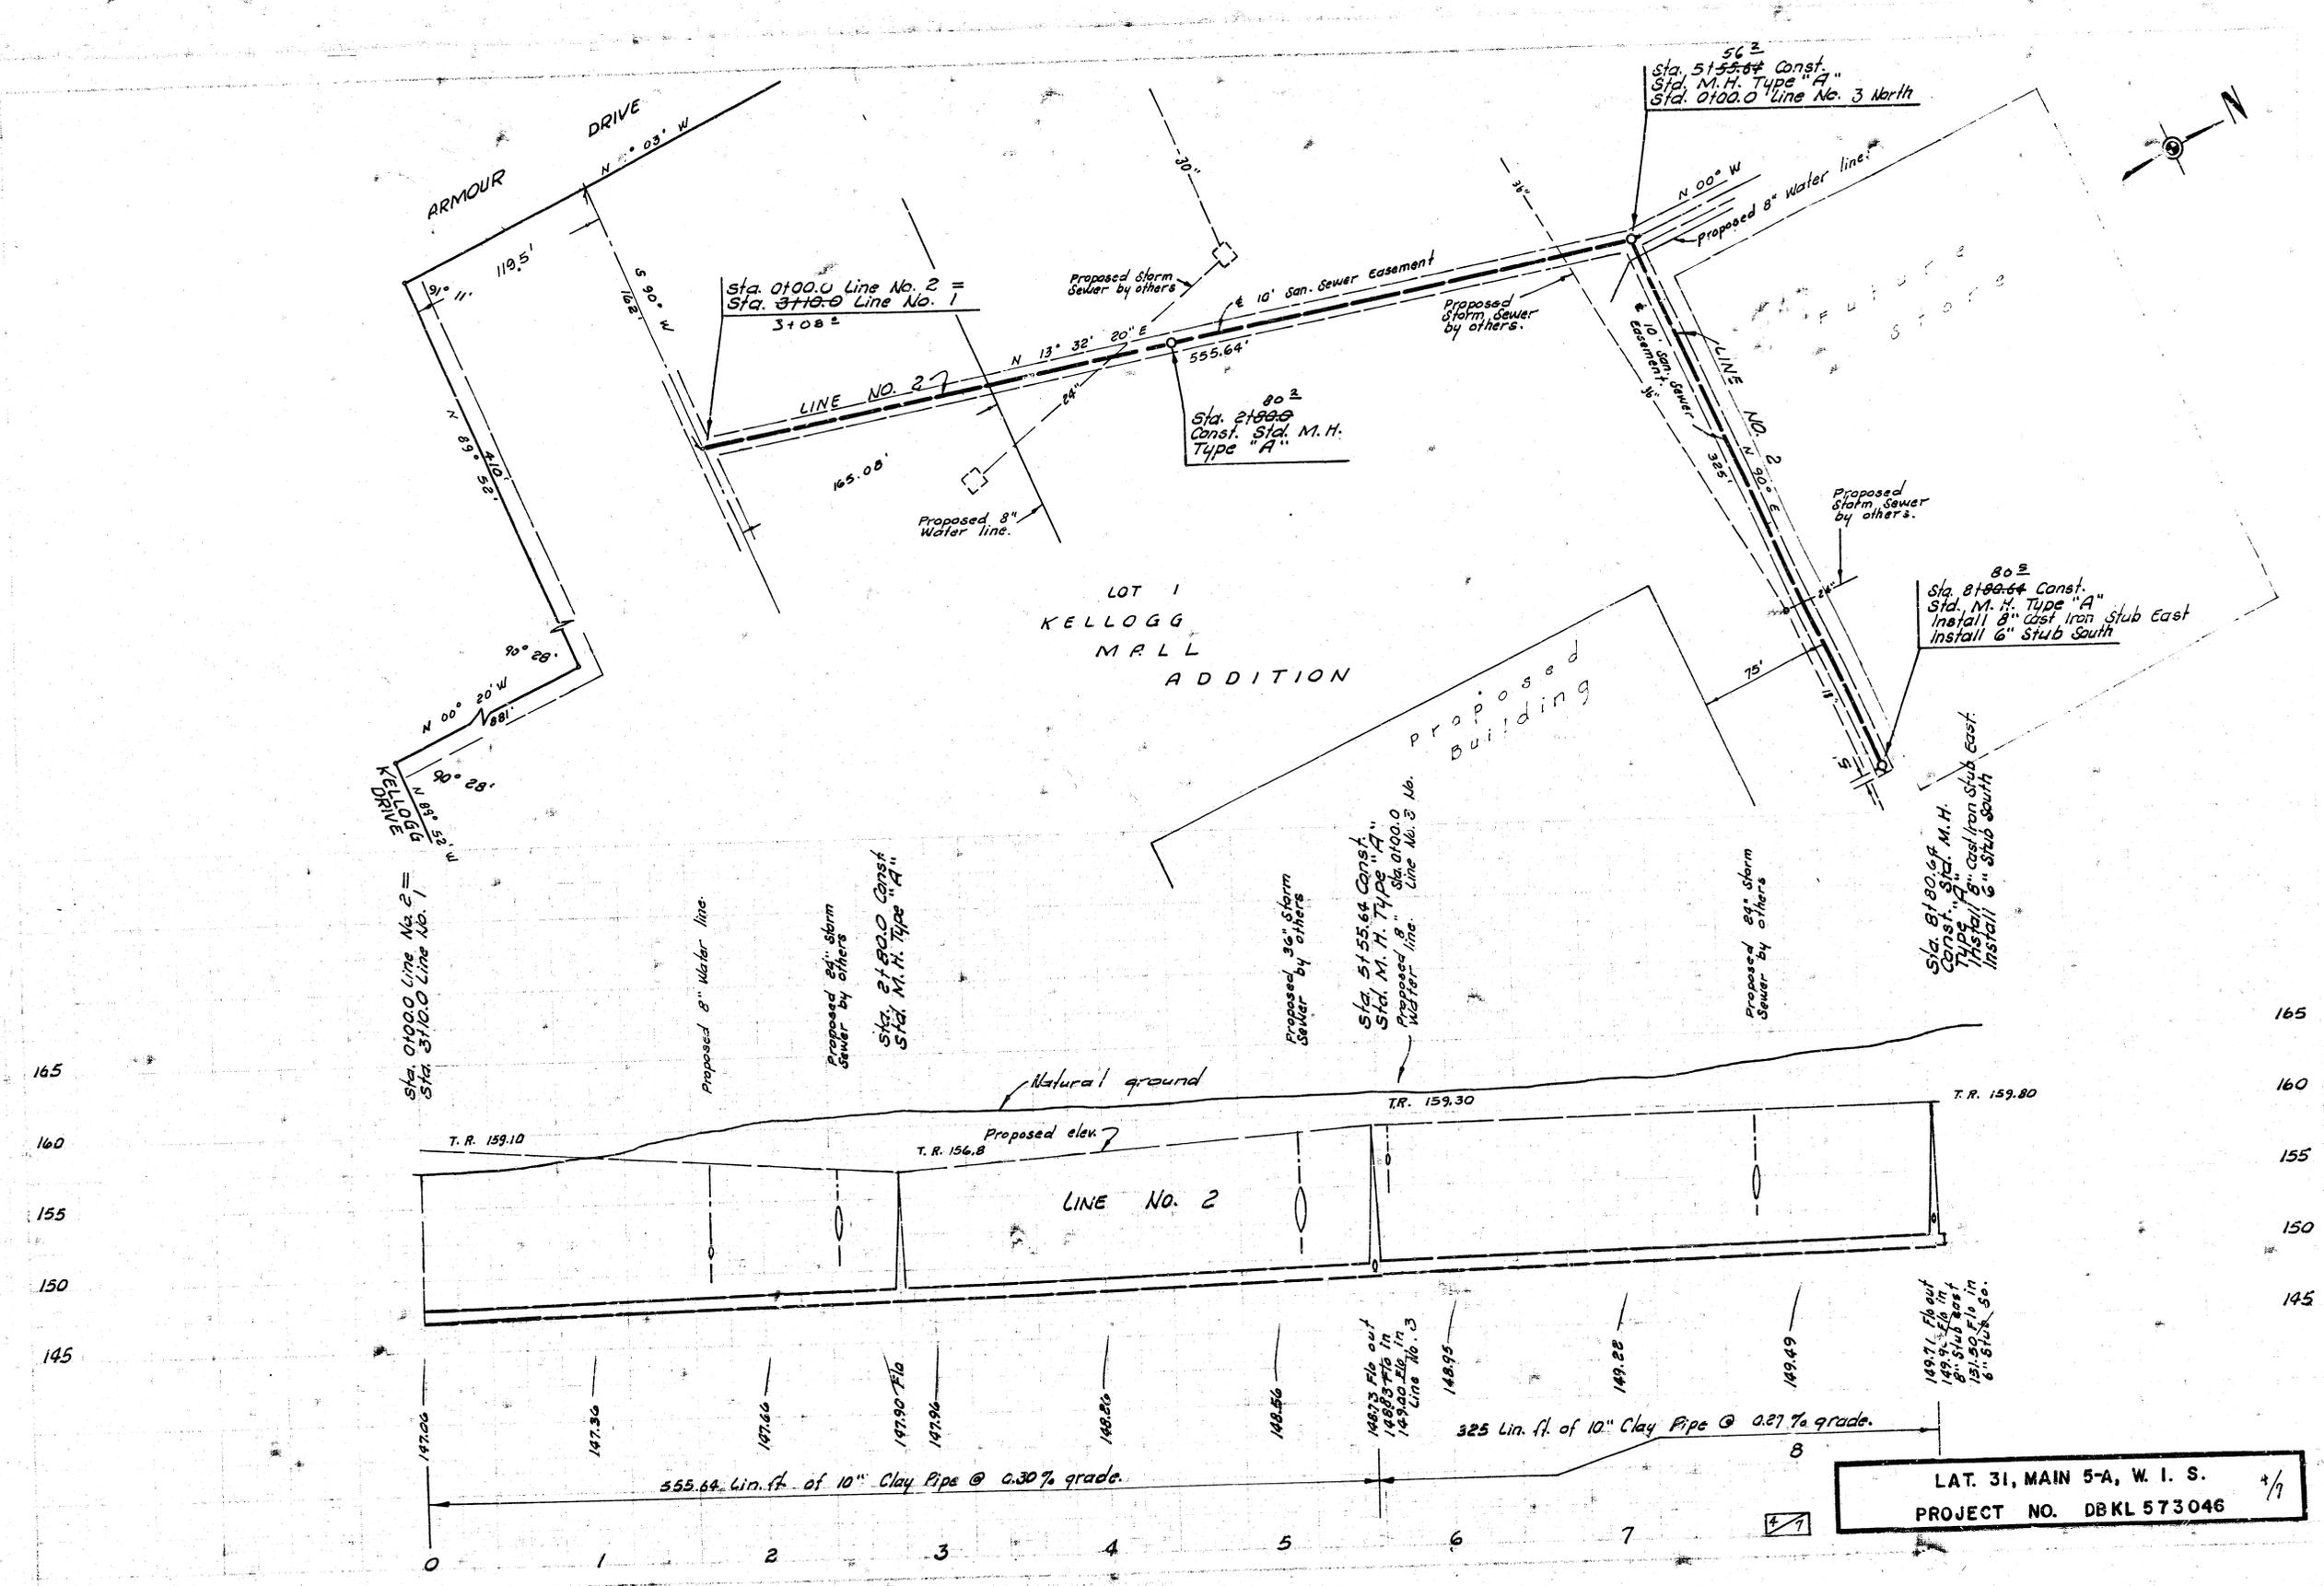

ARMOUR DRIVE
 N 00° 03' W
 110.5'
 9' 11"
 N 83° 52' W
 210.52'
 5 30' W
 210.52'
 70° 28'
 N 00° 20' W
 281'
 90° 28'
 N 83° 52' W
 210.52'
 KELLOGG DRIVE
 Sta. 0100.0 Line No. 2 =
 Sta. 310.0 Line No. 1

Sta. 0100.0 Line No. 2 =
 Sta. 310.0 Line No. 1
 3+08.2

LINE NO. 27
 N 13° 32' 20" E
 555.64'

80 ±
 Sta. 2180.0
 Const. Std. M.H.
 Type "A"

56 ±
 Sta. 5155.64 Const.
 Std. M.H. Type "A"
 Sta. 0100.0 Line No. 3 North

LOT 1
 KELLOGG
 MALL
 ADDITION

Proposed
 Building

80 ±
 Sta. 8180.64 Const.
 Std. M.H. Type "A"
 Install 8" Cast Iron Stub East
 Install 6" Stub South

Sta. 8180.64
 Const. Std. M.H.
 Type "A"
 Install 8" Cast Iron Stub East
 Install 6" Stub South

Sta. 0100.0 Line No. 2 =
 Sta. 310.0 Line No. 1

Proposed 8" Water line

Proposed 24" Storm
 Sewer by others

Sta. 2180.0 Const.
 Std. M.H. Type "A"

Proposed 36" Storm
 Sewer by others

Sta. 5155.64 Const.
 Std. M.H. Type "A"
 Proposed 8" Water line


Proposed 24" Storm
 Sewer by others

165
 160
 155
 150
 145

165
 160
 155
 150
 145

Natural ground
 Proposed elev.
 T.R. 159.10
 T.R. 156.8
 T.R. 159.30
 T.R. 159.80
 LINE NO. 2
 555.64 Lin. ft. of 10" Clay Pipe @ 0.30% grade.
 325 Lin. ft. of 10" Clay Pipe @ 0.27% grade.
 147.36
 147.60
 147.90 Flt
 147.96
 148.20
 148.46
 148.73 Flt out
 148.87 Flt in
 149.00 Flt in
 Line No. 3
 148.95
 149.22
 149.49
 149.71 Flt out
 149.9 Flt in
 8" Stub East
 151.50 Flt in
 6" Stub So.

LAT. 31, MAIN 5-A, W. I. S.
 PROJECT NO. DBKL 573046

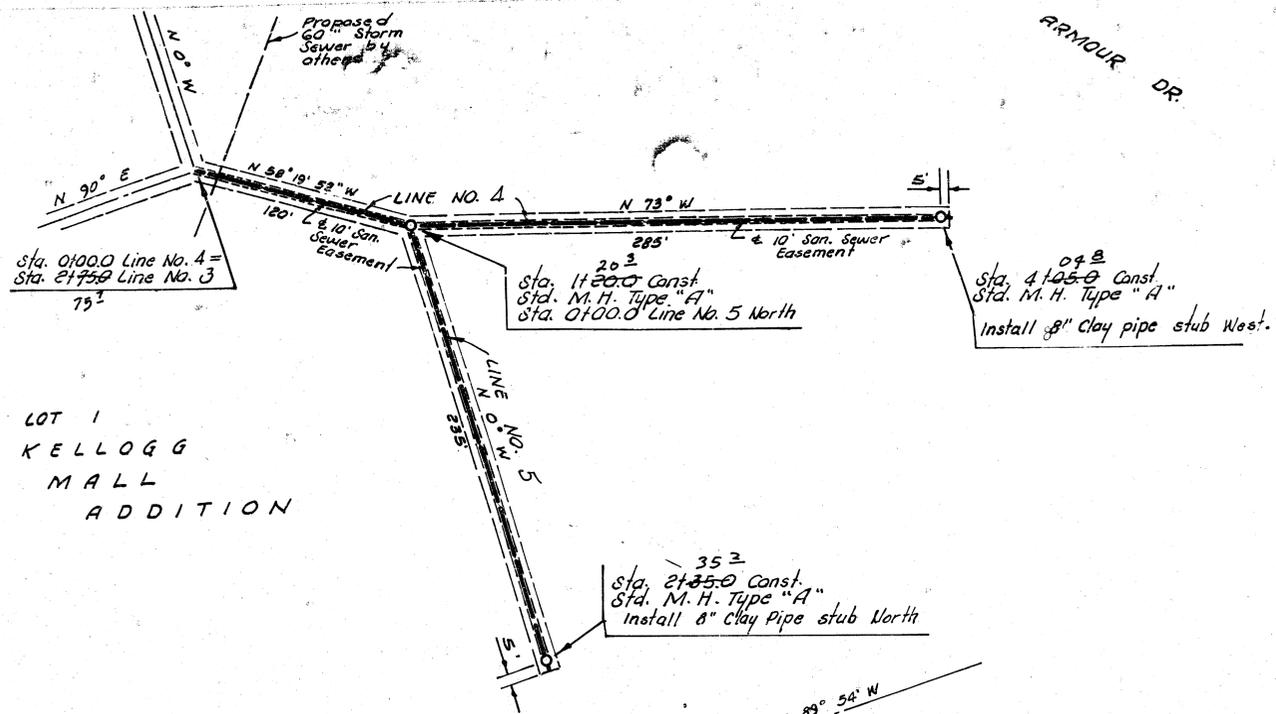

LOT 1
KELLOGG
MALL
ADDITION

Sta. 0+00.0 Line No. 4 =
Sta. 2+75.0 Line No. 3
Proposed 60" Storm
Sewer by others

Sta. 1+200.0 Const.
Sta. M. H. Type "A"
Sta. 0+00.0 Line No. 5





Sta. 4+05.0 Const.
Sta. M. H. Type "A"
Install 8" clay pipe stub West

Sta. 0+00.0 Line No. 5 =
Sta. 1+200.0 Line No. 4

Sta. 2+35.0 Const.
Sta. M. H. Type "A"
Install 8" clay pipe stub North

170
165
160
155

170
165
160
155

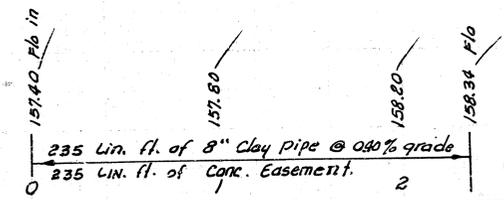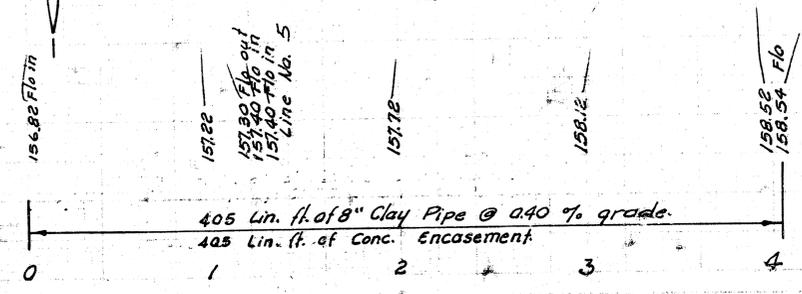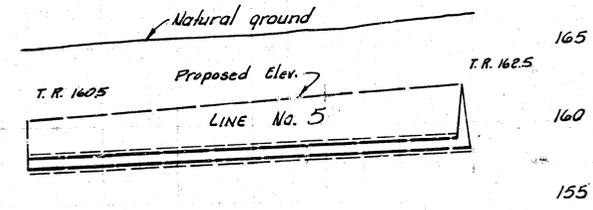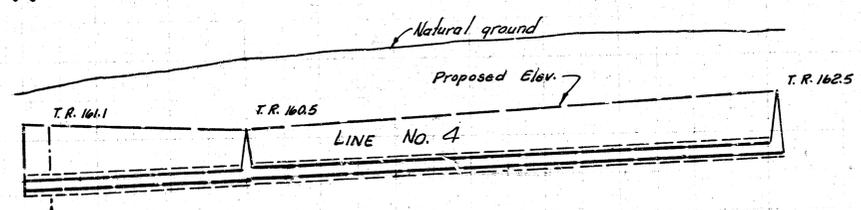

LAT. 31, MAIN 5-A, W. I. S.
PROJECT NO. DBK 573046
Sheet No. 6 Revised 9-11-73

6/7

