


# LATERAL 16, MAIN 22, W.I.S. PROJECT NO. 468-76-245-81157-000-000-001

CITY OF WICHITA, KANSAS  
R. W. BRUGGEMAN, CITY ENGINEER  
JANUARY, 1982

*As Built  
J.L.H.  
11-82*

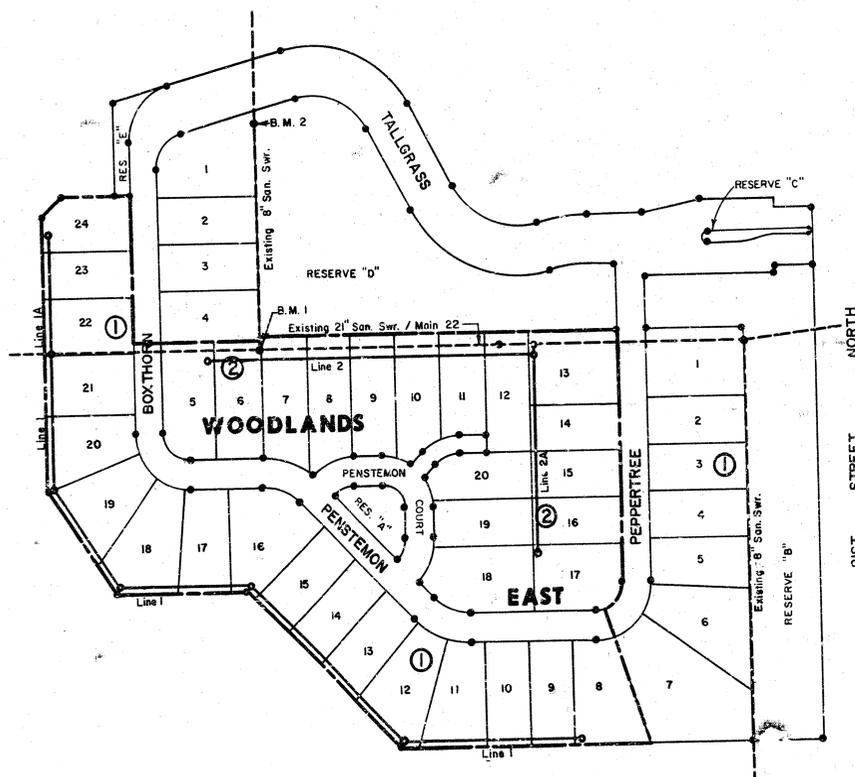

B.M. #1: SOUTH RIM OF WEST MANHOLE, STA 104+05  
MAIN 22, W.I.S.  
ELEV. = 194.11

B.M. #2: SOUTH RIM OF EAST MANHOLE, STA 2+50 -  
LINE 1, MAIN 22, W.I.S. EXTENSION  
ELEV. = 192.16



Due to extensive, ongoing construction, special attention should be given to the location of underground utilities.

### INDEX TO DRAWINGS

SHEET NO.	DESCRIPTION
1	COVER SHEET
2	LINE 1 & 1A
3	LINE 2 & 2A
4	PLAT
5	RISER DETAIL

### LEGEND

PROPOSED LINE	—————
EXISTING LINE	-----
BENEFIT DISTRICT BOUNDARY	-----



### GENERAL NOTES

- RISER PIPE SHALL BE INSTALLED TO SERVE INDIVIDUAL LOTS OR TRACTS IN CONJUNCTION WITH NEW SANITARY SEWER CONSTRUCTION, UNLESS OTHERWISE ORDERED BY THE ENGINEER, BECAUSE OF GROUND WATER, UNSTABLE SOIL OR UNUSUALLY DEEP CONSTRUCTION. RISER LOCATIONS SHALL BE AS APPROVED BY THE PROPERTY OWNER WITH THE CONCURRENCE OF THE ENGINEER. INSTALLATION OF RISERS ON SEWERS BECAUSE OF UNUSUAL DEPTH WILL BE REQUIRED WHEN THE SEWER IS DEEPER THAN TWELVE FEET (12'). THE CONTRACTOR WILL BE REQUIRED TO FILE WRITTEN DOCUMENTATION WITH THE ENGINEER IN A FORM APPROVED BY THE ENGINEER INDICATING THE LOCATIONS WHERE RISERS ARE TO BE INSTALLED AS REQUESTED BY THE PROPERTY OWNER OR HIS AUTHORIZED REPRESENTATIVE. RISER PIPE CONSTRUCTION SHALL CONFORM TO THE REQUIREMENTS AS SHOWN ON THE STANDARD RISER DETAIL SHEET.
- THE CONTRACTOR SHALL BE RESPONSIBLE FOR PRESERVING PROPERTY IRONS. THE CONTRACTOR SHALL BE REQUIRED TO RE-ESTABLISH ANY PROPERTY IRONS WHICH ARE DAMAGED OR DESTROYED BY HIS CONSTRUCTION OPERATIONS. SUCH IRONS SHALL BE RE-ESTABLISHED BY A LICENSED LAND SURVEYOR OR A LICENSED PROFESSIONAL ENGINEER IN ACCORDANCE WITH STATE LAWS.




**Van Doren Hazard Stallings**  
Architects - Engineers - Planners  
Topeka - Wichita - Minneapolis - Kansas City

Sheet 1  
of 1/5

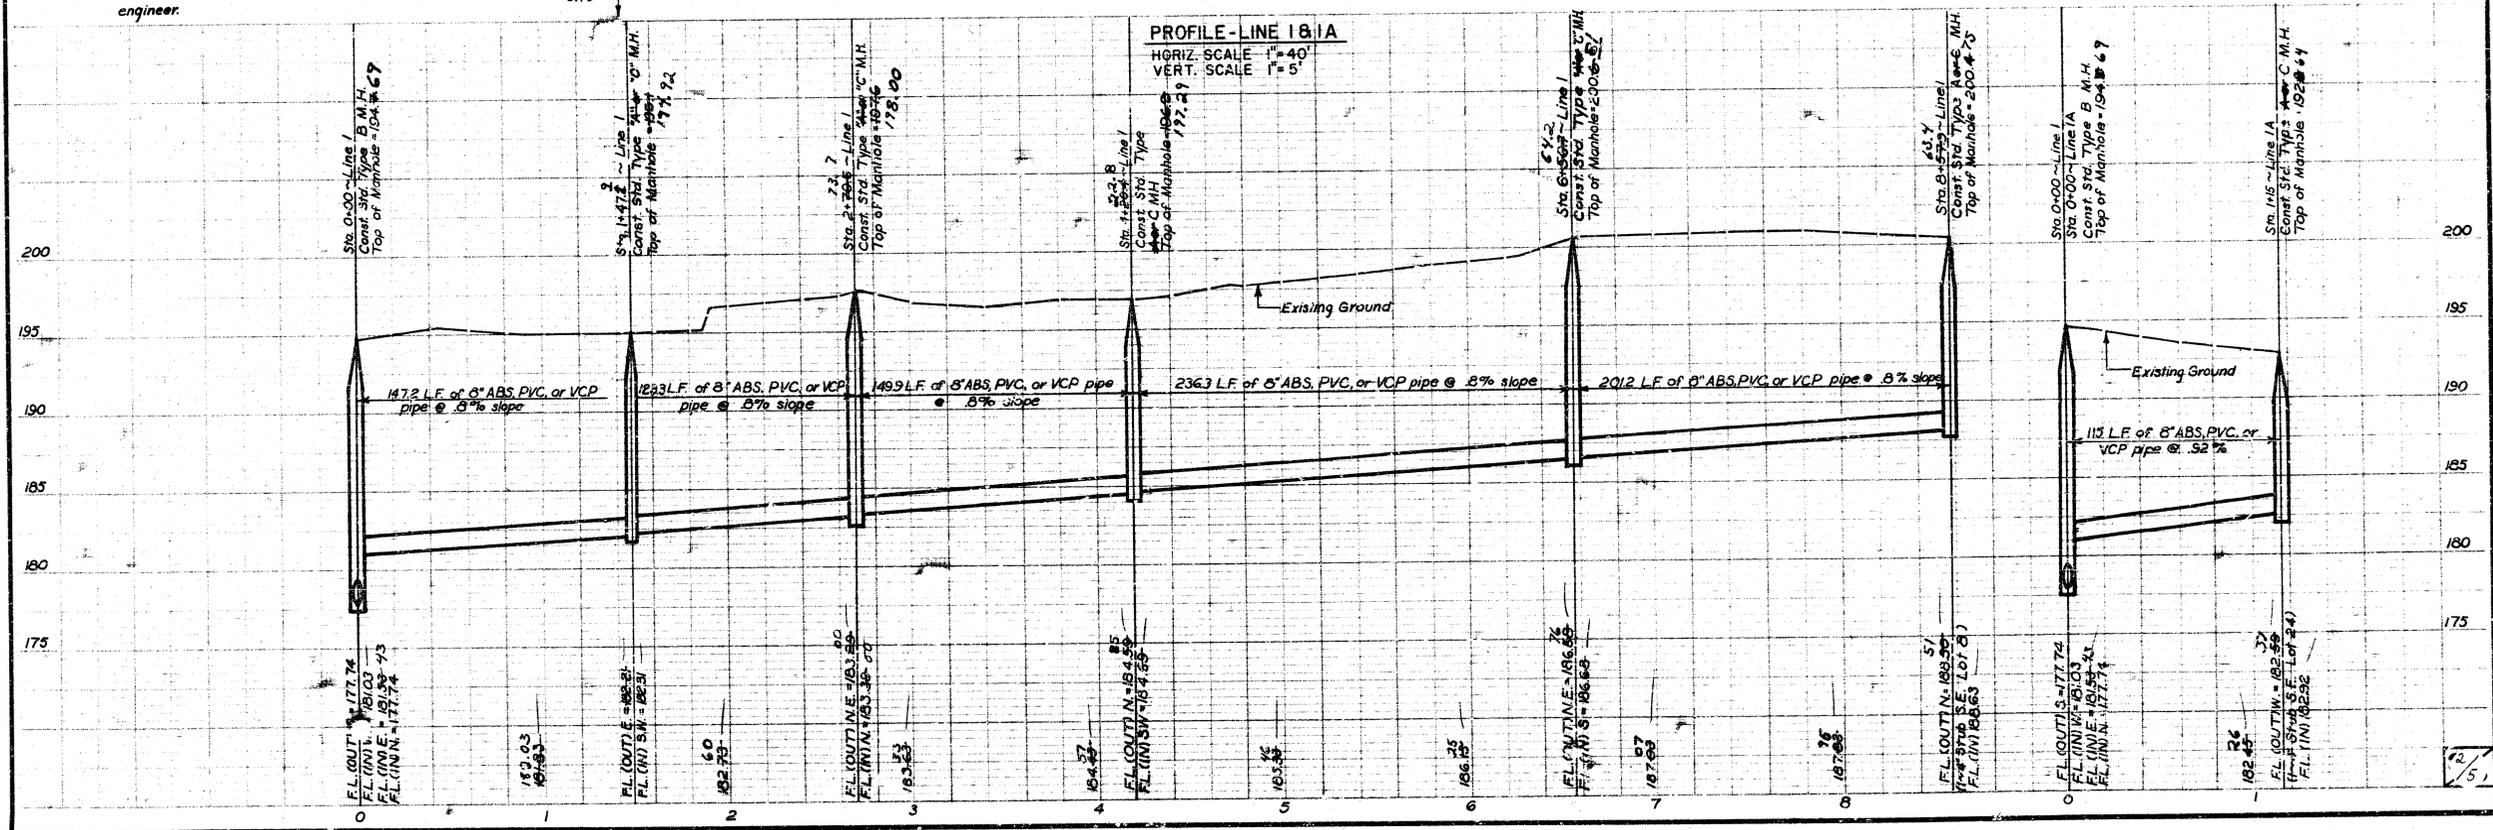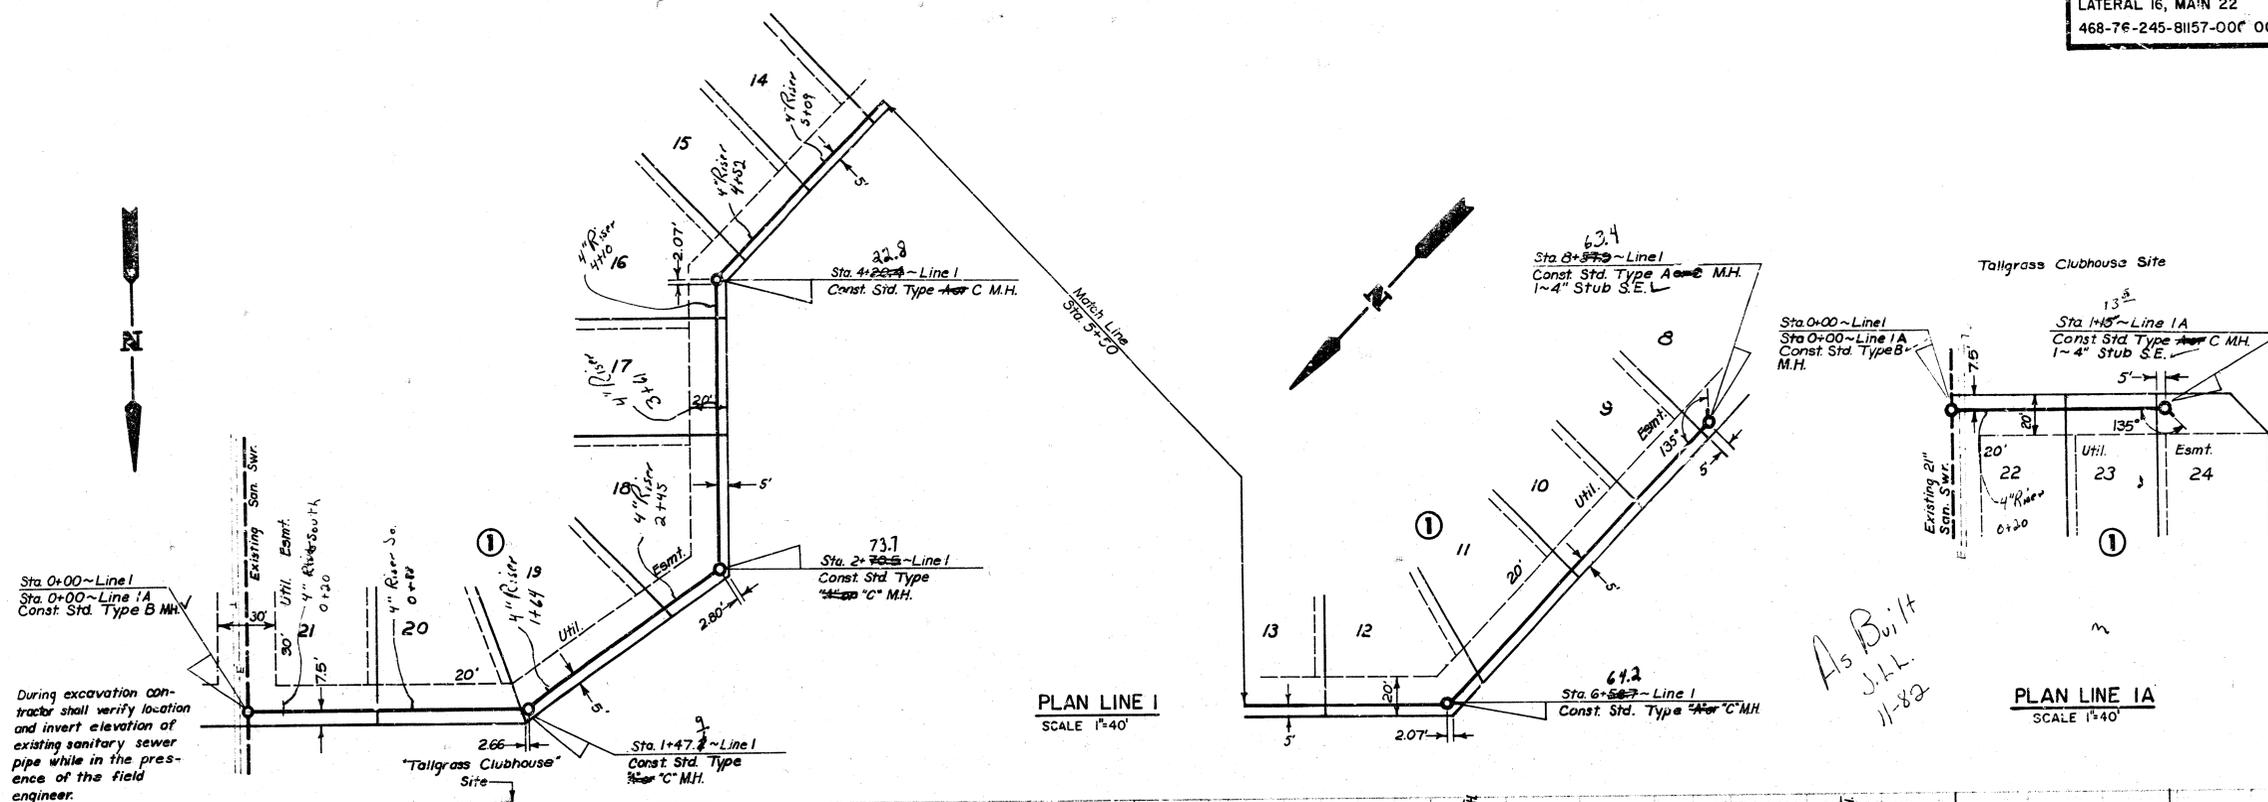

PLAN-LINE 2 & 2A  
 SCALE 1"=40'

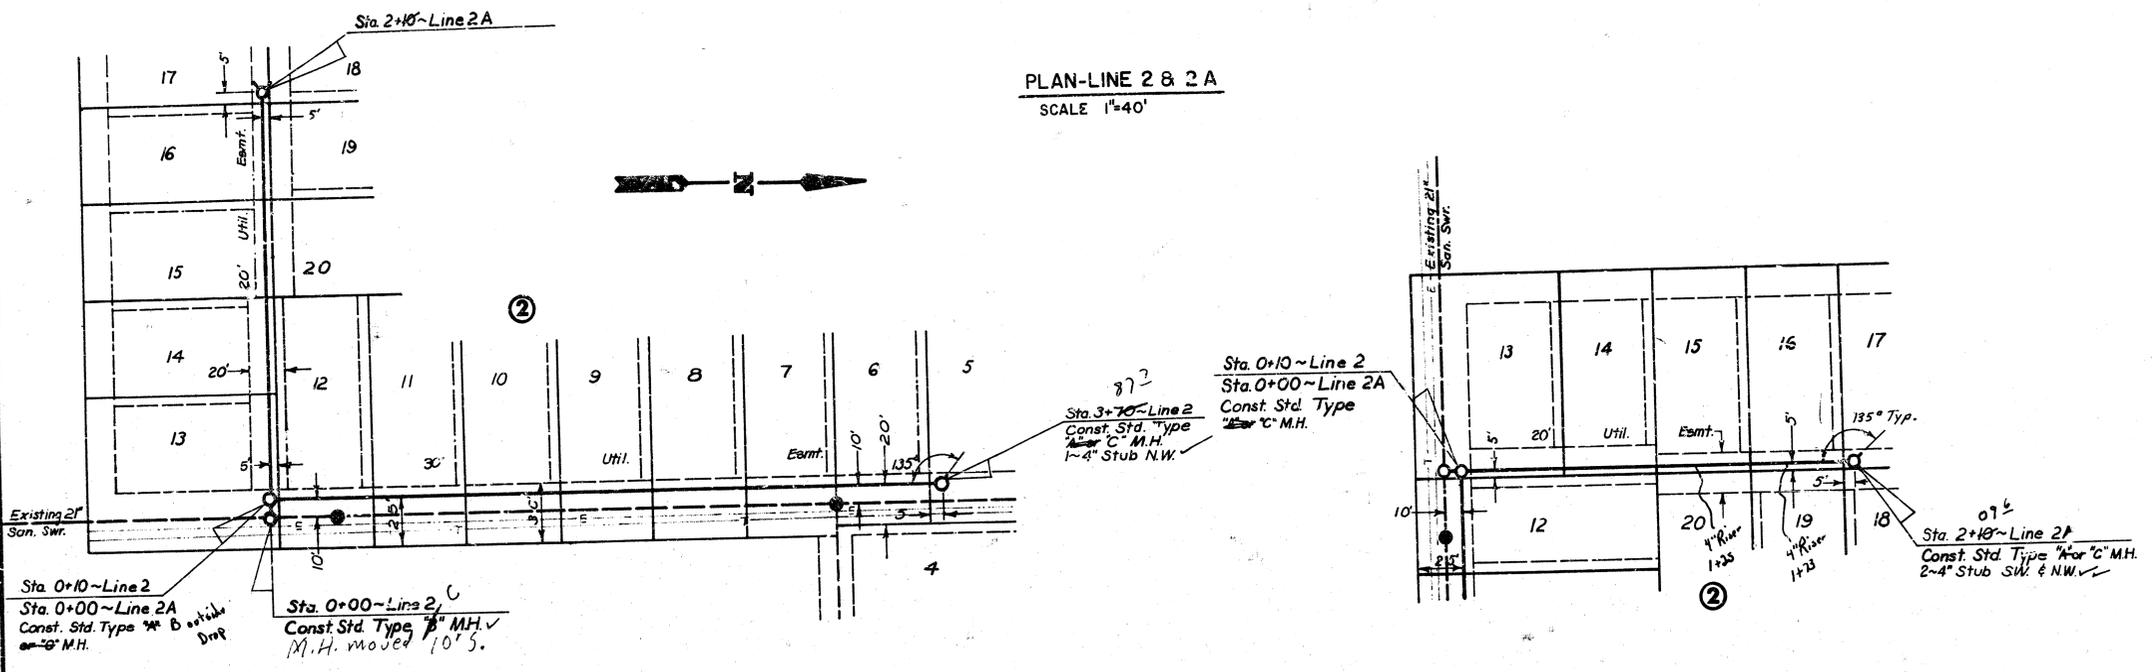

*A. Built*  
*J.H.L.*  
*11-82*

PROFILE-LINE 2 & 2A  
 HORIZ. SCALE 1"=40'  
 VERT. SCALE 1"=6'

