

LAT 4 , MAIN 12 , SW. INTERCEPTOR


CITY OF WICHITA

RAY BRUGGEMAN - CITY ENGINEER

PROJ. NO. 468-76-245-80954-000-000-001

Line # 1	Sheet # 2
Line # 2	Sheets # 3-4
Line # 2A	Sheet # 3
Line # 2B	Sheet # 3
Line # 2C	Sheet # 4
Line # 3	Sheet # 4
Line # 4	Sheet # 5
Line # 5	Sheet # 6
Line # 6	Sheet # 6
Line # 7	Sheet # 7-8
Line # 7A	Sheet # 7
Line # 7B	Sheet # 8
Line # 8	Sheet # 9

As Built
JFB

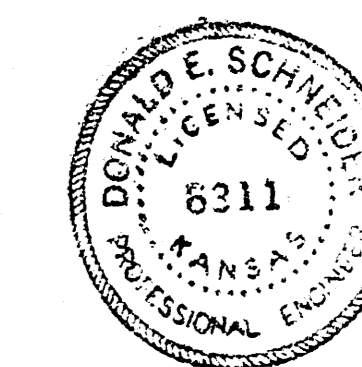

B.M. 157.93 City Std. 27.5' N and 25' E of 1/4 sec. corner 1/2 mile W. of Maize Rd. on 13th St.


B.M. 153.12 Bridge spike S-face HLP N-side 13th St. approx 20' E of EL Cardington south.

B.M. 156.52 R.R. spike S-face HLP N-side 13th St. 1400' E of 119th St. W or approx. 100' E of 1/4 corner (hedge row south).



B.M. 146.47 R.R. spike E-face Osage Orange Hedge tree in hedge row N-S @ NE Ponderosa 1/2 Block W of Cardington

B.M. 162.25 R.R. spike SW-face Osage Orange Hedge tree in hedge row N-S 1/2 mile W. of Maize Road near NE corner lot 21, Blk 5, Briarwood Estates.






Scale Plan 1"=40'
Profile 1"=40' Horiz.
1"=5' Vert.

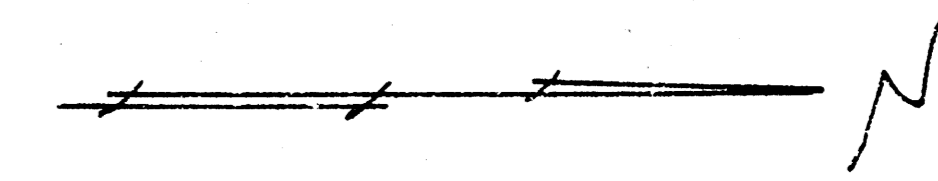









D.K. 419

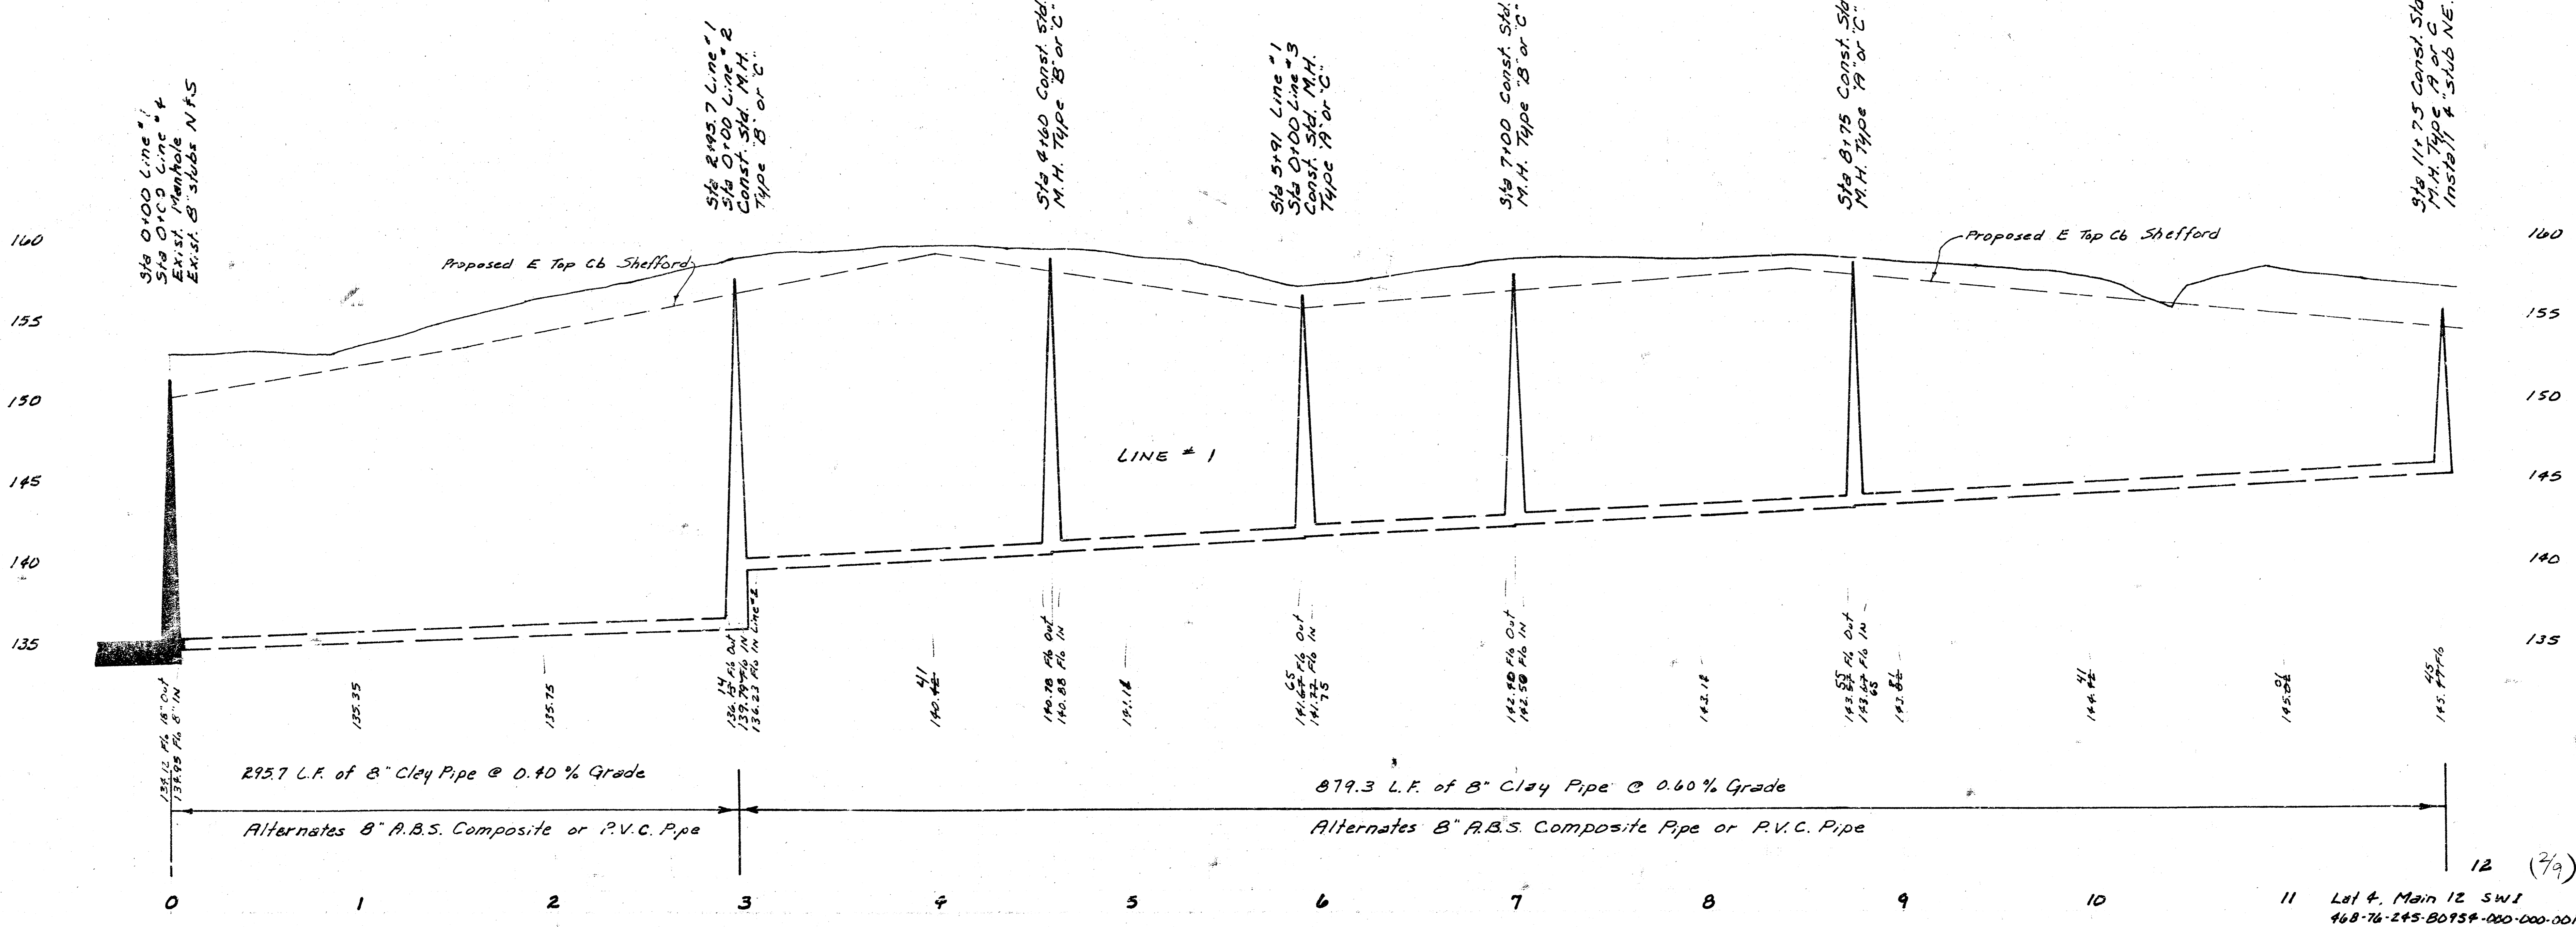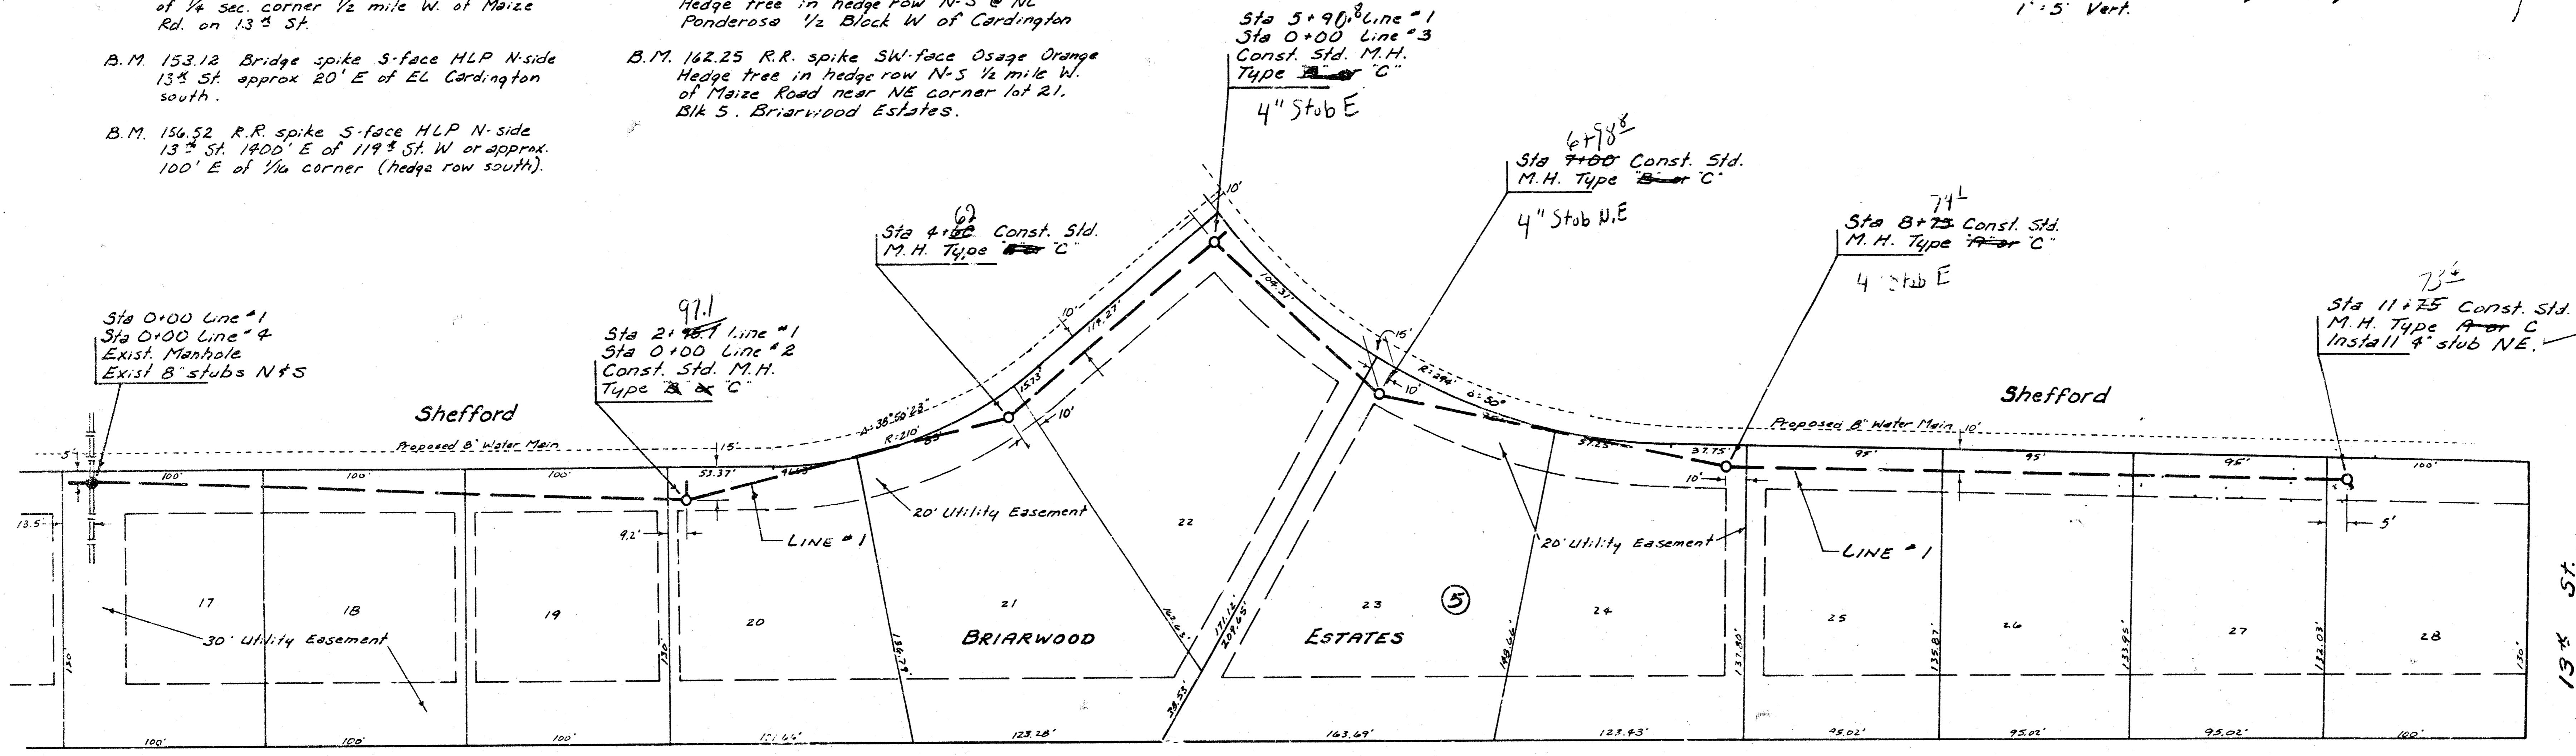


Scale Plan 1" = 40'
 Profile 1" = 40' Horiz.
 1" = 15' Vert.

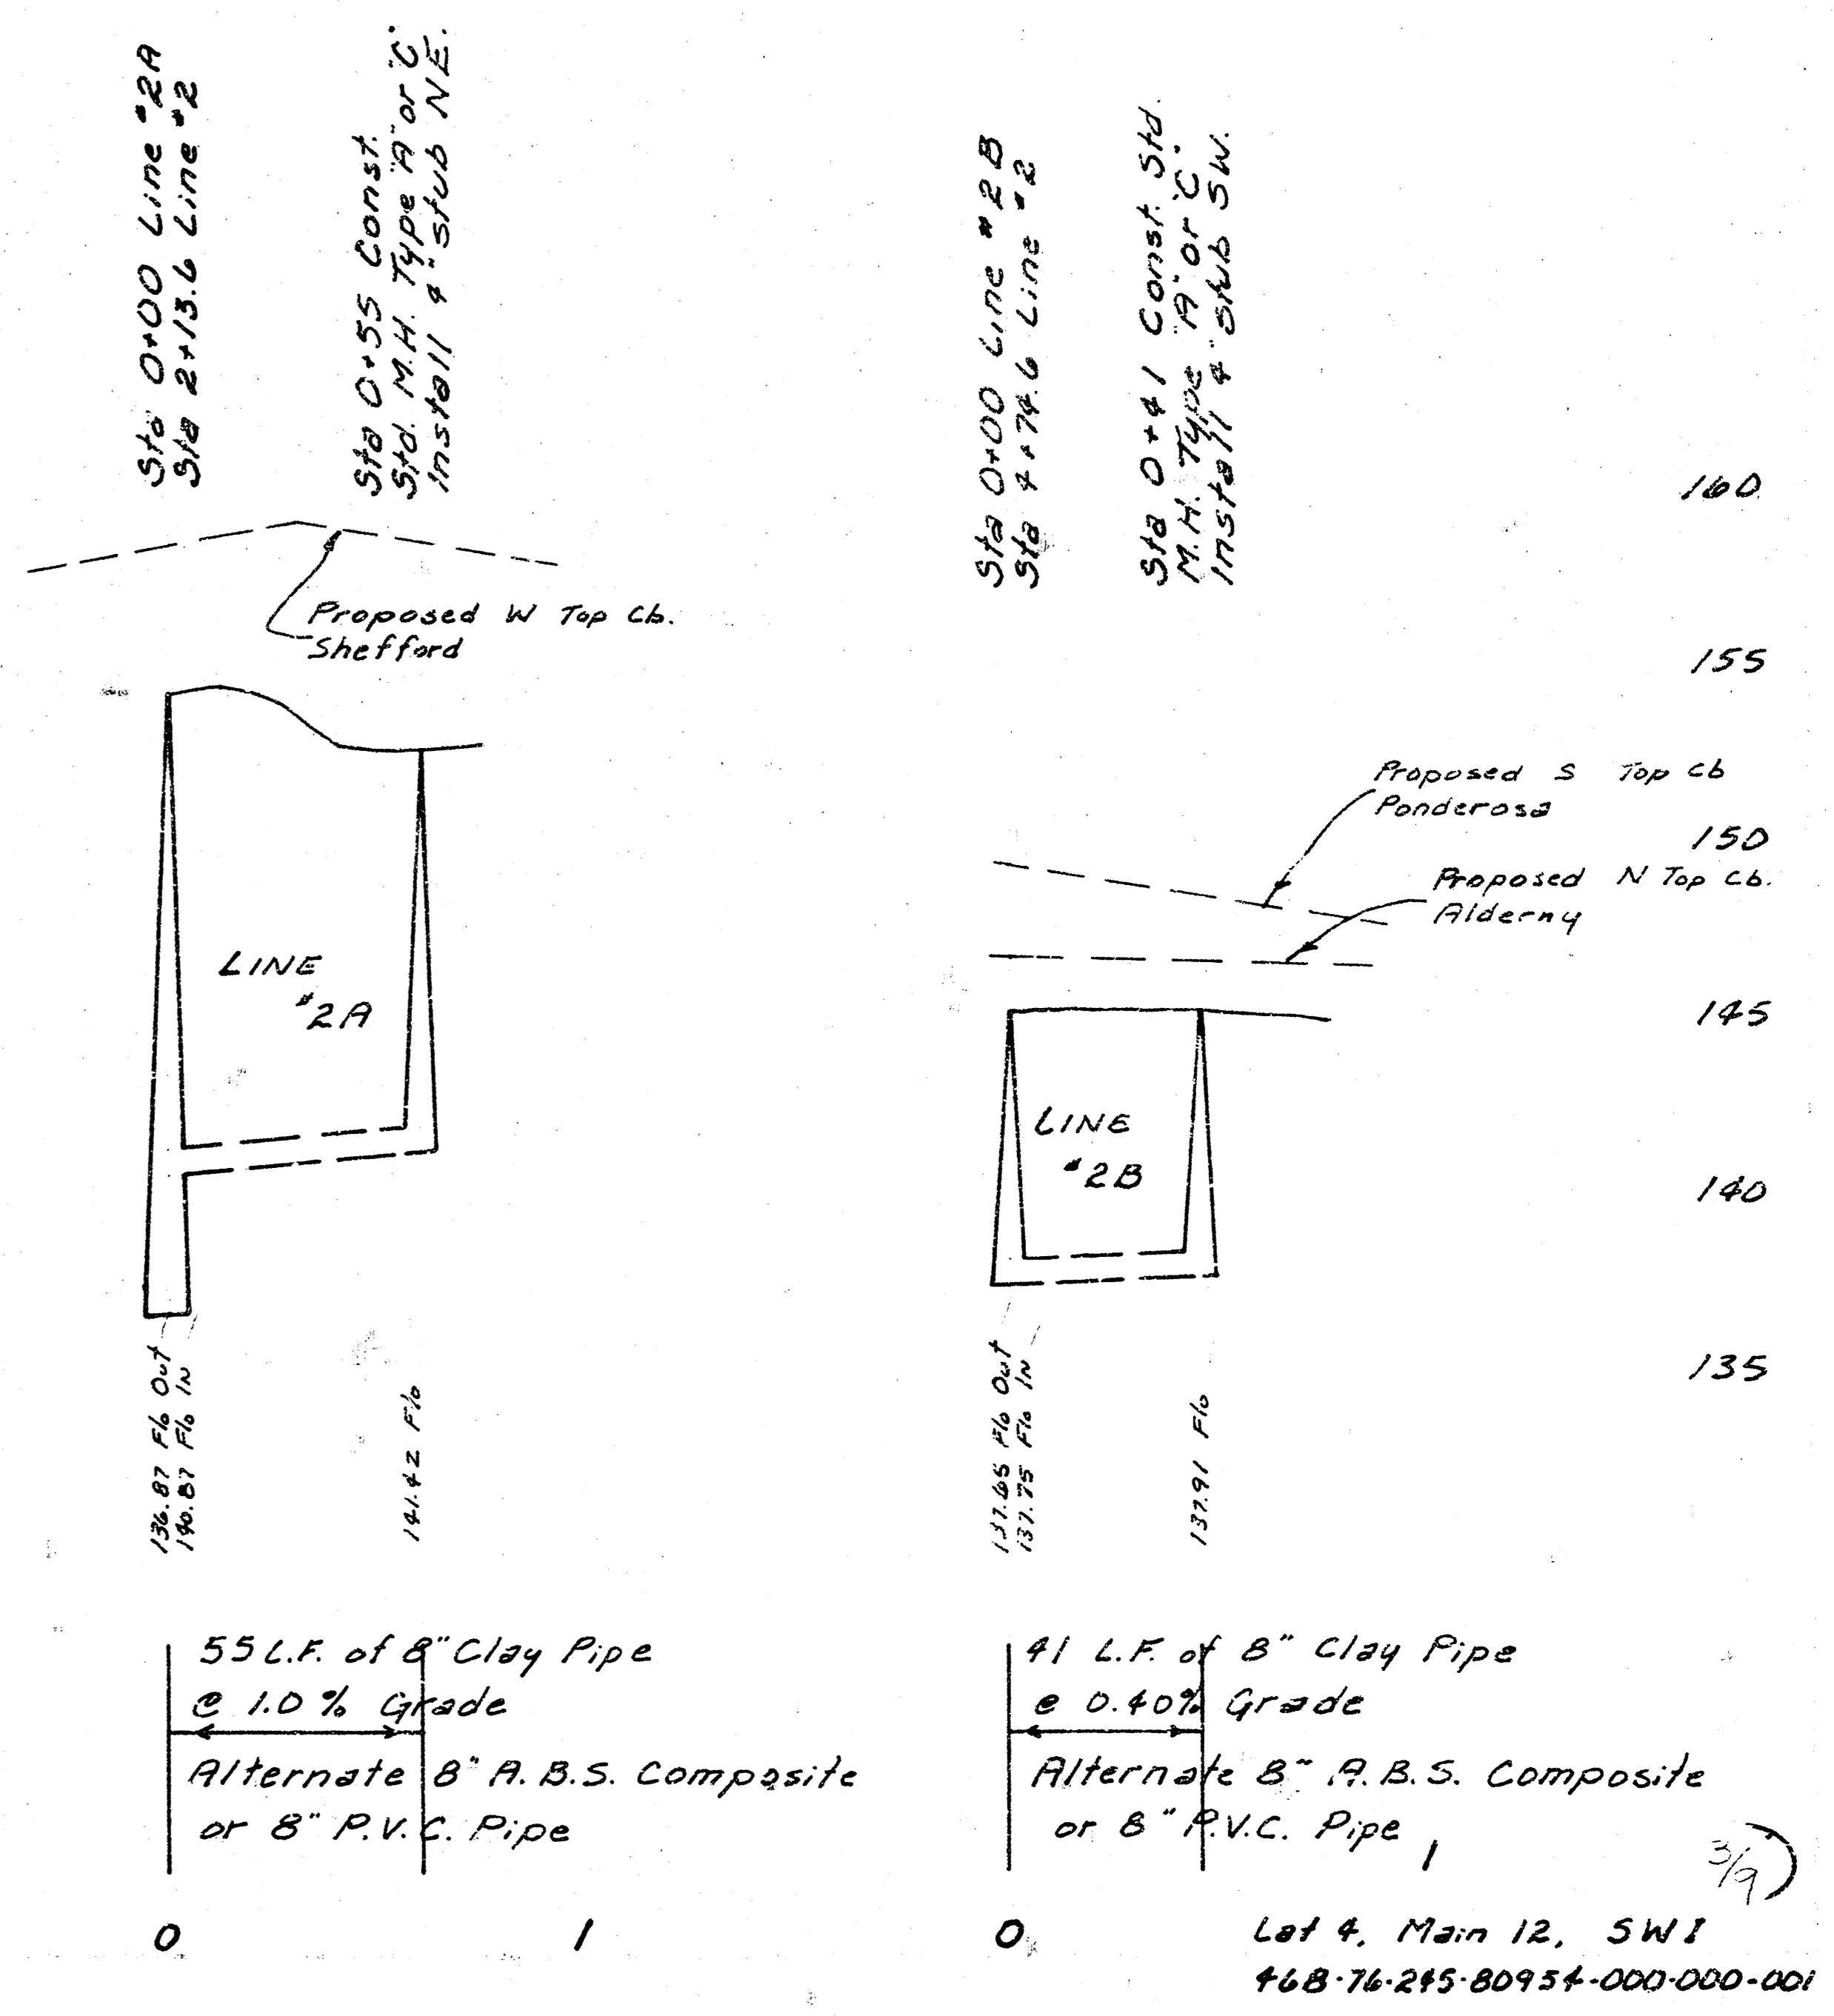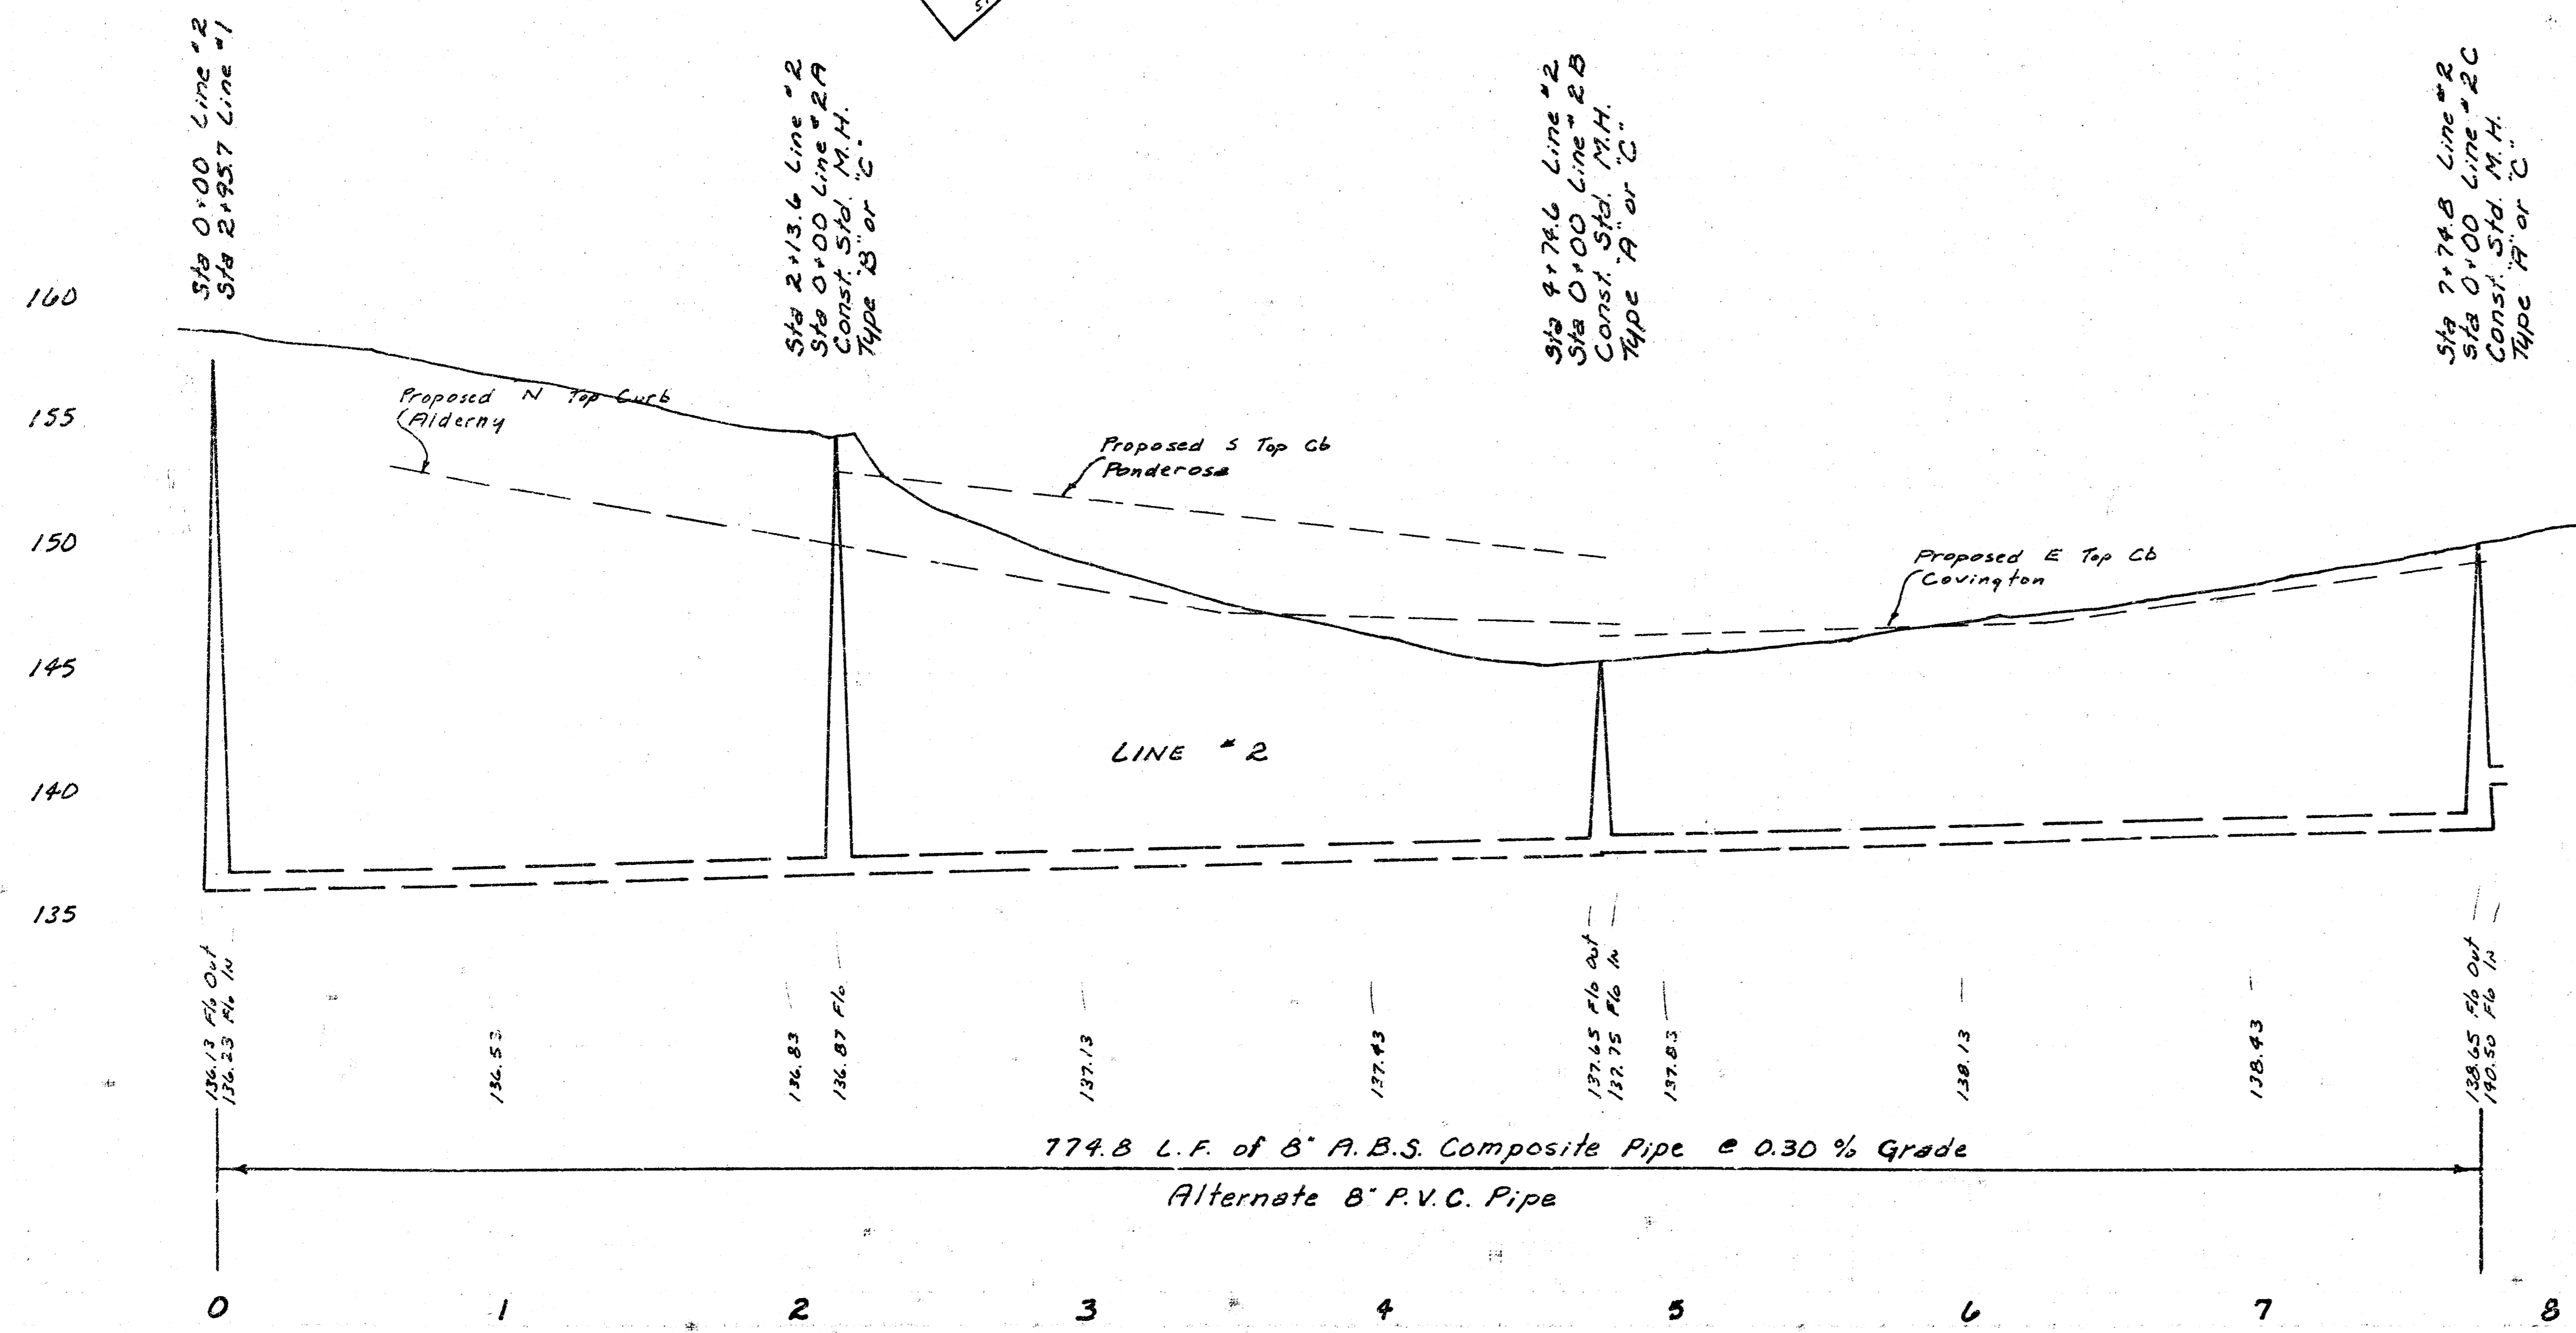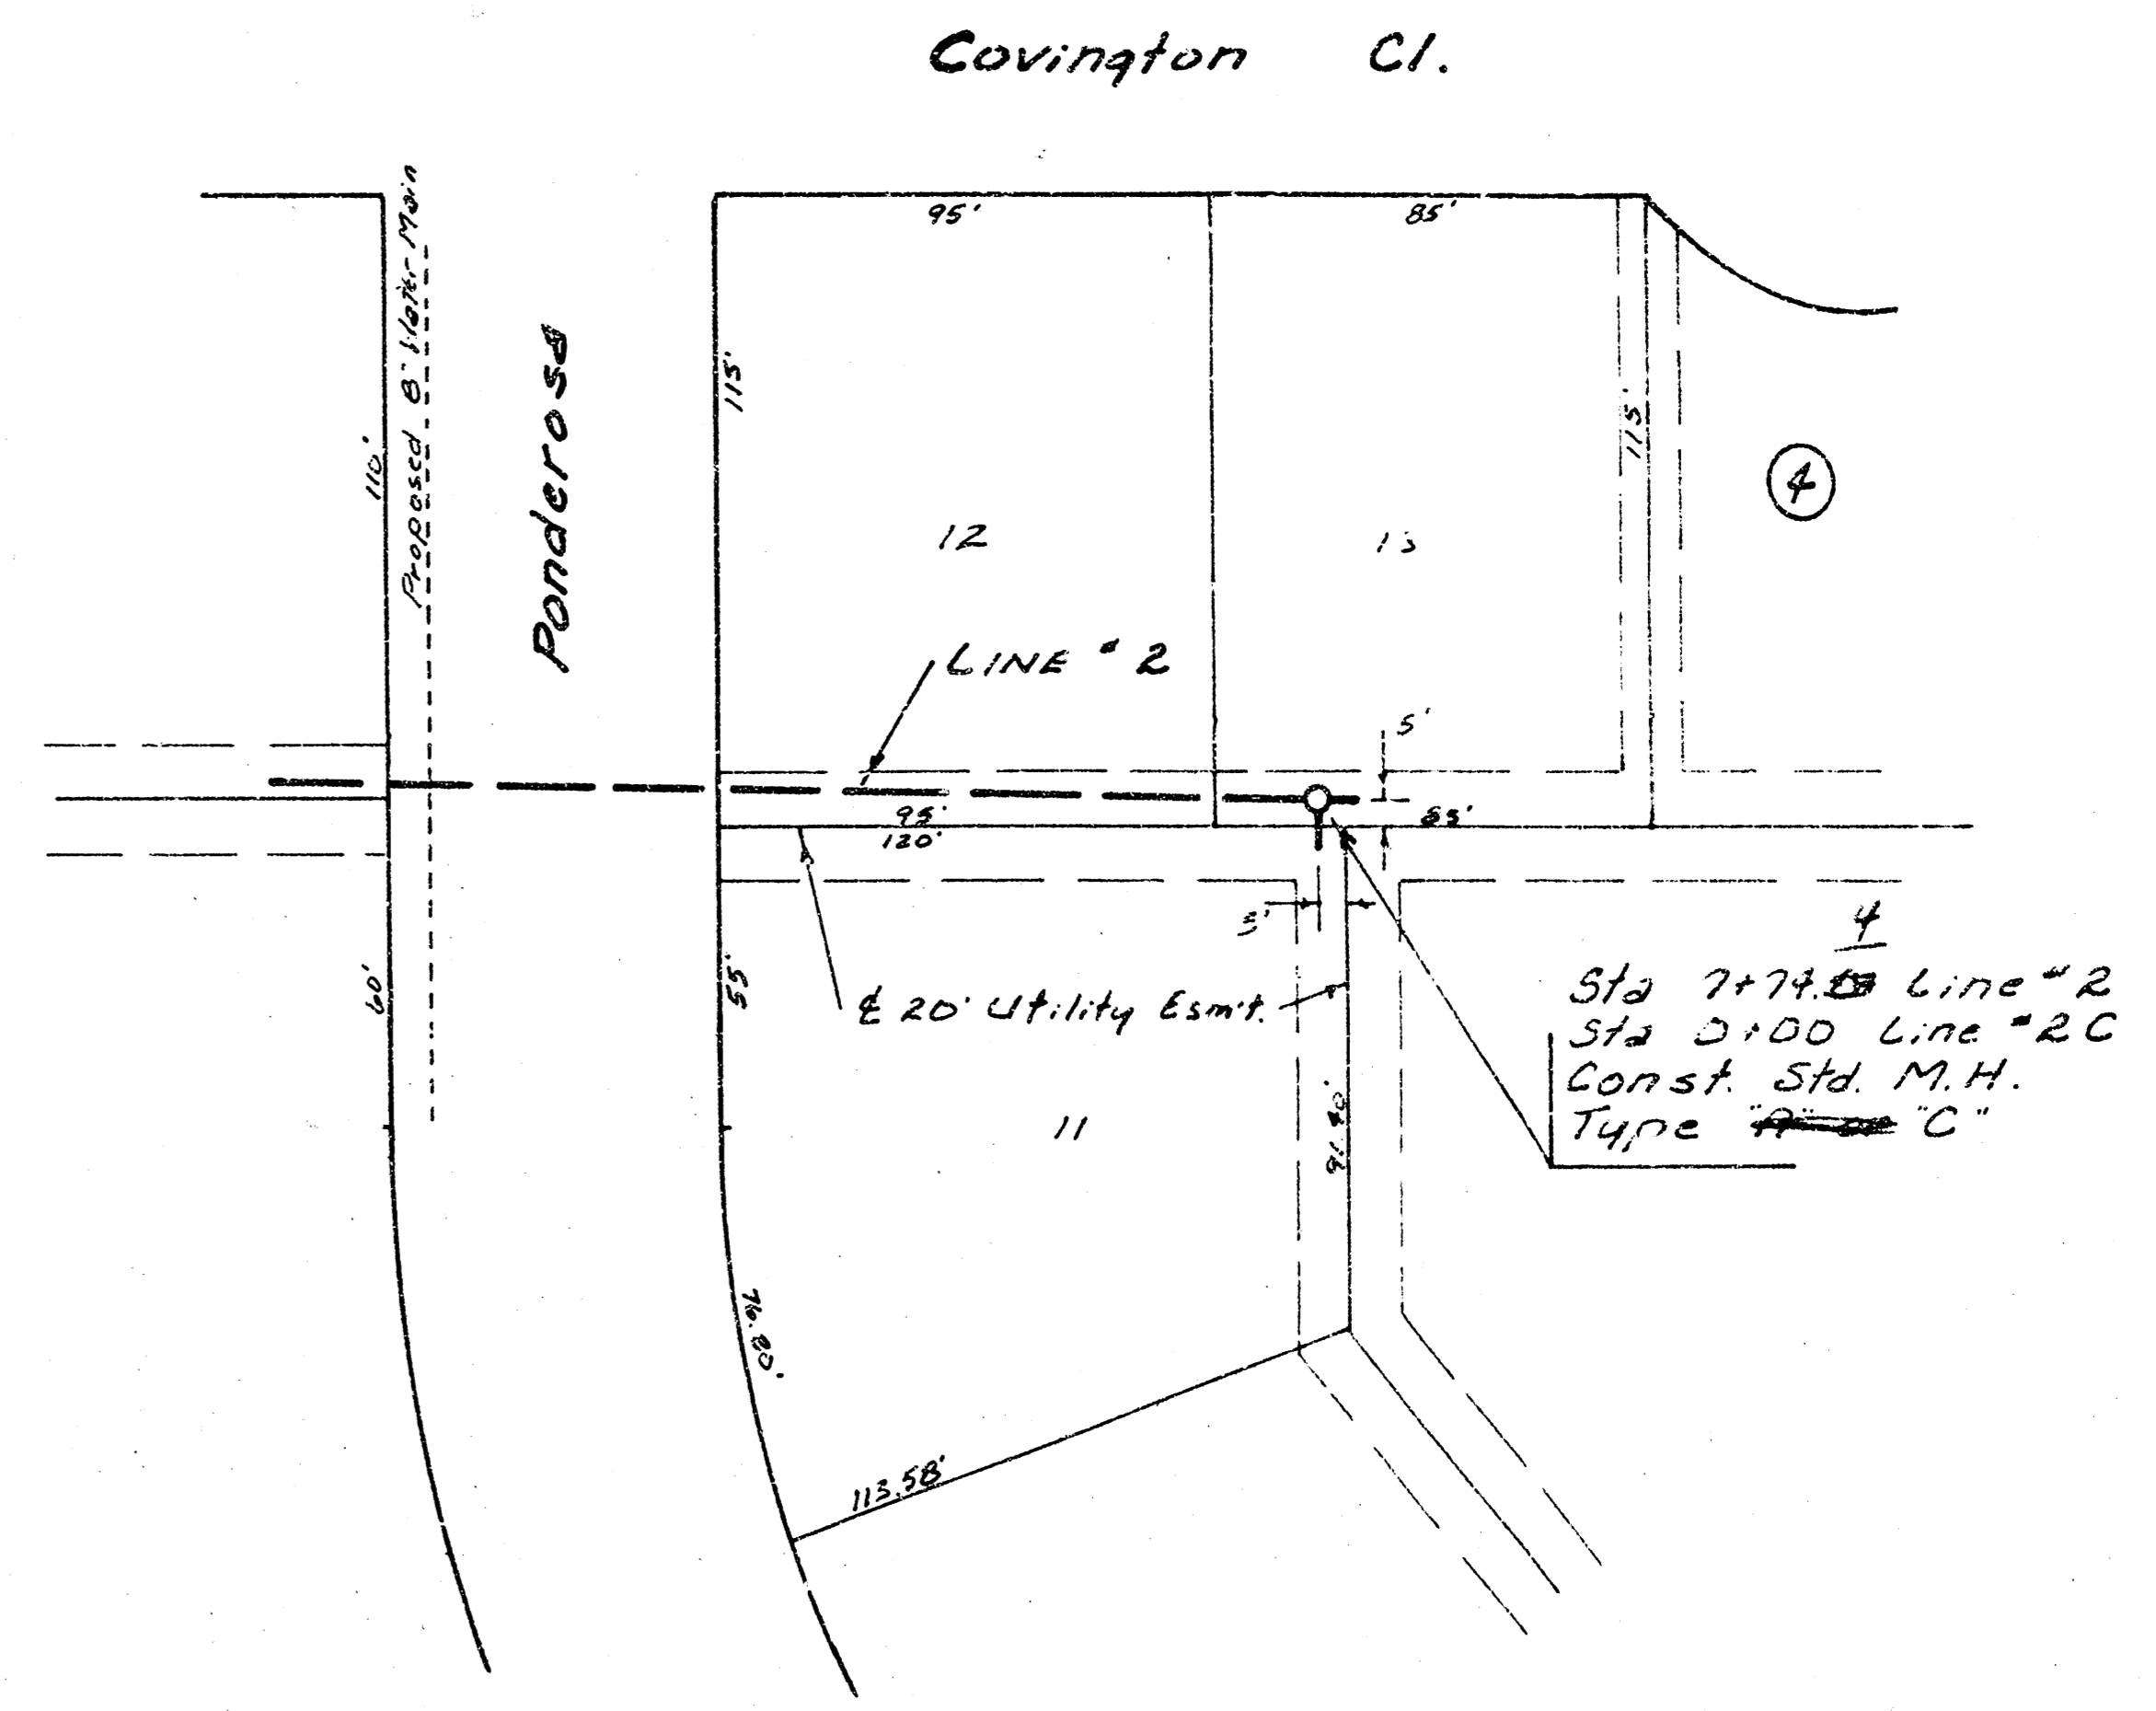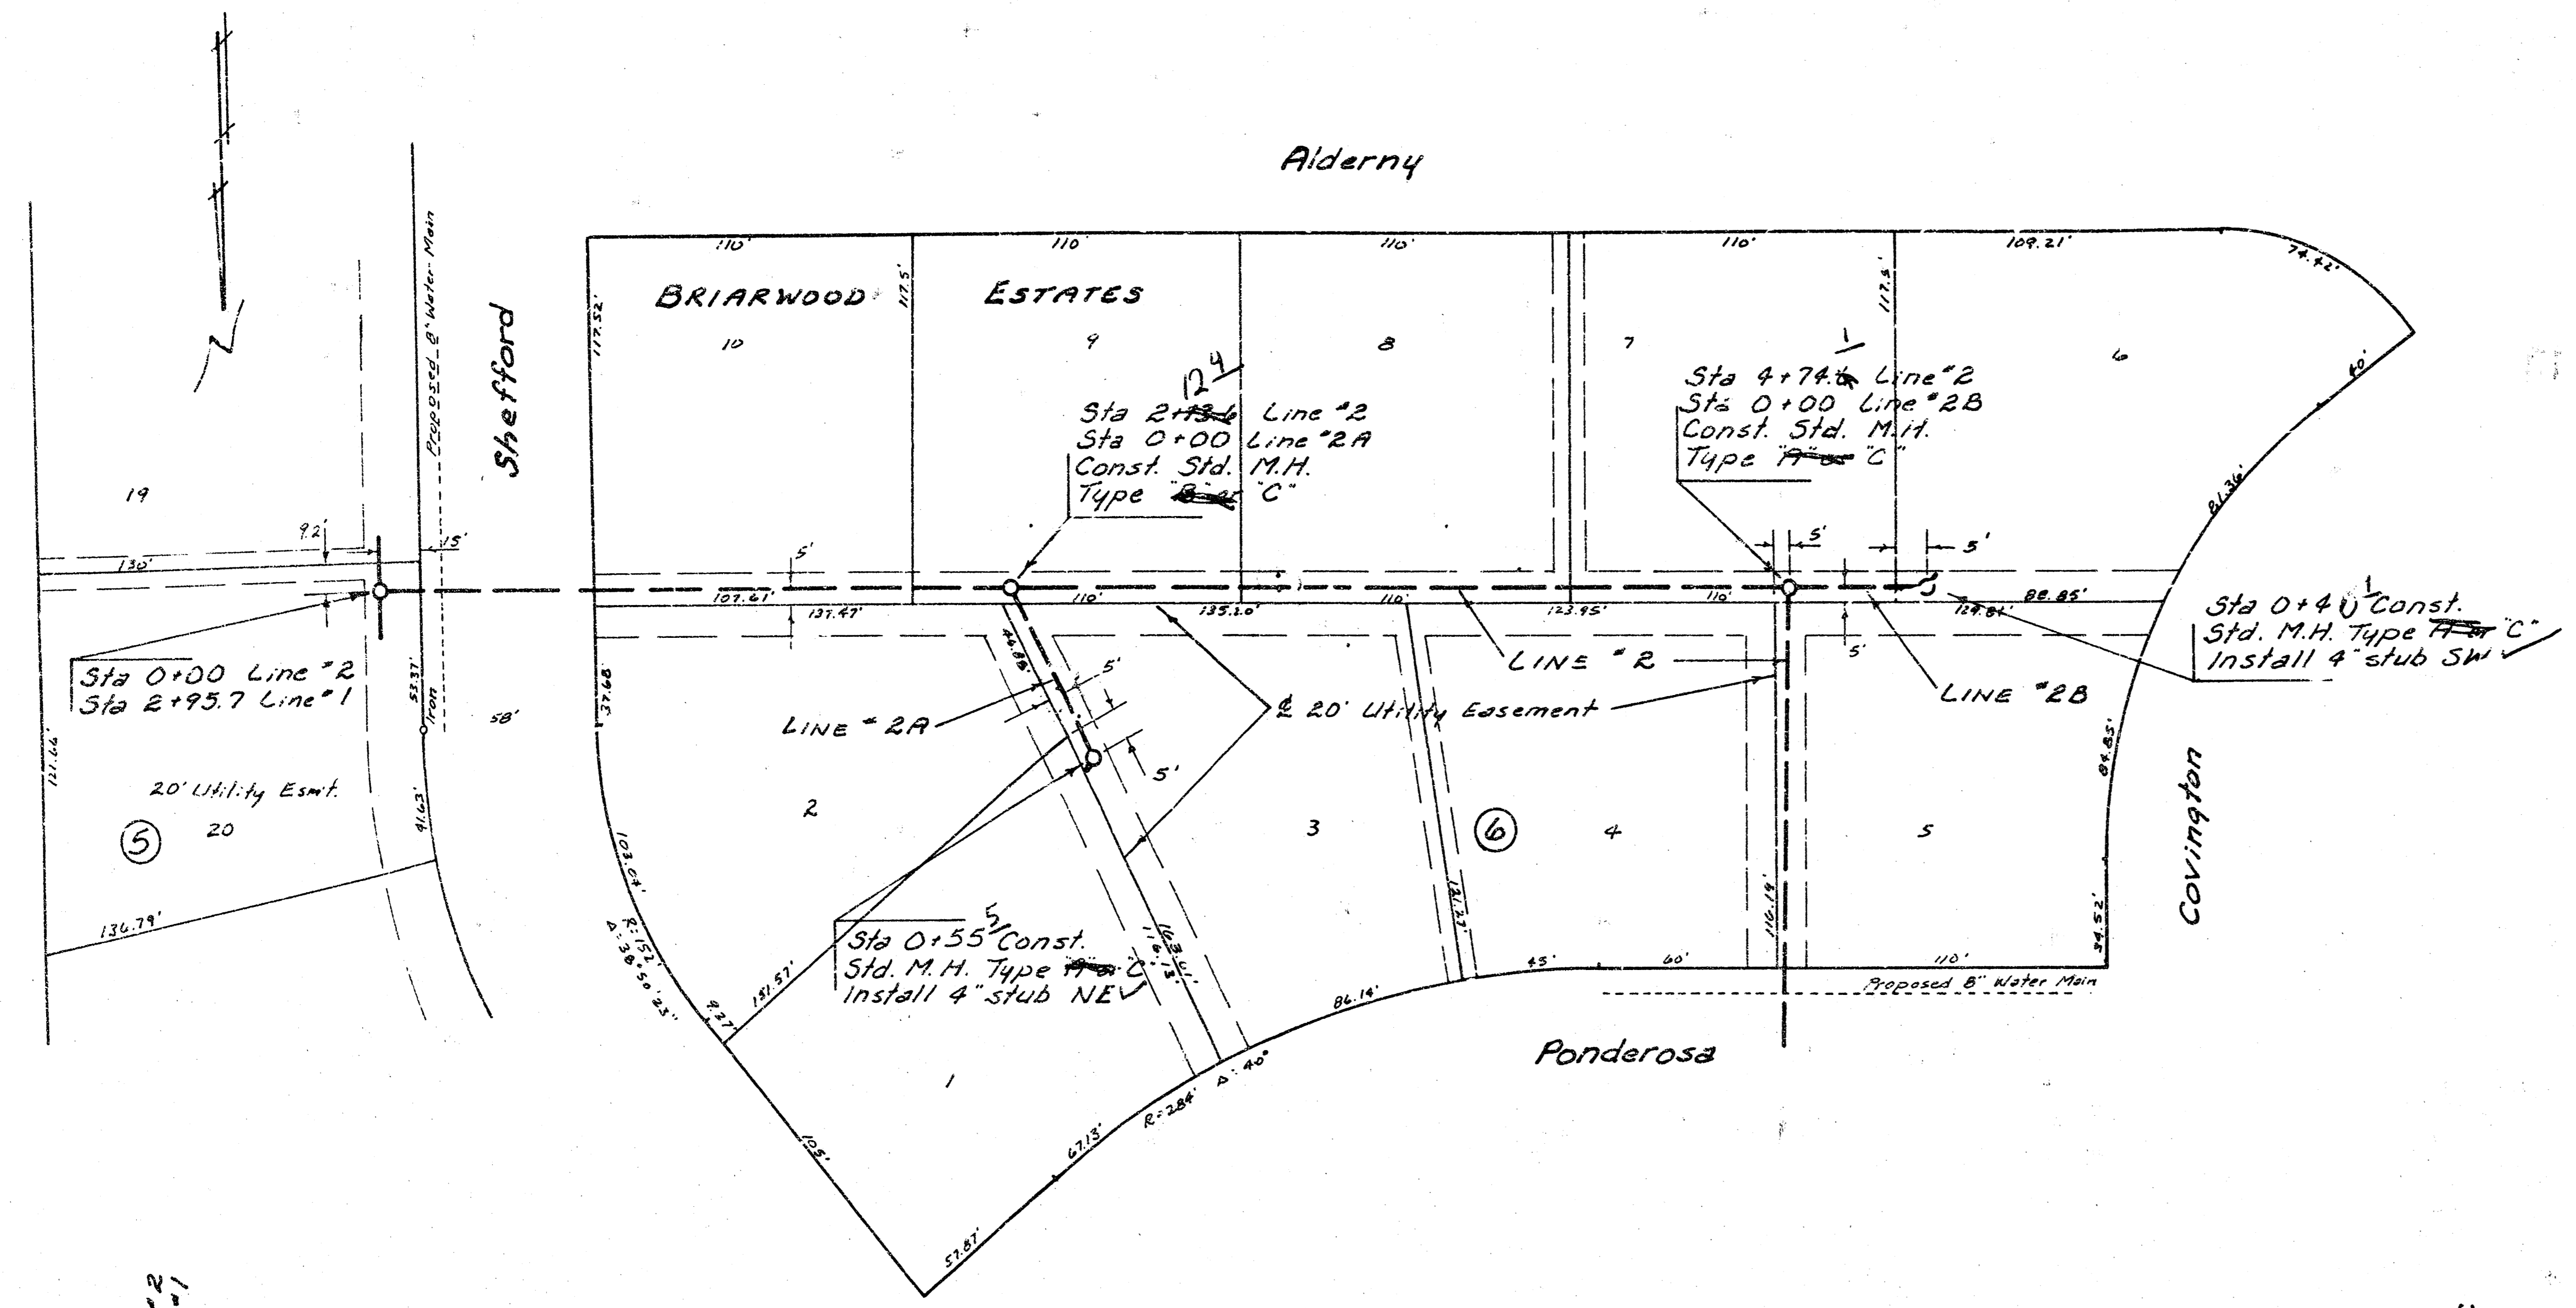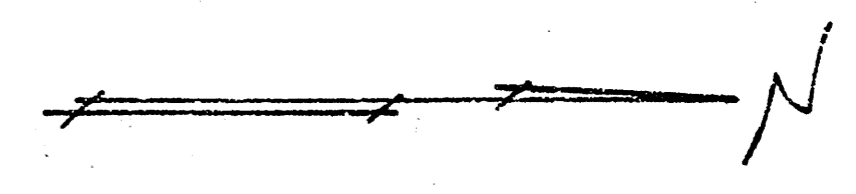


Lot 4, Main 12, SW1
 #68-76-295-80954-000-000-001

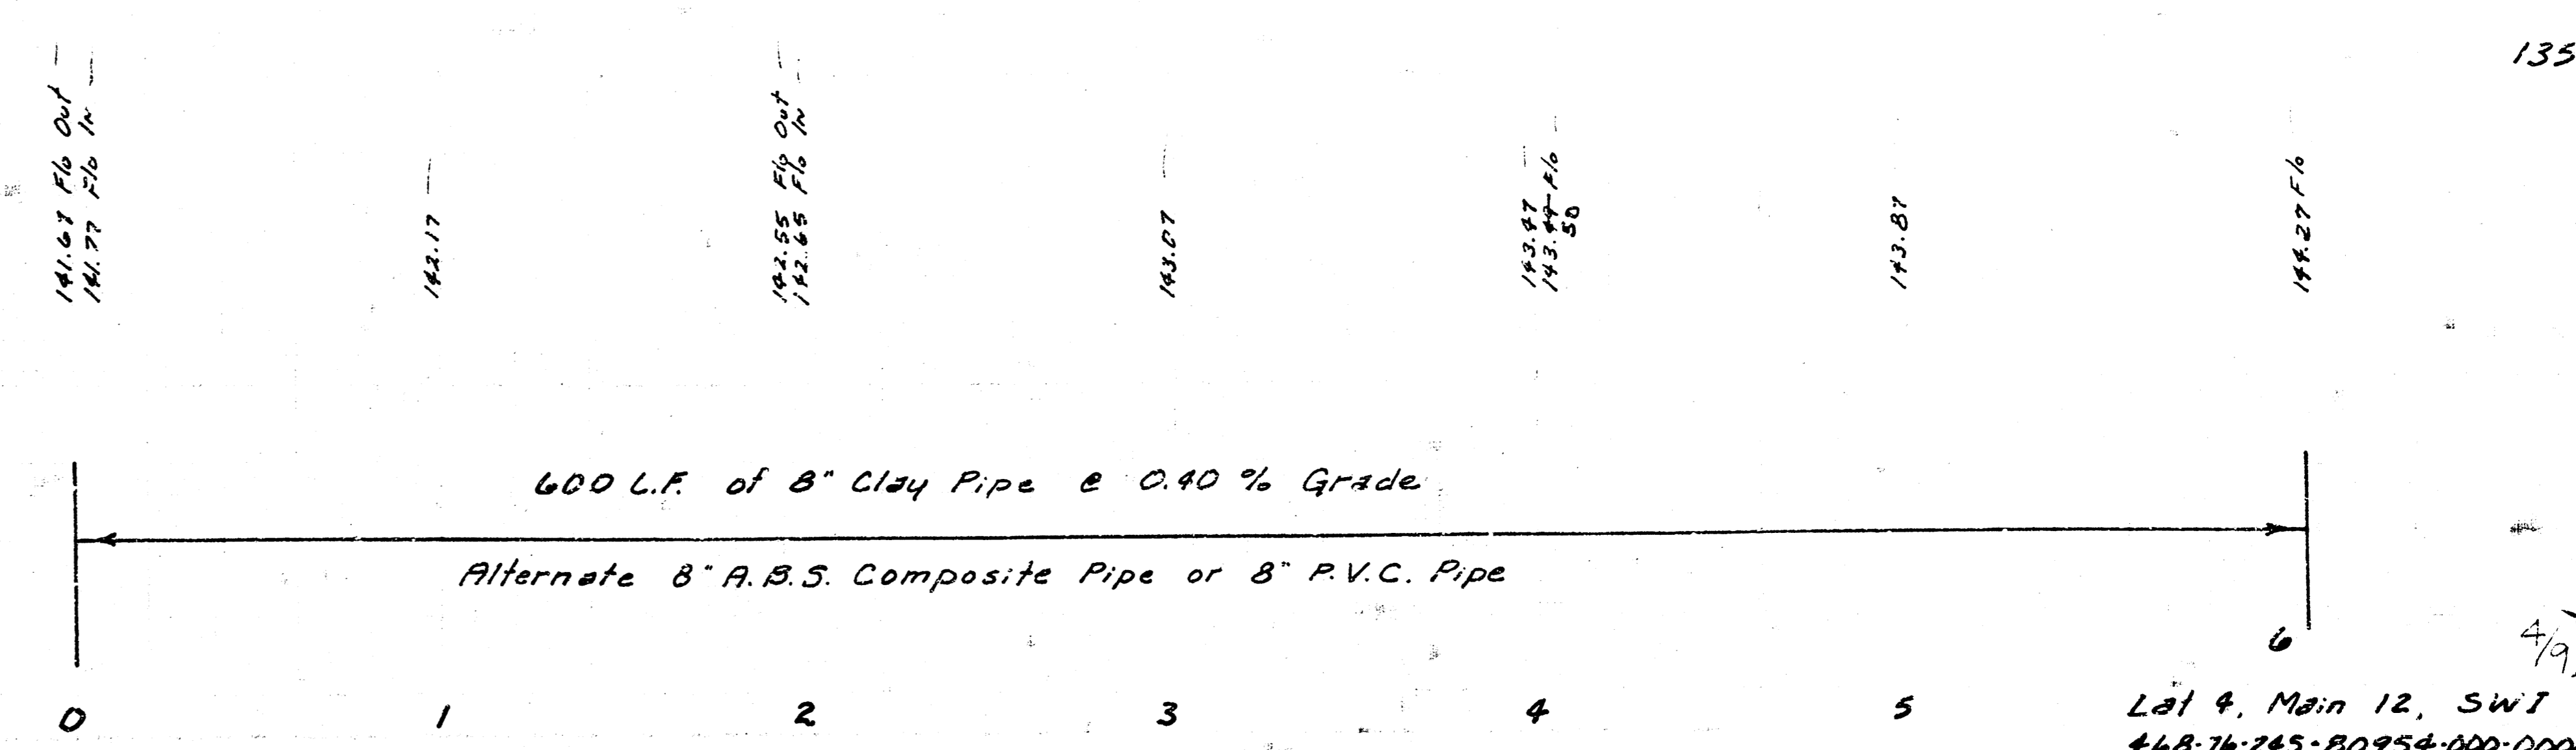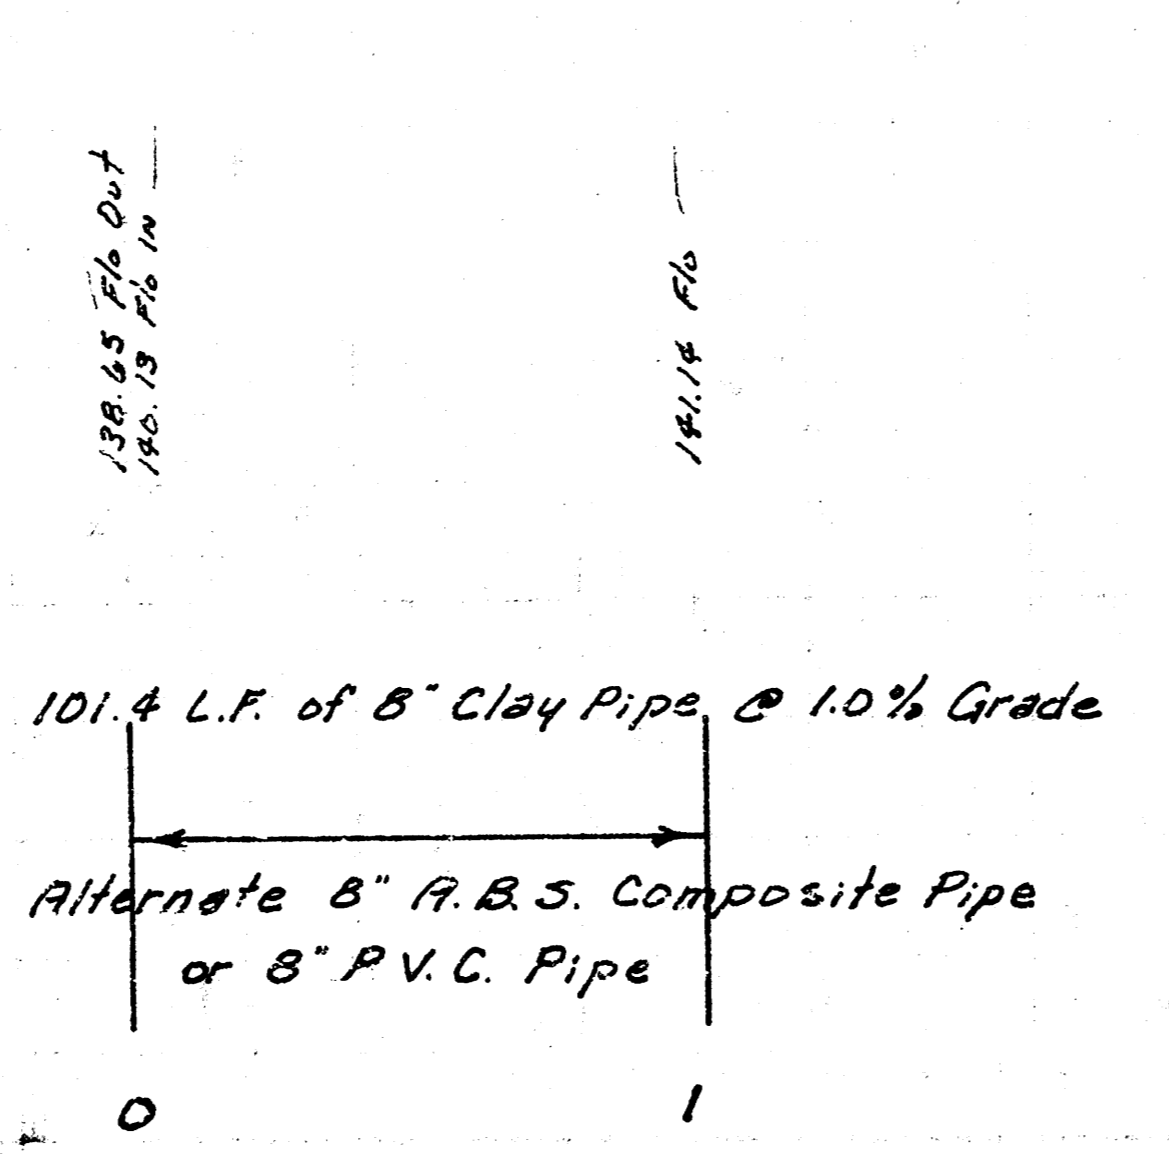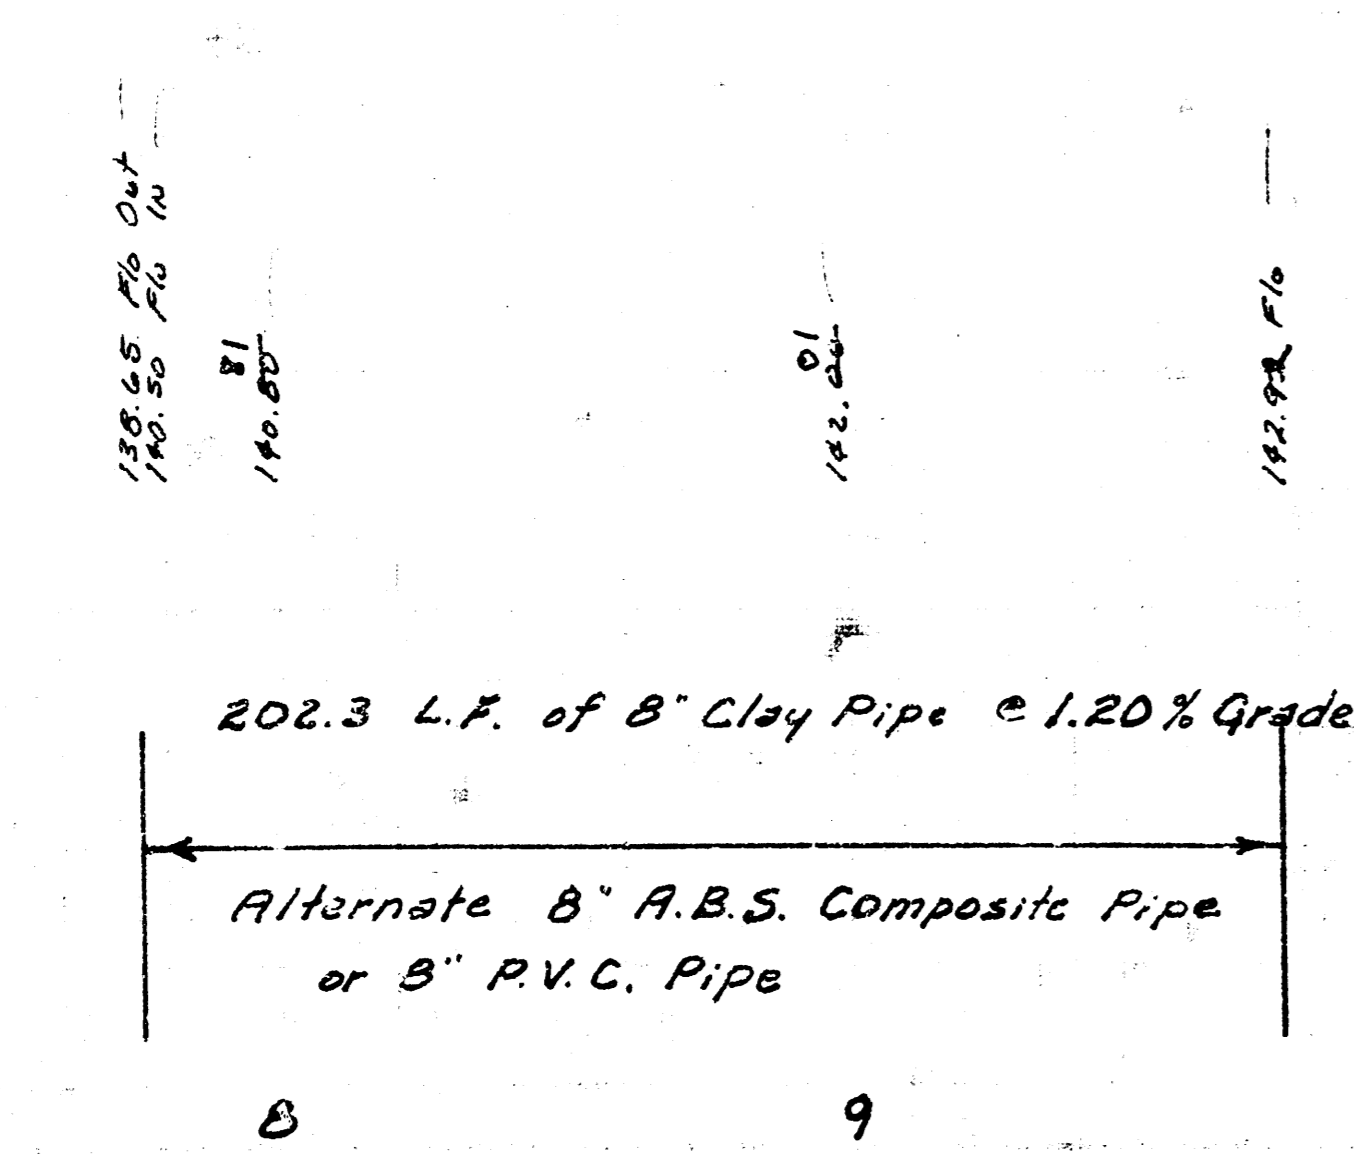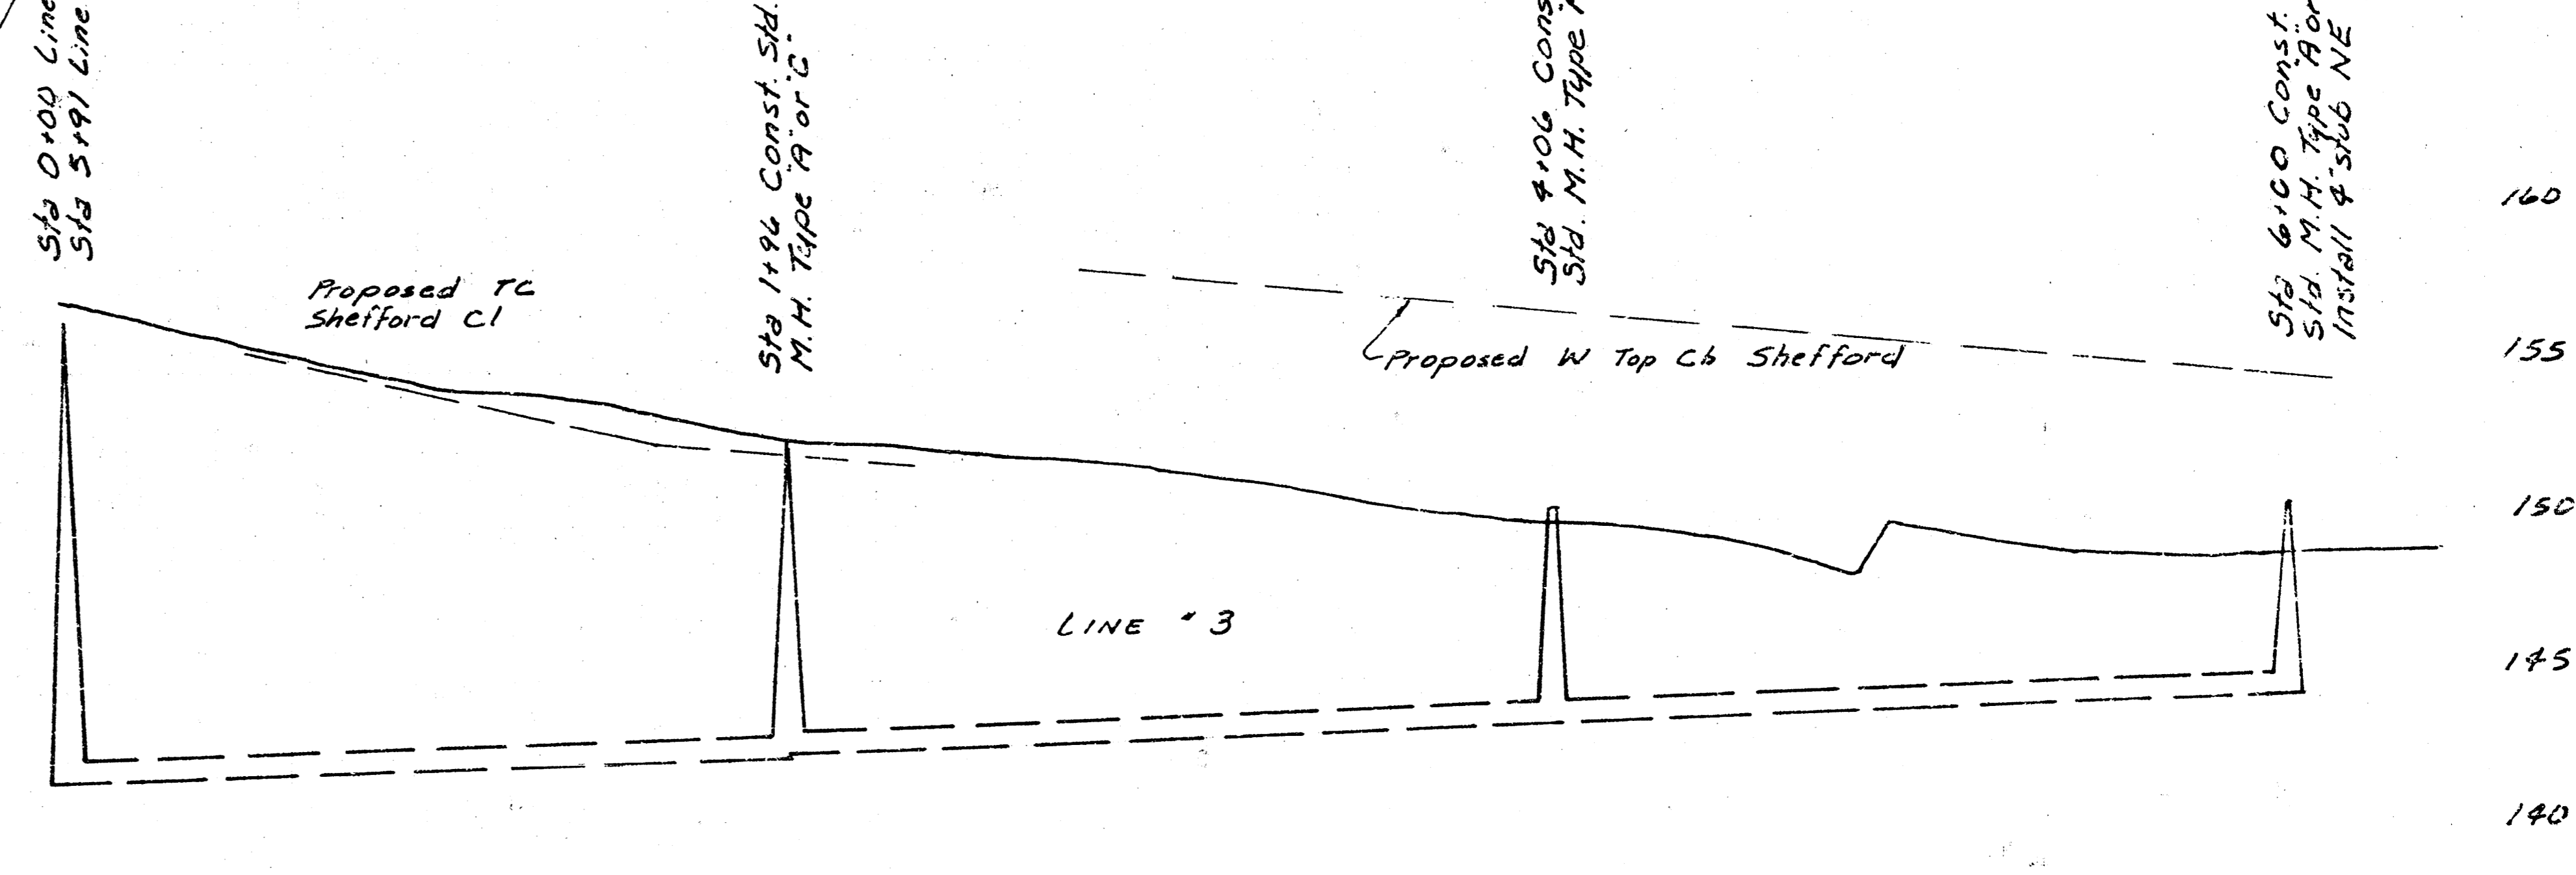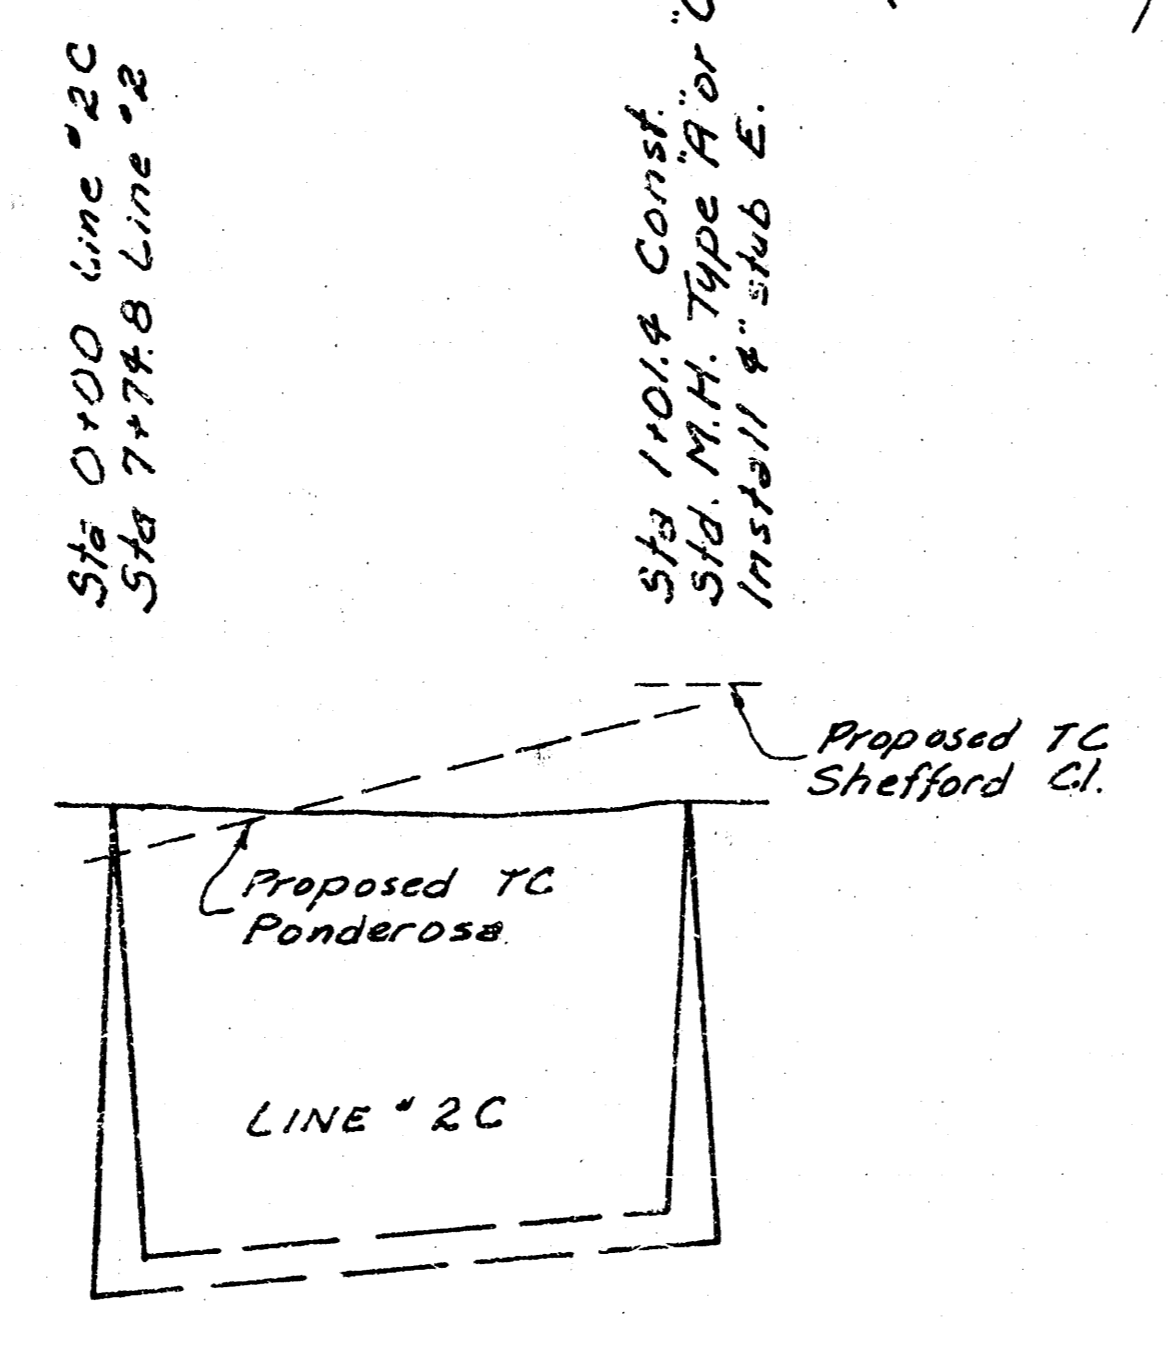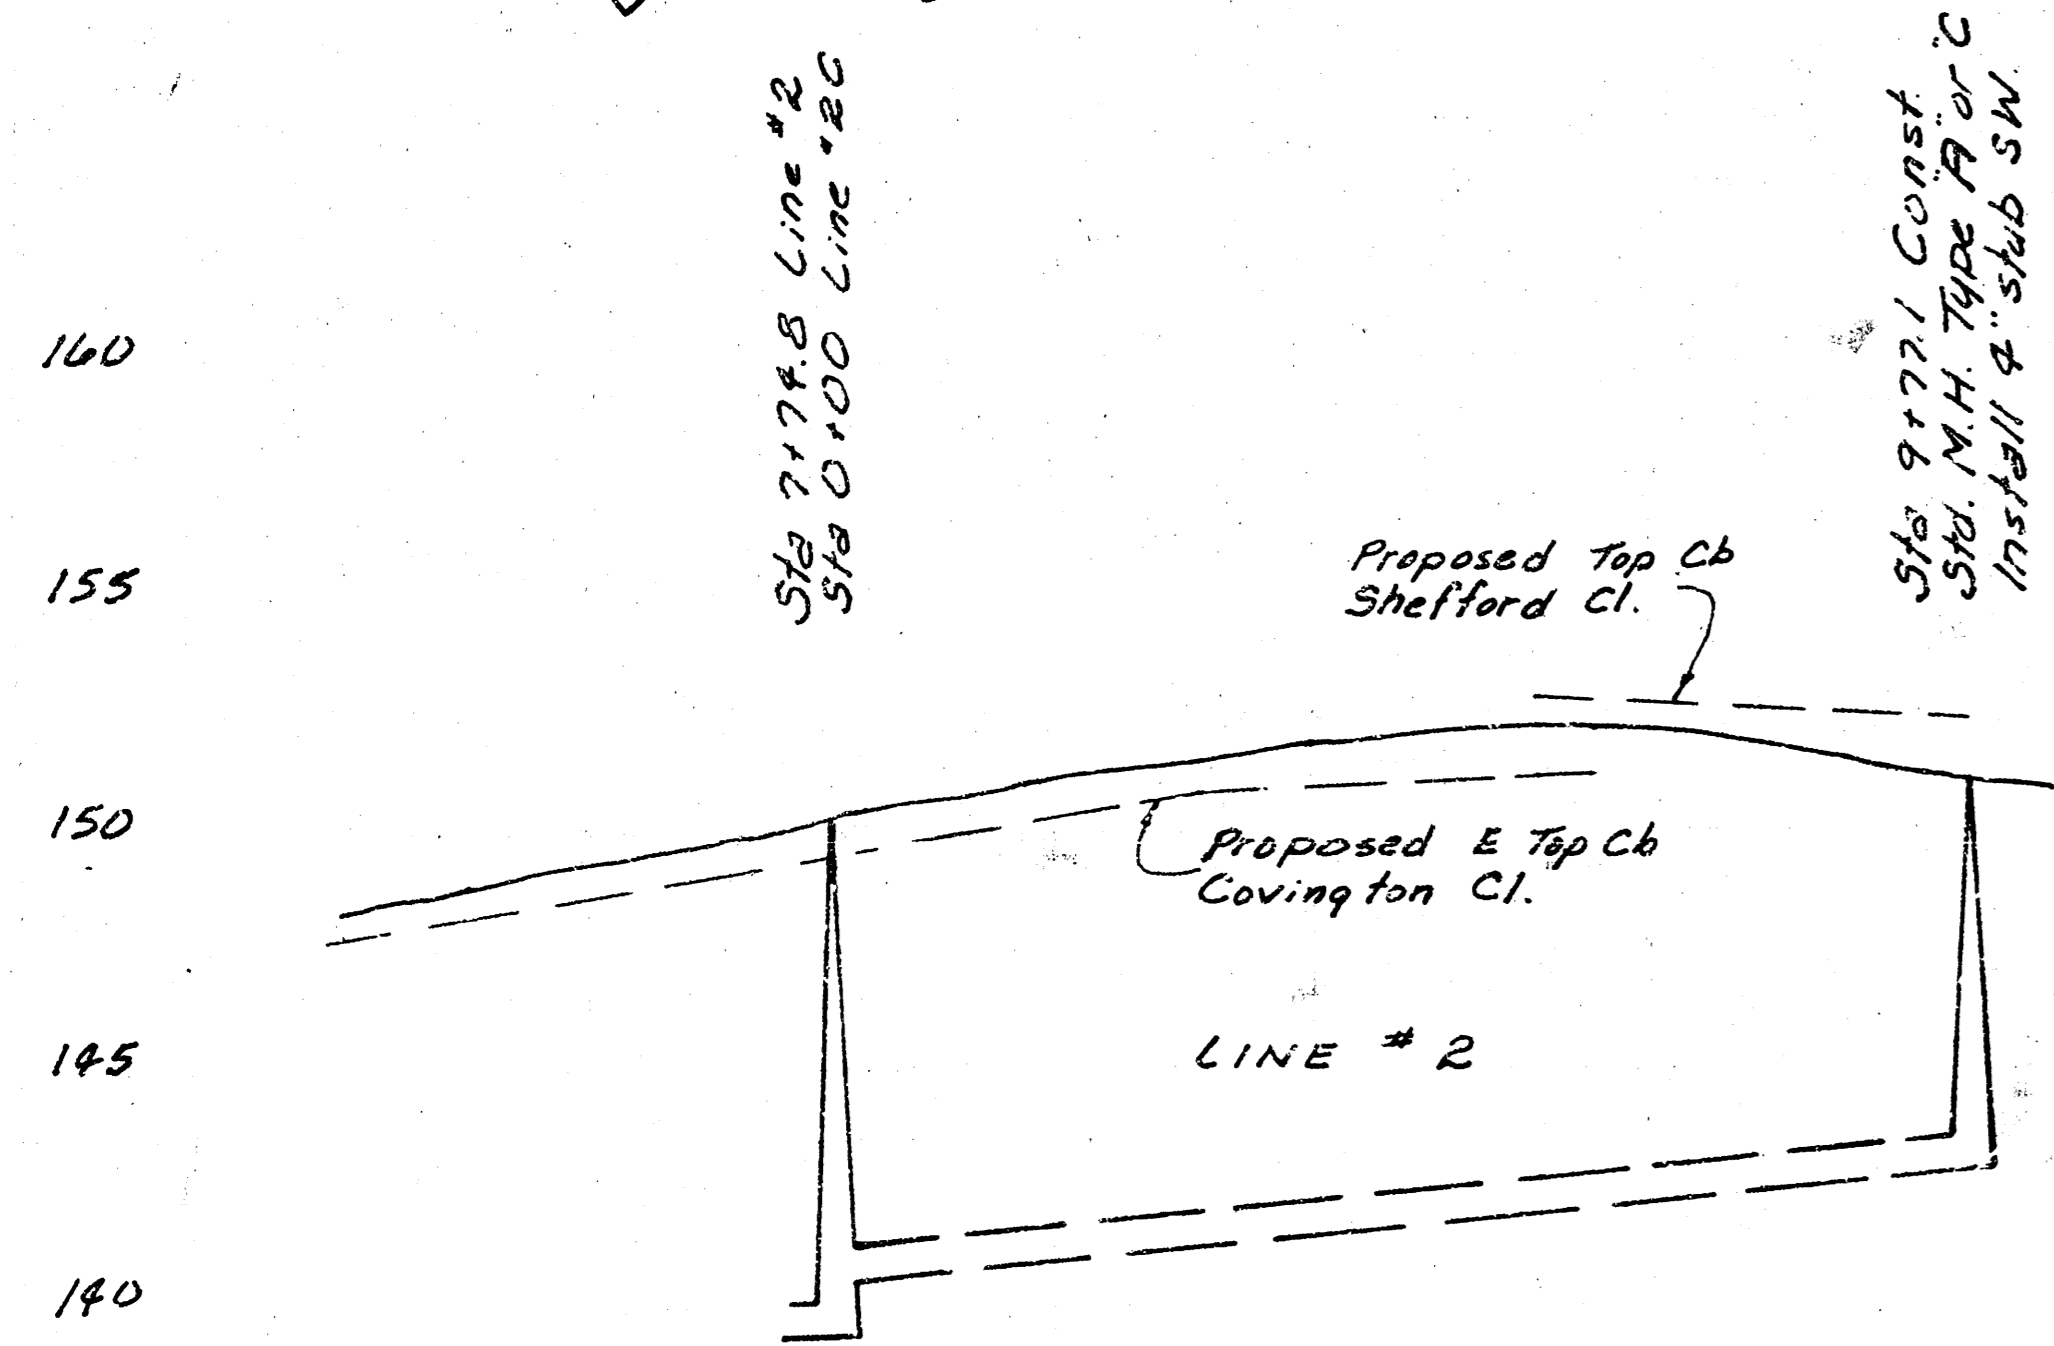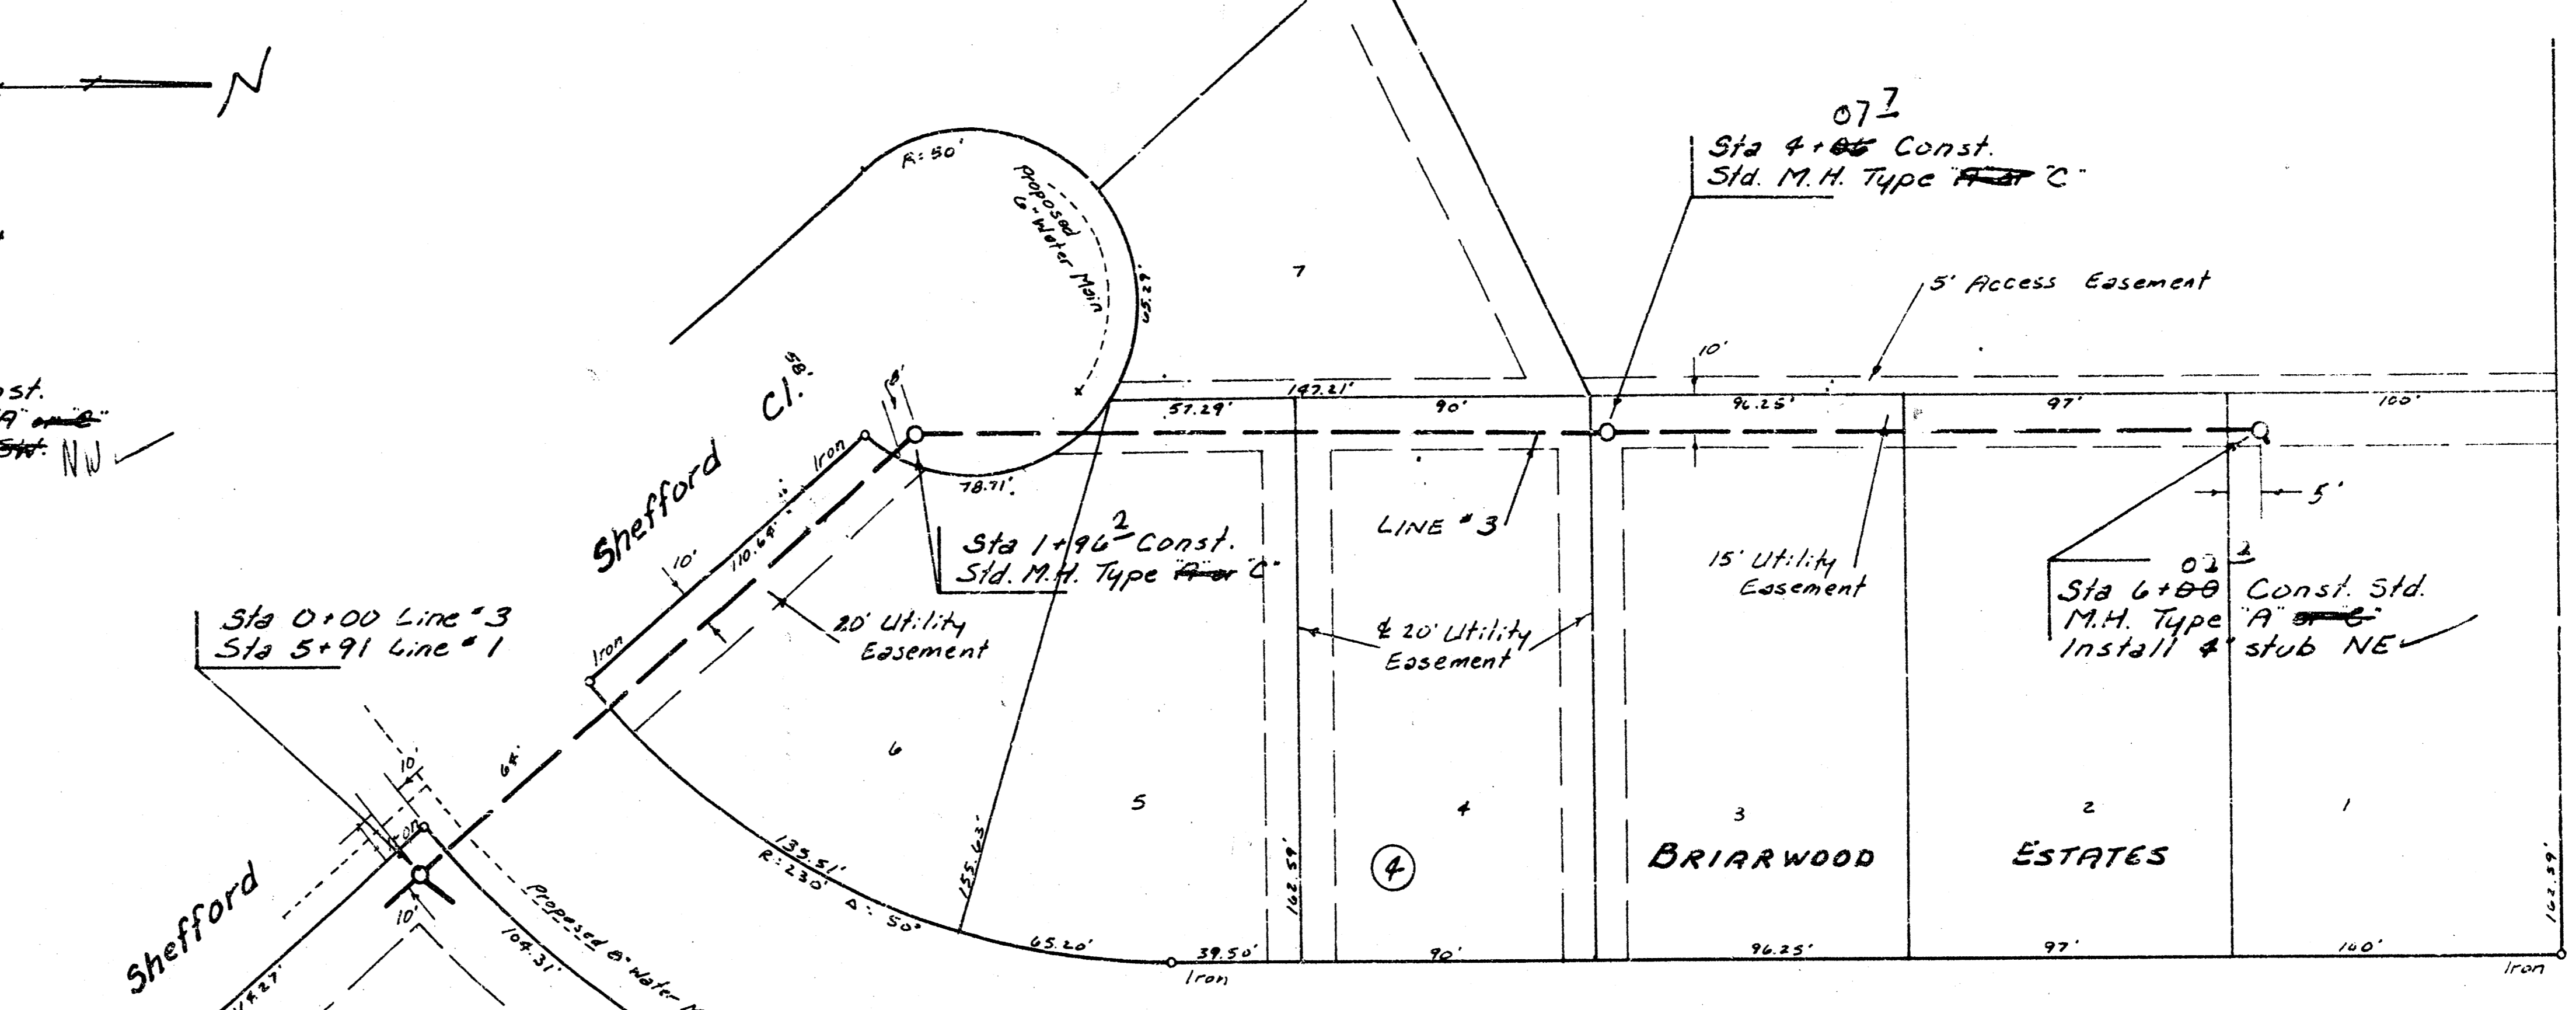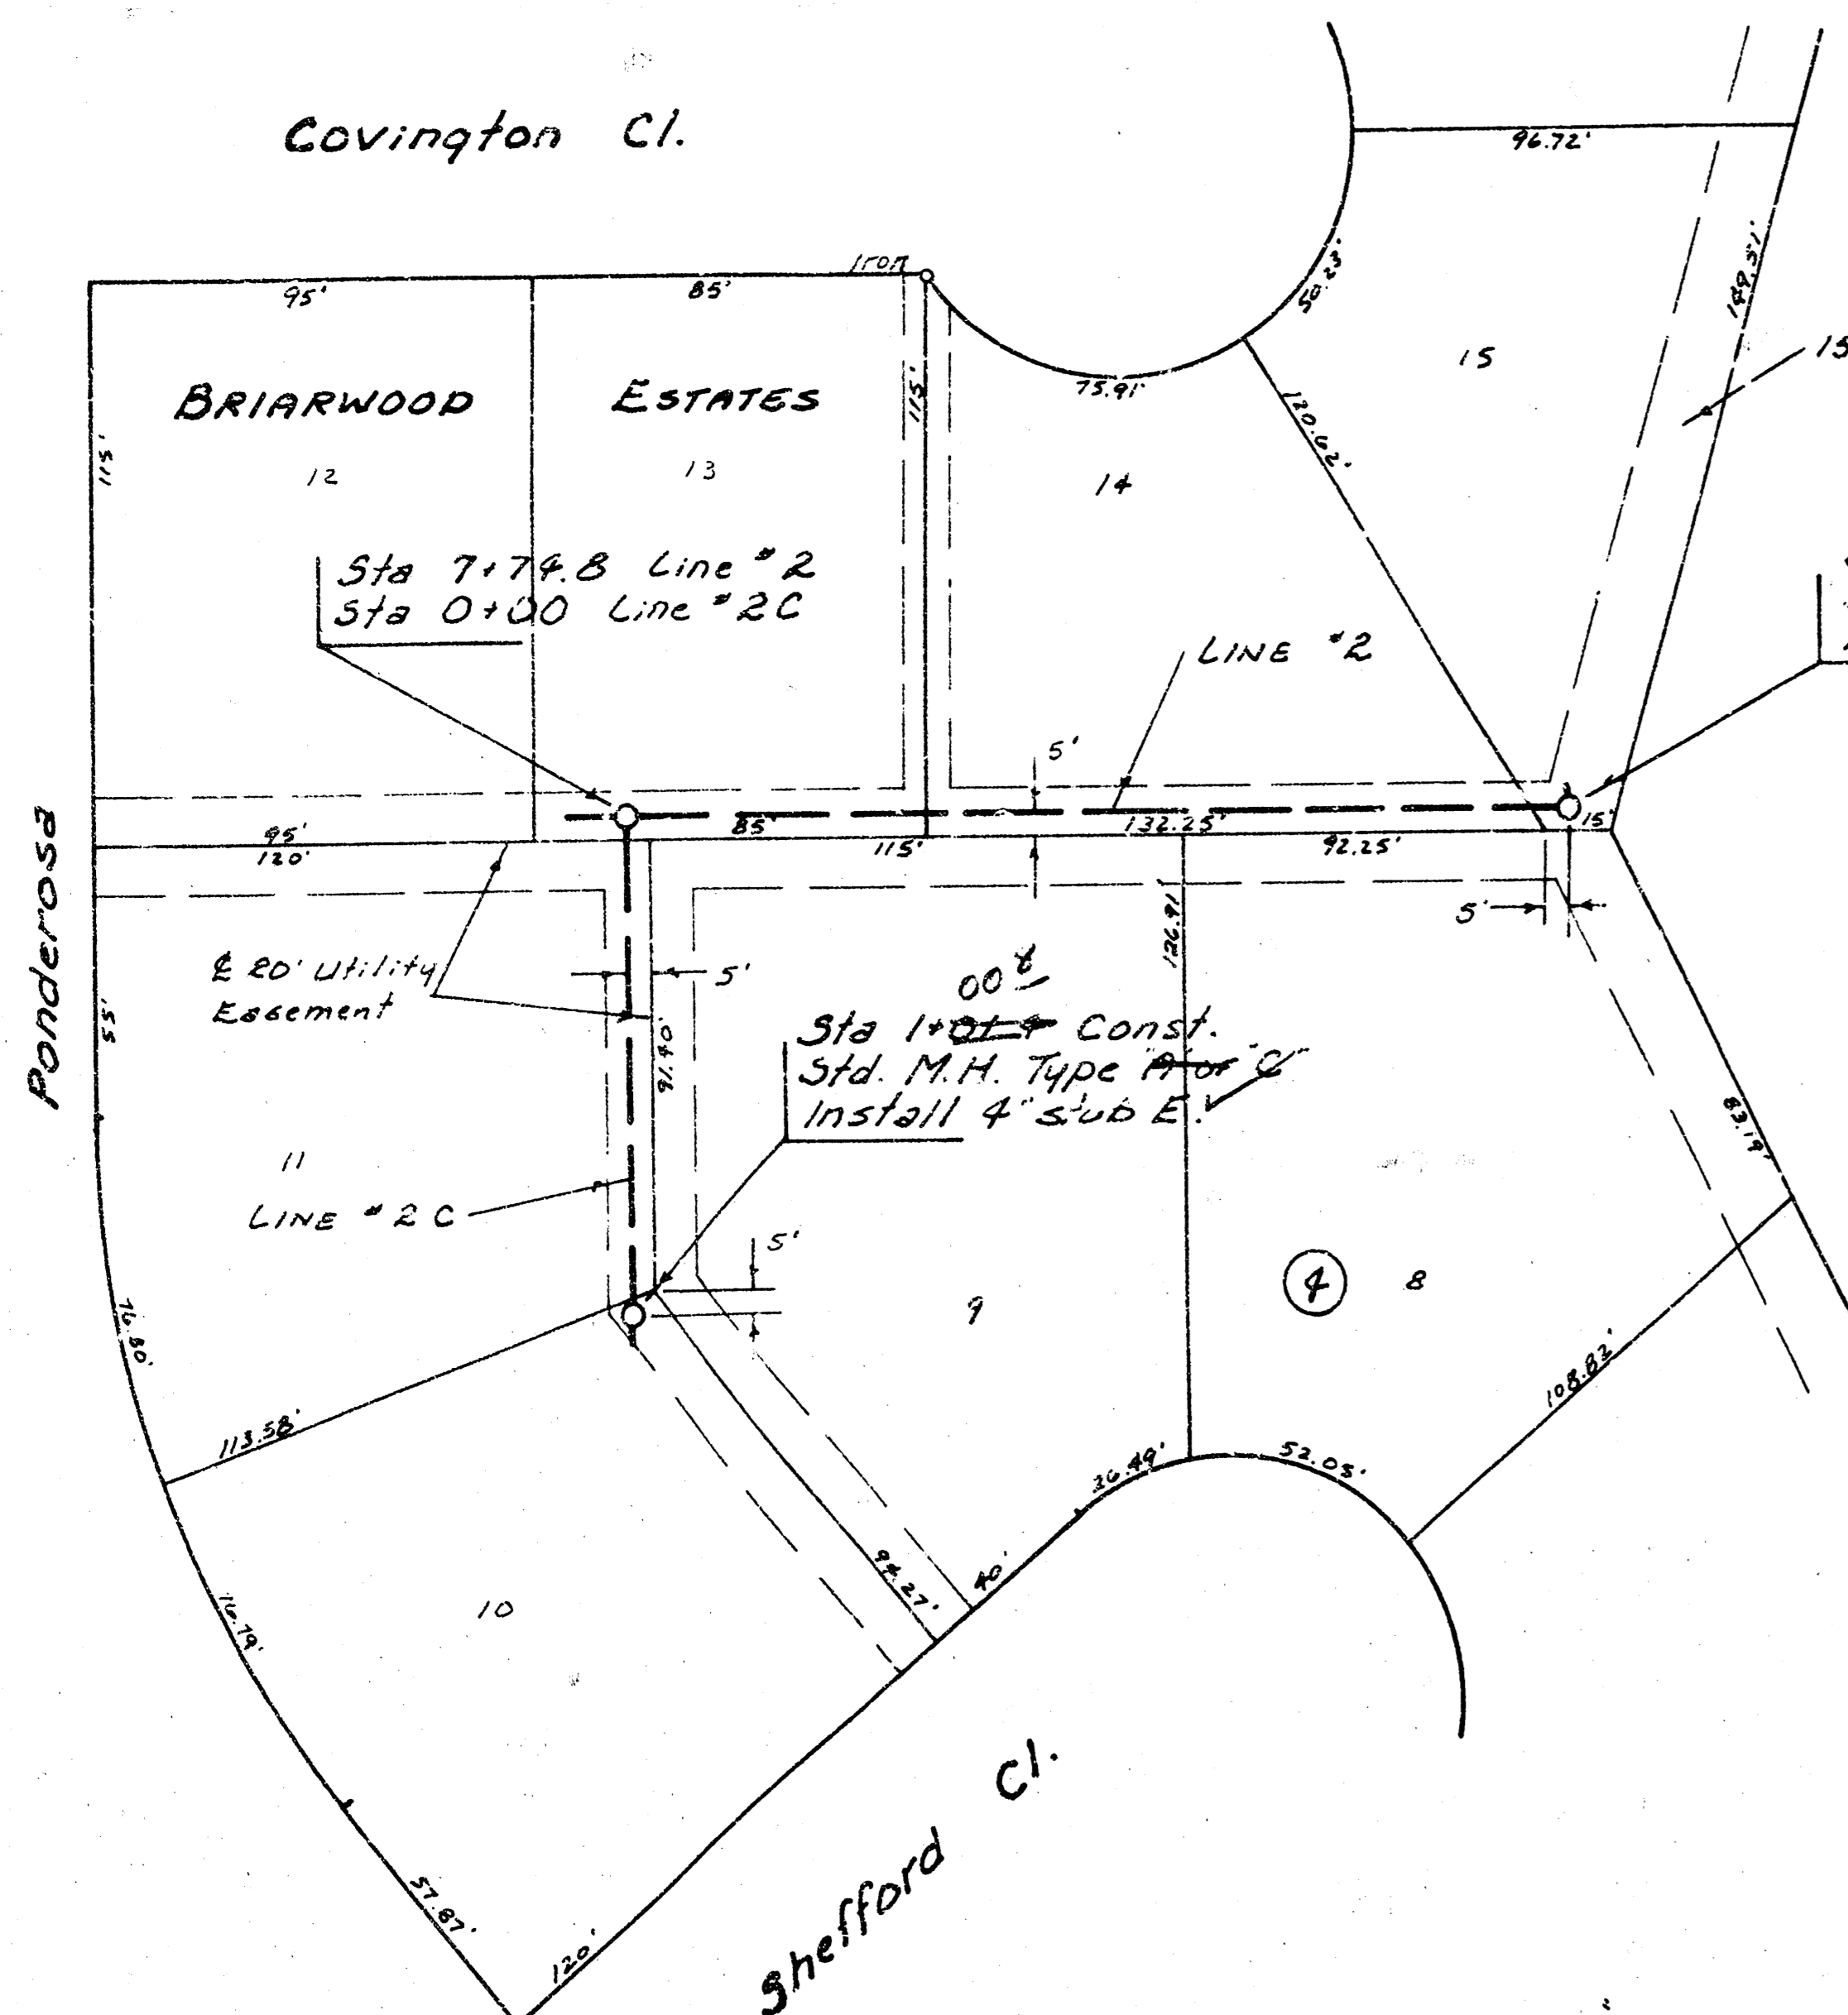

Scale Plan 1" = 40'
Profile 1" = 40' Horiz.
1" = 5' Vert.


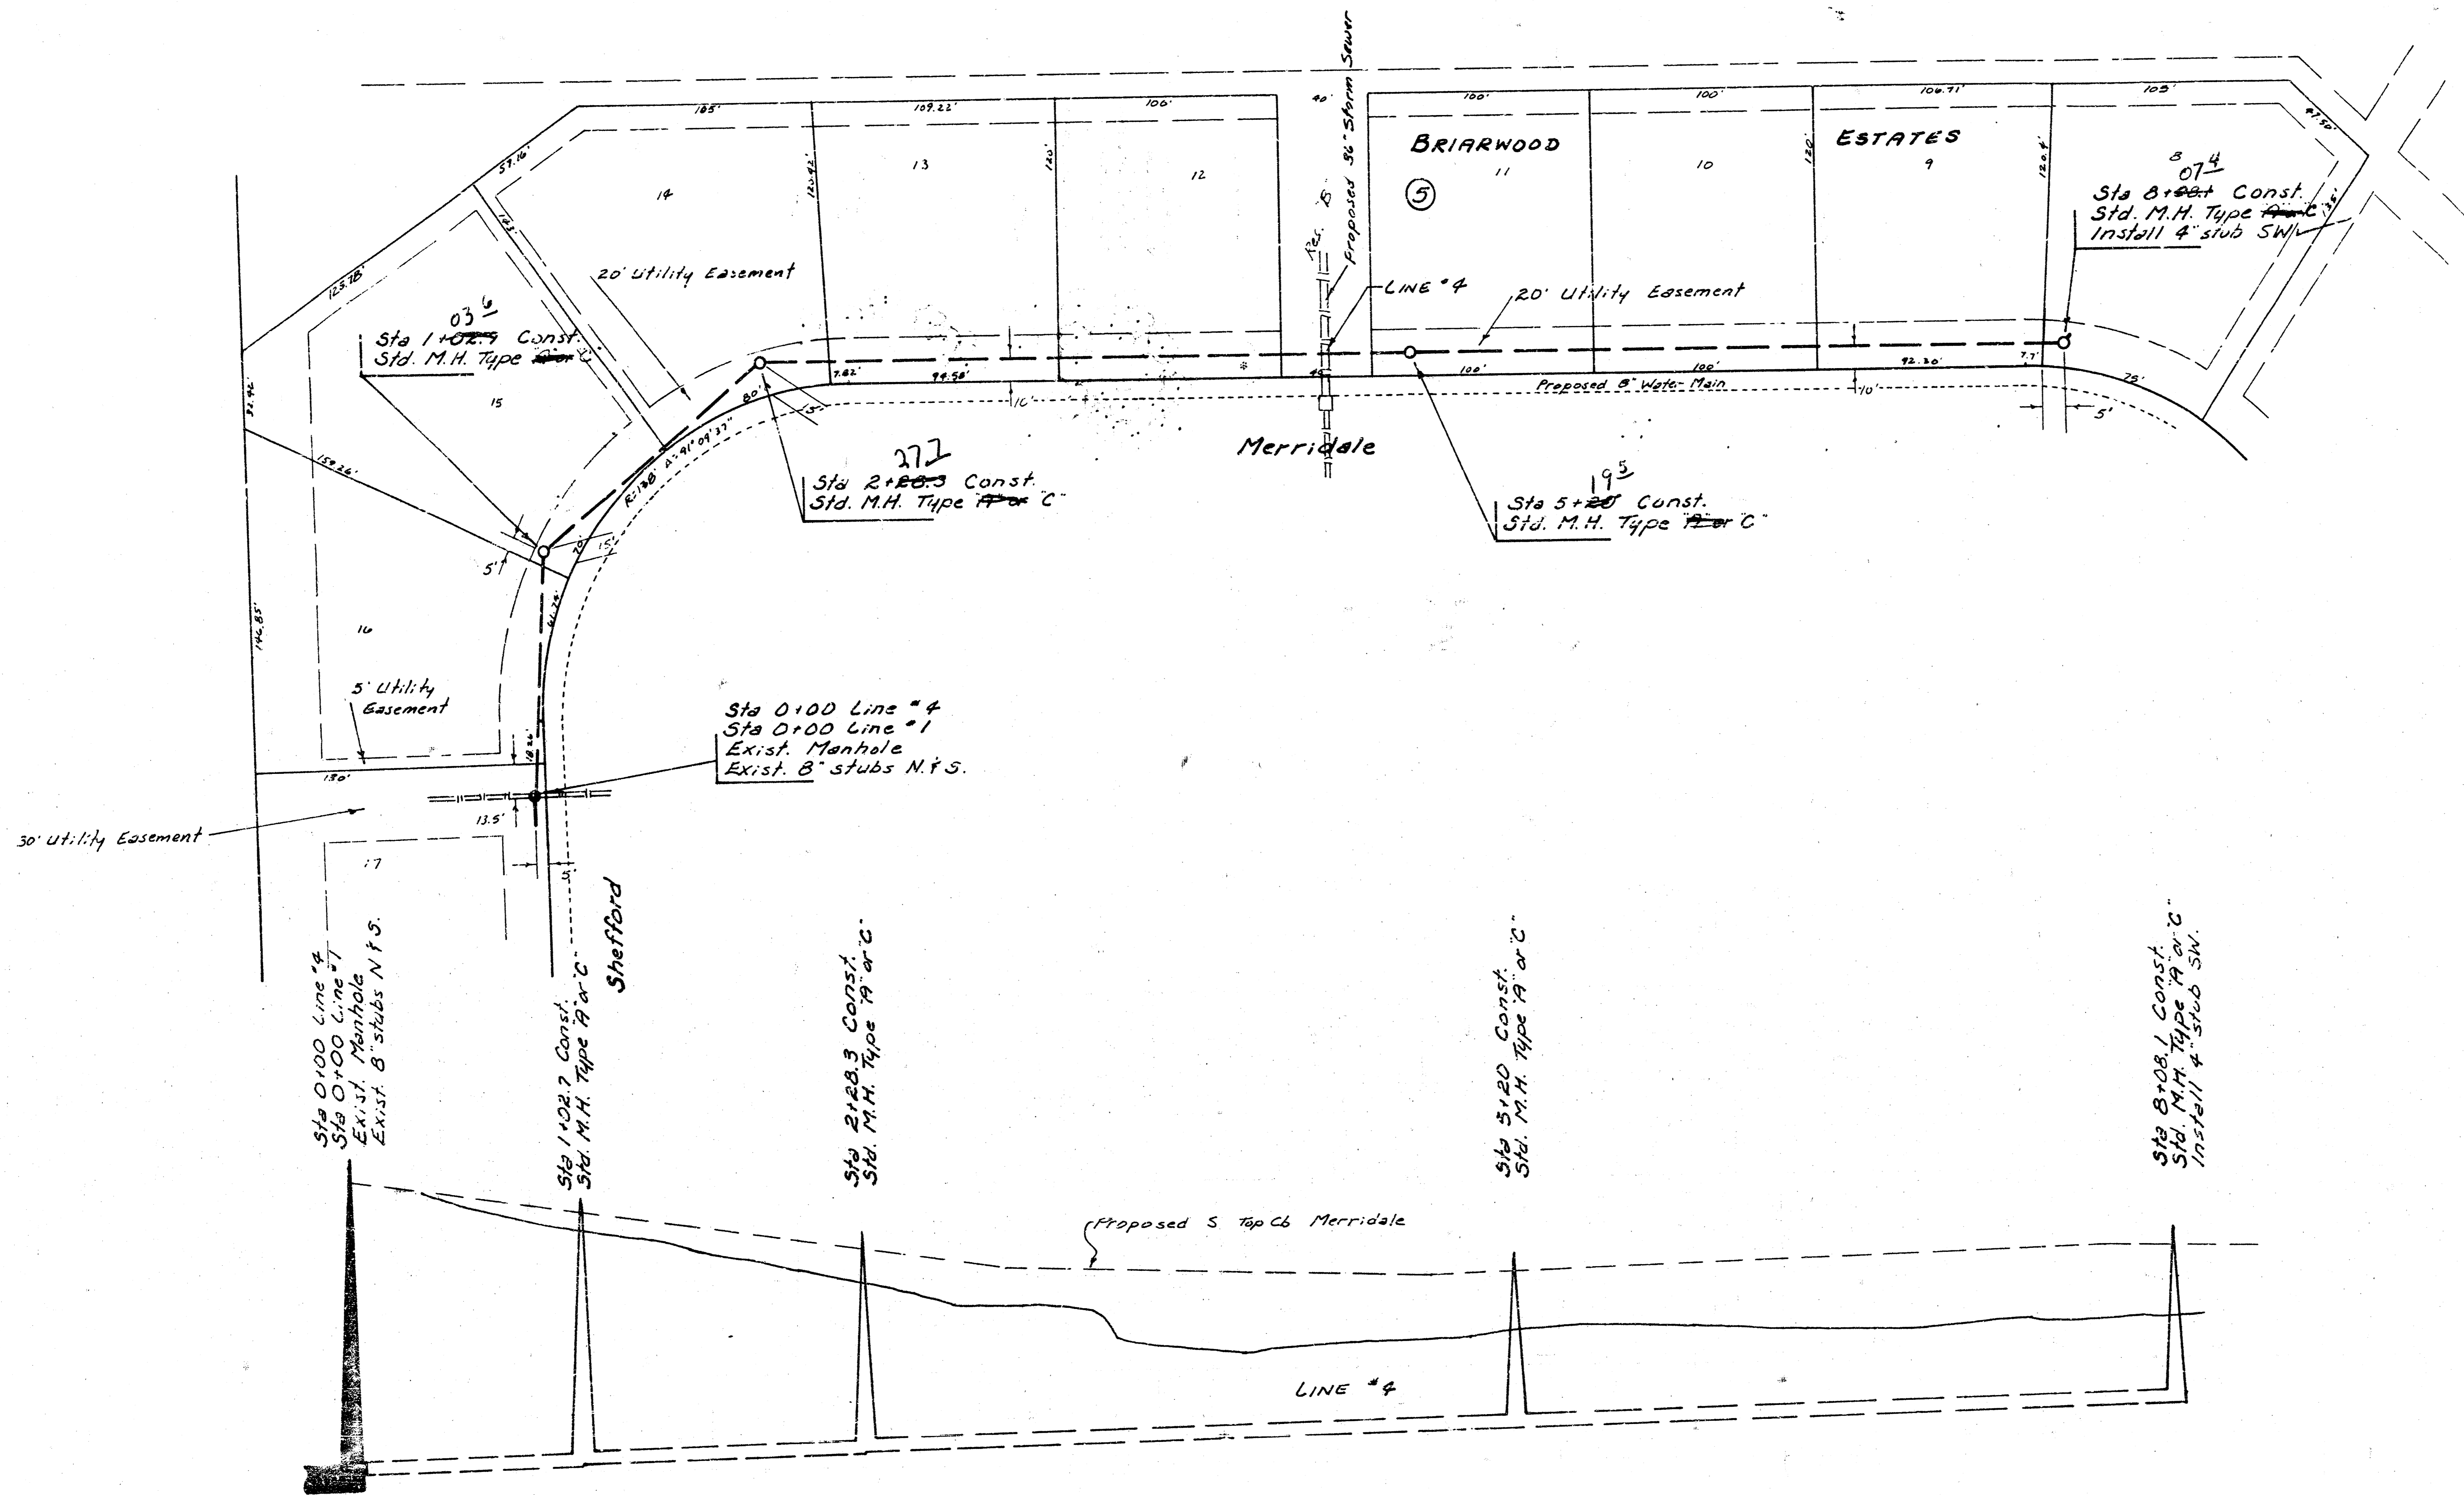


Scale Plan 1"=40'
 Profile 1"=40' Horiz.
 1"=5' Vert.



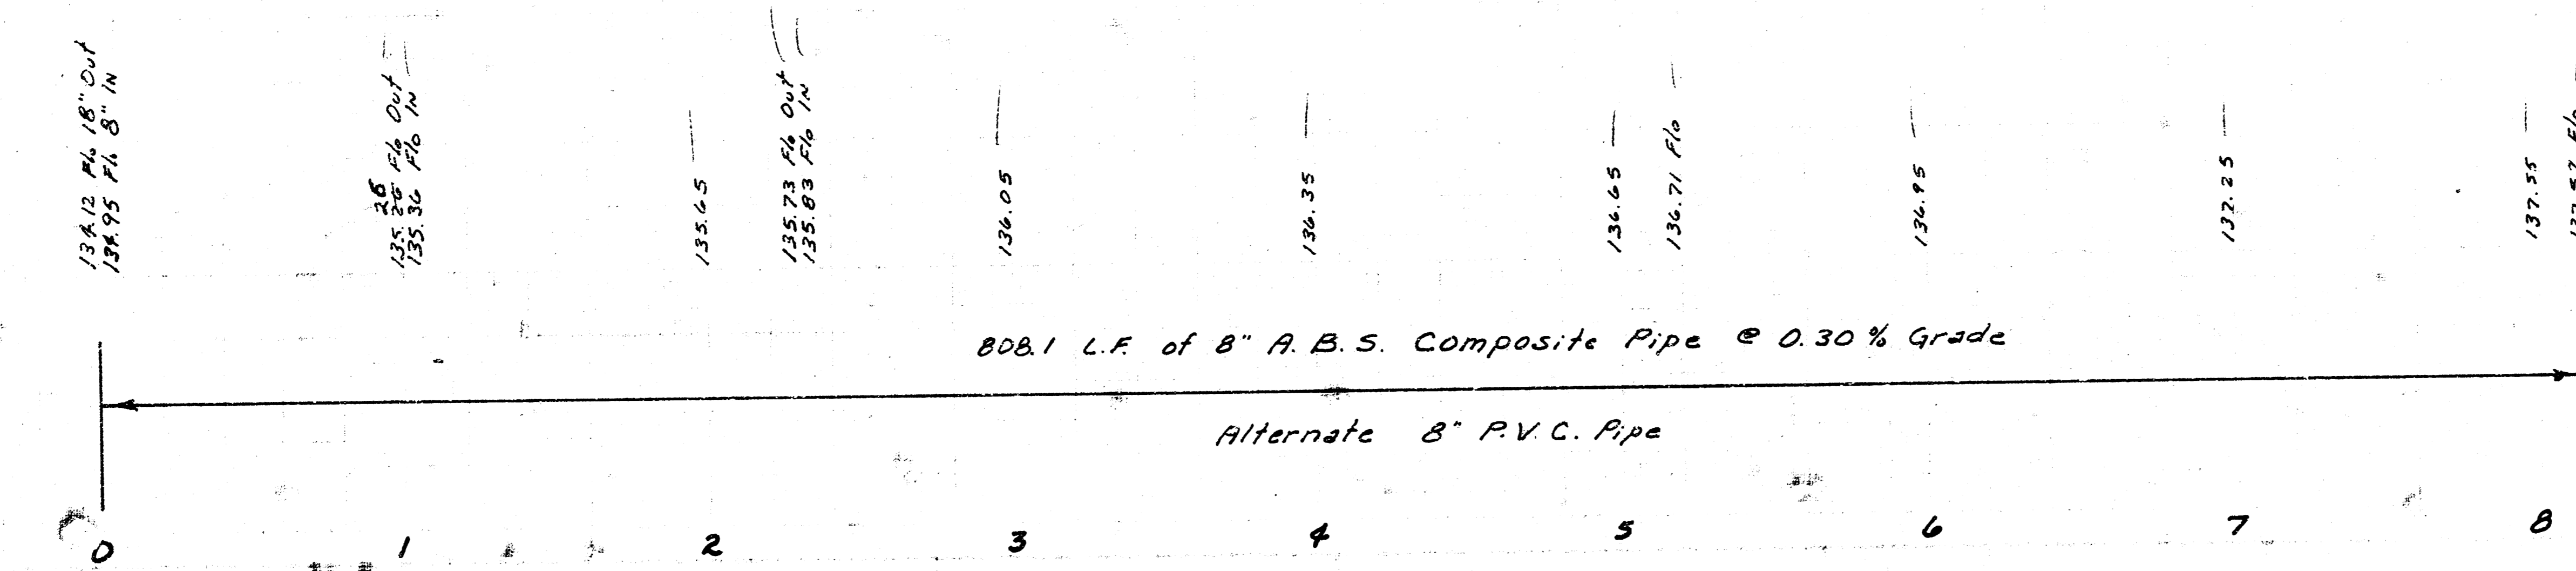


Lat 4, Main 12, SW1
 468-76-245-80954-000-000-001

FILMED FROM THE BEST

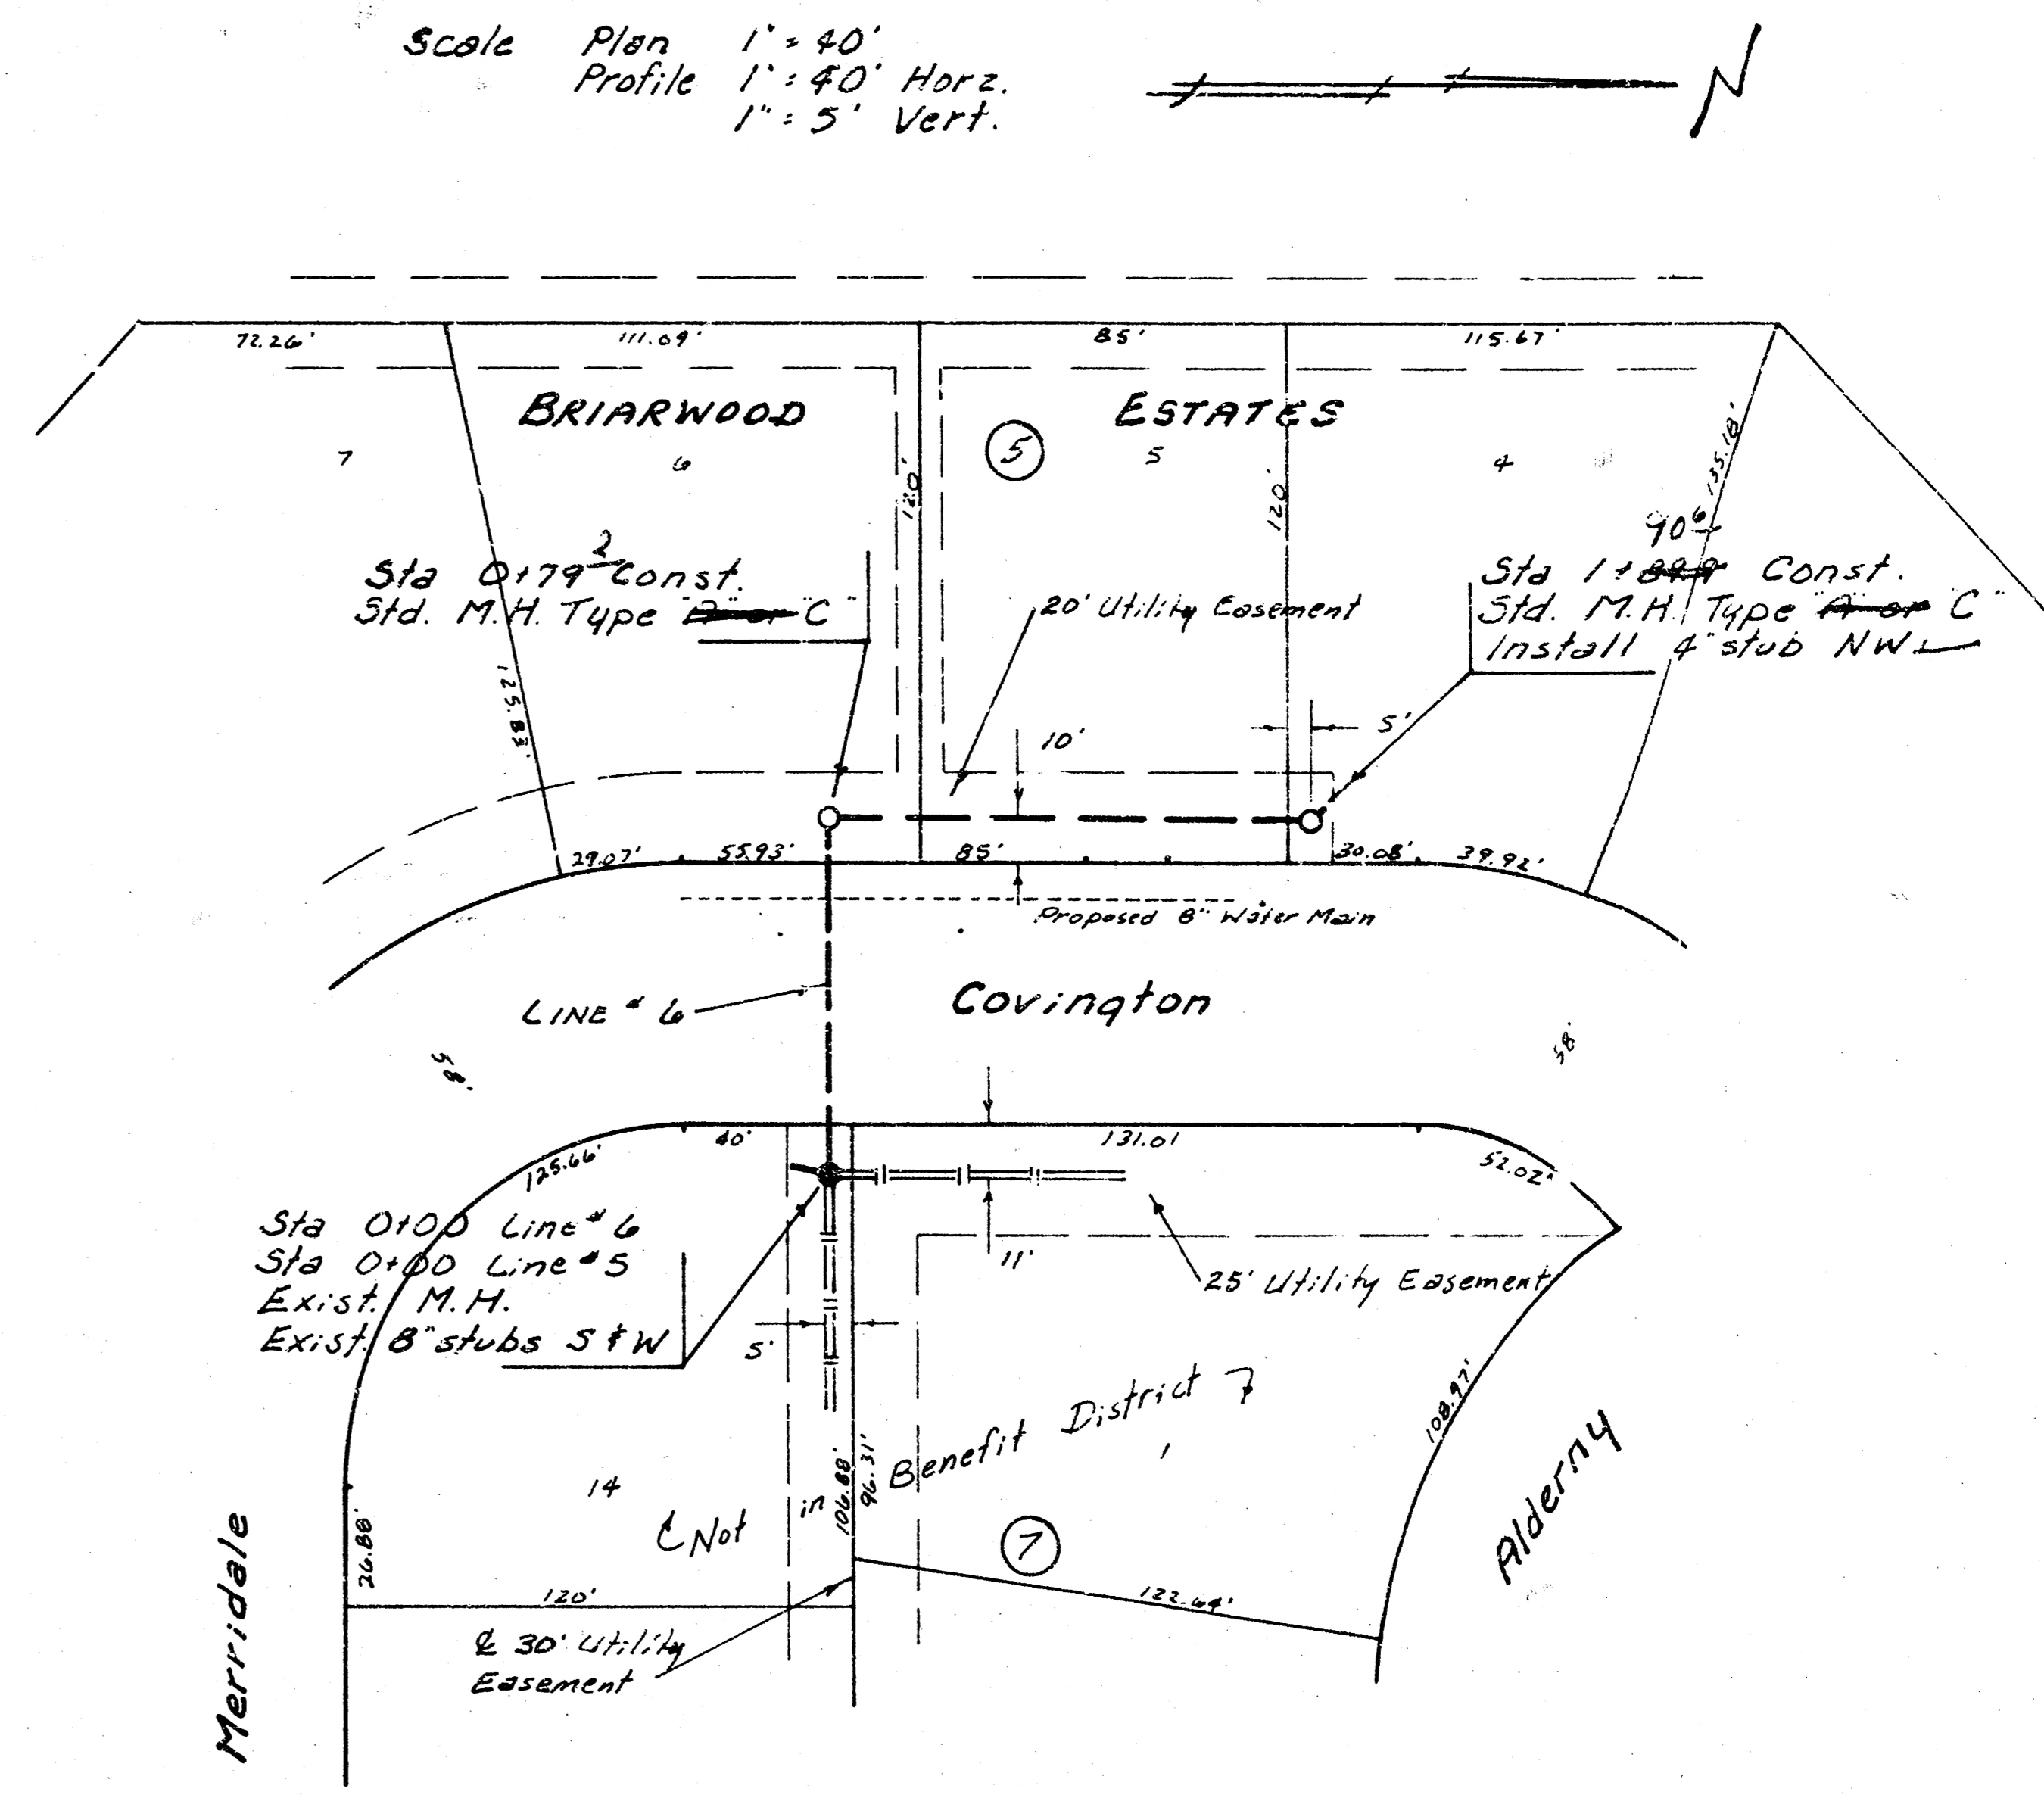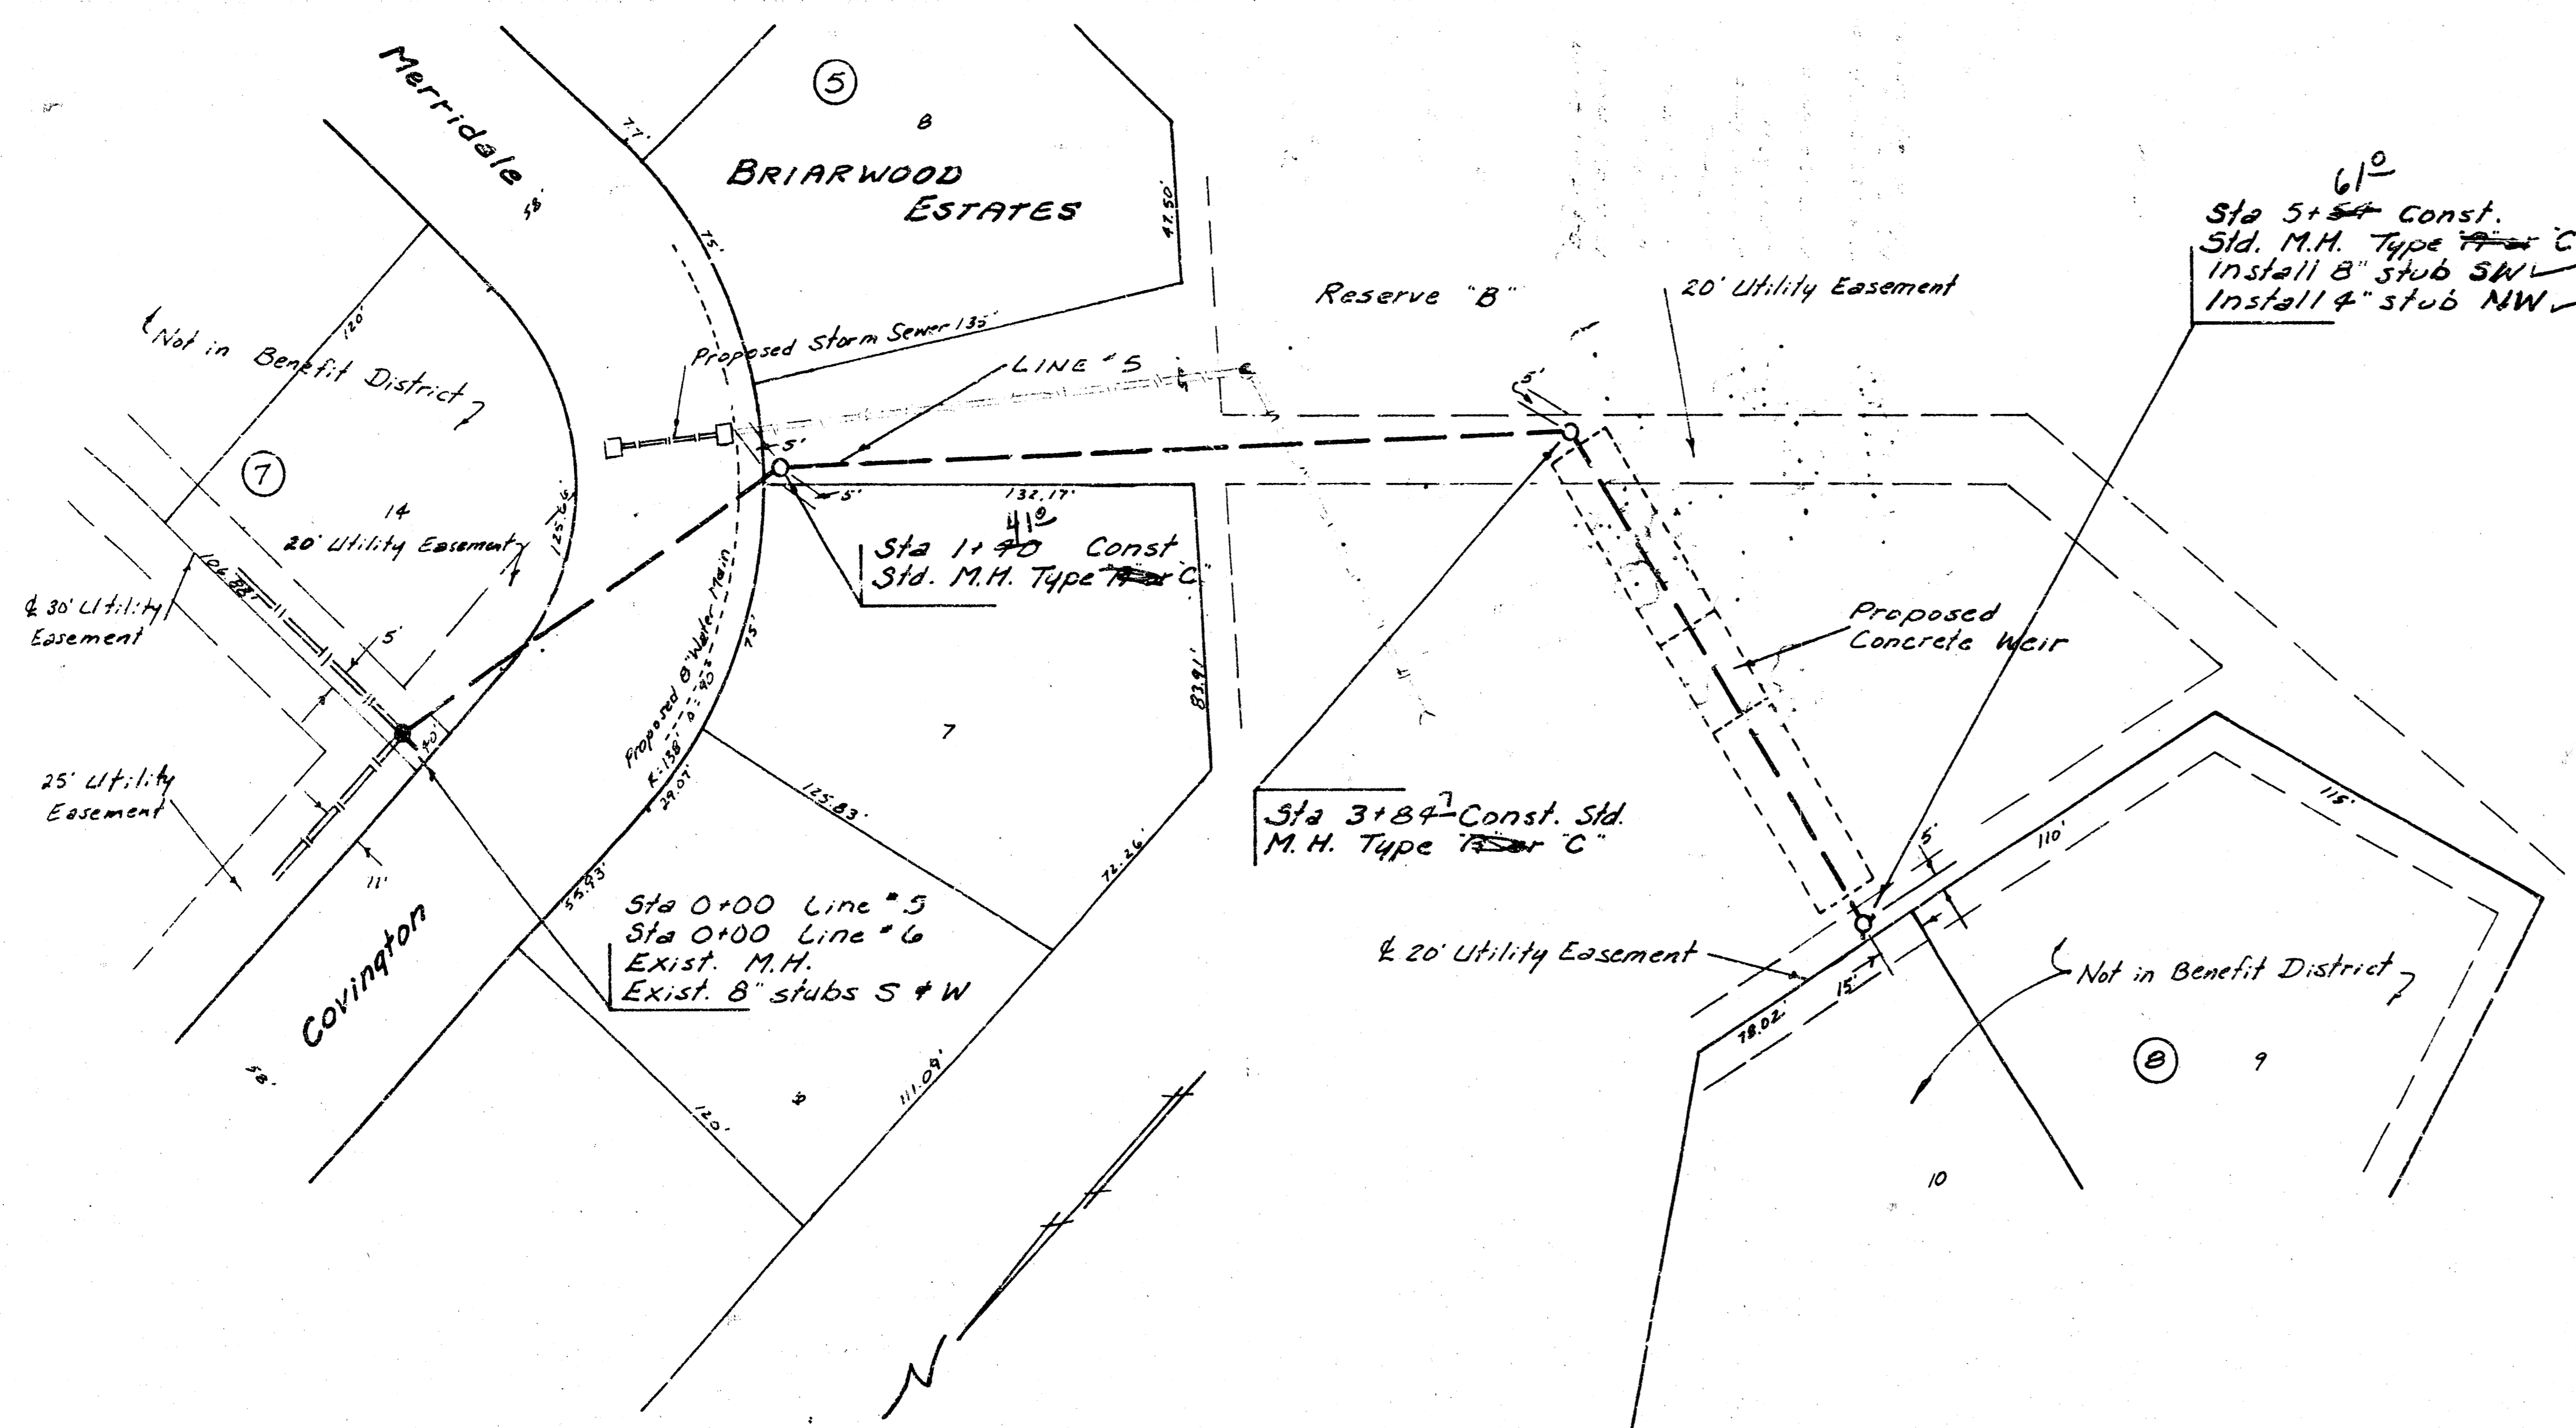


Scale Plan 1" = 40'
 Profile 1" = 40' Horiz.
 1" = 5' Vert.

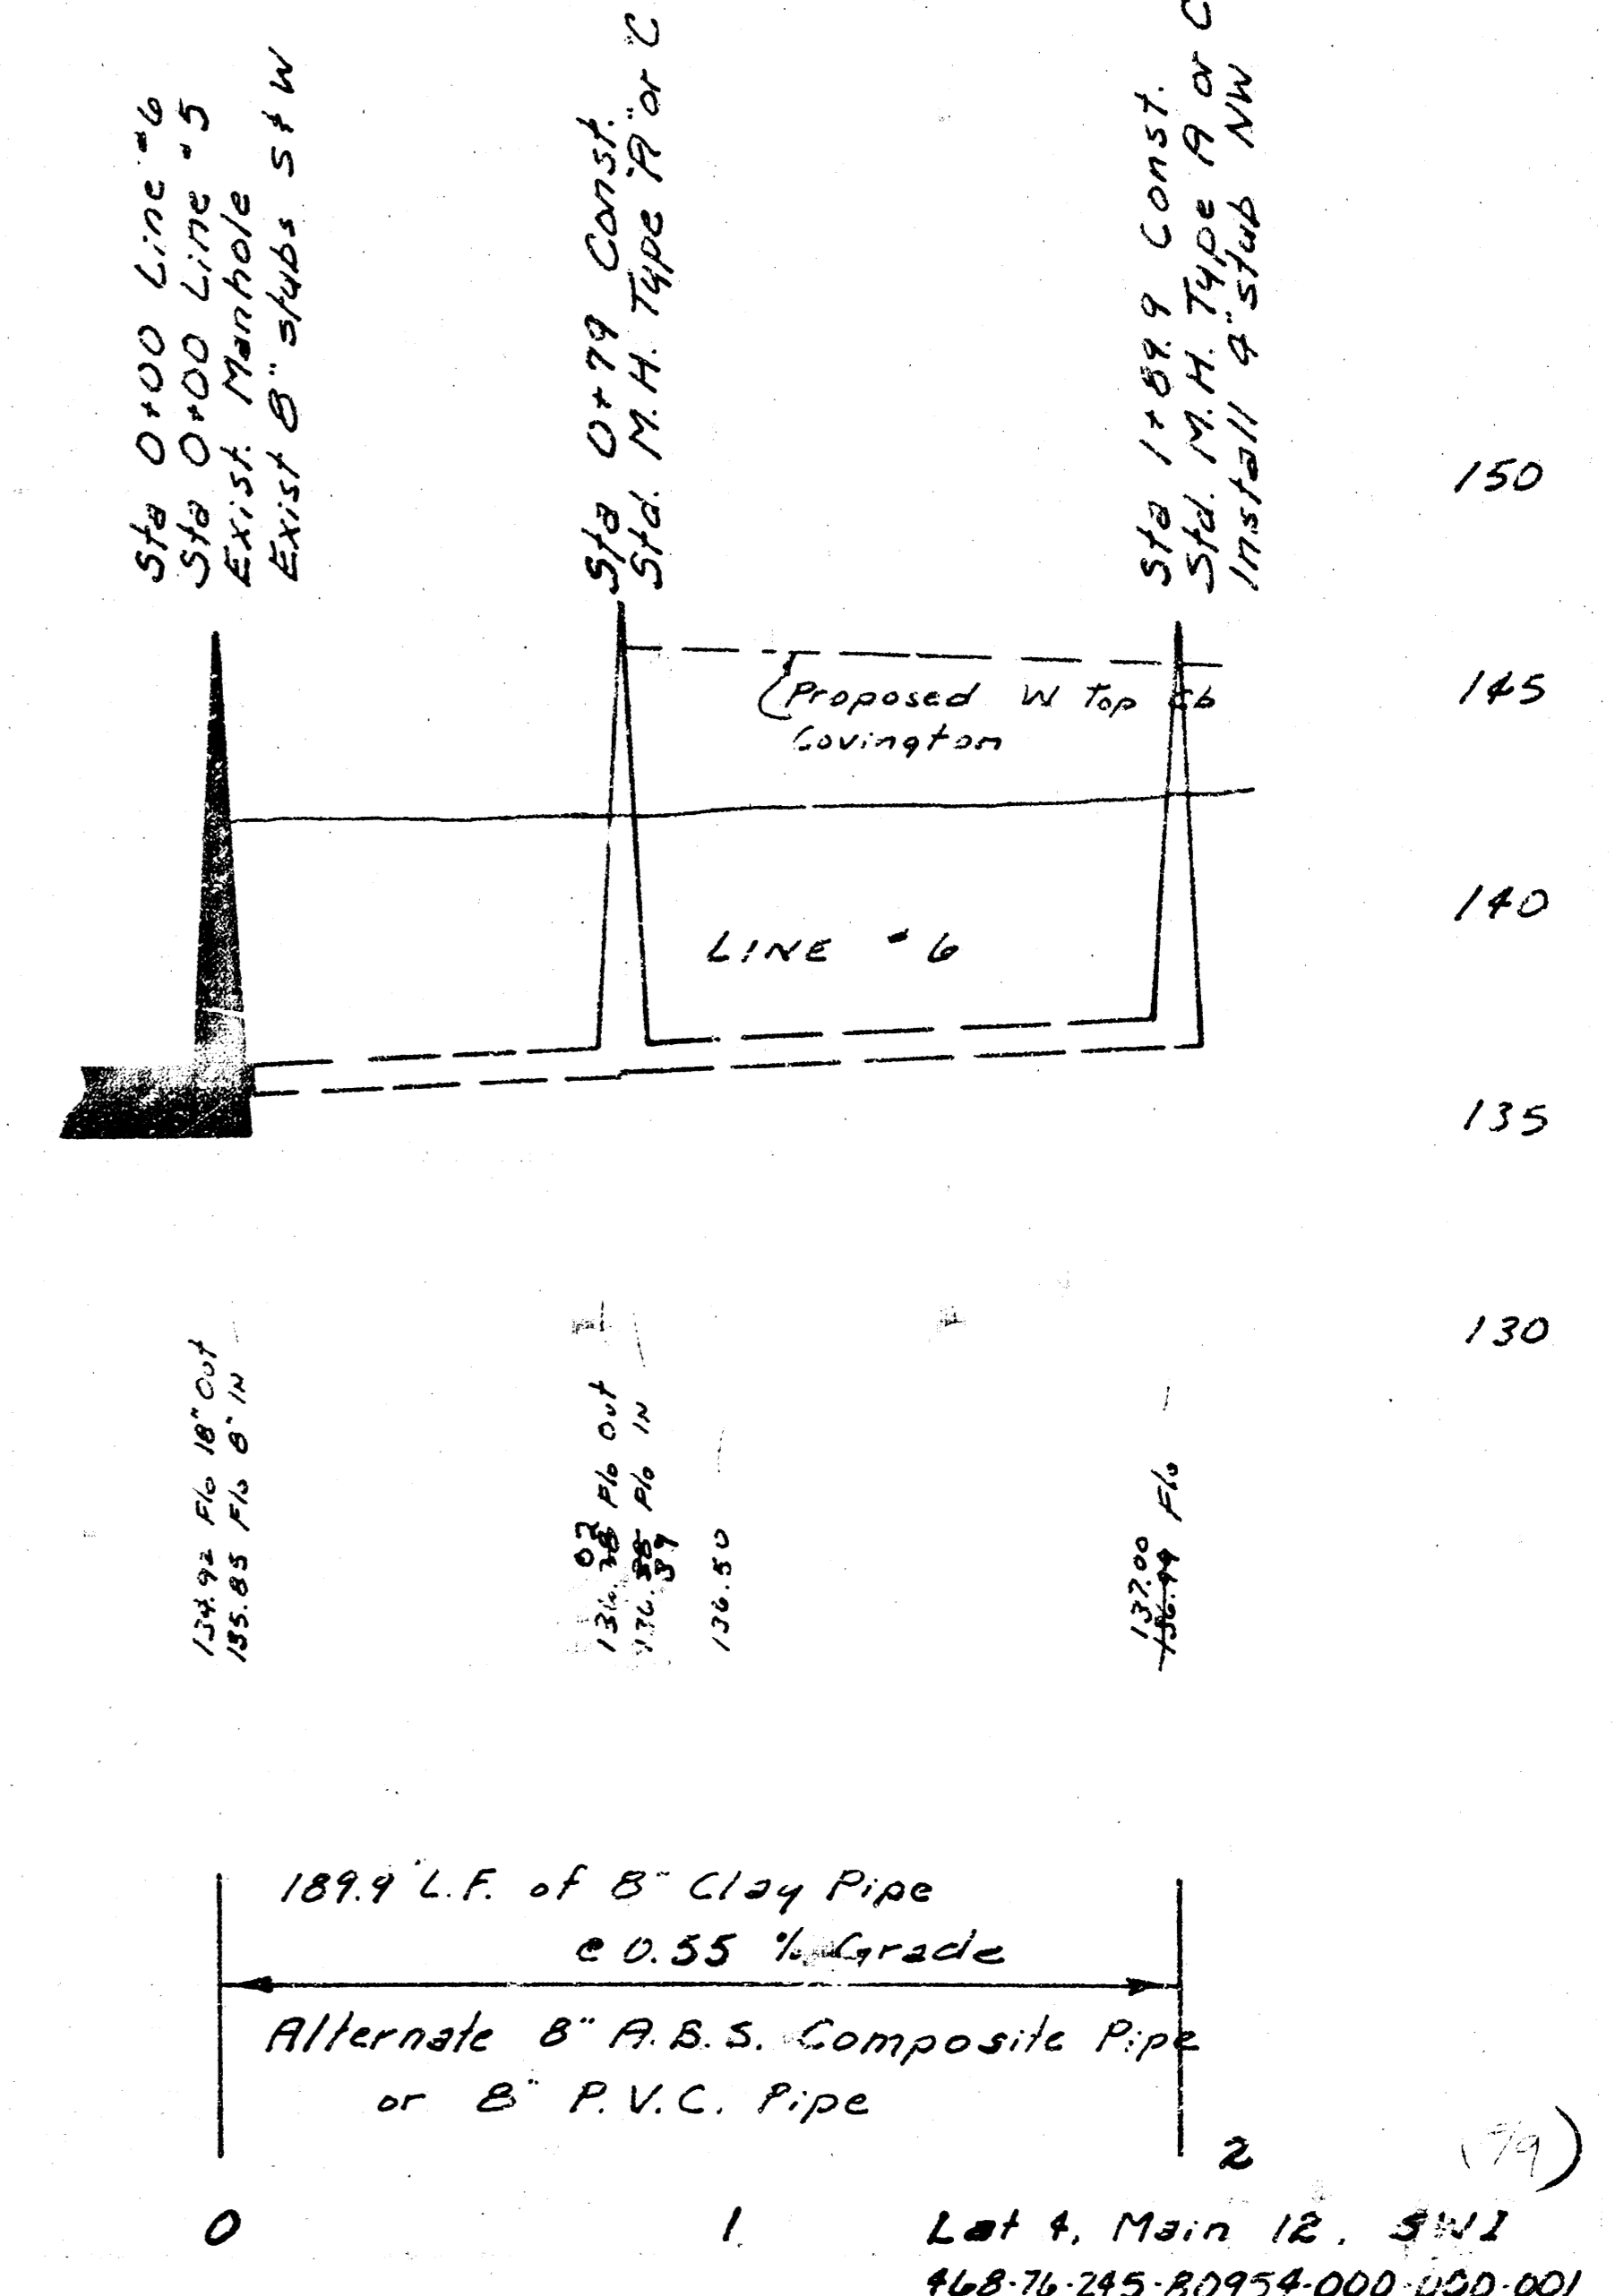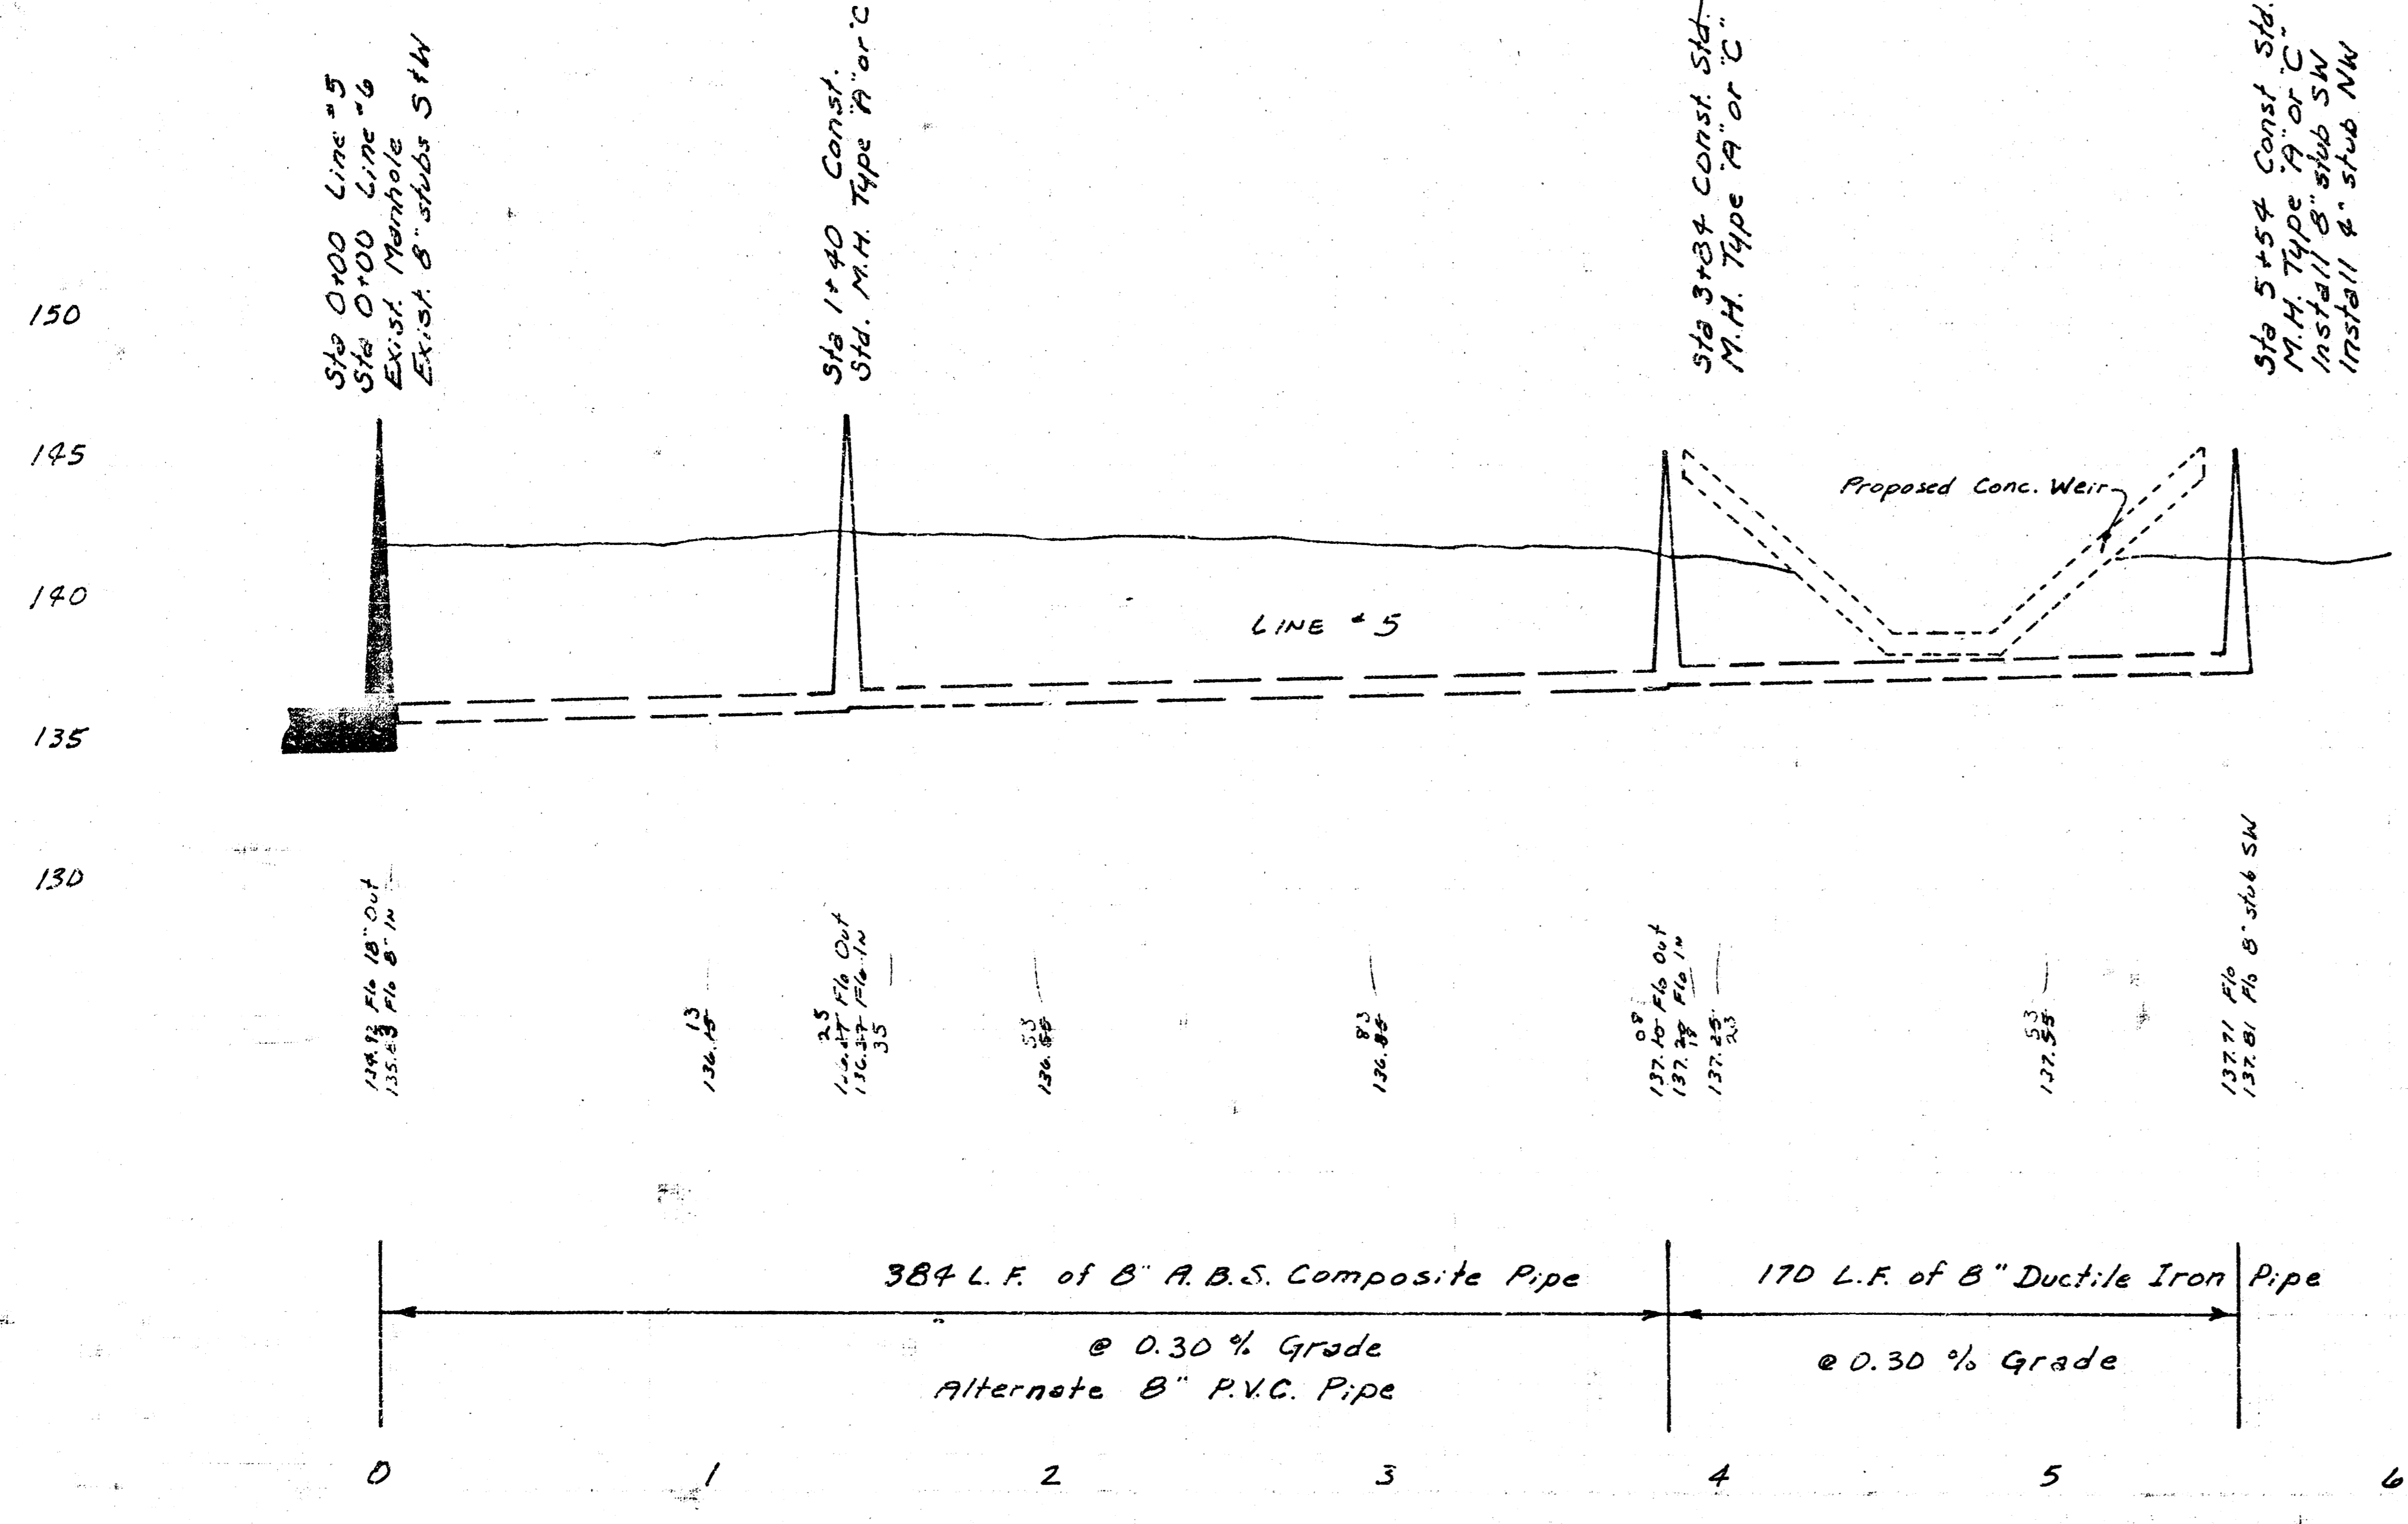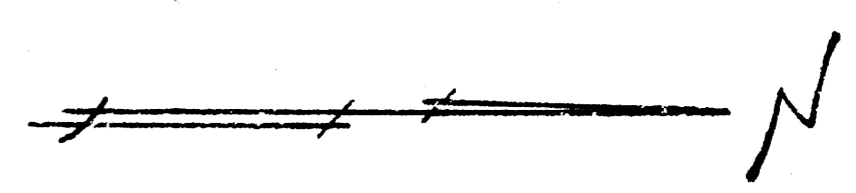


Lot 4, Main 12, 341
 468-76-245-80954-000-000-001

FILMED FROM THE BEST
 AVAILABLE COPY


Scale Plan 1" = 40'
Profile 1" = 40' Horz.
1" = 5' Vert.

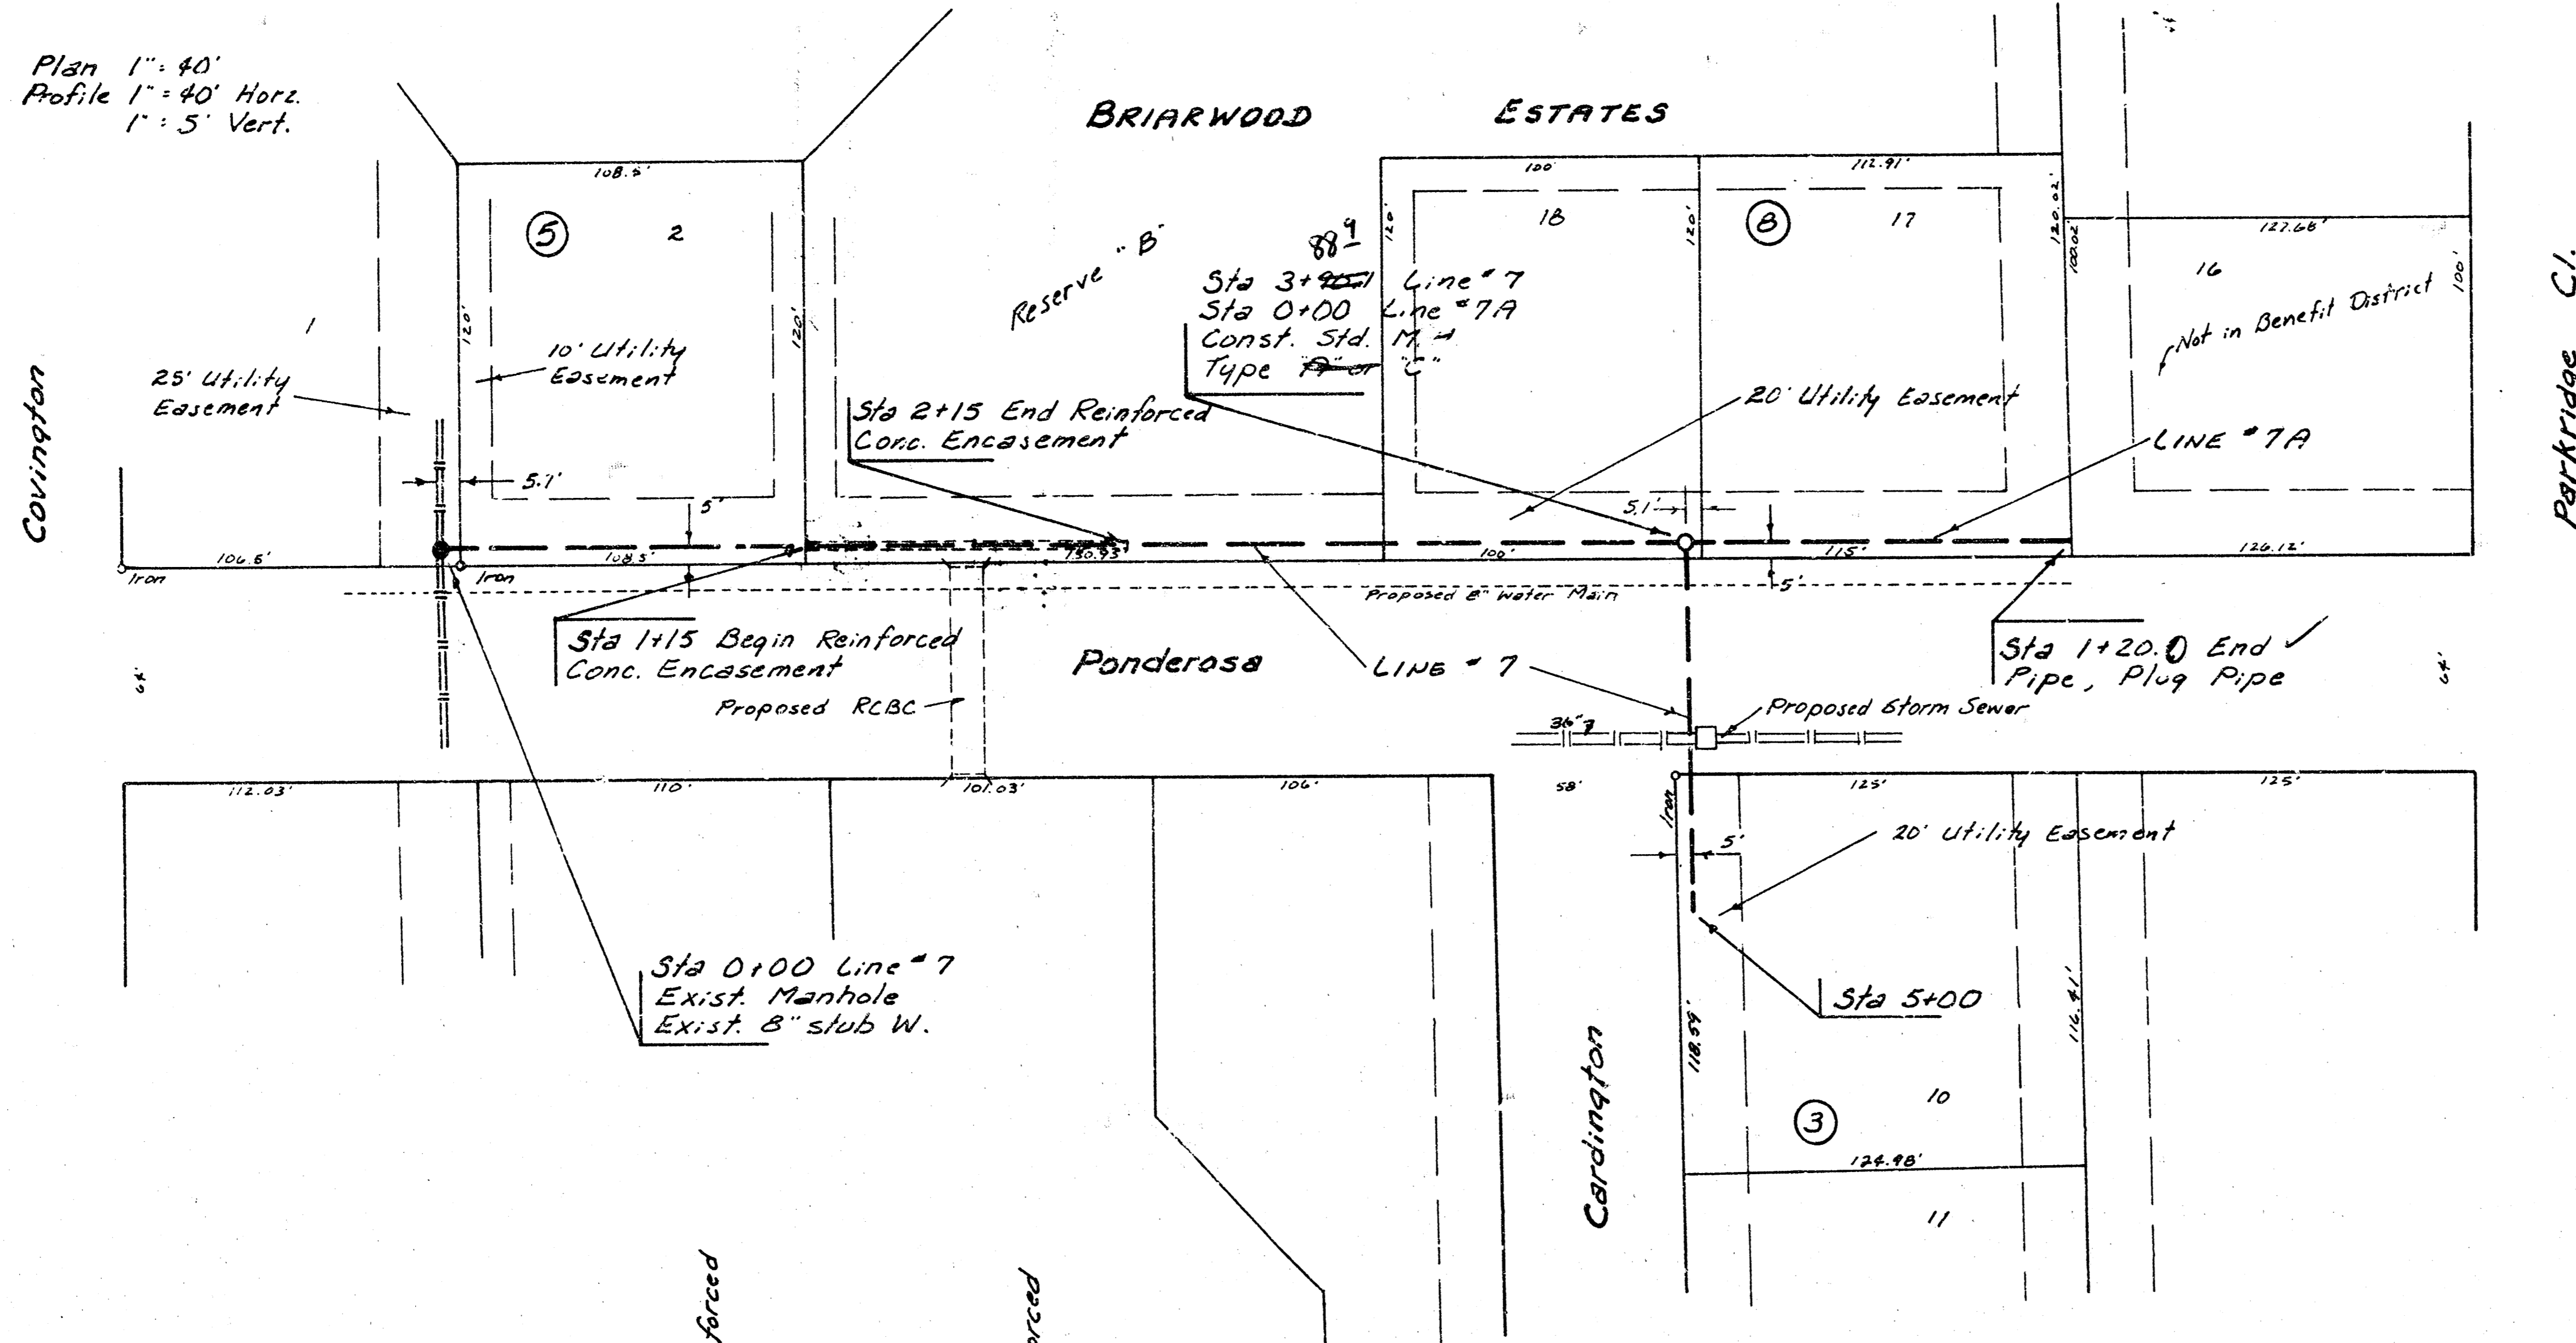

150
145
140
135

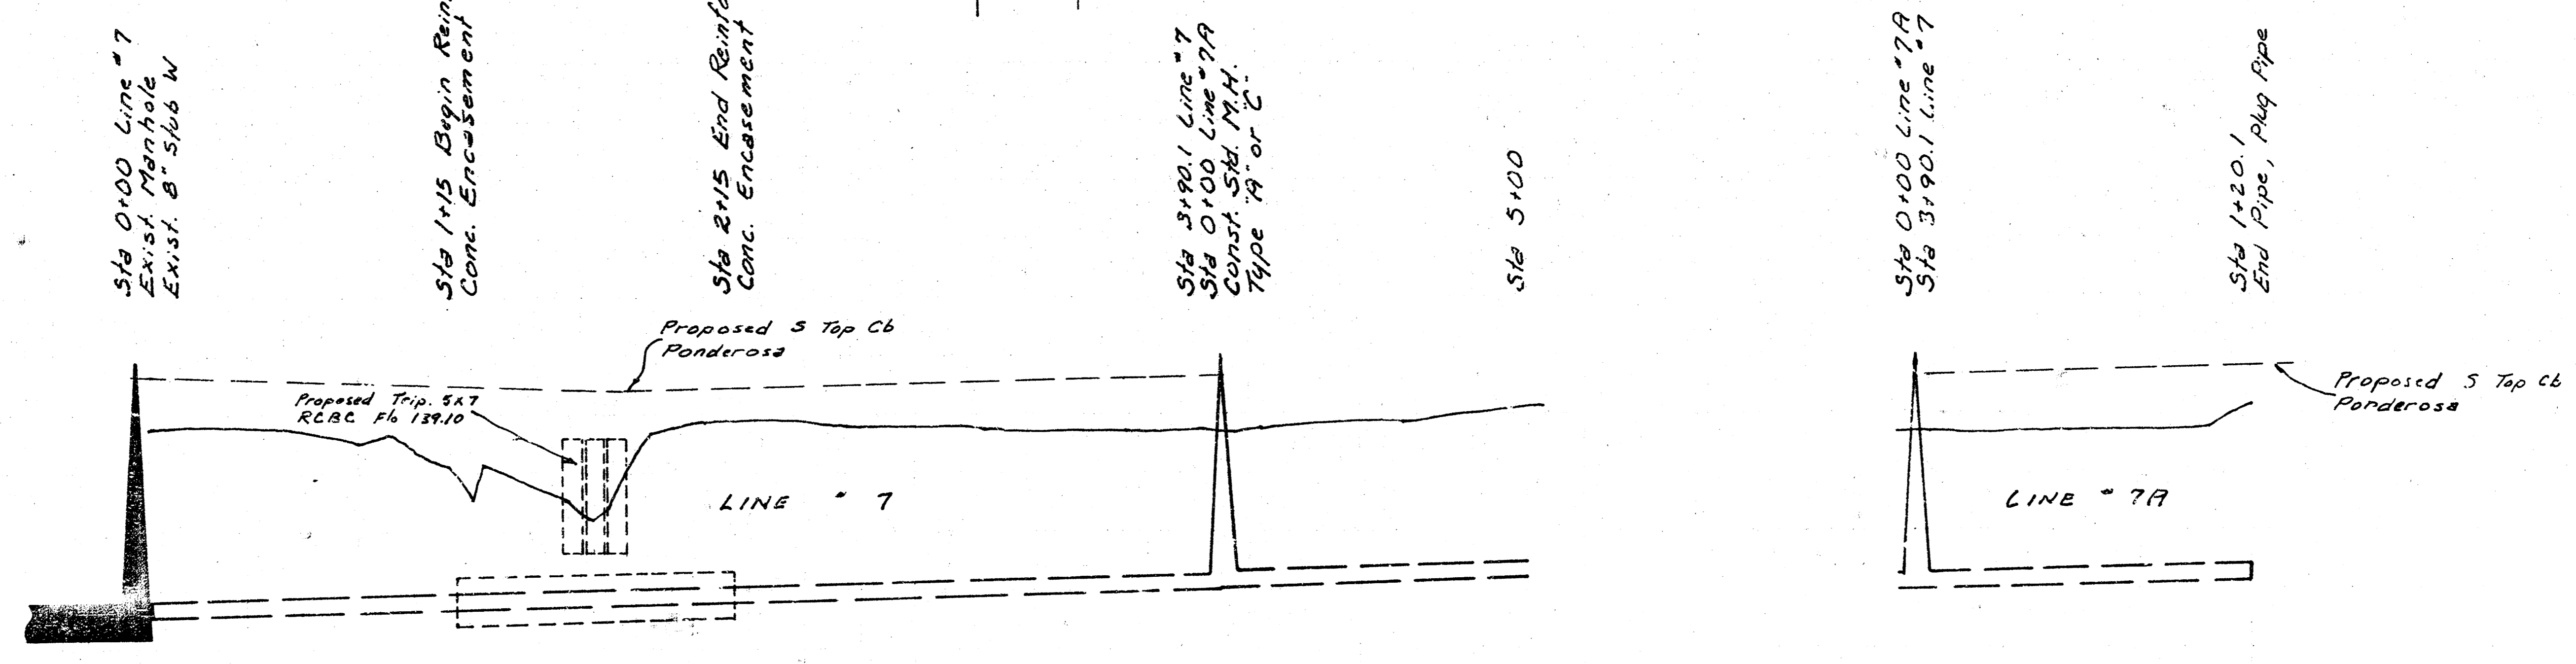





150
145
140
135

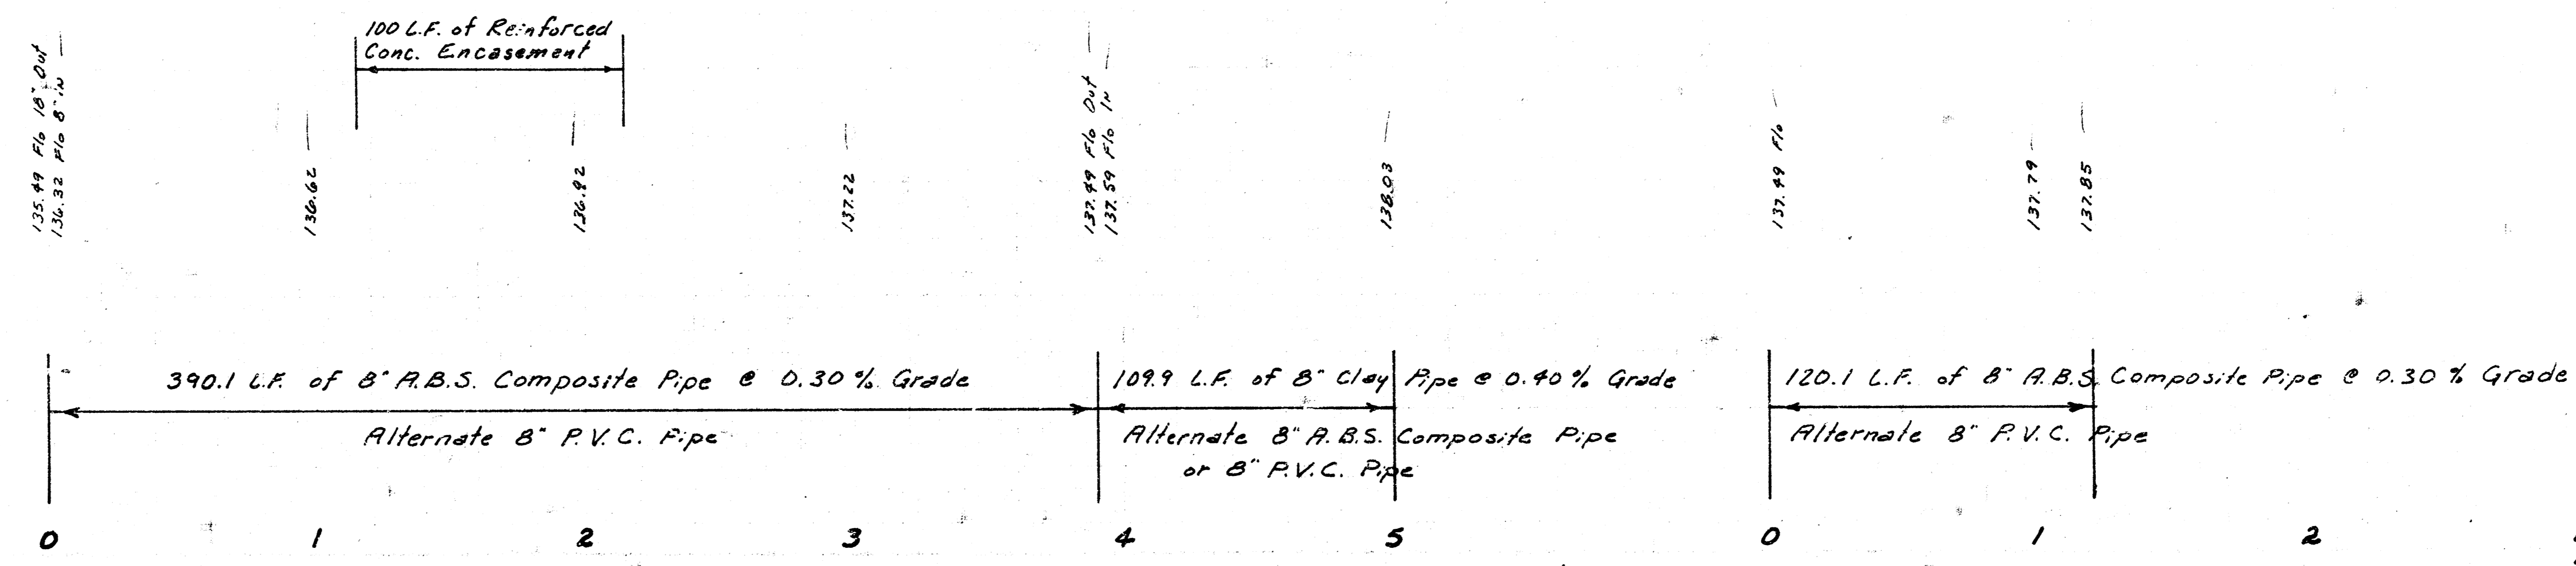


Lot 9, Main 12, SWI
468-76-295-80939-000-000-001

FILMED FROM THE BEST


Scale Plan 1" = 40'
 Profile 1" = 40' Horz.
 1" = 5' Vert.

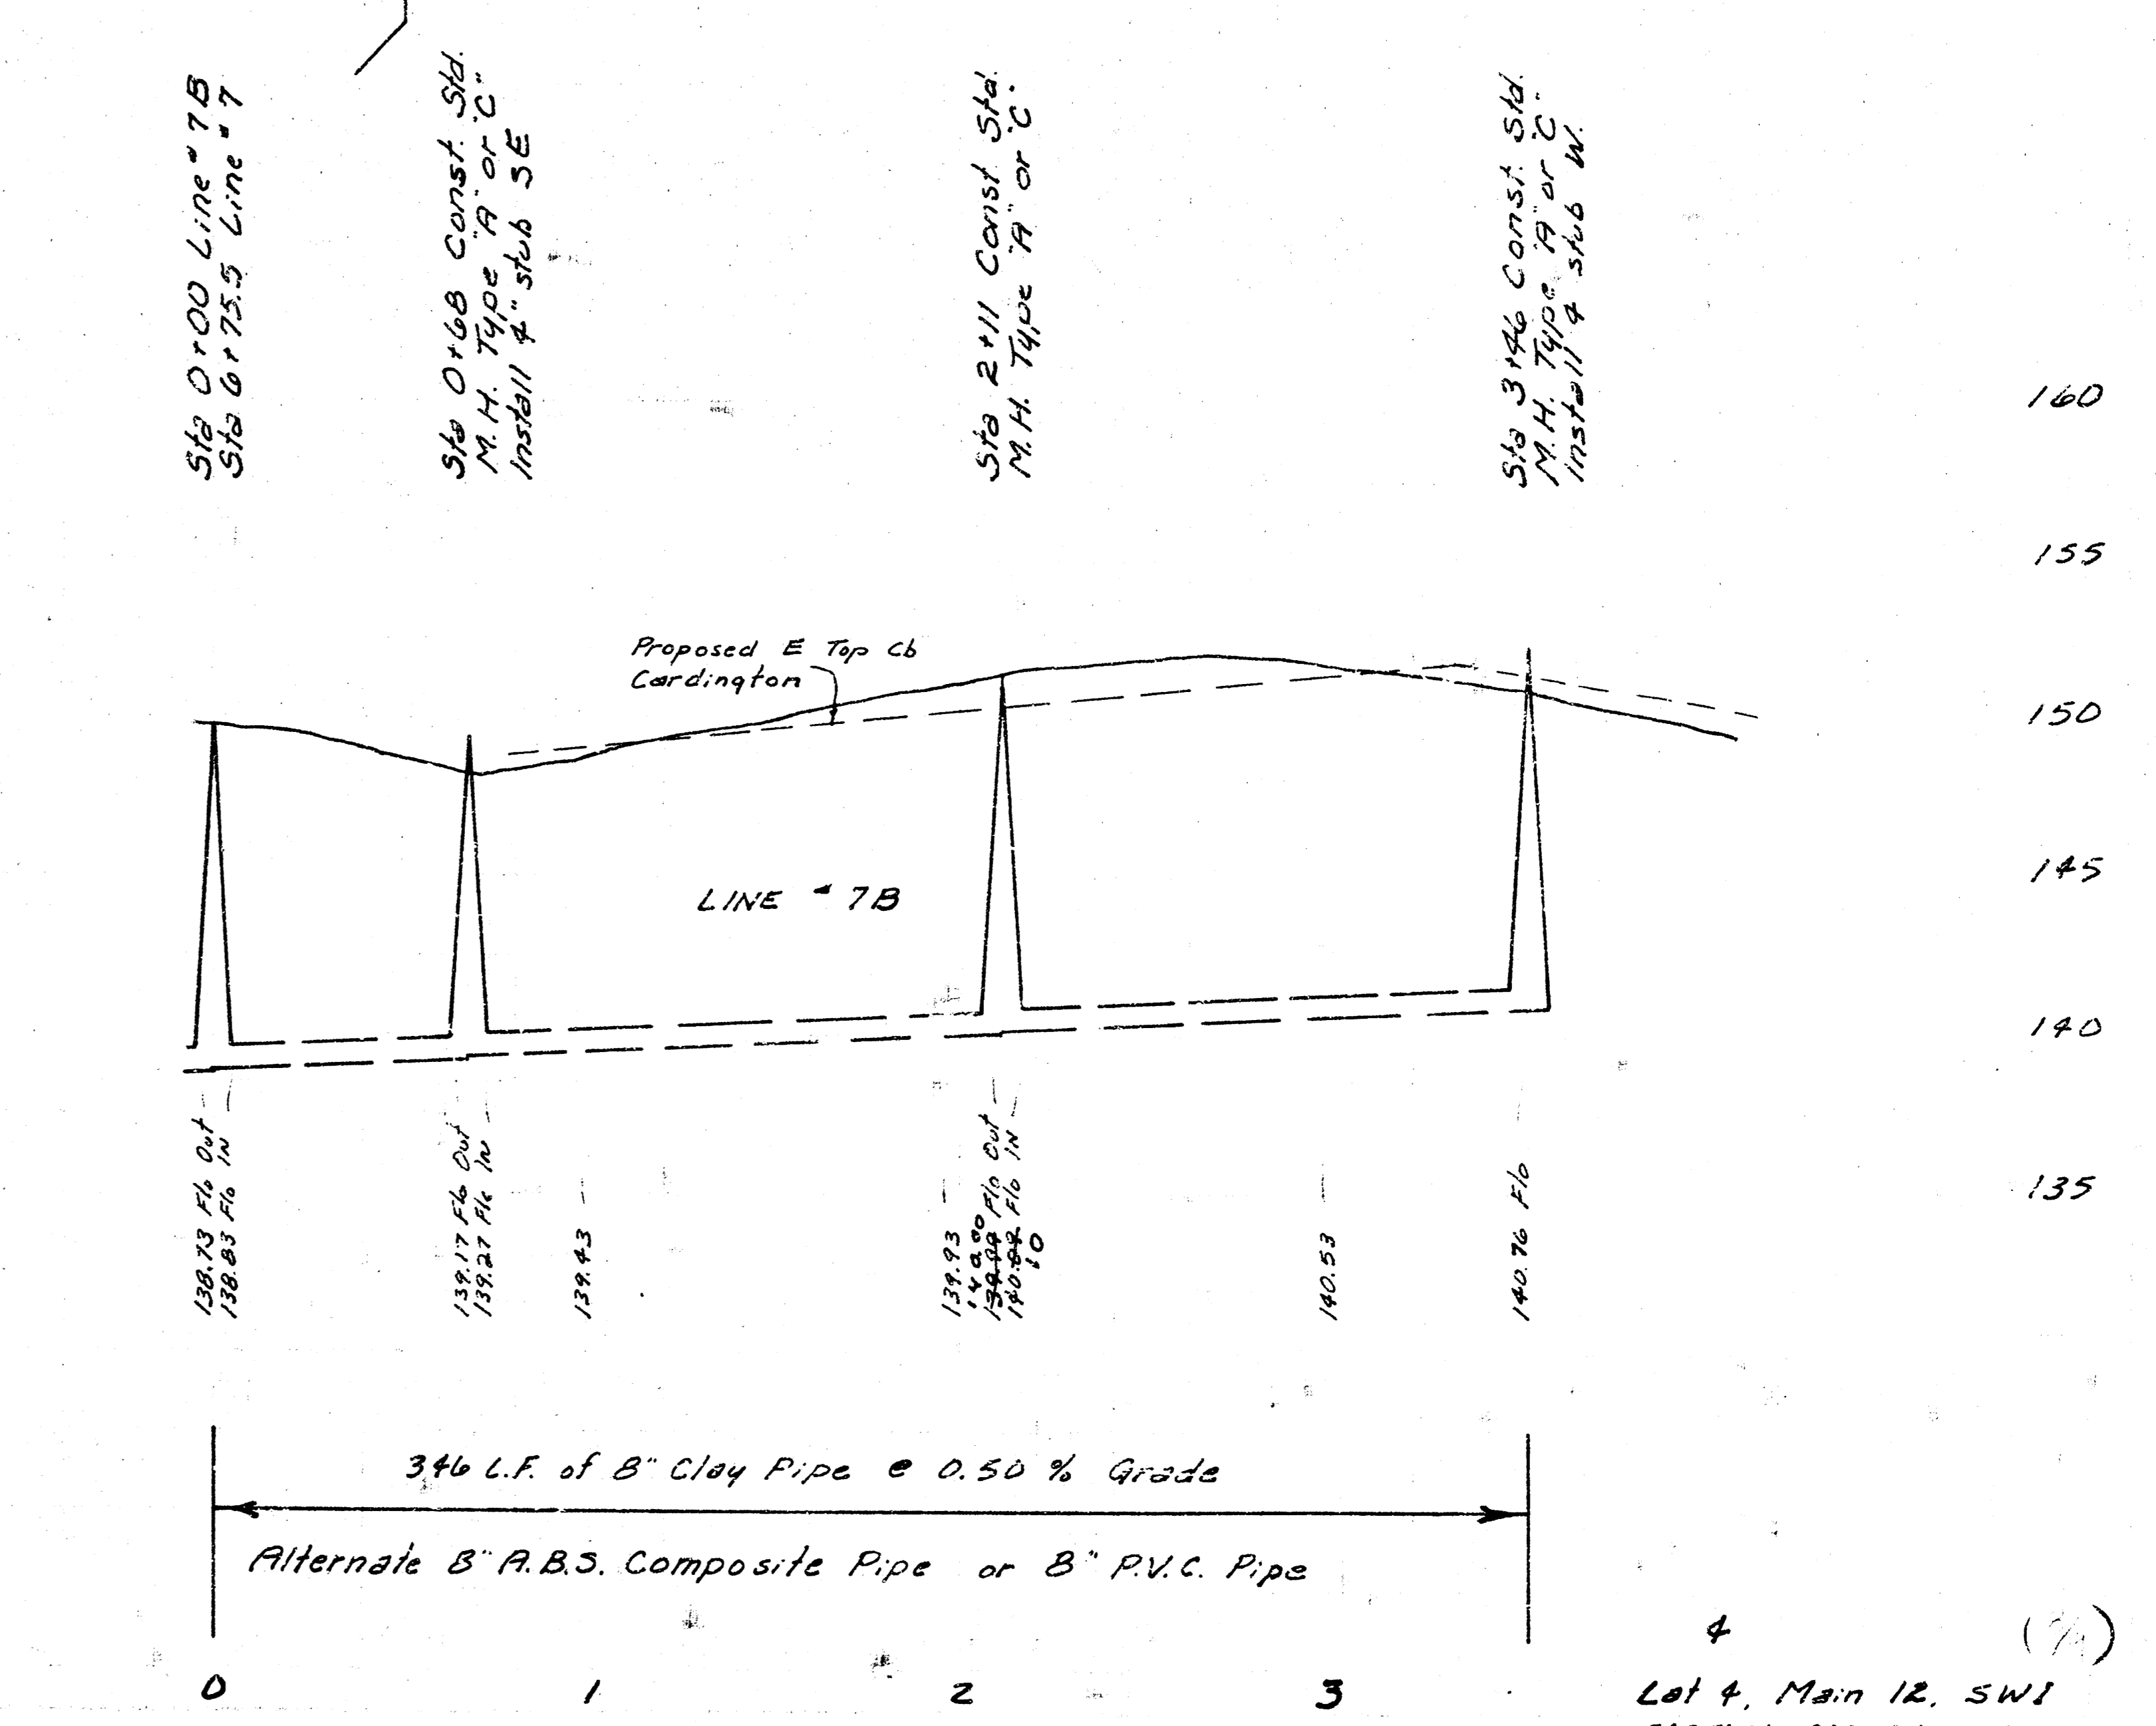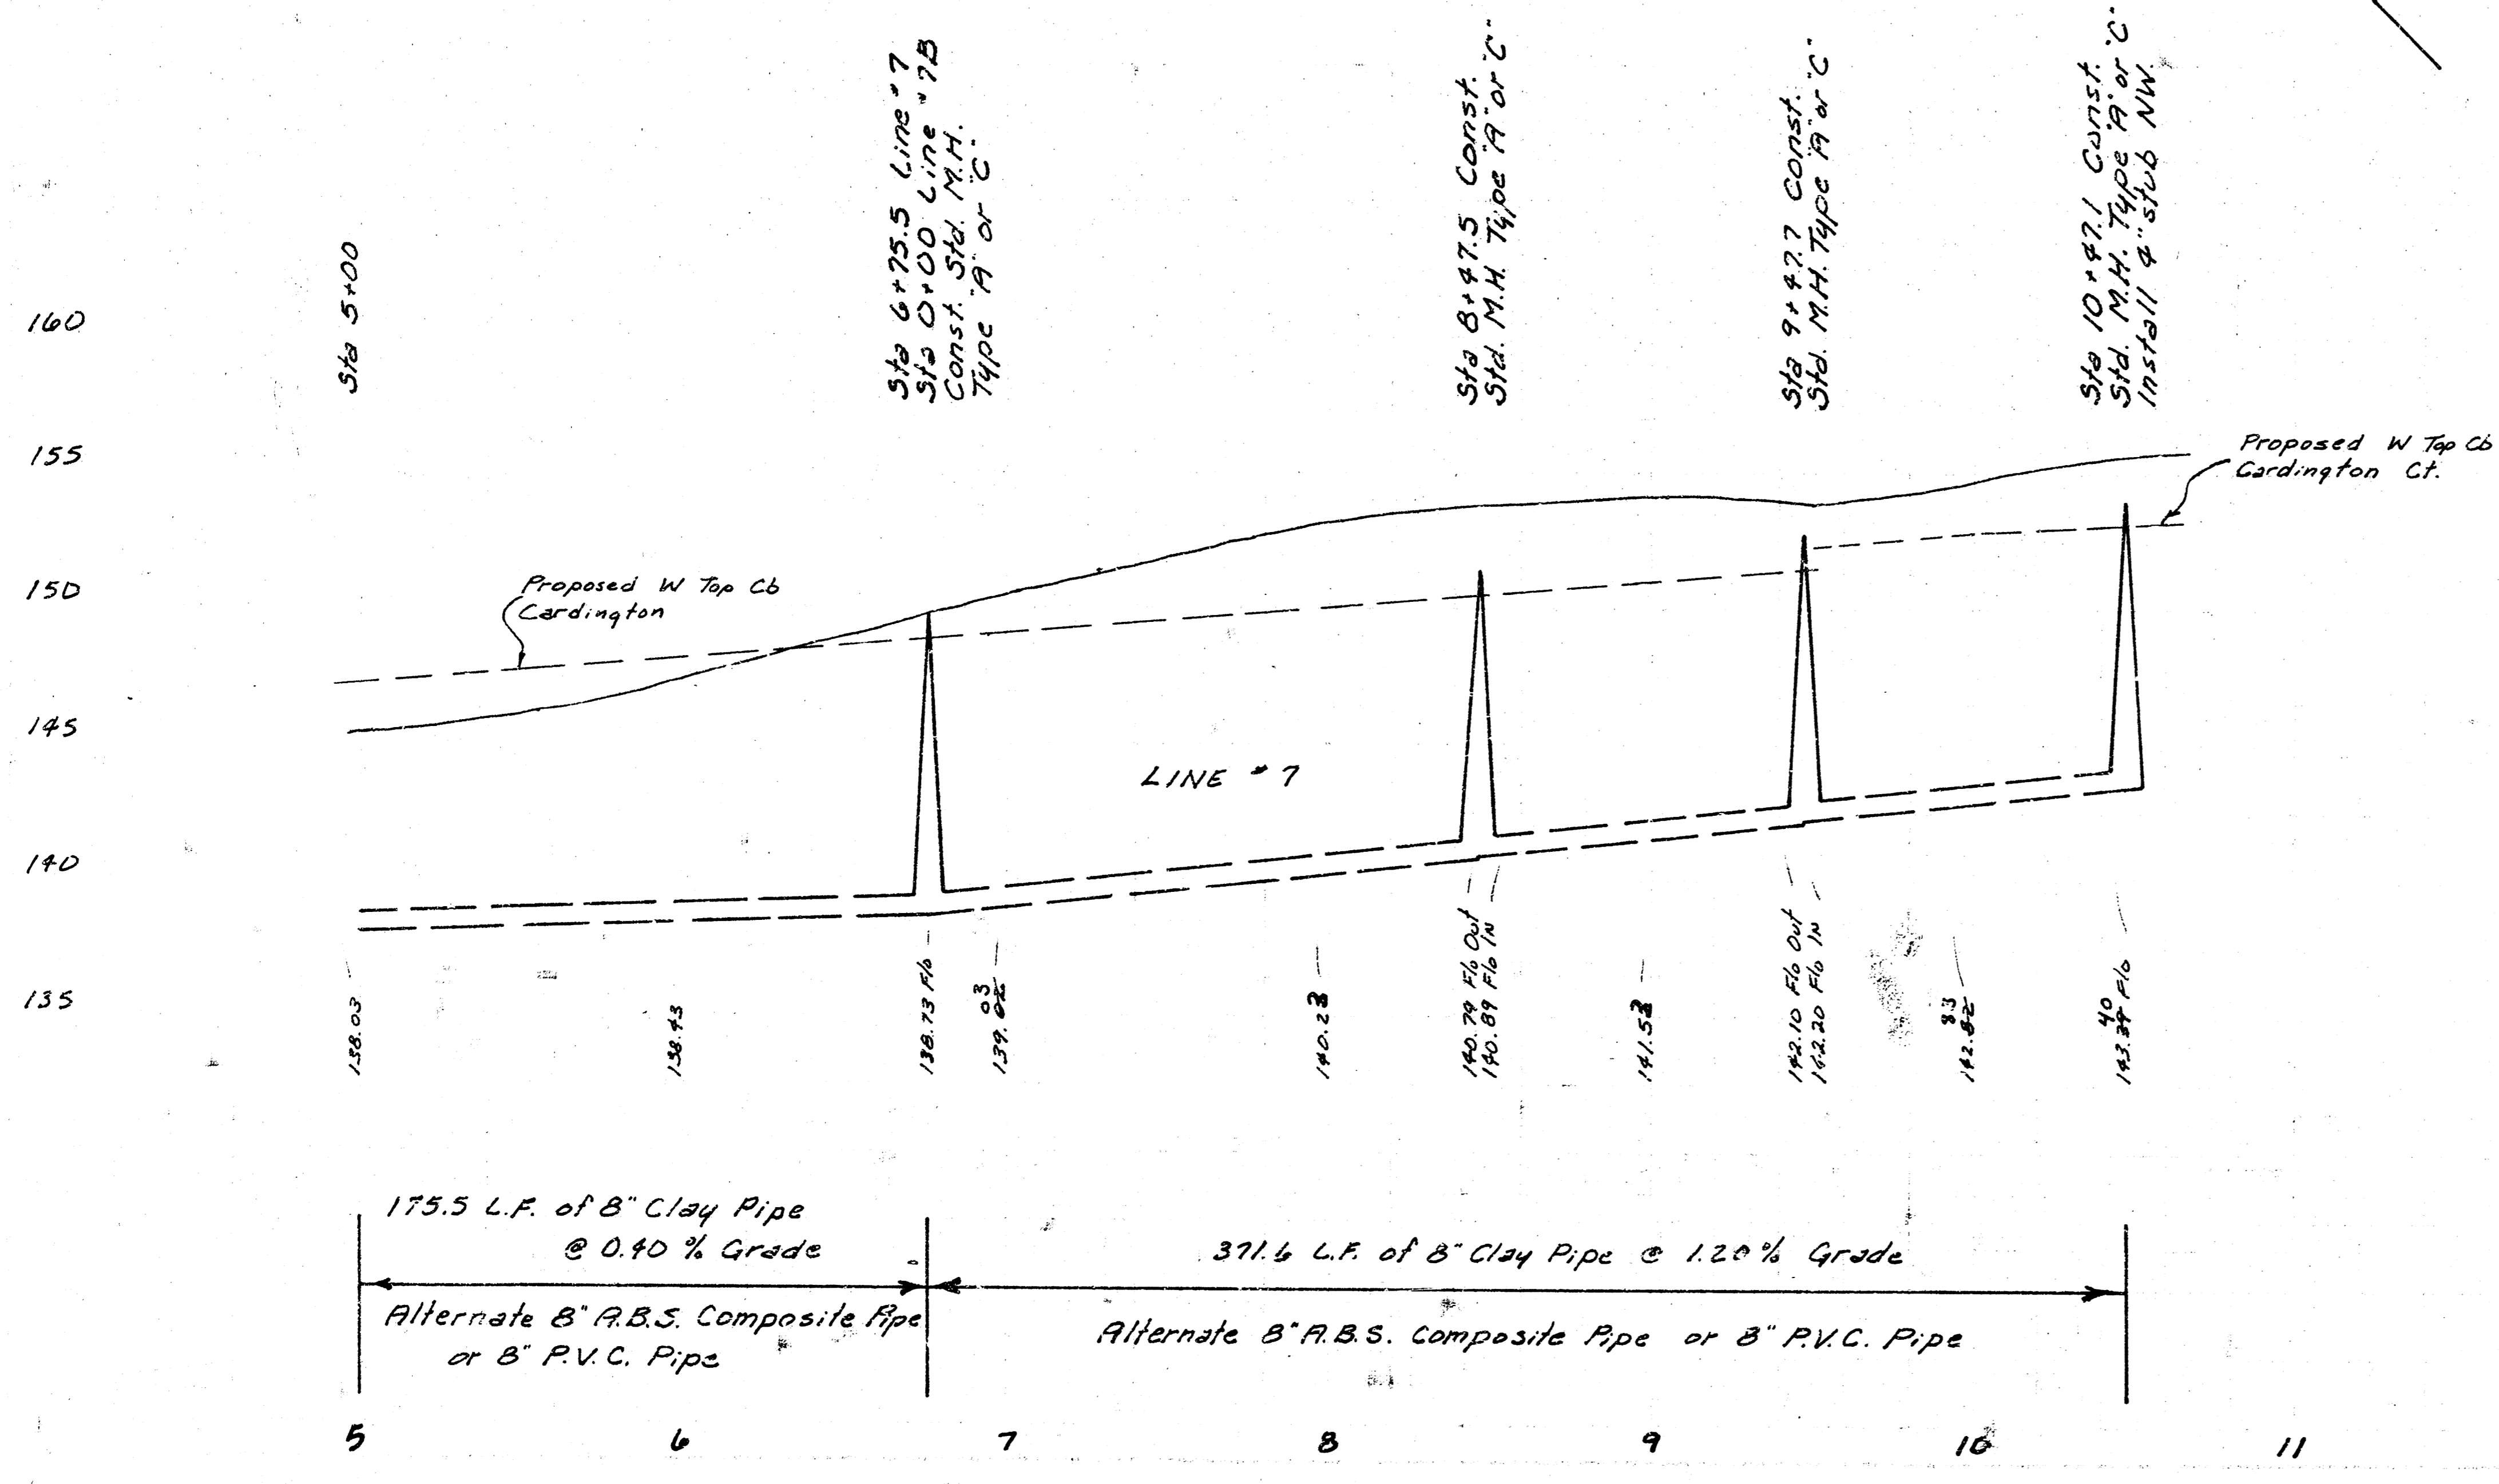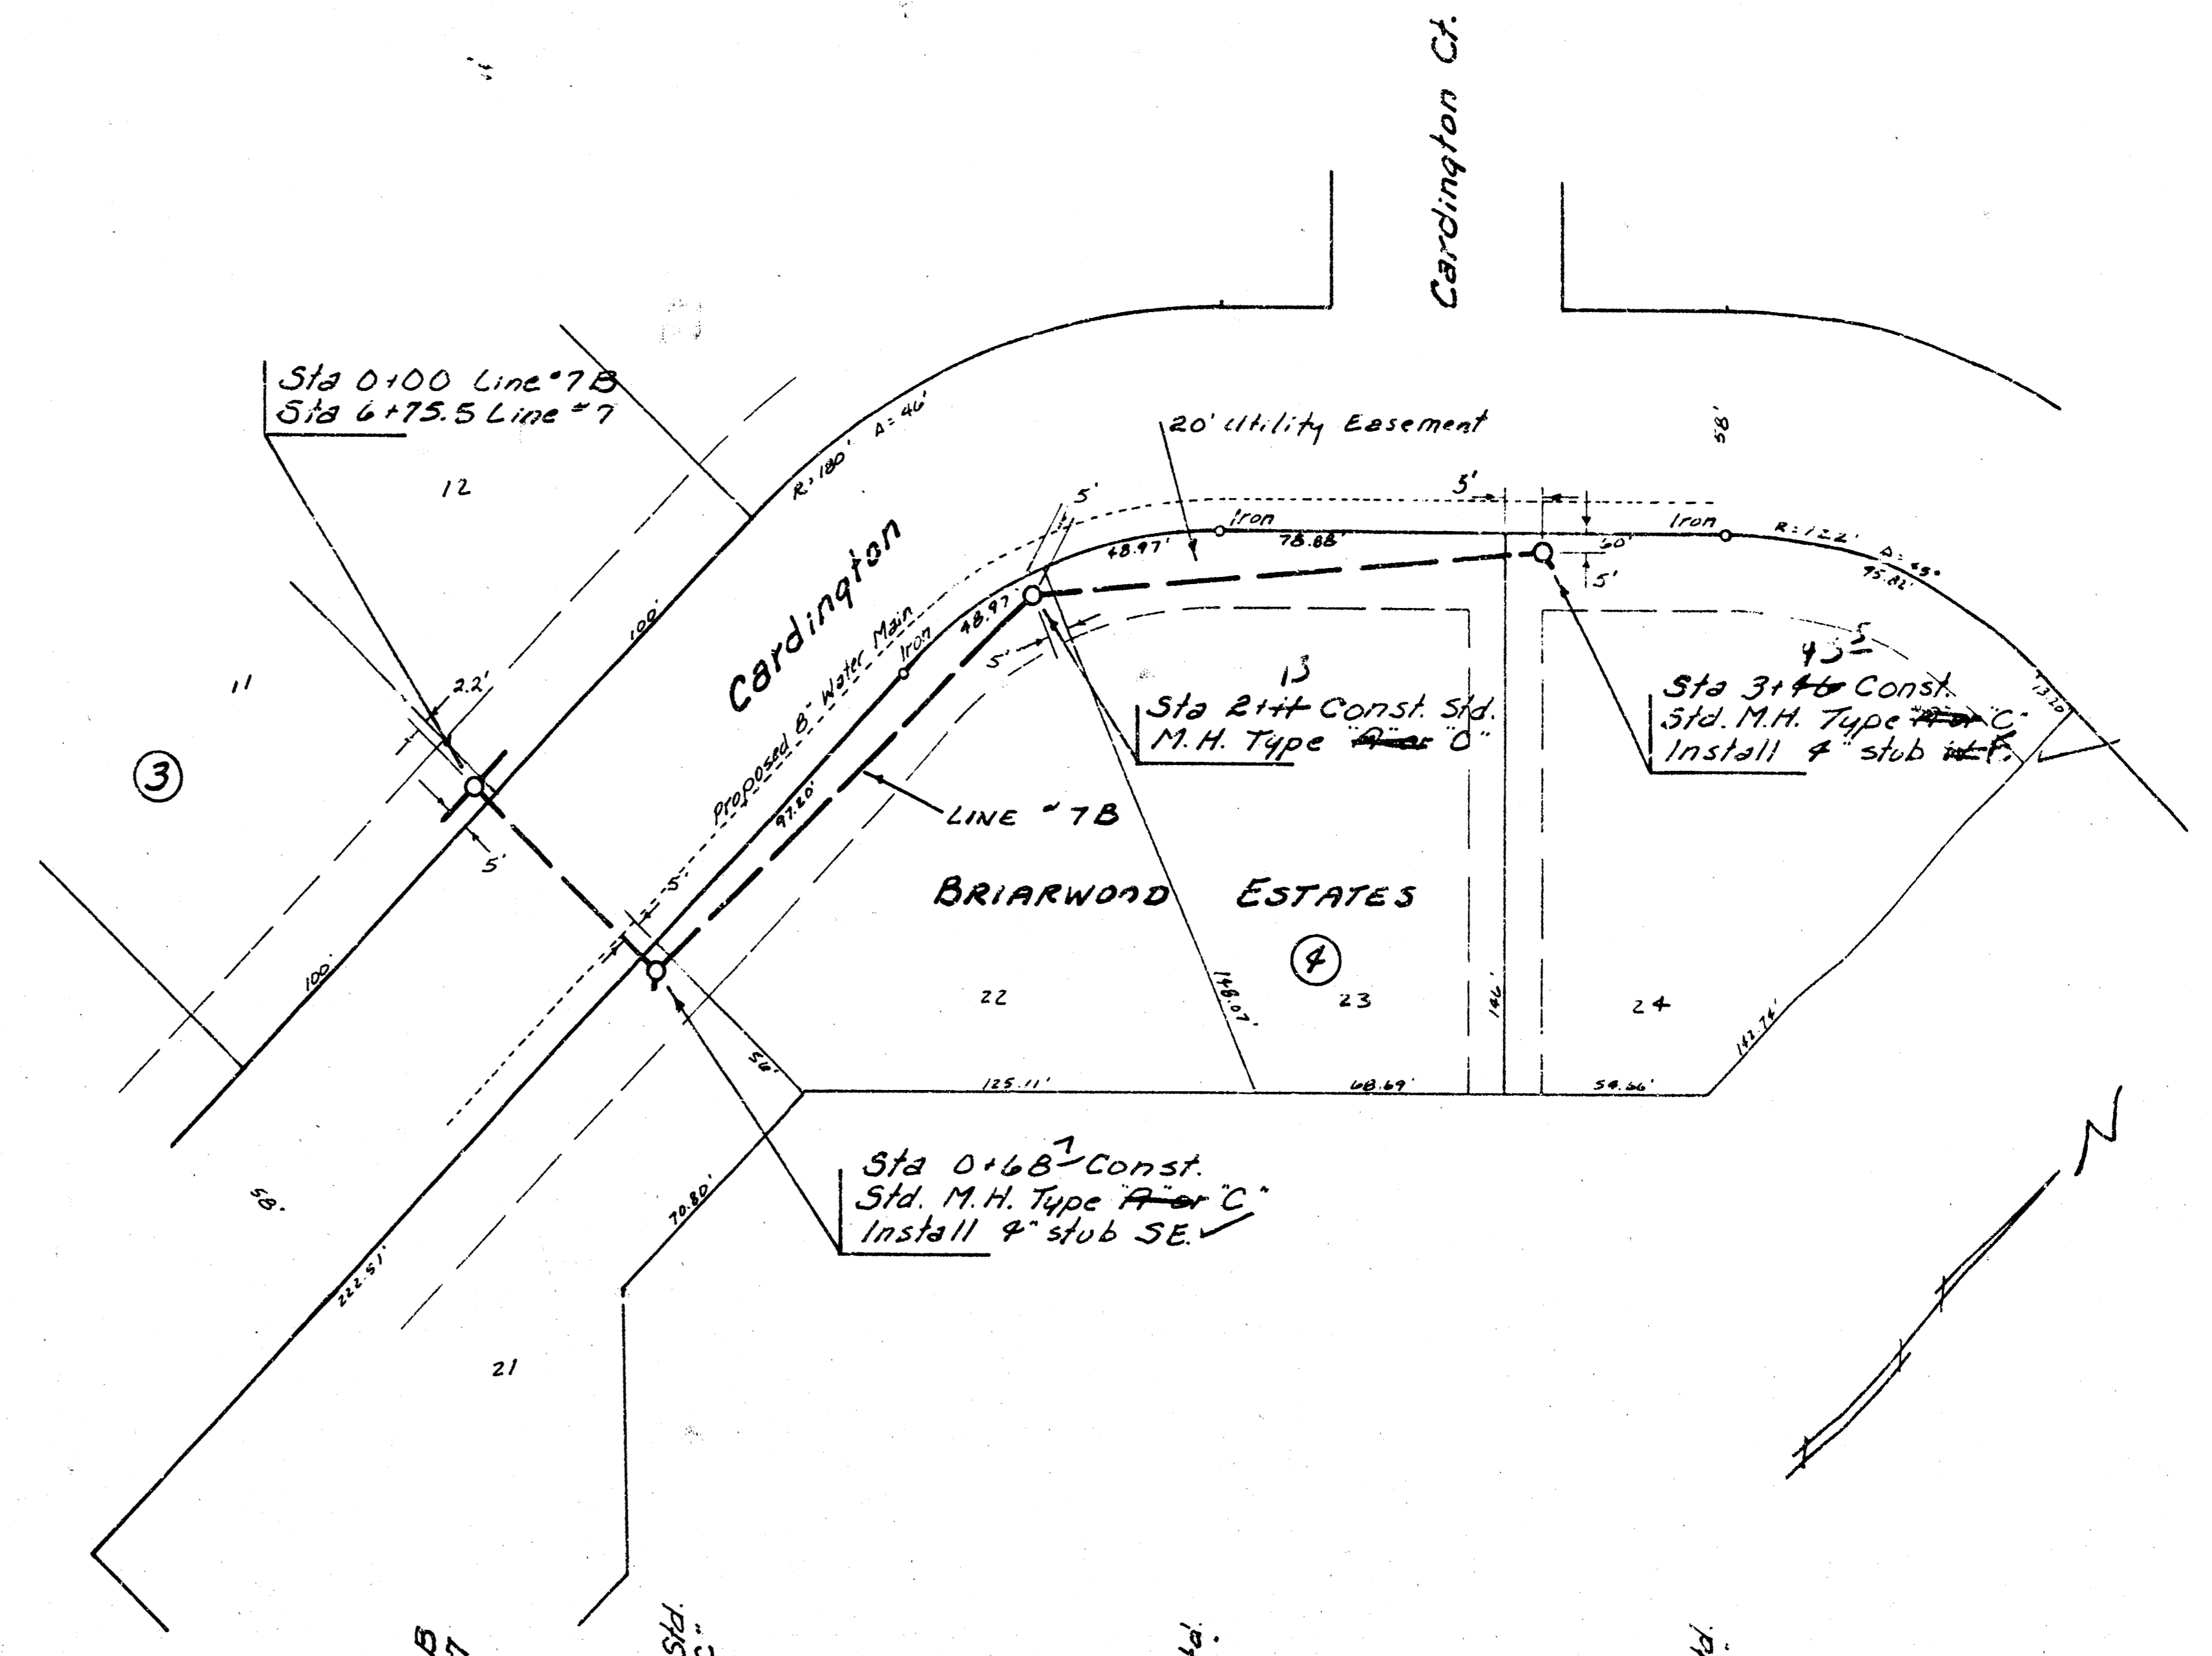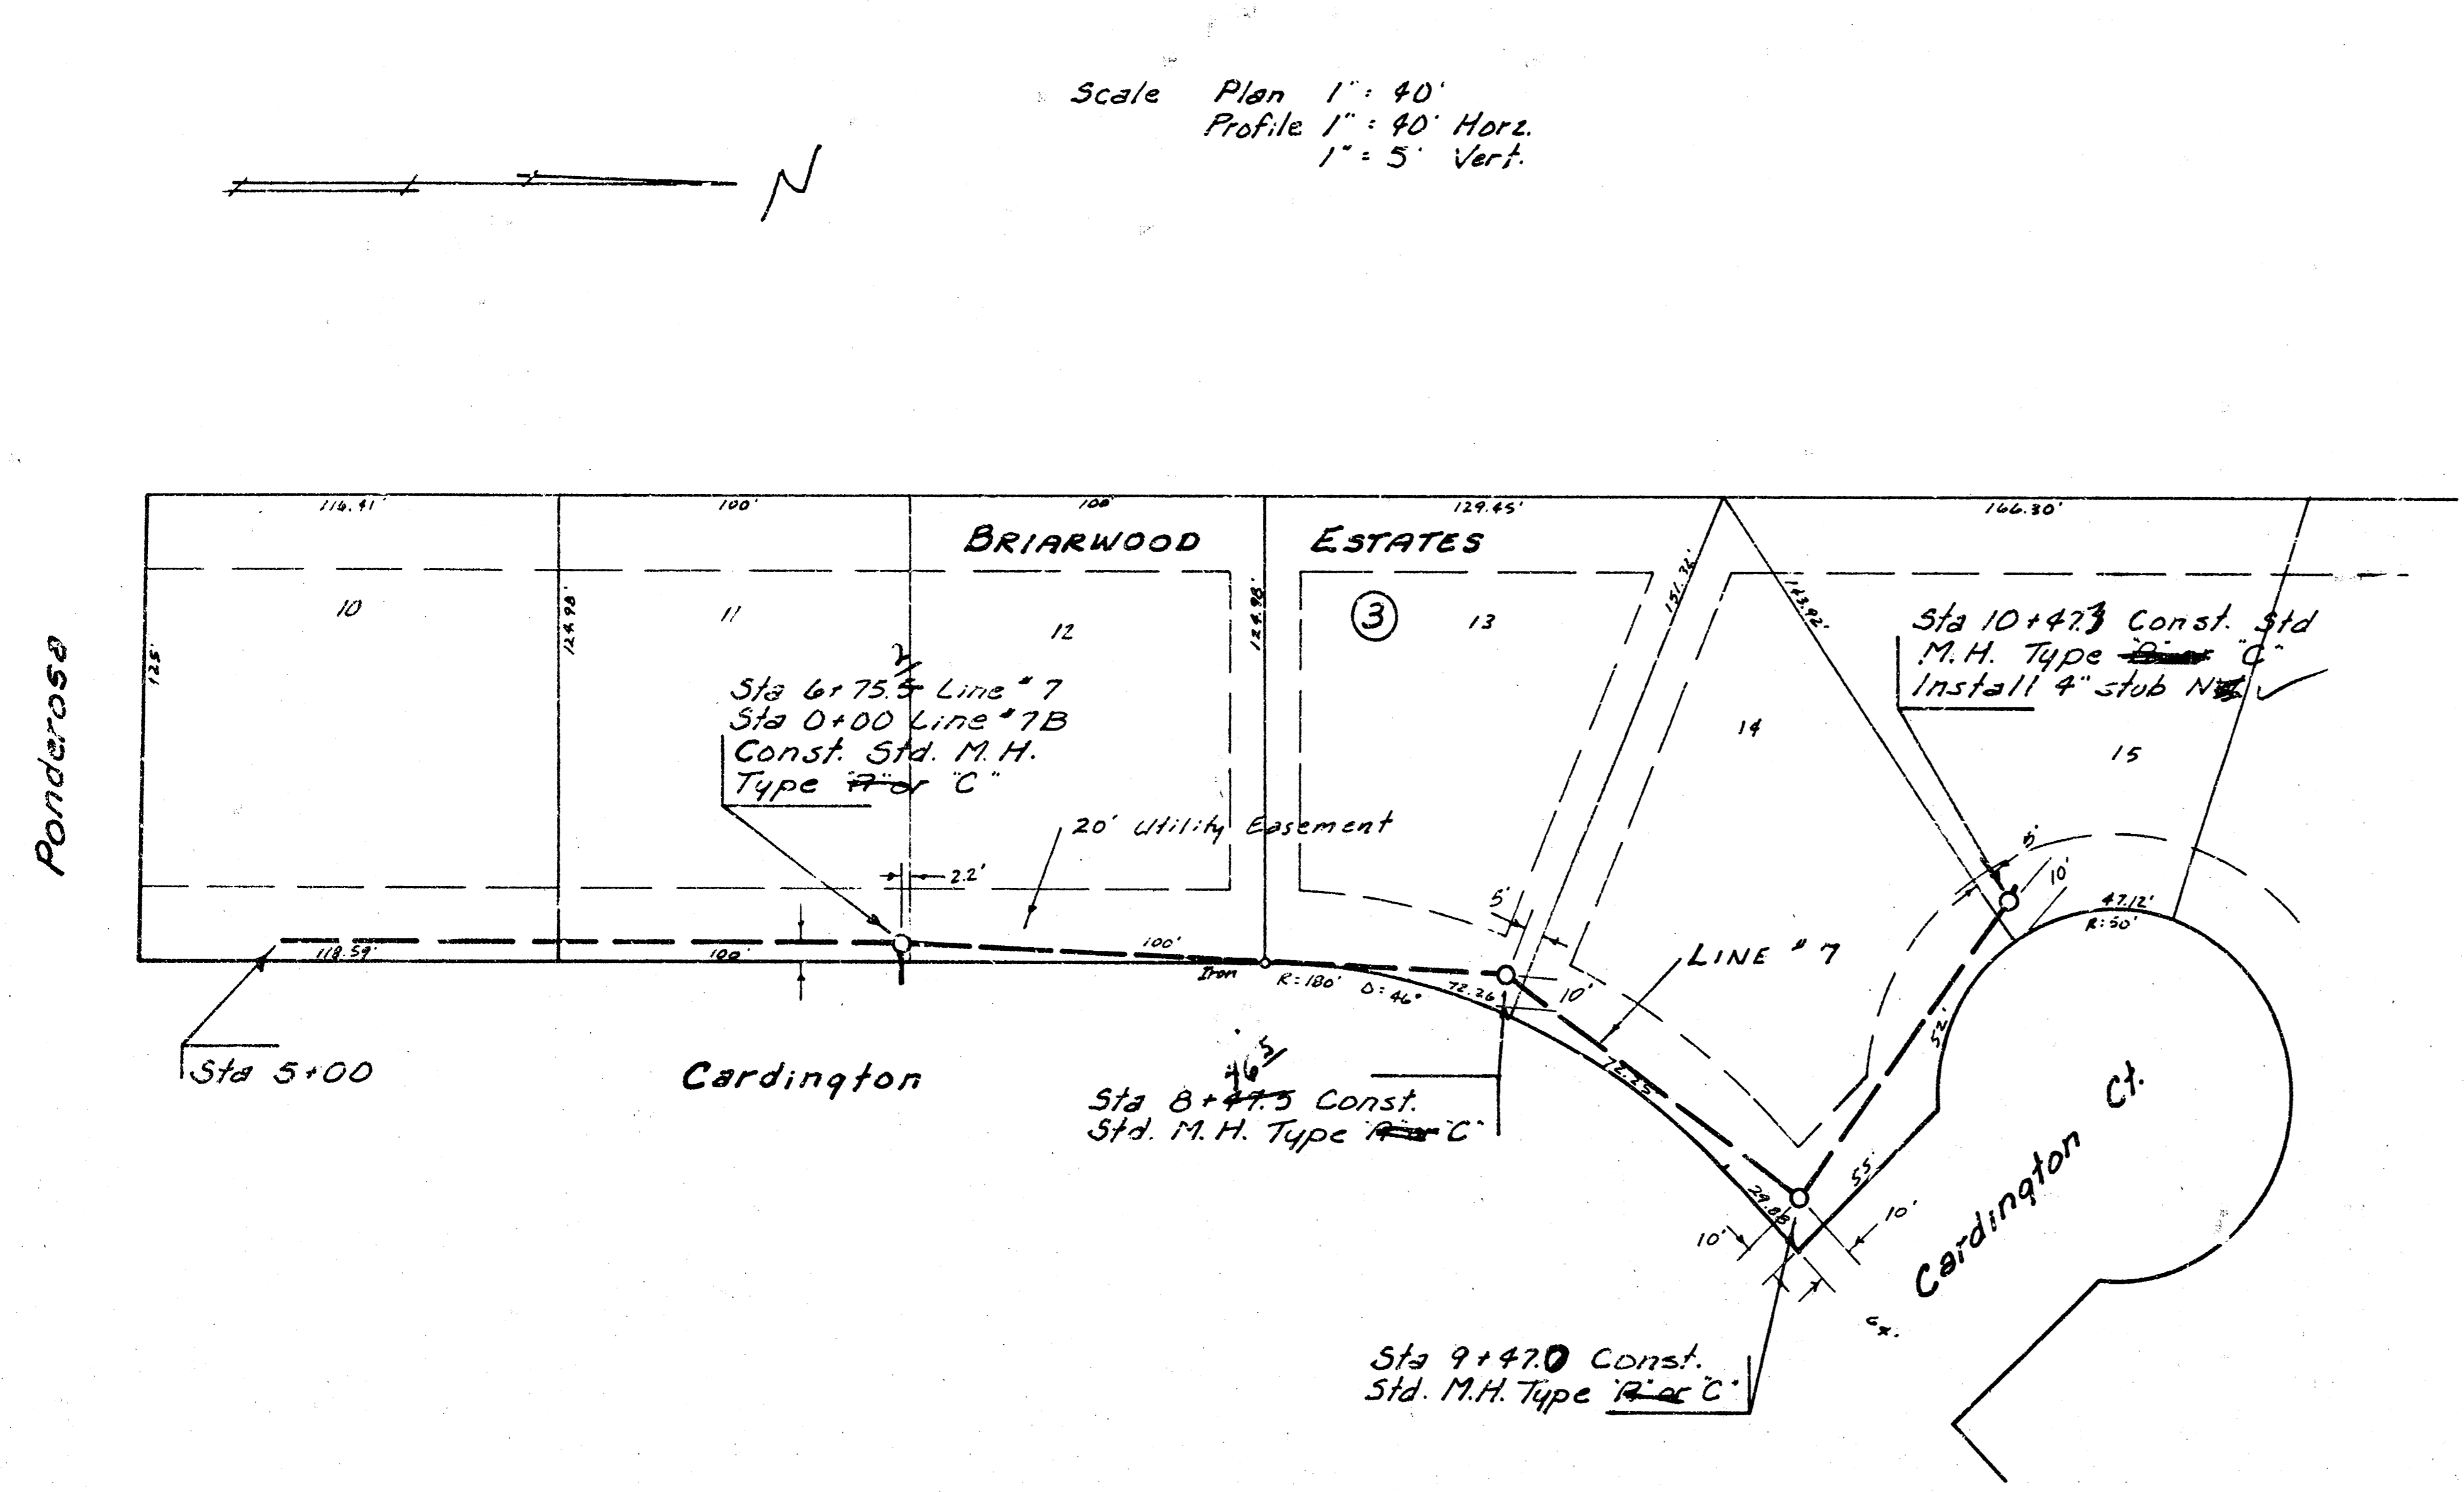

4
 Lot 4, Main 12, SW1
 #6876 245-80954-000.000.001

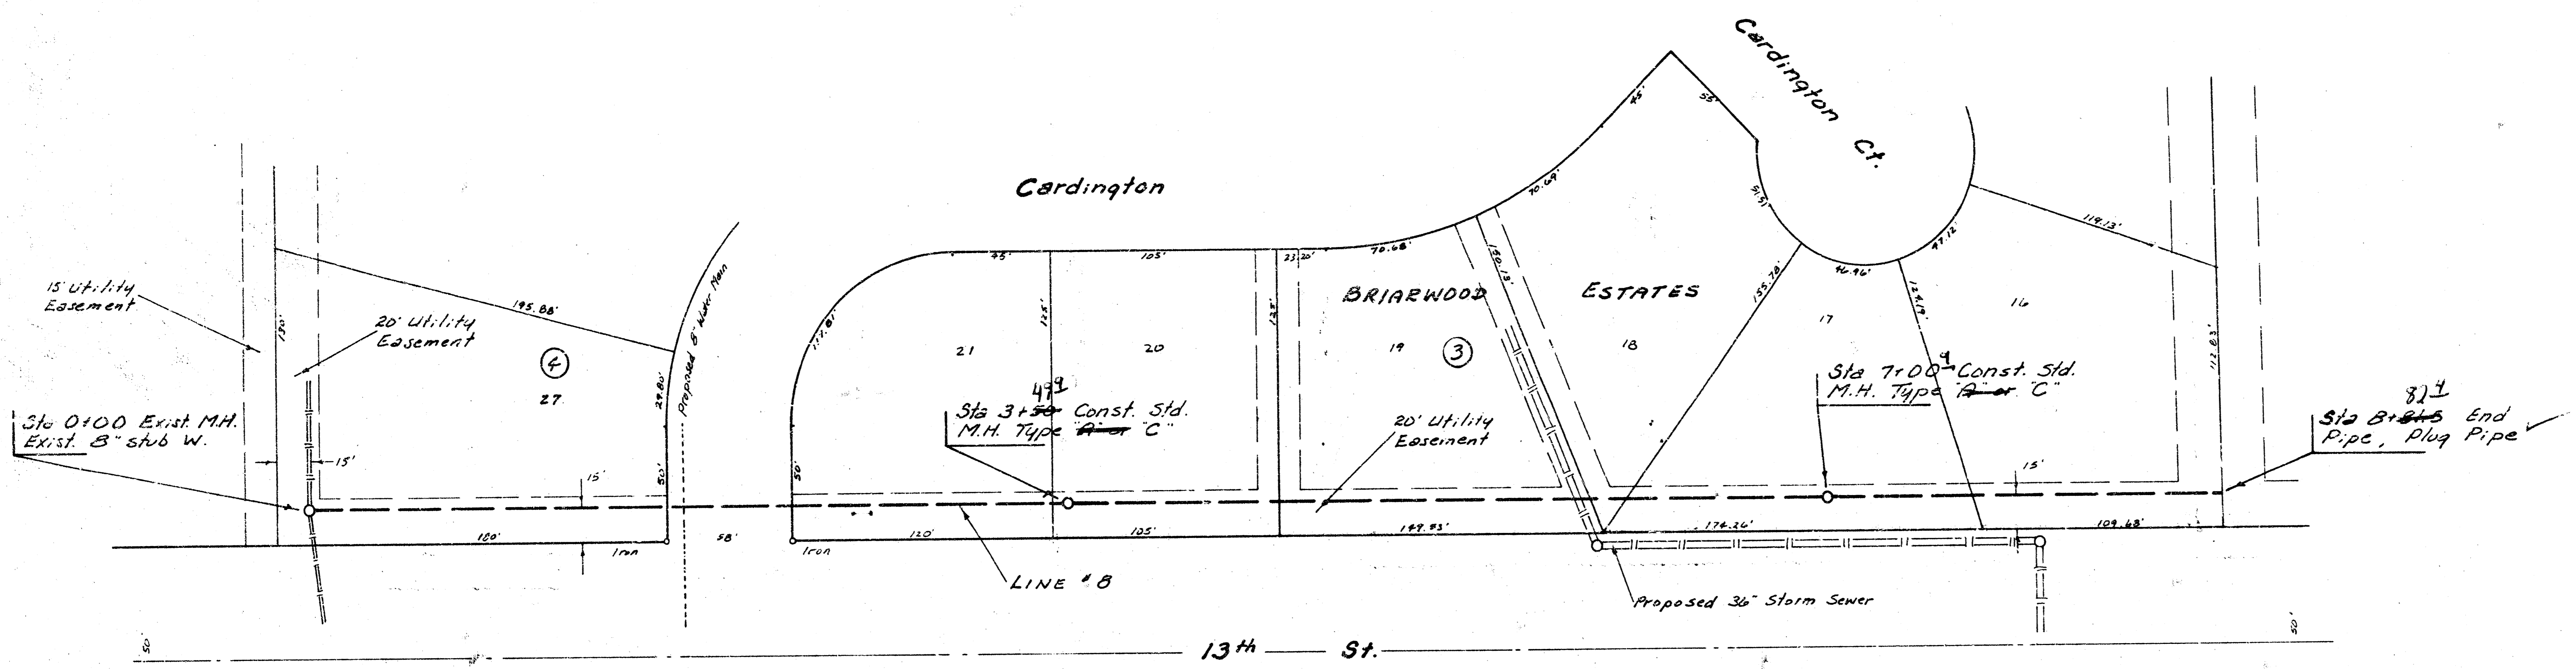

Scale Plan 1" = 40'
 Profile 1" = 40' Horiz.
 1" = 5' Vert.

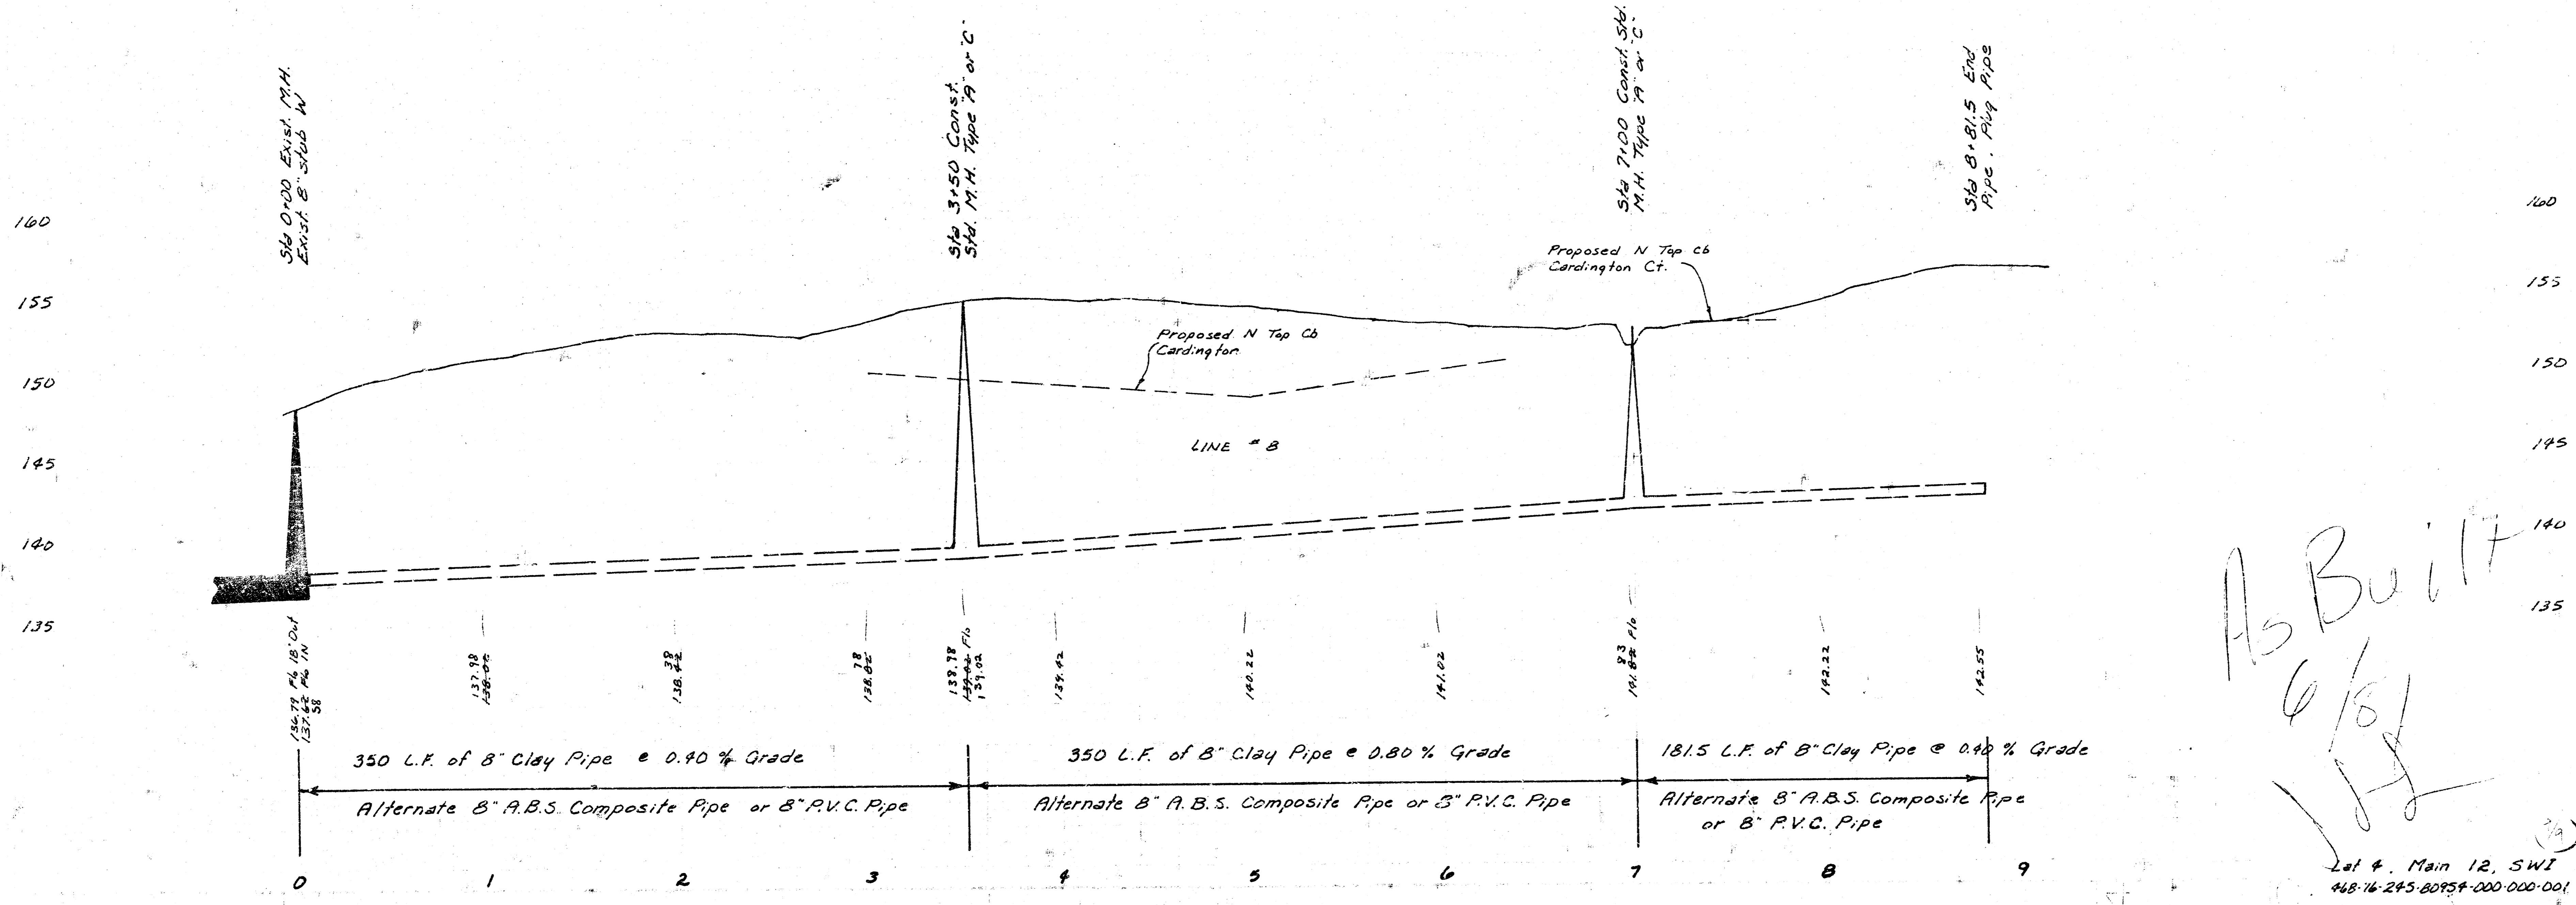

As Built
 6/8/11
 [Signature]

Lot 4, Main 12, SWI
 448-16-245-80954-000-000-001