


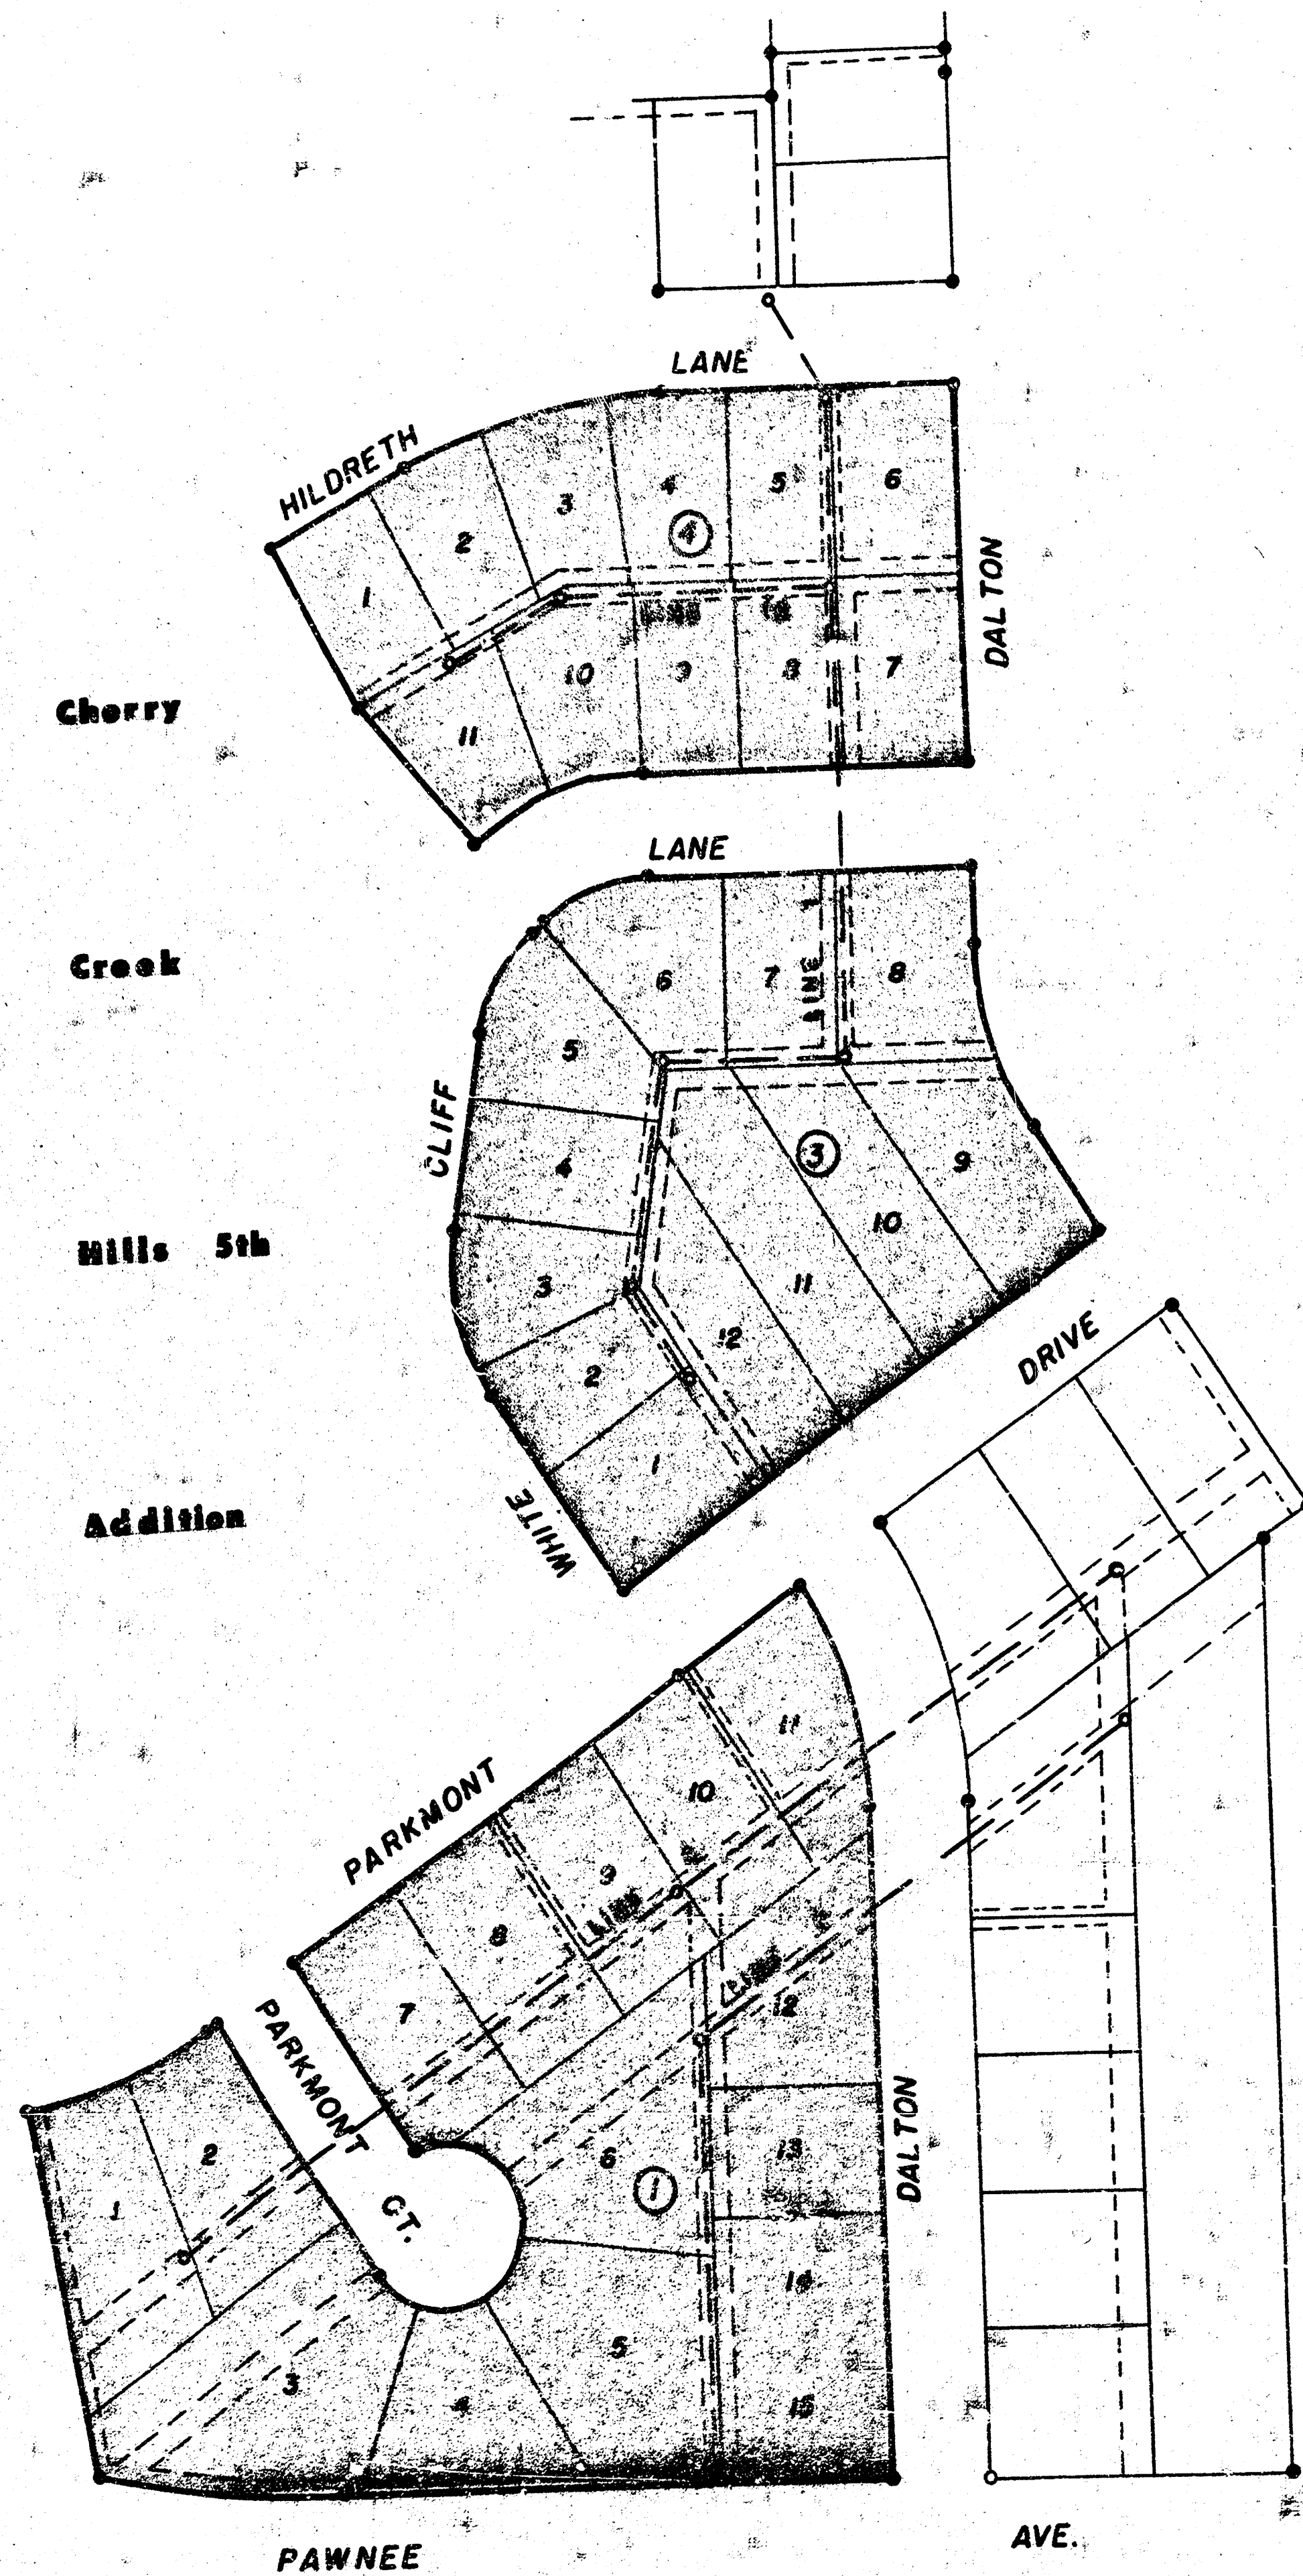

IMPROVEMENT DISTRICT

LATERAL 72, WAR INDUSTRIES SEWER

PROJECT NO. 468-76-245-81161-000-000-001

CITY OF WICHITA, KANSAS

R. W. BRUGGEMAN DIRECTOR OF ENGINEERING / CITY ENGINEERING


As Built
J.L.L.
11-82

SHEET INDEX

- TITLE - SHEET 1
- LINE 1 - SHEET 2
- LINE 1A - SHEET 3
- LINE 2 - SHEET 4
- LINE 3 - SHEET 5

THE CONTRACTOR SHALL BE RESPONSIBLE FOR PRESERVING PROPERTY IRONS. THE CONTRACTOR SHALL BE REQUIRED TO RE-ESTABLISH ANY PROPERTY IRONS WHICH ARE DAMAGED OR DESTROYED BY HIS CONSTRUCTION OPERATIONS. SUCH IRONS SHALL BE RE-ESTABLISHED BY A LICENSED LAND SURVEYOR OR A LICENSED PROFESSIONAL ENGINEER IN ACCORDANCE WITH STATE LAWS.

INSTALLED TO SERVE INDIVIDUAL LOTS OR TRACTS IN ANY SEWER CONSTRUCTION, UNLESS OTHERWISE ORDERED BY PERMIT OWNER WITH THE CONCURRENCE OF THE ENGINEER. REQUIRED TO FILE WRITTEN DOCUMENTATION WITH THE ENGINEER. THE ENGINEER ENDORSEMENT LOCATIONS WHERE RISERS ARE REQUESTED BY THE PROPERTY OWNER OR HIS AUTHORIZED REPRESENTATIVE SHALL CONFORM TO THE REQUIREMENTS AS SHOWN RISER DETAIL SHEET.

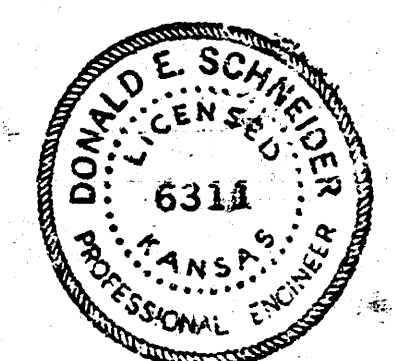



Scale: 1" = 40' Plan
1" = 40' Horiz.
1" = 5' Profile

THE CONTRACTOR SHALL BE RESPONSIBLE FOR PRESERVING PROPERTY IRONS. THE CONTRACTOR SHALL BE REQUIRED TO RE-ESTABLISH ANY PROPERTY IRONS WHICH ARE DAMAGED OR DESTROYED BY HIS CONSTRUCTION OPERATIONS. SUCH IRONS SHALL BE RE-ESTABLISHED BY A LICENSED LAND SURVEYOR OR A LICENSED PROFESSIONAL ENGINEER IN ACCORDANCE WITH STATE LAWS.

BENCH MARKS

- 171.46 N. Rim. M.H. Sta. (1-33) Line 1, Lot 12, W15.
- 5' N. & 5' W. of NE Cor. Lot 7, Blk 3, Cherry Creek 5th
- 179.84 N. Rim. M.H. Sta. 0+00 Line 2, Lot 12, W15.
- 192.20 City Std. Pawnee and West Parkway, 1/4 mile East of Rock Rd., 48' S & 2' E. of 1/4 Sec. Cor.

As Built
J.L.L.
11-82

Sta. 7+53.8 Const. Std. M.H., Type A or C Top Elev. of M.H. = 184.0 - 183.56

Sta. 8+15.5 Const. Std. M.H., Type A or C. Install 4" Stub, SW Top Elev. of M.H. = 184.0


Sta. 4+84.3 Const. Std. M.H., Type A or C. Install 4" Stub, SE Top Elev. of M.H. = 184.4

Sta. 0+70.3 Const. Std. M.H., Type A or C. Top Elev. of M.H. = 174.9 - 175.19


Sta. 0+00 Const. Std. M.H., Type A or C. Connect to existing 8" Line. Top Elev. of M.H. = 175.31

Sta. 1+90.3 Line 1 - Sta. 0+00 Line 1A Const. Std. M.H., Type A or C. Inside Drop. Top Elev. of M.H. = 176.24

Sta. 6+07.1 Const. Std. M.H., Type A or C. Top Elev. of M.H. = 180.98

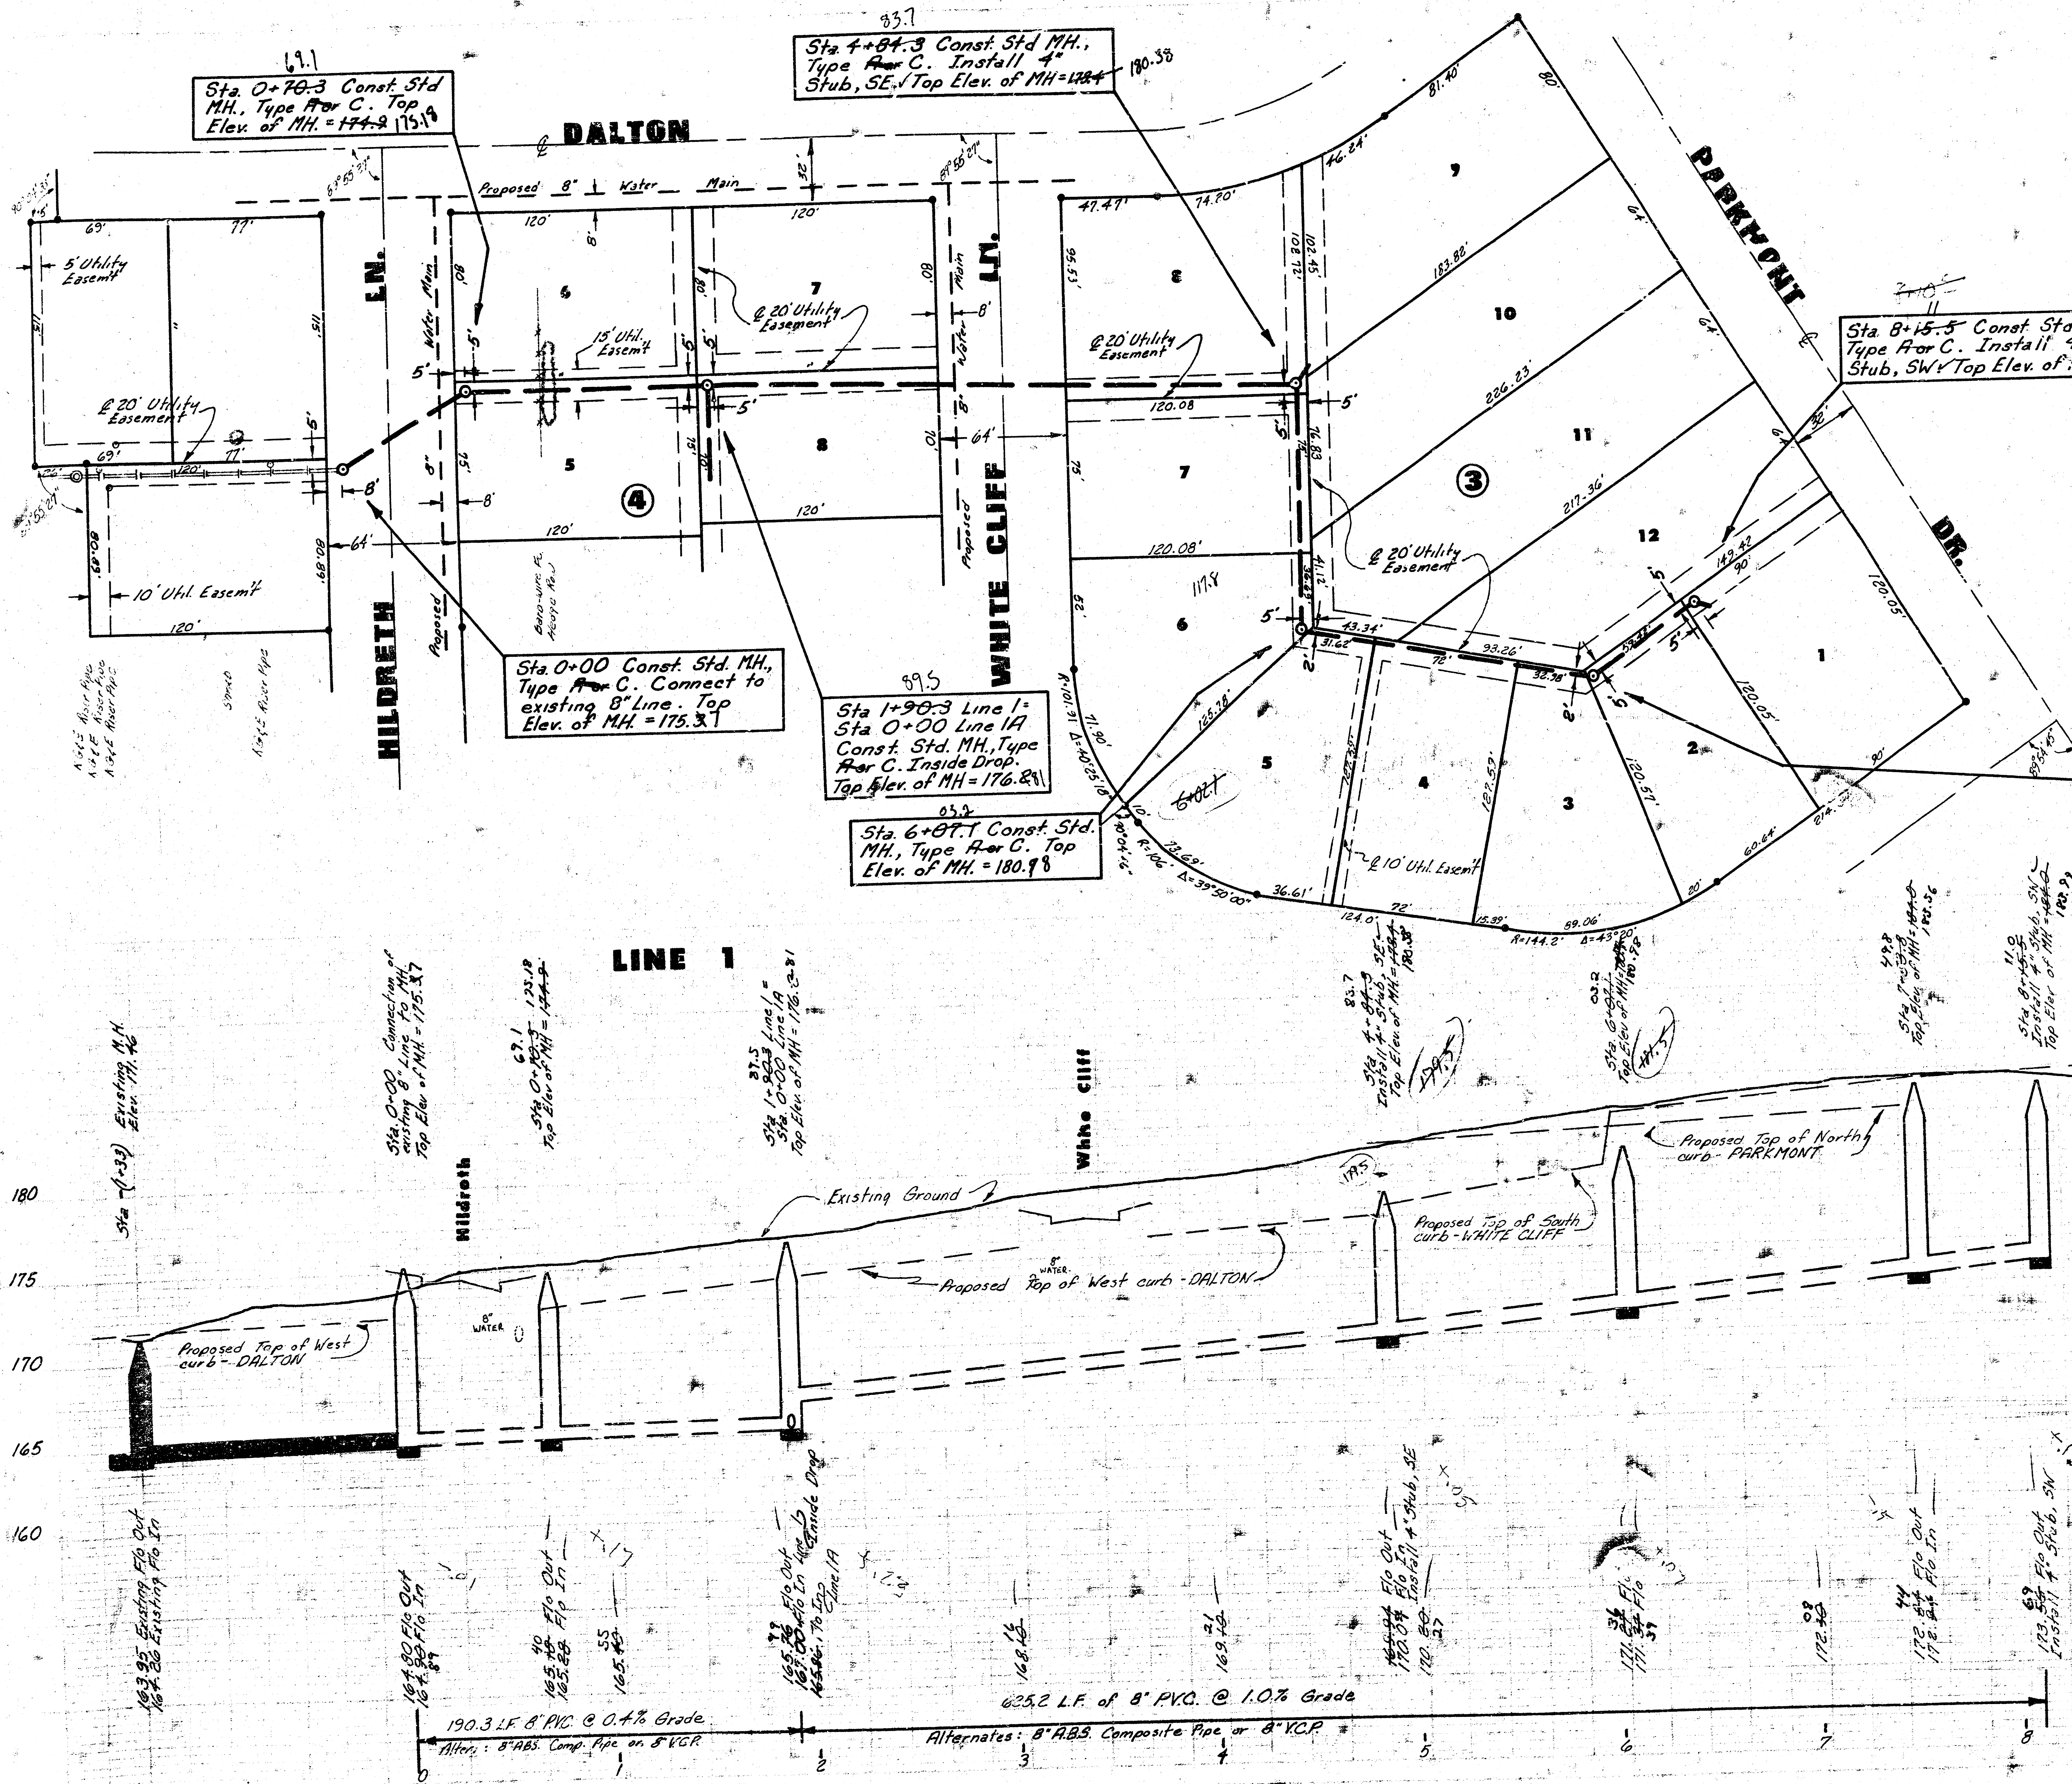

PROJECT DESCRIPTION
LATERAL 72, W.I.S.
PROJECT NUMBER
468-76-245-81161-000-001

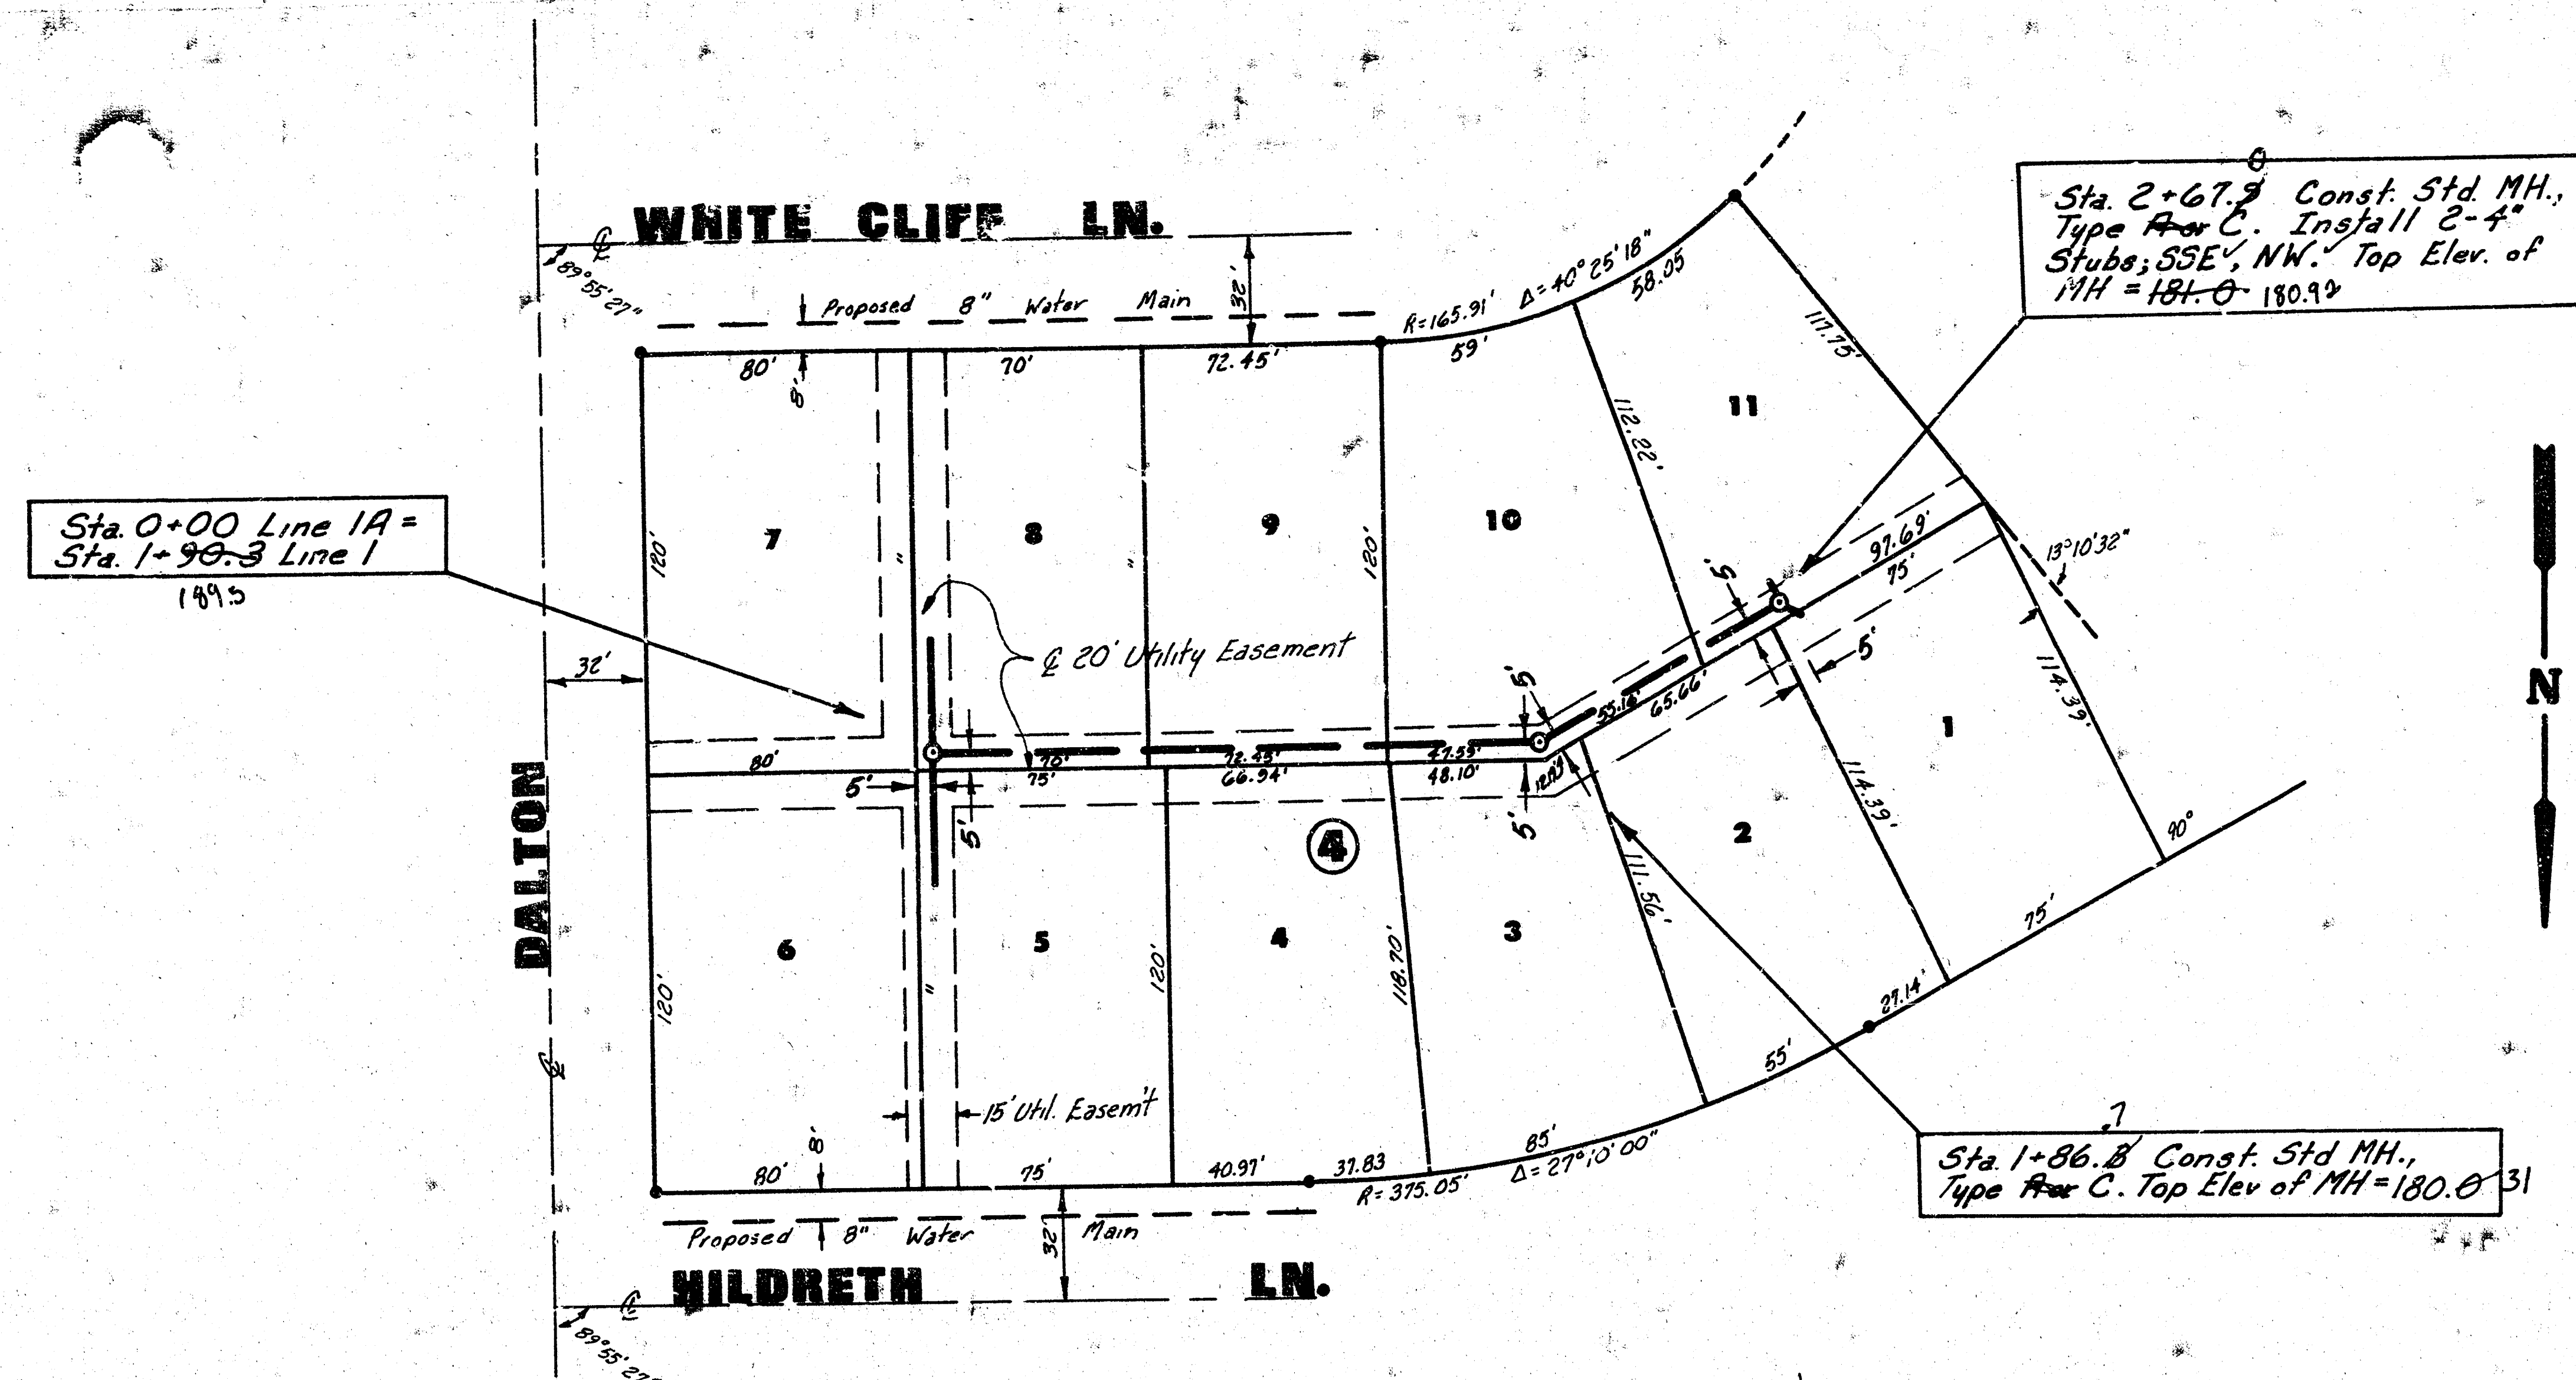


THE CONTRACTOR SHALL BE RESPONSIBLE FOR PRESERVING PROPERTY IRONS. THE CONTRACTOR SHALL BE REQUIRED TO RE-ESTABLISH ANY PROPERTY IRONS WHICH ARE DAMAGED OR DESTROYED BY HIS CONSTRUCTION OPERATIONS. SUCH IRONS SHALL BE RE-ESTABLISHED BY A LICENSED LAND SURVEYOR OR A LICENSED PROFESSIONAL ENGINEER IN ACCORDANCE WITH STATE LAWS.



As Built
J.L.L.
11-82

LINE 1A

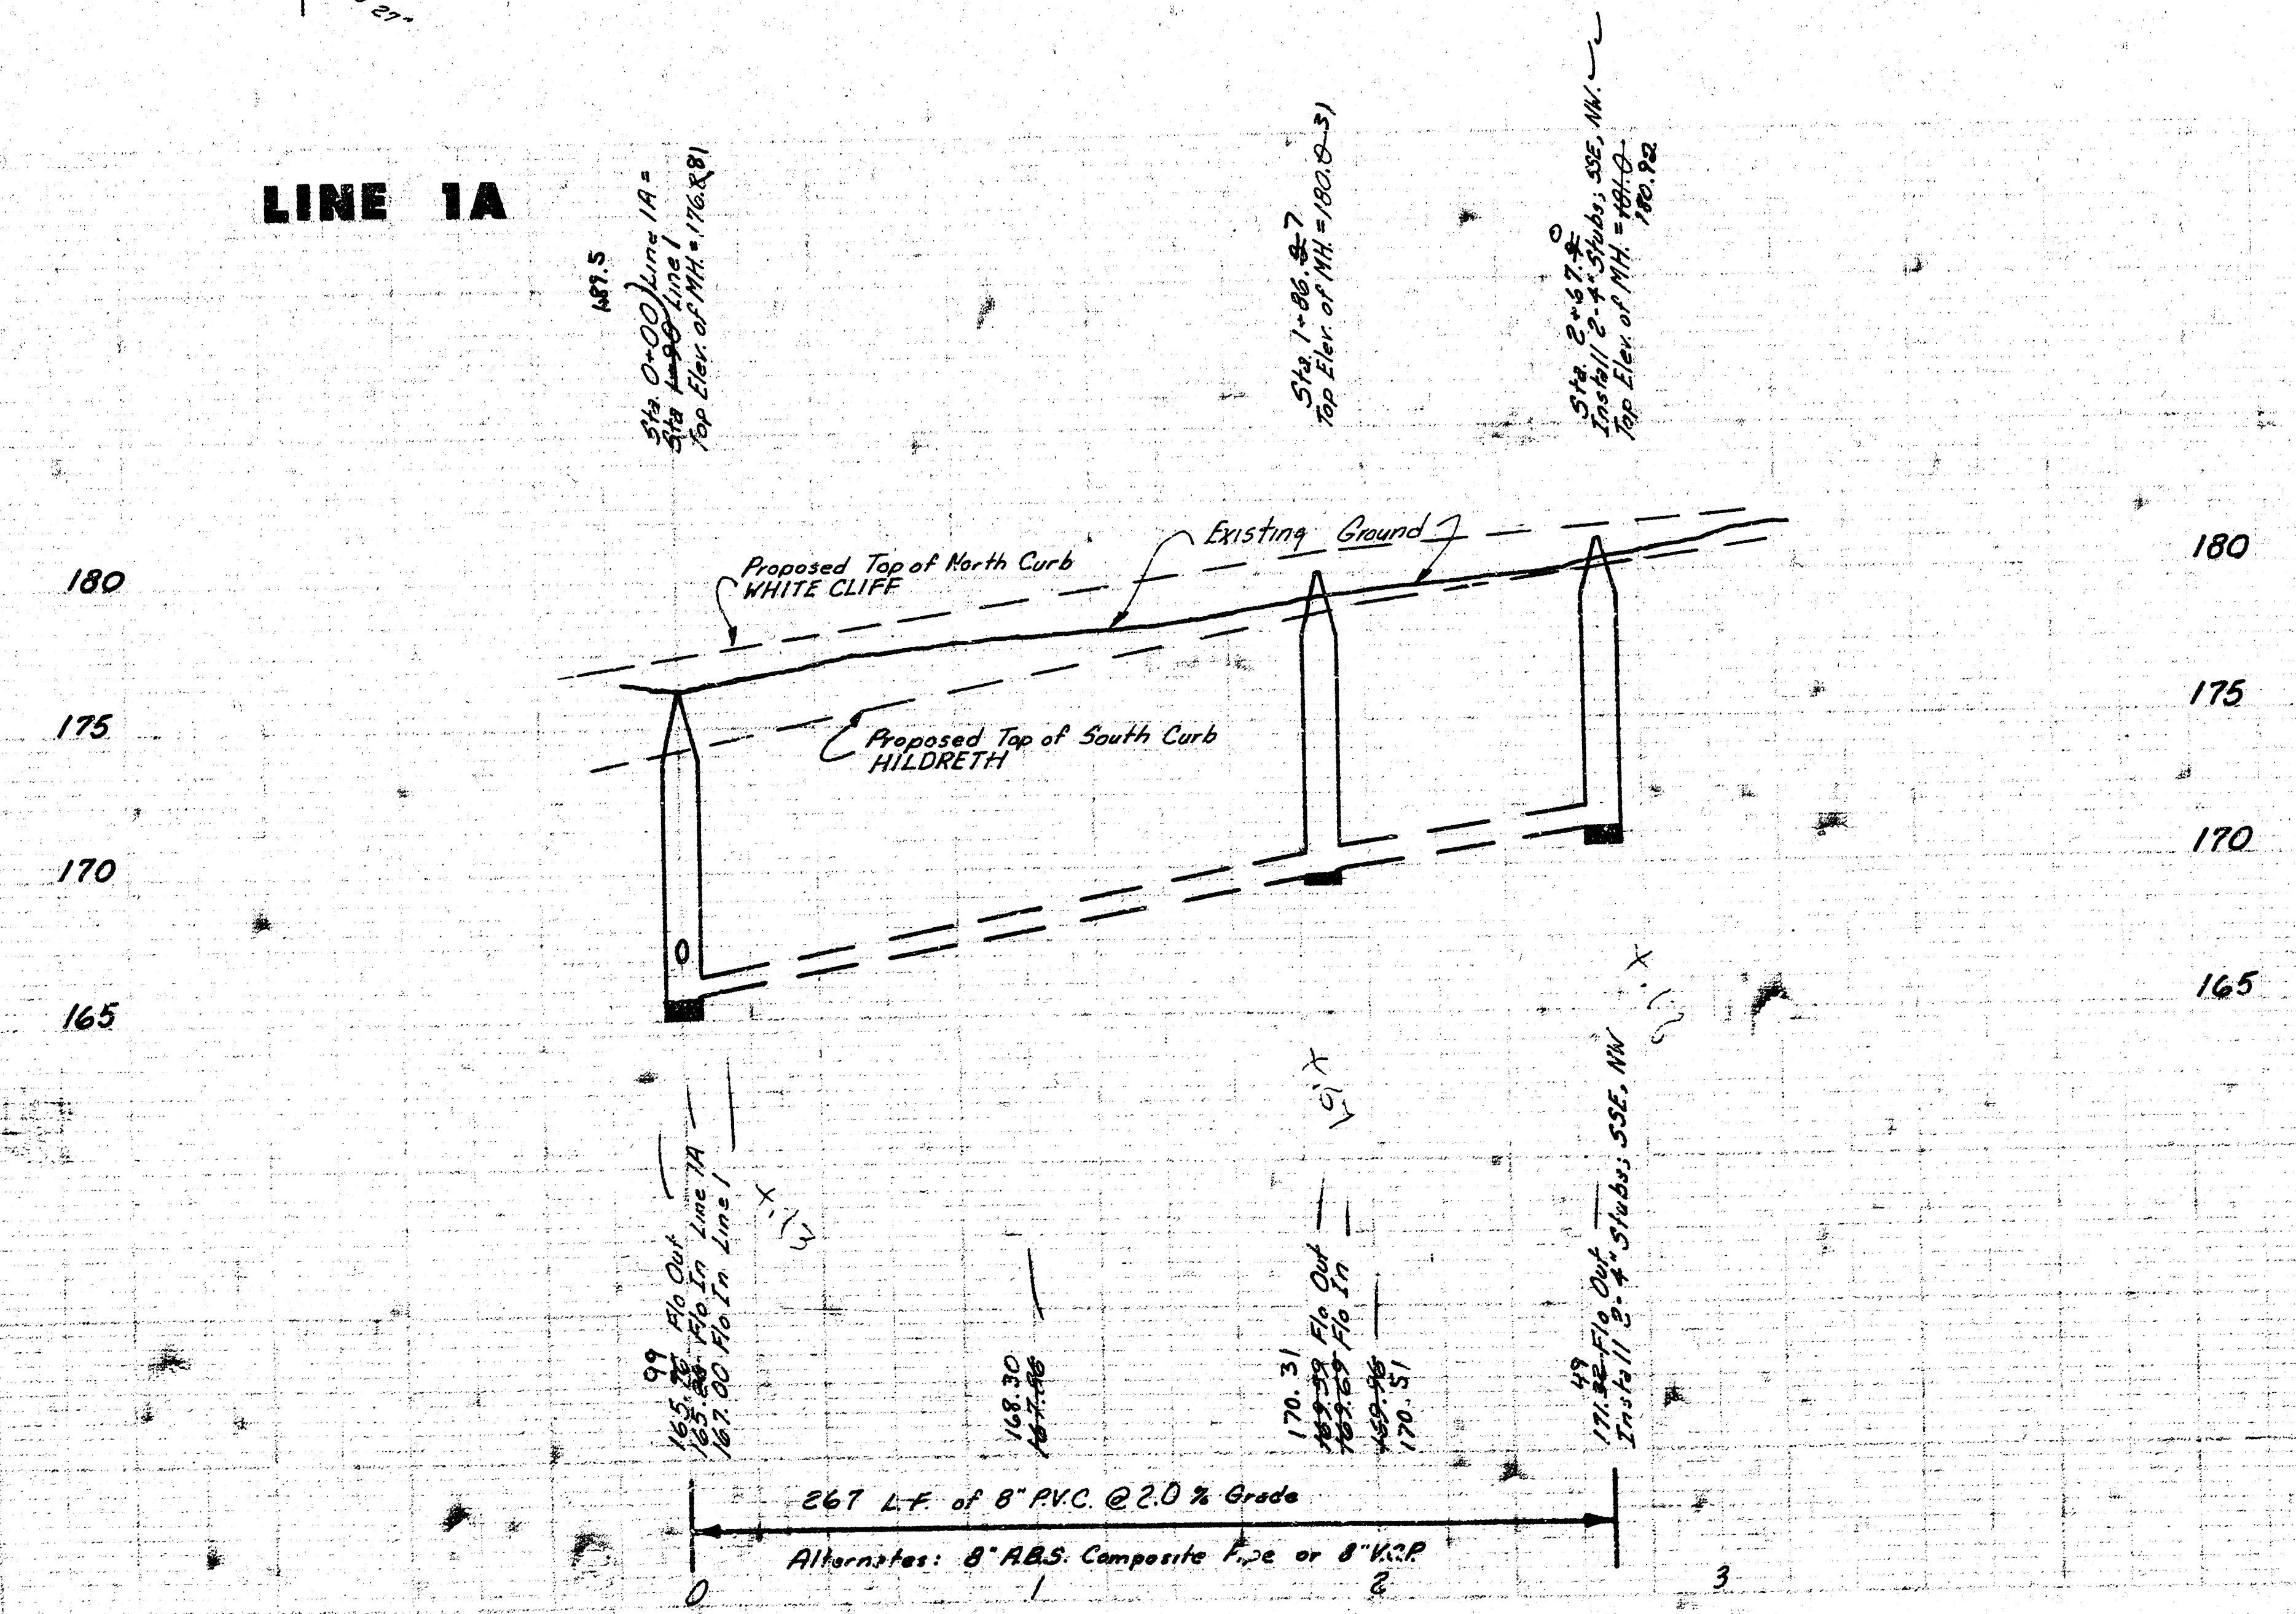


PROJECT DESCRIPTION

LATERAL 72, W.I.S.

PROJECT NUMBER


468-76-245-81161-000-000-001

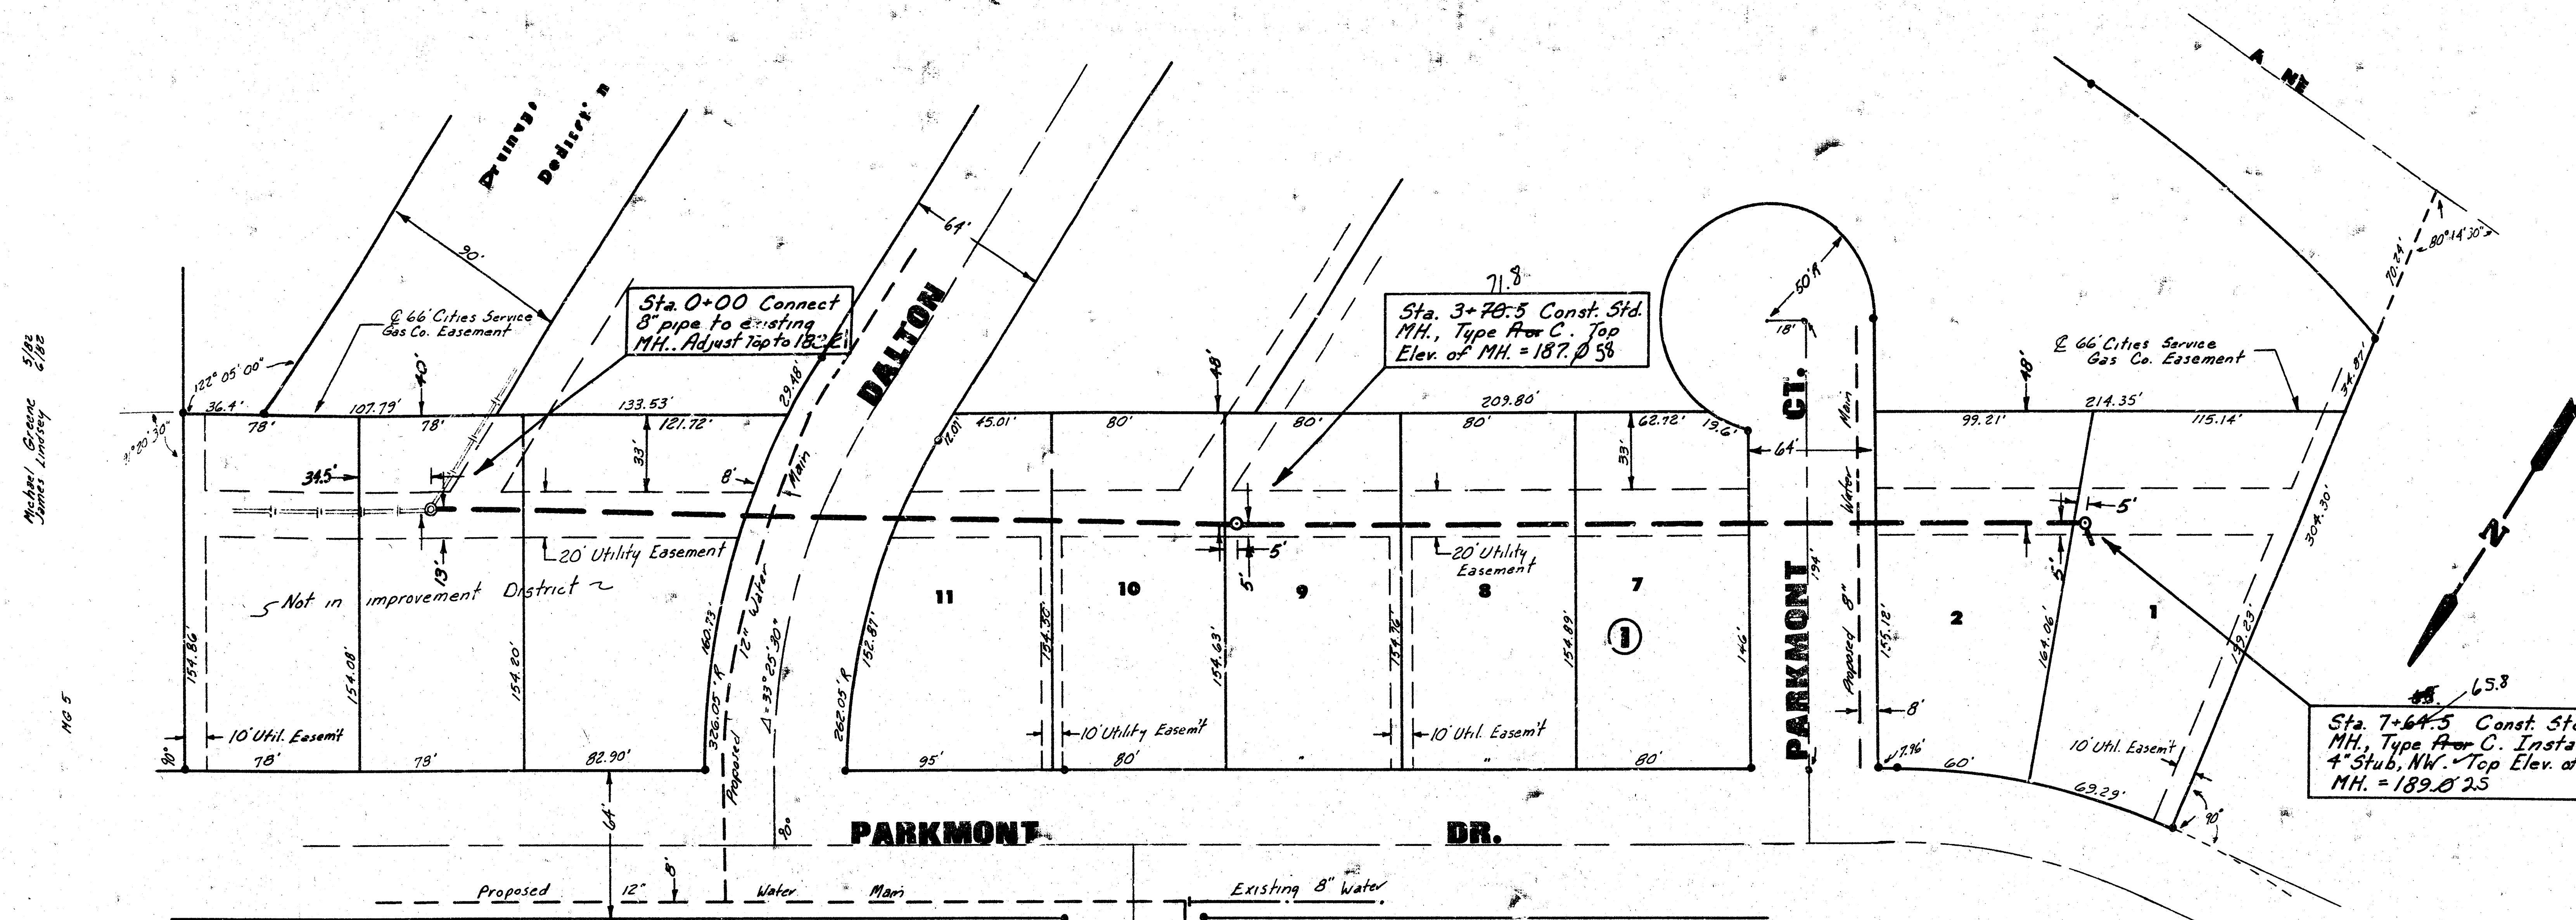

Scale: 1" = 40' Plan
1" = 40' Profile
1" = 5' Profile

THE CONTRACTOR SHALL BE RESPONSIBLE FOR PRESERVING PROPERTY IRONS. THE CONTRACTOR SHALL BE REQUIRED TO RE-ESTABLISH ANY PROPERTY IRONS WHICH ARE DAMAGED OR DESTROYED BY HIS CONSTRUCTION OPERATIONS. SUCH IRONS SHALL BE RE-ESTABLISHED BY A LICENSED LAND SURVEYOR OR A LICENSED PROFESSIONAL ENGINEER IN ACCORDANCE WITH STATE LAWS.


As Bld. It
J.L.L.
11-82

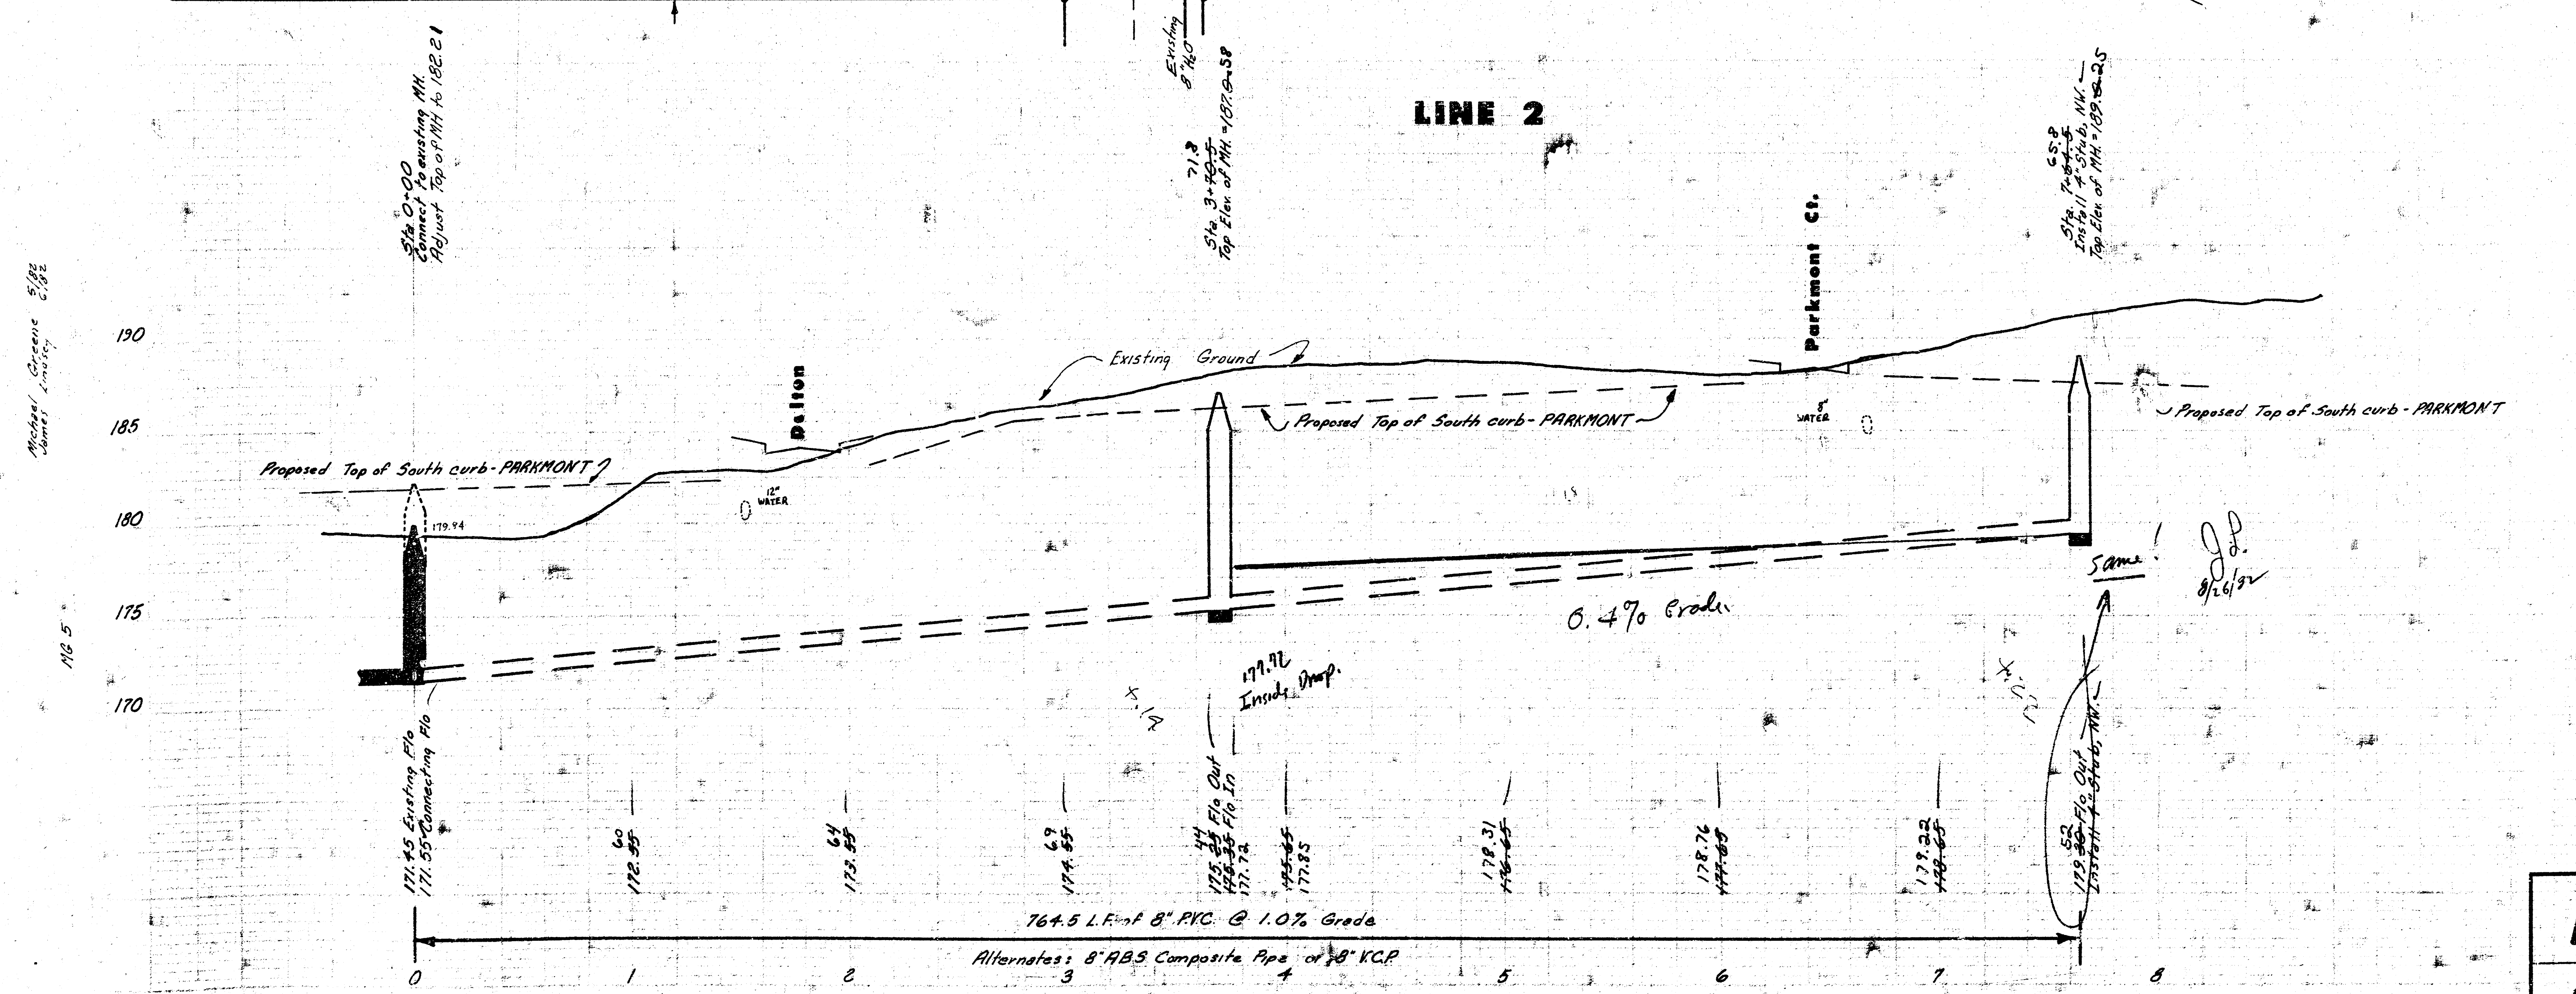


PROJECT DESCRIPTION
LATERAL 72, W.I.S.
PROJECT NUMBER
468-76-245-81161-000-000-001 4/5

Scale: 1"=40' Plan
 Horiz. 1"=40' Profile
 Vert. 1"=5' Profile

THE CONTRACTOR SHALL BE RESPONSIBLE FOR PRESERVING PROPERTY IRONS. THE CONTRACTOR SHALL BE REQUIRED TO RE-ESTABLISH ANY PROPERTY IRONS WHICH ARE DAMAGED OR DESTROYED BY HIS CONSTRUCTION OPERATIONS. SUCH IRONS SHALL BE RE-ESTABLISHED BY A LICENSED LAND SURVEYOR OR A LICENSED PROFESSIONAL ENGINEER IN ACCORDANCE WITH STATE LAWS.

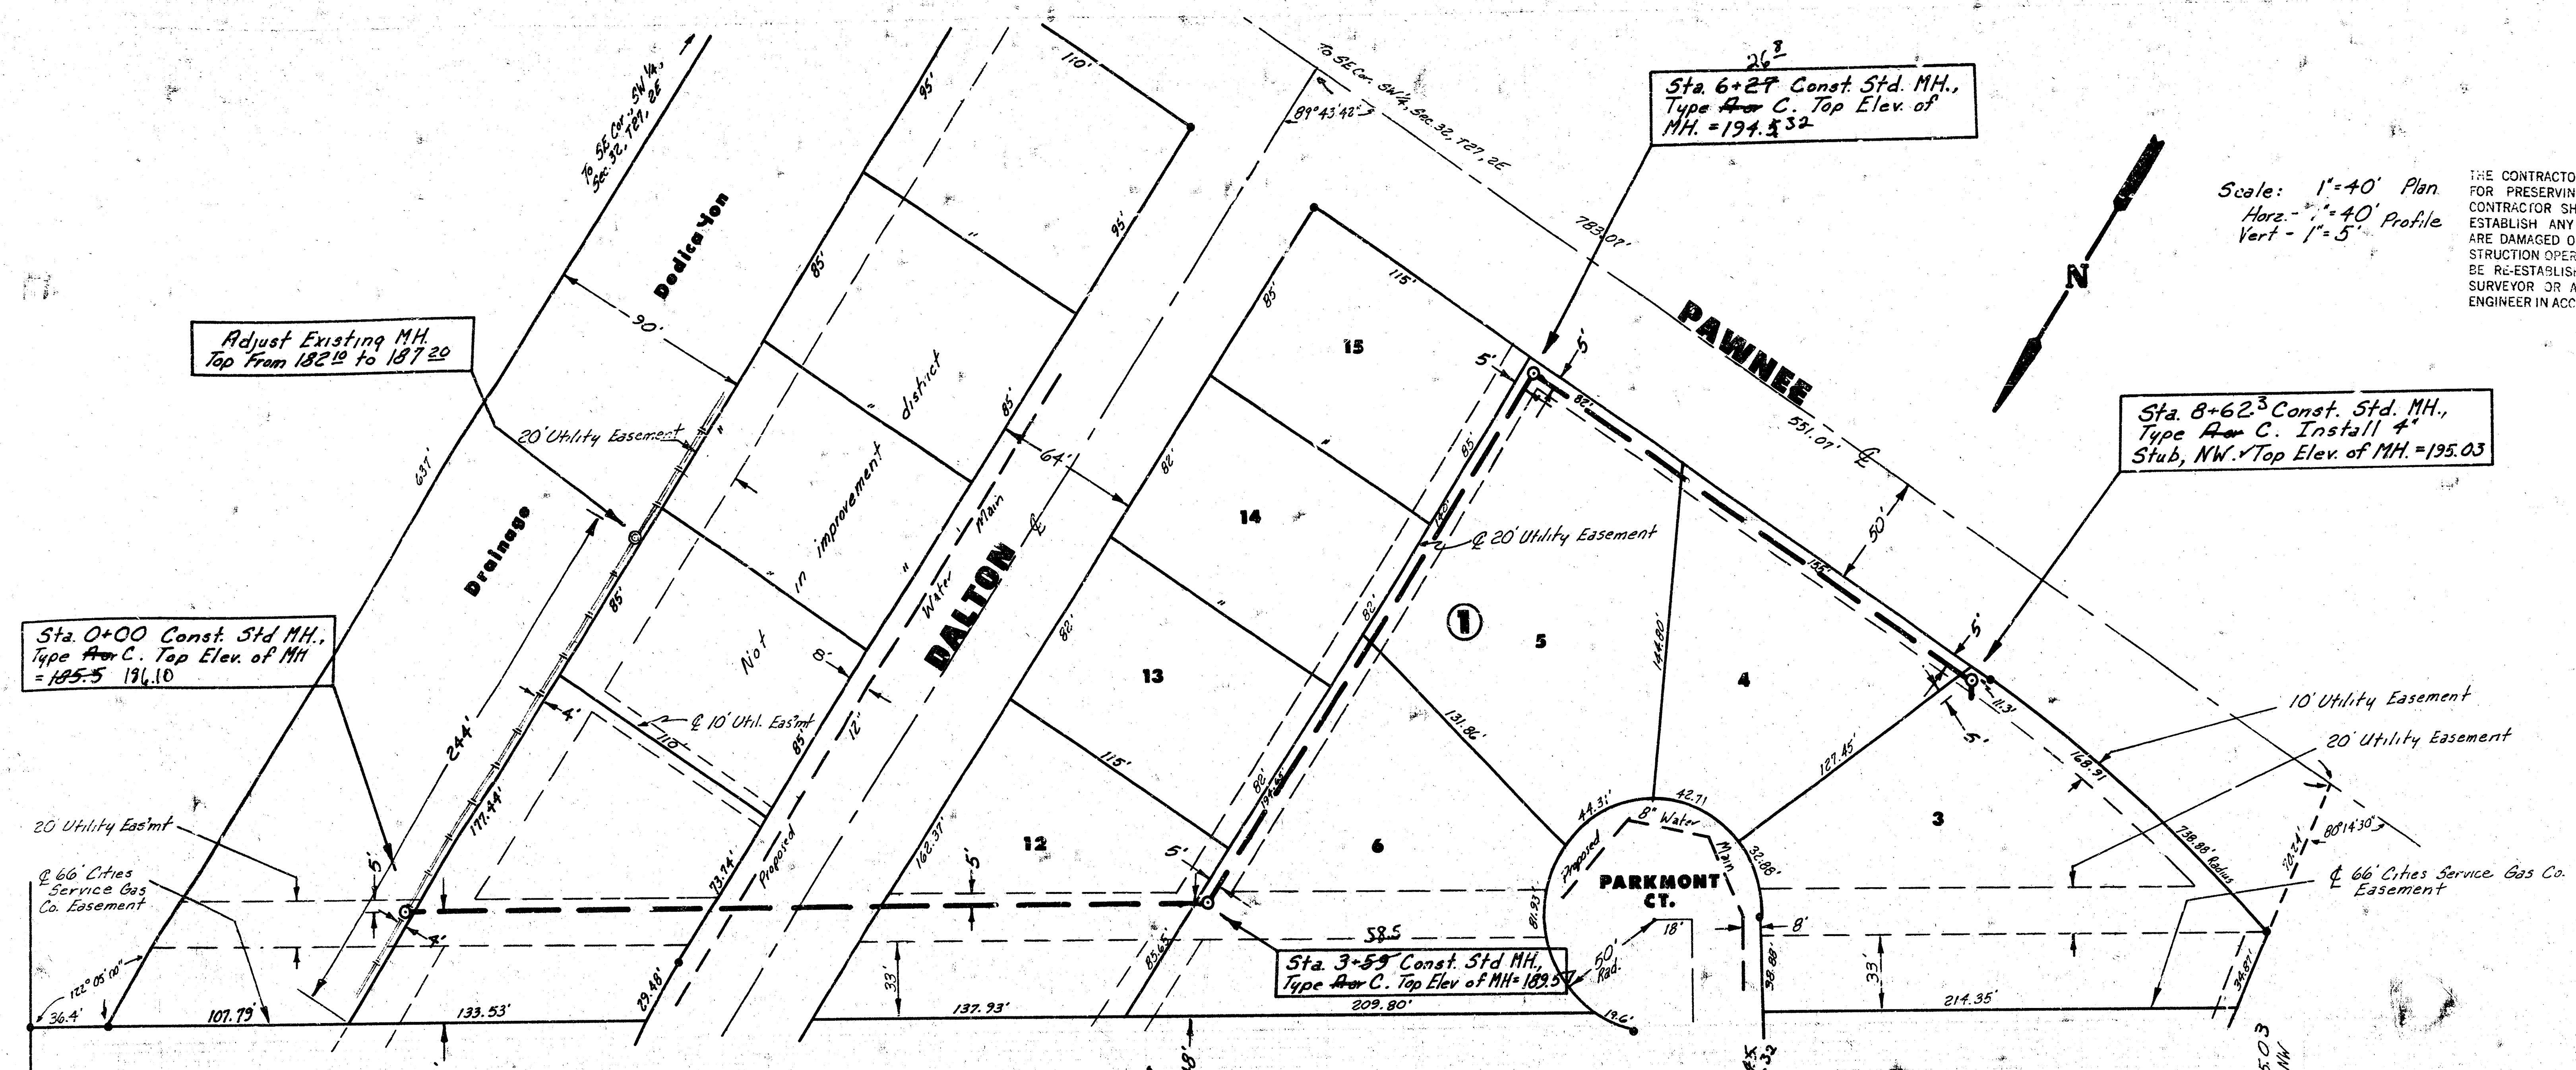

As Bui
 J.L.
 11/82

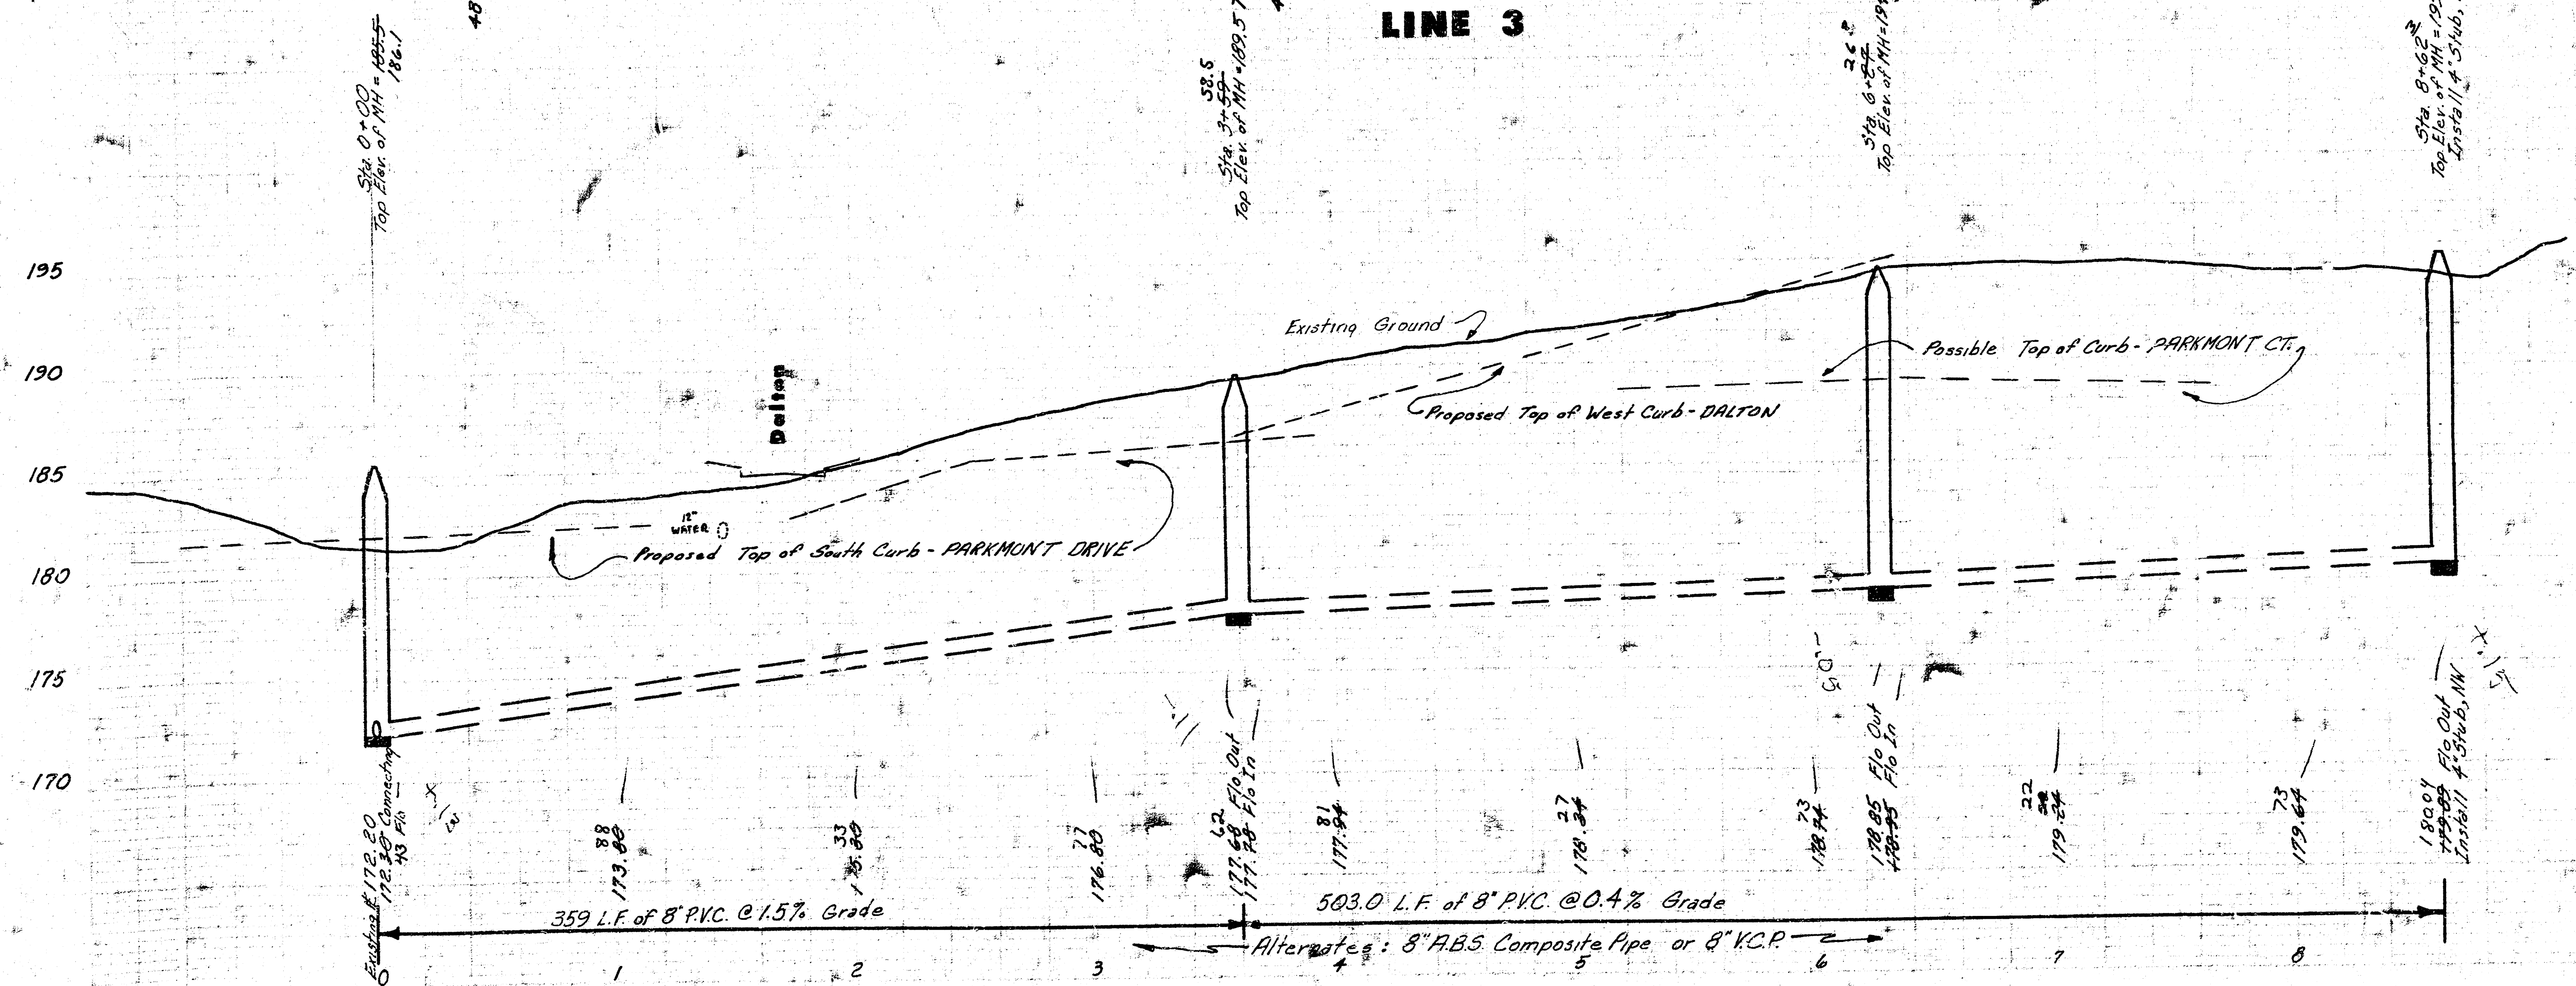

PROJECT DESCRIPTION	
LATERAL 72, W.I.S.	
PROJECT NUMBER	
468-76-245-81161-000-001 5/5	