

CONFORMED TO CONSTRUCTION RECORDS

PLANS FOR

SEWERAGE IMPROVEMENTS

WICHITA, KANSAS


SOUTHWEST INTERCEPTOR


CONTRACT NO. 1


PROJECT NO. 2844


BLACK & VEATCH
CONSULTING ENGINEERS
KANSAS CITY, MISSOURI


1968

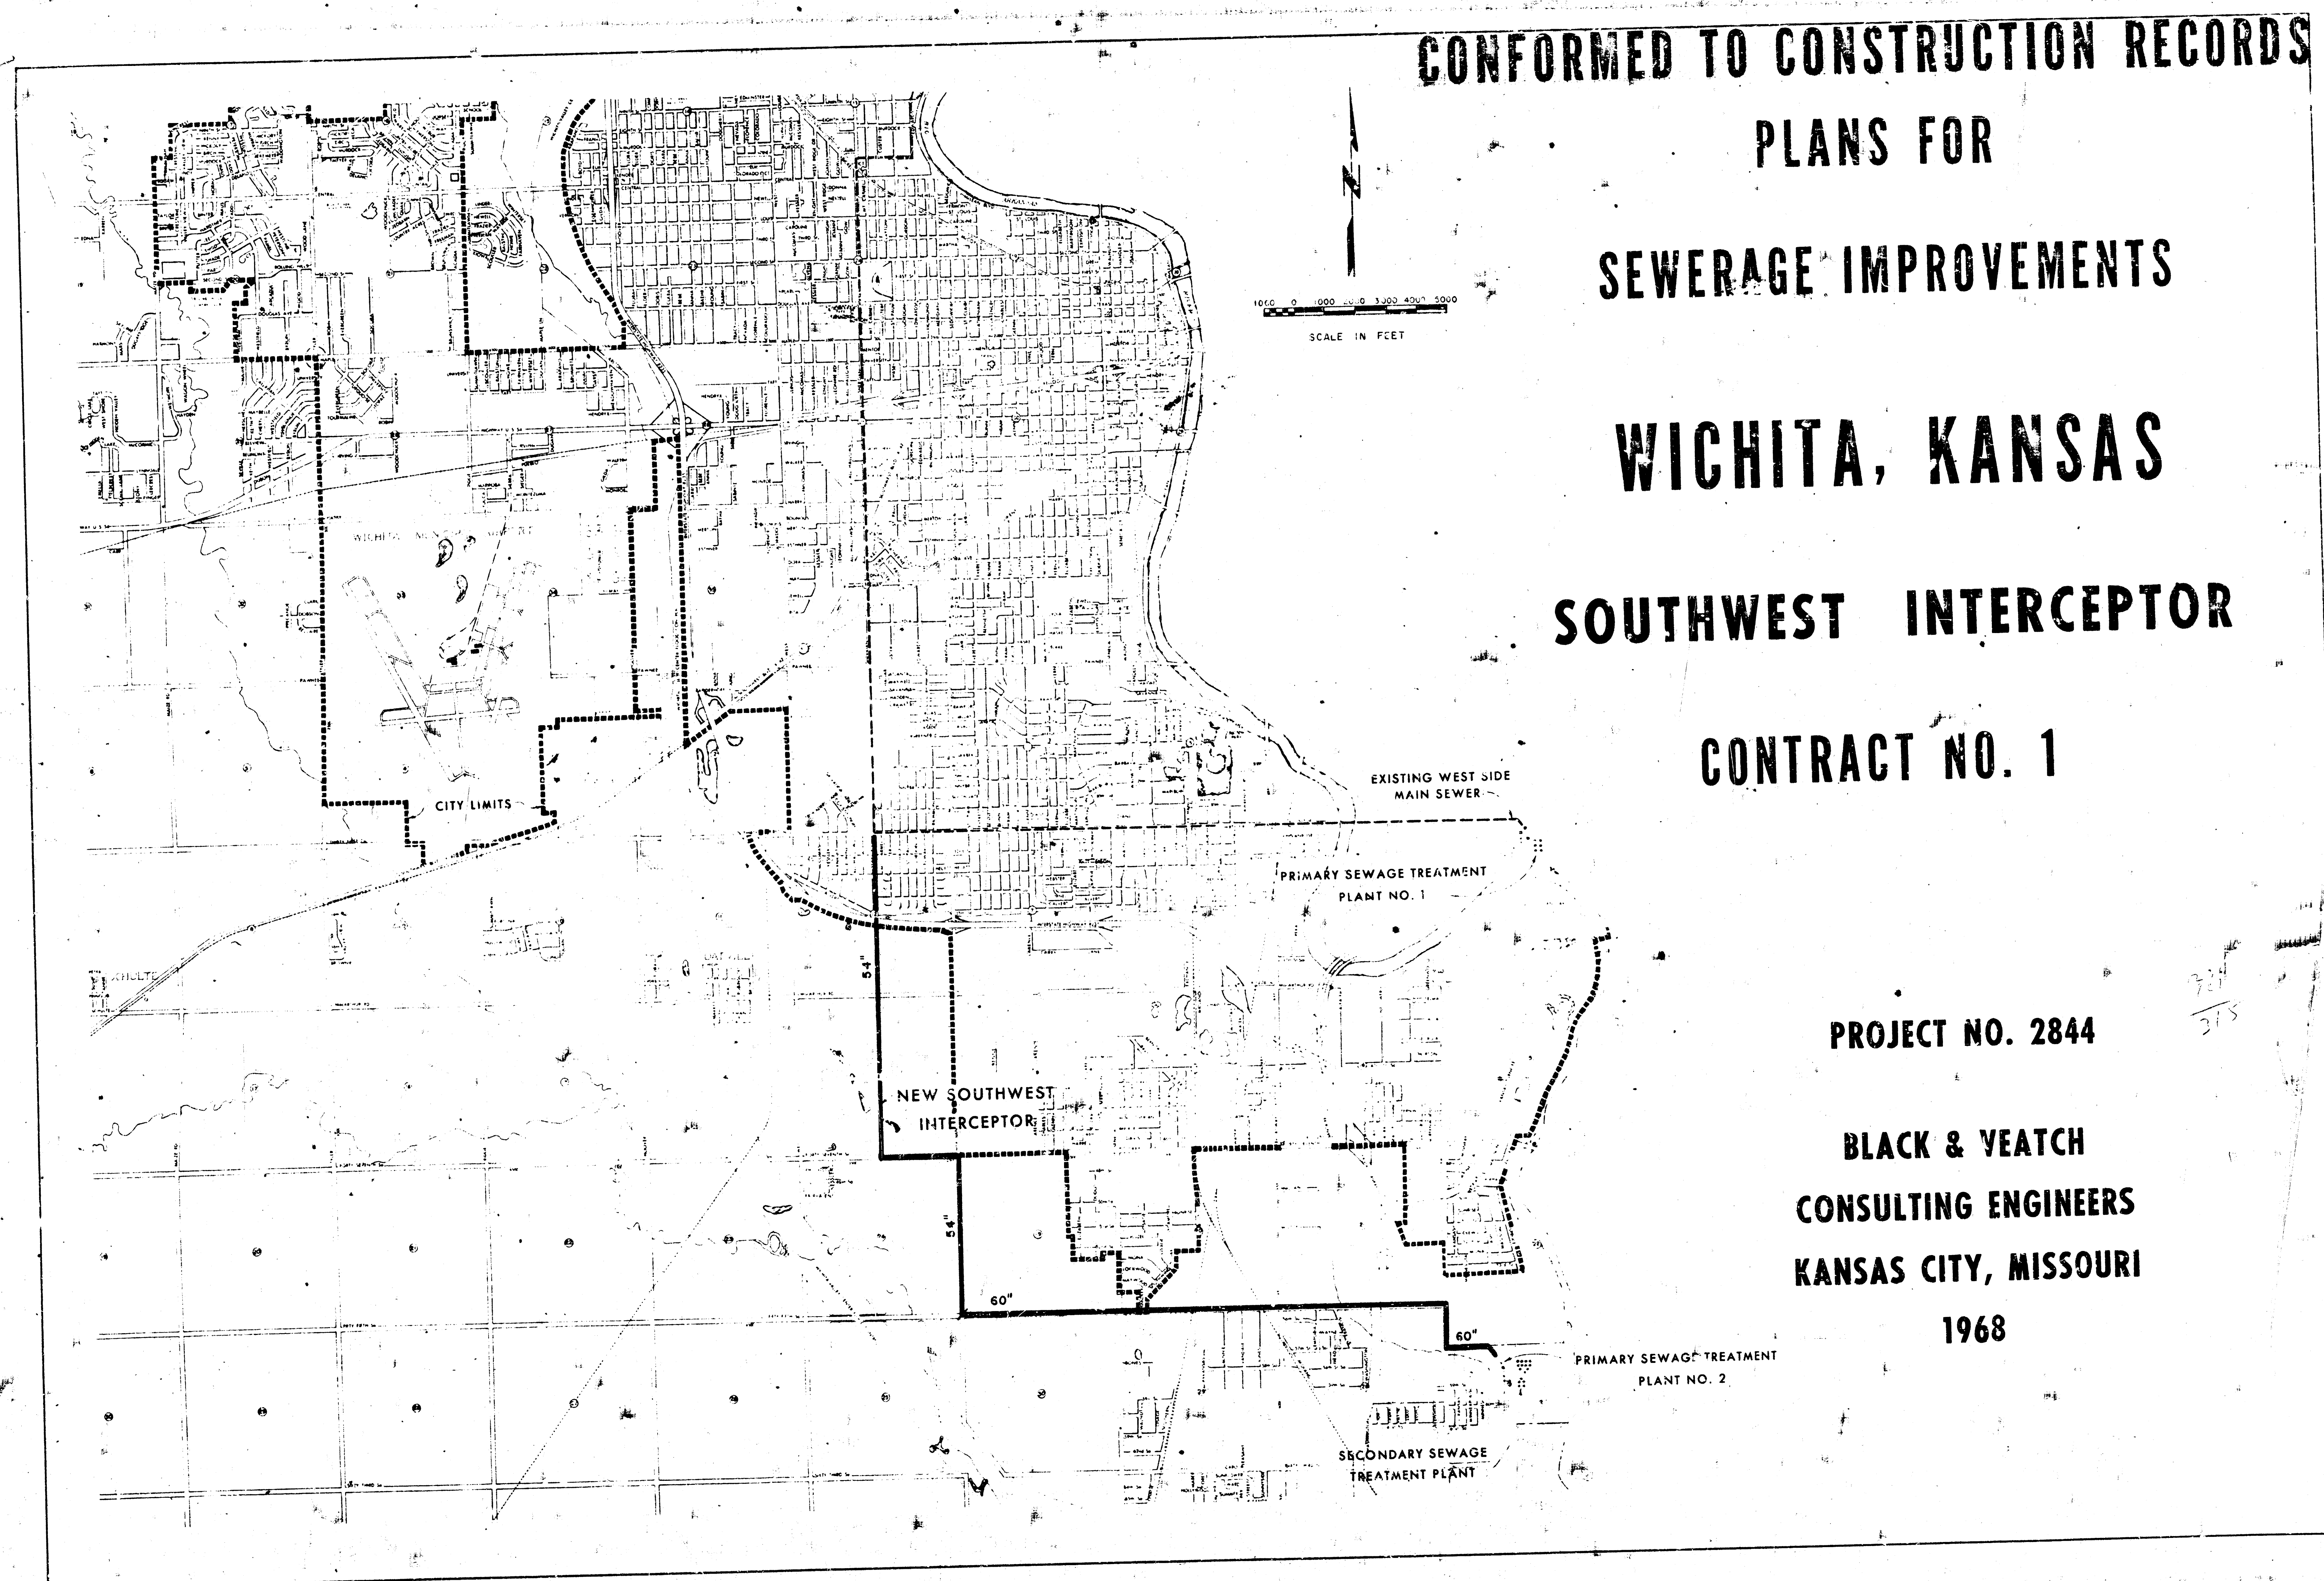


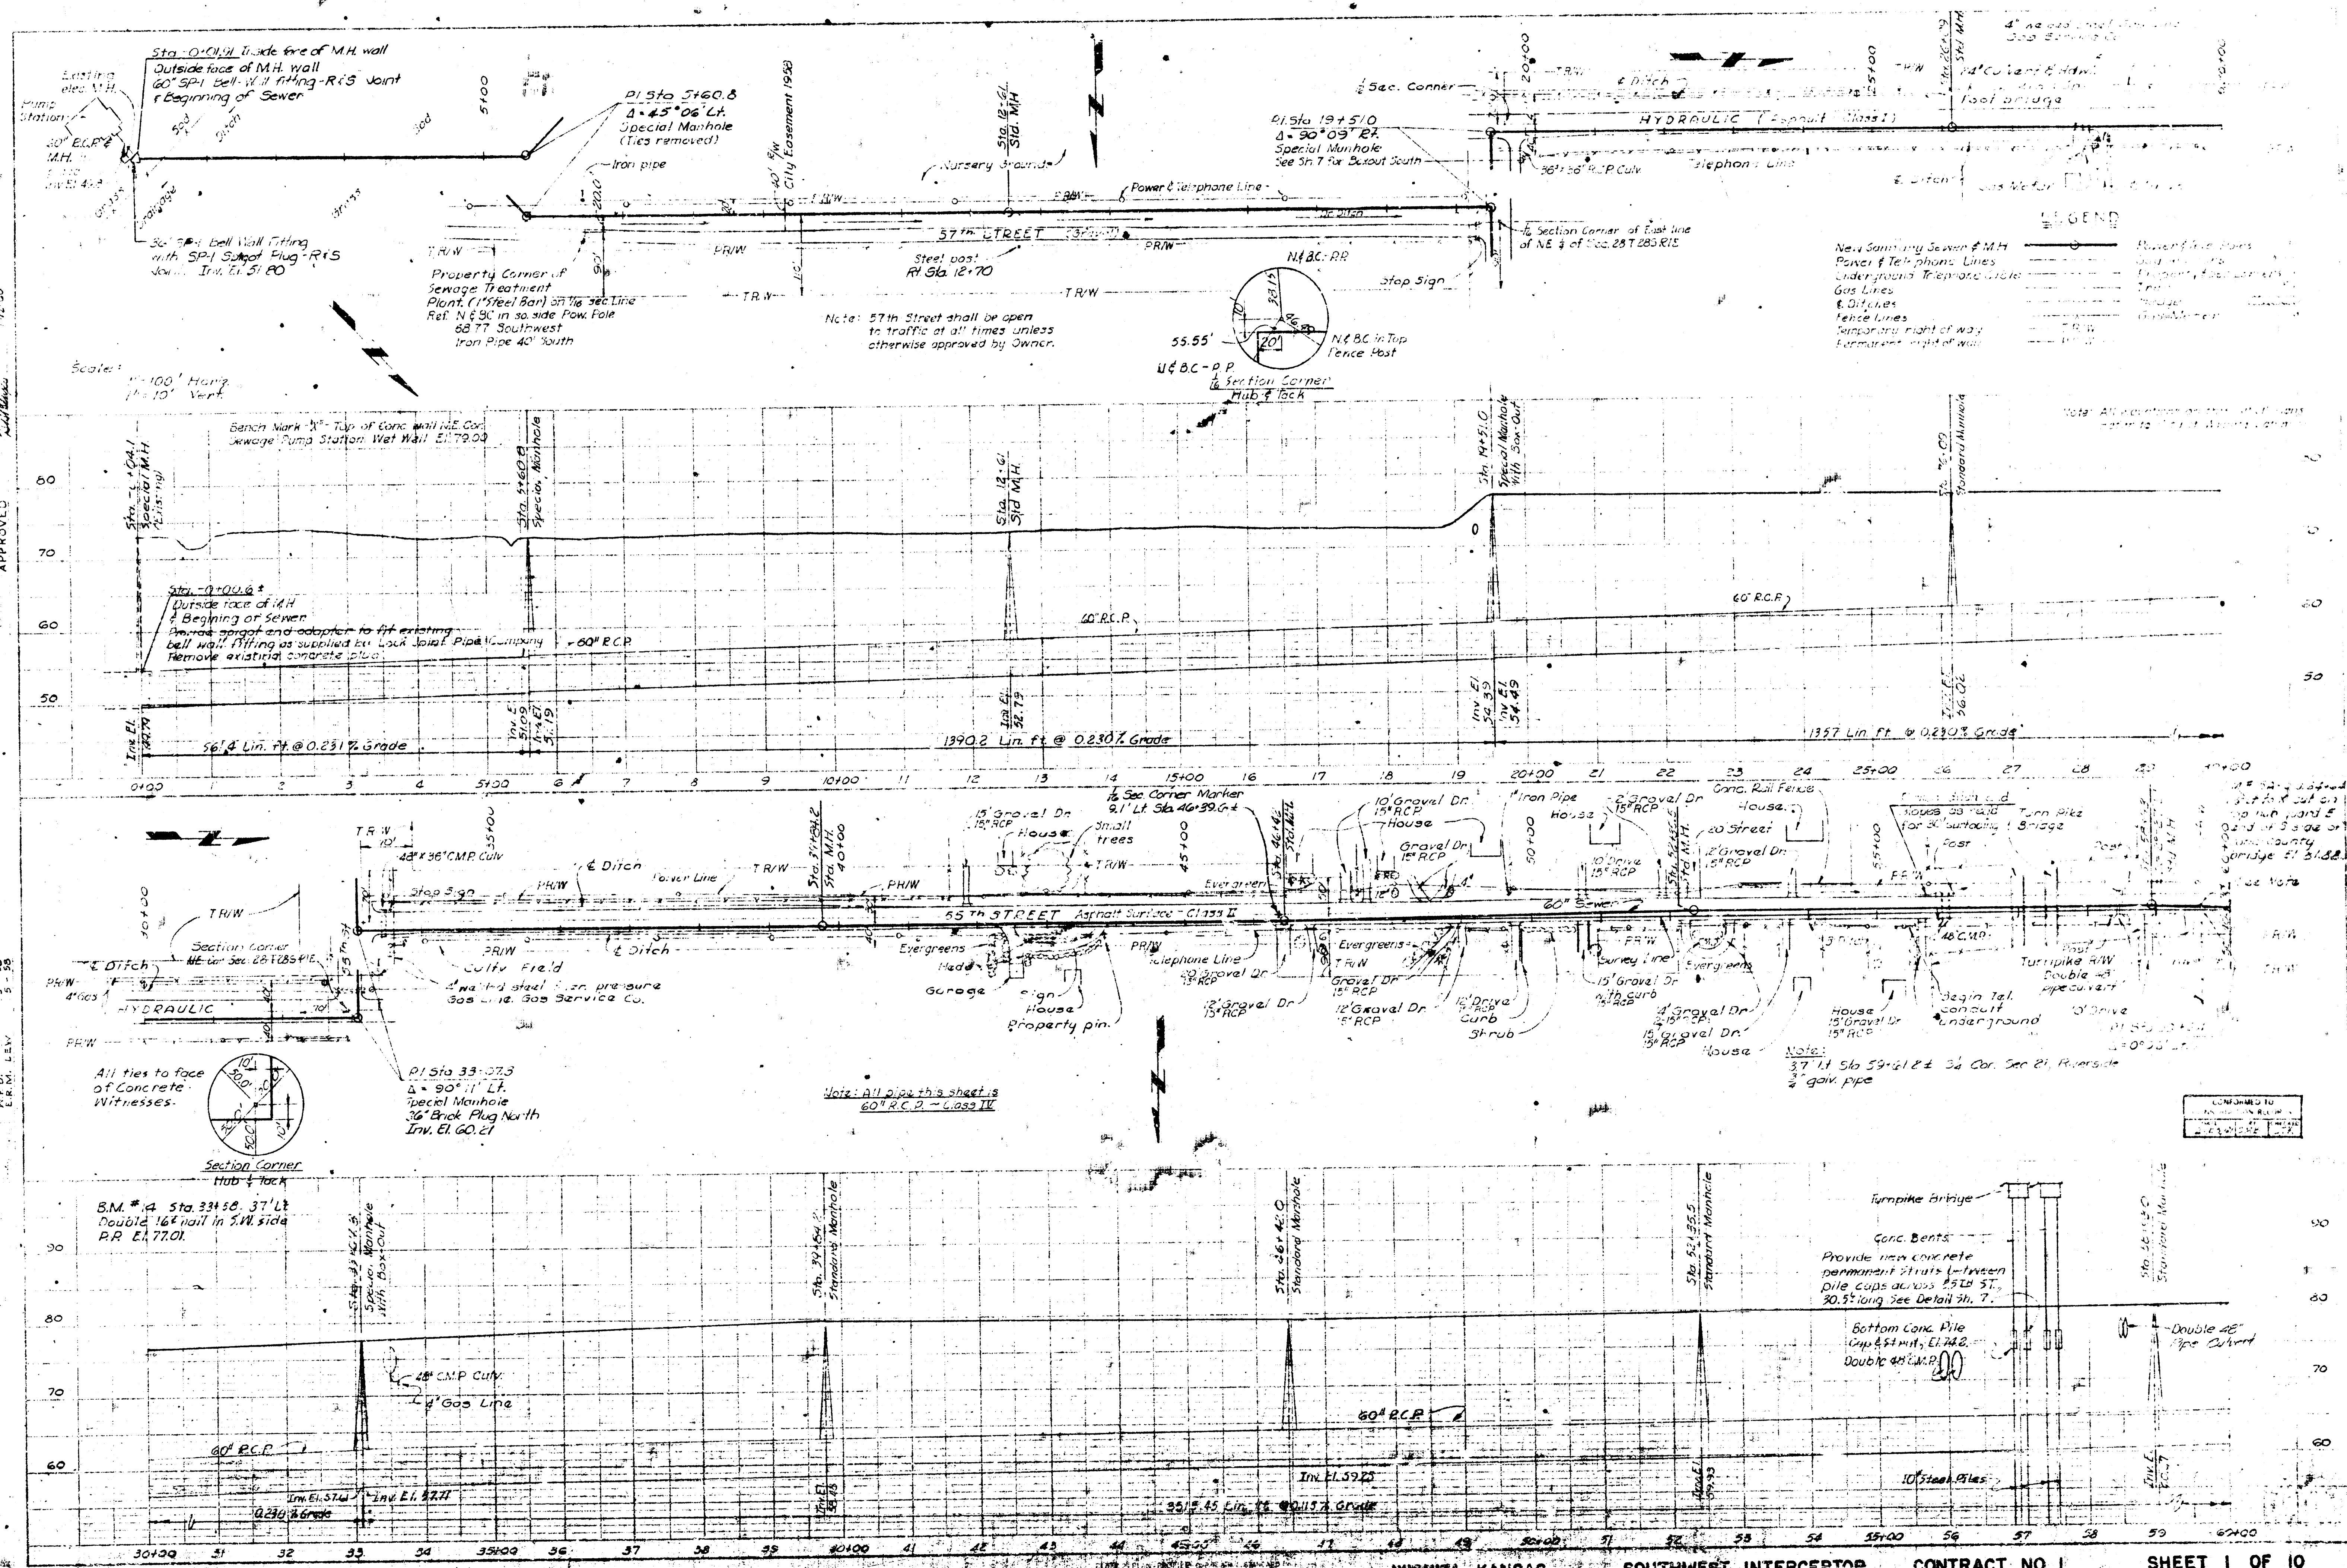

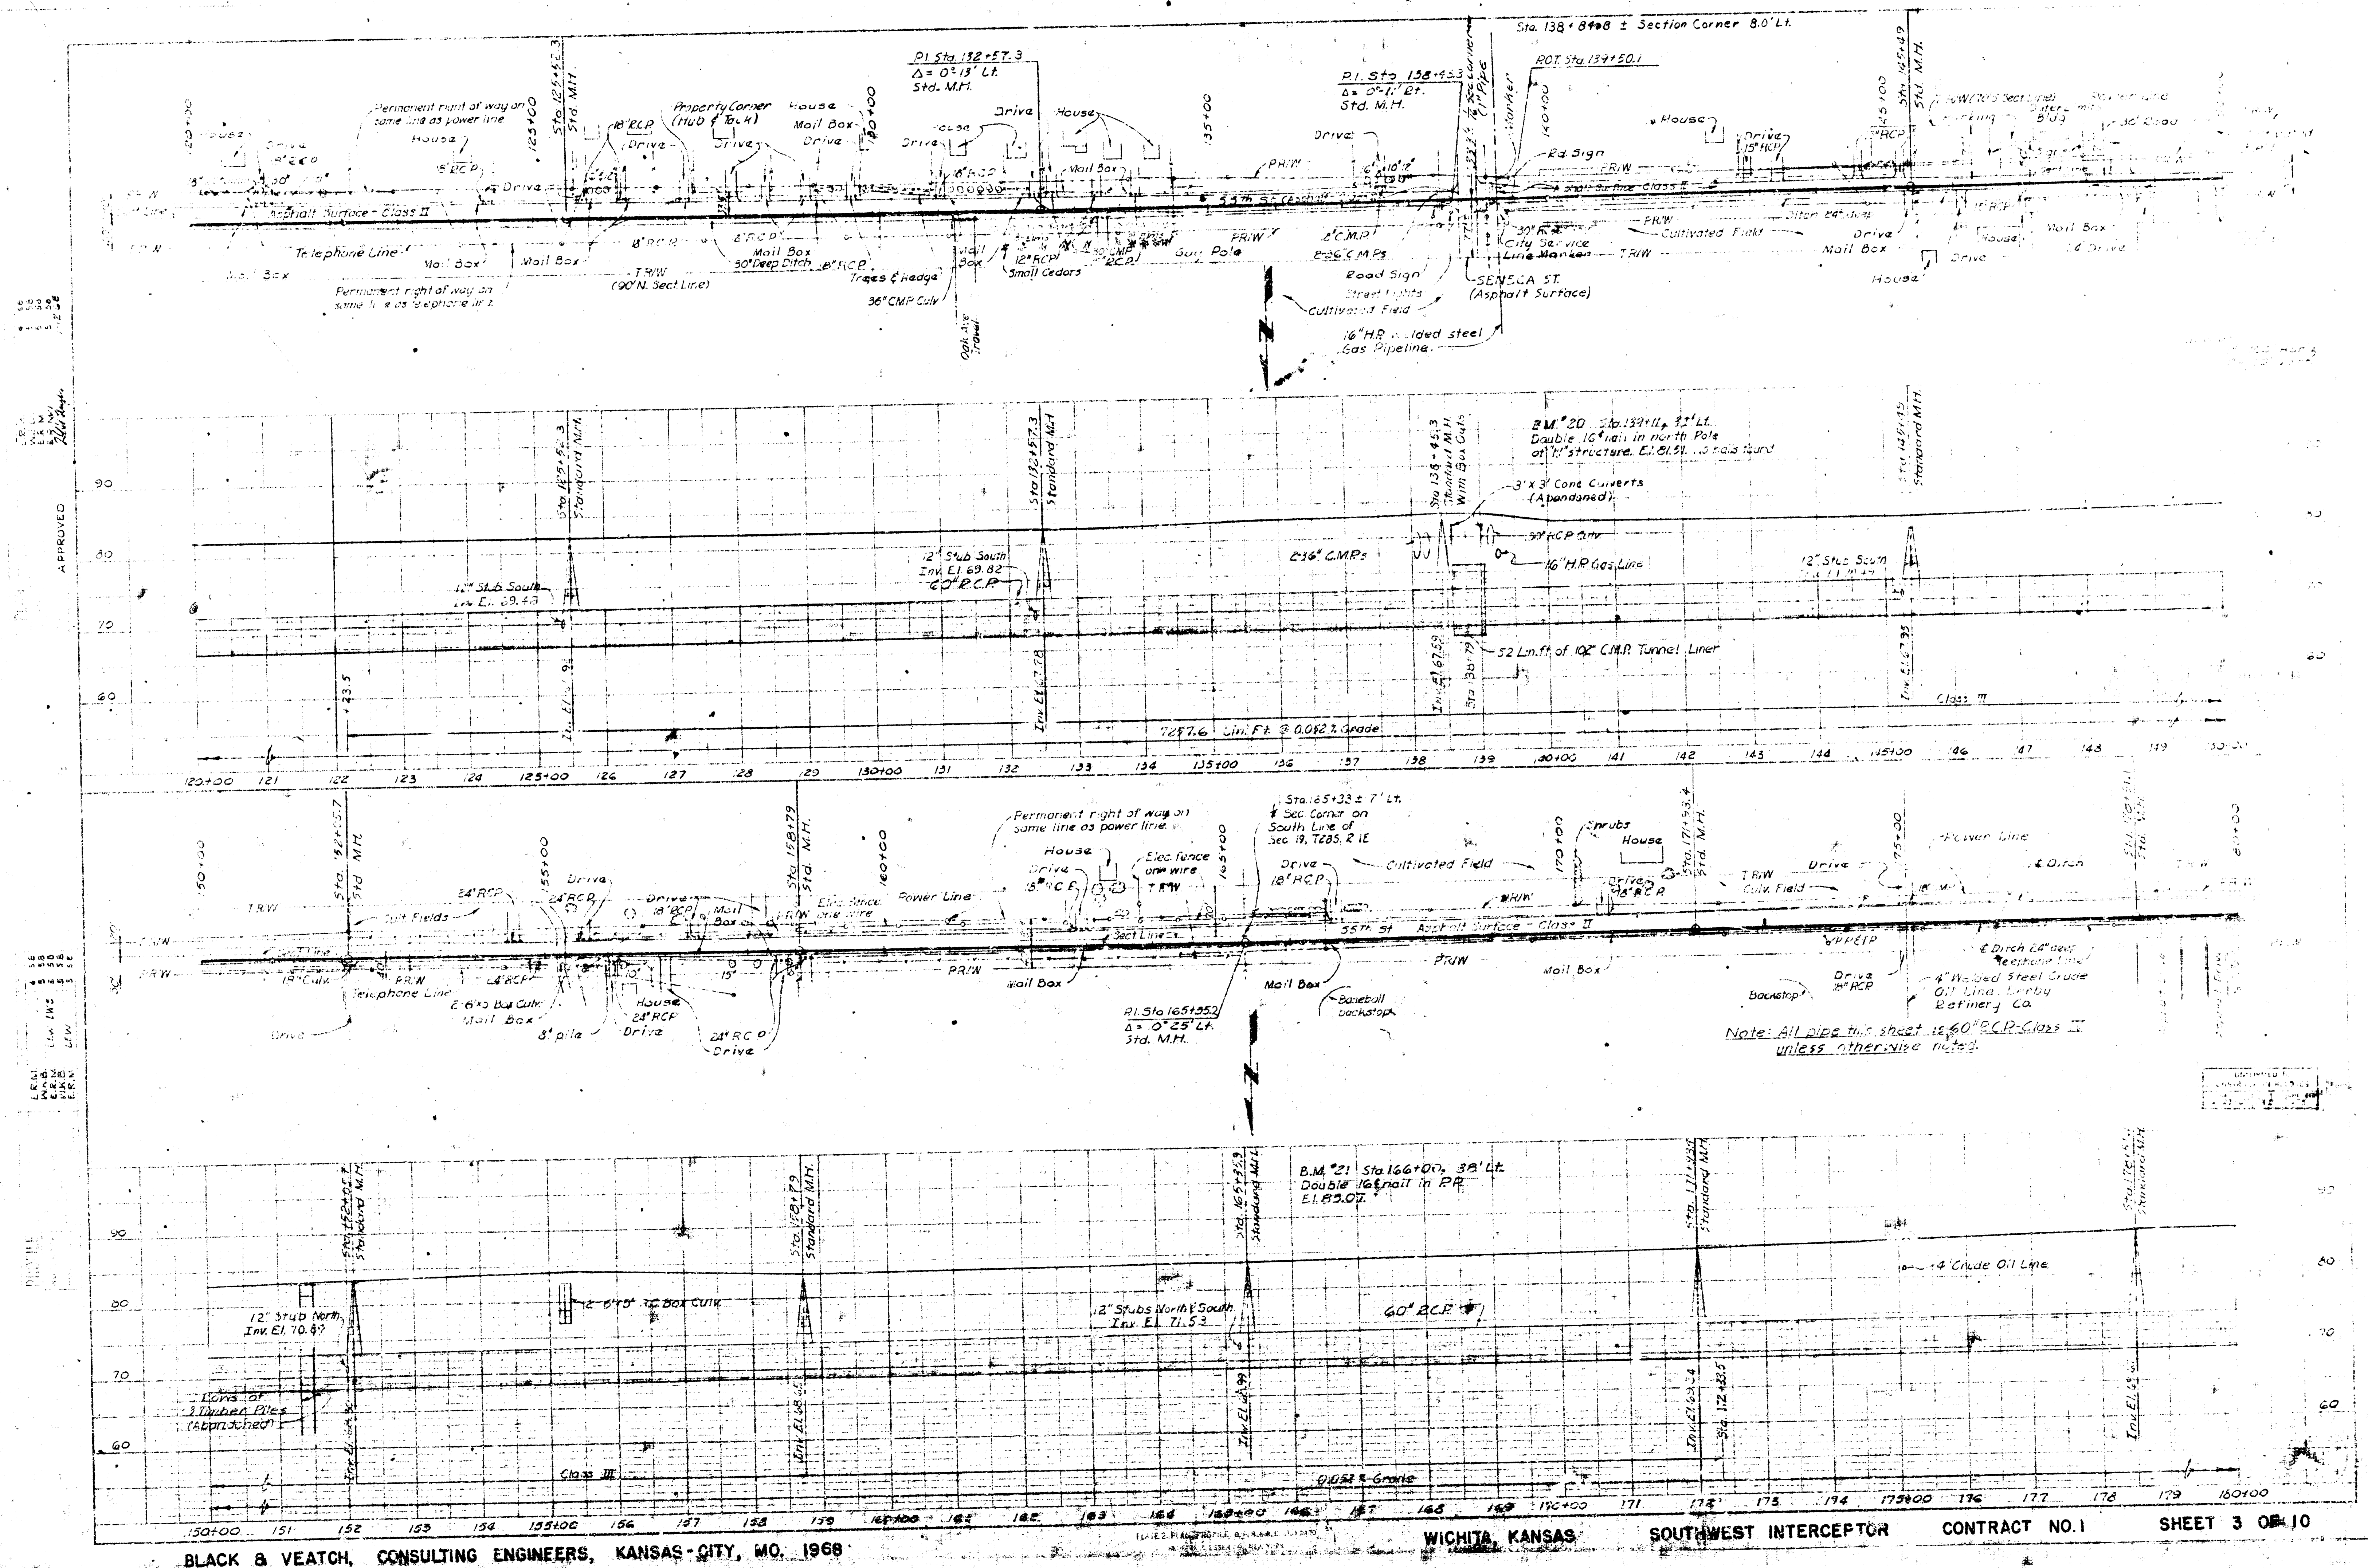

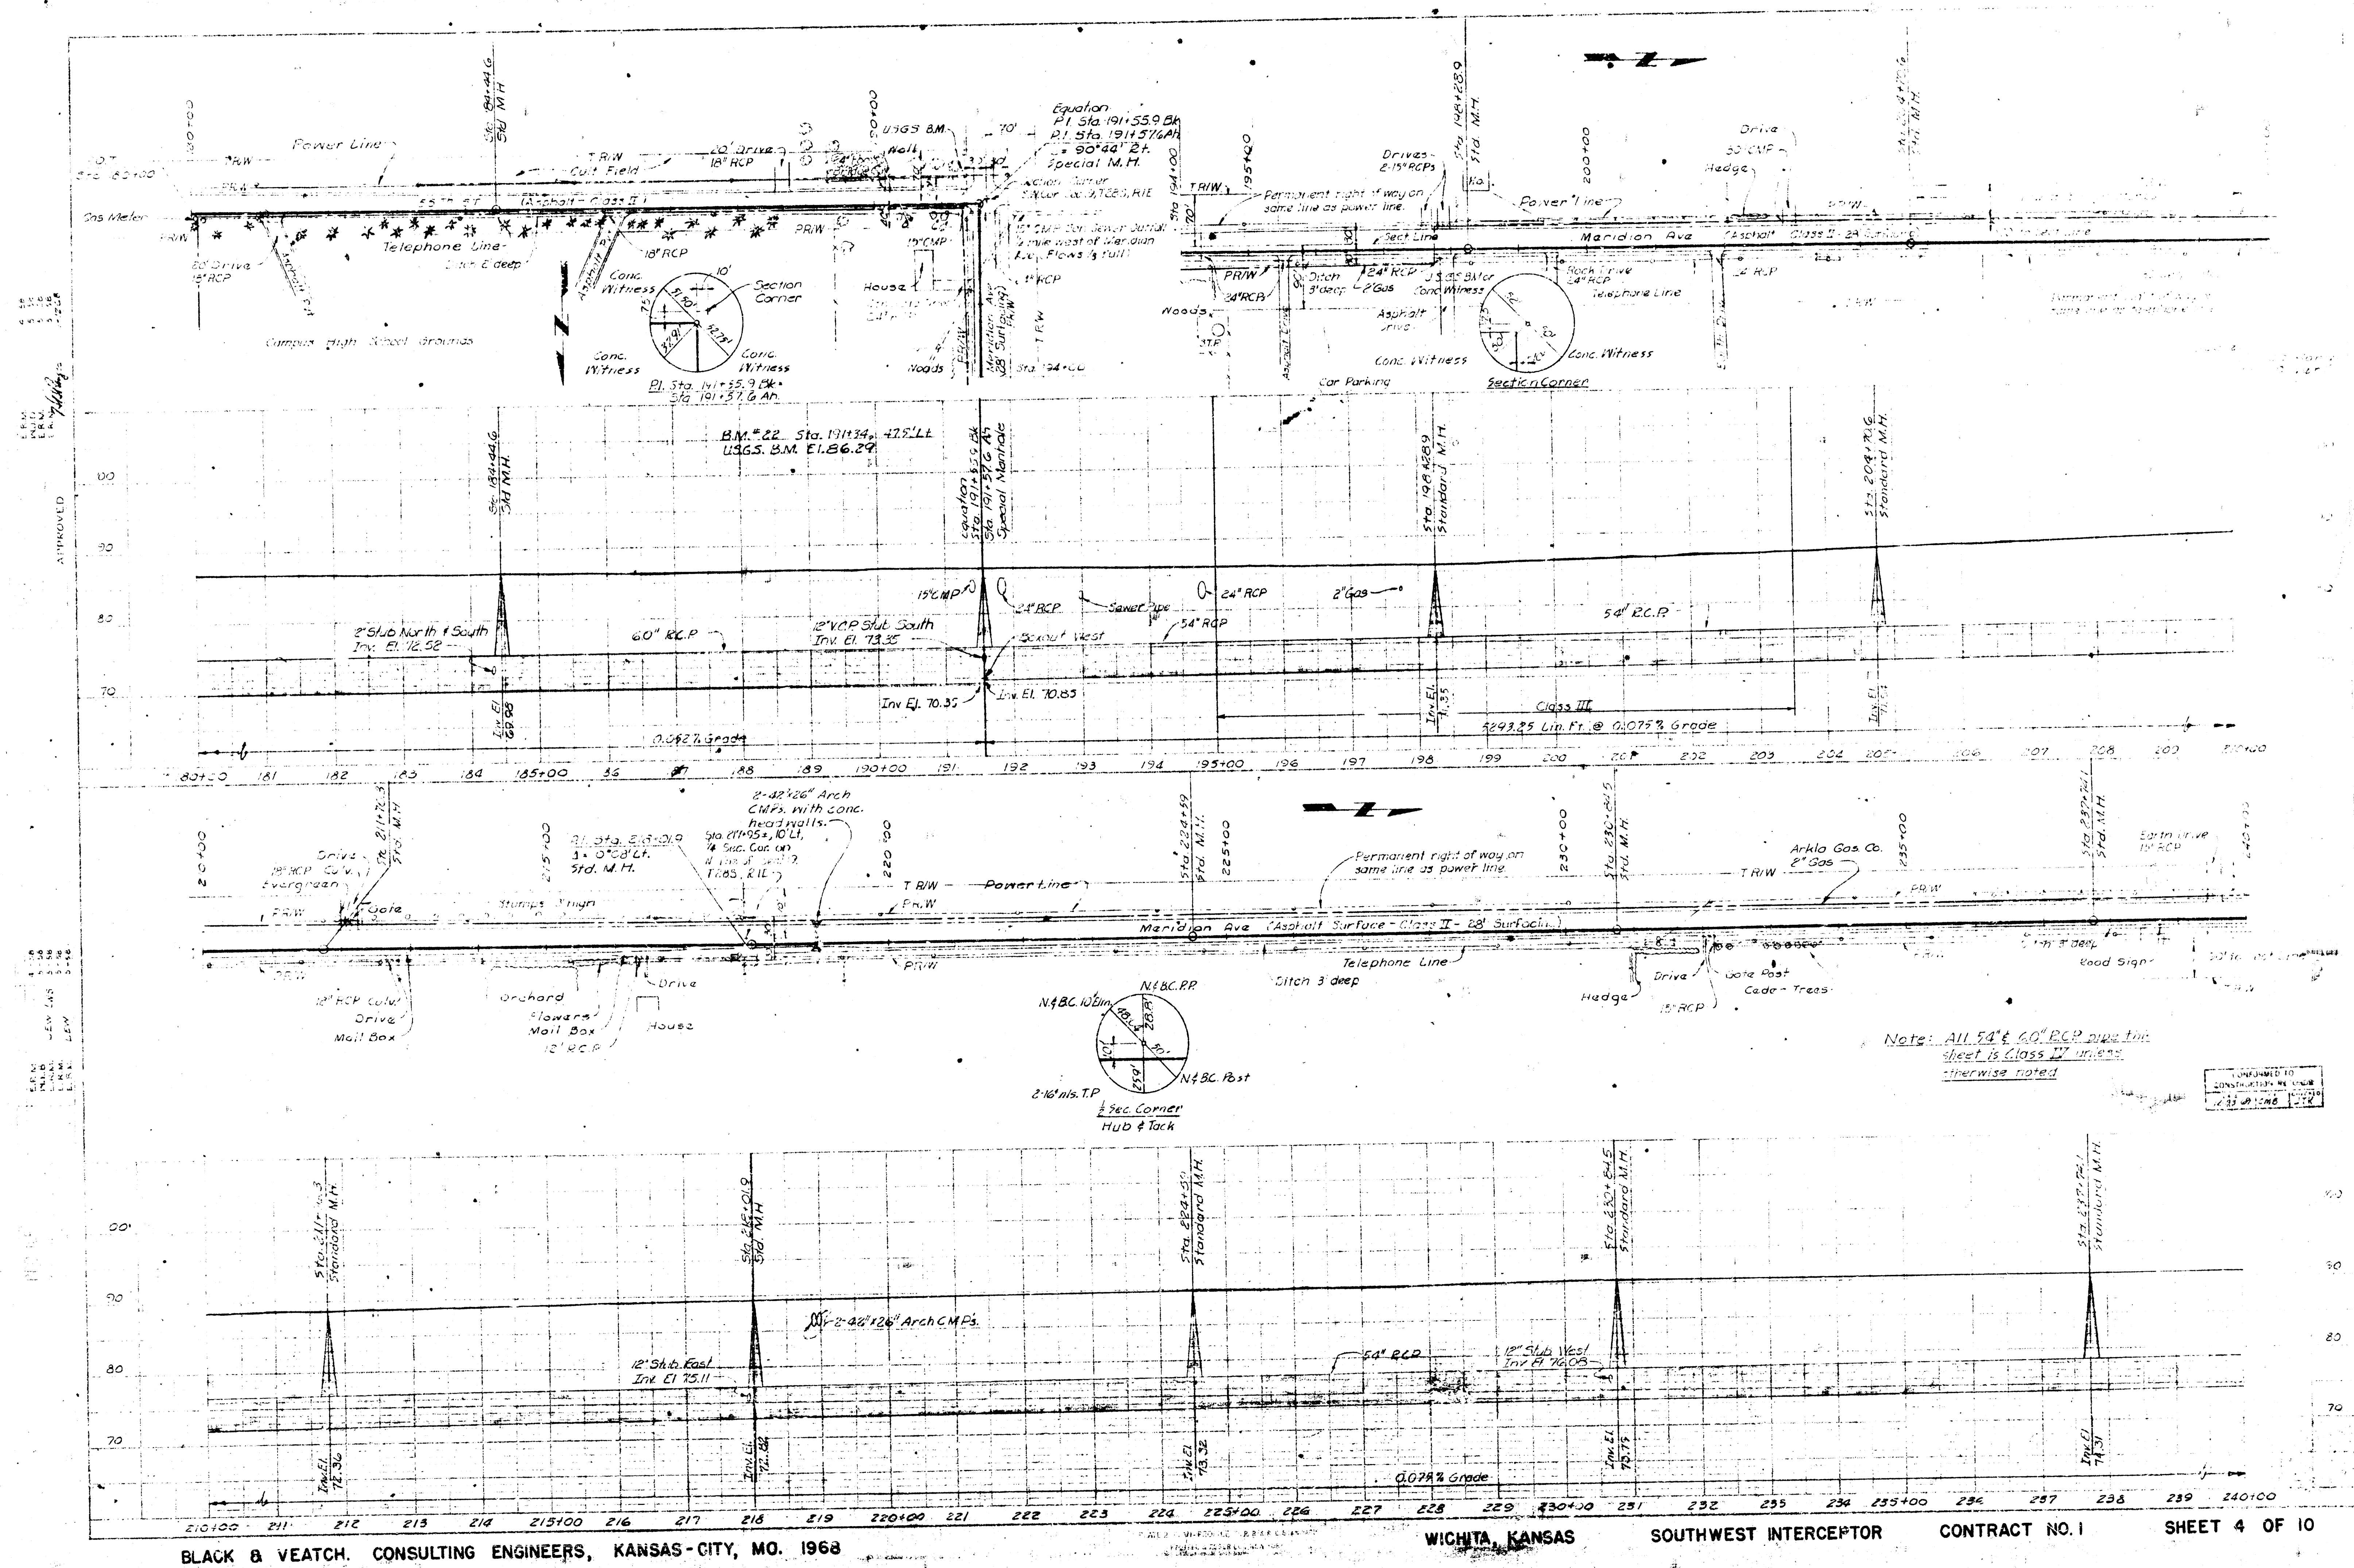





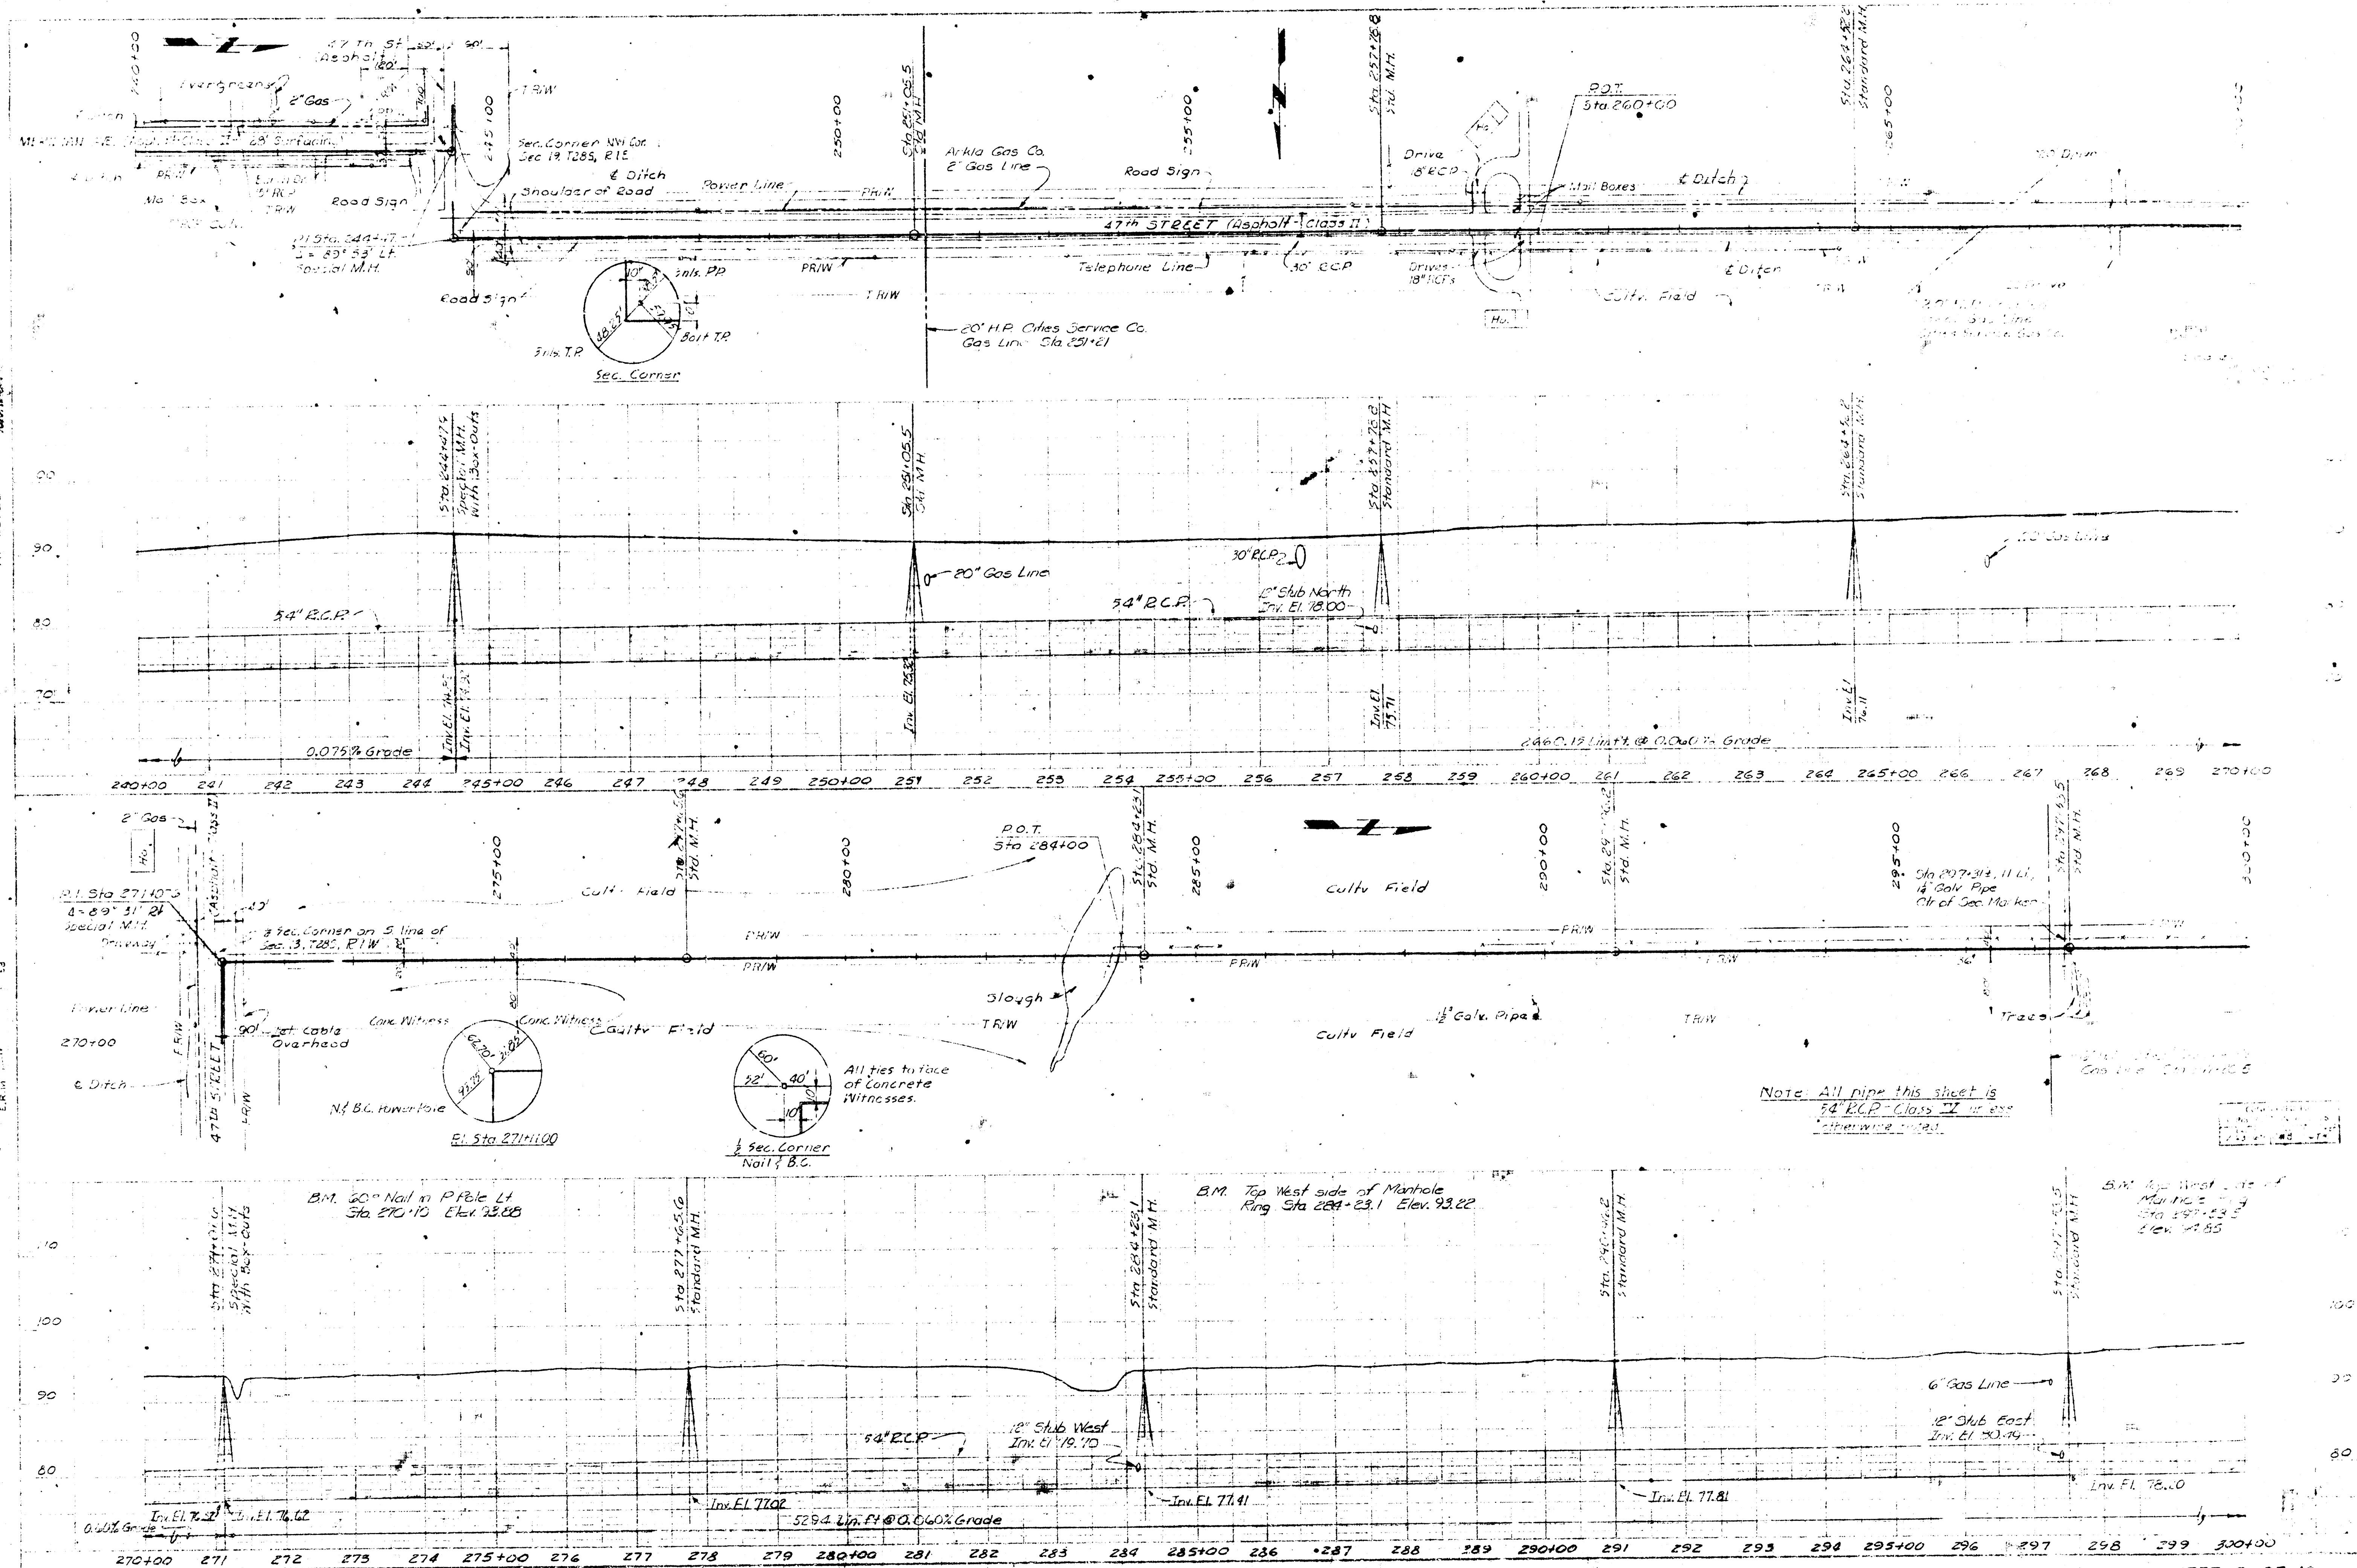


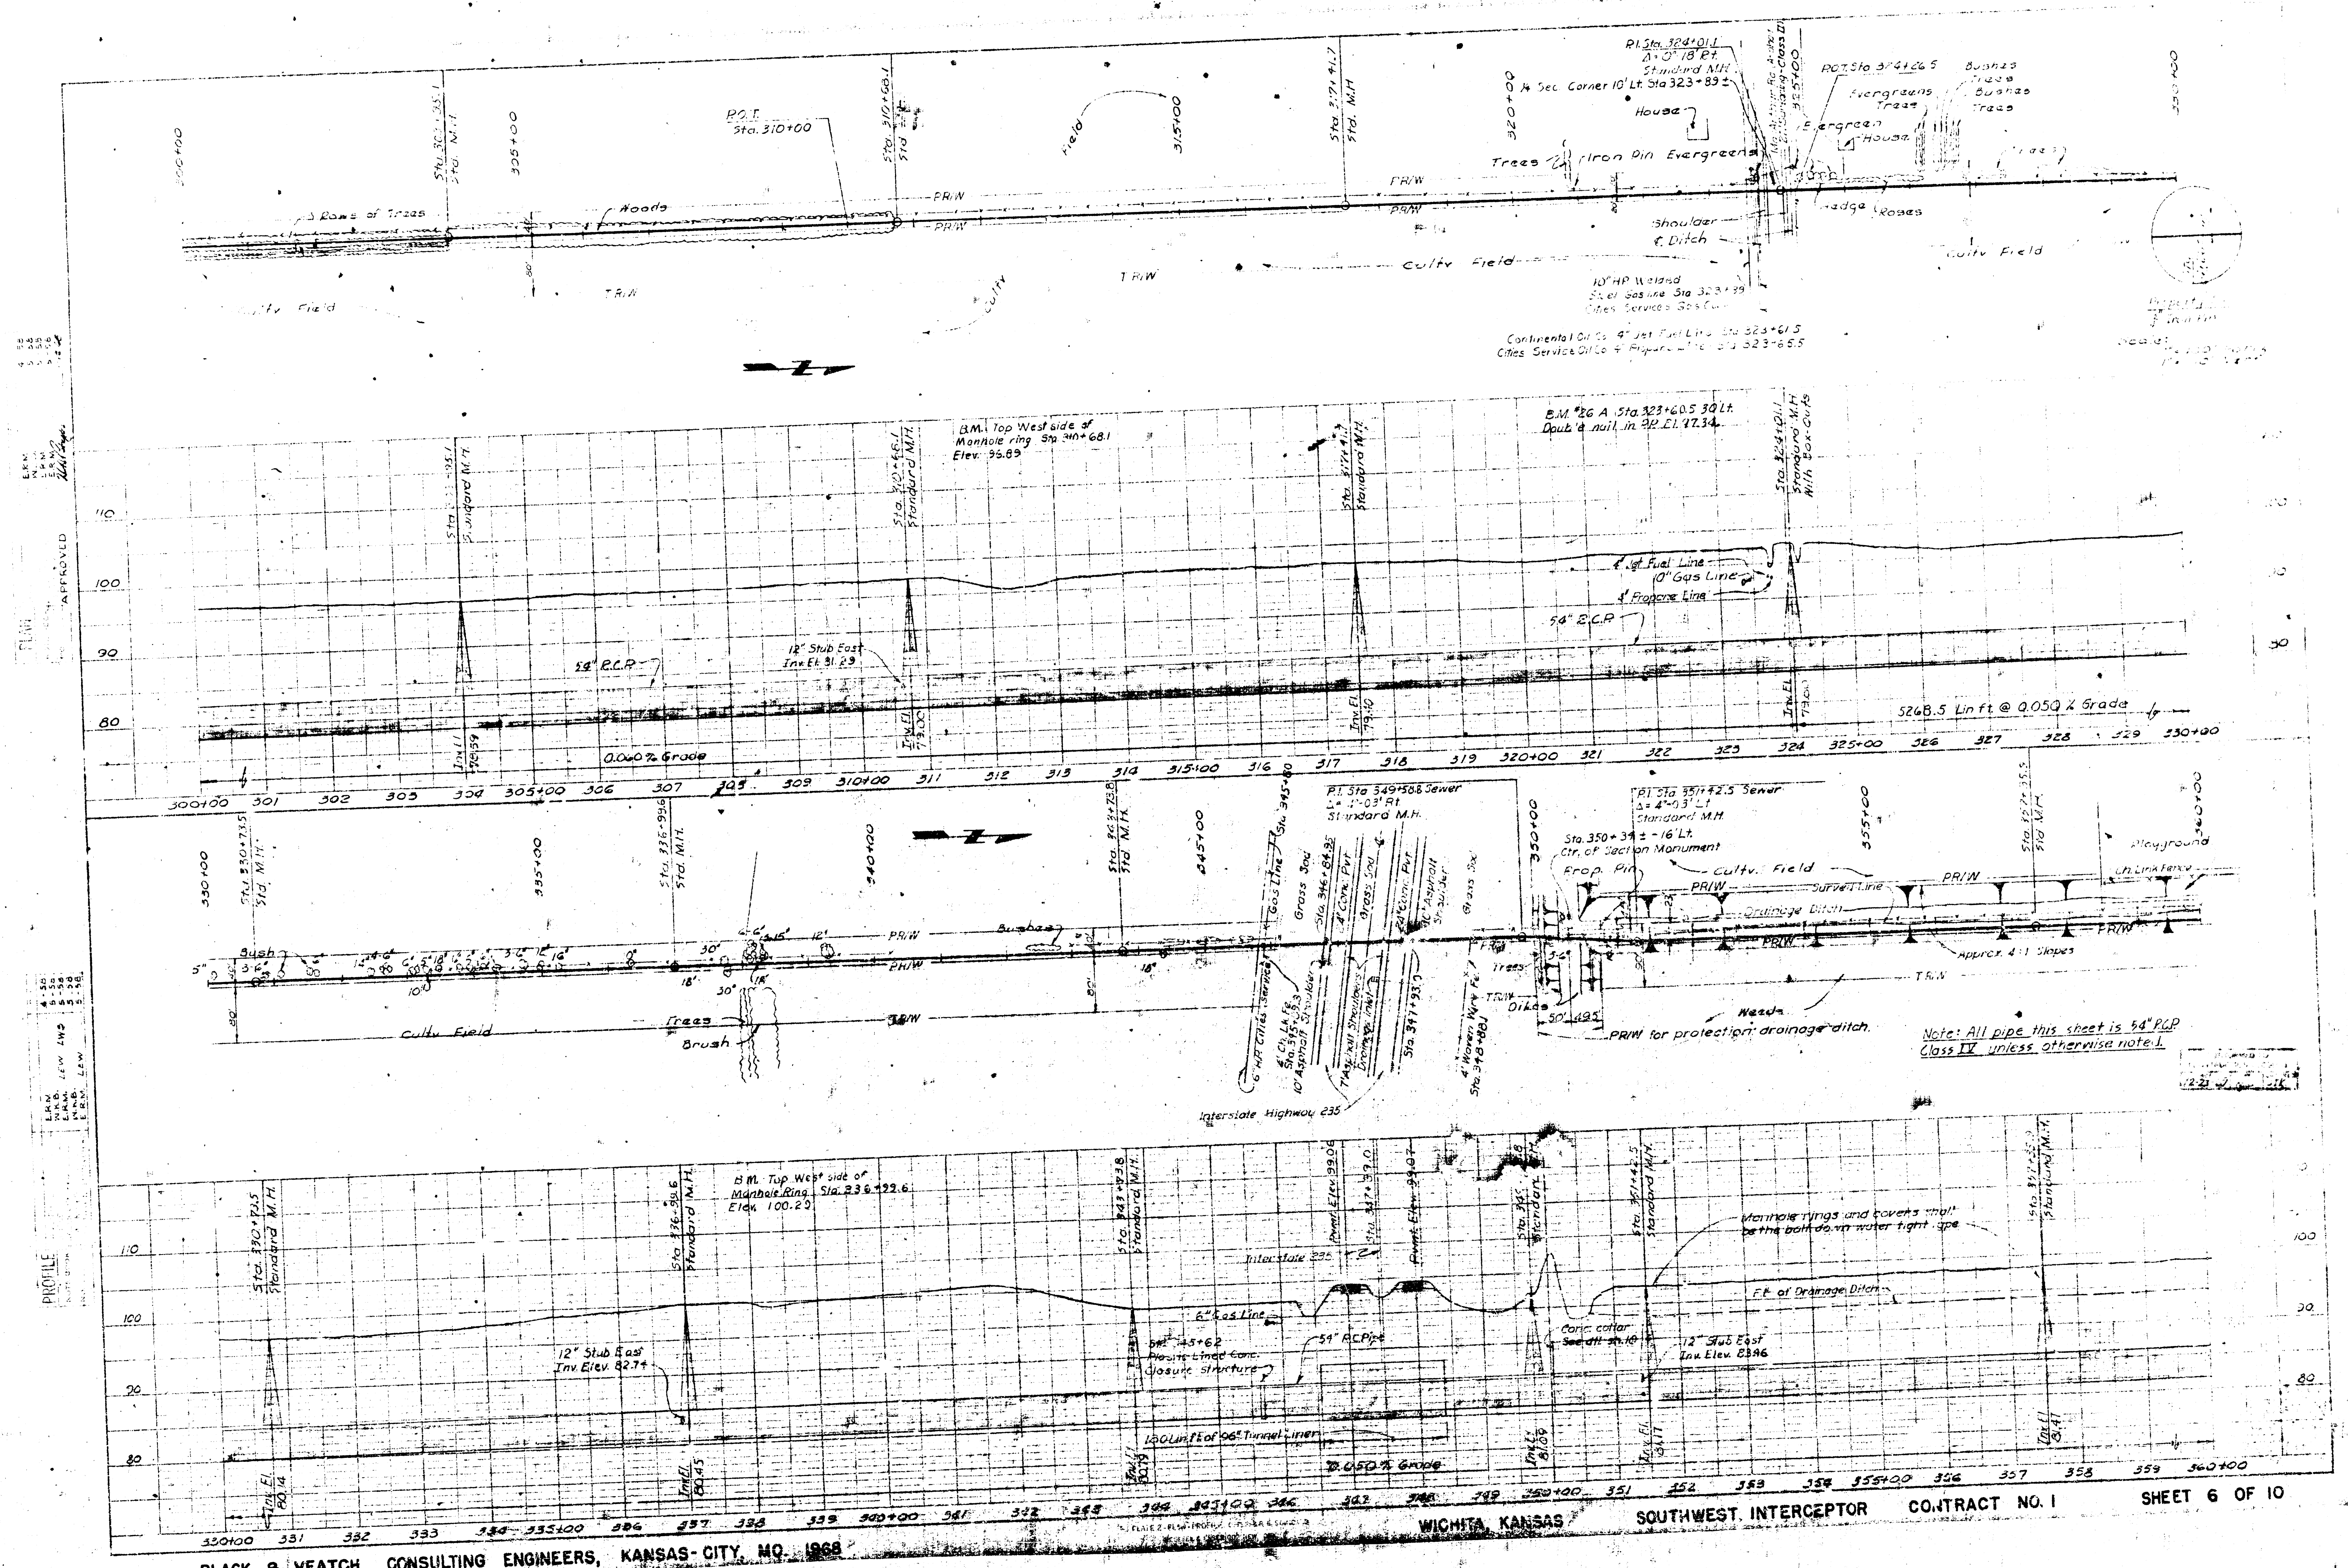

BLACK & VEATCH, CONSULTING ENGINEERS, KANSAS-CITY, MO. 1968



SOUTHWEST INTERCEPTOR CONTRACT NO. 1
WICHITA, KANSAS
SHEET 6 OF 10

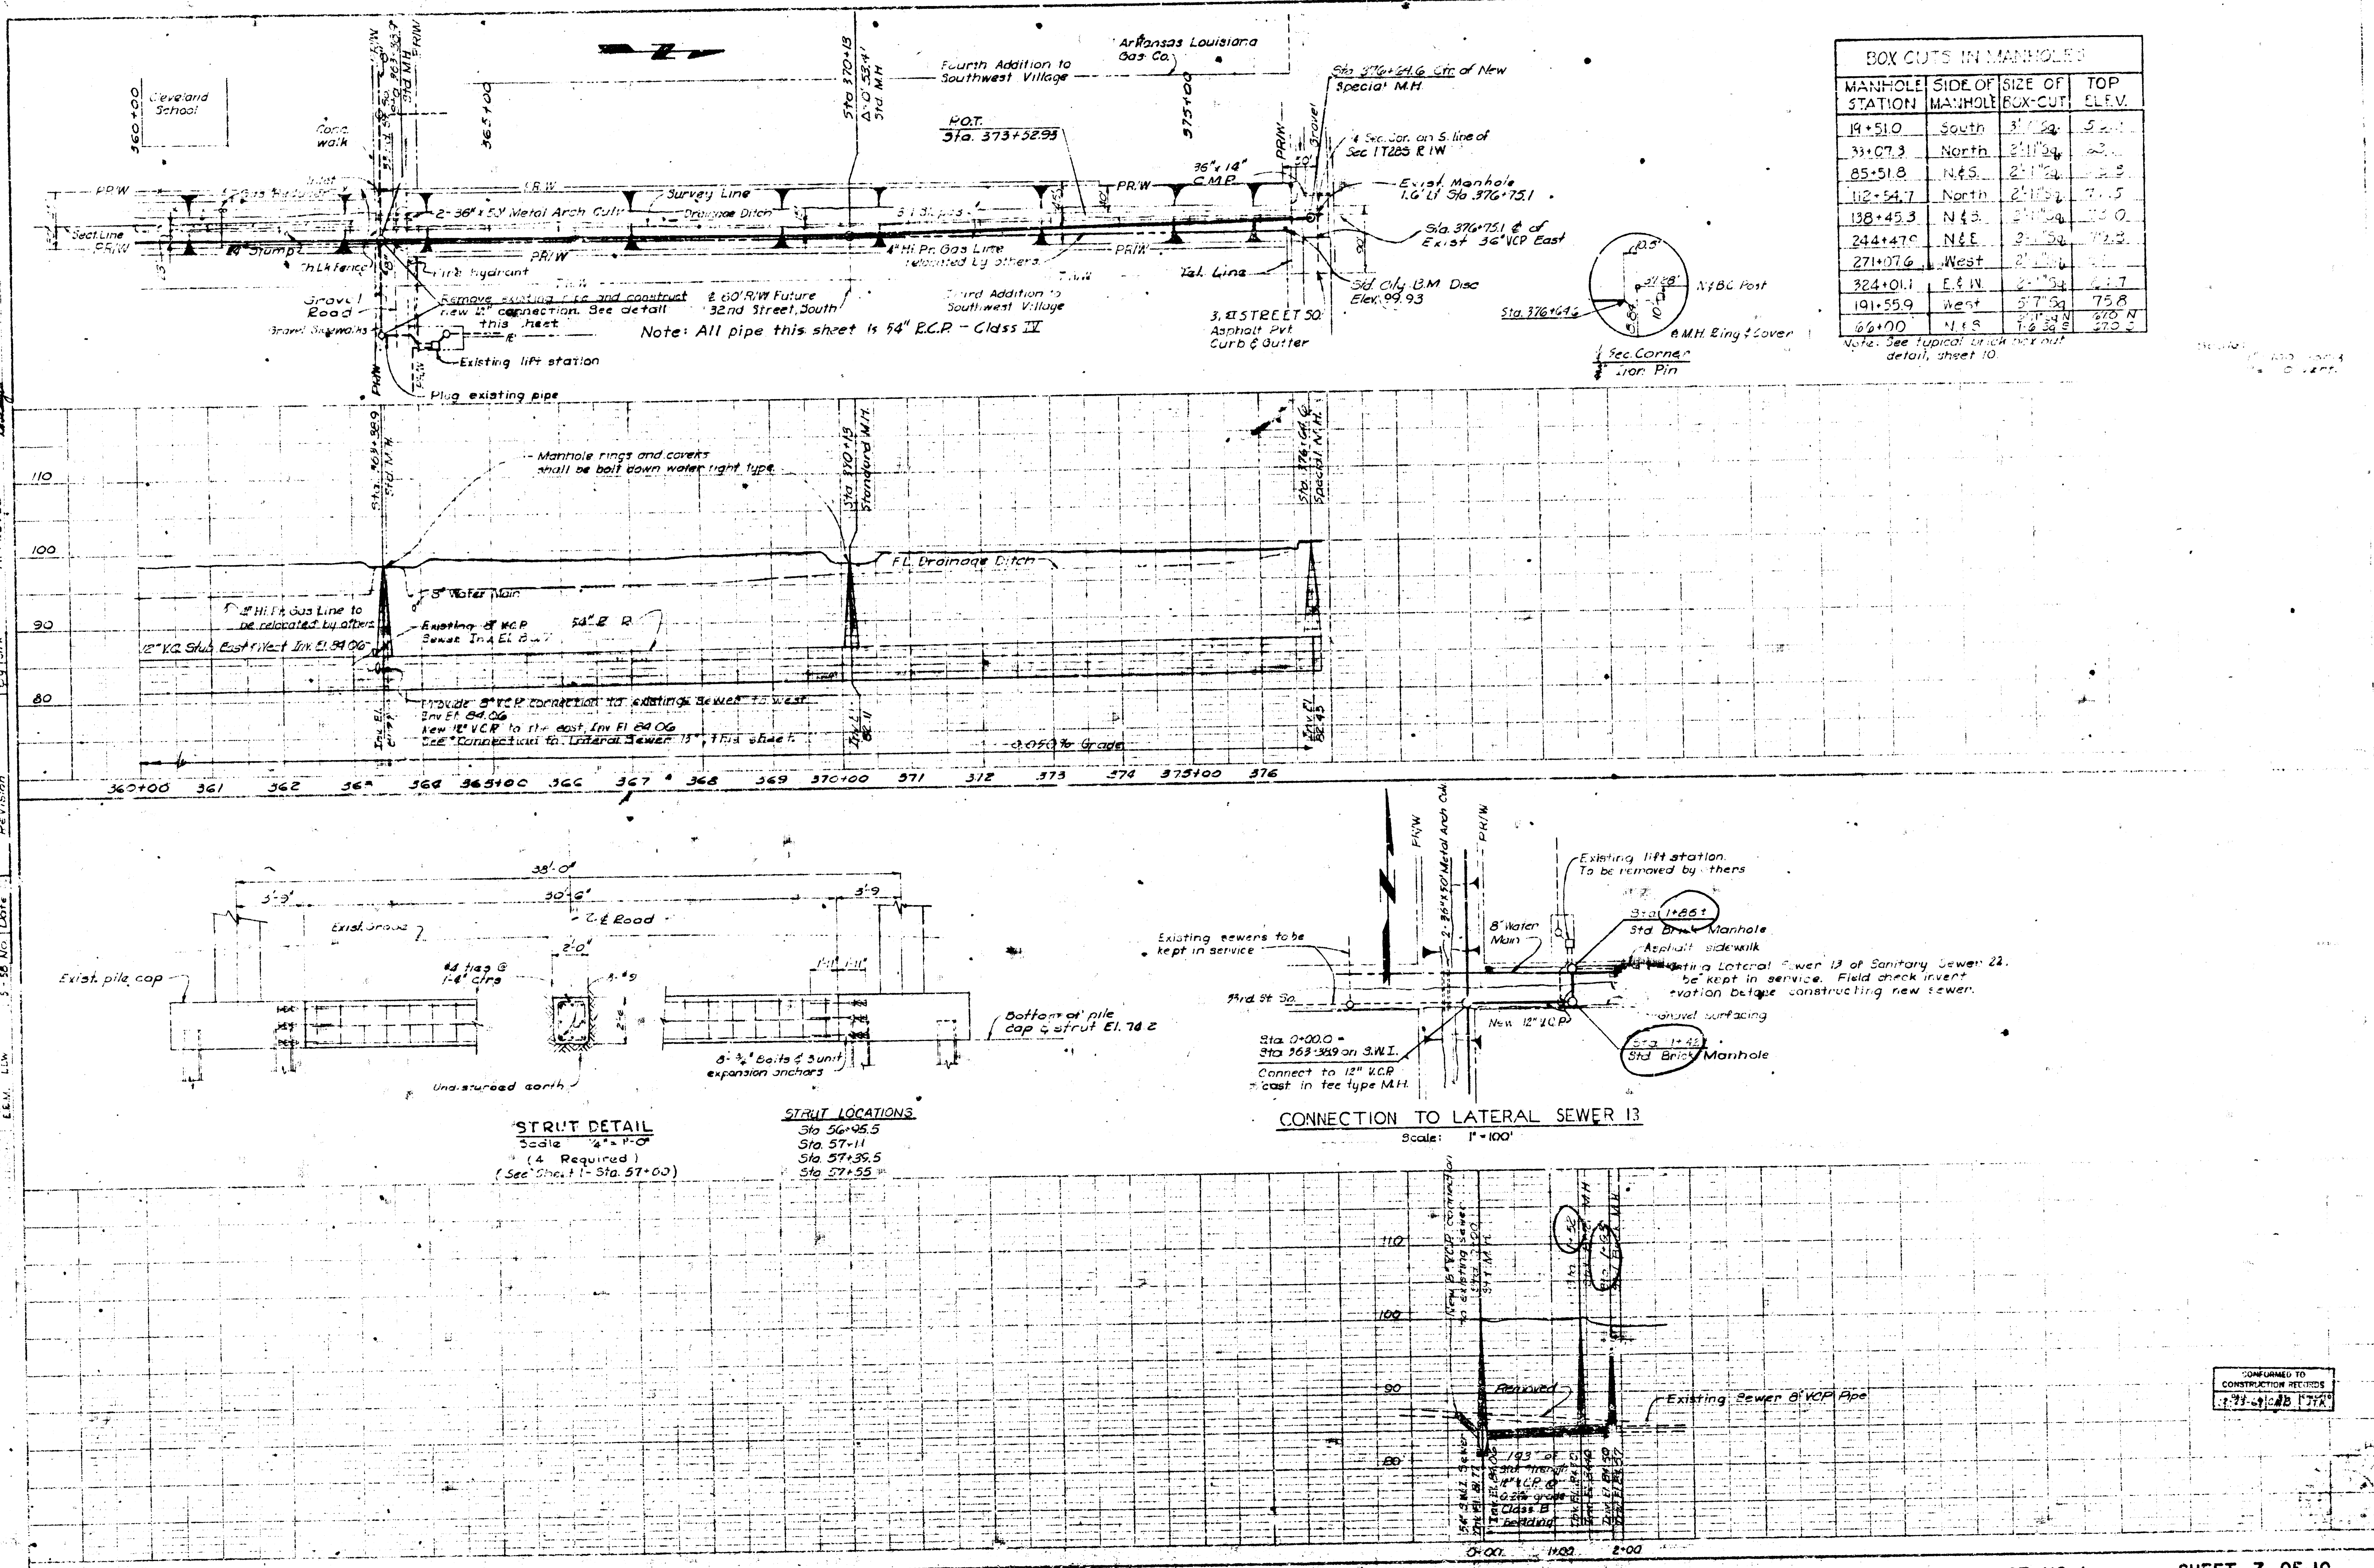

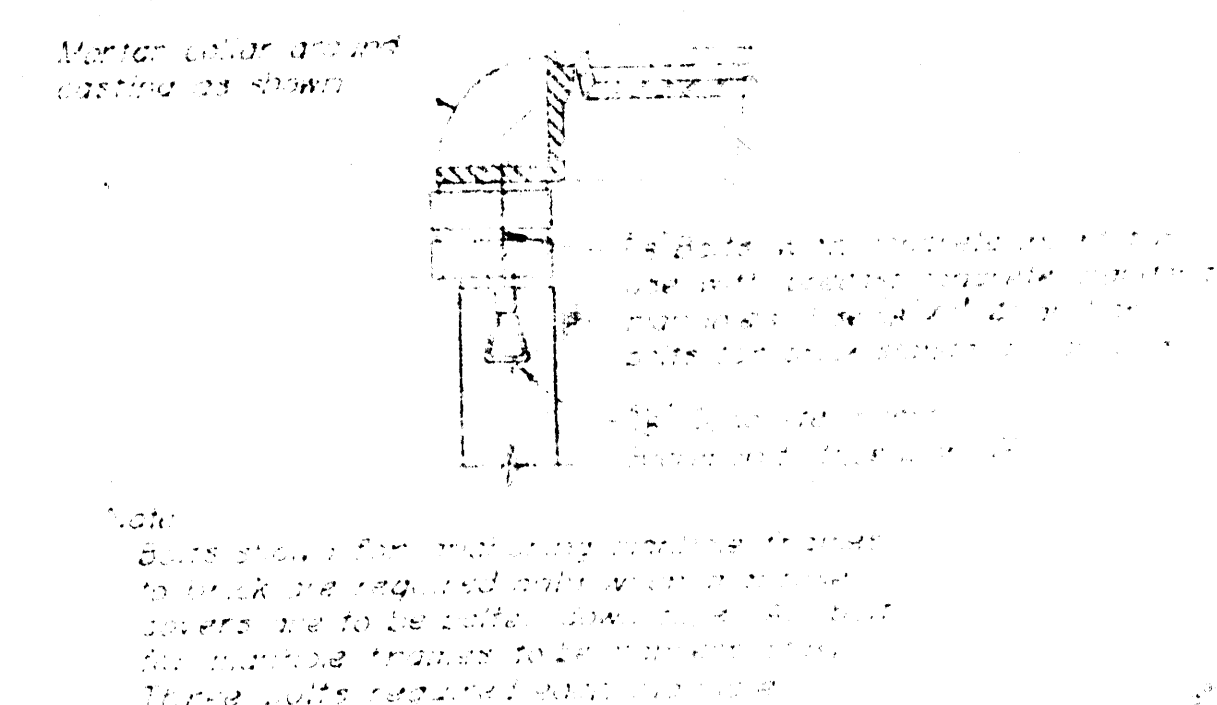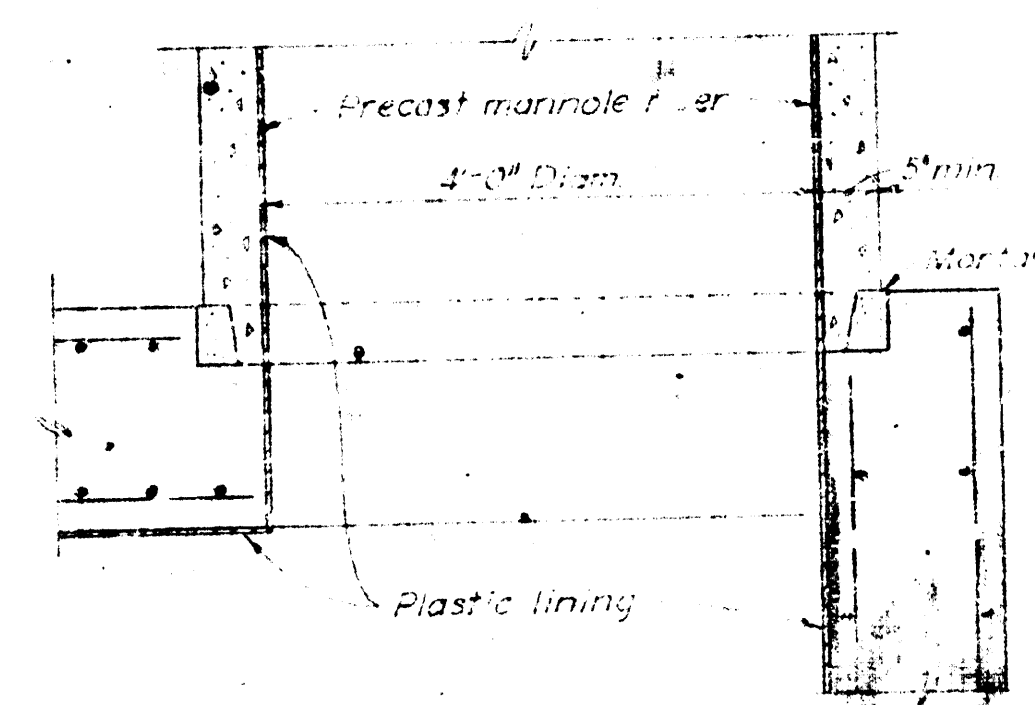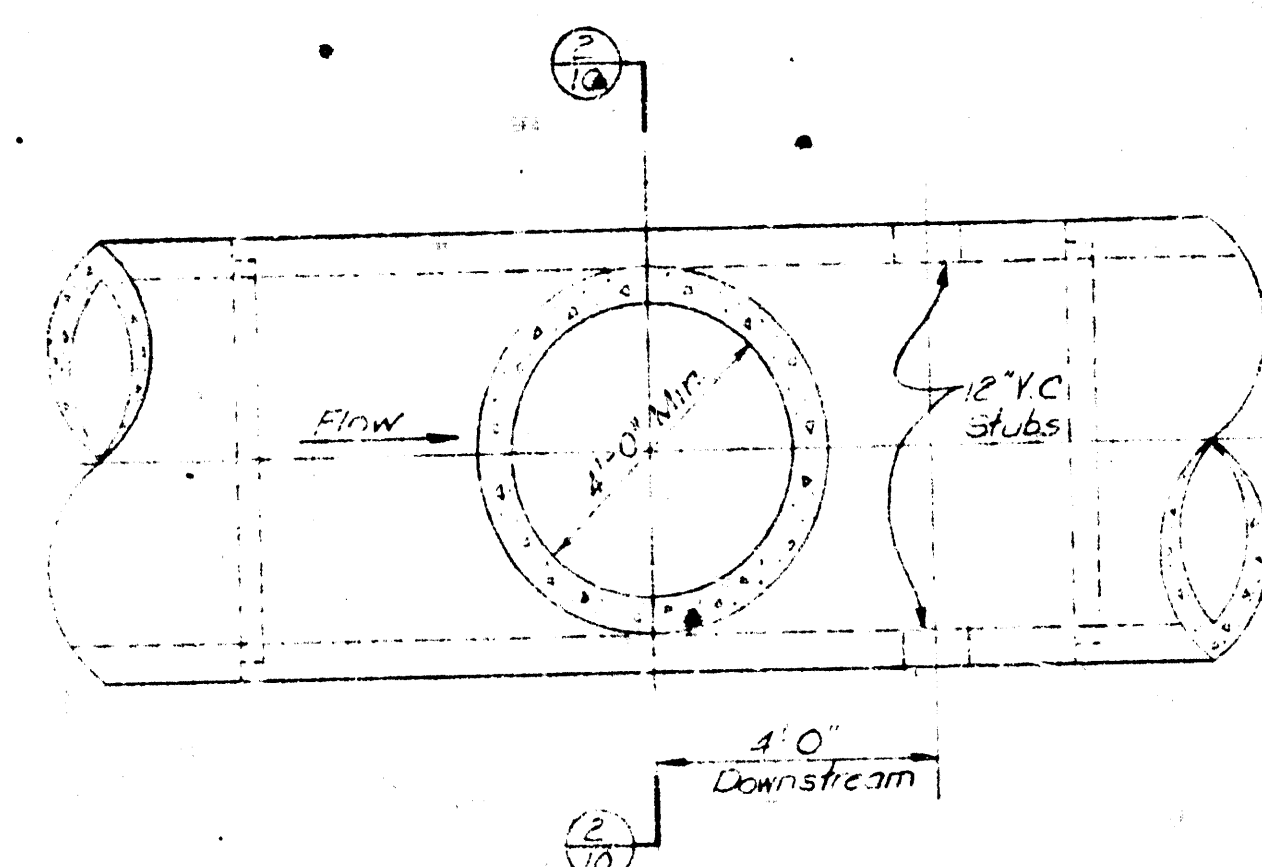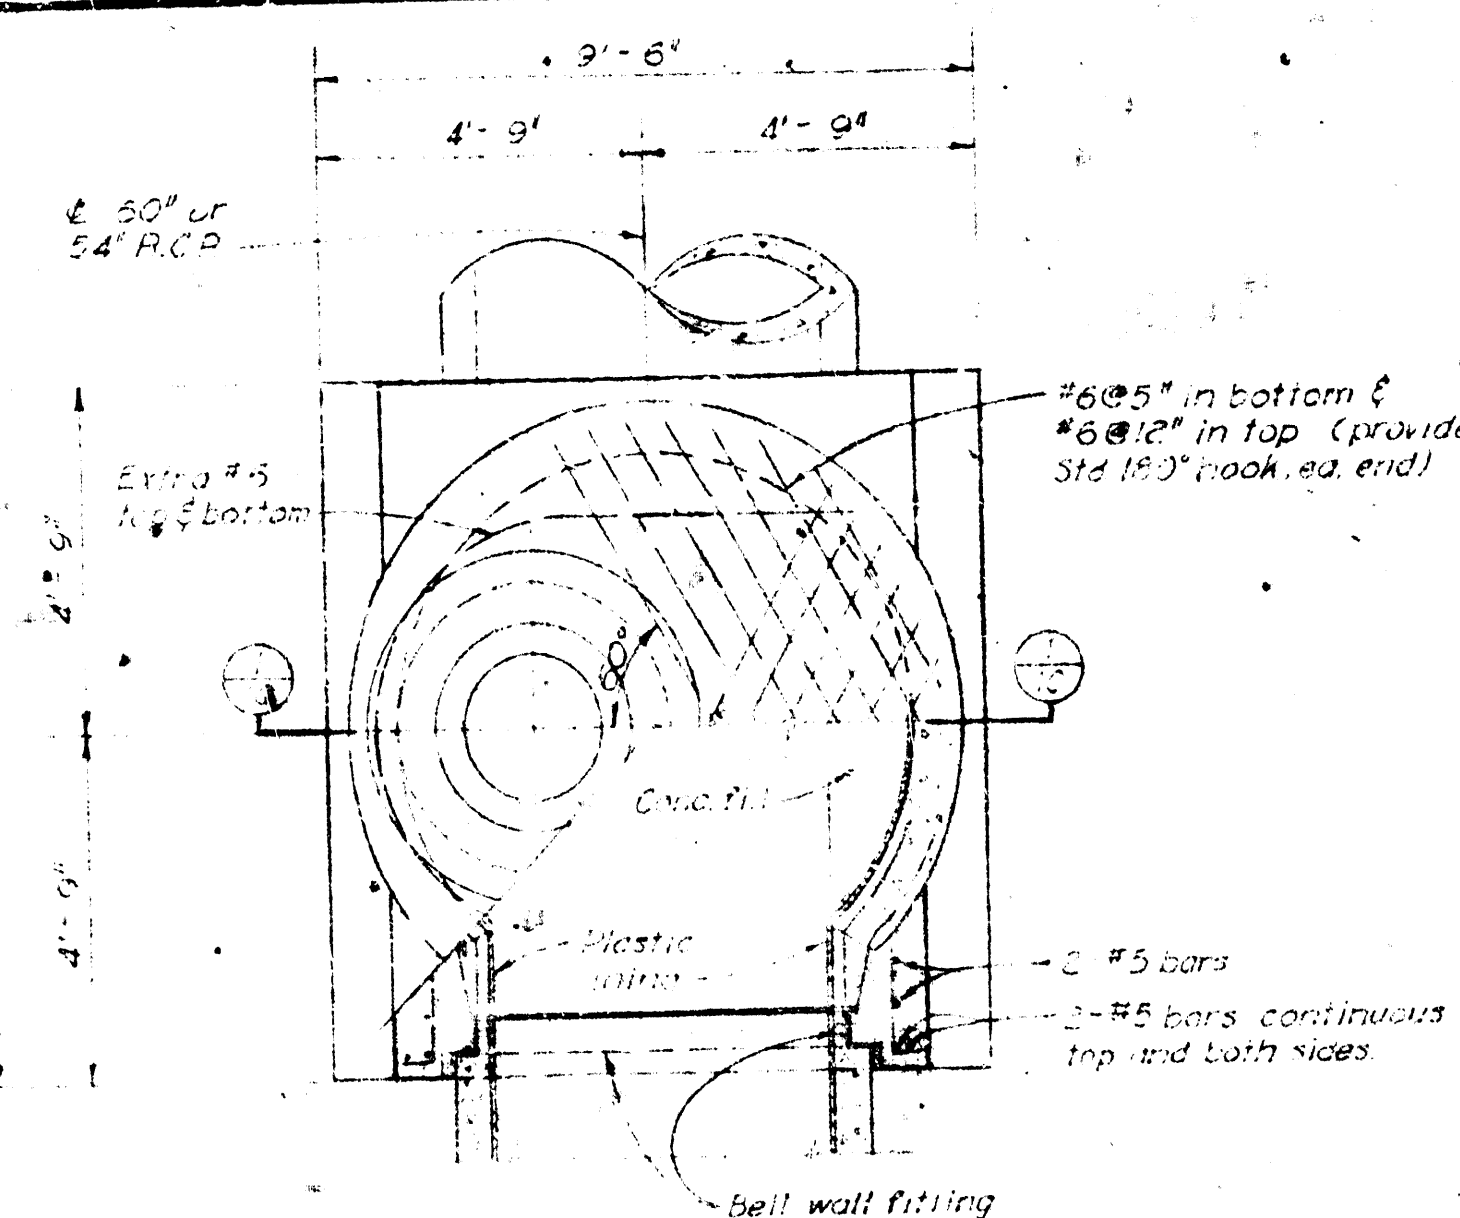

PRECAST RISER ON ROUNDED MANHOLE DETAIL
Scale: 1/2" = 1'-0"
NOT USED

COLLECTED DOWN MANHOLE DETAIL
Scale: 1/2" = 1'-0"
NOT USED

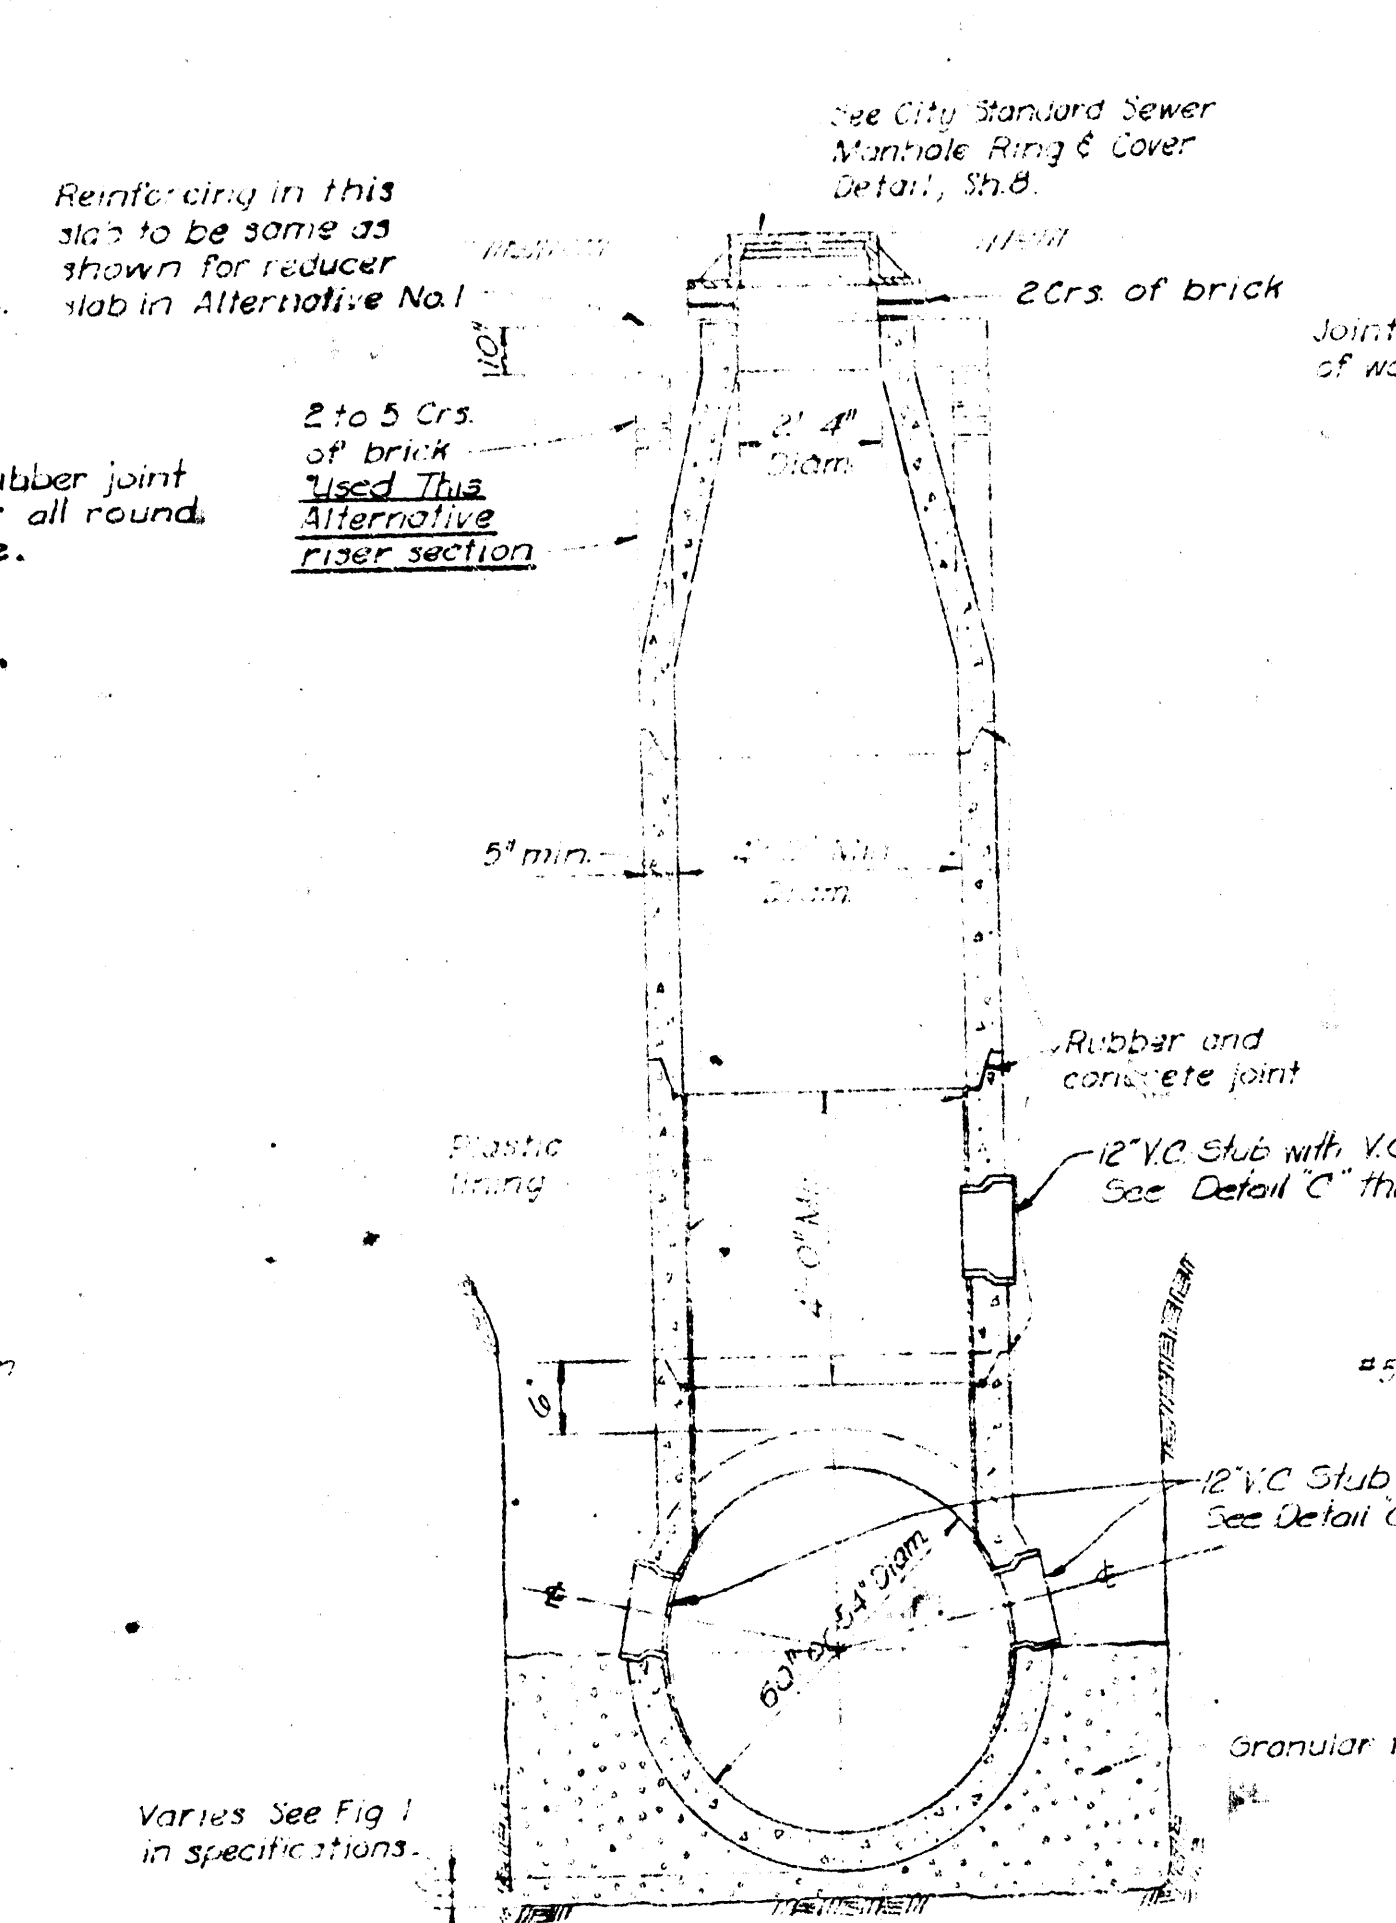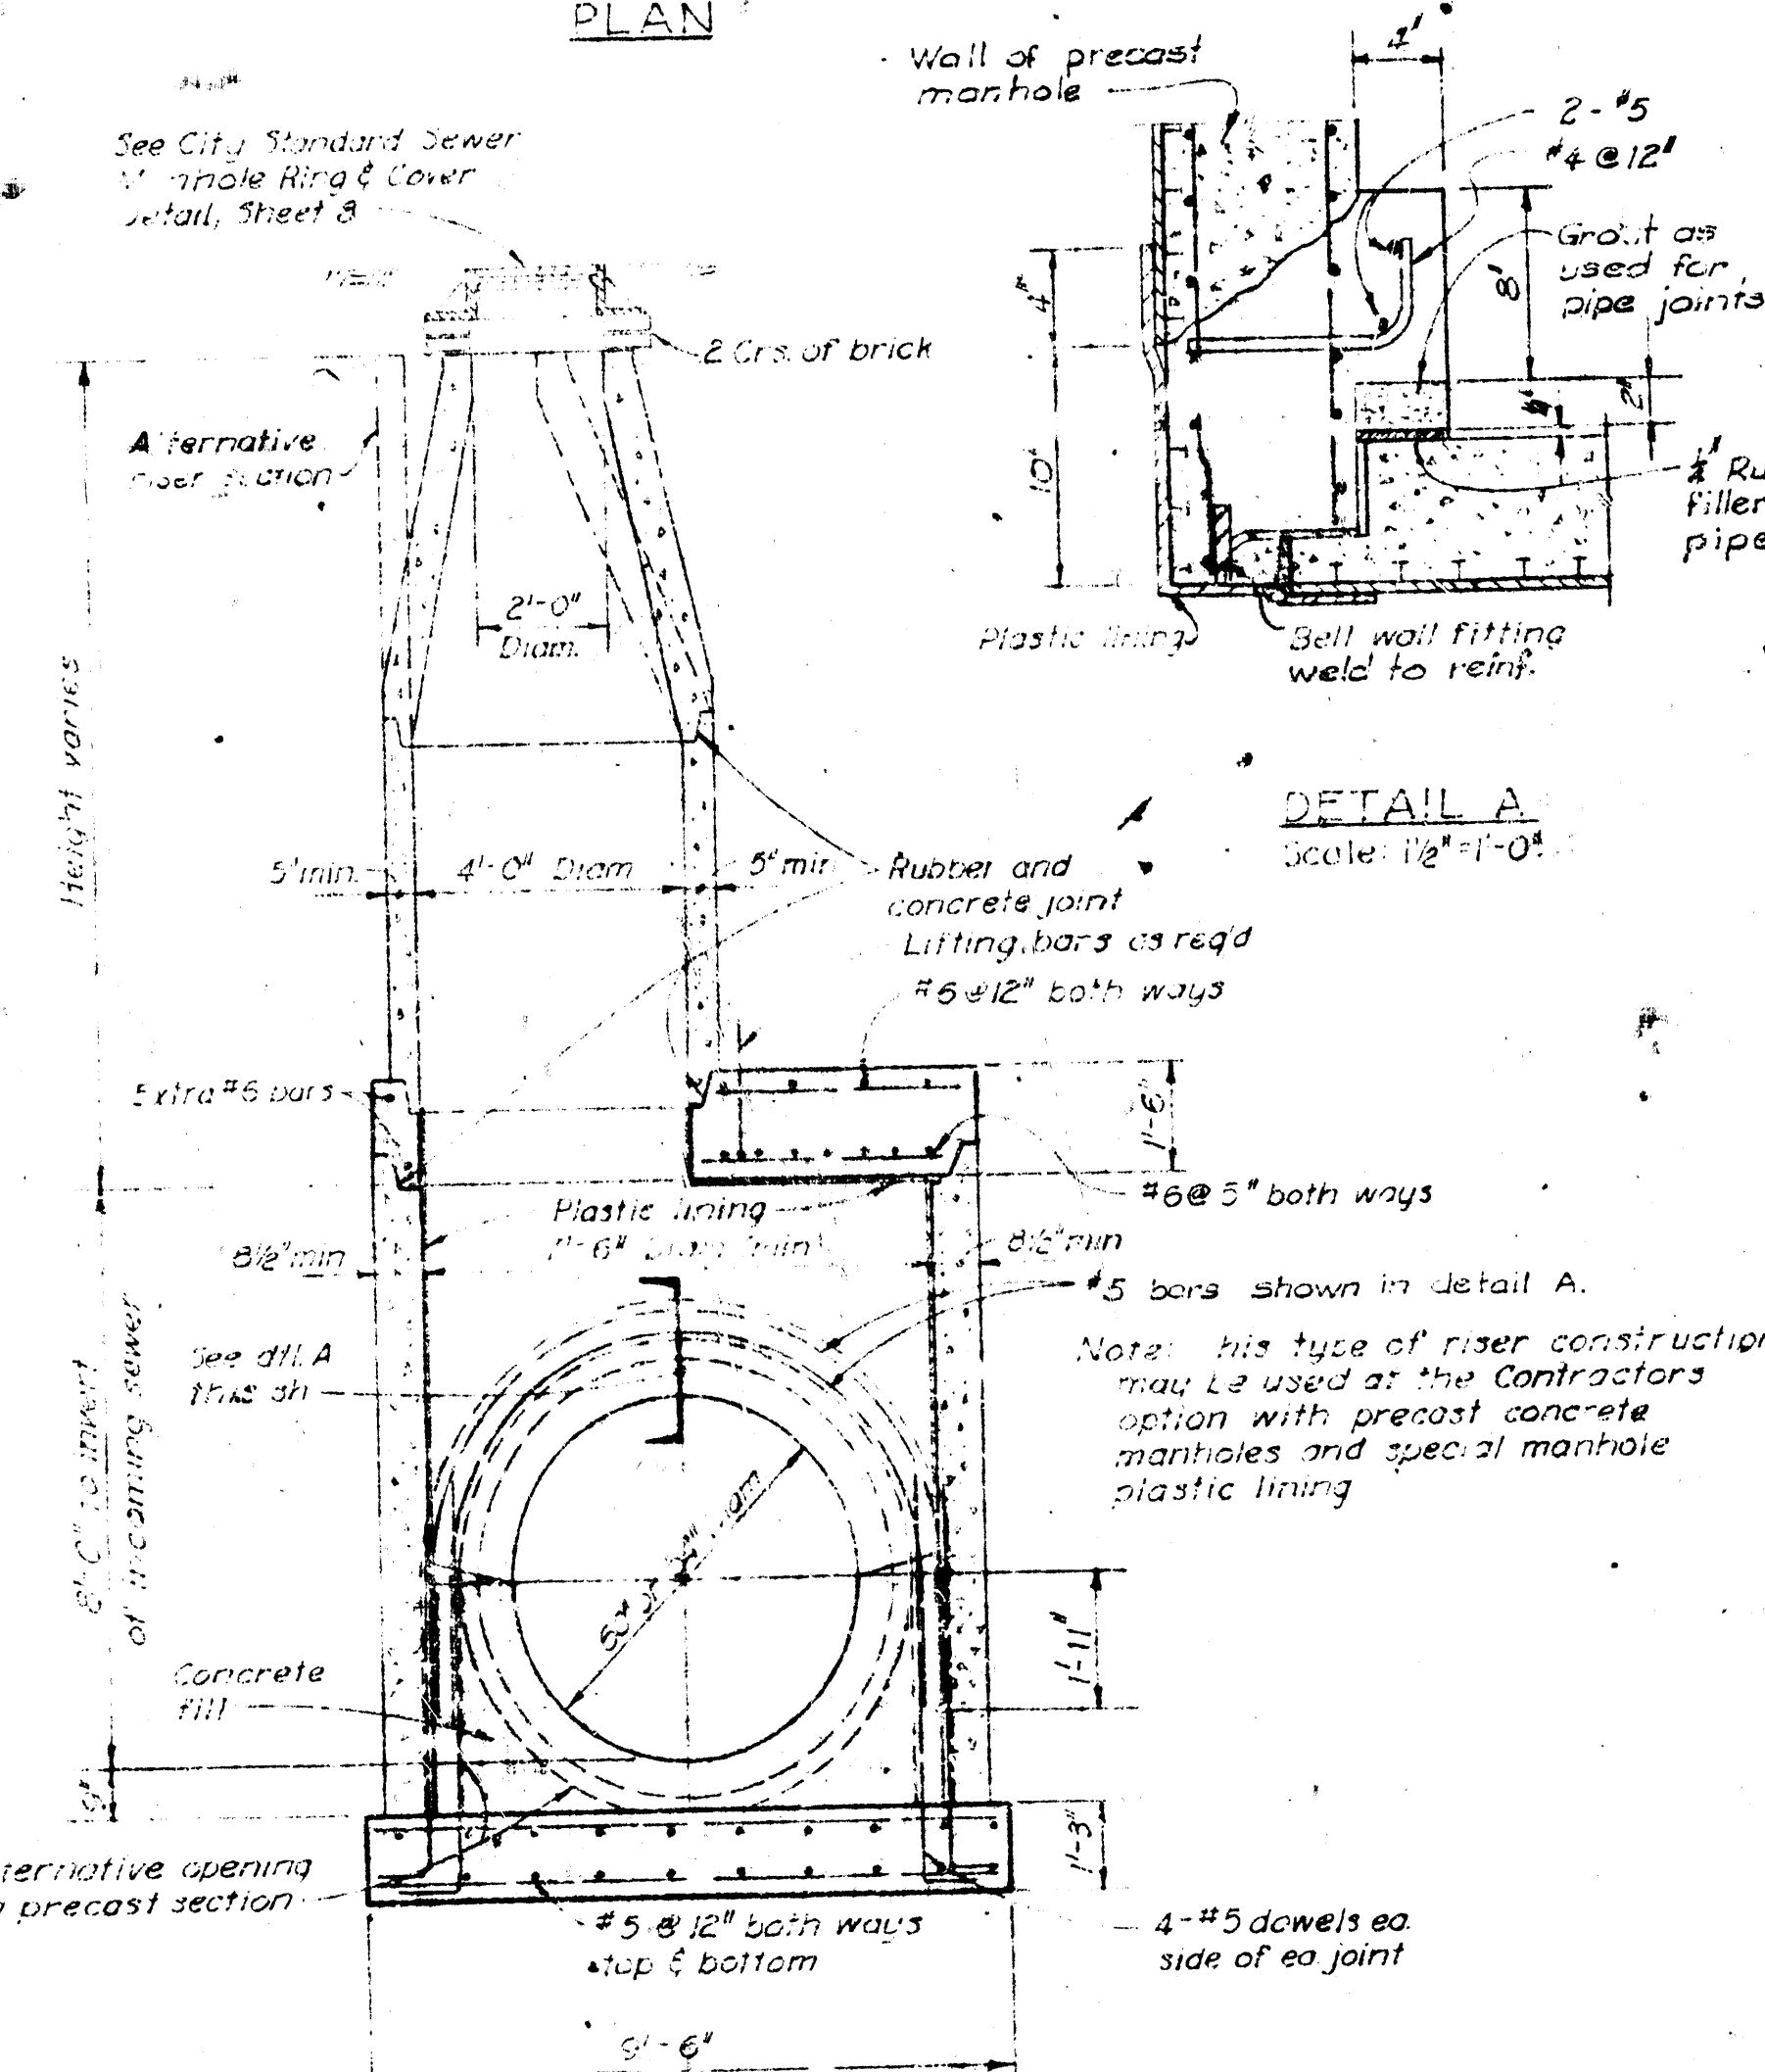

WALL JOINT DETAIL
Scale: 1/2" = 1'-0"

CONCRETE COLLAR DETAIL
Scale: 1/2" = 1'-0"

SECTION 3
Scale: 1/2" = 1'-0"

BRICK BOX OUT DETAIL
Scale: 1/2" = 1'-0"

DETAIL B
Scale: 1/2" = 1'-0"

CONTRACT NO. 1	
WICHITA, KANSAS	
SOUTHWEST INTERCEPTOR	
MANHOLE ALTERNATIVES & MISCELLANEOUS DETAILS	
BLACK & VEATCH CONSULTING ENGINEERS, KANSAS CITY, MO.	
DESIGNED BY: <i>GMG</i>	CHECKED BY: <i>GMG</i>
DATE: <i>12/93</i>	APPROVED BY: <i>GMG</i>
SHEET 10 OF 10	