

CONFORMED TO CONSTRUCTION RECORDS

PLANS FOR

SEWERAGE IMPROVEMENTS

WICHITA, KANSAS


SOUTHWEST INTERCEPTOR


CONTRACT NO. 1


PROJECT NO. 2844


BLACK & VEATCH
CONSULTING ENGINEERS
KANSAS CITY, MISSOURI


1968

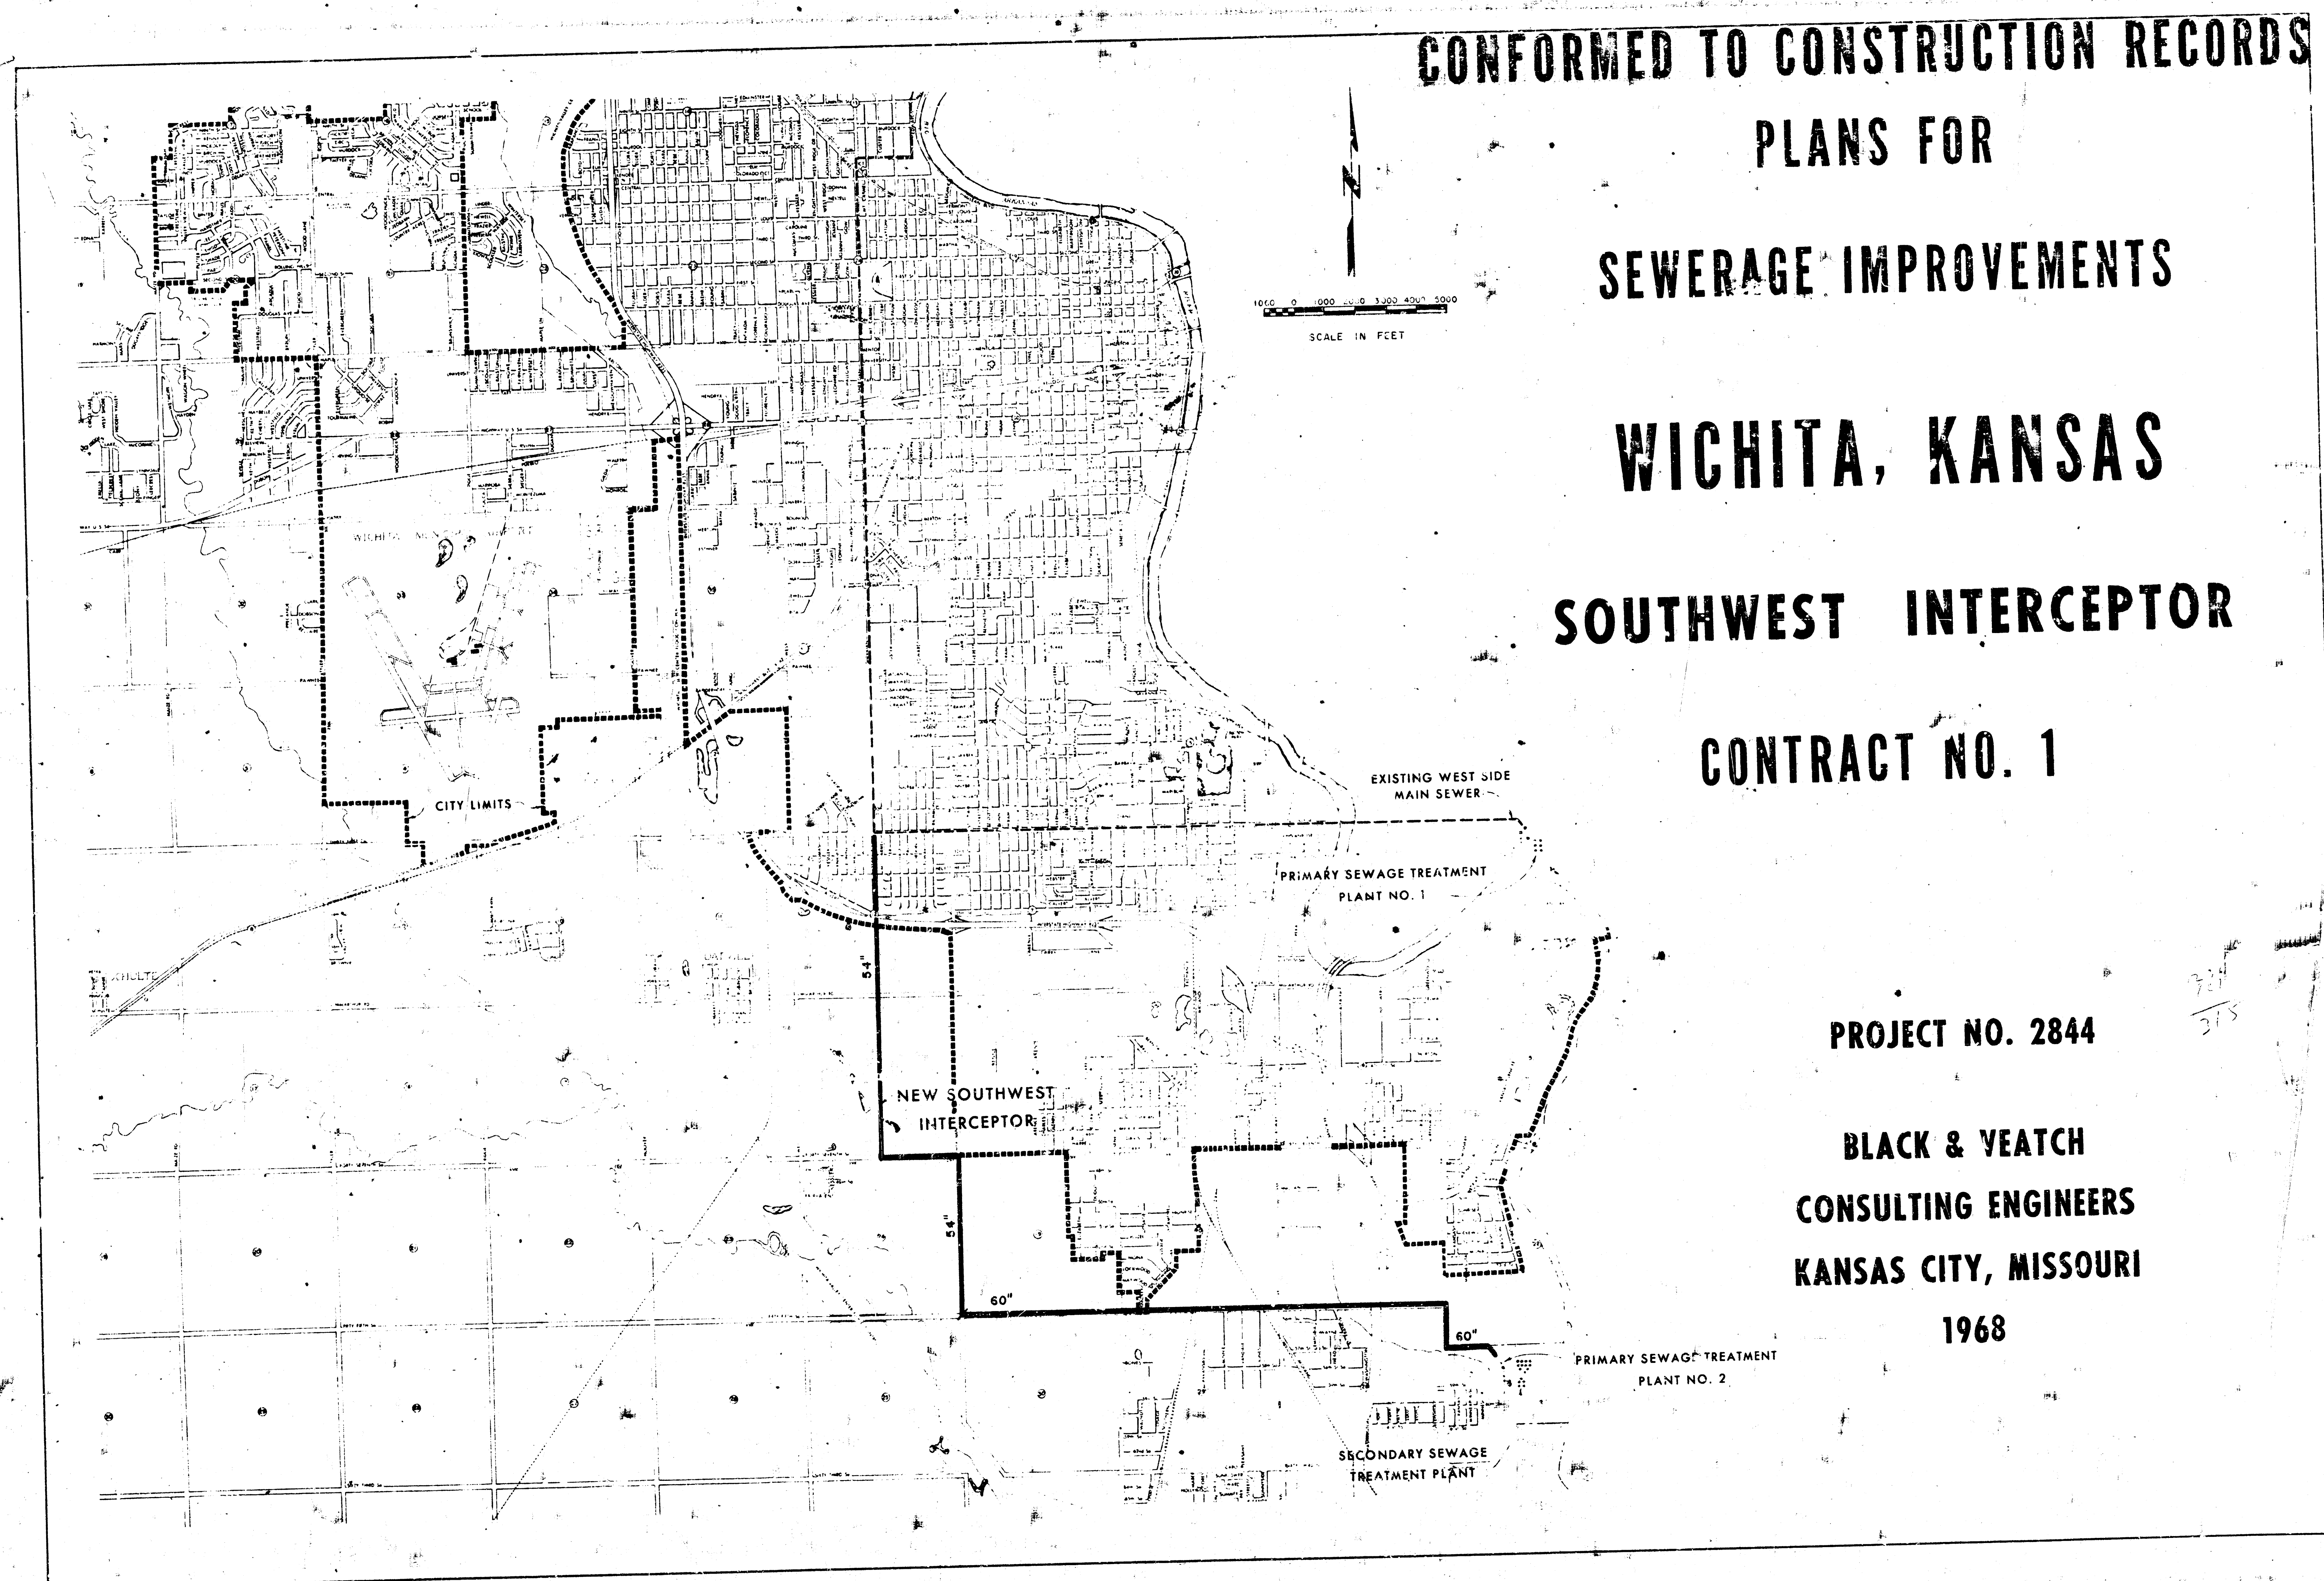

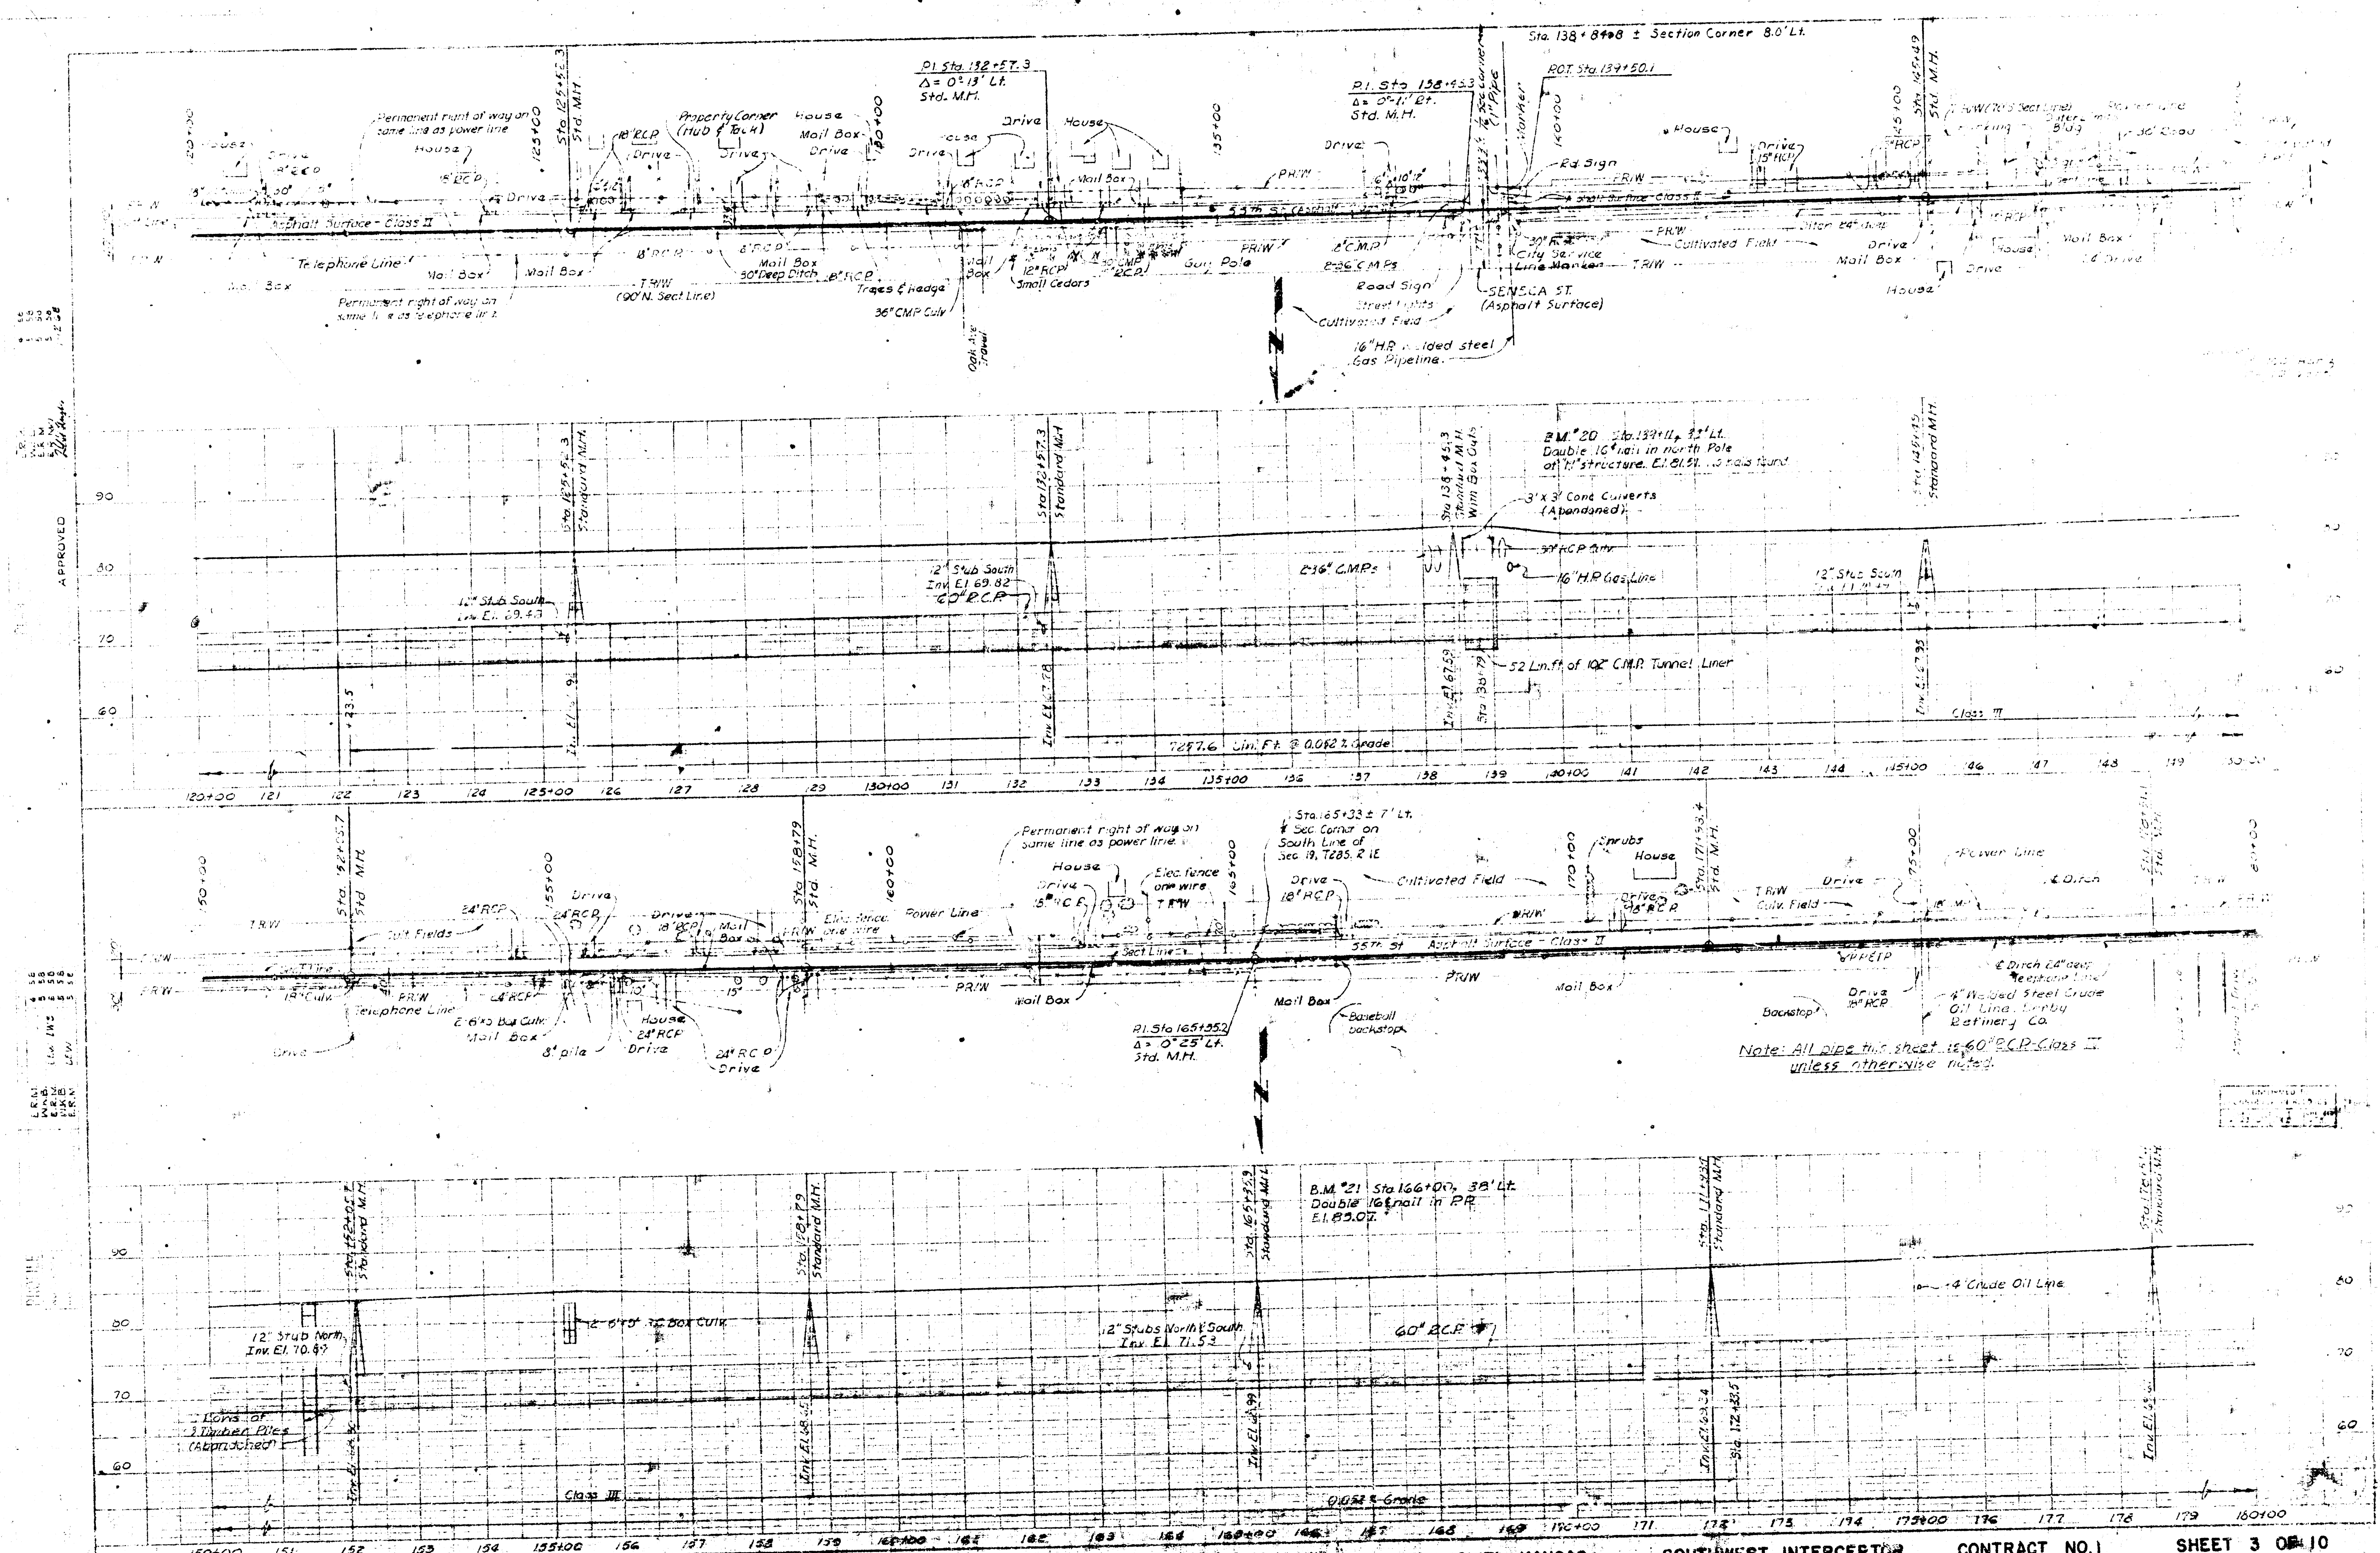

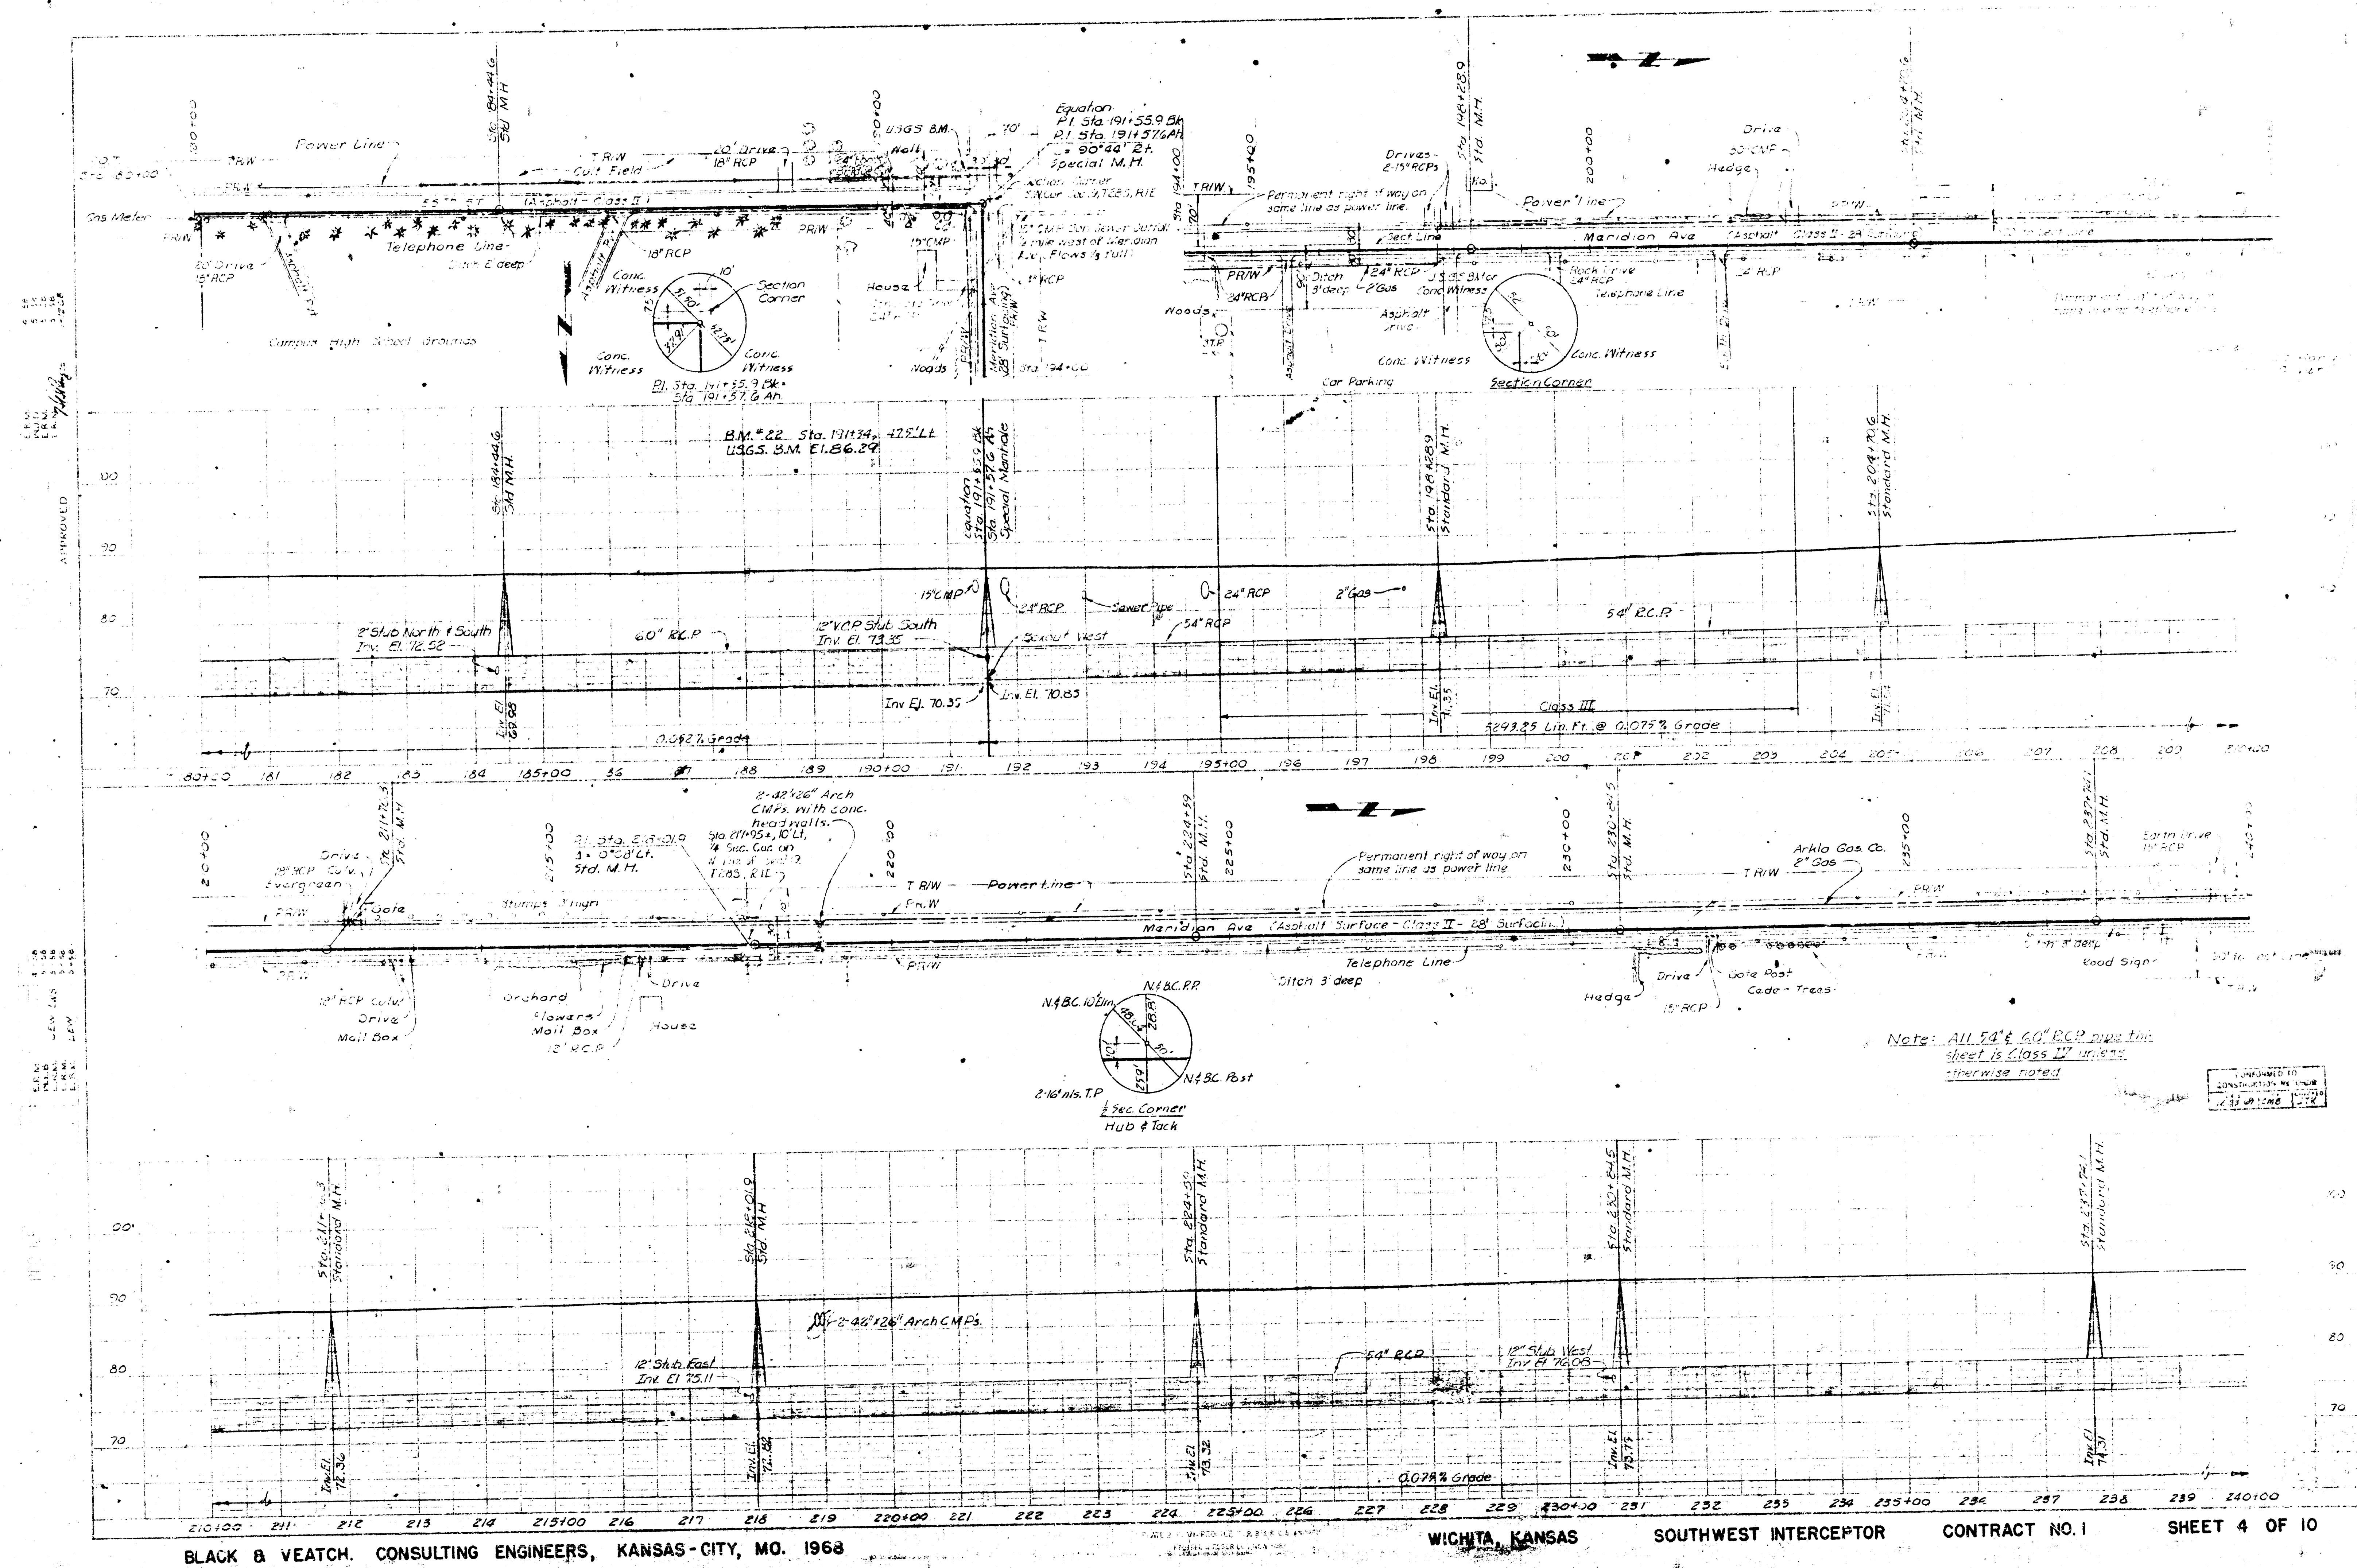


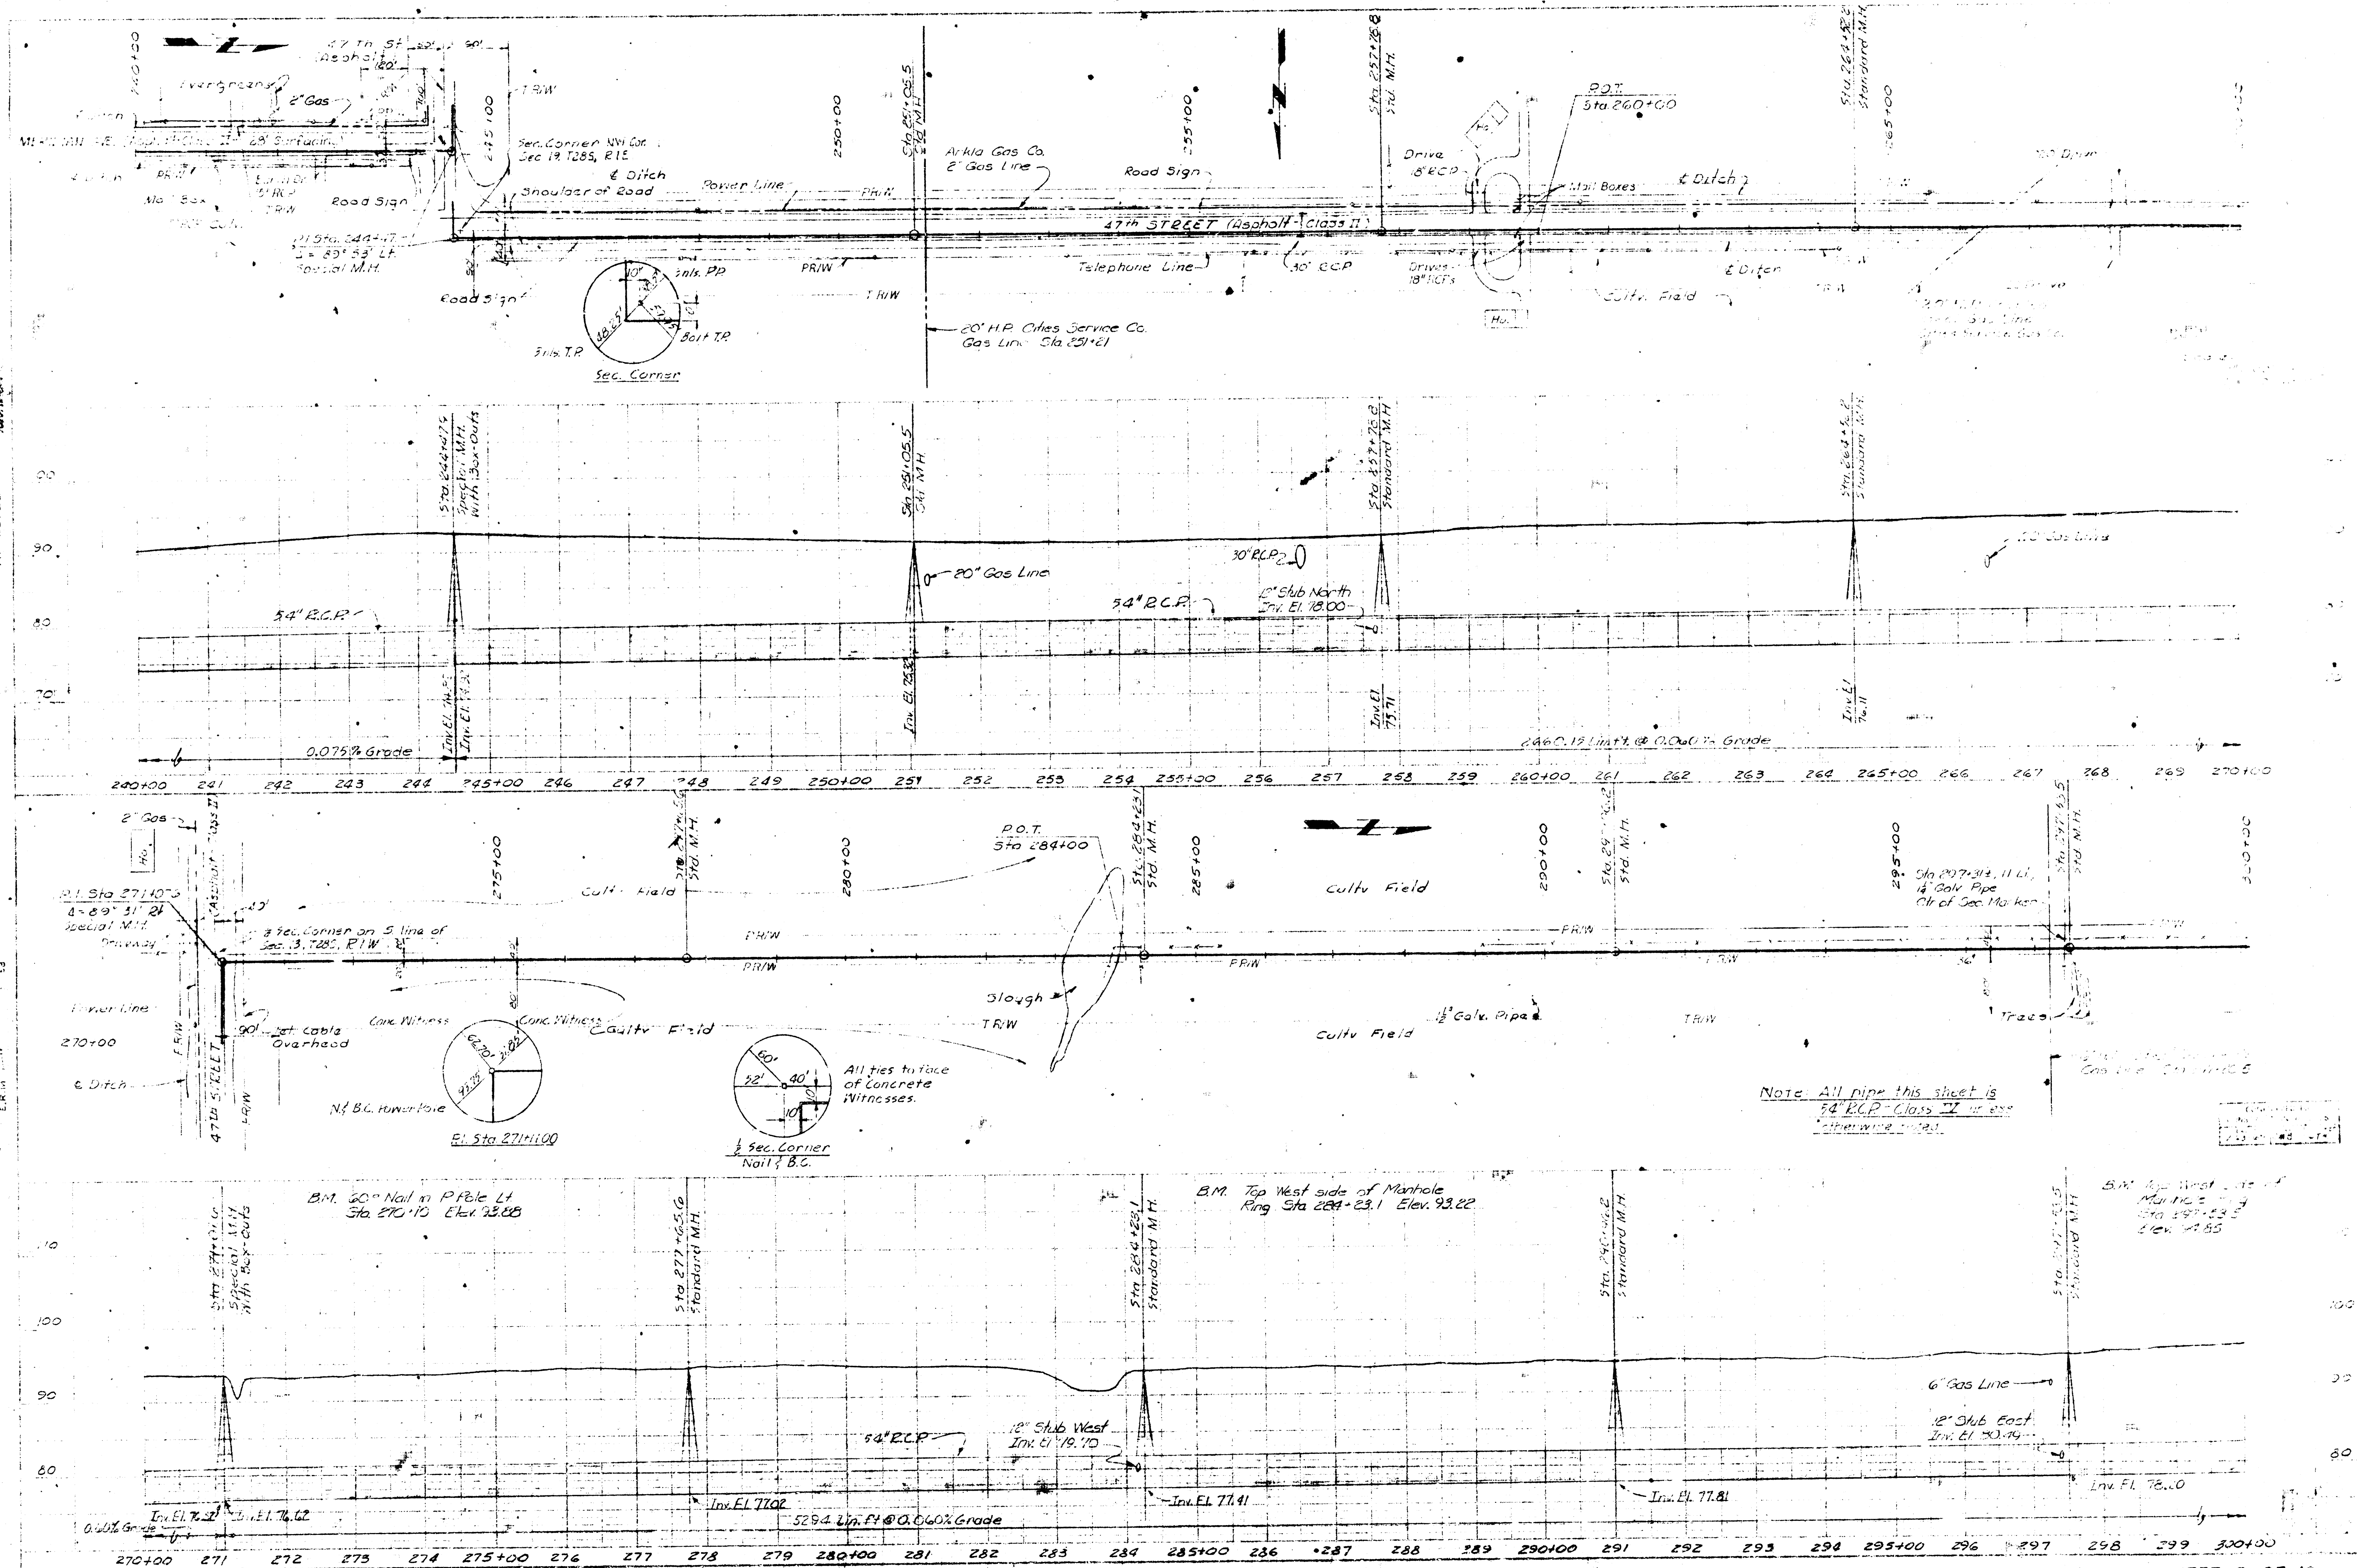


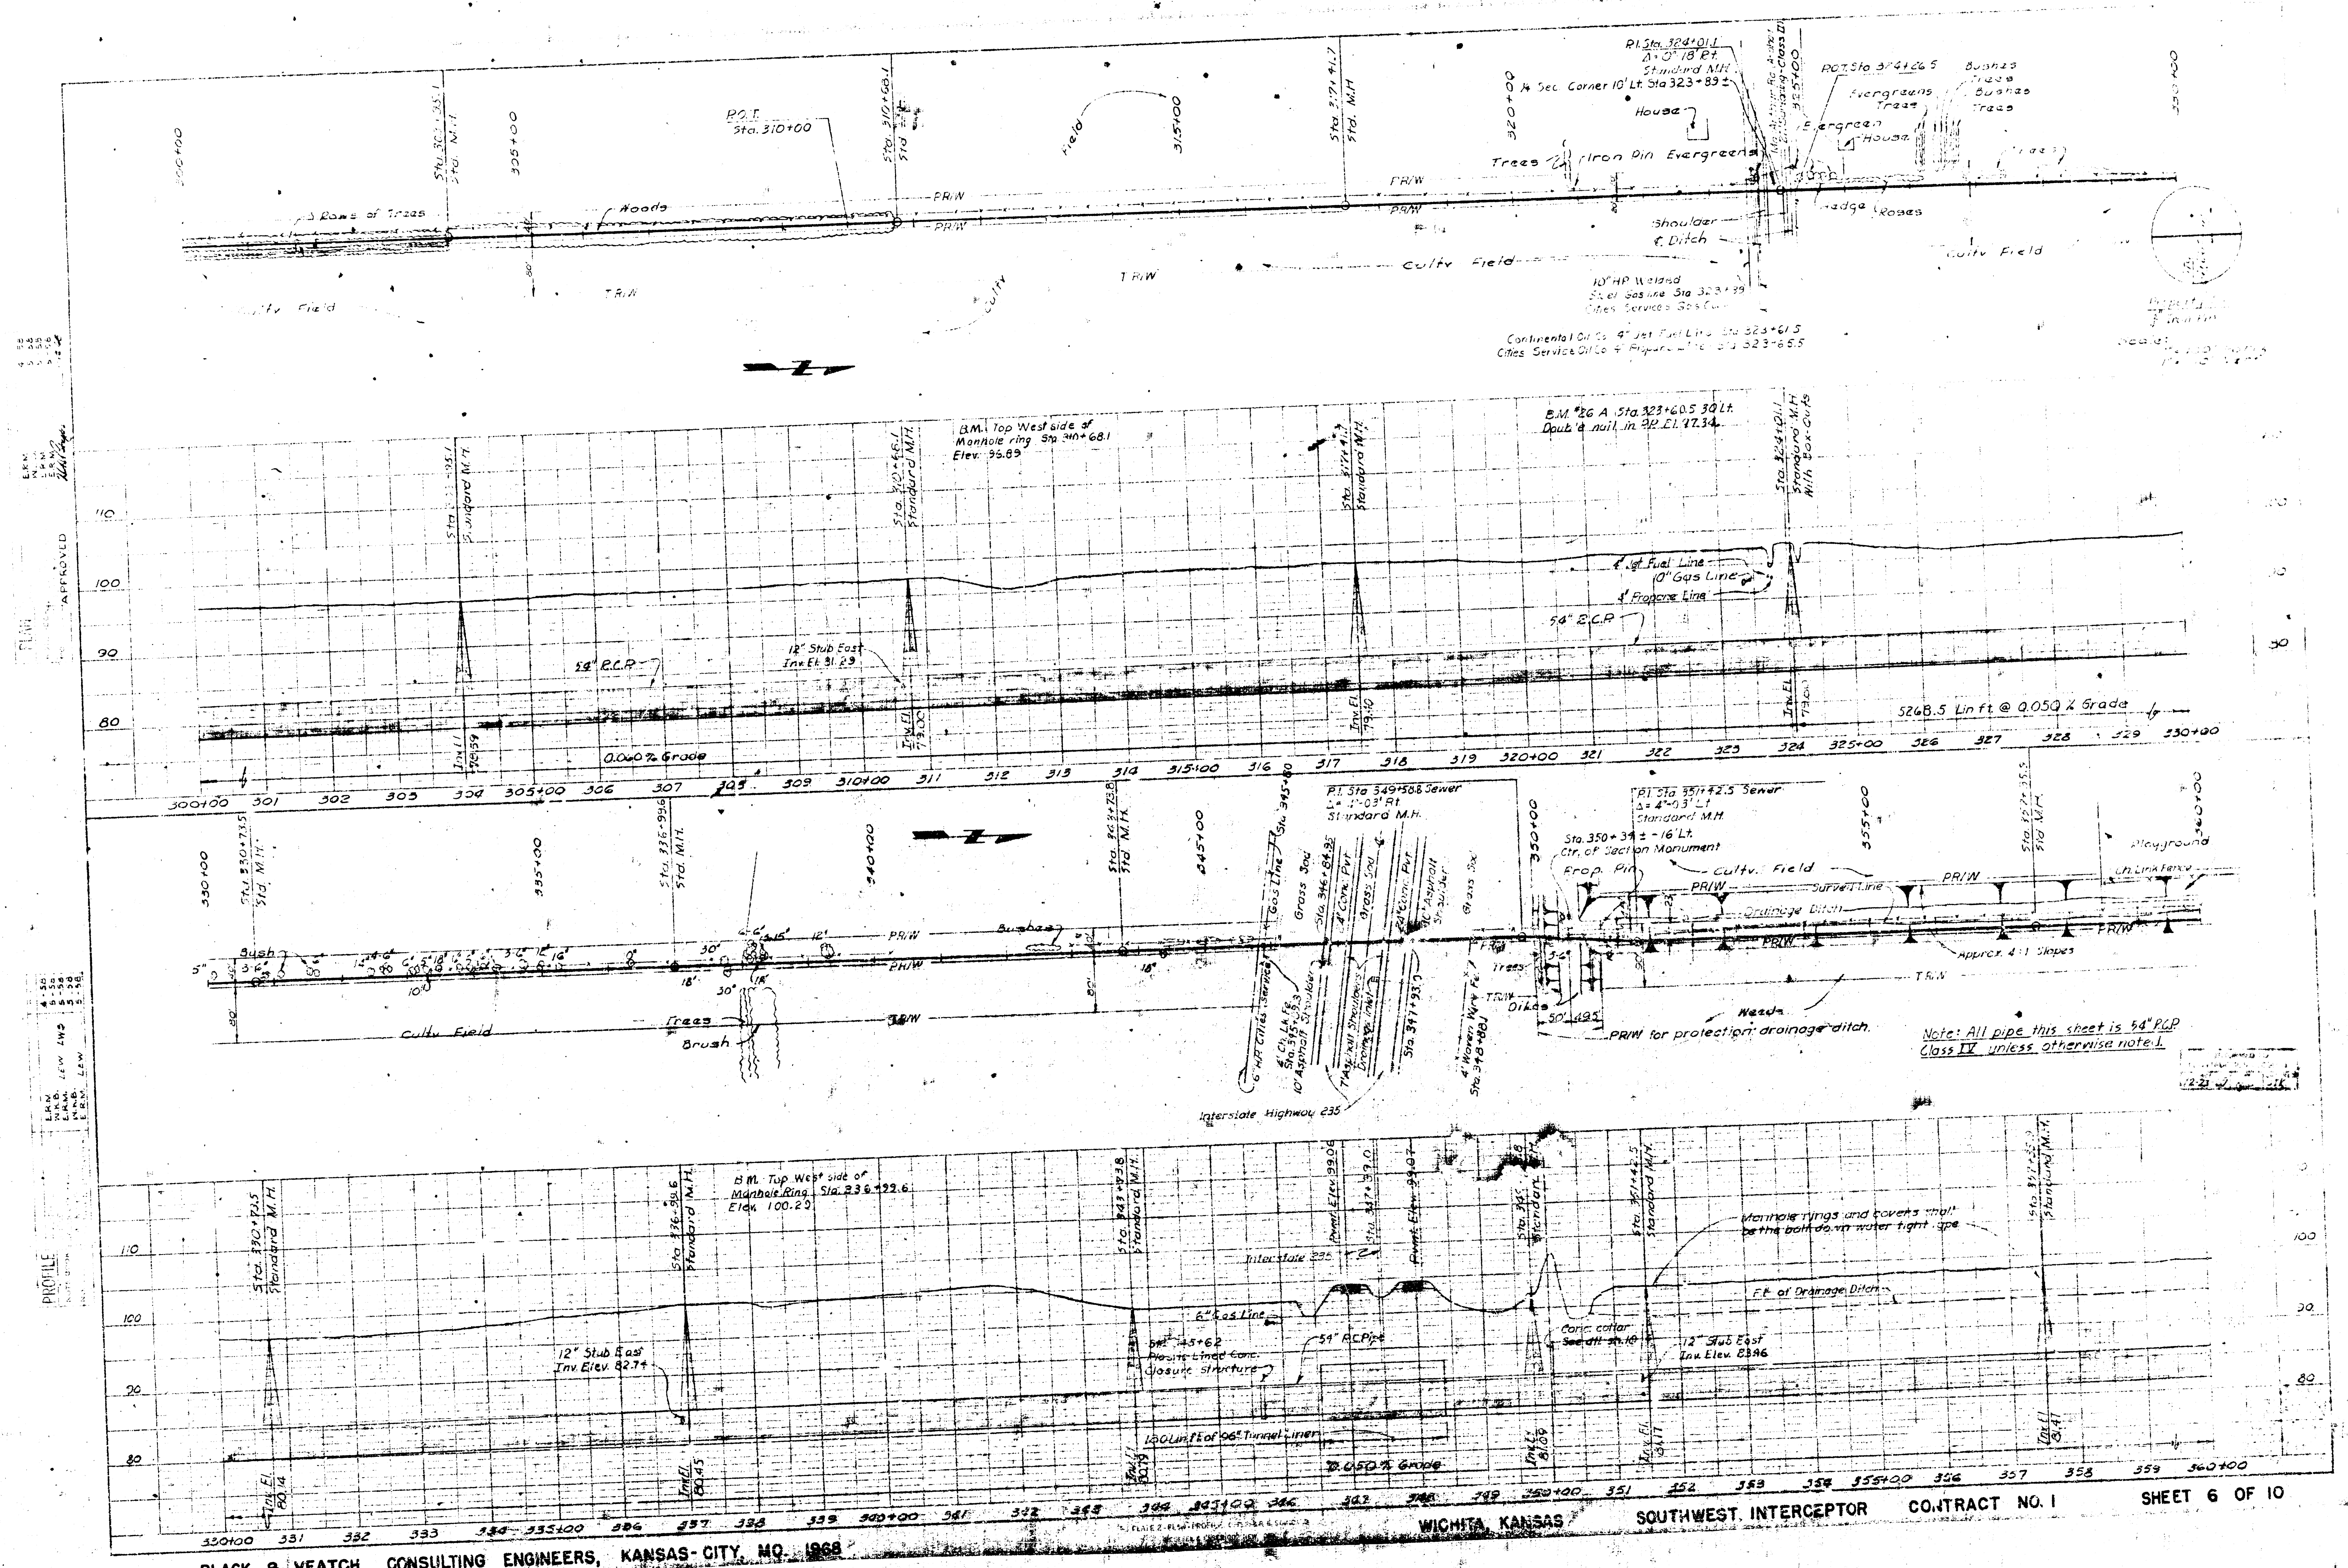


BLACK & VEATCH, CONSULTING ENGINEERS, KANSAS-CITY, MO. 1968



SOUTHWEST INTERCEPTOR CONTRACT NO. 1
WICHITA, KANSAS
SHEET 6 OF 10

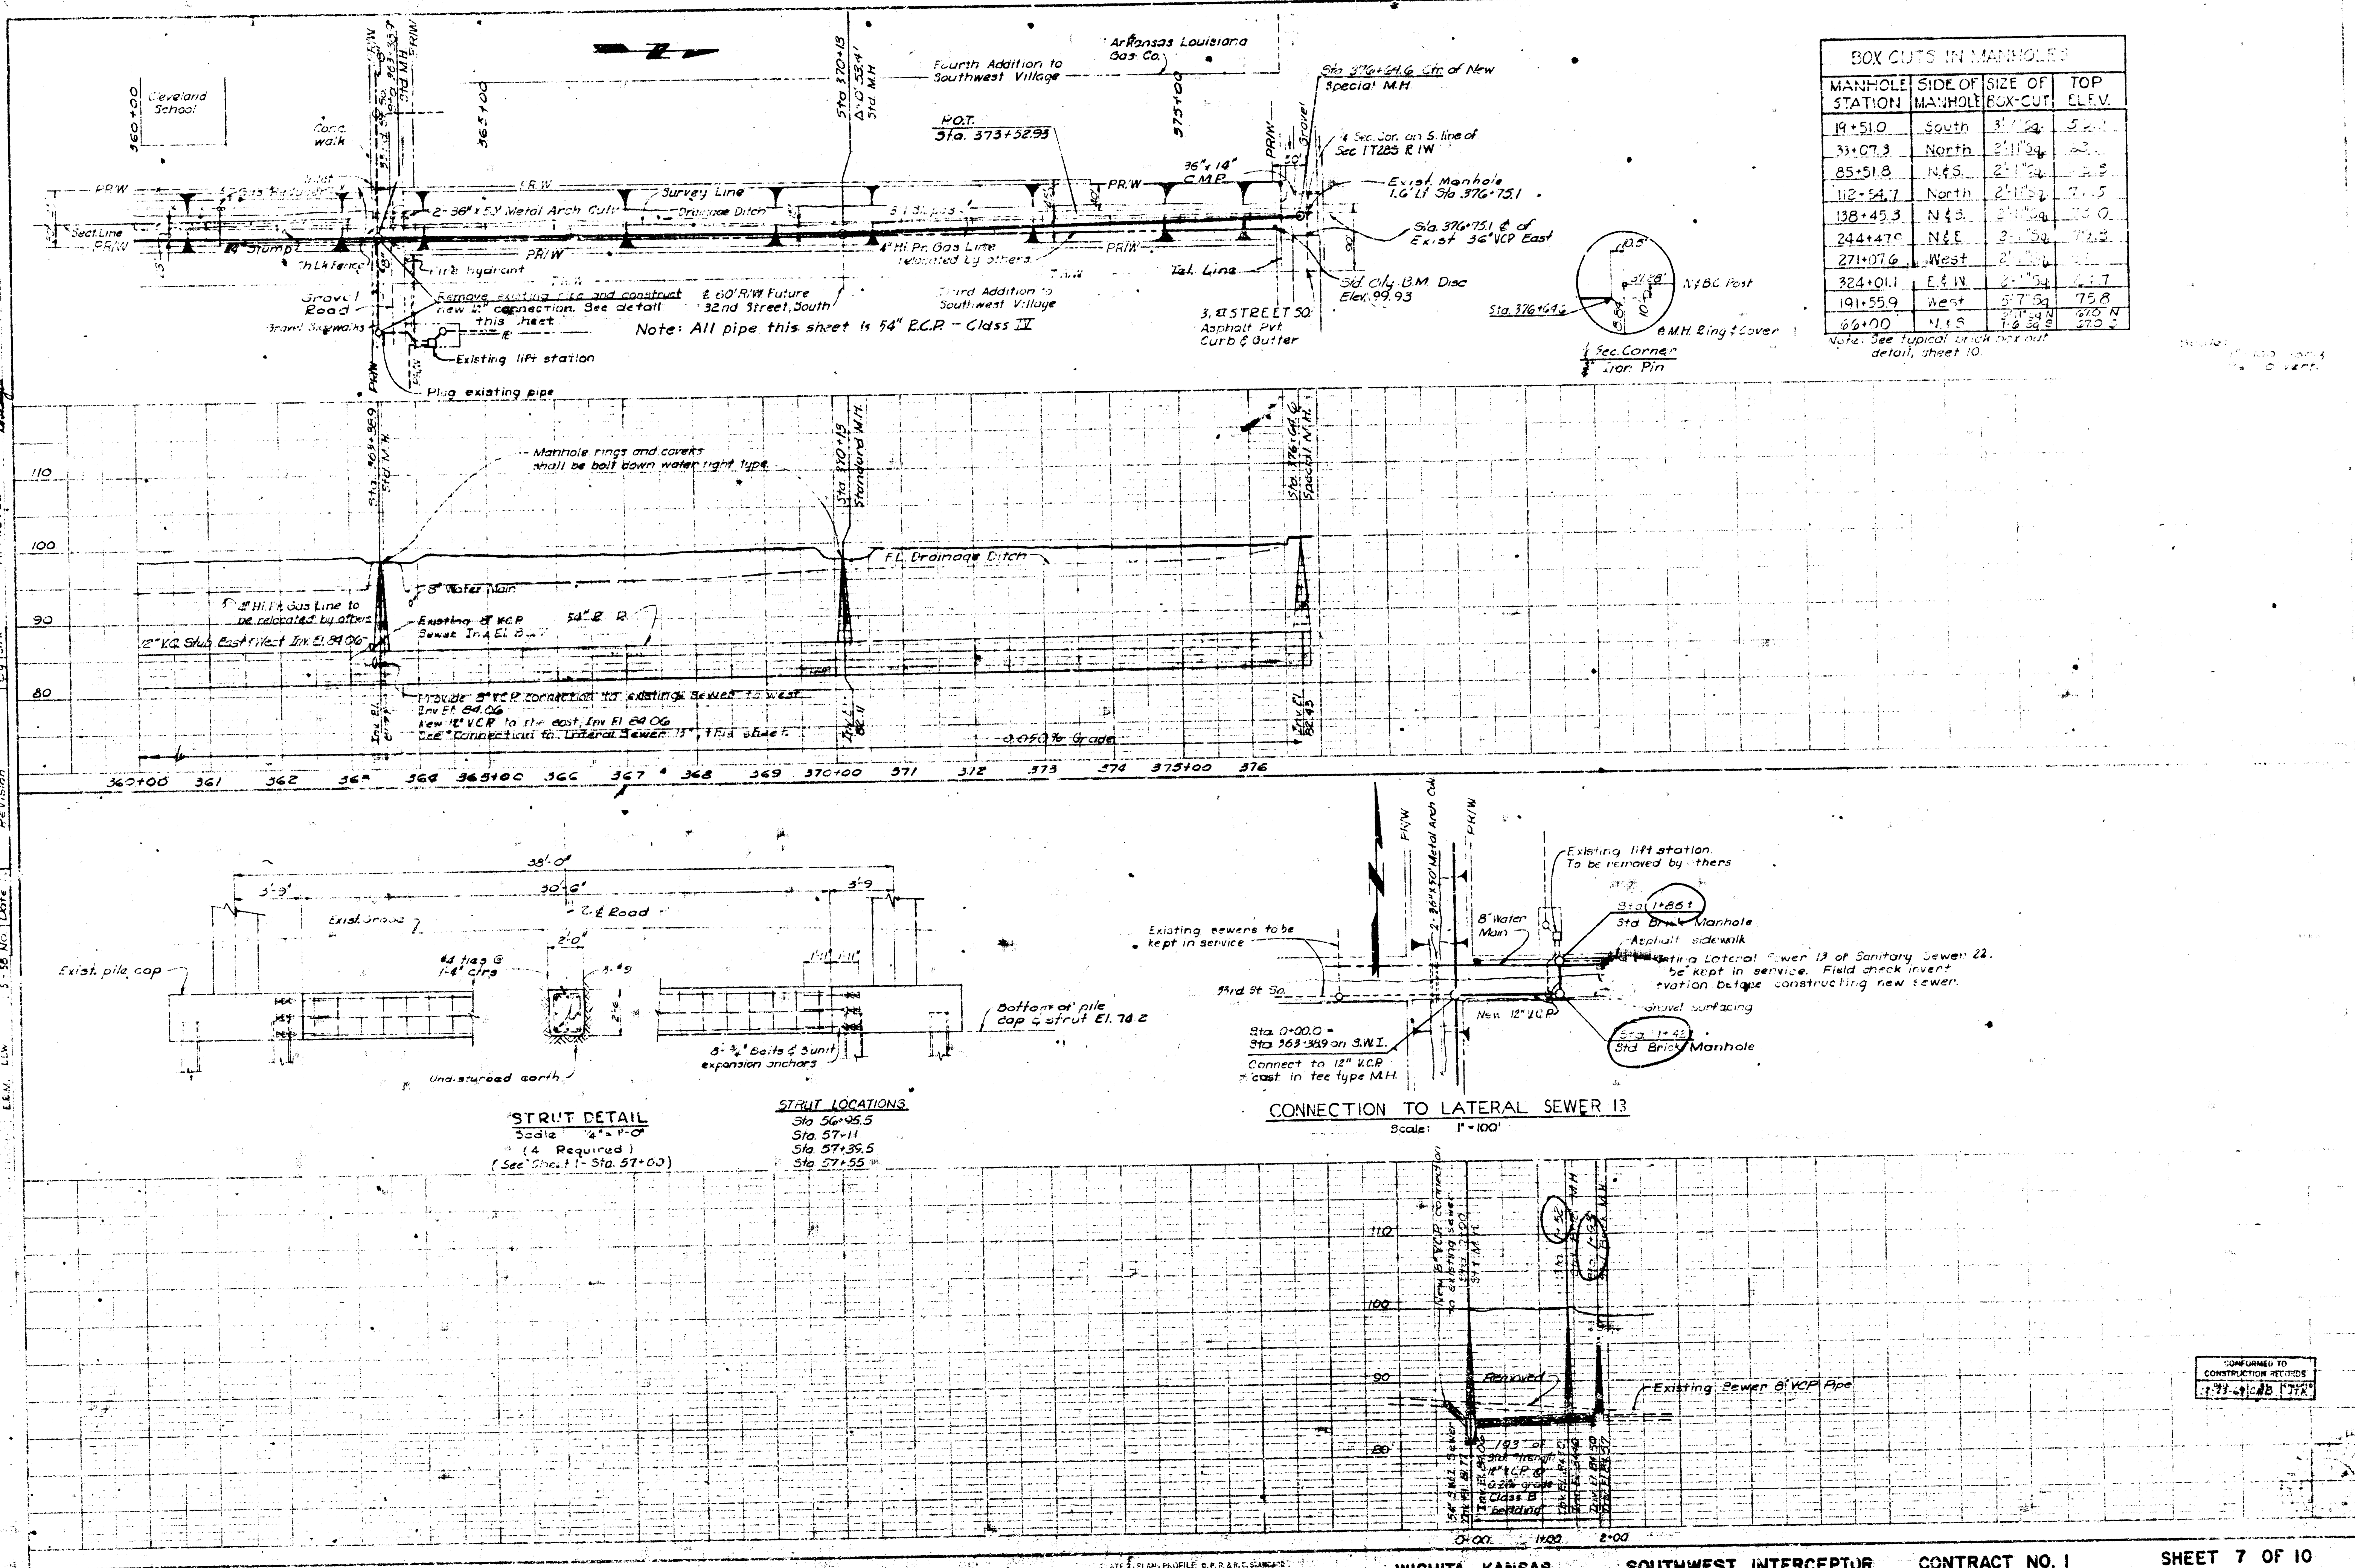

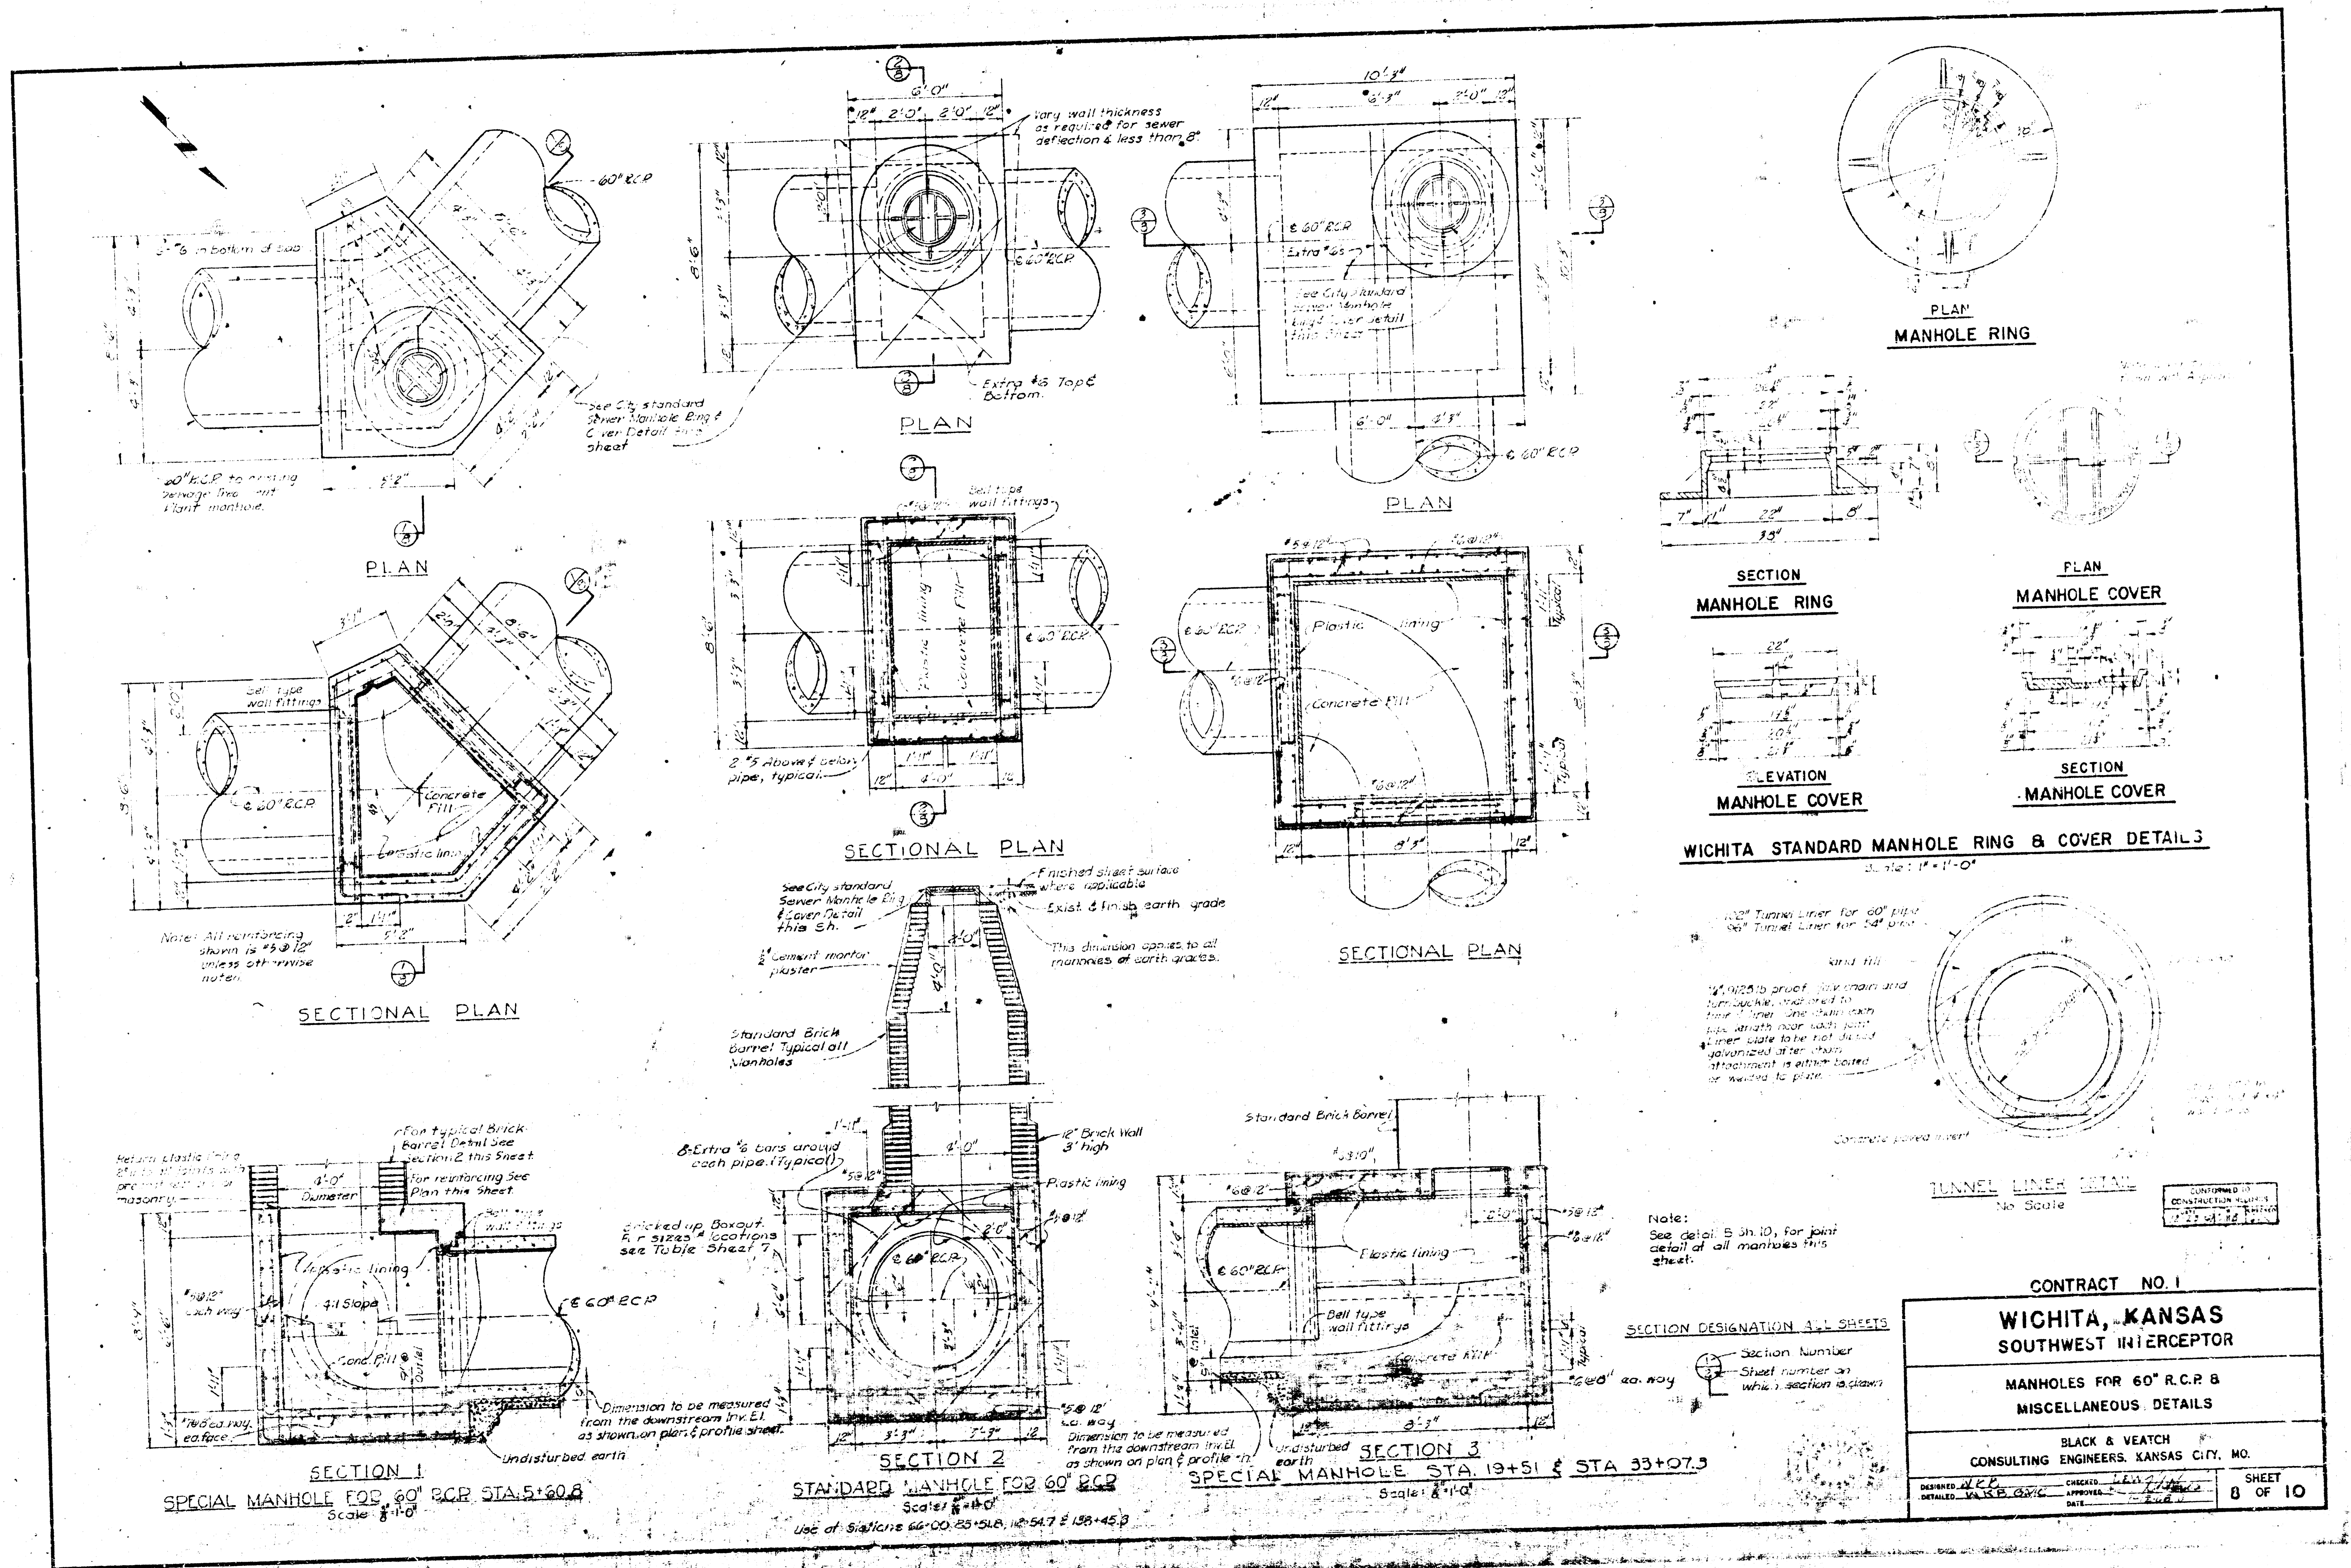


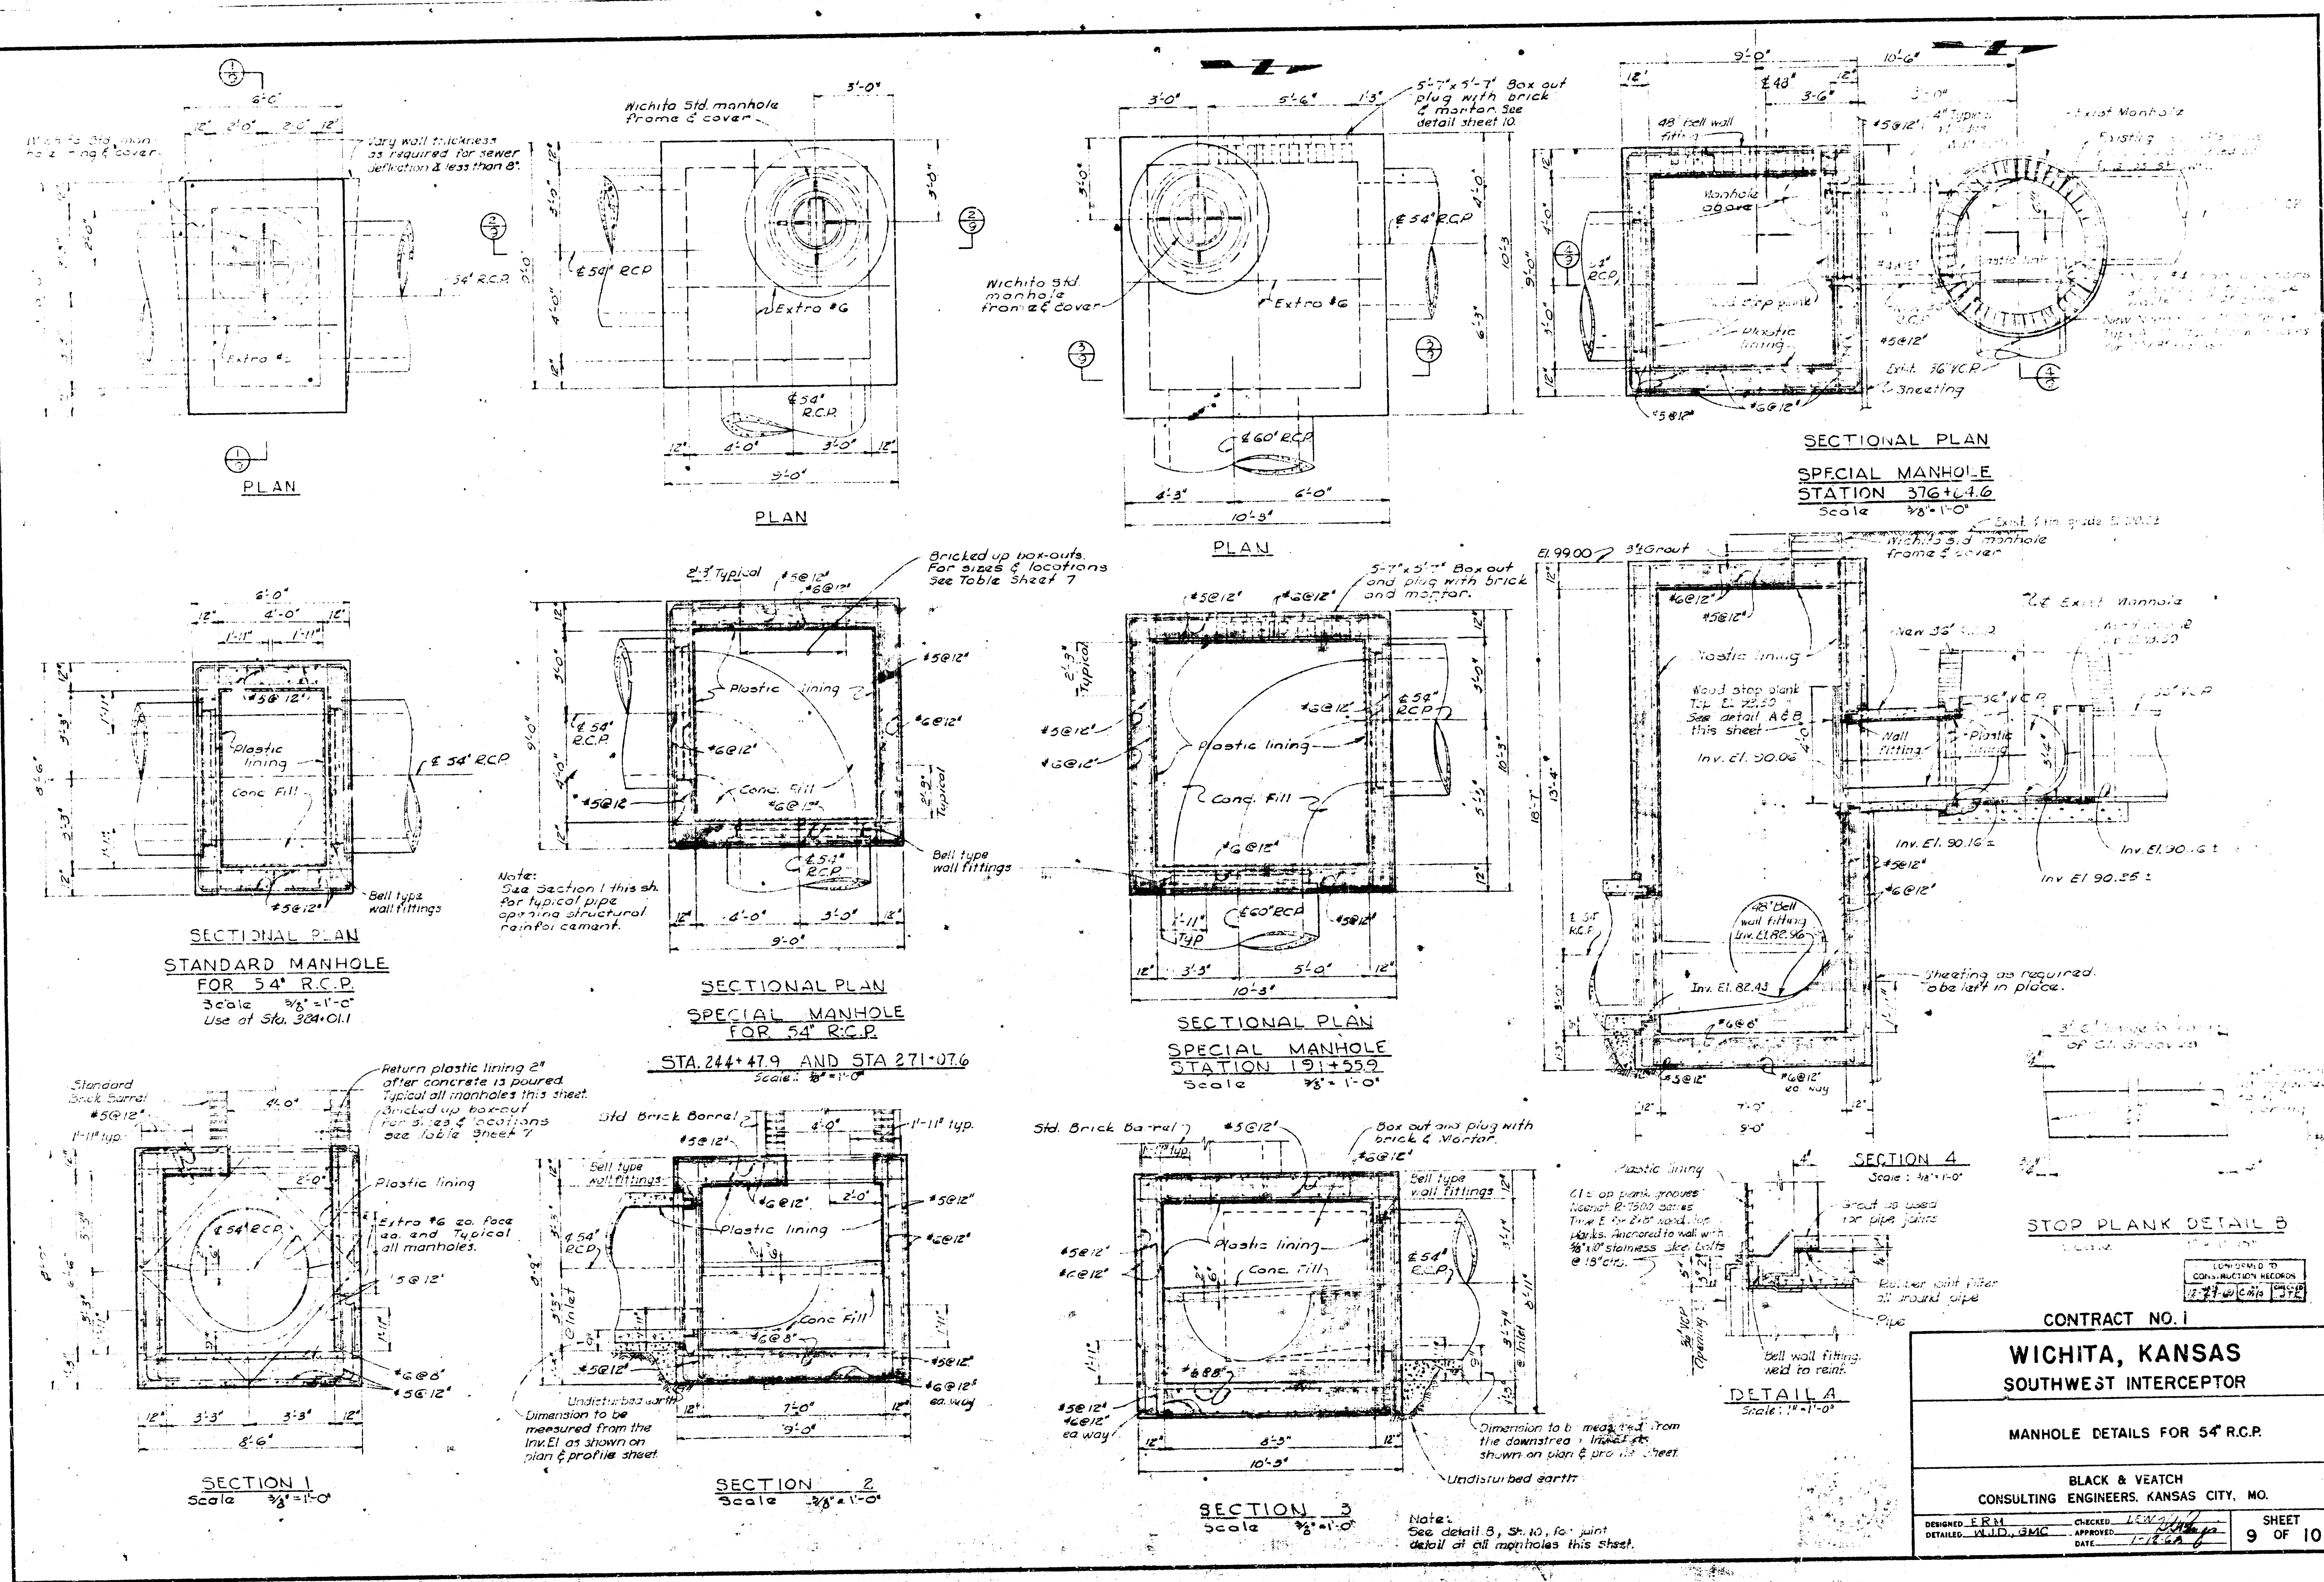

CONTRACT NO. 1	
WICHITA, KANSAS	
SOUTHWEST INTERCEPTOR	
MANHOLE DETAILS FOR 34" R.C.P.	
BLACK & VEATCH	
CONSULTING ENGINEERS, KANSAS CITY, MO.	
DESIGNED: F.R.I.	CHECKED: L.R.M.
DETAILED: J.D.D., G.M.C.	APPROVED: J.D.D.
DATE: 12/22/64	DATE: 12/22/64
SHEET 9 OF 10	

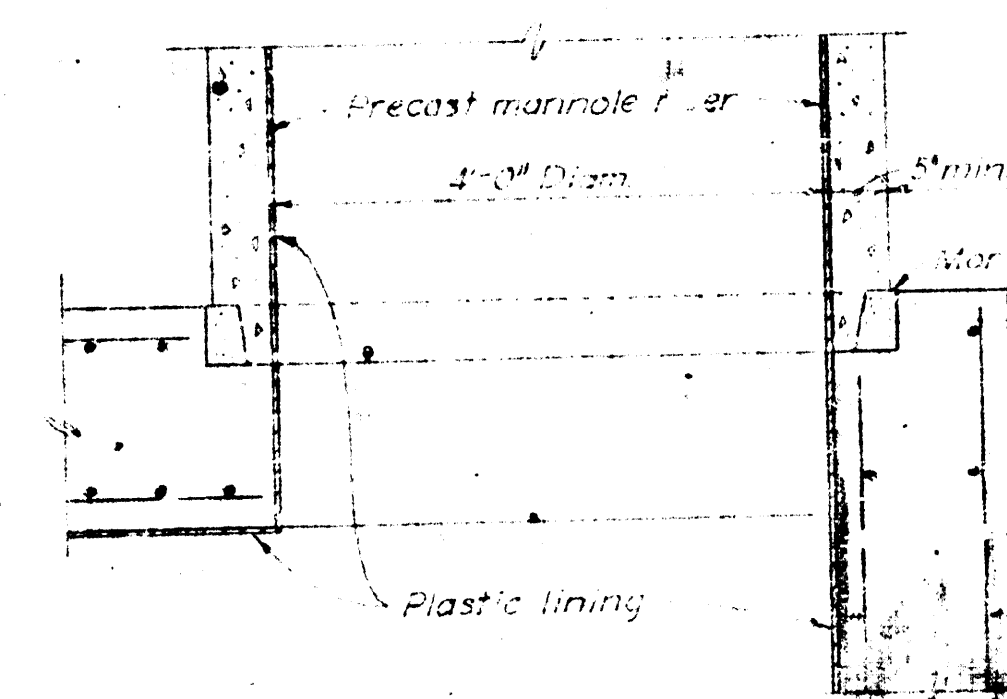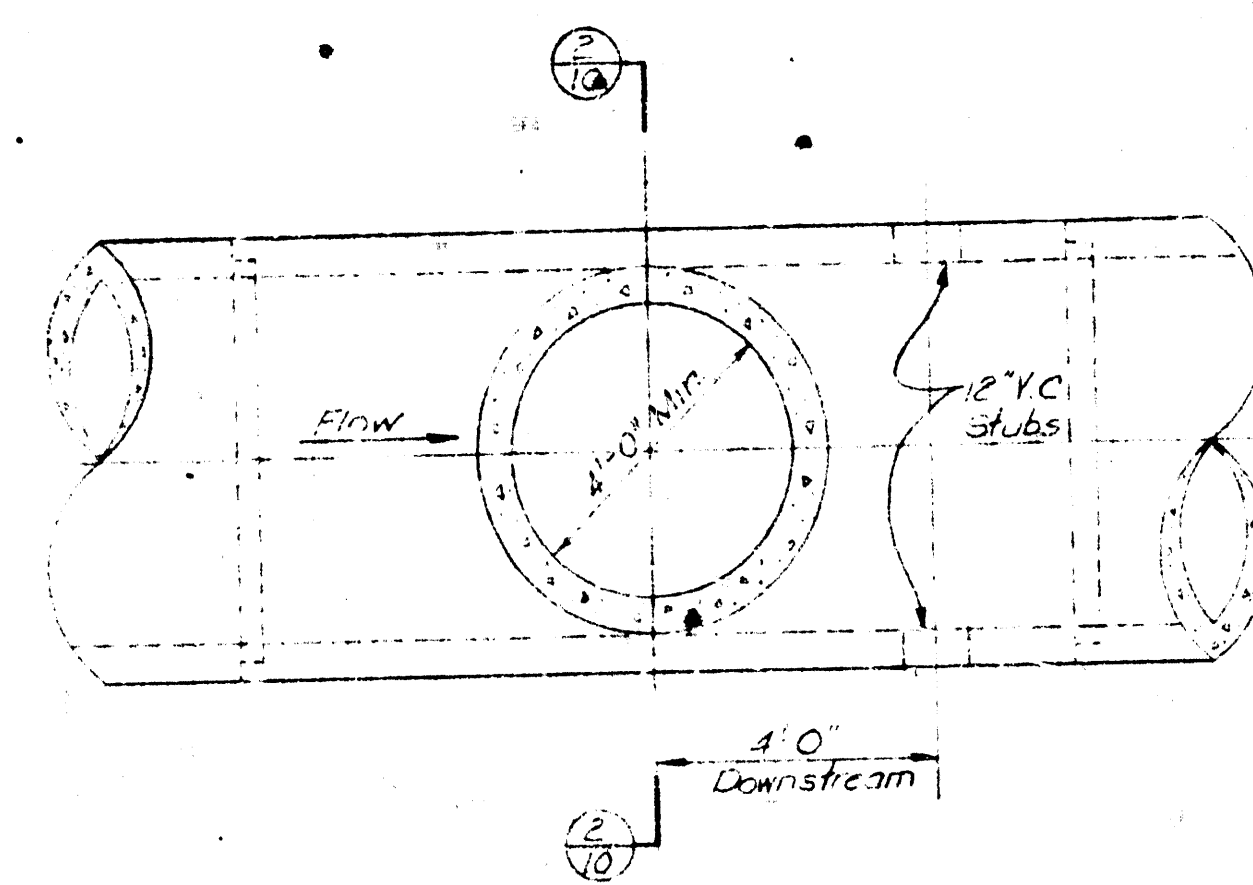


Marker color and
casting as shown

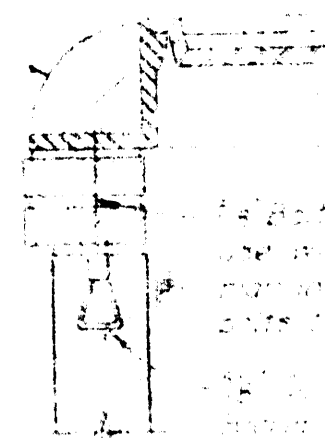


But still for many days after he returned to work he required only a few minutes' sleep and he felt that he was not getting any sleep at all. He had the same feeling for the first few days after he returned to work. He felt that he was not getting any sleep at all.

PRECAST RISER ON POUPED
MANHOLE DETAIL
Scale 3/4" = 1'-0"
NOT USED


COLLEGE BOUND MEMBERS
COLLEGE DELIA
MAY 1955

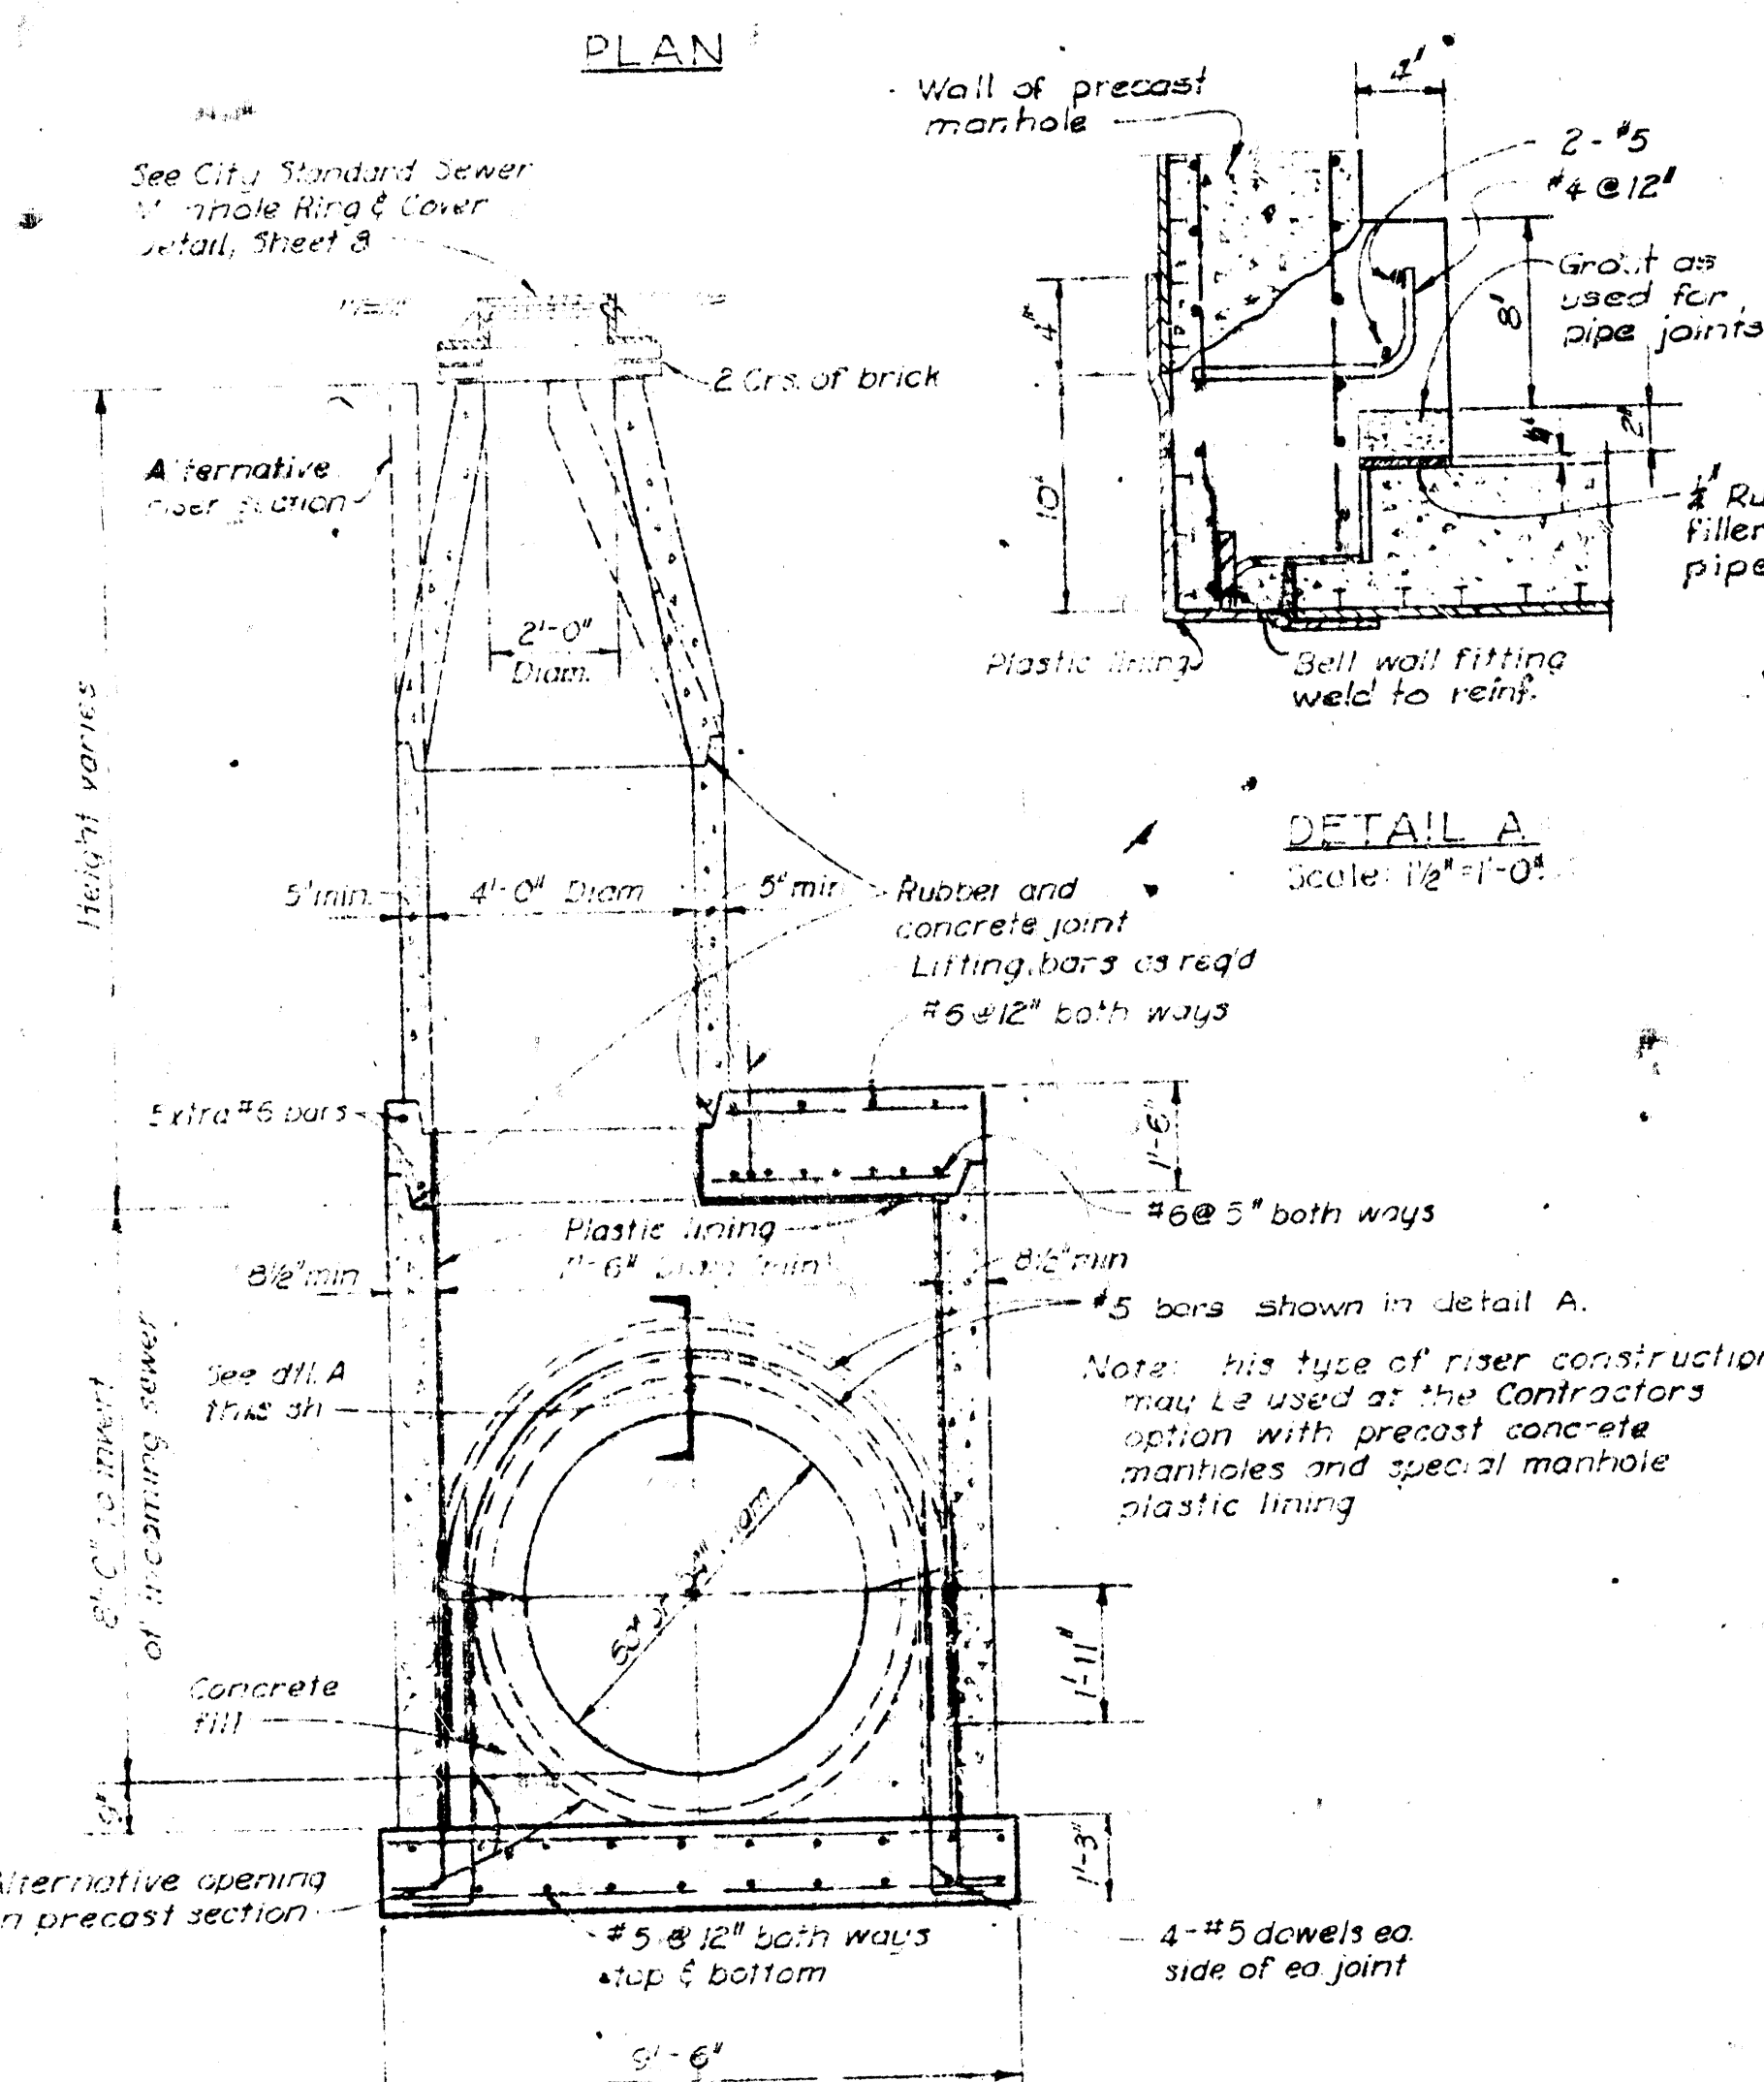


SECTION 1
ALTERNATIVE NO. 1
STANDARD MANHOLE DETAIL
Scale: $\frac{3}{8}" = 1' - 0"$
NOT USED

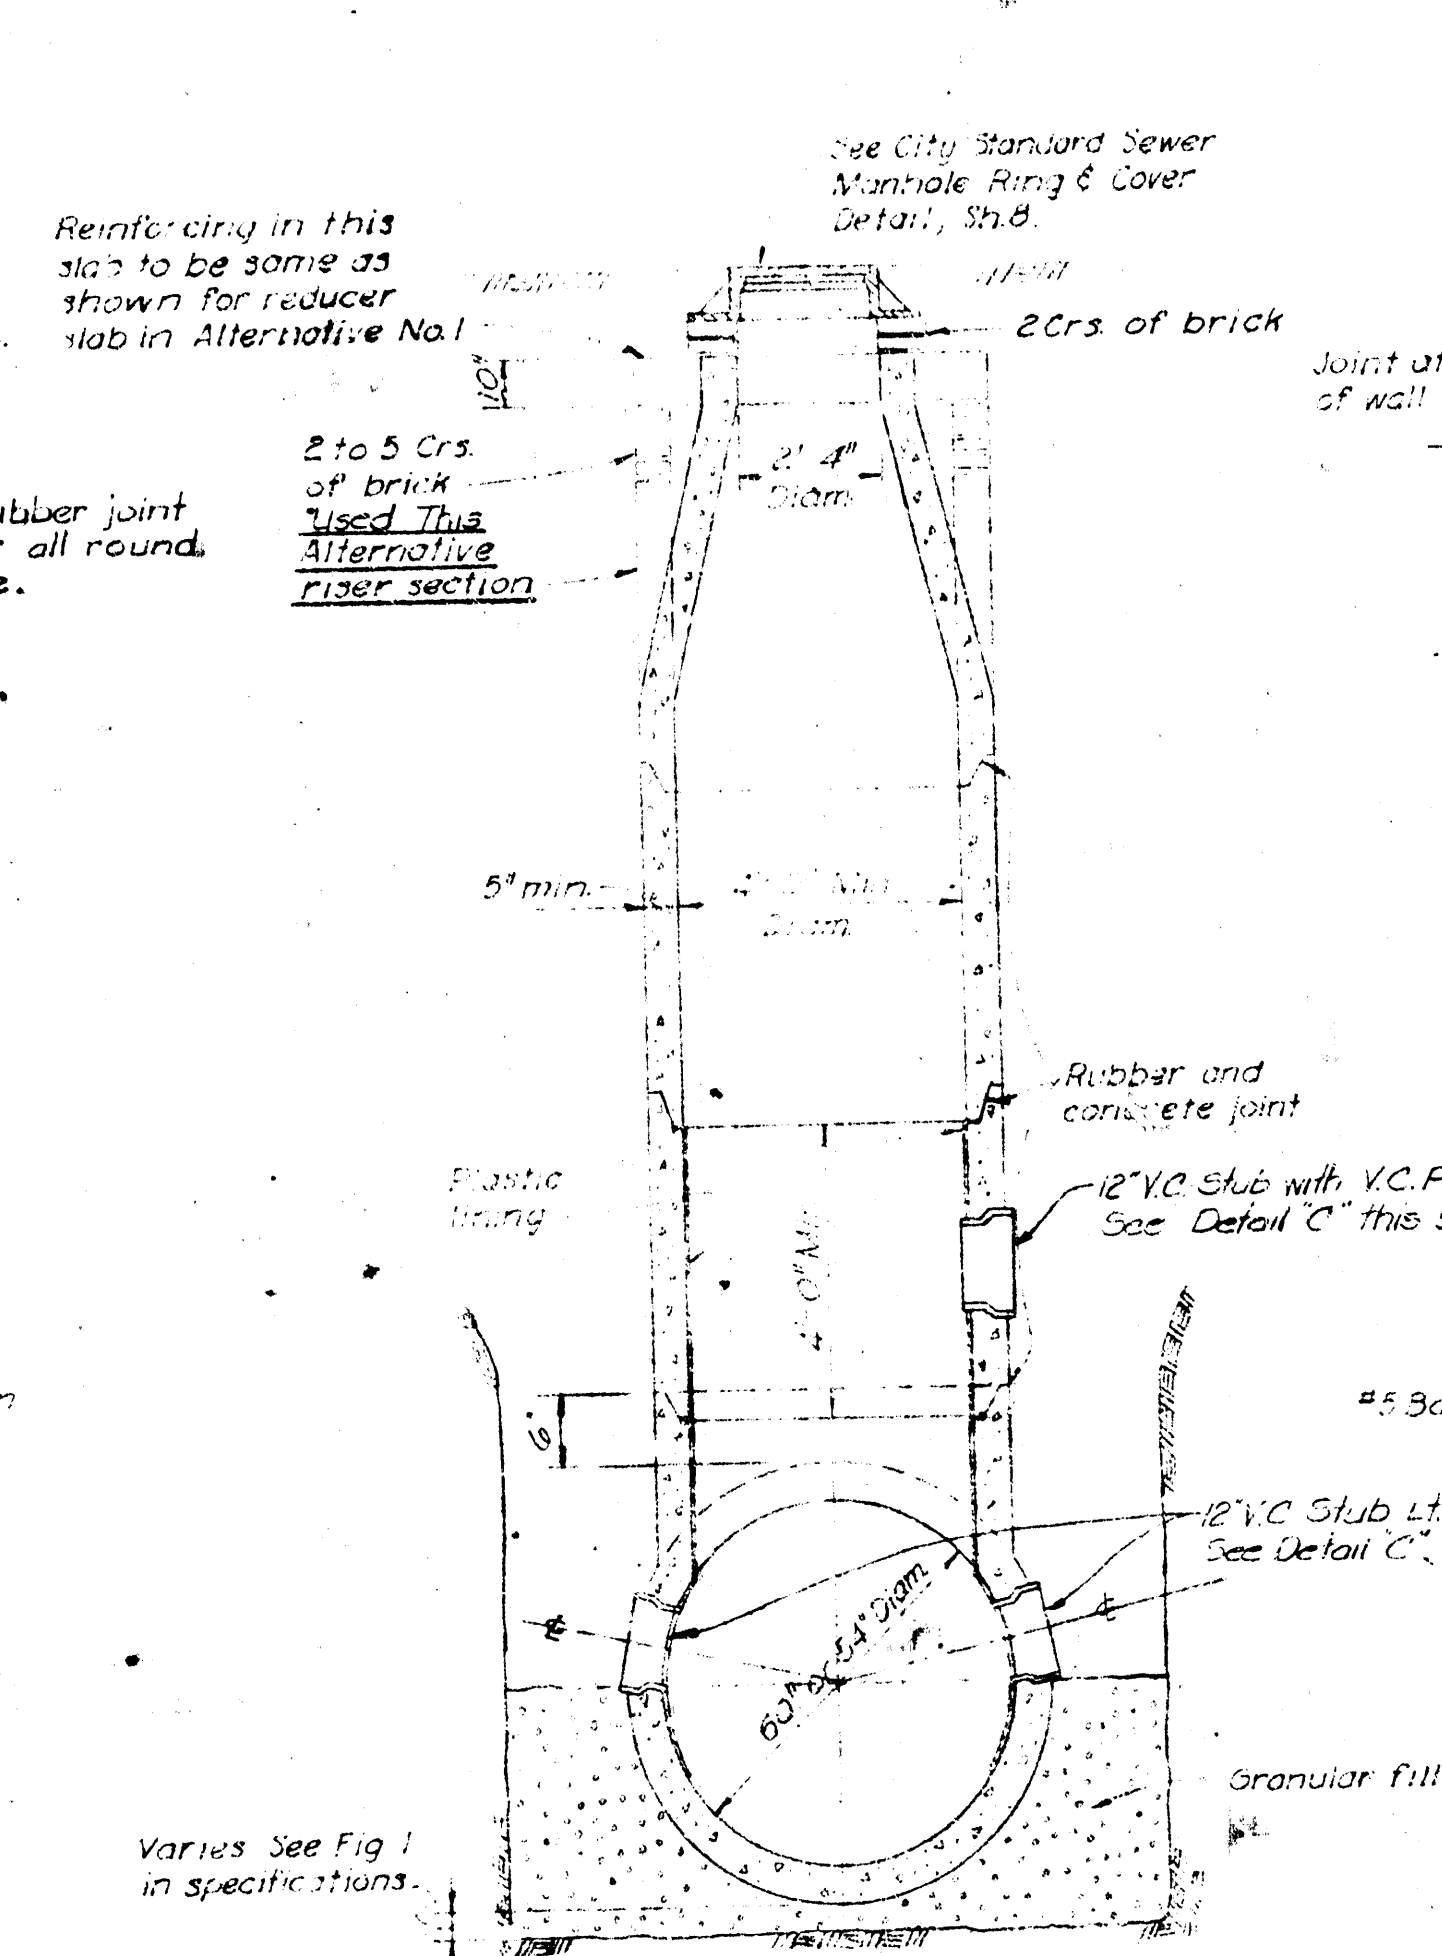


SECTION 2
ALTERNATIVE NO 2
STANDARD MANHOLE DETAIL
Scale: $3/8" = 1'-0"$
This alternate used at all
locations except for the
G Sid. M.H.'s noted on sh. 849.

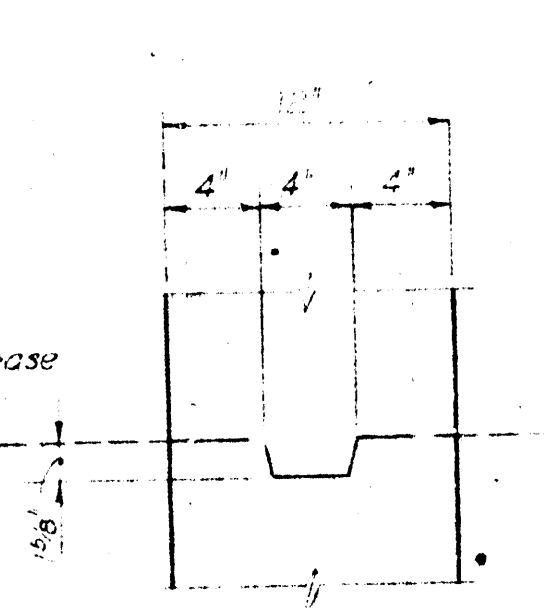


WALL JOINT DETAIL

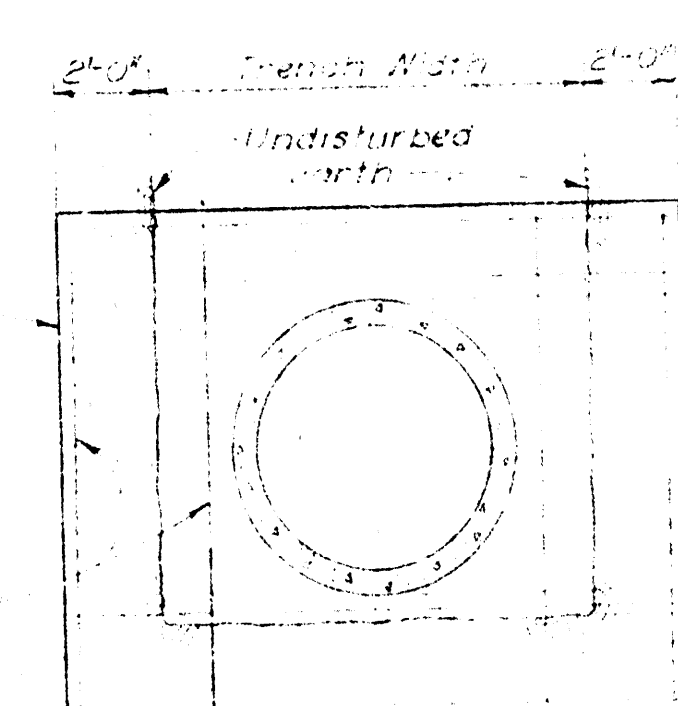

CONCRETE COLLAR DETAIL

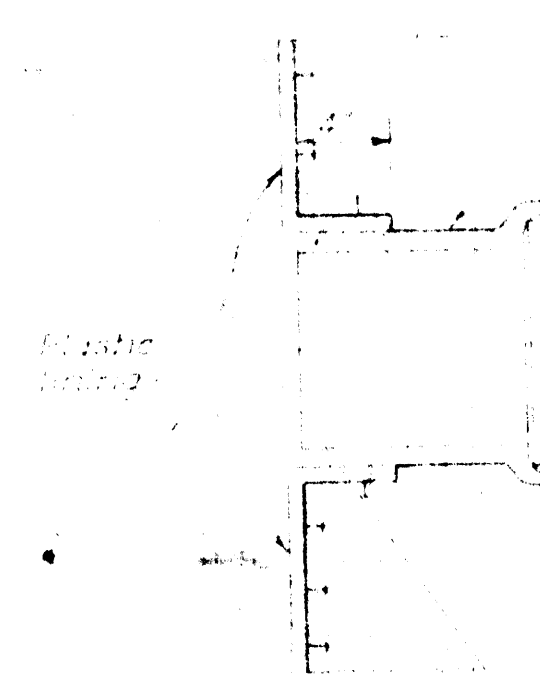


CONCLUSIONS

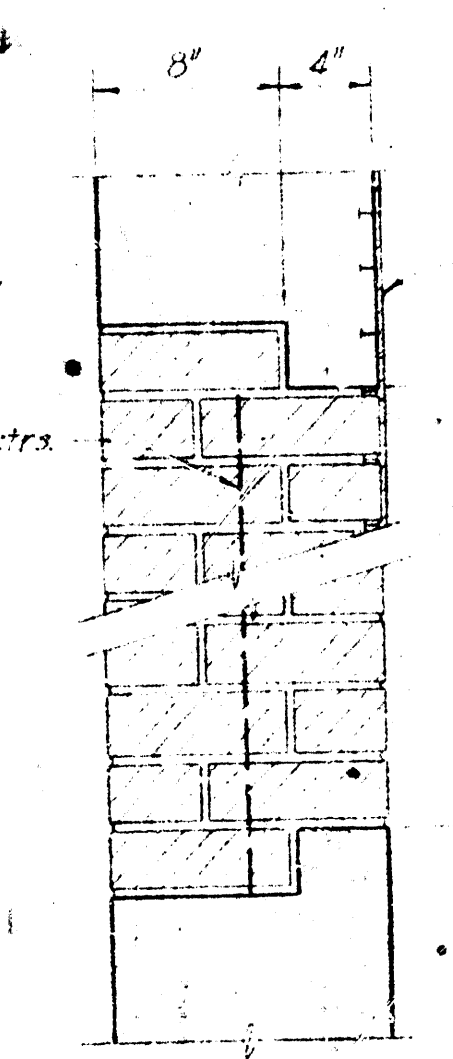

SECTION

BRICK BOX OUT DETAIL
Scale: $1\frac{1}{2}" = 1'-0"$

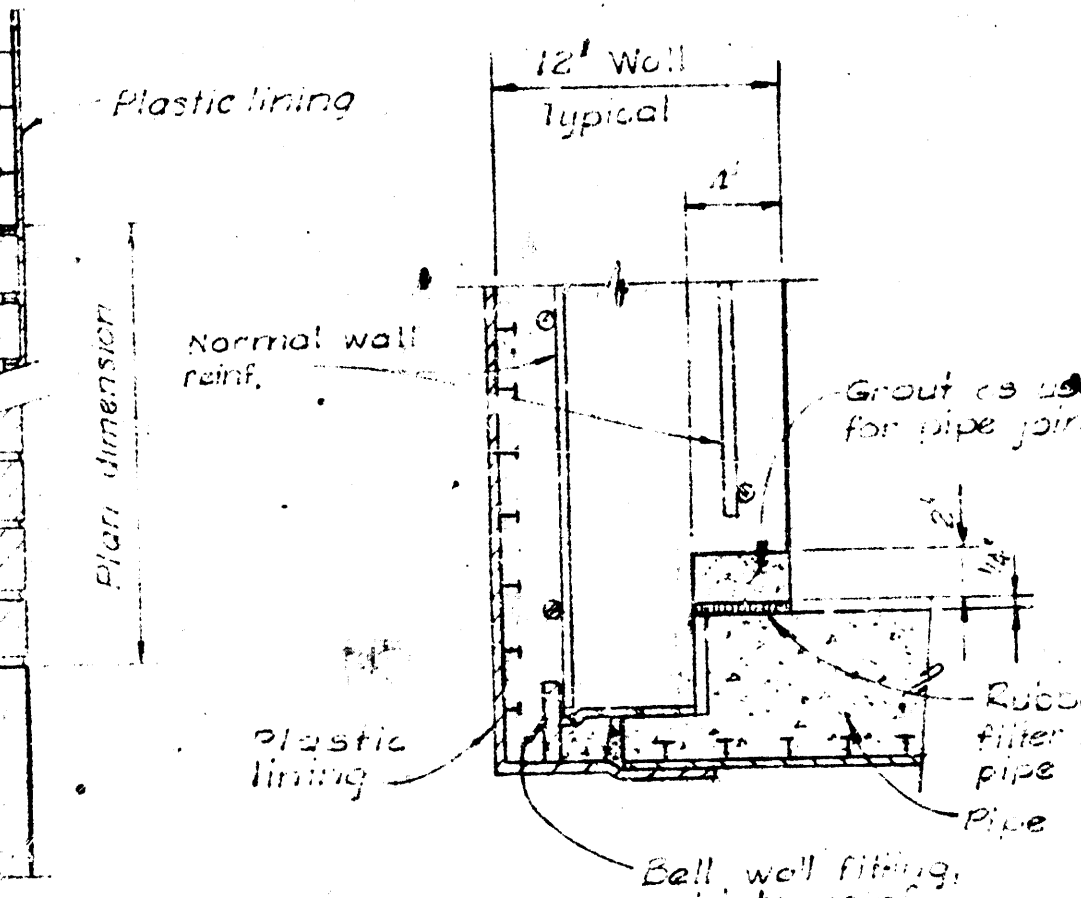

DETAIL B
Scale: $1\frac{1}{2}'' = 1'-0''$

Notes

1. *Staphylococcus aureus* strains were isolated from the wounds of patients with severe burns and treated with a combination of antibiotics. The isolates were then tested for sensitivity to various antibiotics.

2. The isolates were tested for sensitivity to various antibiotics using the disk diffusion method. The results are shown in the table below.

3. The isolates were also tested for sensitivity to various antibiotics using the MIC method. The results are shown in the table below.

4. The isolates were also tested for sensitivity to various antibiotics using the E-test method. The results are shown in the table below.

5. The isolates were also tested for sensitivity to various antibiotics using the agar diffusion method. The results are shown in the table below.

6. The isolates were also tested for sensitivity to various antibiotics using the microdilution method. The results are shown in the table below.

7. The isolates were also tested for sensitivity to various antibiotics using the broth microdilution method. The results are shown in the table below.

8. The isolates were also tested for sensitivity to various antibiotics using the agar microdilution method. The results are shown in the table below.

9. The isolates were also tested for sensitivity to various antibiotics using the broth microdilution method. The results are shown in the table below.

10. The isolates were also tested for sensitivity to various antibiotics using the agar microdilution method. The results are shown in the table below.

CONTRACT NO. !

WICHITA, KANSAS

SOUTHWEST INTERCEPTOR

MANHOLE ALTERNATIVES &
MISCELLANEOUS DETAILS

BLACK & VEATCH
CONSULTING ENGINEERS, KANSAS CITY, MO.

DESIGNED BY SMC/DR CHECKED BY SMC/DR
DETAILED BY SMC/DR APPROVED BY SMC/DR

10 SHEET
OF 10