


LAT. 182, SOUTHWEST INTERCEPTOR
SANITARY SEWER EXTENSION
FOR
BLOCK 2, WESTERN ADDITION


468-76-245-81304-000-000-001
CITY OF WICHITA, KANSAS
MIKE LINDEBAK, CITY ENGINEER

U.S. 54 HIGHWAY

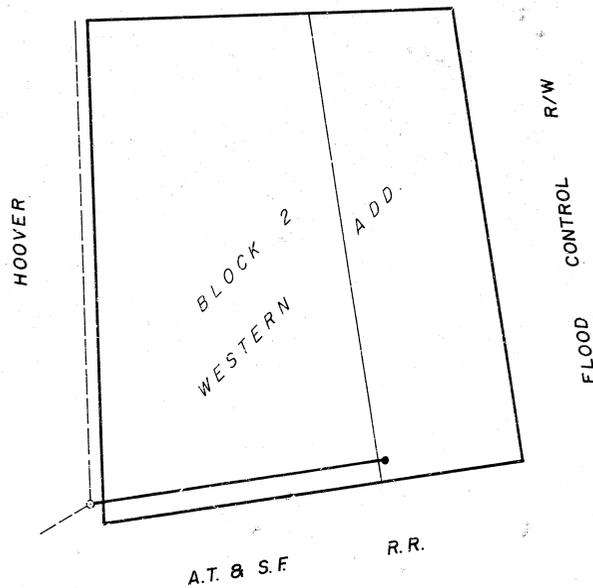


*As Built
JHL
10-83*



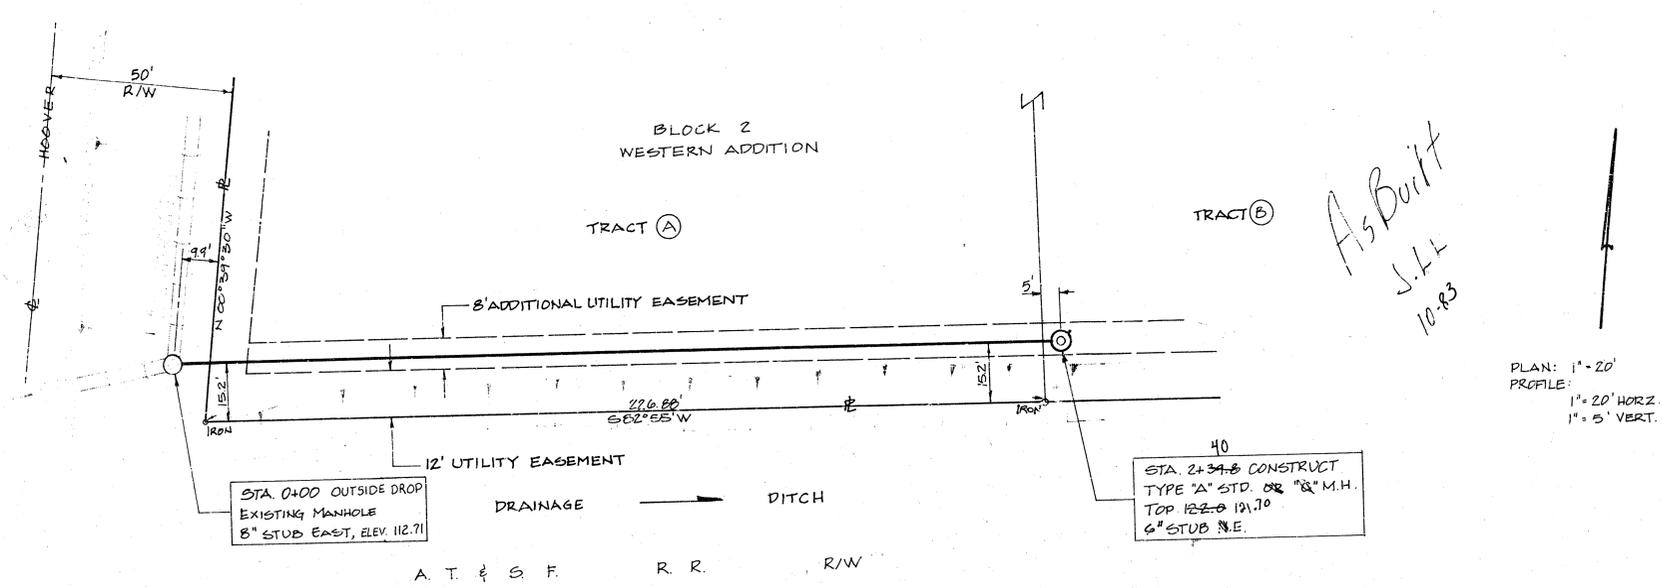

BENCH MARK:
 "D" CUT IN CONCRETE @ N.E. COR. OF BLDG.
 5601 W. KELLOGG, ELEV. 122.17

Note - The contractor shall be responsible for preserving property irons. The contractor shall be required to re-establish any property irons which are destroyed or damaged by his construction. Such irons shall be re-established by a licensed land surveyor or a professional engineer in accordance with state laws. The existing 6" V.C.P. stub of the existing manhole is to be utilized in the pipe construction & extension.

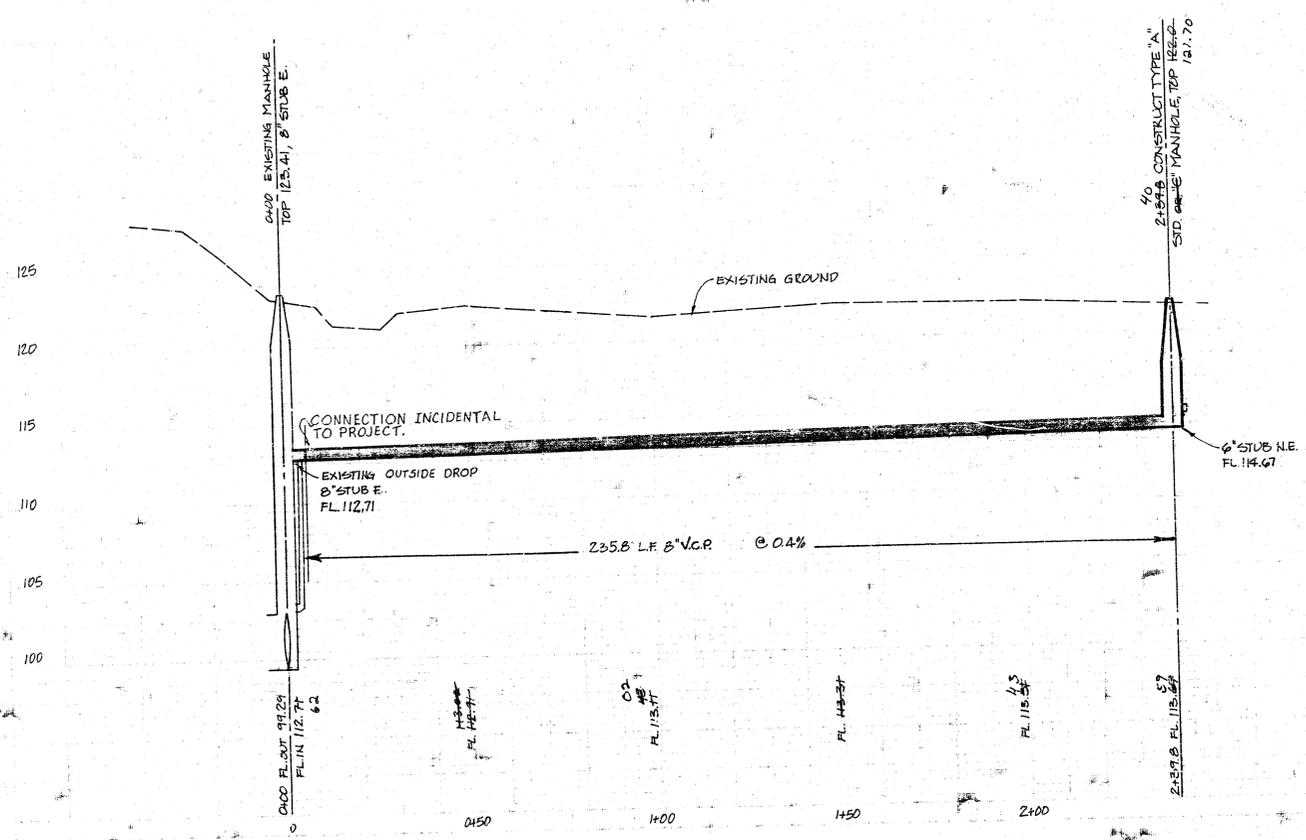

LAT. 182, SOUTHWEST INTERCEPTOR
 Block 2, Western Addition
 City of Wichita, Kansas
 468-76-245-81304-000-000-001

BAUGHMAN COMPANY, P.A.
 SURVEYING & ENGINEERING
 316/263-7271 • 330 LAURA • WICHITA, KANSAS 67211