


SCALE PLAN 1" = 40'
PROFILE 1" = 40' HORIZ.
1" = 5' VERT.




NOTE: PAVEMENT REWORK, IF ANY
SHALL BE CONSIDERED INCIDENTAL
TO THE PROJECT.

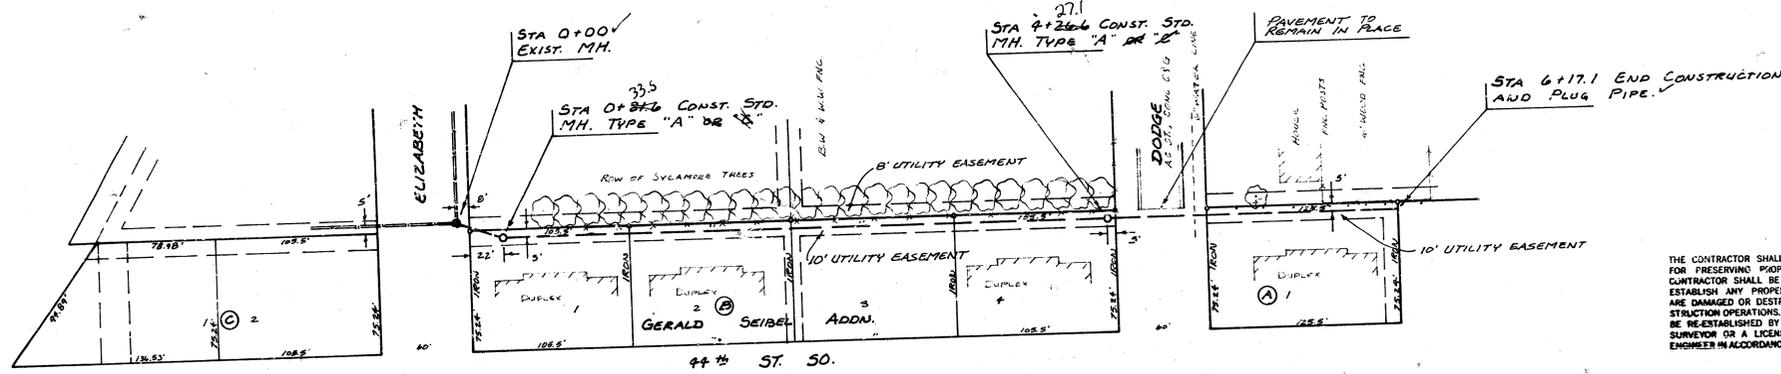

THE CONTRACTOR SHALL BE RESPONSIBLE
FOR PRESERVING PROPERTY IRONS. THE
CONTRACTOR SHALL BE REQUIRED TO RE-
ESTABLISH ANY PROPERTY IRONS WHICH
ARE DAMAGED OR DESTROYED BY HIS CON-
STRUCTION OPERATIONS. SUCH IRONS SHALL
BE RE-ESTABLISHED BY A LICENSED LAND
SURVEYOR OR A LICENSED PROFESSIONAL
ENGINEER IN ACCORDANCE WITH STATE LAWS.

B.M. 88.008 CITY STD. D.I. 48' E AND 42' S
S. OF E. SENECA AND 43' ST. 50. (E)
B.M. 86.43 "D" IN TOP CURB AT S. END
CURB SECTION TO DOUBLE INLET, E. END
ELIZABETH 2 1/2' N. OF N.W. 77 1/2' ST. 2.

As Built
J.L.L.
11-83

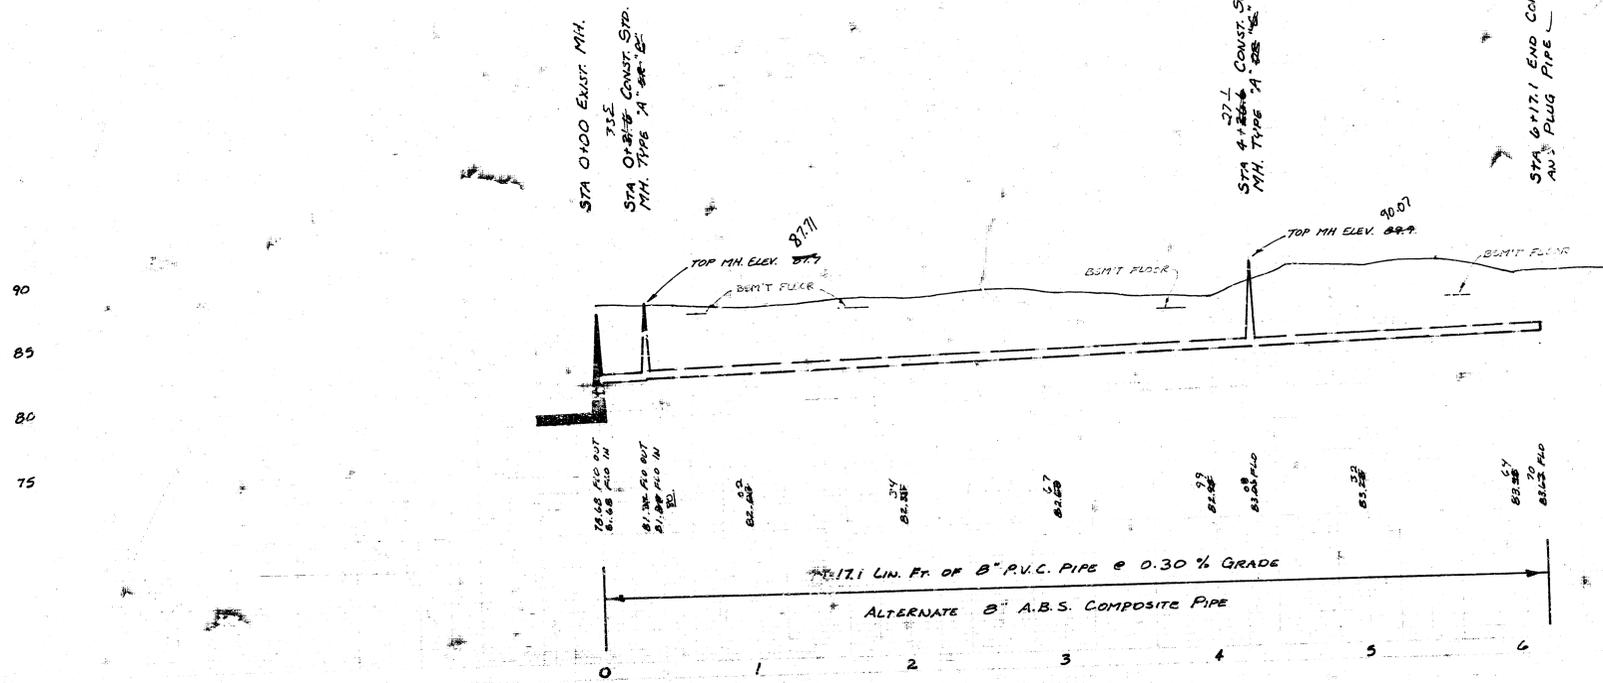

PROJECT DESCRIPTION	
LAT. 35, MAIN 3, SW. INTERCEPTOR	
PROJECT NUMBER	
488-78-245-81284-000-000-901	
BOOK NO. DC-255	APPROVED BY: _____
DRAWN BY: 200715	DATE: _____
CITY OF WICHITA	
DEPARTMENT OF ENGINEERING	
M.E. LINDEBAK - CITY ENGINEER	SCALE: 1/1

FILMED FROM THE BEST
AVAILABLE COPY