
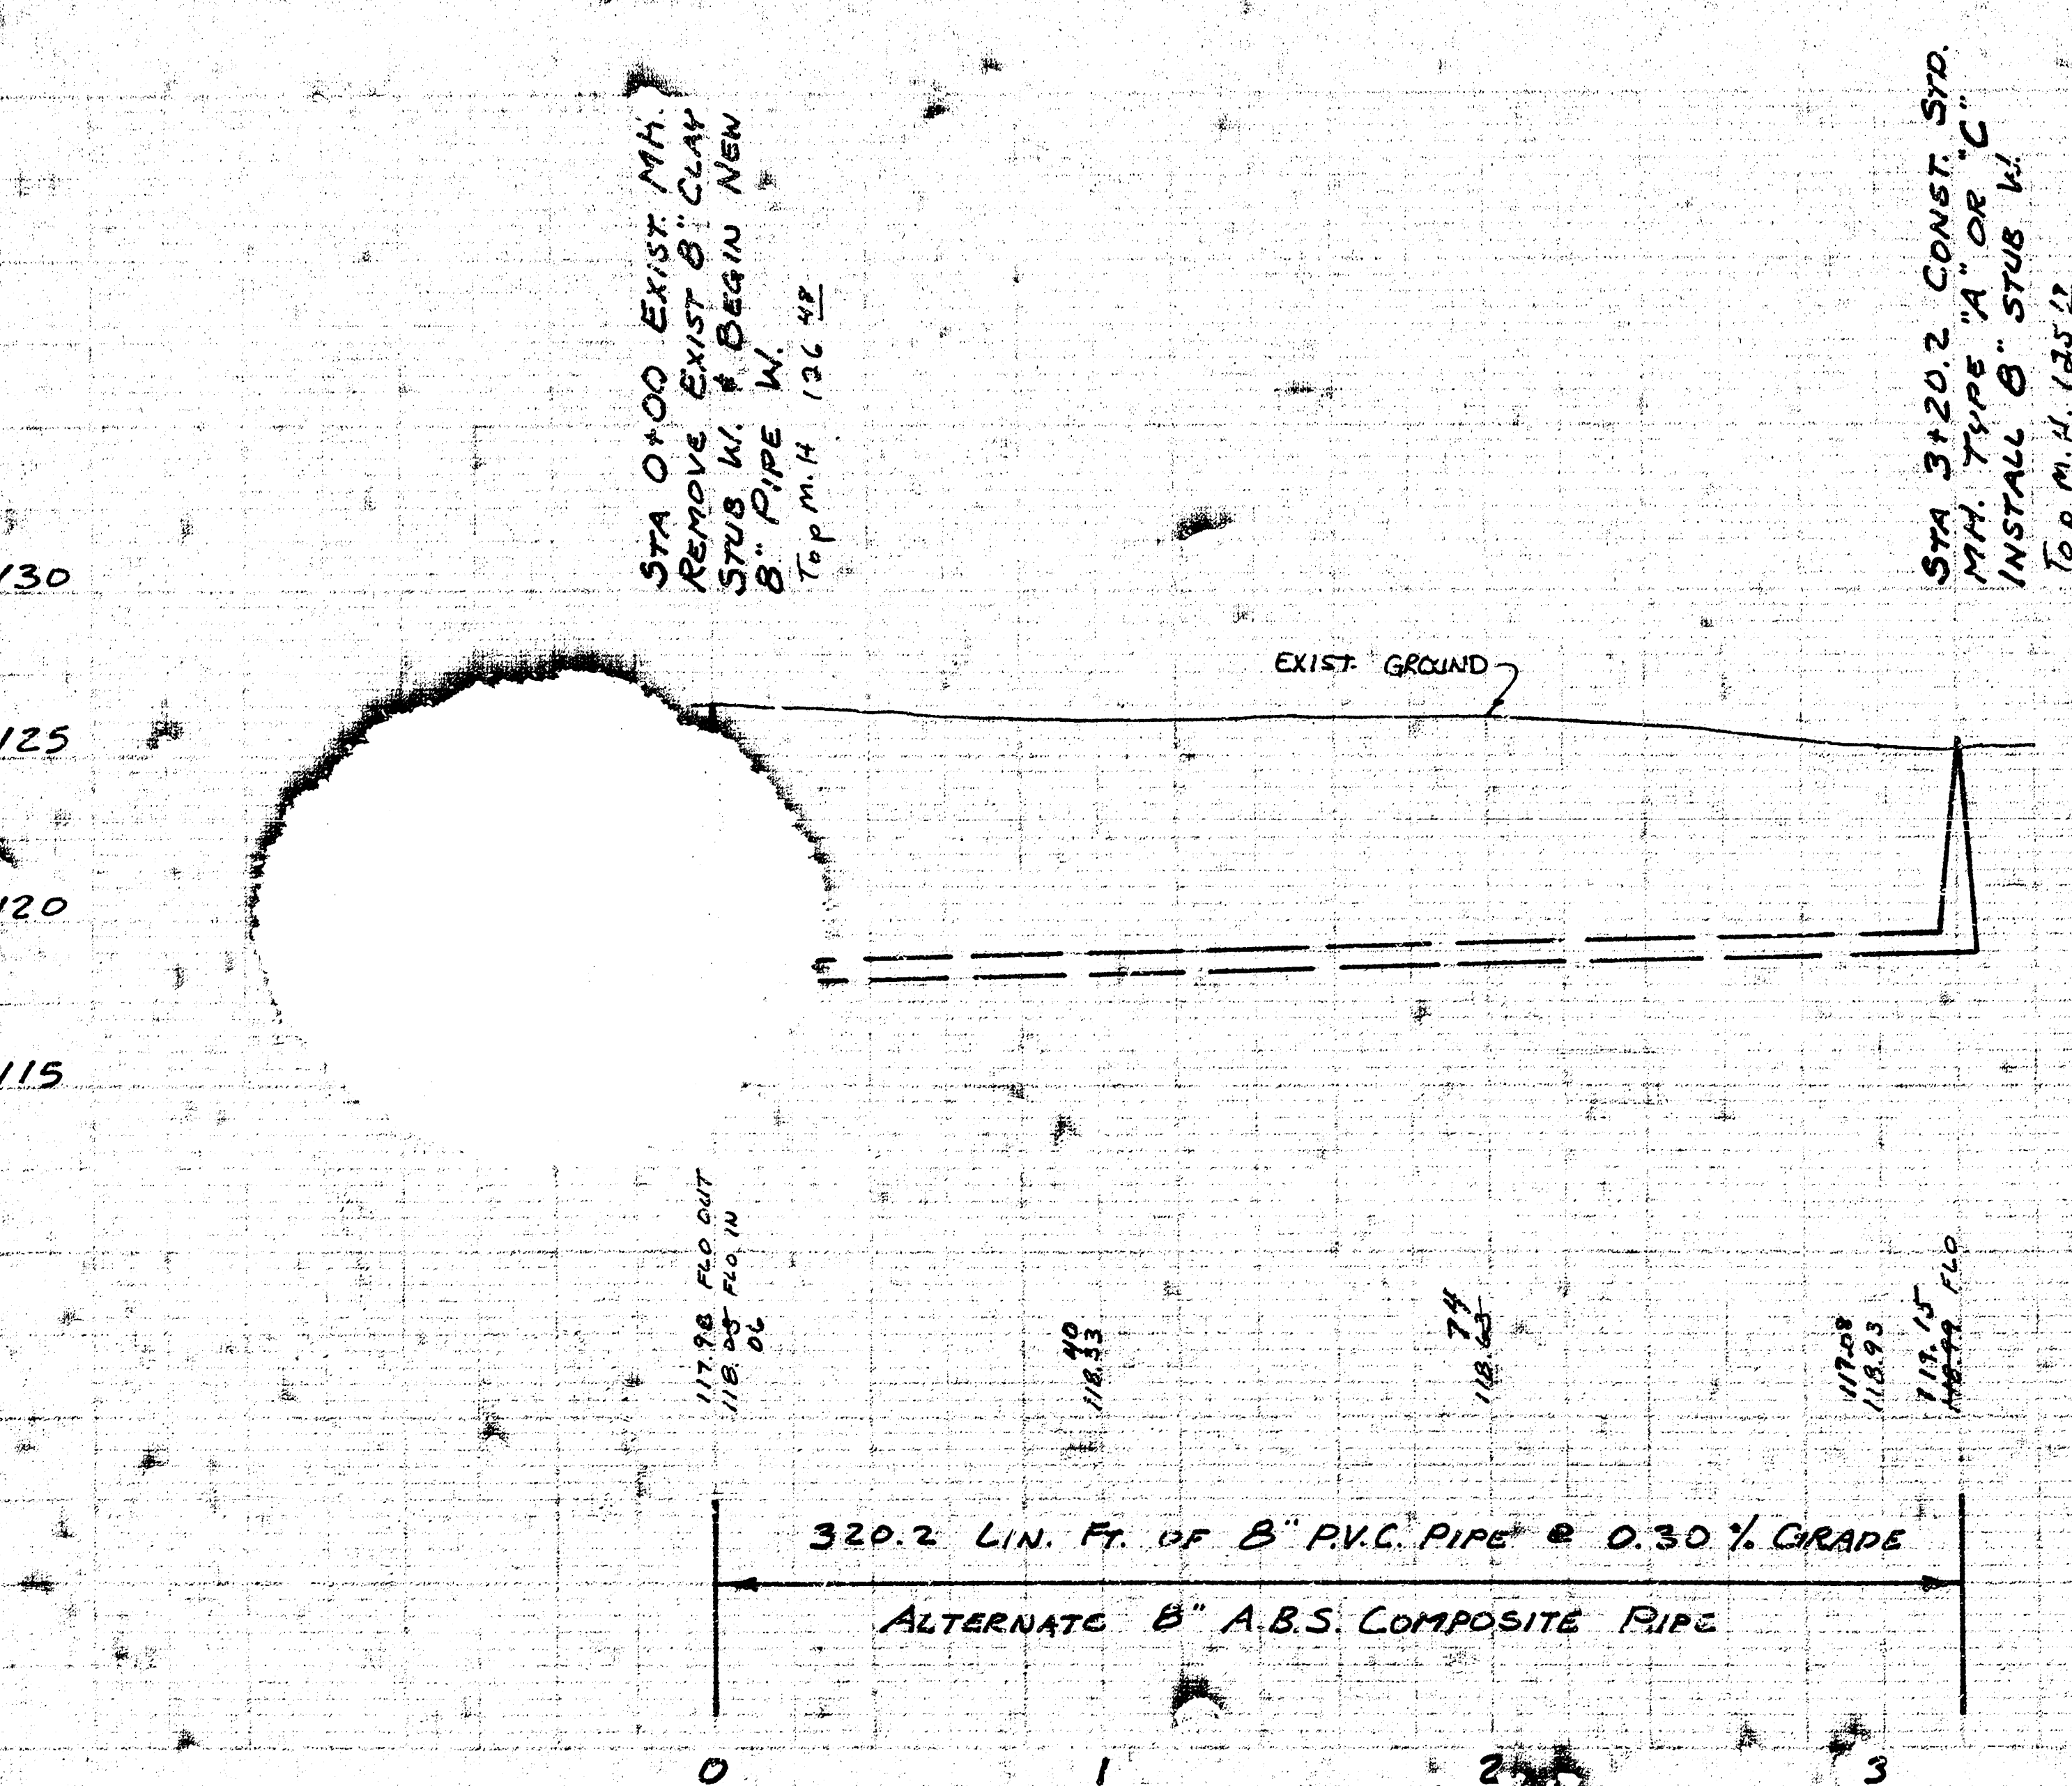
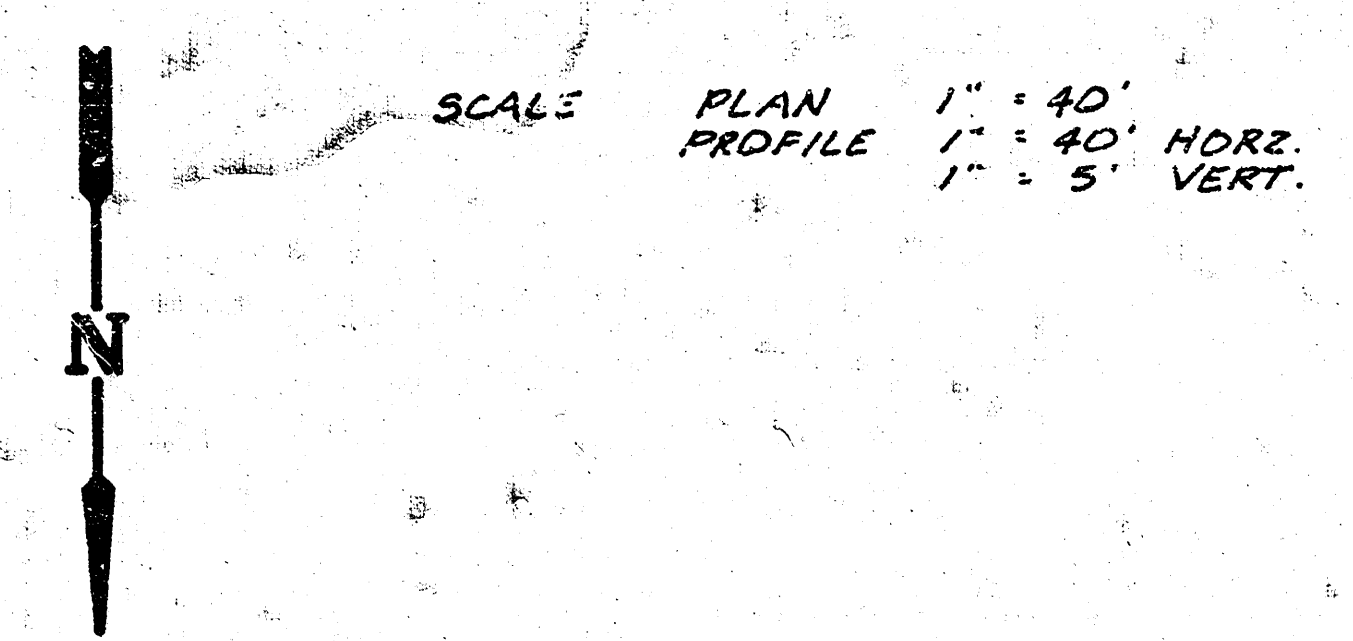


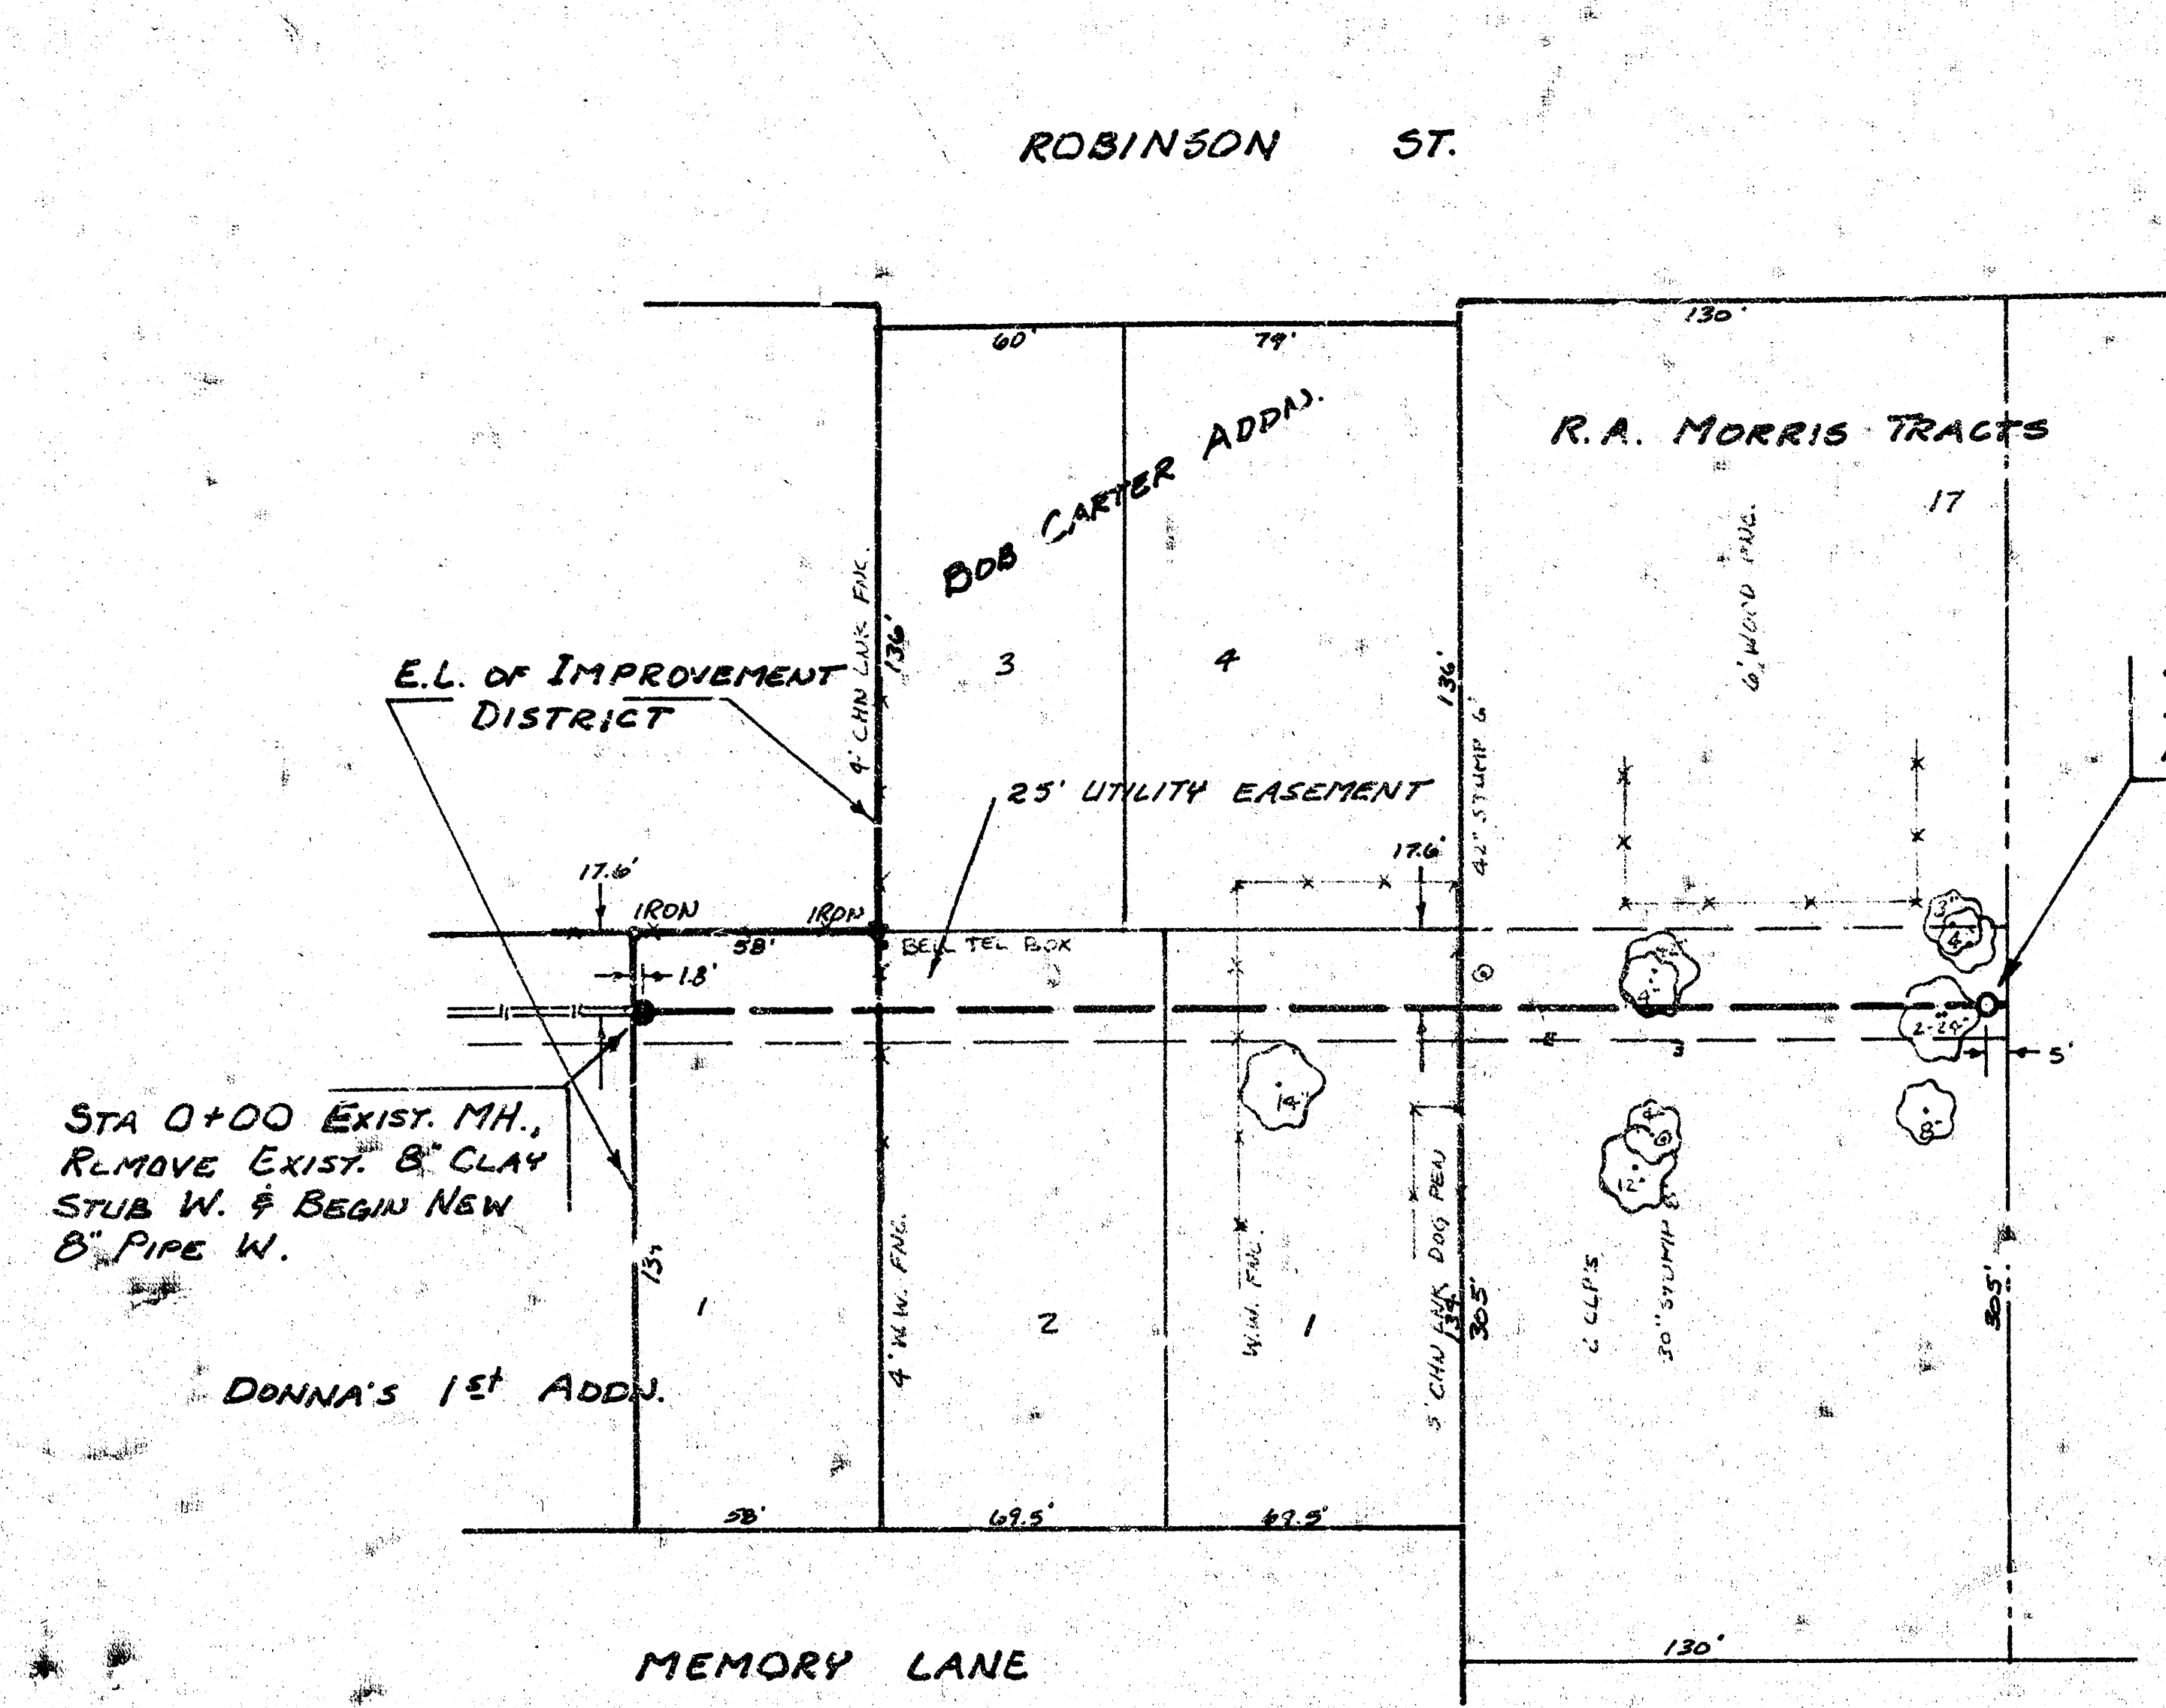

NOTE: THE COST OF REMOVING THE
B" STUB SHALL BE INCIDENTAL
TO THE PROJECT.

THE COST OF INSTALLING THE B" STUB
SHALL BE INCLUDED IN THE PRICE
BID FOR THE MANHOLE.

THE CONTRACTOR SHALL BE RESPONSIBLE
FOR PRESERVING PROPERTY IRONS. THE
CONTRACTOR SHALL BE REQUIRED TO RE-
ESTABLISH ANY PROPERTY IRONS WHICH
ARE DAMAGED OR DESTROYED BY HIS CON-
STRUCTION OPERATIONS. SUCH IRONS SHALL
BE RE-ESTABLISHED BY A LICENSED LAND
SURVEYOR OR A LICENSED PROFESSIONAL
ENGINEER IN ACCORDANCE WITH STATE LAWS.

NOTE: THE CONTRACTOR SHALL GIVE ALL PROPERTY OWNERS
AND/OR TENANTS OF DEVELOPED PROPERTY DIRECTLY
AFFECTED BY THE CONSTRUCTION OF THIS PROJECT A
MINIMUM ADVANCE NOTICE OF 48 HOURS PRIOR TO
STARTING CONSTRUCTION.

B.M. 130.29 SE CORNER PORCH, HOUSE #5124 MEMORY LANE.
B.M. 128.30 NE CORNER CONC. STEP, HOUSE #5008 MEMORY LANE
B.M. 128.99 SE CORNER CONC. PORCH AT 1121 SMITH
B.M. 128.36 R.R. SPIKE S. FACE P.P. AT NE CORNER SMITH
AND 12TH ST. No.

As Built
Sht
11-83



PROJECT DESCRIPTION		
LAT. 238, MAIN 5, S.S. # 22		
PROJECT NUMBER		
468-76-245-81289-000-000-001		
BOOK NO. DCD-304	APPROVED BY	DATE 8-83
DRAWN BY LDM/TLS	REVISOR	
CITY OF WICHITA		
DEPARTMENT OF ENGINEERING		
M. E. LINDEBAK - CITY ENGINEER		SCALE