
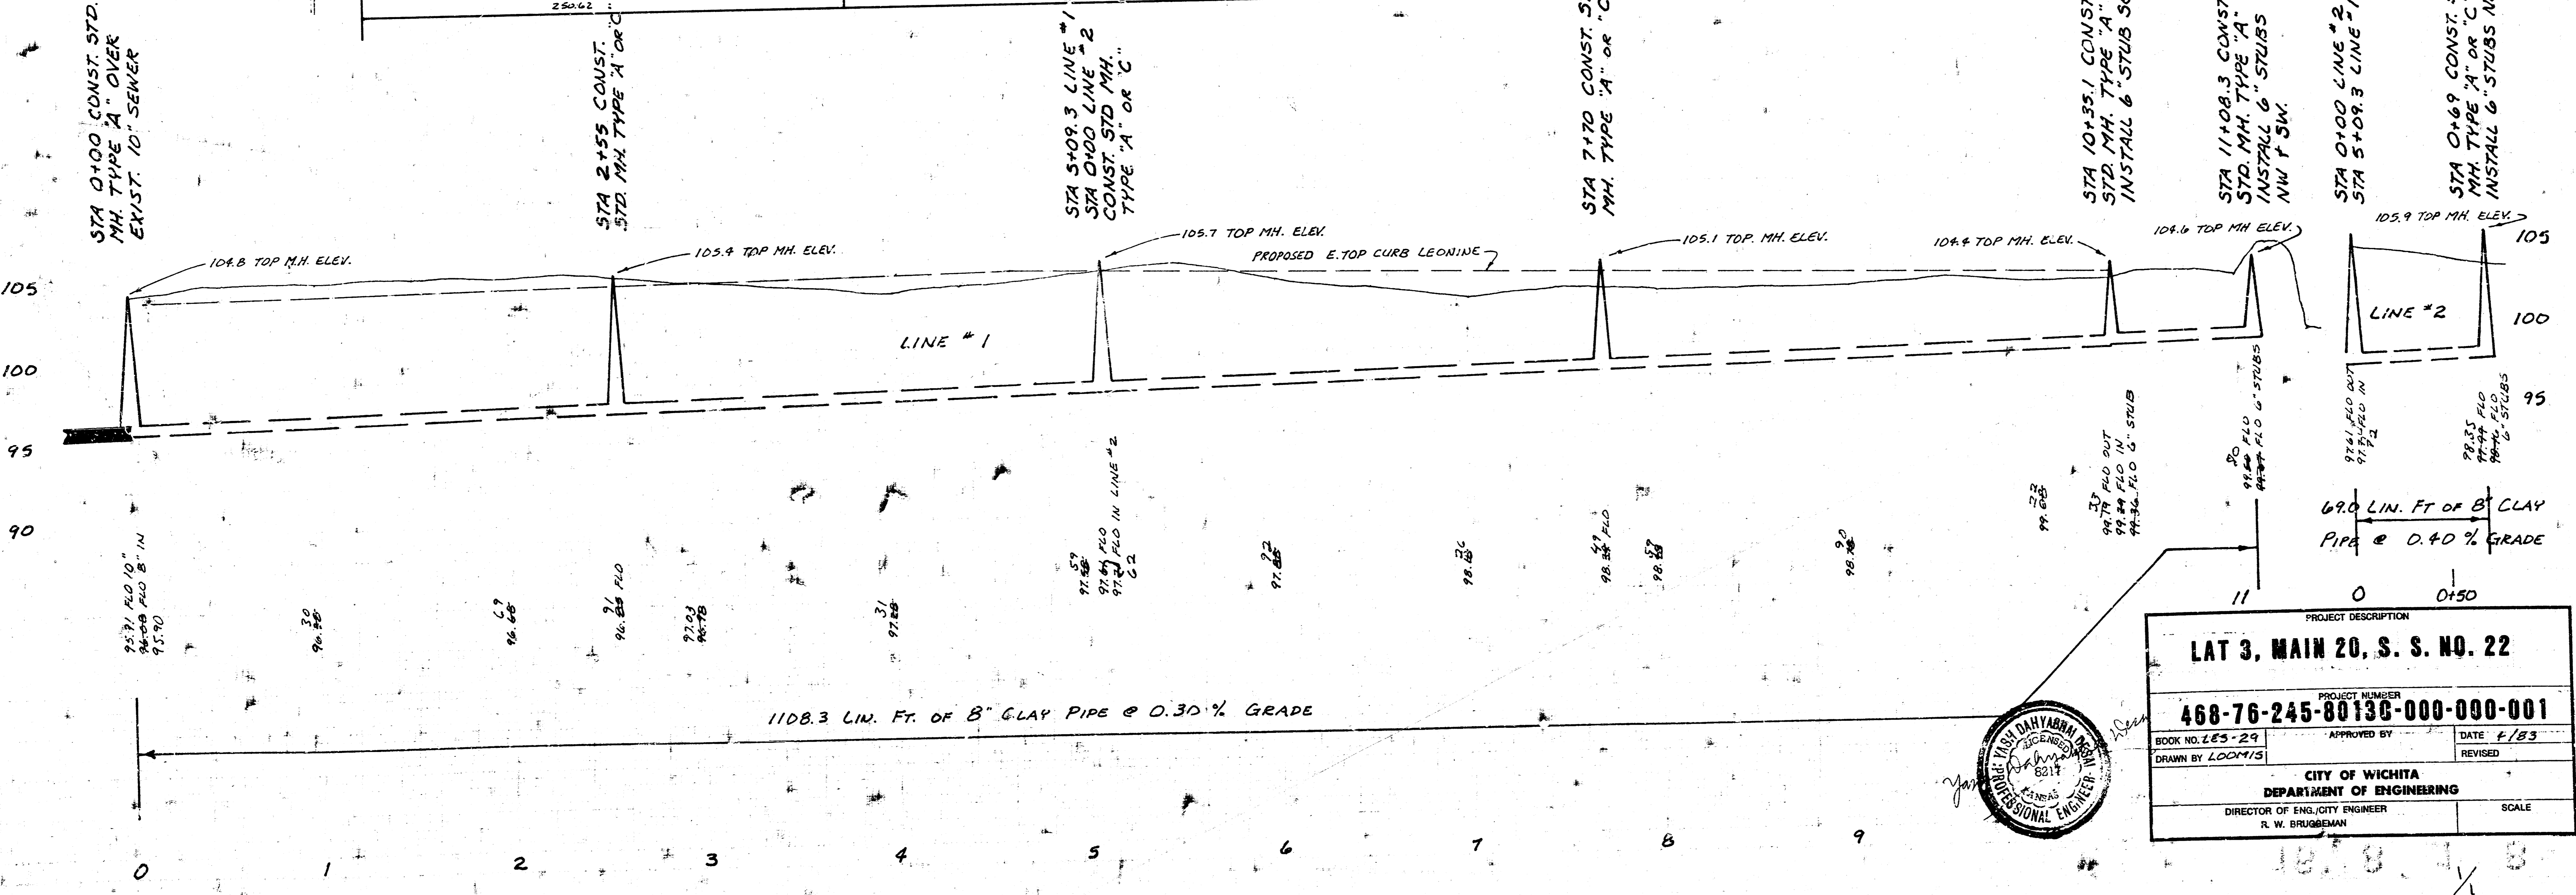


SCALE PLAN 1" = 40'  
 PROFILE 1" = 40' HORIZ.  
 1" = 5' VERT.


**CAUTION**  
 UNDERGROUND UTILITIES

Please check with K G & E or  
 Southwestern Bell  
 Telephone Co. for Location

STA 0+00 CONST. STD.  
 MH. TYPE "A"  
 OVER EXIST. 10" SEWER

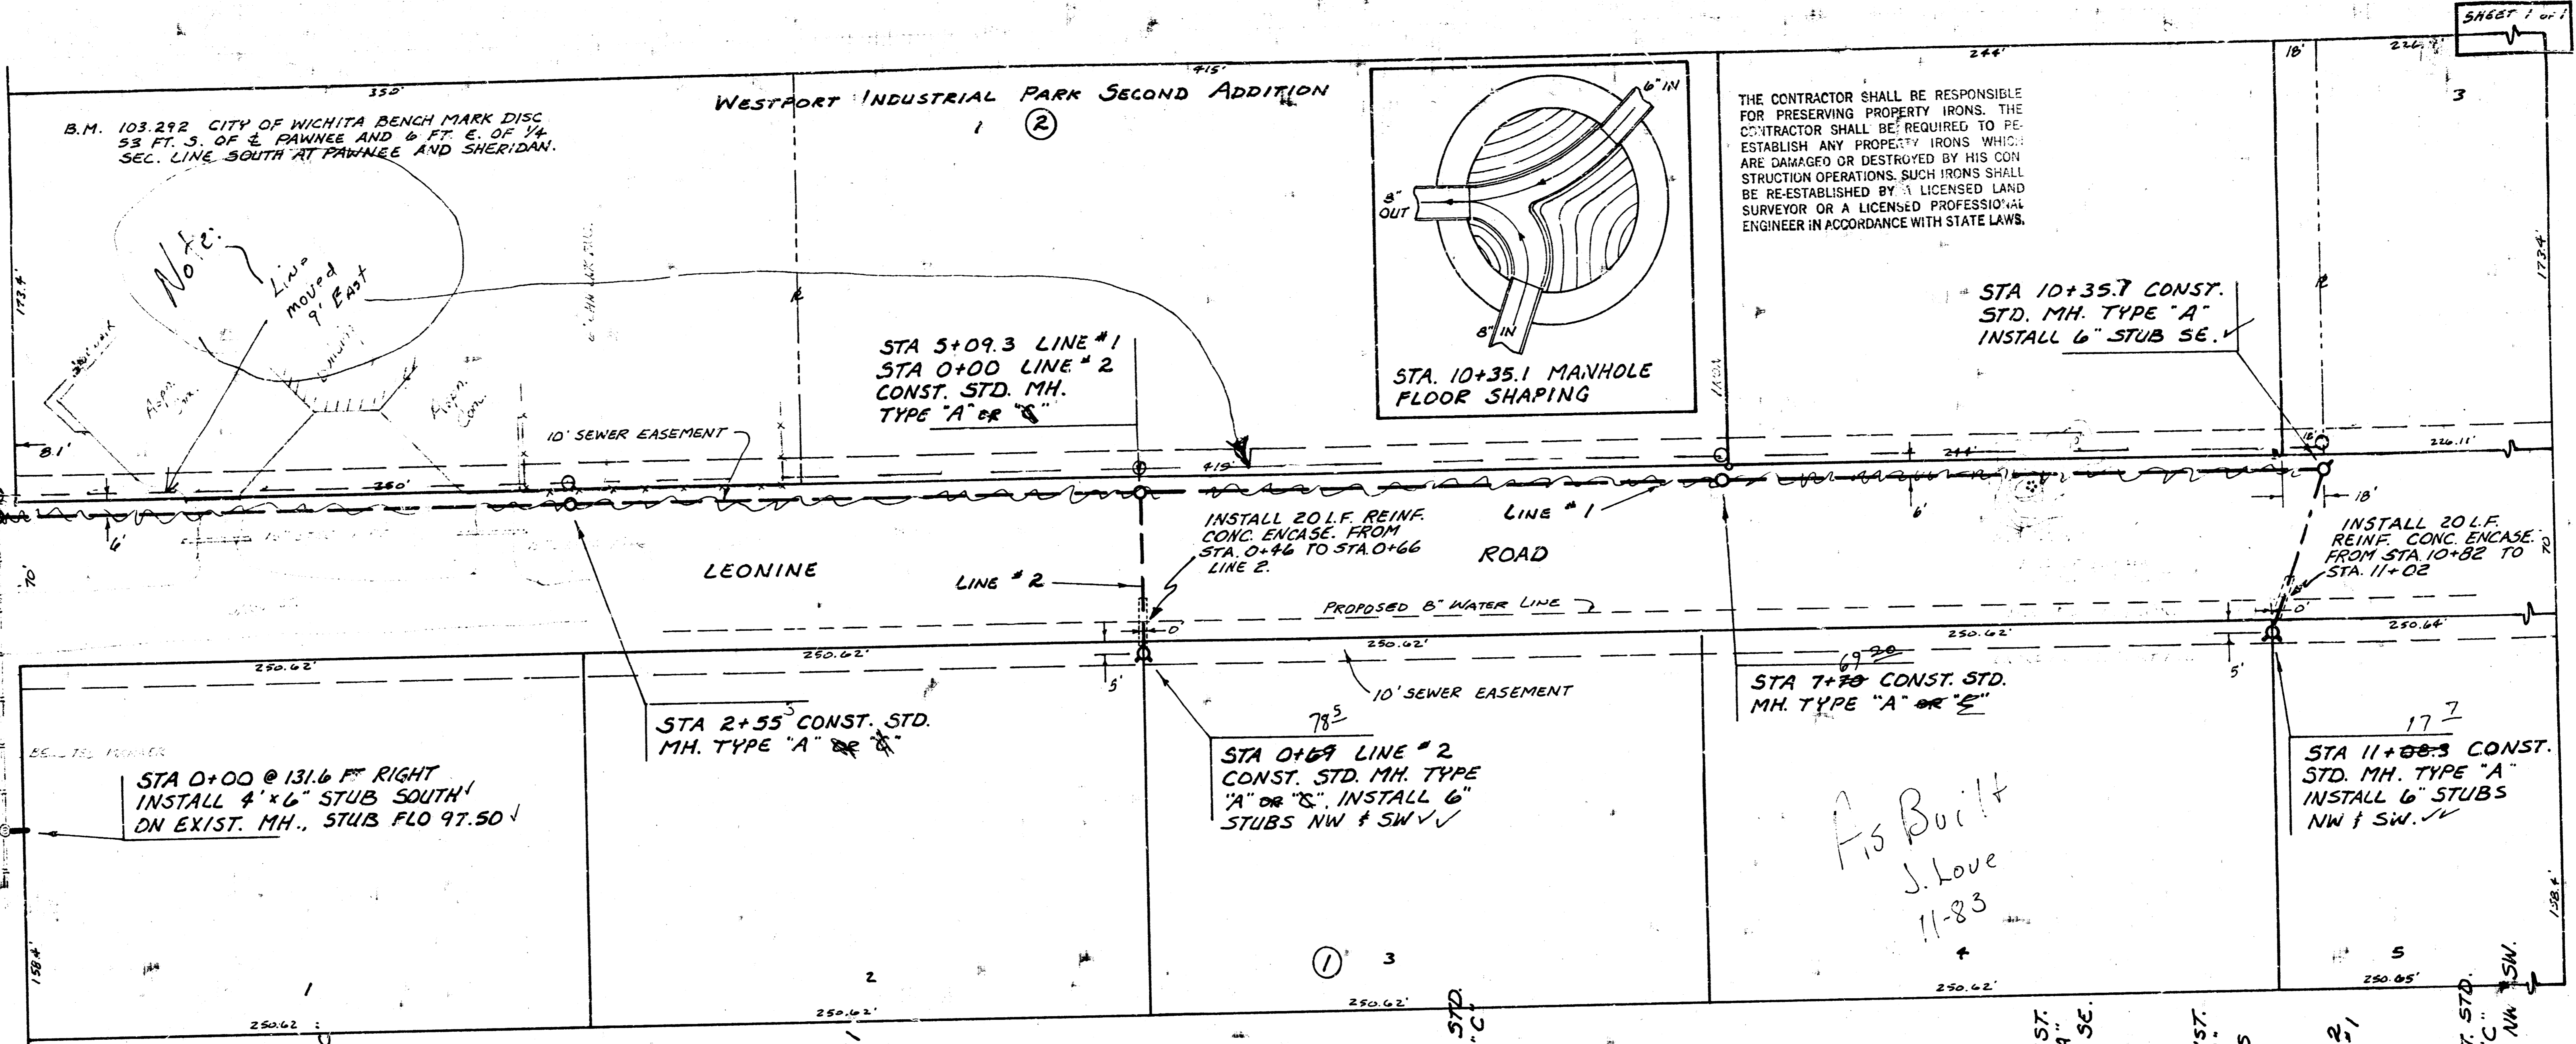

THE CONTRACTOR SHALL BE RESPONSIBLE FOR PRESERVING PROPERTY IRONS. THE CONTRACTOR SHALL BE REQUIRED TO RE-ESTABLISH ANY PROPERTY IRONS WHICH ARE DAMAGED OR DESTROYED BY HIS CONSTRUCTION OPERATIONS. SUCH IRONS SHALL BE RE-ESTABLISHED BY A LICENSED LAND SURVEYOR OR A LICENSED PROFESSIONAL ENGINEER IN ACCORDANCE WITH STATE LAWS.

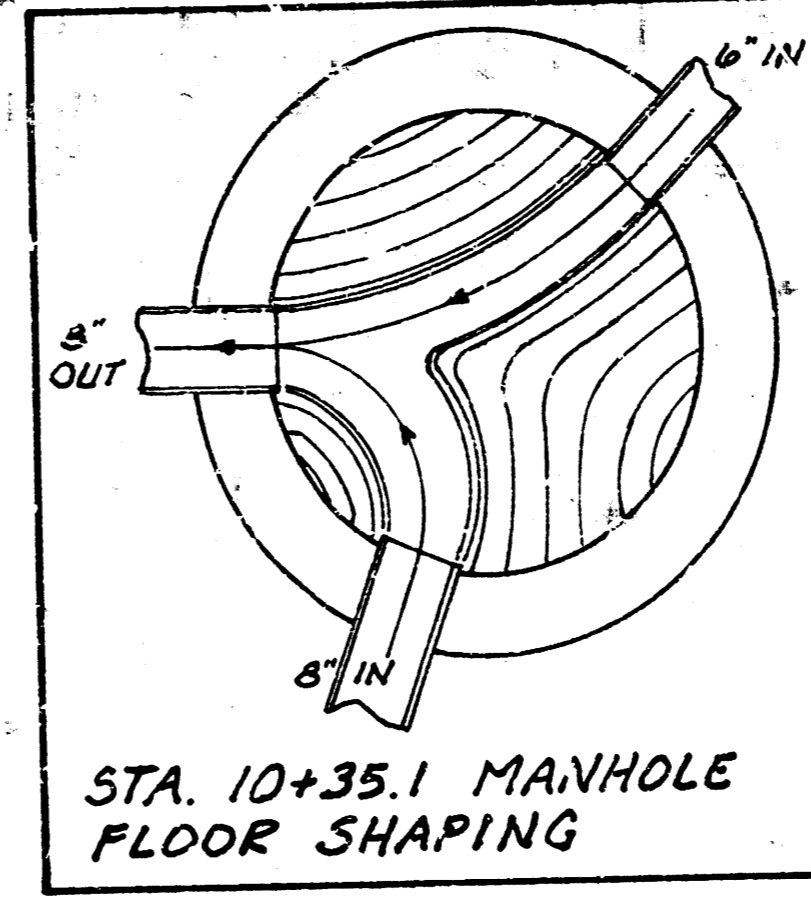

*As Built*  
 J. Love  
 11-83

PROJECT DESCRIPTION	
LAT 3, MAIN 20, S. S. NO. 22	
PROJECT NUMBER	
468-76-245-80130-000-090-001	
BOOK NO. 123-29	APPROVED BY
DRAWN BY L00M13	DATE 4/83
CITY OF WICHITA	
DEPARTMENT OF ENGINEERING	
DIRECTOR OF ENG. CITY ENGINEER	SCALE
R. W. BRUGEMAN	

