






Scale: 1" = 40' Plan  
1" = 40' Profile  
Vert. 1" = 5'

Bench Marks:  
131.48 - 1" in Mueller Fire Hyd.  
S.E. Cor. St. Francis  
and 30<sup>th</sup> St No.  
131.60 - 1" in Mueller Fire Hyd.  
S.E. Cor. Mead & 33<sup>rd</sup> St. No.

Note: Field Engineer shall coordinate construction of sewer such that the restriction of traffic flow is at a minimum during business hours.

THE CONTRACTOR SHALL BE RESPONSIBLE FOR PROTECTING PROPERTY IRONS. THE CONTRACTOR SHALL BE REQUIRED TO RE-ESTABLISH ANY PROPERTY IRONS WHICH ARE DAMAGED OR DESTROYED BY HIS CONSTRUCTION OPERATIONS. SUCH IRONS SHALL BE RE-ESTABLISHED BY A LICENSED LAND SURVEYOR OR A LICENSED PROFESSIONAL ENGINEER IN ACCORDANCE WITH STATE LAWS.

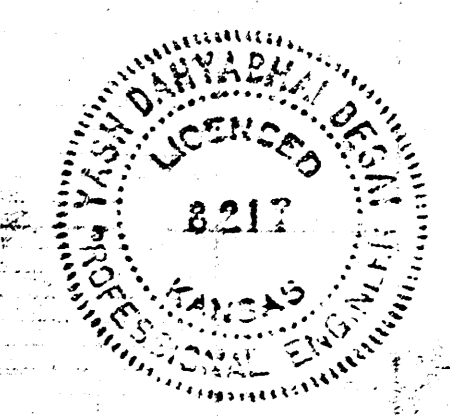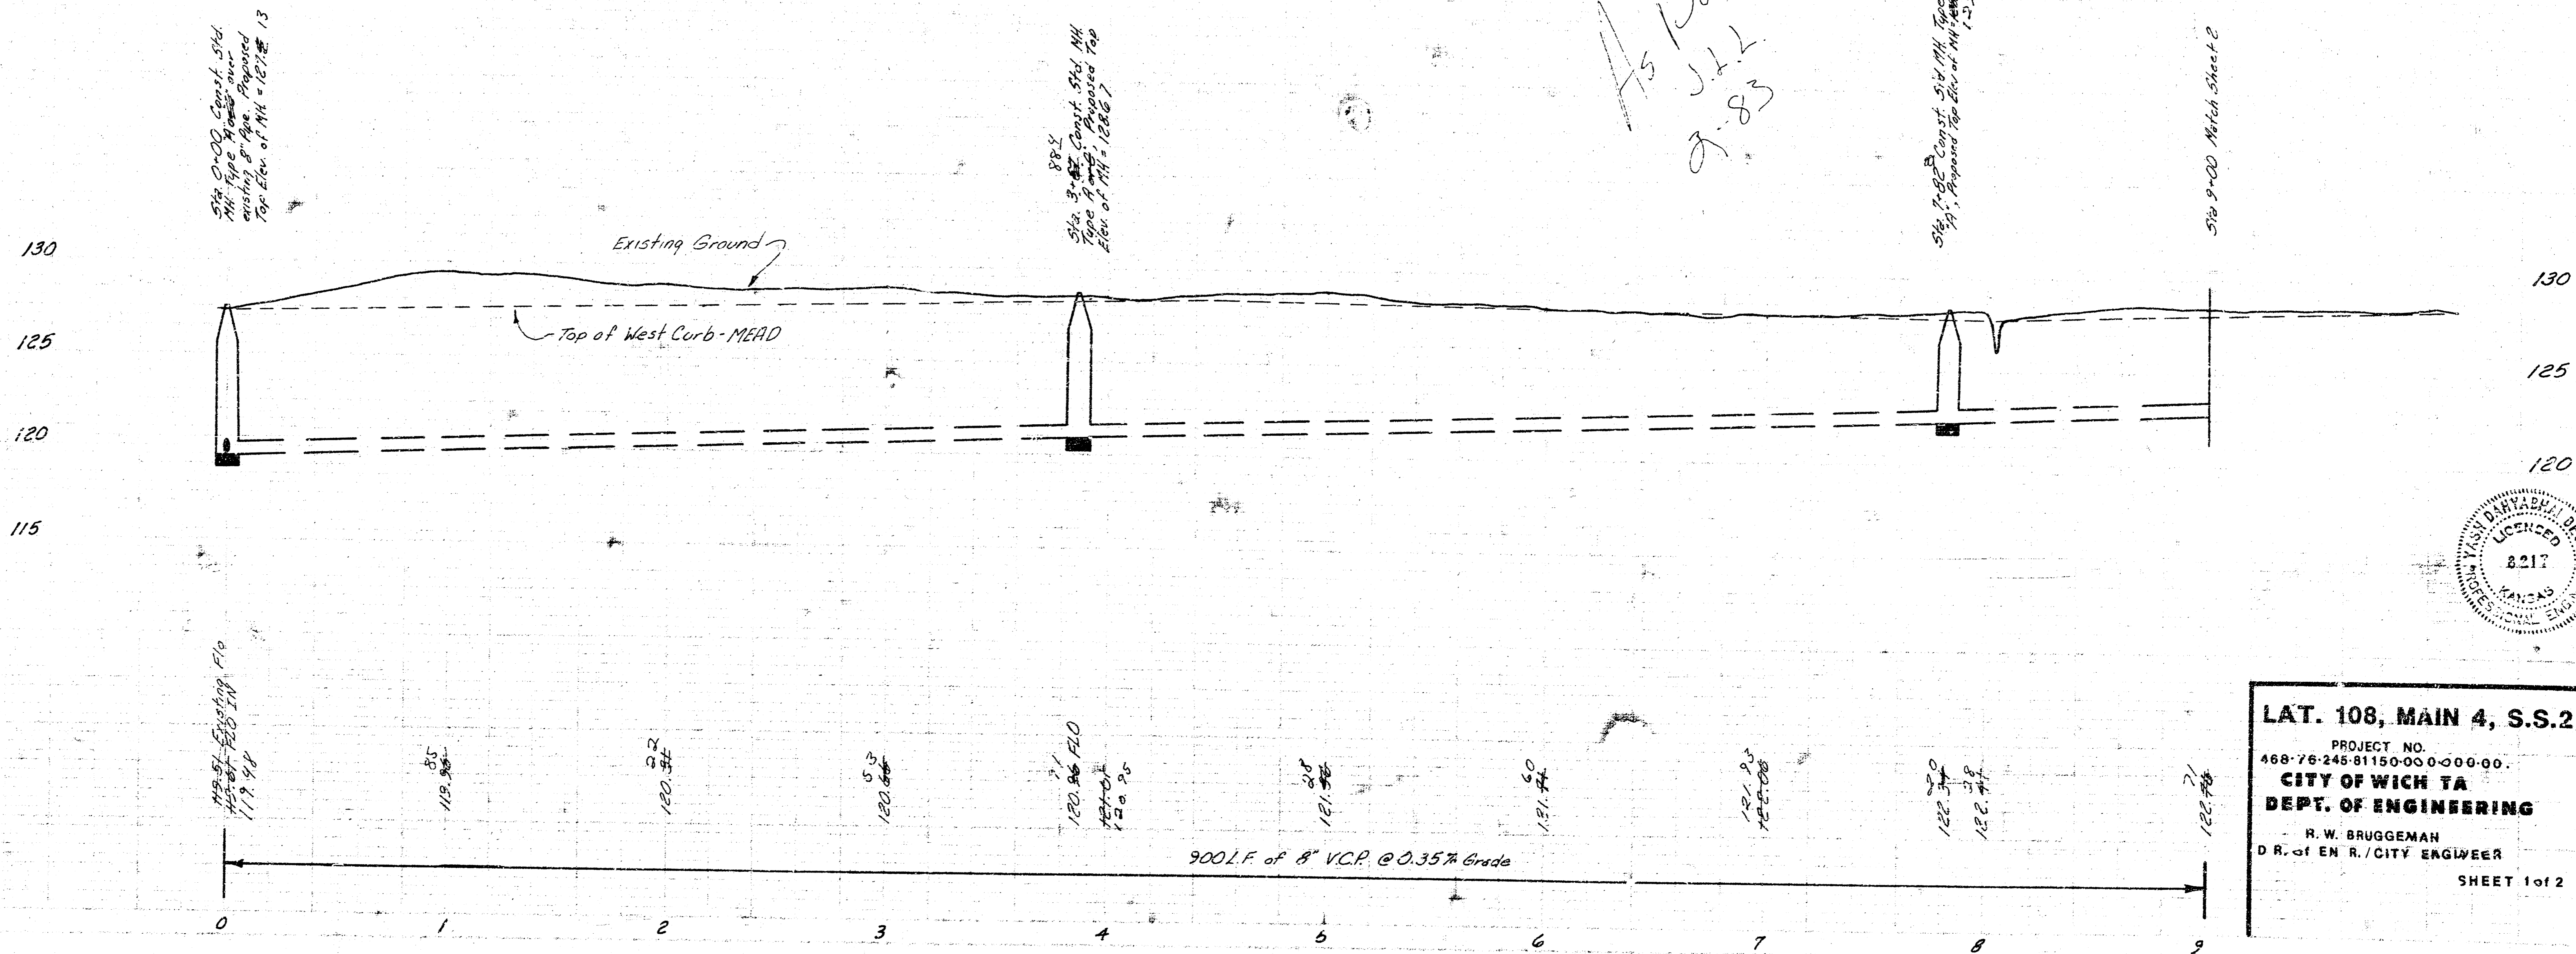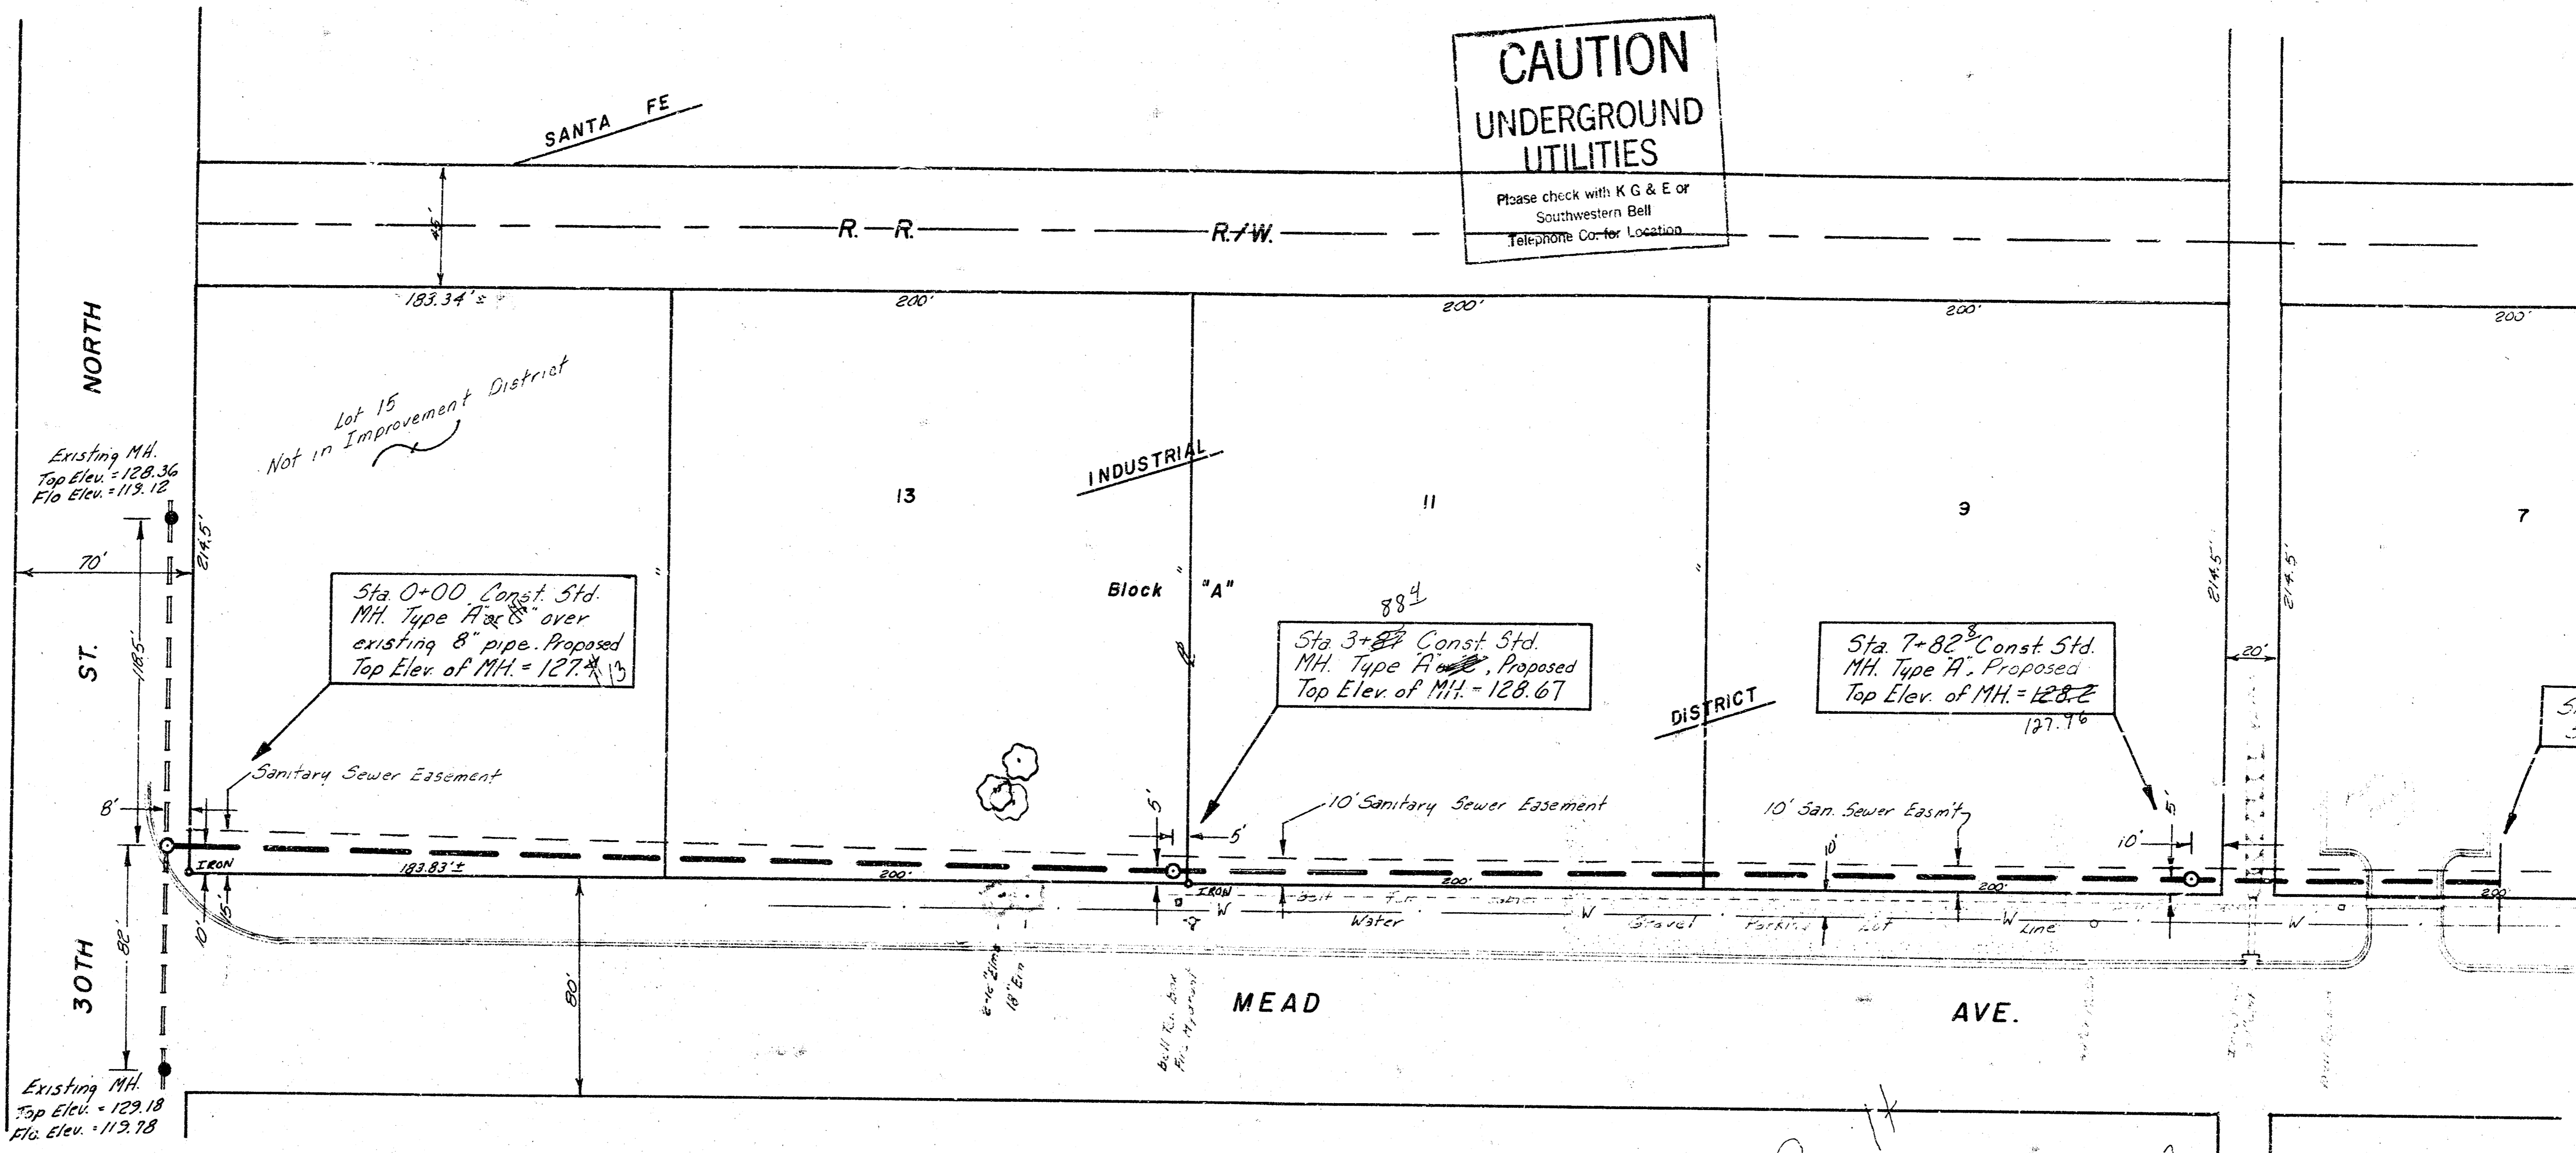


LAT. 108, MAIN 4, S.S.23  
PROJECT NO. 468-76-248-81150-00-0-00-00.  
CITY OF WICHITA  
DEPT. OF ENGINEERING  
R. W. BRUGGEMAN  
D.R. of EN R./CITY ENGINEER  
SHEET 1 of 2

30th St  
11/22/83  
J. Bruggeman  
S. Bruggeman



30th St  
11/22/83  
J. Bruggeman  
S. Bruggeman

MAP 7

As Built  
J.L.L.  
8.83

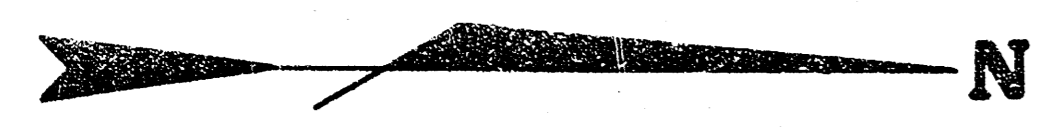

Scale: 1" = 40' Plan  
Hors. 1" = 40' Profile  
Vert. 1" = 5'

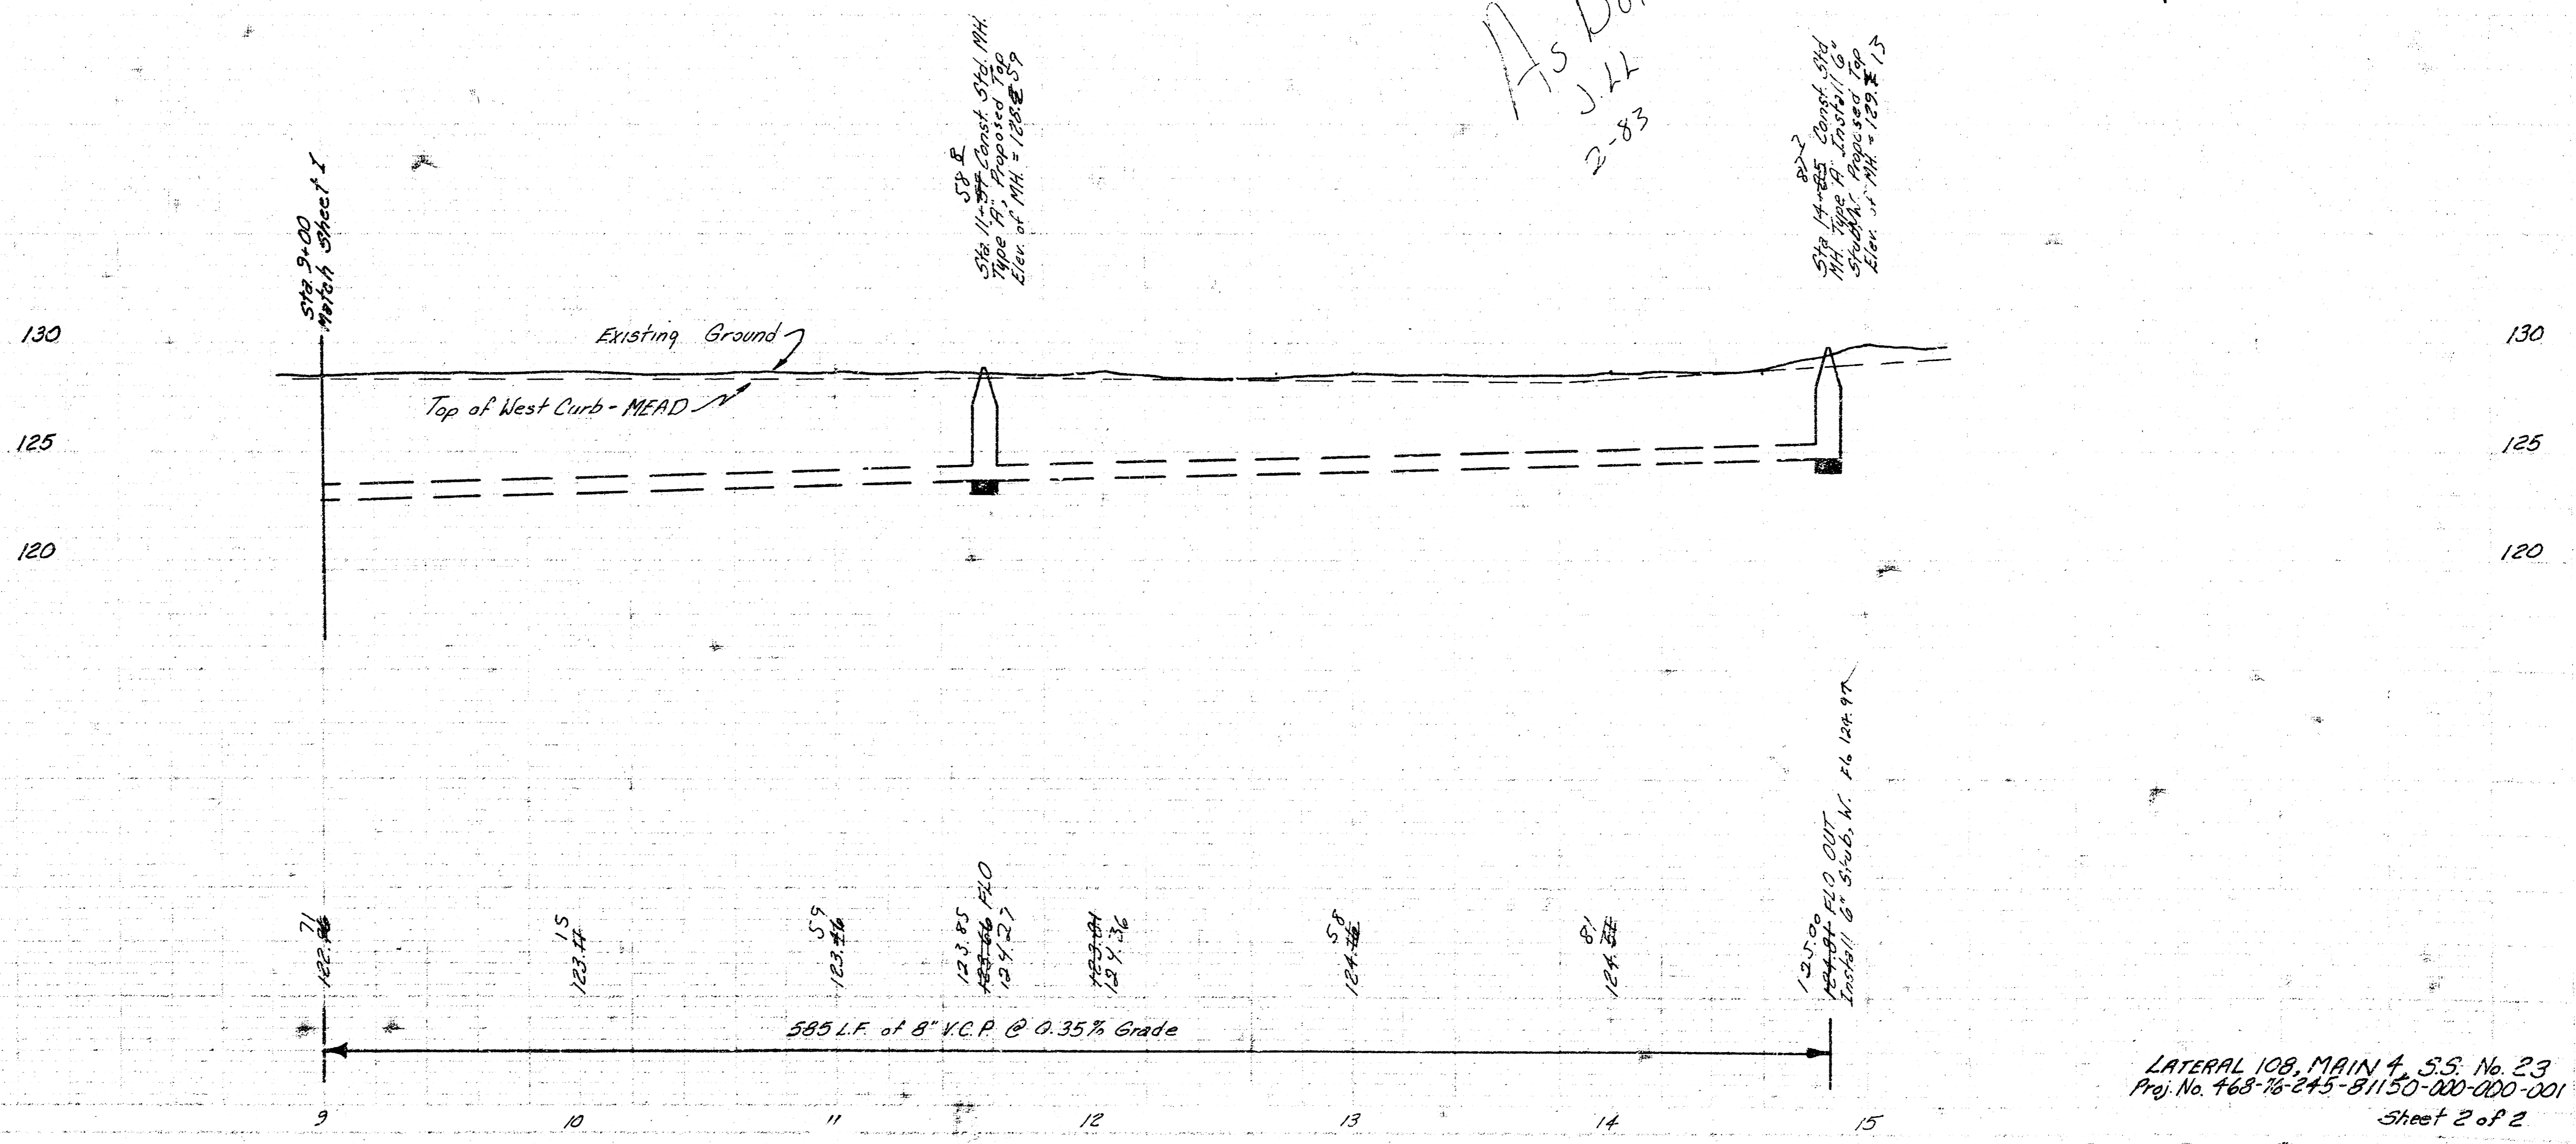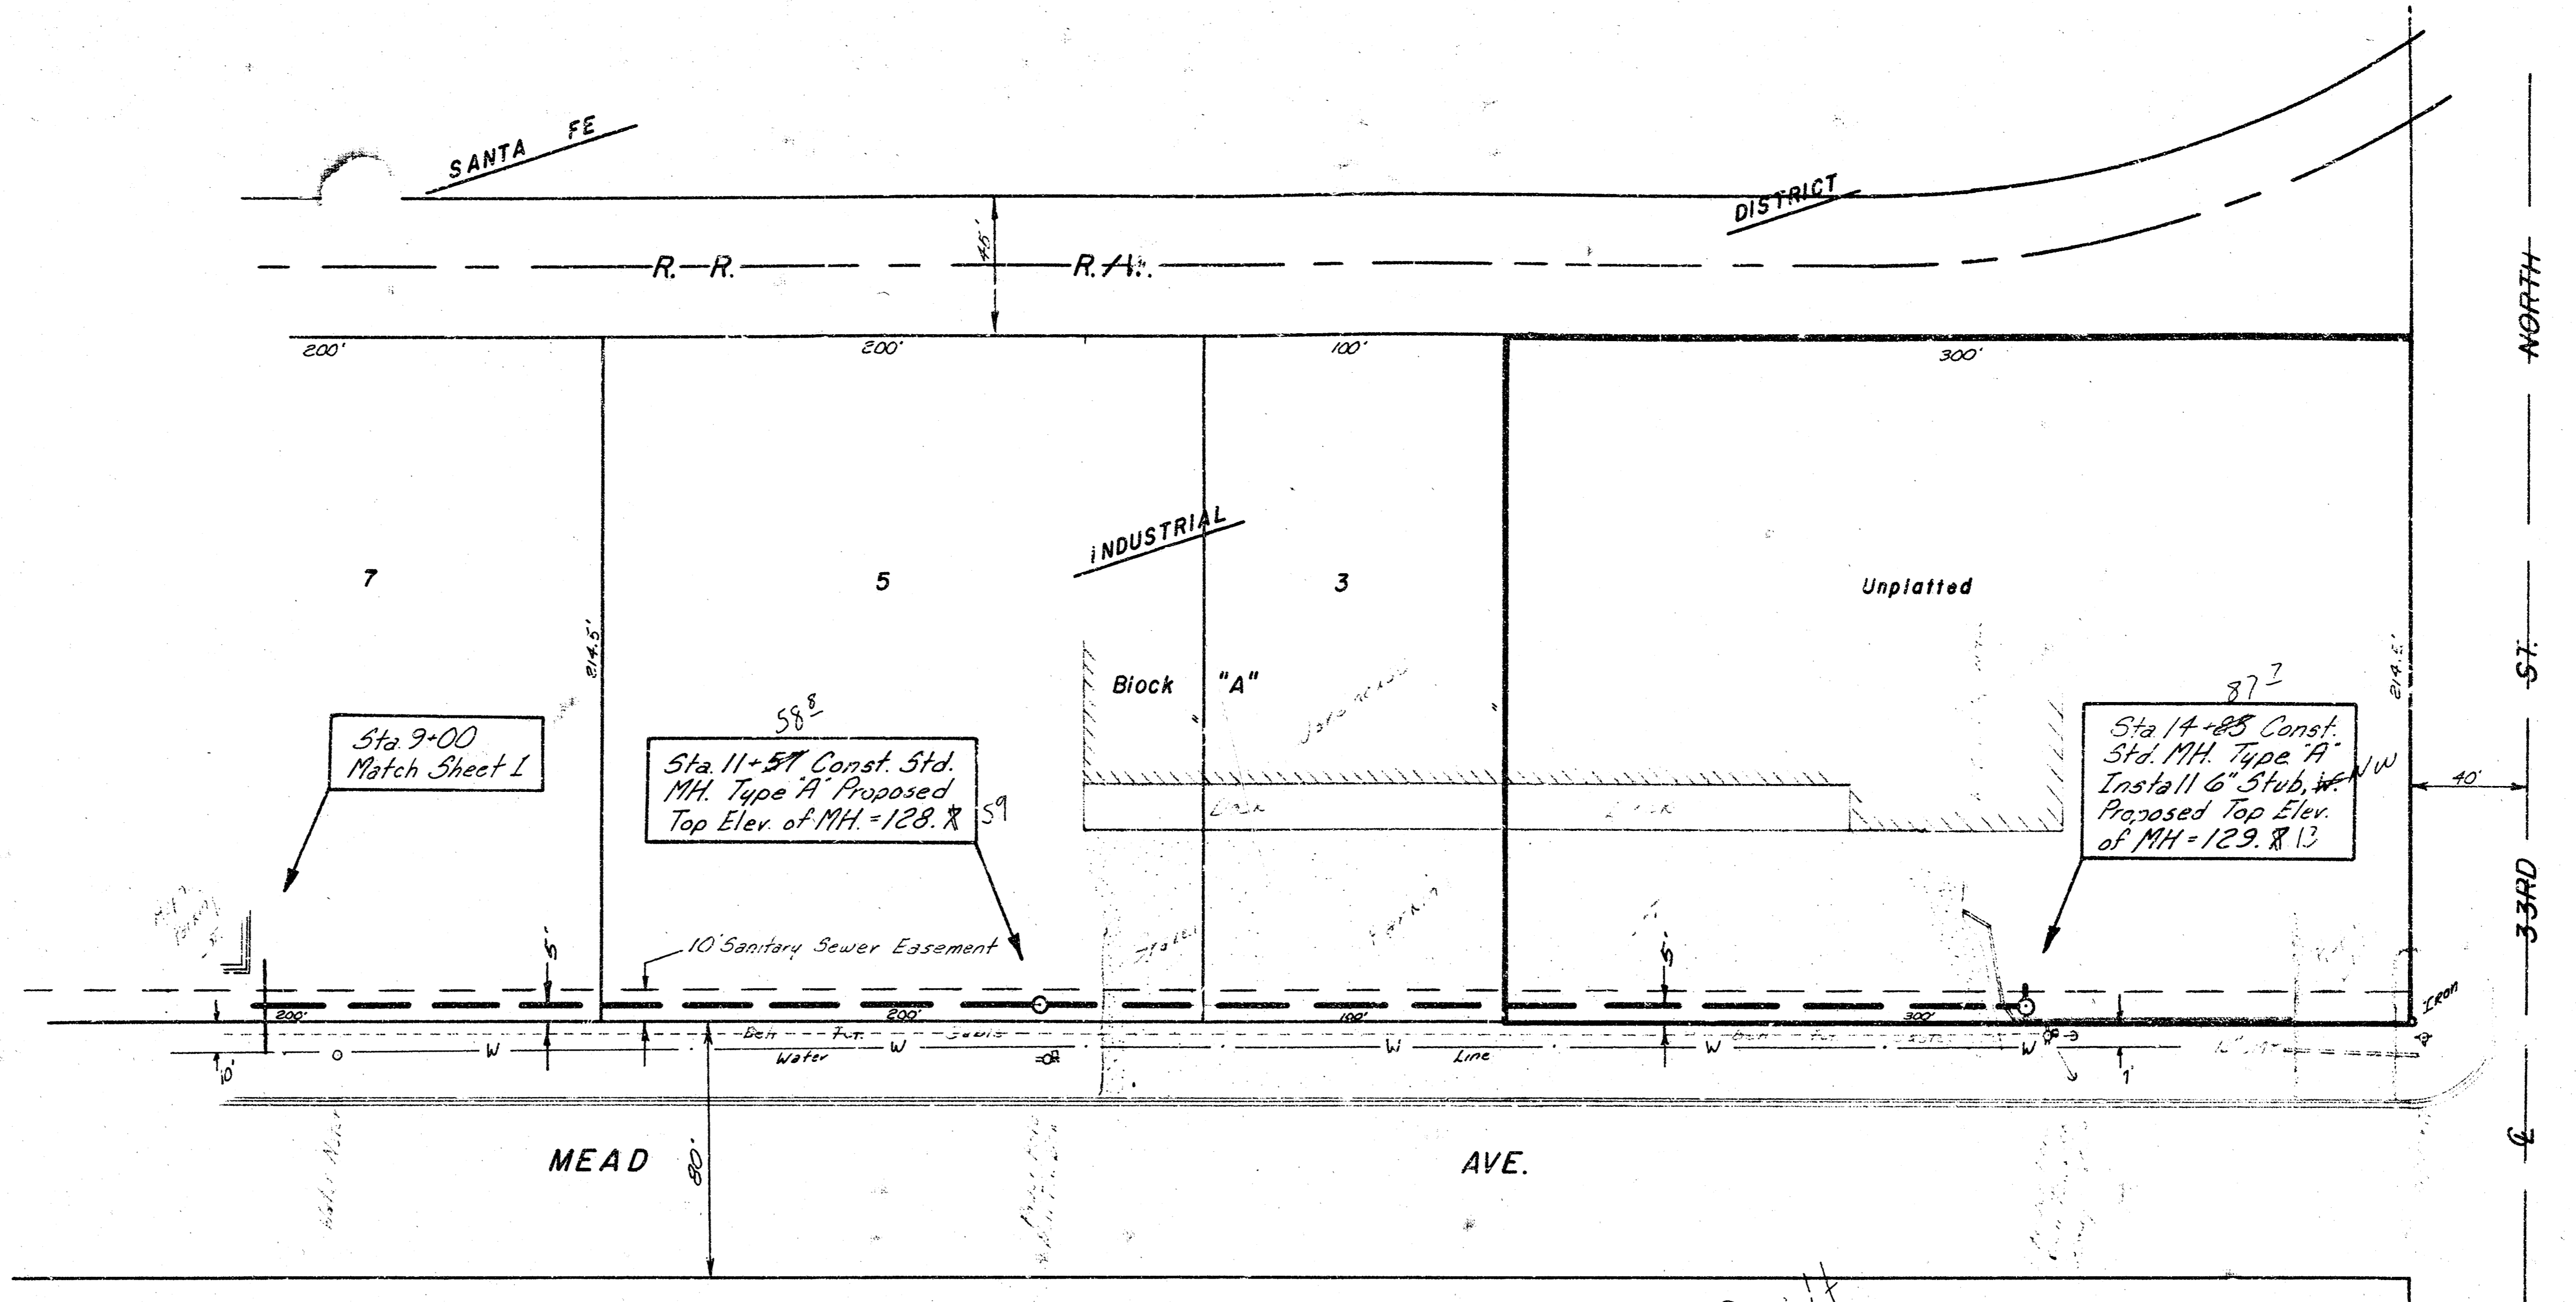

LATERAL 108, MAIN 4, S.S. No. 23  
Proj. No. 463-76-245-81150-000-001  
Sheet 2 of 2

18 3 3 3