

BENCH MARK: Sanitary Sewer Manhole located at the NW corner of the intersection of Harry Street and Hoover Avenue. Elev. = 113.37 City Datum

Sta. 0+00 Begin construction of 8" pipe at manhole. Connect to existing 8" stub.

Sta. 0+88.8 End construction of 8" pipe. Construct Standard Manhole, with 6" stub (NW). Top Elev. = 112.85

SCALE:
1" = 20' Horiz
1" = 5' Vert.


- The contractor shall give all property owners and/or tenants of developed property abutting the construction of this project a minimum of ten (10) days advance notice prior to start of construction.
- The Contractor shall be responsible for preserving property irons. The Contractor will be required to re-establish any property irons which are damaged or destroyed by his construction operations. Such irons shall be re-established by a licensed land surveyor in accordance with state laws.
- Traffic will not be affected by construction of this project.
- The contractor shall be responsible for locating all existing utilities prior to start of construction.
- Contractor shall restore project area as required by City of Wichita administration regulation AR-78.

Saw Joint Remove & replace conc. pavement as necessary.

CAUTION: Existing bushes. Remove as necessary.

APPROVED AS NOTED
BY CITY ENGINEER OF WICHITA
Sanitary Sewers - VRH 3/10/93
Storm Sewers _____
Driveway Approaches _____
Water Mains _____
Paving _____

NOTE TO CONTRACTORS
Inspection and testing for this project is to be provided by a Licensed Consulting Engineering firm under contract with the Owner/Developer. Said inspection to be in accordance with the City of Wichita standard construction engineering practices and certified by a Licensed Professional Engineer. No work shall be performed in dedicated easements or public right-of-way by the Contractor without such inspection nor shall any work be commenced without written authorization by the City Engineer.

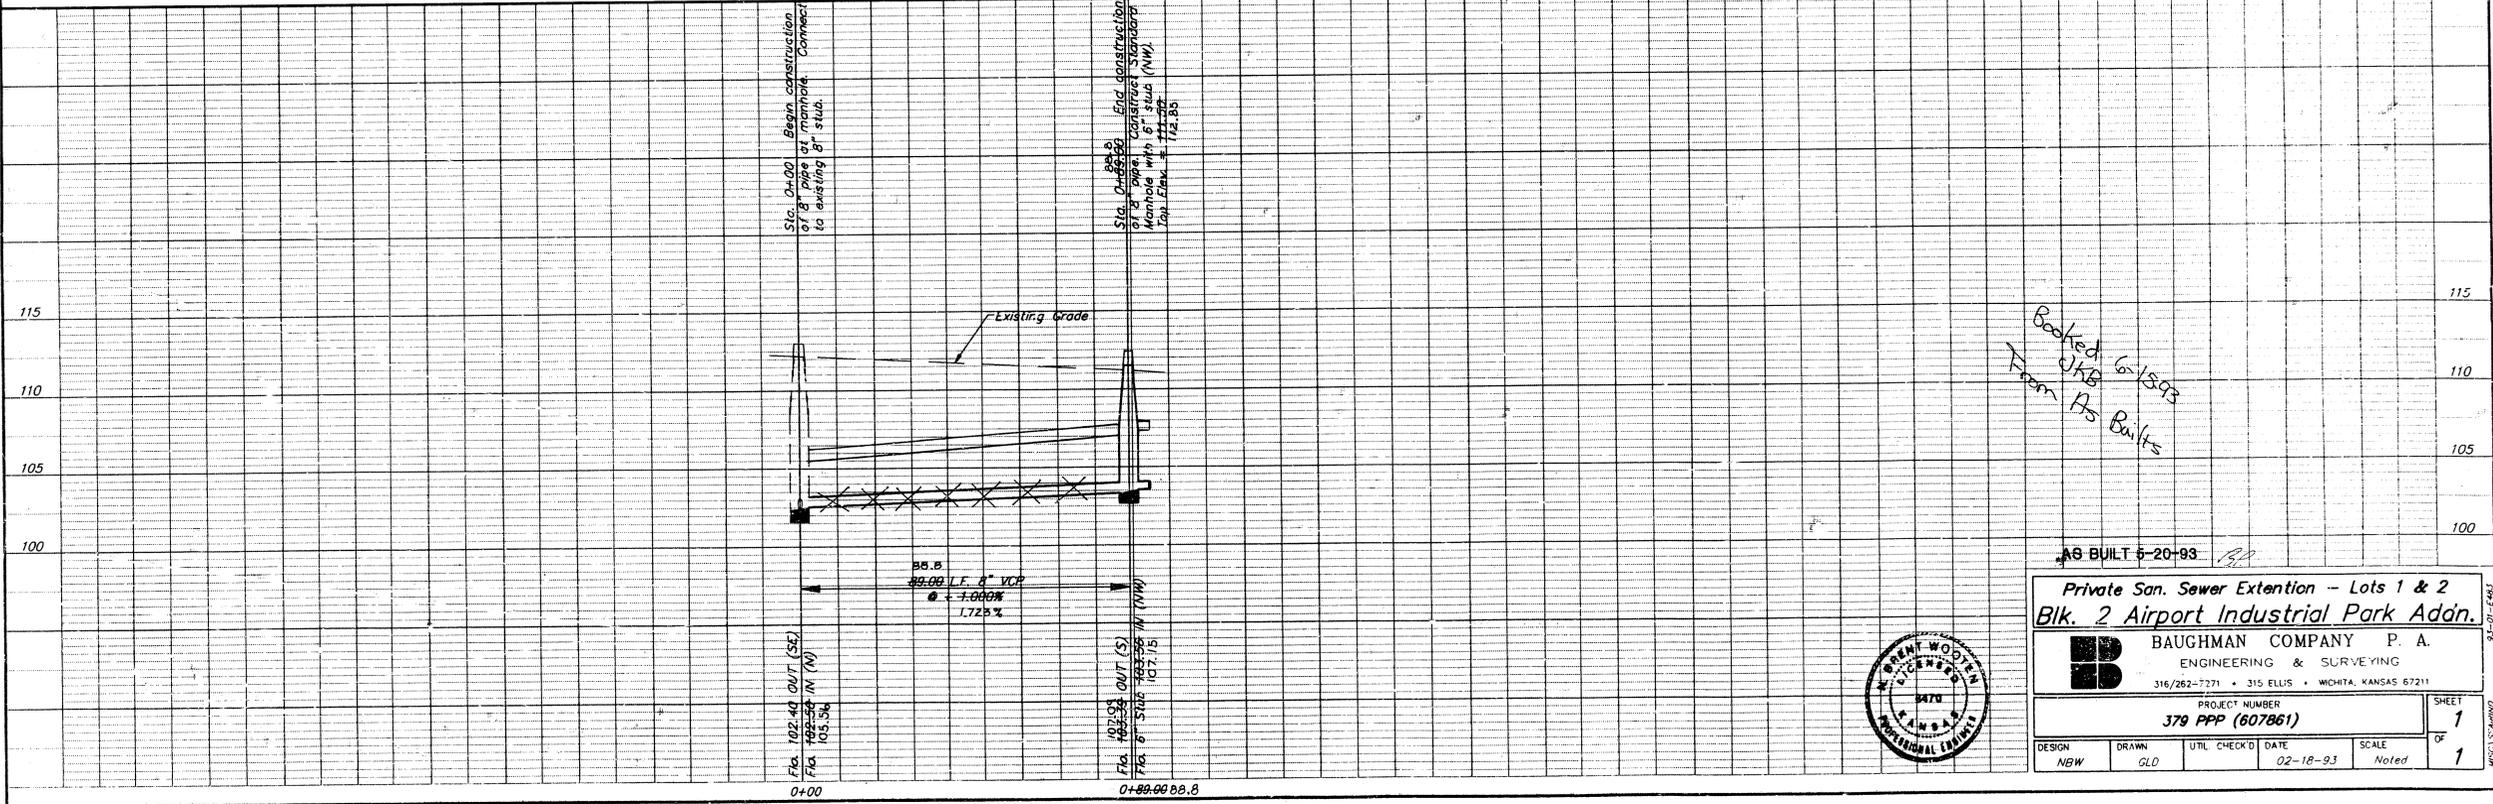

AS BUILT 5-20-93

Booked 6/13/93
From As Bults

Private San. Sewer Extension - Lots 1 & 2
Blk. 2 Airport Industrial Park Addn.

B BAUGHMAN COMPANY P. A.
ENGINEERING & SURVEYING
316/262-7271 • 315 ELLIS • WICHITA, KANSAS 67211

PROJECT NUMBER
378 PPP (607861)

DESIGN NBW DRAWN GLD UTIL CHECK'D DATE 02-18-93 SCALE Noted

SHEET 1 OF 1