


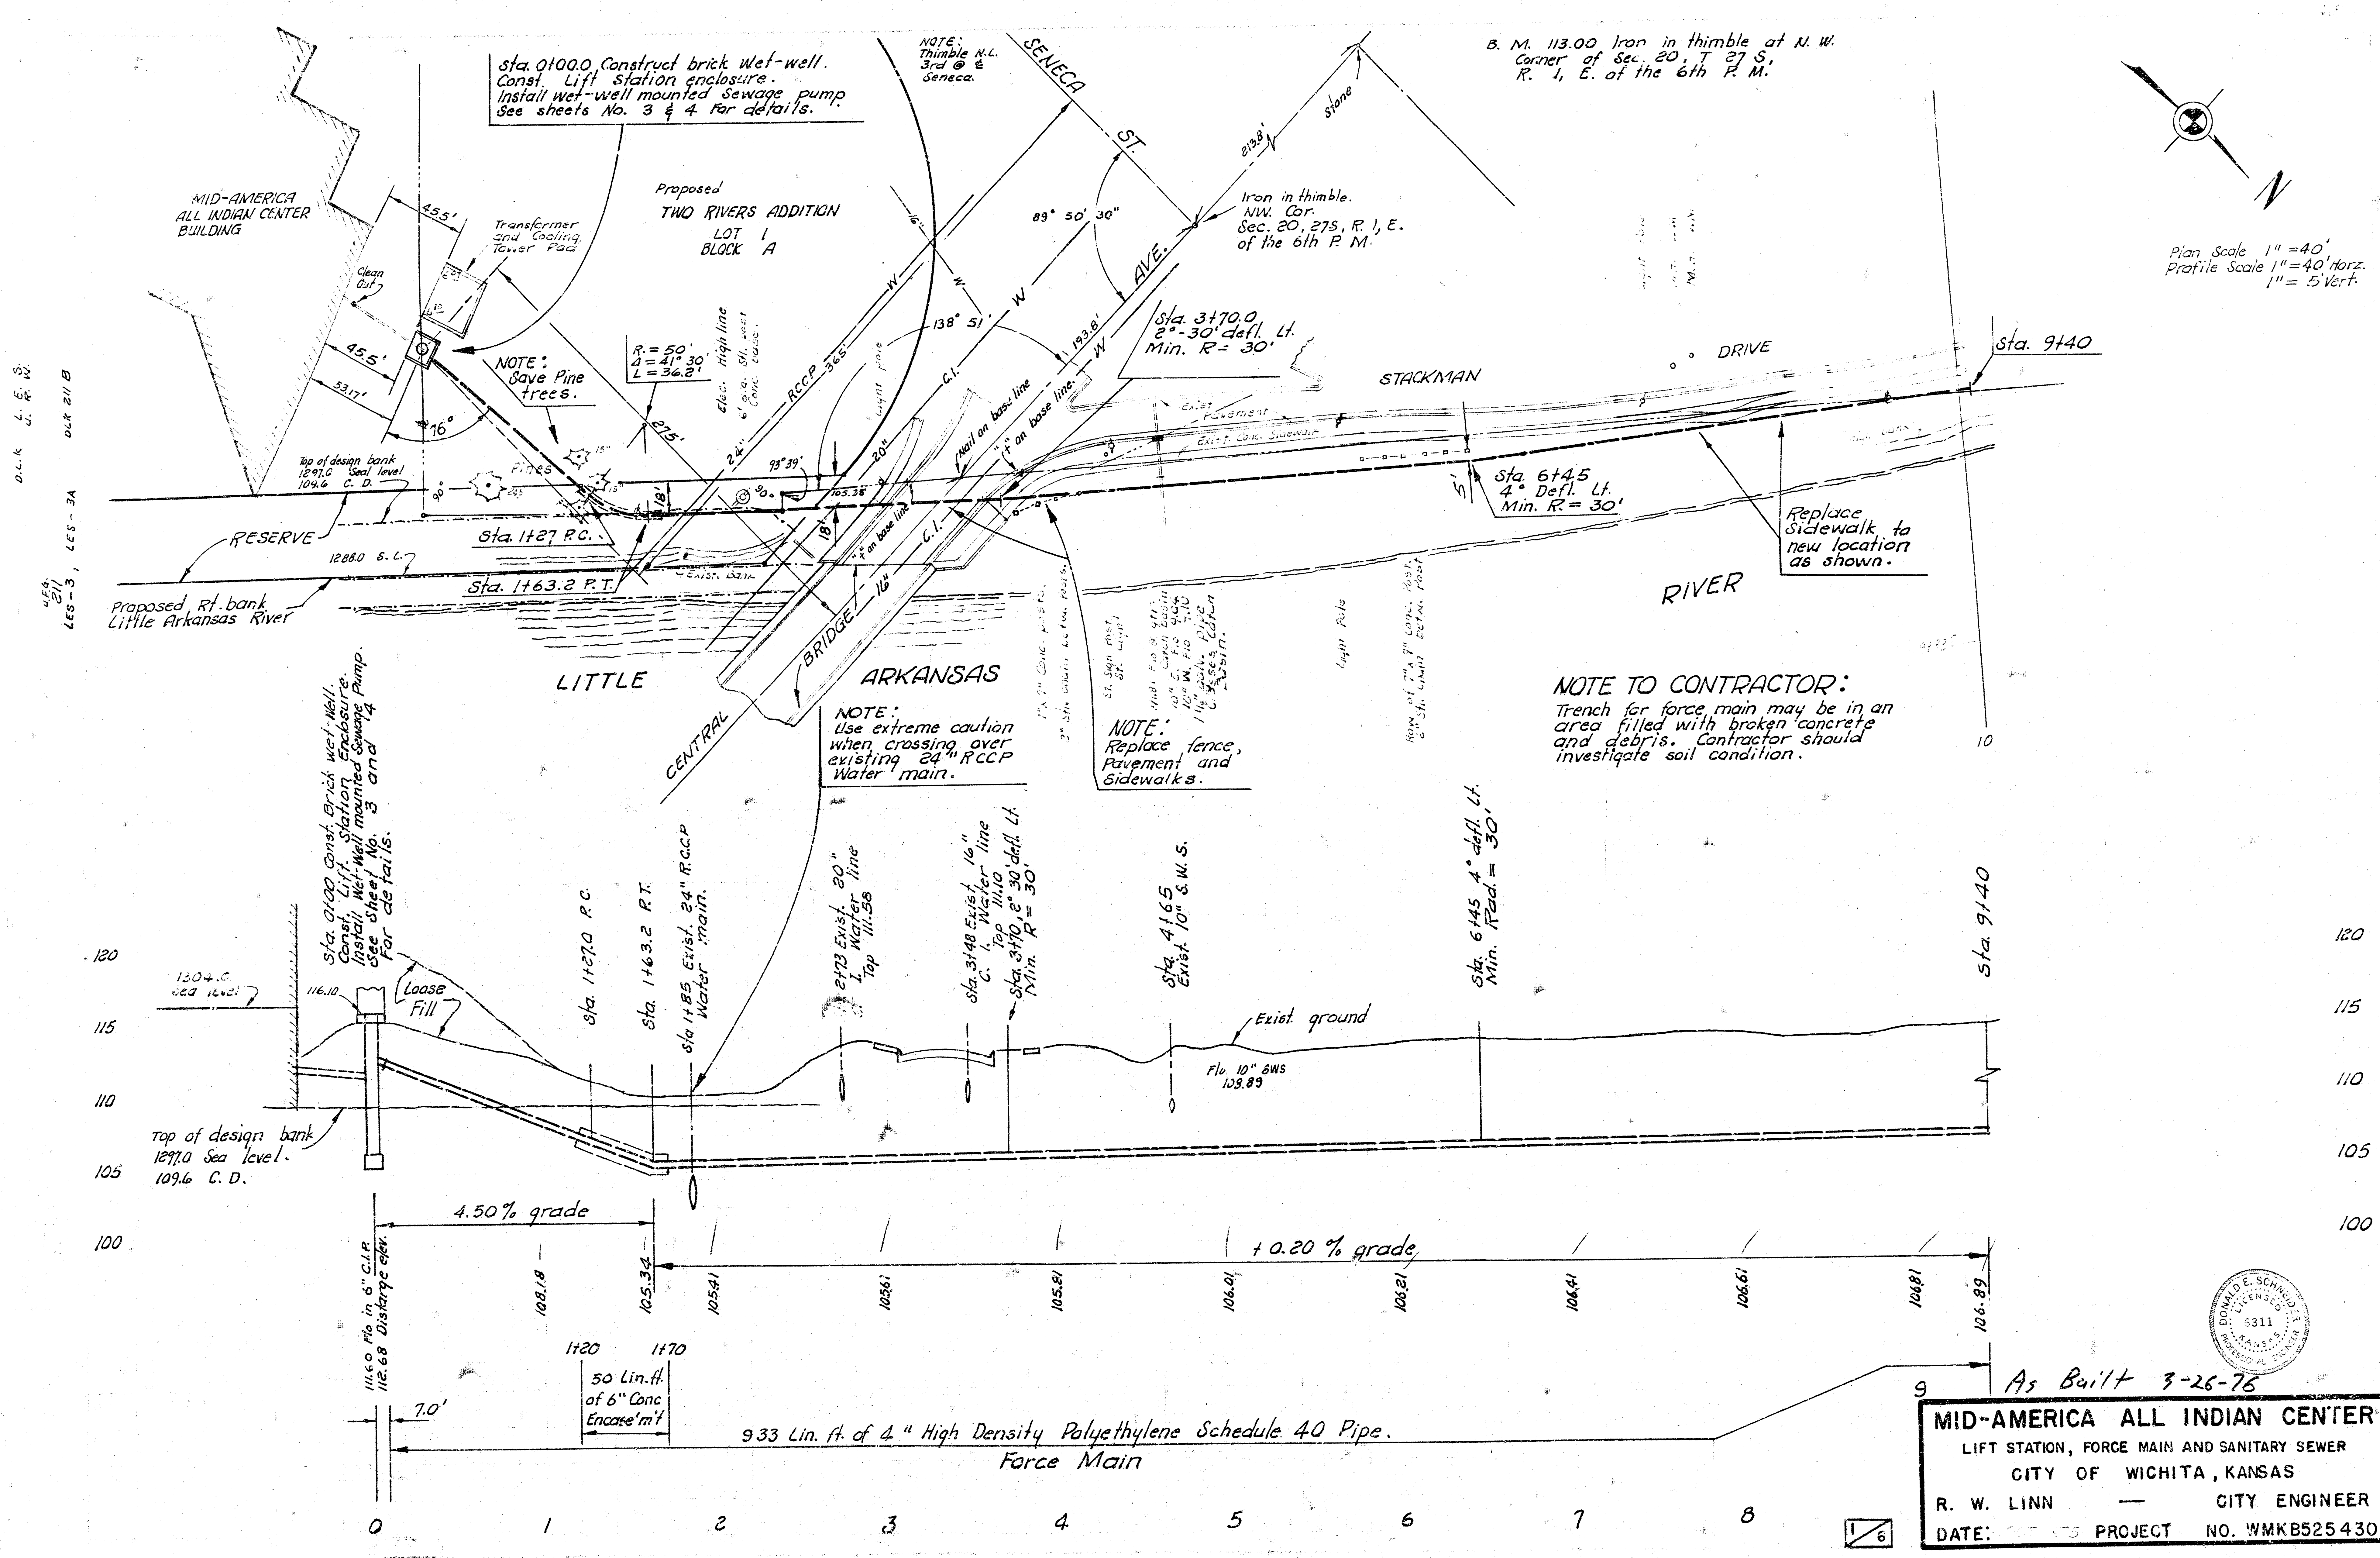


Plan Scale 1" = 40'
Profile Scale 1" = 40' Horiz.
1" = 5' Vert.


NOTE TO CONTRACTOR:
Trench for force main may be in an area filled with broken concrete and debris. Contractor should investigate soil condition.


As Built 3-26-76

MID-AMERICA ALL INDIAN CENTER	
LIFT STATION, FORCE MAIN AND SANITARY SEWER	
CITY OF WICHITA, KANSAS	
R. W. LINN	CITY ENGINEER
DATE: 3-26-76	PROJECT NO. WMKB525430

B. M. 114.78 "d" Top N. cb. Pine
 @ E. 4' walk N. on W. L.
 Stackman Dr.

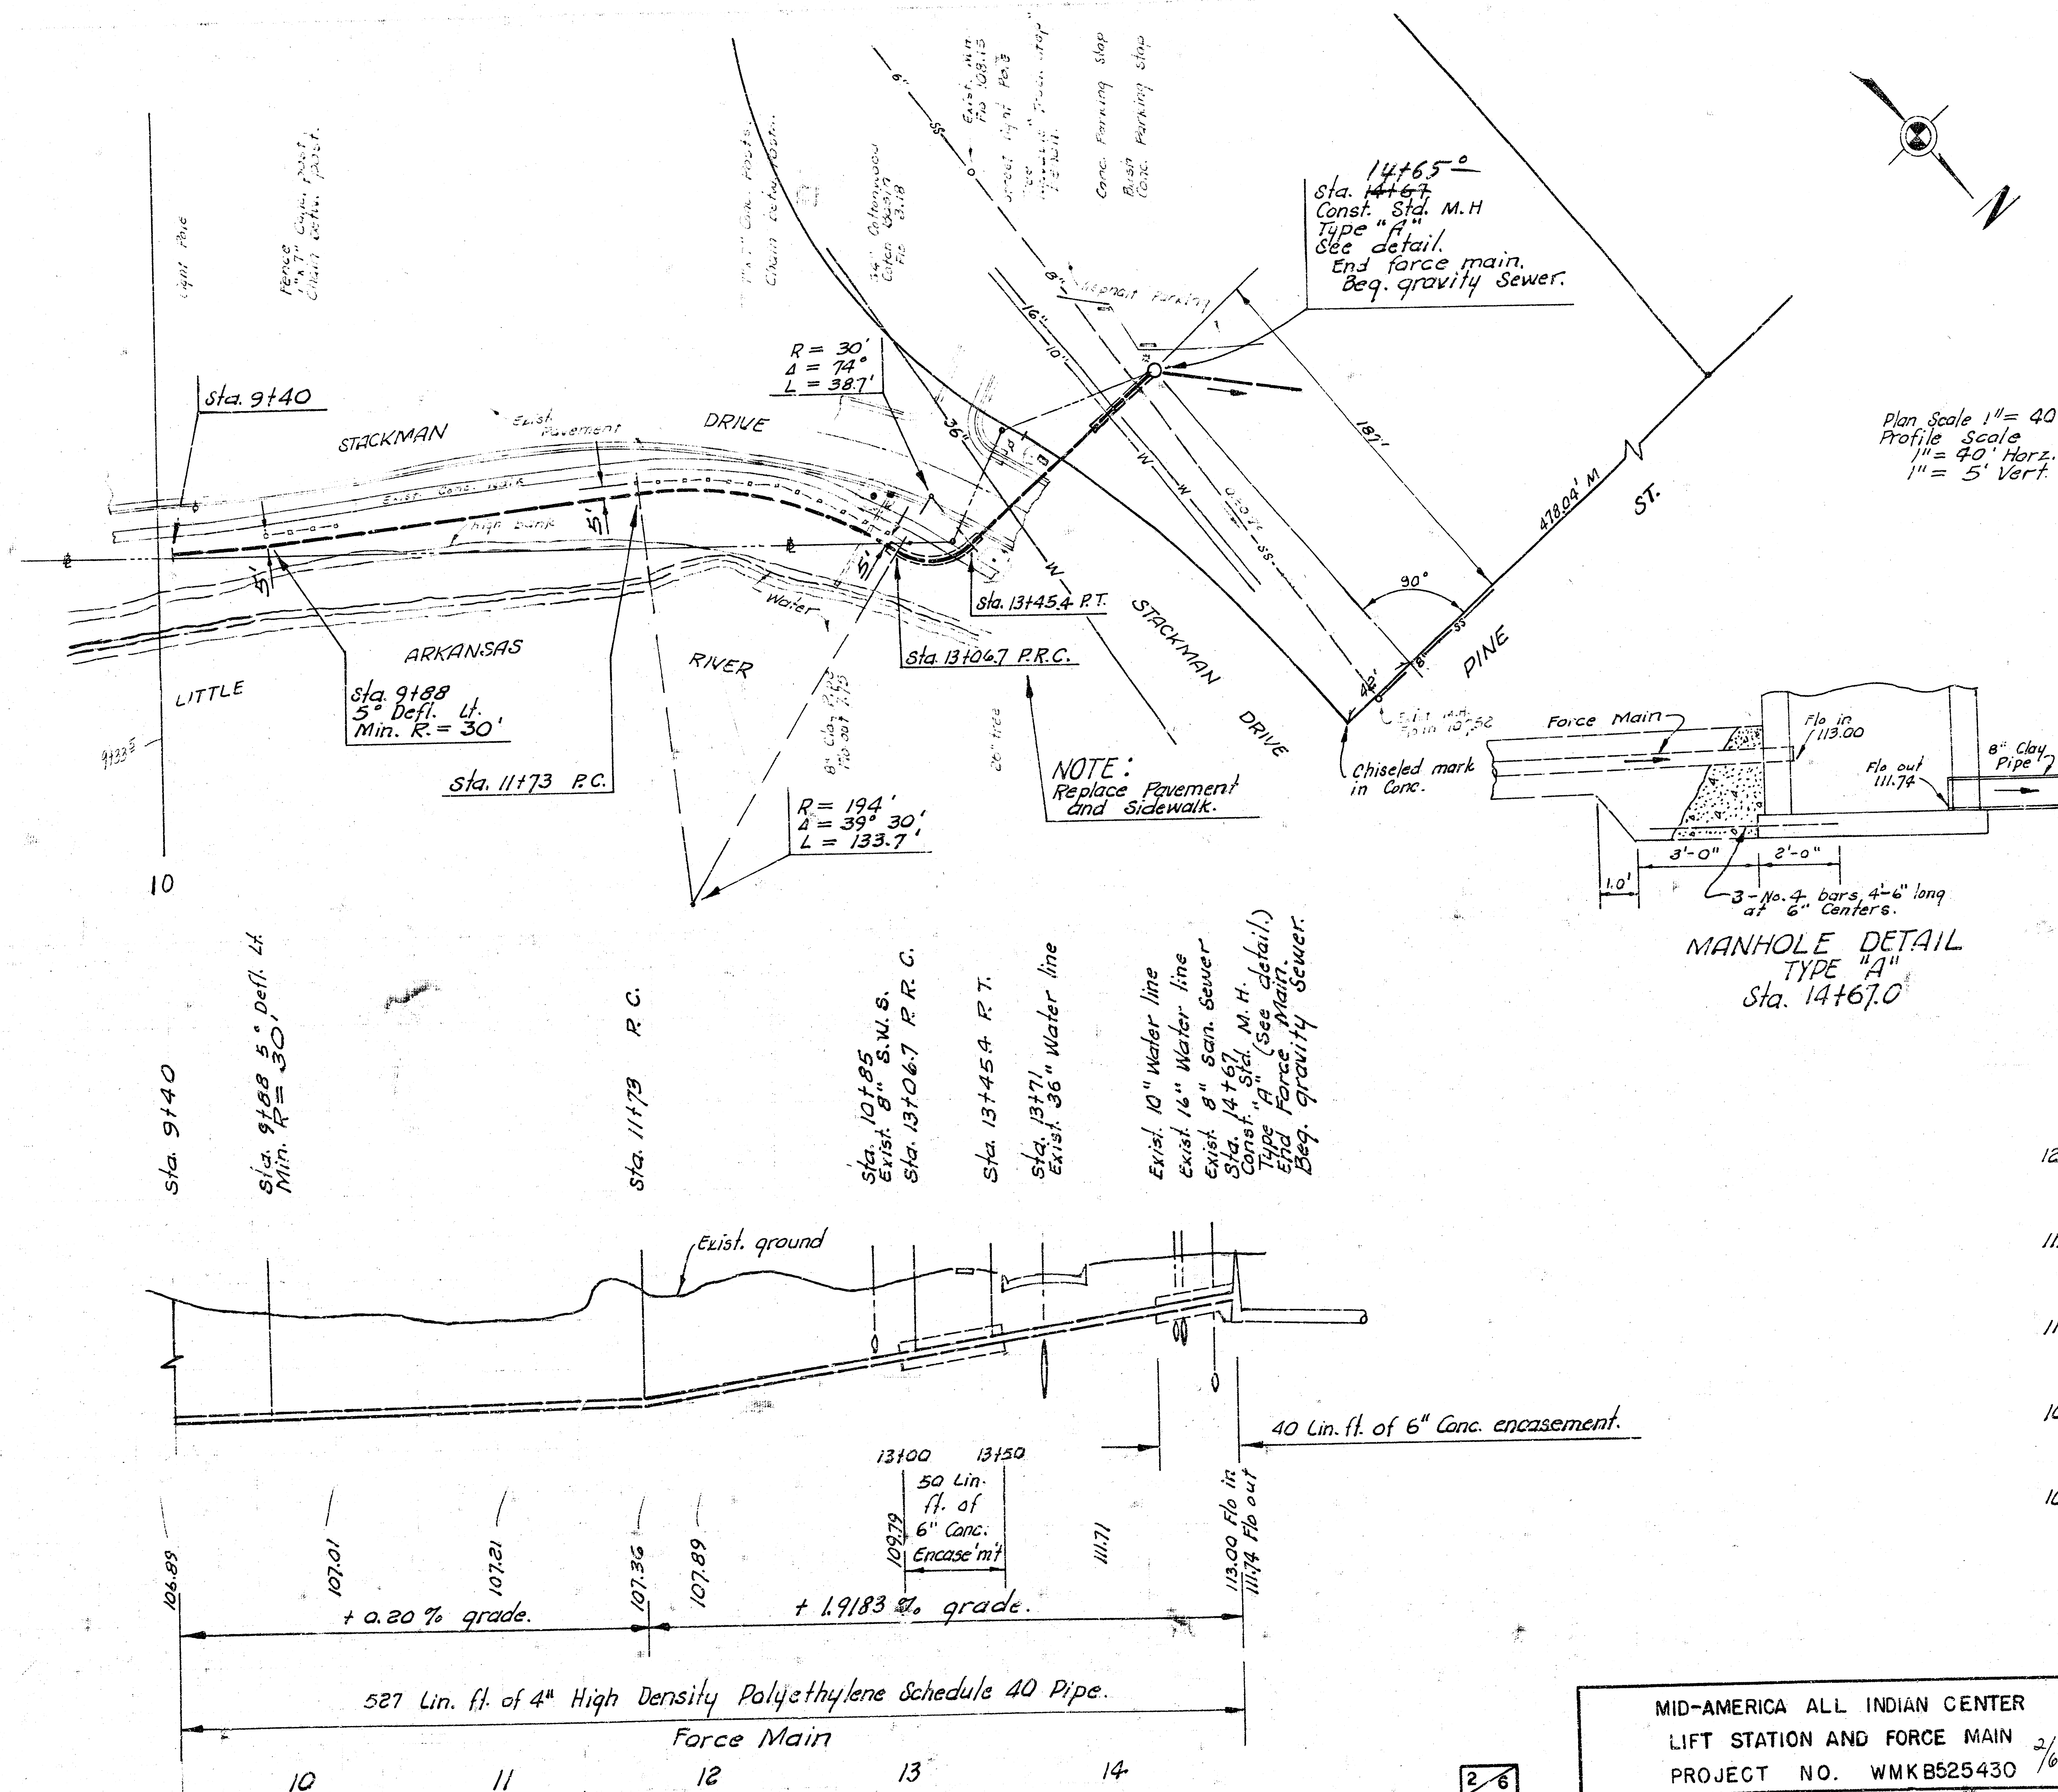

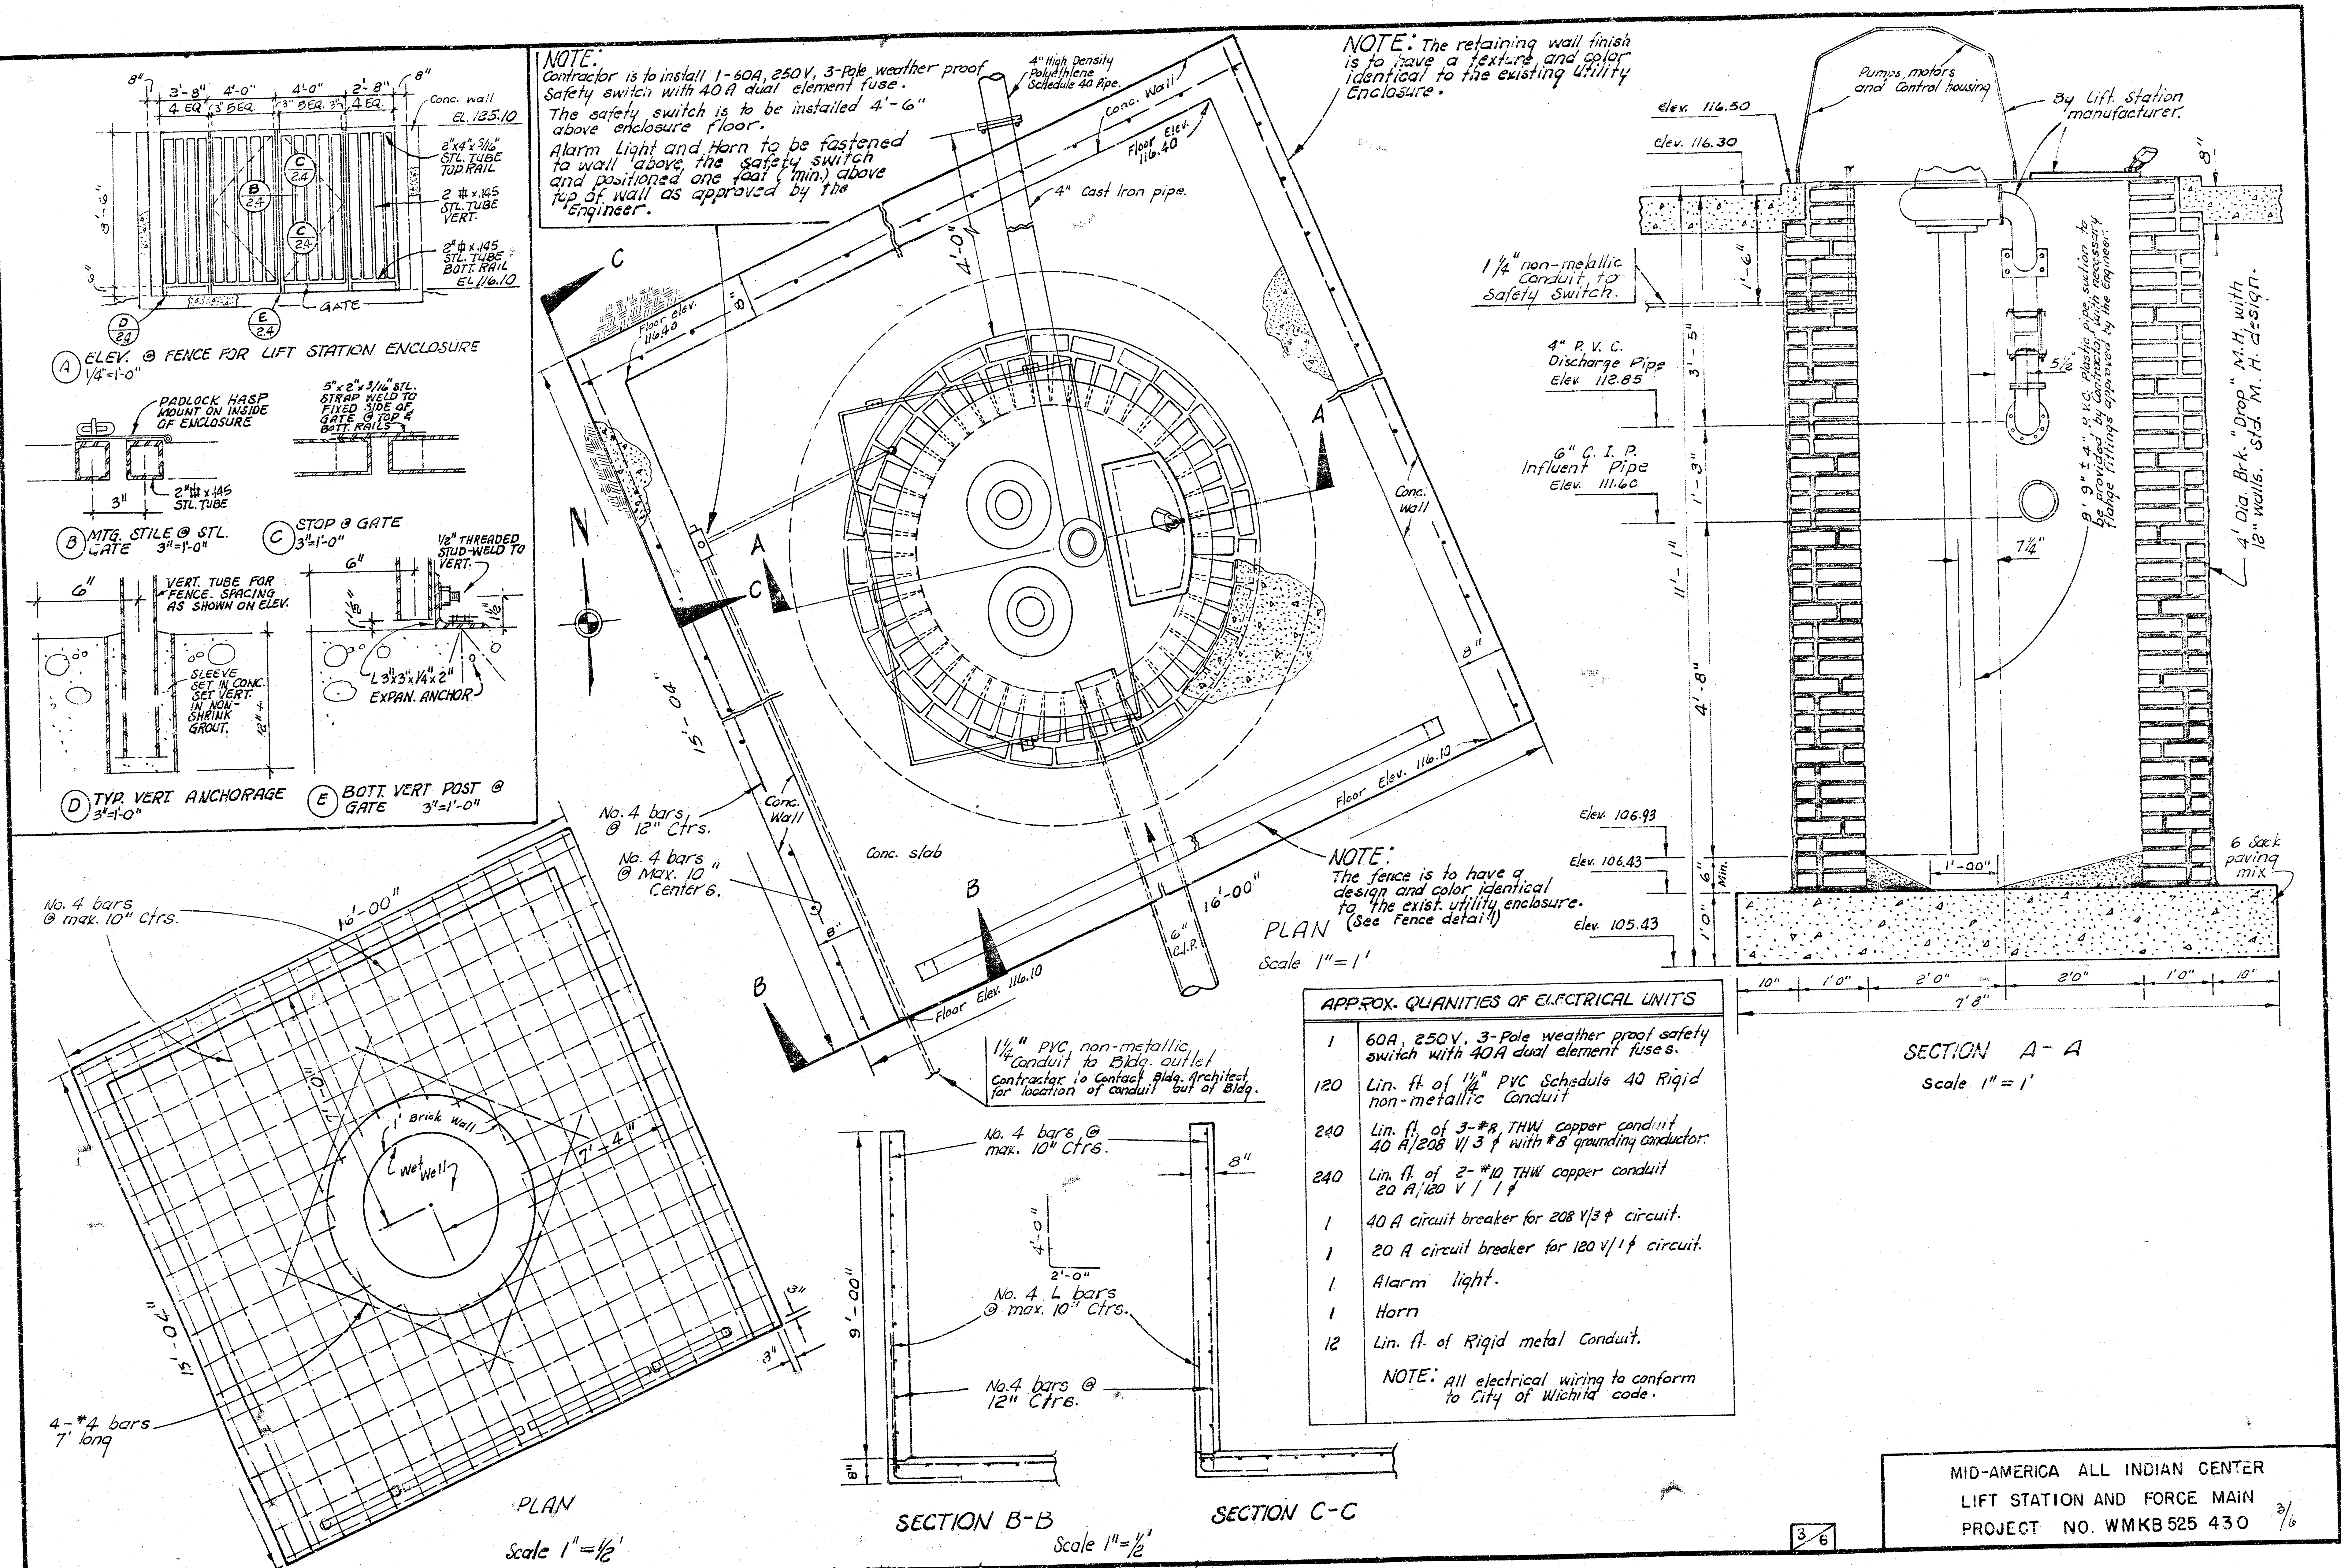

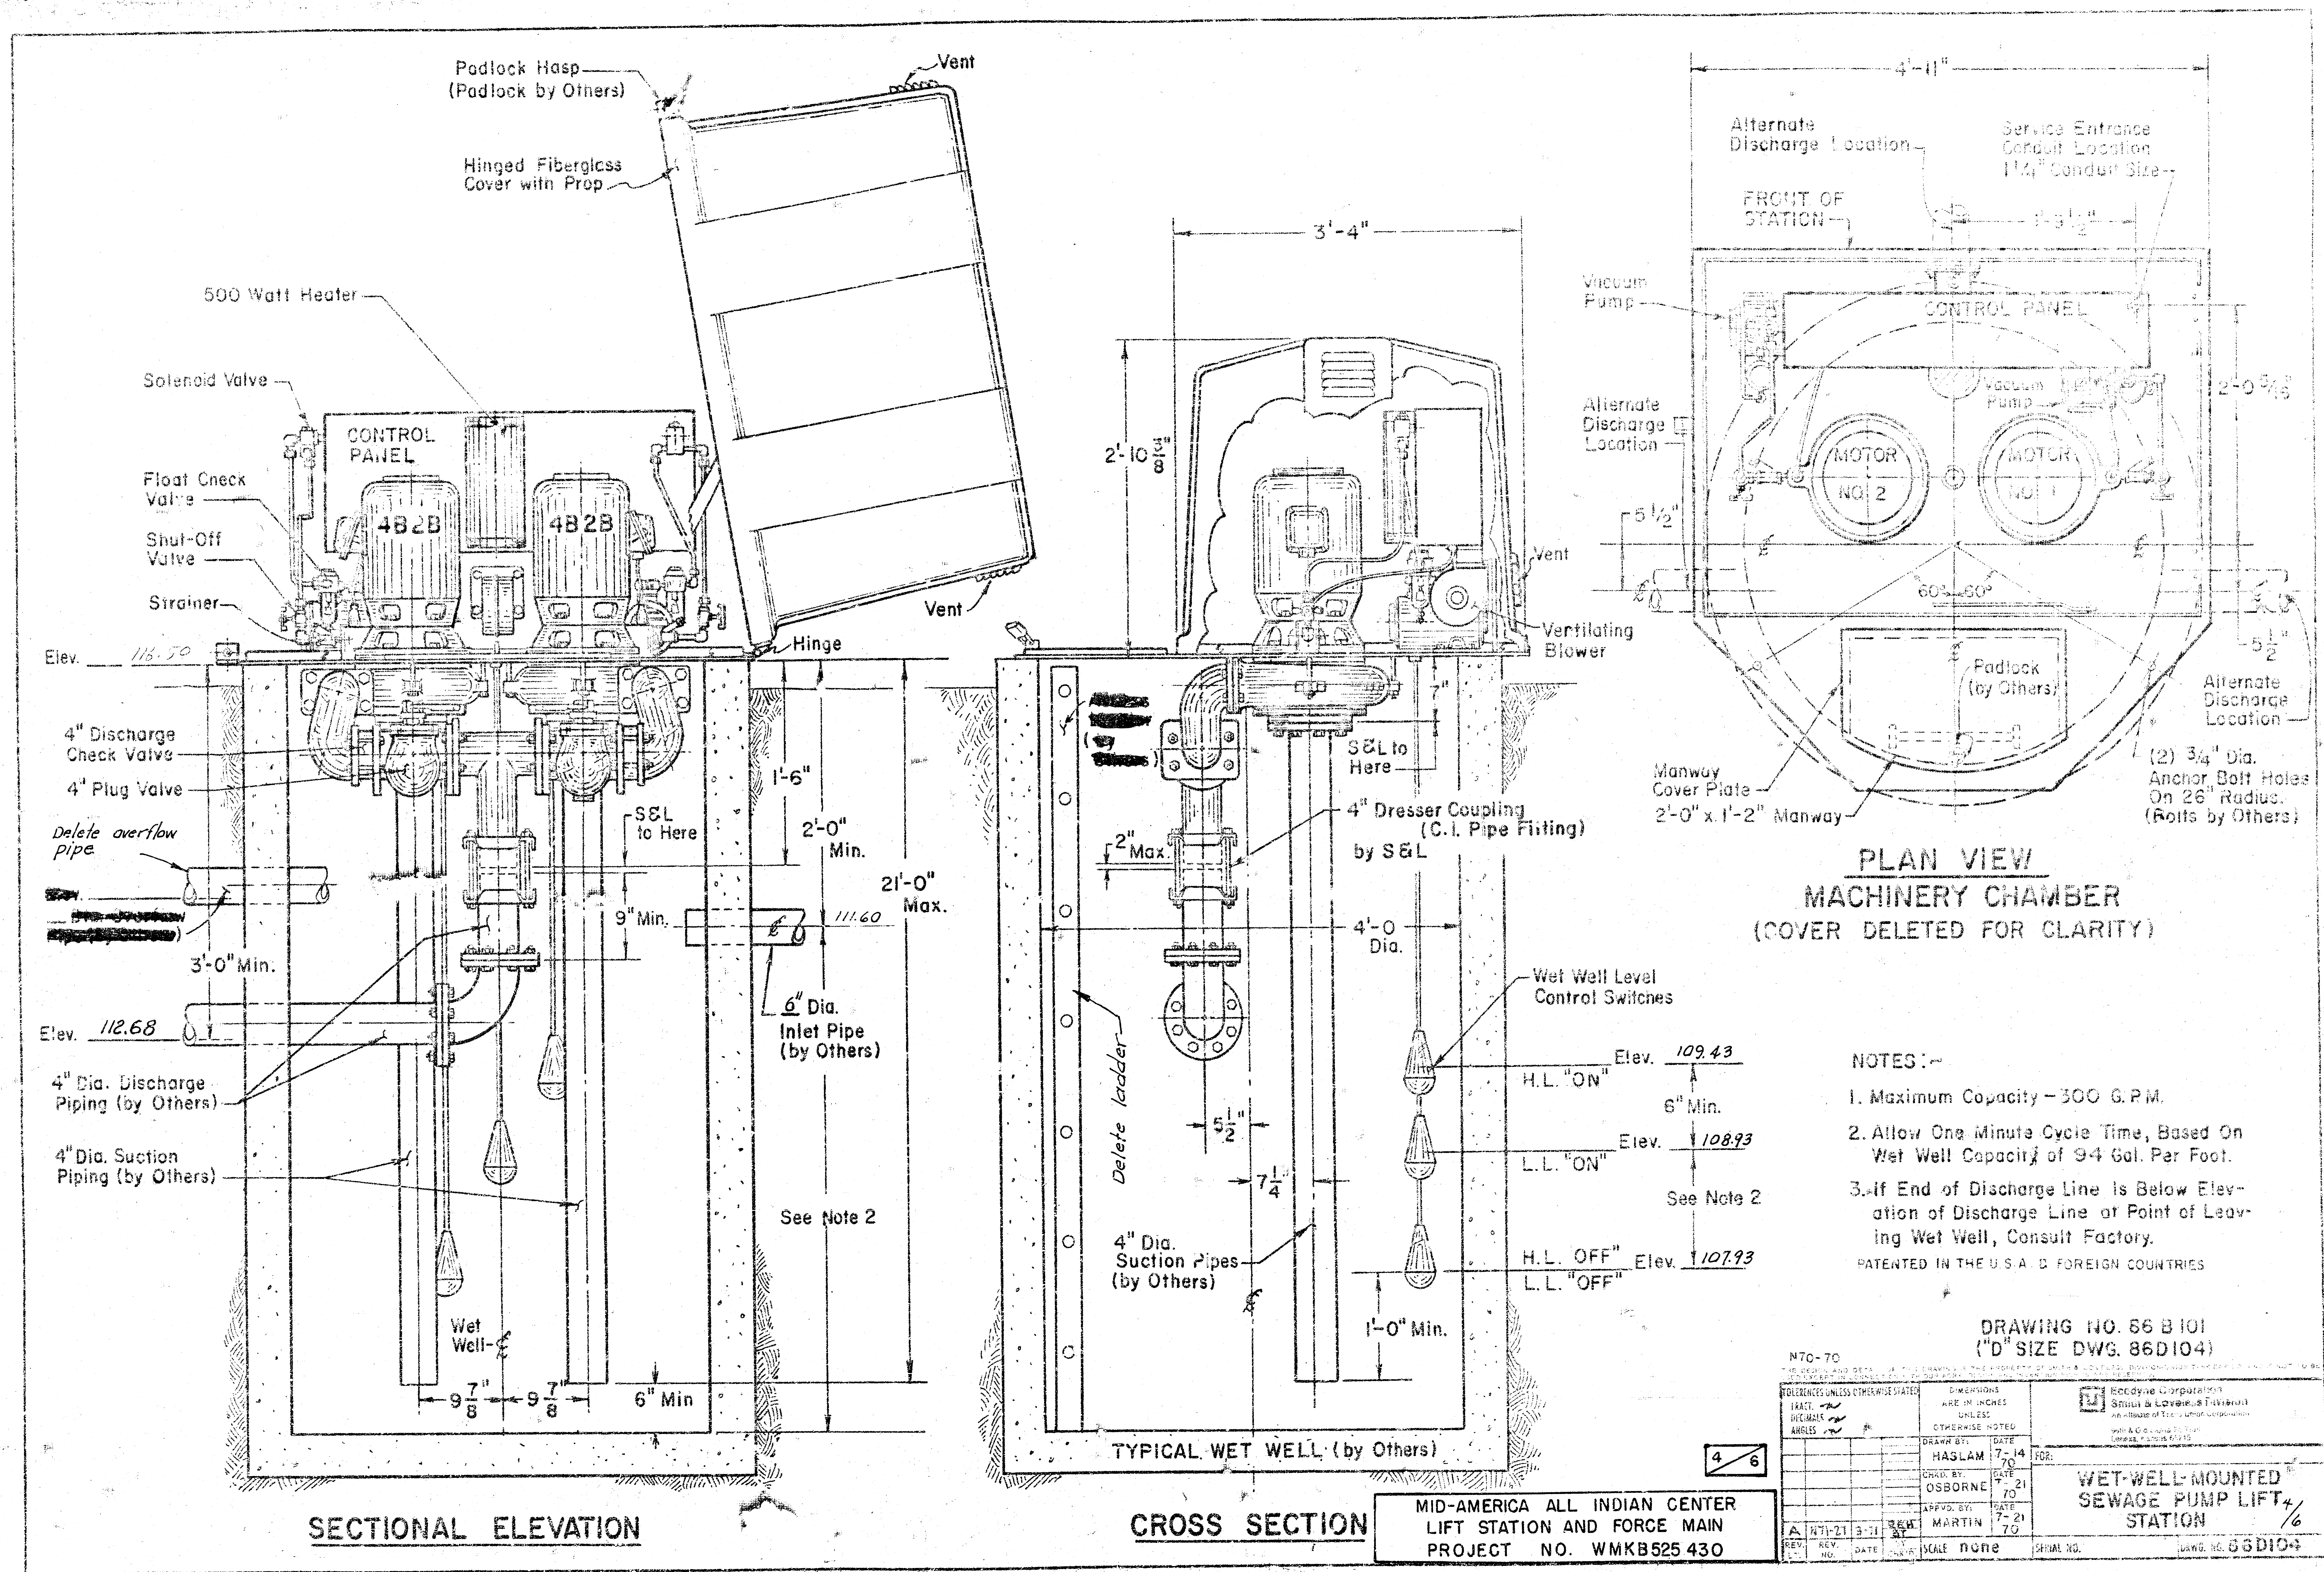

B. M. 113.00 Iron in thimble of N.W. corner of Sec. 20, T27S, R. 1E, of the 6th P. M.

B. M. 114.78 "a" top N. curb Pine St. @ 4' walk N. on west line Stackman Drive.

NOTE:
Removal and Replacement of conc. Areas north of Right-of-way line on Pine St. shall be paid as conc. slab removed and Replaced.

Sta. 0+00.0 Existing manhole Beg. removal of exist. 6" S. S.
Remove exist. manhole. Const. new manhole Type "A" or "C"

CAUTION:
Sta. 0+94 Exist. K. G. & E. Underground conduit.

Remove exist. M. H. Plug 6" San. Sewer north & south. Extend exist. pipe west to new M. H. with same kind and size of pipe.
Extension of pipe west will not be paid for directly and this work shall be considered as subsidiary.

0+74.5
Sta. 0+74.0 Const. Sta. M. H. Type "A" or "C" Intercept San. Sewer from the east. Sta. 0+00.0 Line No. 2

NOTE:
Replace pavement and sidewalk.

Exist. 6" San. Sewer South to Art Museum building.

Plan Scale 1" = 20'
Profile Scale 1" = 20' Horiz.
1" = 5' Vert.

3+2.3
Sta. 3+20.0 = Sta. 14+67 in Force Main.
14+65

Sta. 3+20.0 = Sta. 14+67 in force main.

CAUTION:
K. G. & E. Underground conduit.

Basement floor Proposed Art Museum Elev. 103.60

MID-AMERICA ALI. INDIAN CENTER
SANITARY SEWER
PROJECT NO. WMKB 525 430 5/6

