



PLAN

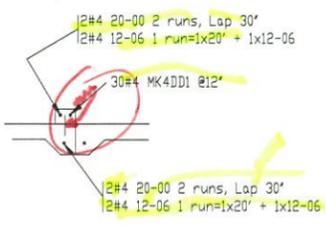


SECTION 'A'

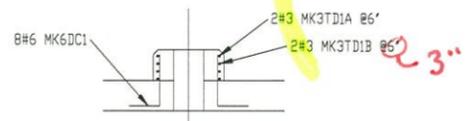

SECTION 'B'

(3 THUS)

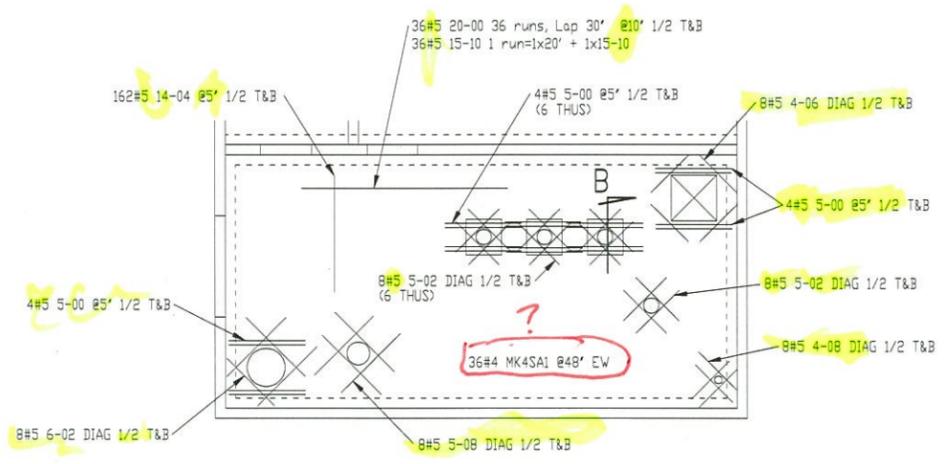

12" SLAB PLAN


MKEC ENGINEERING, INC.
 411 N. WEBB ROAD • WICHITA, KS 67206

Reviewed Revise and Resubmit
 Reviewed as Noted Rejected
 Not Required by the Contract Documents

Reviewed for conformance with the design concept of the Project and compliance with the information given in the Contract Documents. Contractor is responsible for dimensions to be confirmed and correlated at the job site; for information that pertains solely to the fabrication process or to techniques of construction; and for coordination of the work of all trades.

BY AA/TC DATE 4/21-2016

SIZE	LENGTH	MARK	TYPE	A	B	C	D	E	F/R	G	J	D	H	K
#5	4-06	5DA1	17	1-00	3-06									
#5	5-02	5DB1	17	1-00	4-03									
#5	2-06	5DC1	17	1-00	1-06									
#5	5-00	5CA1	17	2-06	2-06									
#5	6-00	5CB1	17	3-00	3-00									
#5	4-00	5CC1	17	1-00	3-00									
#4	5-00	4CA1	17	2-06	2-06									
#4	4-02	4CB1	17	1-08	2-06									
#4	4-00	4DA1	17	1-00	2-00	1-00								
#4	5-00	4DB1	17	1-00	4-00									
#4	10-04	4DC1	S4	2-00	1-10	2-08	1-10			2-00				
#4	1-04	4DD1	17	0-08	0-08									
#4	5-01	4SA1	25	1-06	0-08	0-08	0-08	1-06				0-07	0-10	
#3	4-08	3TA1	T1	0-04	1-00	1-00	1-00	1-00		0-04				
#3	7-04	3TB1	T1	0-04	1-08	1-08	1-08	1-08		0-04				
#3	5-07	3TC1	T4	0-04	1-02?	1-02?	1-02?	1-02?		0-04		1-08	1-08	
#3	8-08	3TD1	T1	0-04	2-00	2-00	2-00	2-00		0-04				
#3	6-07	3TE1	T4	0-04	1-05?	1-05?	1-05?	1-05?		0-04		2-00	2-00	

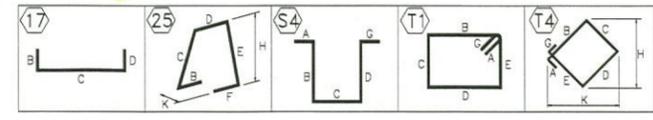

REBAR PLACEMENT DRAWINGS
 * REBAR PLACING DRAWINGS ARE INTENDED TO SUPPLEMENT THE CONTRACT DOCUMENTS. THEY MUST BE INTERPRETED IN CONJUNCTION WITH THEM. CONTRACTOR SHALL BE RESPONSIBLE FOR THE QUALITY AND THE ADEQUACY OF THE REBAR PLACEMENT FOR INSUFFICIENT OR MISSING INFORMATION PROVIDED IN THESE DOCUMENTS/DETAILS.

DO NOT SCALE

3702 W. DORA
 WICHITA, KS. 67213
 PH: (316) 267-9812

COLLEMAN'S MATERIALS

JOB NAME: RE-USE WATER PUMP STATION
 JOB LOCATION: WICHITA, KS
 ENGINEER: MKEC
 CONTRACTOR: WILDCAT CONSTRUCTION

PLAN SET DATE: 4/18/16
 REVISIONS:
 PROJECT # 2725
 DATE: 6/01/16
 DETAILER: CDD
 SHEET # R1

COLEMAN MATERIALS INC.
 3702 W. Dora
 Wichita, KS 67213
 Ph. (316) 267-9812
 Fax (316) 267-9813

Contractor: WILDCAT CONSTRUCTION
 Project: COW REUSE WATER PUMP
 Location:
 Material For: FOUNDATION
 Material: BLACK, GRADE 60

Order No.: 2725
 Bar List No.: 2725-2
 Bar List Date: 06/02/16
 Job No.: 2725
 Drawing No.:
 Sheet No.: 1 of 2

QTY	SIZE	LENGTH	MARK	TYP	A	B	C	D	E	F/R	G	J	O	H	K	
20	#6	4-06	6DA1	17		1-00	3-06									
296	#6	5-03	6DB1	17		1-00	4-03									
24	#6	2-06	6DC1	17		1-00	1-06									
8	#5	5-00	5CA1	17		2-06	2-06									
84	#5	6-00	5CB1	17		3-00	3-00									
152	#5	4-00	5CC1	17		1-00	3-00									
2	#4	5-00	4CA1	17		2-06	2-06									
2	#4	4-02	4CB1	17		1-08	2-06									
48	#4	4-00	4DA1	17		1-00	2-00	1-00								
124	#4	5-00	4DB1	17		1-00	4-00									
8	#4	10-04	4DC1	S4	2-00	1-10	2-08	1-10			2-00					
30	#4	1-04	4DD1	17		0-08	0-08									
72	#4	5-01	4SA1	25		1-06	0-08½	0-08	0-08½	1-06				0-07	0-10	
55	#3	4-08	3TA1	T1	0-04	1-00	1-00	1-00	1-00		0-04					
102	#3	7-04	3TB1A	T1	0-04	1-08	1-08	1-08	1-08		0-04					
102	#3	5-07	3TB1B	T4	0-04	1-02¾	1-02¾	1-02¾	1-02¾		0-04			1-08	1-08	
6	#3	8-08	3TD1A	T1	0-04	2-00	2-00	2-00	2-00		0-04					
6	#3	6-07	3TD1B	T4	0-04	1-05¾	1-05¾	1-05¾	1-05¾		0-04			2-00	2-00	

COLEMAN MATERIALS INC.
 3702 W. Dora
 Wichita, KS 67213
 Ph. (316) 267-9812
 Fax (316) 267-9813

Contractor: WILDCAT CONSTRUCTION
 Project: COW REUSE WATER PUMP
 Location:
 Material For: FOUNDATION
 Material: BLACK, GRADE 60

Order No.: 2725
 Bar List No.: 2725-2
 Bar List Date: 06/02/16
 Job No.: 2725
 Drawing No.:
 Sheet No.: 2 of 2

QTY	SIZE	LENGTH	MARK	
44	#6	20-00		
44	#6	19-06		
90	#6	17-06		
124	#6	15-04		
176	#6	13-10		
24	#6	5-00		
128	#5	20-00		
84	#5	17-06		
36	#5	15-10		
84	#5	15-08		
162	#5	14-04		


QTY	SIZE	LENGTH	MARK	
8	#5	12-06		
8	#5	6-02		
8	#5	5-08		
32	#5	5-02		
40	#5	5-00		
8	#5	4-08		
8	#5	4-06		
40	#5	3-00		
75	#4	20-00		
1	#4	16-08		
4	#4	15-08		

QTY	SIZE	LENGTH	MARK	
2	#4	13-08		
31	#4	12-06		
14	#4	11-10		
3	#4	10-08		
2	#4	7-04		
44	#4	6-09		
44	#4	6-01		
196	#4	4-06		
72	#4	3-00		
2	#4	1-04		


APPROVED BY: _____ DATE: _____ Report Printed Thursday, Jun 2 2016 12:32 PM

Bend Types in Release 2725-2, FOUNDATION PRODUCTION BARLIST BEND TYPES


Type 17

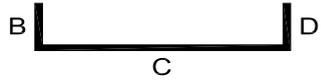


Type S4

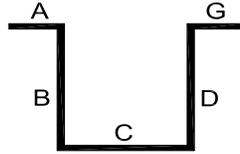


Type 25

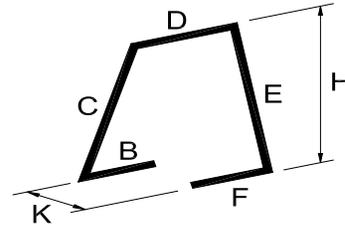

Type T1

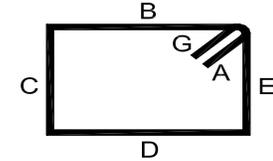

Type T4

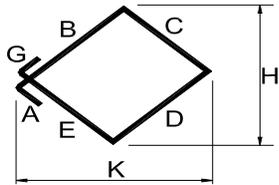

CUSTOMER: Wildcat Construction
JOB: COW Reuse Water Pump
LOCATION:
CITY:
PO/JOB NO:
TEL NO.

SHIP:
JOB NO: **2725-2**
DR: CDD DATE: 06-02-2016
REVISED:
REF. SH: