

City of Wichita

CHENEY TRANSMISSION LINE IMPROVEMENTS

Wichita, Kansas

GARY JANZEN, P.E. , CITY ENGINEER

Project No. 448-90768

OCA 636272



**CONFORMING TO
CONSTRUCTION
RECORDS**

FEBRUARY 2019

BMCD PROJECT No. 97687



Know what's below.
Call 811 before you dig.


no.	date	by	ckd	description
0	11/8/17	CAM	LJK	ISSUED FOR BID
	2/5/19	CAM	LJK	CONFORMING TO CONSTRUCTION RECORDS



9400 WARD PARKWAY
KANSAS CITY, MO 64114
816-333-9400
LICENSEE NO. 000165

CITY OF WICHITA

Conforming to Construction Records Drawings

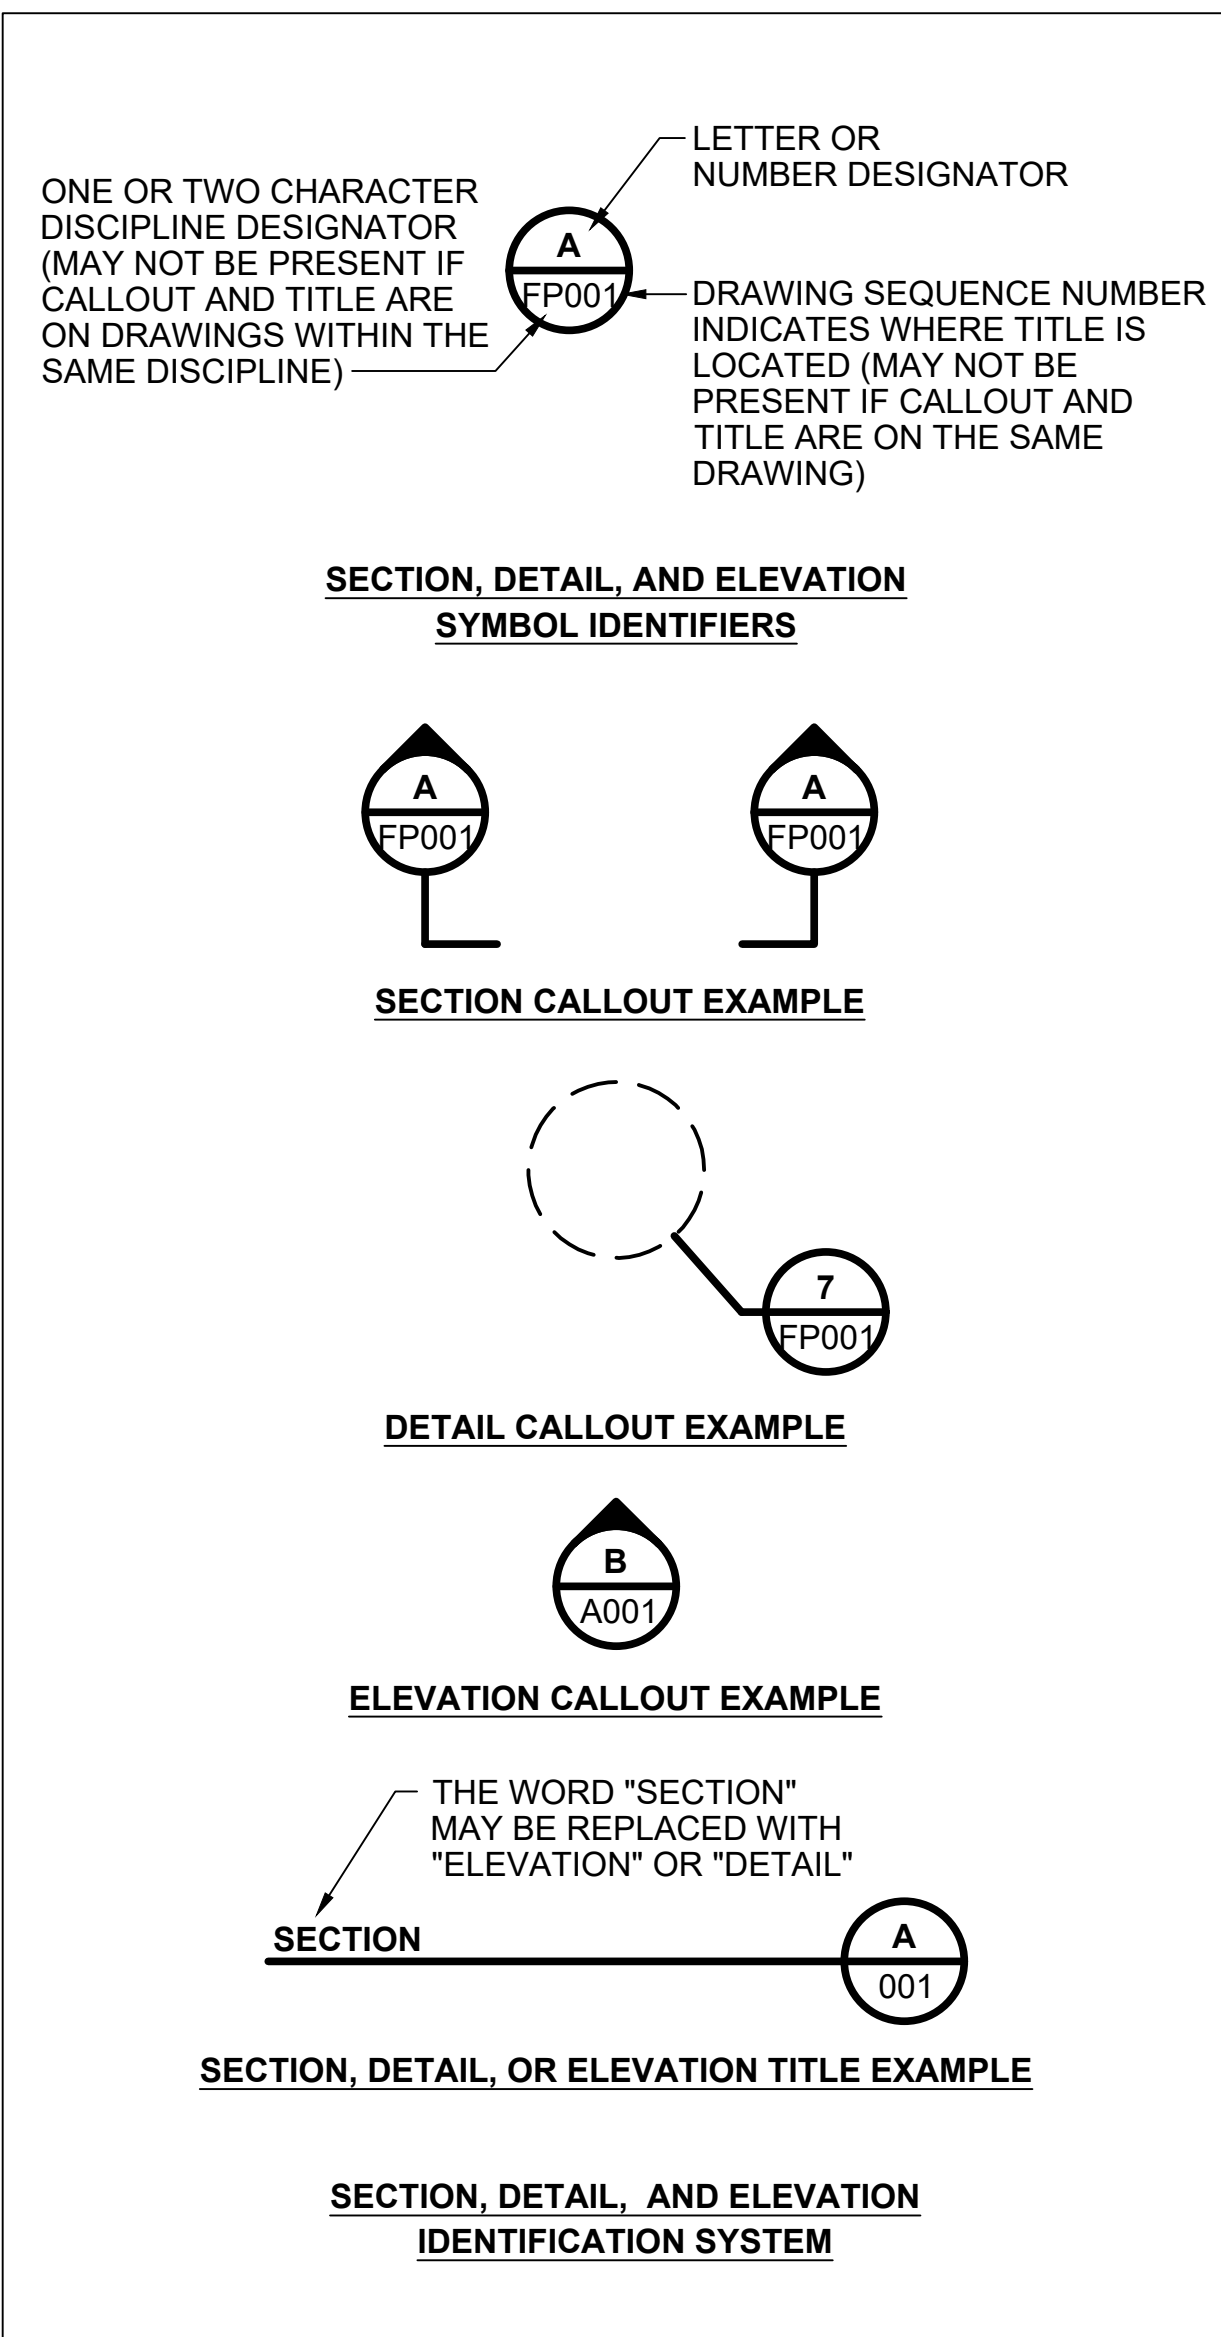

GENERAL DRAWINGS

DWG. NO.	TITLE
G001	COVER SHEET
G002	INDEX SHEET
G003	TRANSMISSION MAIN PLAN

CIVIL DRAWINGS

DWG. NO.	TITLE
C001	GENERAL CIVIL

ARCHITECTURAL DRAWINGS

DWG. NO.	TITLE
A001	FLOOR PLAN
A002	SECTION AND DETAILS

STRUCTURAL DRAWINGS

DWG. NO.	TITLE
S001	VAULT TOP SLAB MODIFICATIONS

PROCESS DRAWINGS

DWG. NO.	TITLE
D001	EXISTING CONDITIONS
D002	INTERIOR MODIFICATIONS
D003	DRAIN VAULT MODIFICATIONS

BID ALTERNATES

PROCESS DRAWINGS

DWG. NO.	TITLE
BA-D001	VAULT REPLACEMENT INTERIOR MODIFICATIONS

STRUCTURAL DRAWINGS

DWG. NO.	TITLE
BA-S001	LEGEND AND ABBREVIATIONS
BA-S002	VAULT REPLACEMENT PLANS, SECTIONS, AND DETAILS

REFERENCE DRAWINGS

DUDLEY WILLIAMS AND ASSOCIATES, PA

DWG. NO.	TITLE
RS1	VAULTS 14, 19, AND 21 REPLACEMENT
RS2	VAULTS 14, 19, AND 21 REPLACEMENT

GENERAL NOTES

- ALL WORK SHALL BE COORDINATED WITH OWNER A MINIMUM OF FIVE (5) DAYS PRIOR TO WORK.
- CONTRACTOR SHALL SUBMIT A DETAILED WORK PLAN FOR REVIEW BY OWNER AND ENGINEER A MINIMUM OF FIVE (5) DAYS PRIOR TO WORK.
- WORK SHALL BE LIMITED TO 12-HOUR INCREMENTS, LIMITED TO THE HOURS OF 9:00 AM THROUGH 9:00 PM.
- IF PERFORMED BETWEEN THE DATES OF DECEMBER 15TH THROUGH FEBRUARY 15TH, VAULTS SHALL BE INSULATED PRIOR TO INSTALLING NEW VALVES AND PIPING.
- THE CONTRACTOR SHALL HAVE ONE (1) SEALED COPY OF THE PLANS INCLUDING ANY ADDENDA RFI, AND CHANGE ORDER REVISIONS AT THE JOB SITE AT ALL TIMES.
- CONTRACTOR SHALL BE RESPONSIBLE FOR PAYING ALL FEES AND FOR OTHERWISE COMPLYING WITH ALL APPLICABLE REGULATIONS GOVERNING THE WORK.
- CONTRACTOR SHALL KEEP ALL CONSTRUCTION MATERIALS, EQUIPMENT AND TRAILERS WITHIN THE EASEMENT OF EACH PROPERTY. CONTRACTOR SHALL HAVE VAULT LOCATIONS SURVEYED TO DETERMINE THE LOCATION OF EXISTING EASEMENTS.
- THE CONTRACTOR SHALL BE SOLELY RESPONSIBLE FOR THE SAFETY OF THE CONSTRUCTION WORKERS, THE PUBLIC, AND OWNER PERSONNEL WORKING IN VICINITY OF CONSTRUCTION.
- CONSTRUCTION SHALL COMPLY WITH ALL APPLICABLE CODES PER THE GOVERNING MUNICIPALITY.
- CONTRACTOR SHALL PROVIDE 3-DAYS NOTICE TO LANDOWNERS PRIOR TO WORK, PER CITY OF WICHITA SPECIFICATIONS.

COPYRIGHT © 2017 BURNS & MCDONNELL ENGINEERING COMPANY, INC.

no.	date	by	ckd	description	no.	date	by	ckd	description
0	11/8/17	CAM	LJK	ISSUED FOR BID	2	2/5/19	CAM	LJK	CONFORMING TO CONSTRUCTION RECORDS
1	5/25/18	BDF	CAM	REVISER PER ECN 001					
2	1/30/19	BDF	CAM	DRAWING ADDED					





9400 WARD PARKWAY
KANSAS CITY, MO 64114
816-333-9400
LICENSEE NO. 000165

**CHENEY TRANSMISSION LINE
EVALUATION & IMPROVEMENTS**
Project No. 448-90768
BMCD PROJECT No. 97687

Index

VAULT COORDINATES		
VAULT	LATITUDE	LONGITUDE
1	37.7198	-97.7886
2	37.7199	-97.7834
DRAIN 1	37.7200	-97.7768
3	37.7204	-97.7617
3A	37.7204	-97.7514
4	37.7205	-97.7435
DRAIN 2	37.7205	-97.7363
5	37.7206	-97.7336
6	37.7206	-97.7209
7	37.7207	-97.7147
8	37.7207	-97.7102
DRAIN 3	37.7207	-97.7095
9	37.7207	-97.7011
10	37.7210	-97.6945
11	37.7213	-97.6856
12	37.7213	-97.6794
DRAIN 4	37.7213	-97.6769
13	37.7213	-97.6737
14*	37.7215	-97.6392
15	37.7215	-97.6253
DRAIN 5	37.7216	-97.5997
16	37.7217	-97.5980
17	37.7217	-97.5931
DRAIN 6	37.7217	-97.5862
18	37.7218	-97.5834
19*	37.7218	-97.5777
20	37.7218	-97.5665
21*	37.7217	-97.5582
22	37.7216	-97.5537
23	37.7218	-97.5331
24	37.7221	-97.5181
DRAIN 7	37.7221	-97.5118
25	37.7221	-97.5113
26	37.7222	-97.5046
27	37.7223	-97.4963
DRAIN 8	37.7224	-97.4920
28	37.7226	-97.4808
29	37.7228	-97.4697
30	37.7232	-97.4432
DRAIN 9	37.7162	-97.4024
DRAIN 10	37.7018	-97.3723
VAULT AT STA. 42.04	37.7018	-97.3723
DRAIN 11	37.7015	-97.3713

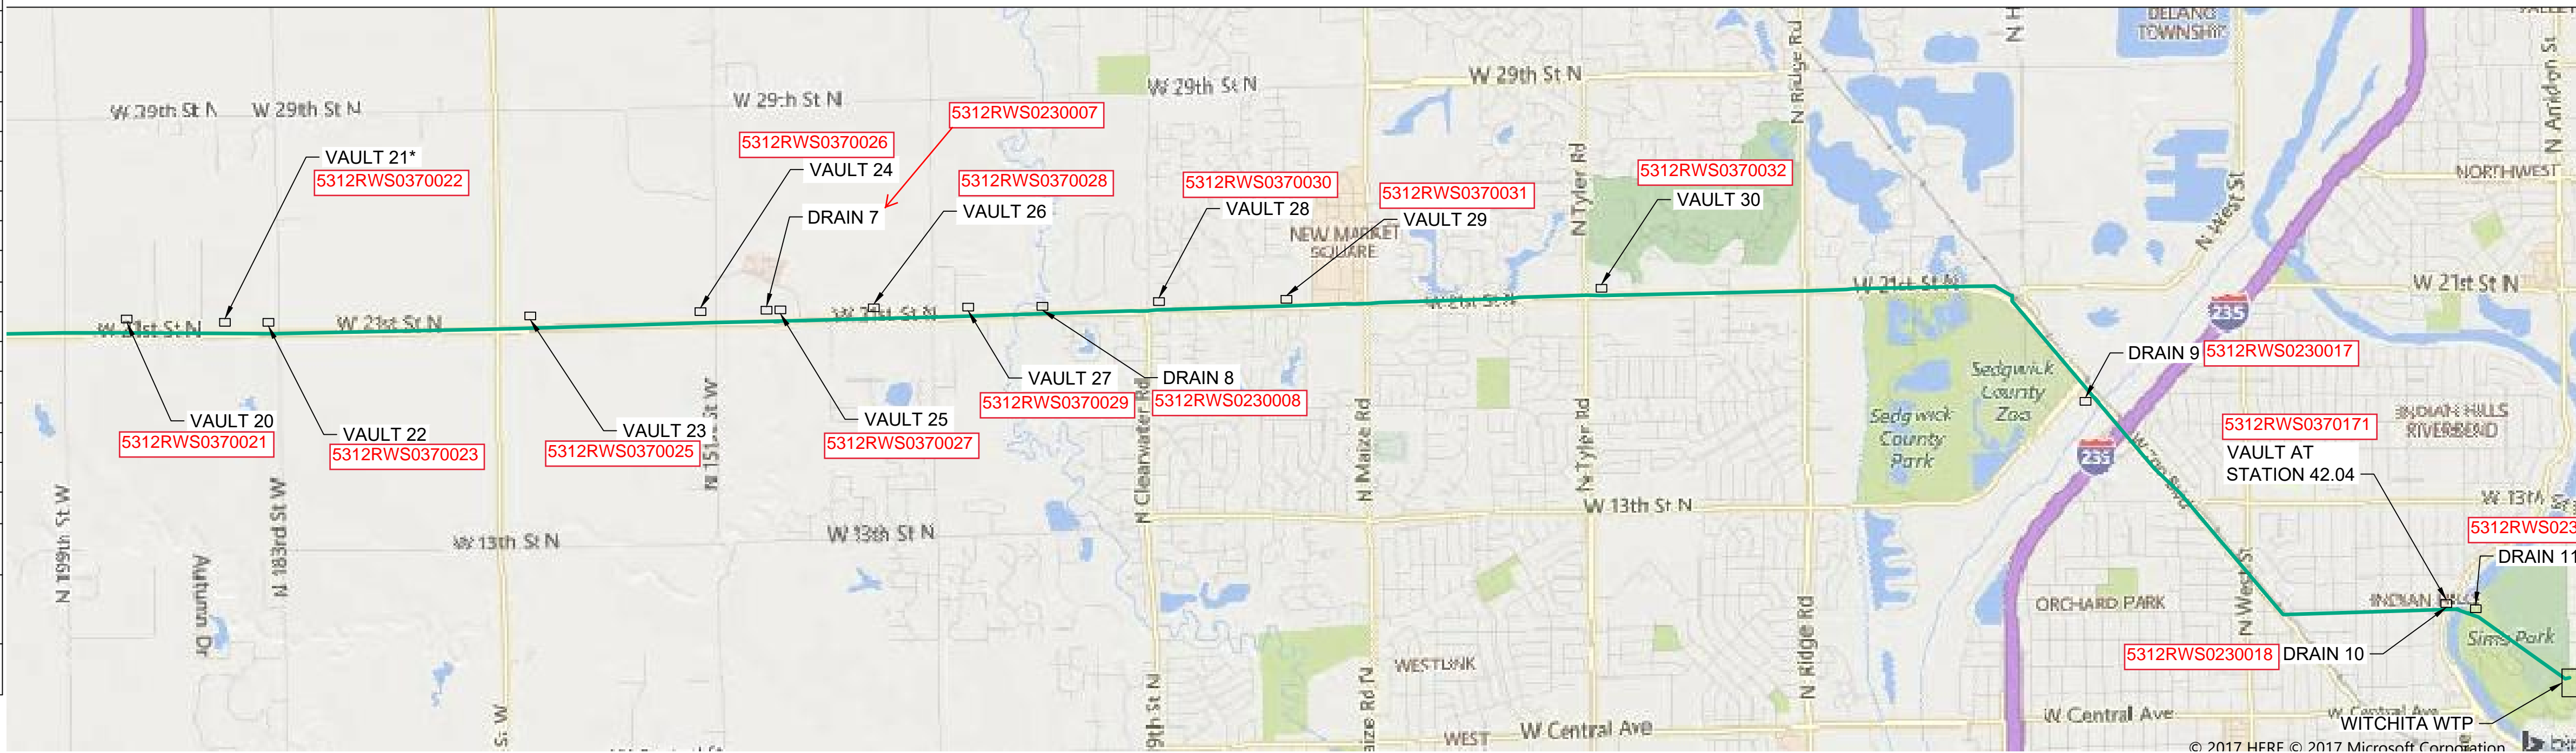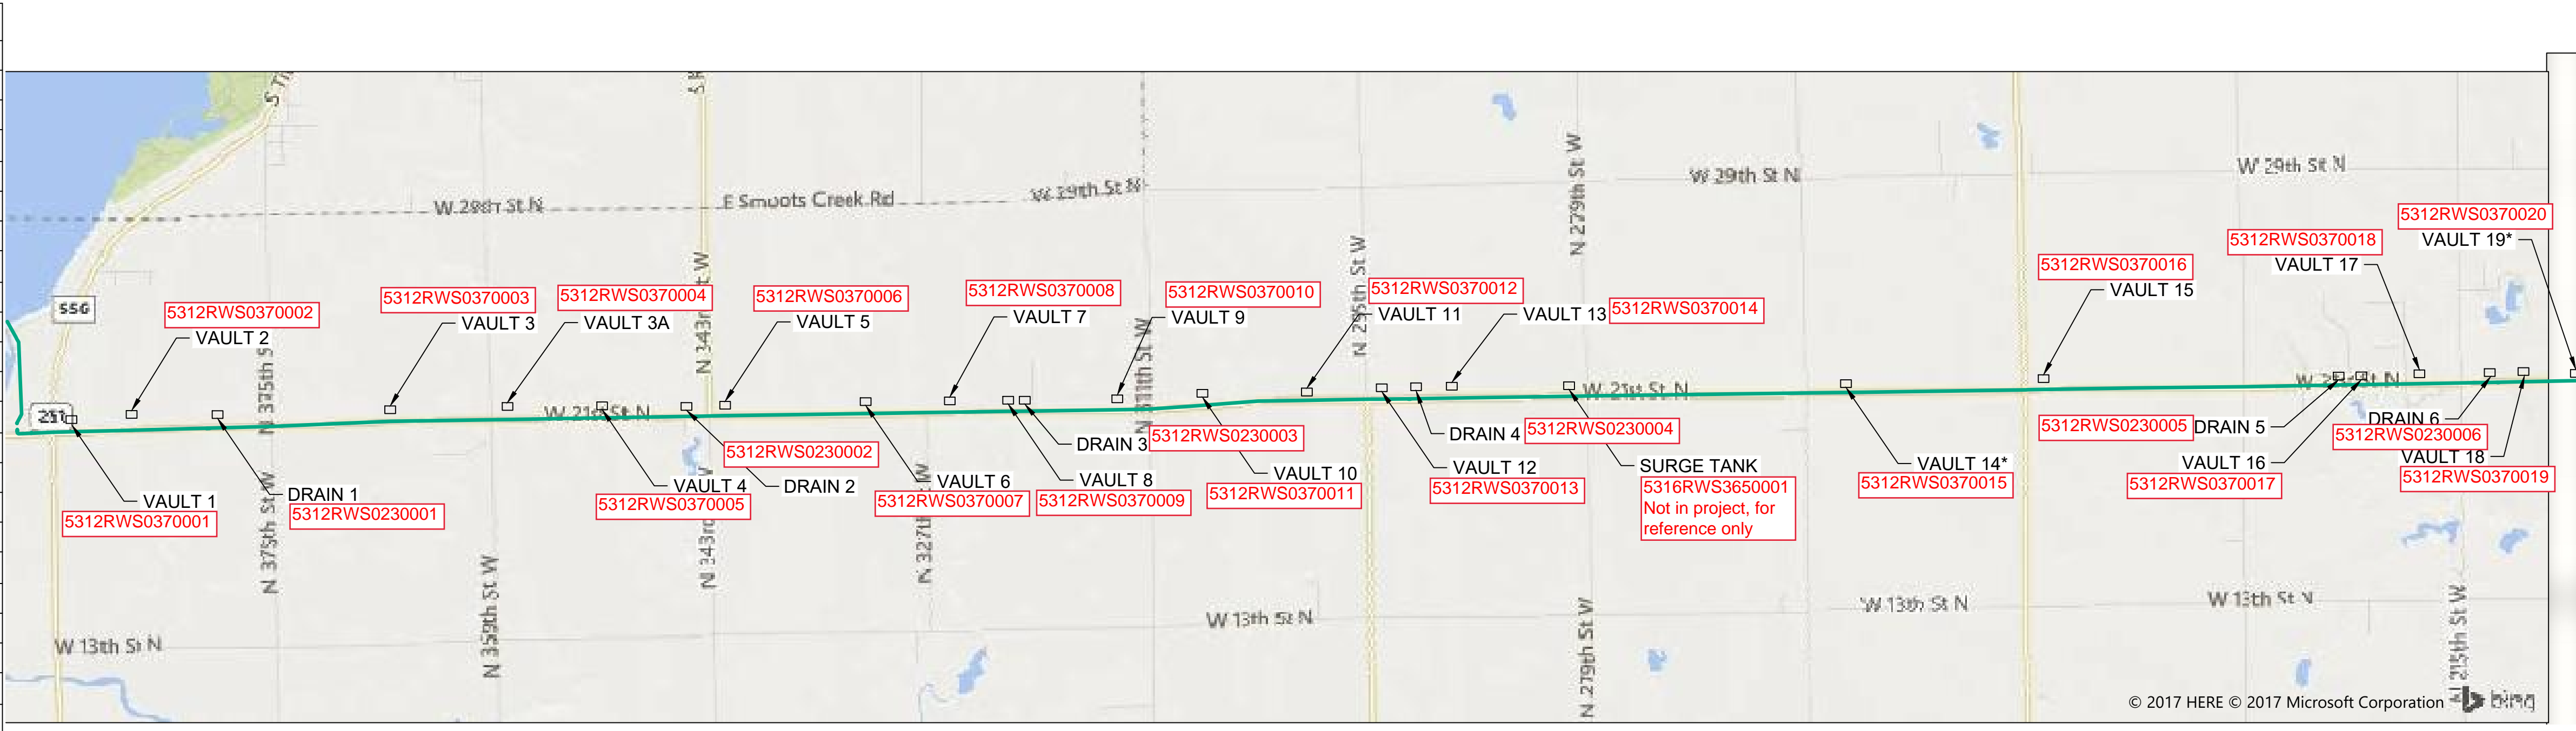

- NOTES:**
1. VAULT AND DRAIN LOCATIONS INDICATE LOCATIONS OF WORK.
 2. REFERENCE OTHER SHEETS FOR DETAILED WORK AT EACH LOCATION.
 3. ASTERISK DENOTES NEW VAULTS RECONSTRUCTED IN LOCATIONS SIMILAR TO ORIGINAL.

no.	date	by	ckd	description
0	11/8/17	CAM	LJK	ISSUED FOR BID
1	2/5/19	CAM	LJK	CONFORMING TO CONSTRUCTION RECORDS

BURNS MEDONNELL

9400 WARD PARKWAY
KANSAS CITY, MO 64114
816-333-9400
LICENSEE NO. E-65

date	designed	detailed
SEPTEMBER 11, 2017	C. MAGES	B. FIFIELD
checked		
L. KLEIN		

City of Wichita, Kansas


SEDGWICK, KANSAS

CHENEY TRANSMISSION LINE


TRANSMISSION MAIN PLAN

project	contract
97687	
drawing	rev.
G003	0
sheet	of sheets
file 97687_G003.DWG	

Scale For Microfitting
Millimeters
Inches

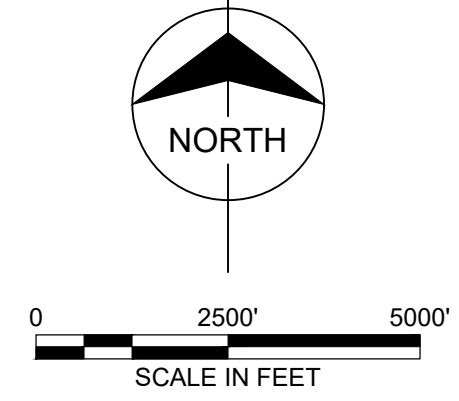



COPYRIGHT © 2017 BURNS & MEDONNELL ENGINEERING COMPANY, INC.

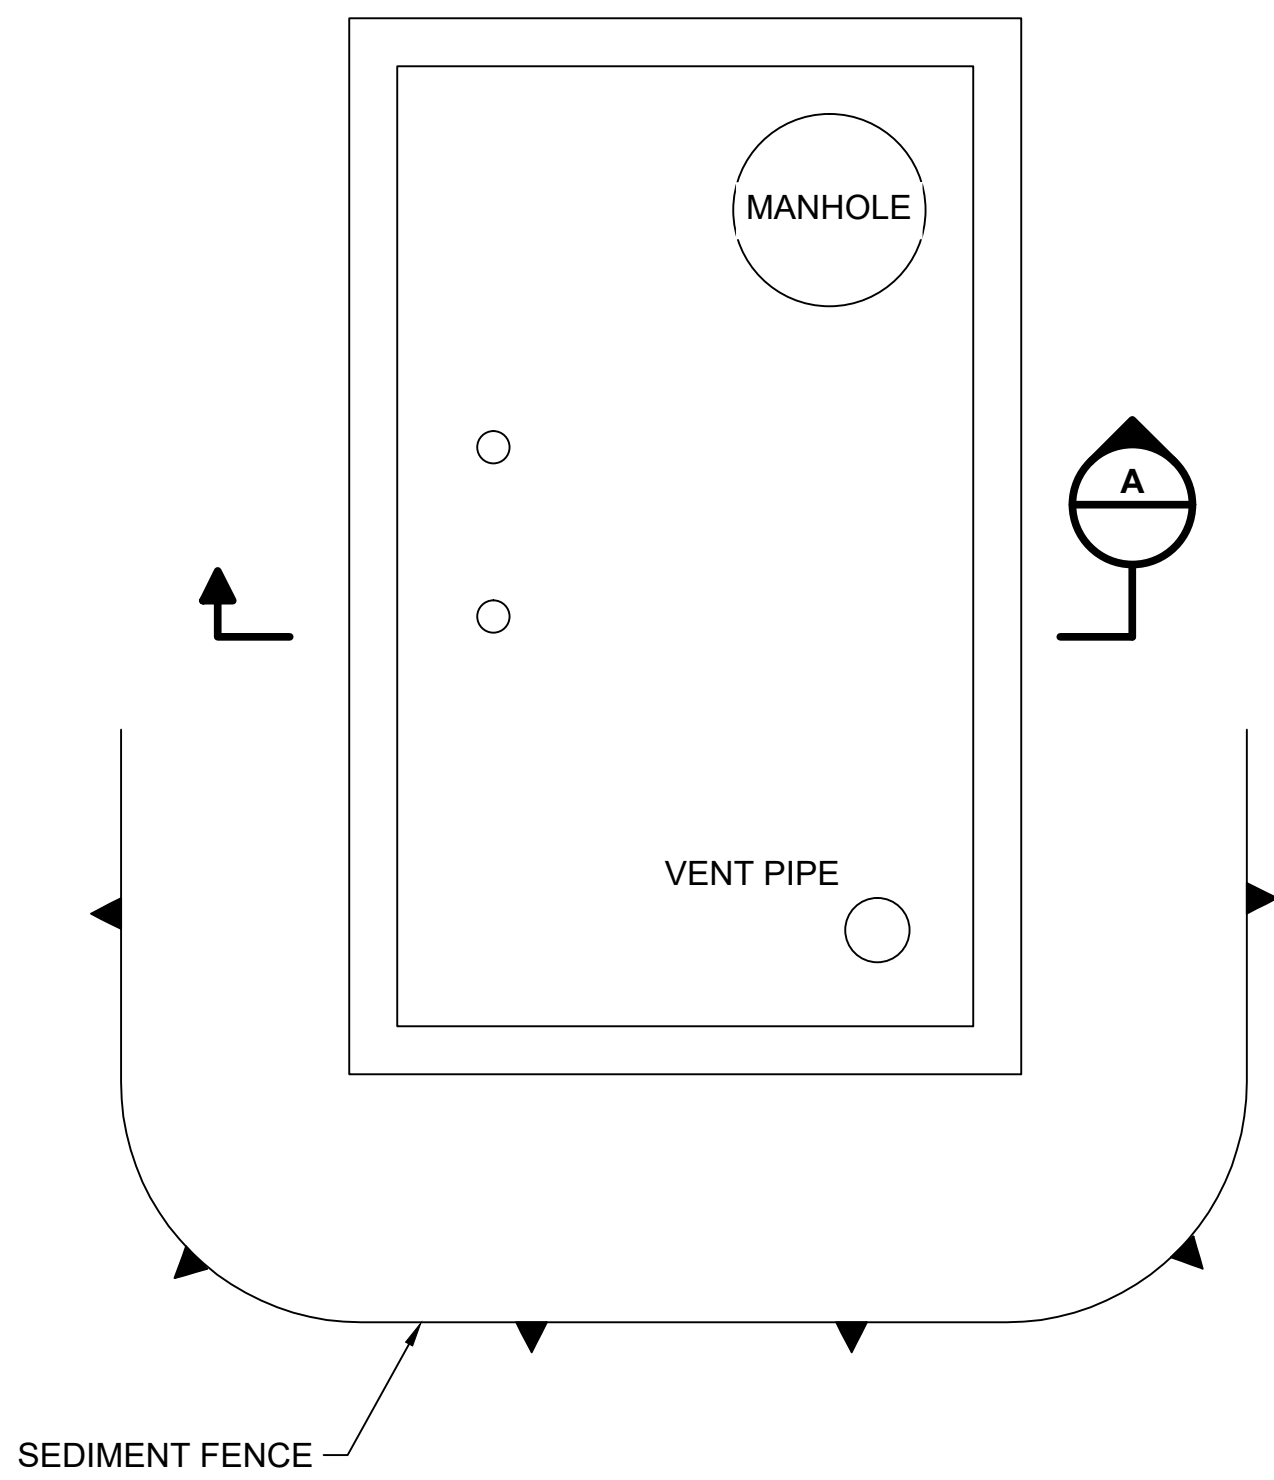

NOTE:

1. PROVIDE SEDIMENT FENCE IN DISTURBED AREAS WHERE NOT PROTECTED BY NATURAL VEGETATION.
2. EXISTING FENCING SHALL BE TAKEN DOWN AS NEEDED AND REESTABLISHED TO ORIGINAL CONDITION. PROVIDE TEMPORARY FENCING DURING CONSTRUCTION.
3. VAULTS WITHIN CITY LIMITS SHALL BE RESTORED TO ORIGINAL CONDITIONS AND SODDED. VAULTS OUTSIDE OF CITY LIMITS SHALL BE RESTORED TO ORIGINAL CONDITIONS AND SEEDED PER CITY OF WICHITA STANDARD SPECIFICATIONS.


VAULT COVER
NOT TO SCALE

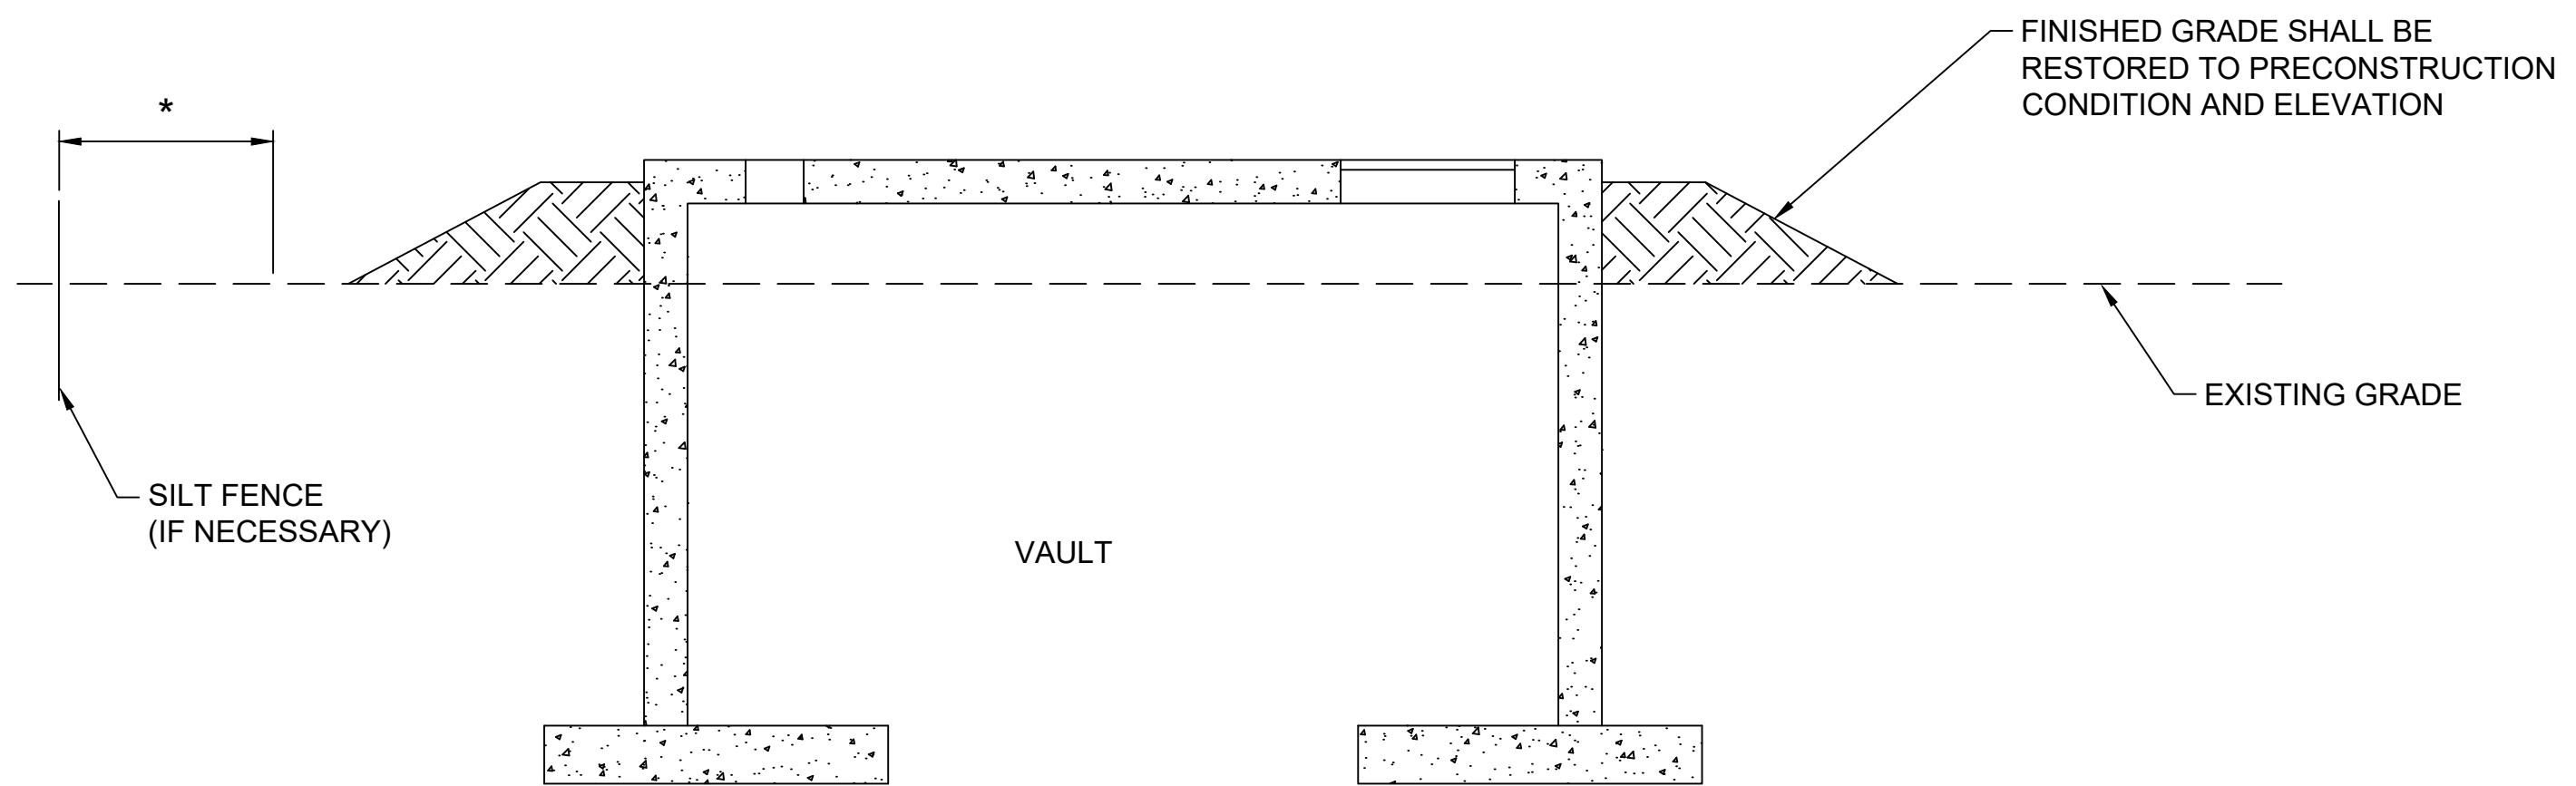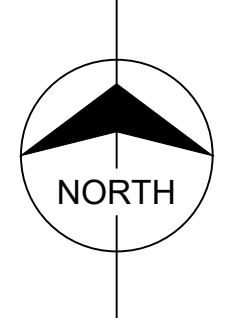

NOTE:

1. EXCAVATION AREA DEPTH WILL VARY BASED ON EXISTING GRADE, AND WHETHER THE VAULT IS EXISTING OR NEW (BID ALTERNATES 1, 2, AND 3). BACKFILL AND COMPACT TO 90% MODIFIED PROCTOR.
- * PLACE SEDIMENT FENCE DOWN-SLOPE OF CONSTRUCTION AND WITHIN THE EXISTING EASEMENT, BUT NO MORE THAN 10 FEET FROM THE LIMITS OF DISTURBANCE.


SECTION

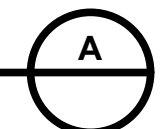


VAULT
NOT TO SCALE

SEDIMENT FENCE

1. EXCAVATE A 6"x4" TRENCH.
2. SET THE STAKES ALONG THE DOWN SLOPE SIDE OF THE TRENCH.
3. STAPLE GEOTEXTILE MATERIAL TO STAKES AND EXTEND IT INTO AND AROUND THE BOTTOM OF THE TRENCH.
4. BACKFILL AND COMPACT THE EXCAVATED SOIL OVER THE GEOTEXTILE IN THE TRENCH.

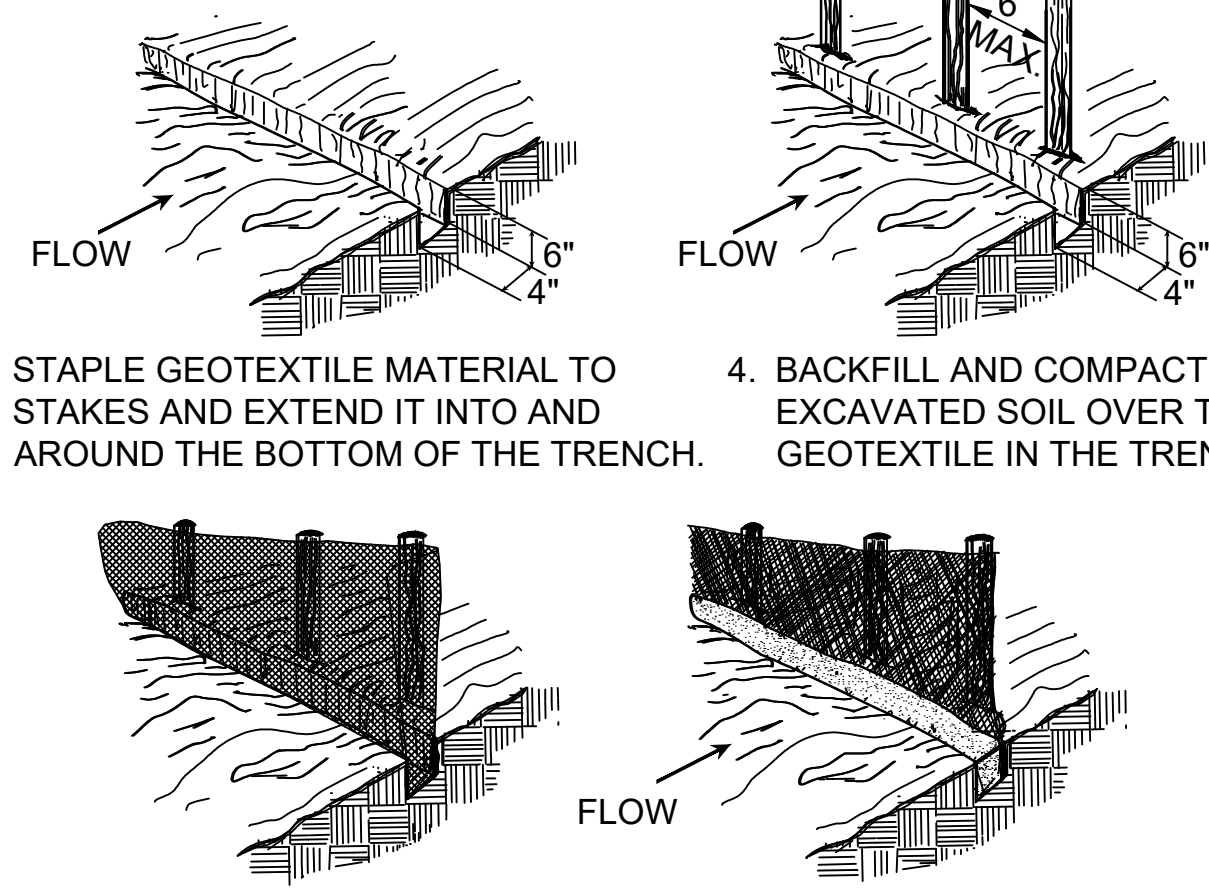

SHEET FLOW INSTALLATION (PERSPECTIVE VIEW)
NOT TO SCALE

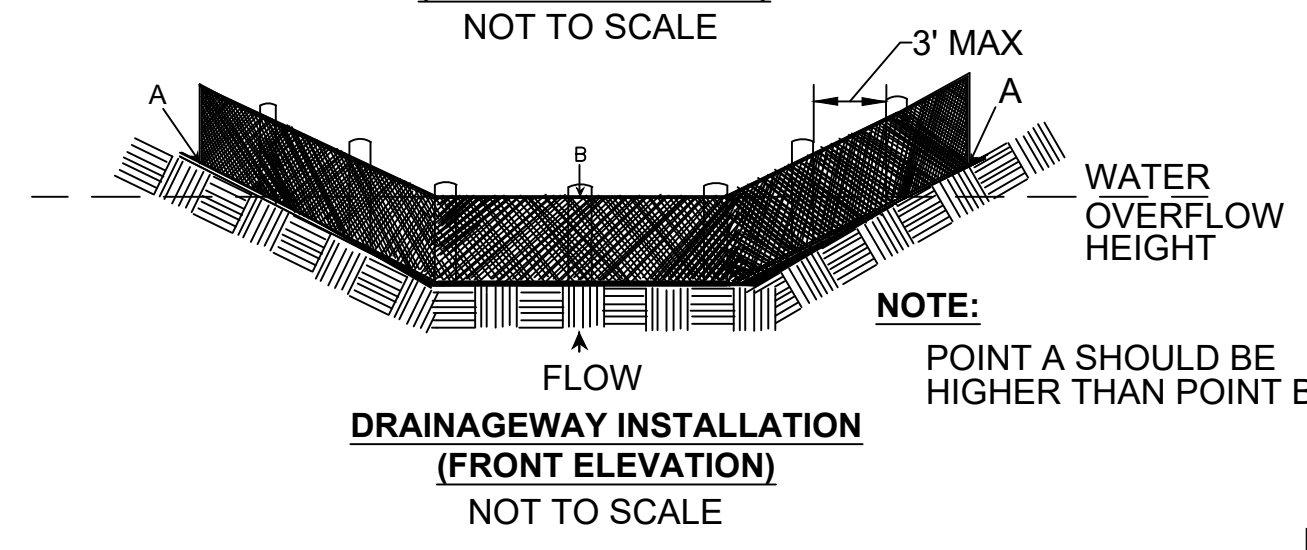

NOTE:

POINT A SHOULD BE HIGHER THAN POINT B.

DRAINAGEWAY INSTALLATION (FRONT ELEVATION)
NOT TO SCALE

SEDIMENT FENCE NOTES:

A) INSTALLATION:

1. THE HEIGHT OF SEDIMENT FENCE SHALL BE A MINIMUM OF 16 INCHES ABOVE THE ORIGINAL GROUND SURFACE AND SHALL NOT EXCEED 34 INCHES ABOVE THE GROUND SURFACE.
2. THE FABRIC SHALL BE PURCHASED IN A CONTINUOUS ROLL CUT TO THE LENGTH OF THE BARRIER TO AVOID THE USE OF JOINTS. WHEN JOINTS ARE UNAVOIDABLE, FILTER CLOTH SHALL BE SECURELY SPLICED TOGETHER ONLY AT SUPPORT POSTS, WITH A MAX 6-INCH OVERLAP.
3. DIG A TRENCH AT LEAST 6 INCHES DEEP AND 4 INCHES WIDE ALONG THE FENCE ALIGNMENT.
4. DRIVE POSTS AT LEAST 24 INCHES INTO THE GROUND ON THE DOWNSLOPE SIDE OF THE TRENCH. SPACE POSTS A MAXIMUM OF 6 FEET APART.
5. EXTRA-STRENGTH SEDIMENT FENCE FABRIC SHALL BE USED. POSTS FOR THIS TYPE OF FABRIC SHALL BE PLACED A MAXIMUM OF 6 FEET APART. THE SEDIMENT FABRIC SHALL BE FASTENED SECURELY TO THE UPSLOPE SIDE OF THE POSTS USING A MINIMUM OF ONE INCH LONG, HEAVY-DUTY WIRE STAPLES OR TIE-WIRES, AND EIGHT INCHES OF THE FABRIC SHALL BE EXTENDED INTO THE TRENCH. THE FABRIC SHALL NOT BE STAPLED TO EXISTING TREES.
6. PLACE THE BOTTOM 1 FOOT OF FABRIC IN THE MINIMUM-OF-6-INCH DEEP TRENCH, LAPPING TOWARD THE UPSLOPE SIDE. BACKFILL WITH COMPACTED EARTH OR GRAVEL.
7. IF A SEDIMENT FENCE IS TO BE CONSTRUCTED ACROSS A DITCH LINE OR SWALE, IT MUST BE OF SUFFICIENT LENGTH TO ELIMINATE ENDFLOW, AND THE PLAN CONFIGURATION SHALL RESEMBLE AN ARC OR HORSESHOE WITH THE ENDS ORIENTED UPSLOPE. EXTRA-STRENGTH SEDIMENT FABRIC SHALL BE USED WITH A MAXIMUM 3-FOOT SPACING OF POSTS.
8. TO REDUCE MAINTENANCE, EXCAVATE A SHALLOW SEDIMENT STORAGE AREA IN THE UPSLOPE SIDE OF THE FENCE. PROVIDE GOOD ACCESS IN AREAS OF HEAVY SEDIMENTATION FOR CLEAN OUT AND MAINTENANCE.
9. SEDEMENT FENCES SHALL BE REMOVED WHEN THEY HAVE SERVED THEIR USEFUL PURPOSE, BUT NOT BEFORE THE UPSLOPE AREA HAS BEEN PERMANENTLY STABILIZED.

B) TROUBLESHOOTING:

1. DETERMINE THE EXACT LOCATION OF UNDERGROUND UTILITIES, BEFORE FENCE INSTALLATION SO UTILITIES ARE NOT DISTURBED.
2. GRADE ALIGNMENT OF FENCE AS NEEDED TO PROVIDE A BROAD, NEARLY LEVEL AREA UPSTREAM OF FENCE TO ALLOW SEDIMENT COLLECTION AREA.

C) INSPECTION MAINTENANCE:

1. INSPECT SEDIMENT FENCES AT LEAST ONCE A WEEK AND AFTER EACH RAINFALL. MAKE ANY REQUIRED REPAIRS IMMEDIATELY.
2. SHOULD THE FABRIC OF A SEDIMENT FENCE COLLAPSE, TEAR, DECOMPOSE, OR BECOME INEFFECTIVE, REPLACE IT PROMPTLY.
3. REMOVE SEDIMENT DEPOSITS AS NECESSARY TO PROVIDE ADEQUATE STORAGE VOLUME FOR THE NEXT RAIN AND TO REDUCE PRESSURE ON THE FENCE. AVOID DAMAGING OR UNDERMINING THE FENCE DURING CLEANOUT. SEDIMENT ACCUMULATION SHOULD NOT EXCEED 1/2 THE HEIGHT OF THE FENCE.
4. REMOVE ALL FENCING MATERIALS AND UNSTABLE SEDIMENT DEPOSITS, AND BRING THE AREA TO GRADE AND STABILIZE IT AFTER THE CONTRIBUTING DRAINAGE AREA HAS BEEN PROPERLY AND COMPLETELY STABILIZED.

no.	date	by	ckd	description
0	11/8/17	CAM	LJS	ISSUED FOR BID
	2/5/19	CAM	LJK	CONFORMING TO CONSTRUCTION RECORDS



9400 WARD PARKWAY
KANSAS CITY, MO 64114
816-333-9400
LICENSEE NO. E-65

date	SEPTEMBER 11, 2017	detailed	B. FIFIELD
designed	C. MAGES	checked	L. STAAB



SEDGWICK, KANSAS

CHENEY TRANSMISSION LINE

GENERAL CIVIL

project	97687	contract	CONTRACT
drawing	C001	rev.	0
sheet	of	sheets	
file 97687_C001.DWG			

Scale For Microfinishing

Inches

COPYRIGHT © 2012 BURNS & MCDONNELL ENGINEERING COMPANY, INC.

no.	date	by	ckd	description
0	11/8/17	RPL	JT	ISSUED FOR BID
1	2/5/19	RPL	JT	CONFORMING TO CONSTRUCTION RECORDS

BURNS & MCDONNELL

PROTECTIVE COATING SYSTEM

System: **E-1**

SERVICE: Steel & Iron – Nonpotable Liquid Immersion, Normal to Severe Exposure. Interior of Tank or Basin. Exterior of Steel, Piping, or Equipment in Tank or Basin.

Surface Preparation: Shop or Field First Coat: SSPC-SP10 and profile depth of 1.5 to 2.5 mils (38 to 63 microns). Field Touch-Up (of Shop-applied first coat): Same as for First Coat.


First Coat: High solids amine, polyamidoamine, or polyamide epoxy coating with minimum 67% solids by volume. Apply at 5.0 to 7.0 mils (125 to 175 microns) dry film thickness.

Second Coat: Same as first coat.



System Total: Minimum 10.0 mils (250 microns) dry film thickness. Check for voids with holiday or pinhole detector.

Volatile Organic Content: Maximum 2.8 lb/gal (340 g/L).

COATING MANUFACTURER	PRODUCT DESIGNATION		
	FIRST COAT	TOUCH UP	SECOND COAT
PPG	Amerlock 2 or 400	Same as first coat	Same as first coat
Sherwin-Williams	Macropoxy 646 FC B58W610/B58V600	Same as first coat	Same as first coat
Tnemec	Epoxoline II Series 96 HS	Same as first coat	Same as first coat

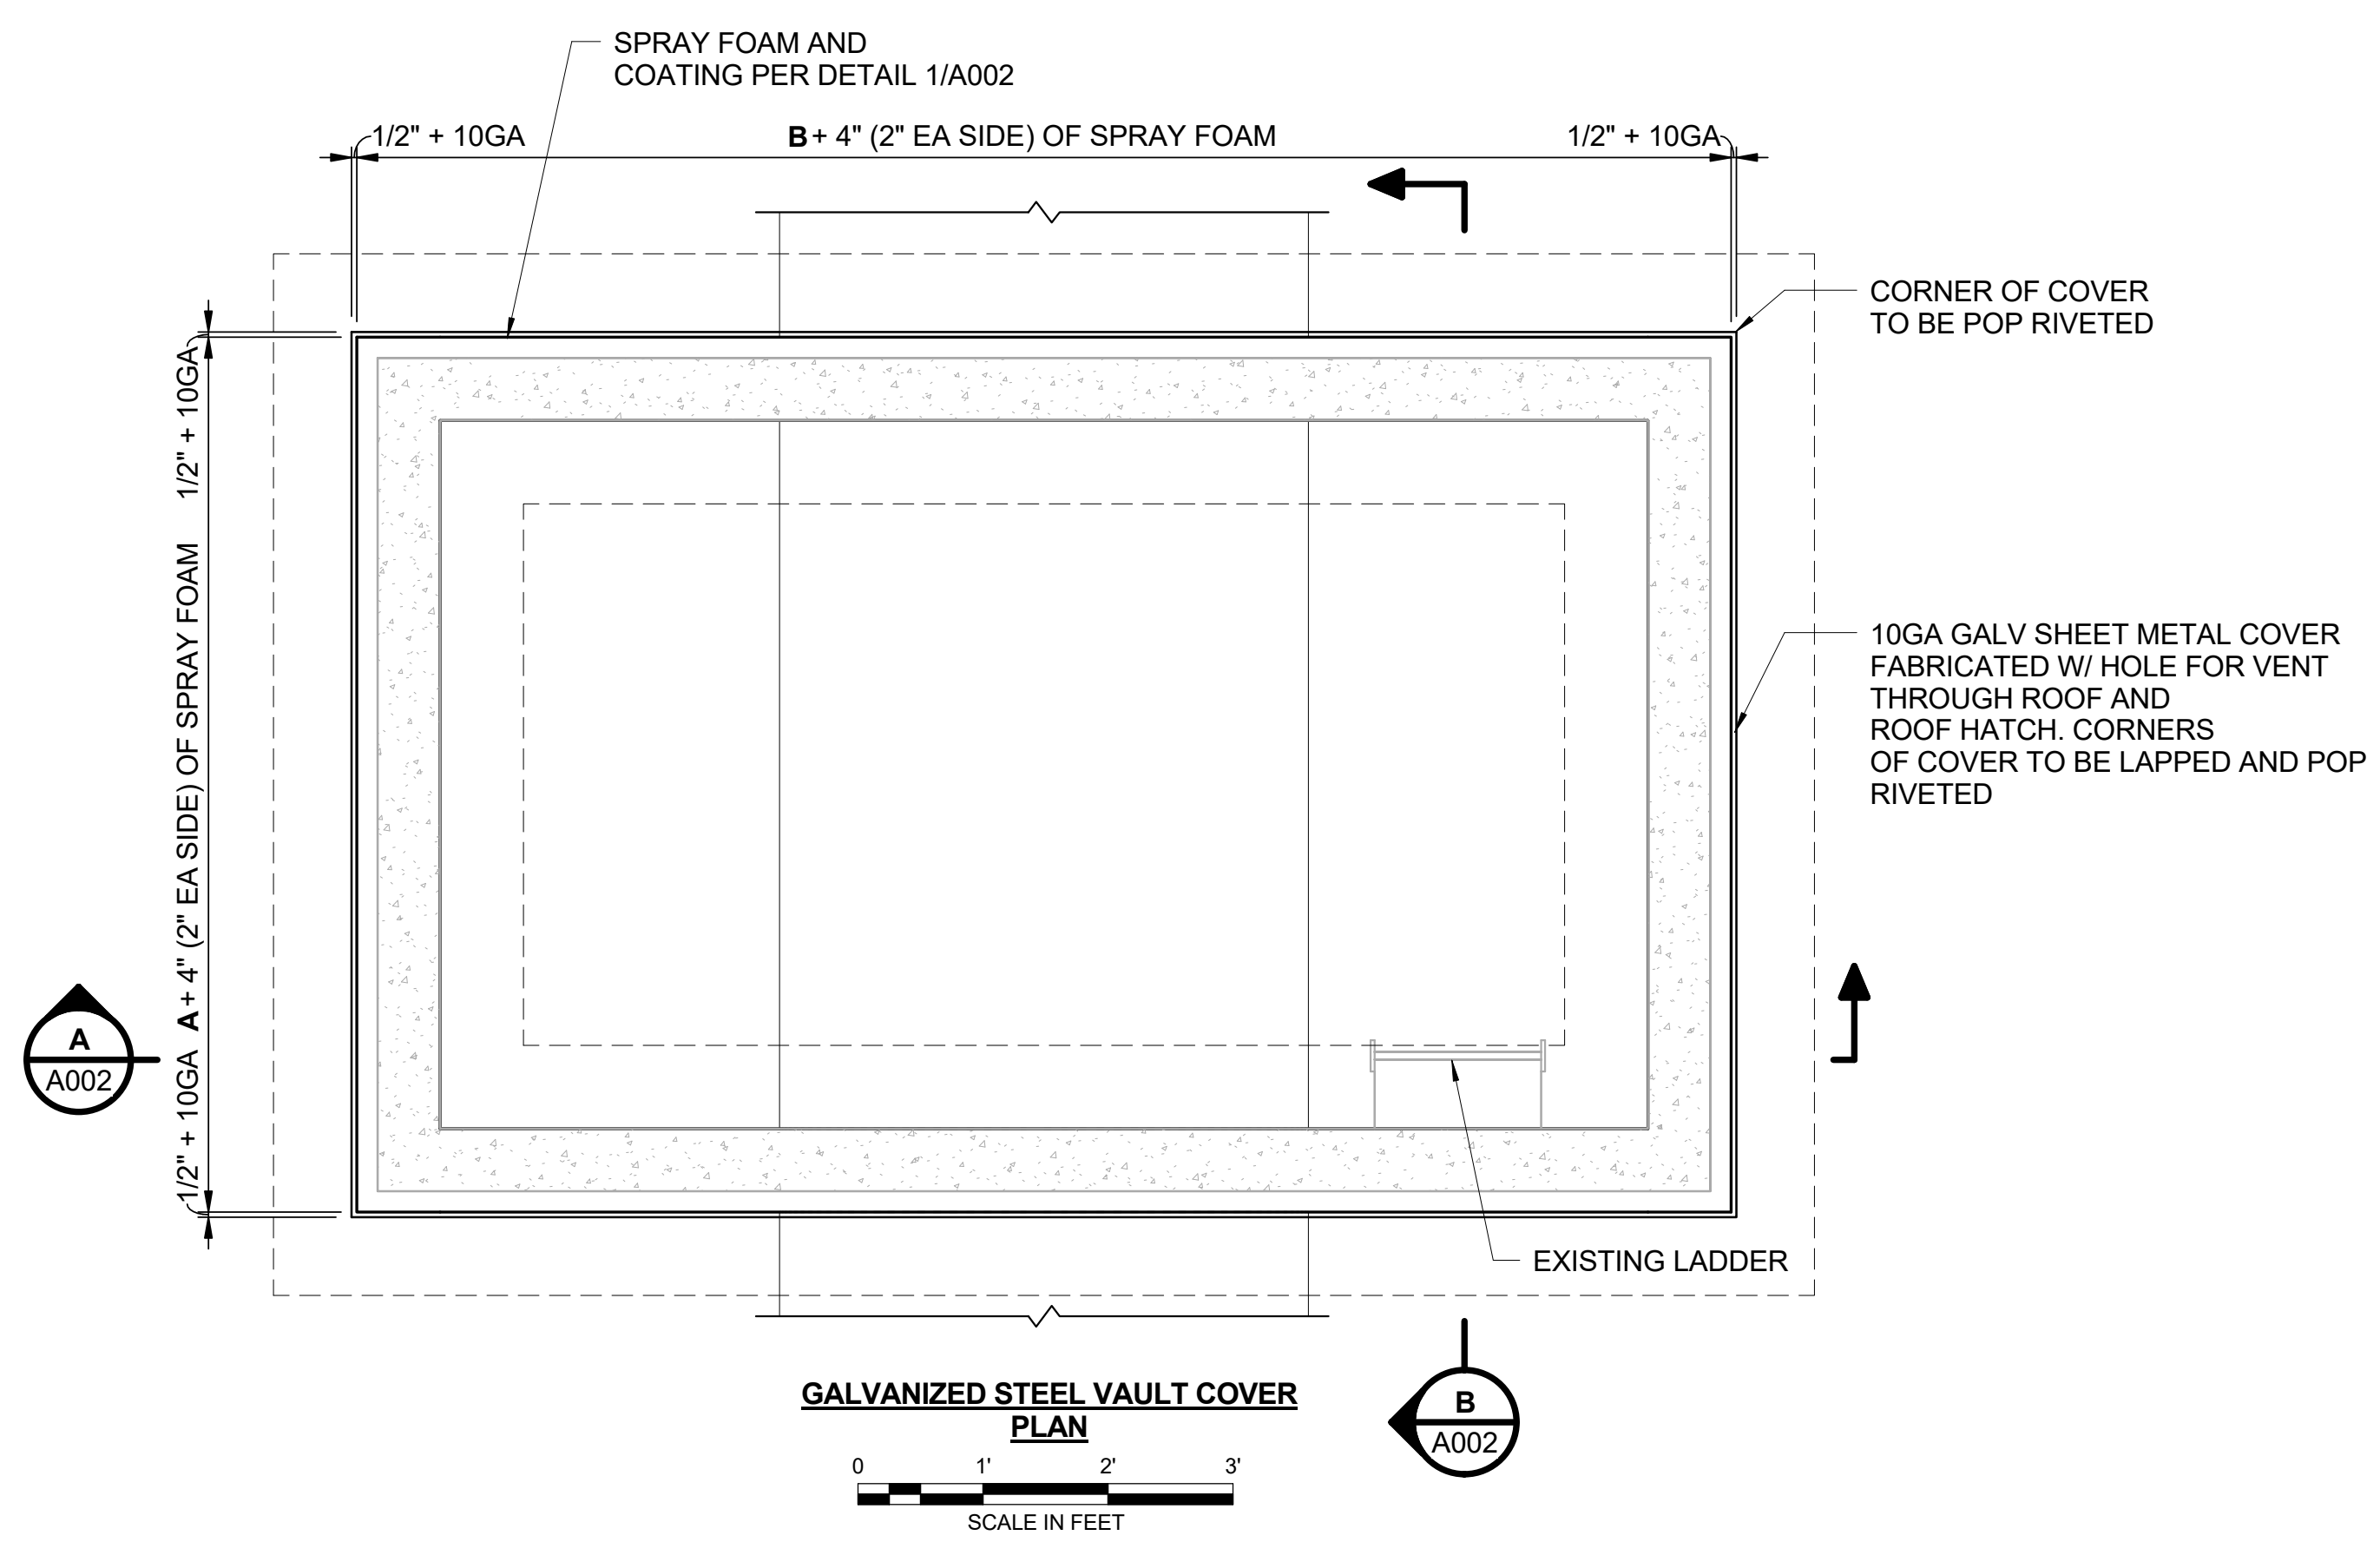

- GENERAL NOTES:**
- ALL PRODUCTS SPECIFIED ARE "OR ENGINEER APPROVED EQUAL."
 - MINIMUM R-VALUE REQUIRED R-10Ci PER INTERNATIONAL BUILDING CODE 2012 IECC BELOW GRADE MASS.
 - SUBMIT ALL ITEMS CALLED FOR ON THIS SHEET FOR ENGINEER/ARCHITECT APPROVAL PRIOR TO INSTALLATION. SUBMITTAL SHALL INCLUDE BUT NOT BE LIMITED TO DATA SHEETS, SHOP DRAWINGS, HARD AND DIGITAL COPY COLOR CHART.
 - INSTALL PER MANUFACTURERS DATA SHEETS AND INSTRUCTIONS.
 - SPRAY FOAM SYSTEM AND COATINGS SHALL BE WARRANTED AS A SINGLE SYSTEM.
 - SPRAY FOAM APPLICATORS SHALL HAVE AND DOCUMENT IN THE SUBMITTAL A MINIMUM OF 5 YEARS APPLICABLE EXPERIENCE.
 - OWNER TO APPROVE SHEET METAL COVER ON FIRST VAULT PRIOR TO FABRICATION OF SUBSEQUENT COVERS.
 - INSULATION SHALL BE ON EVERY VAULT EXISTING AND NEW.

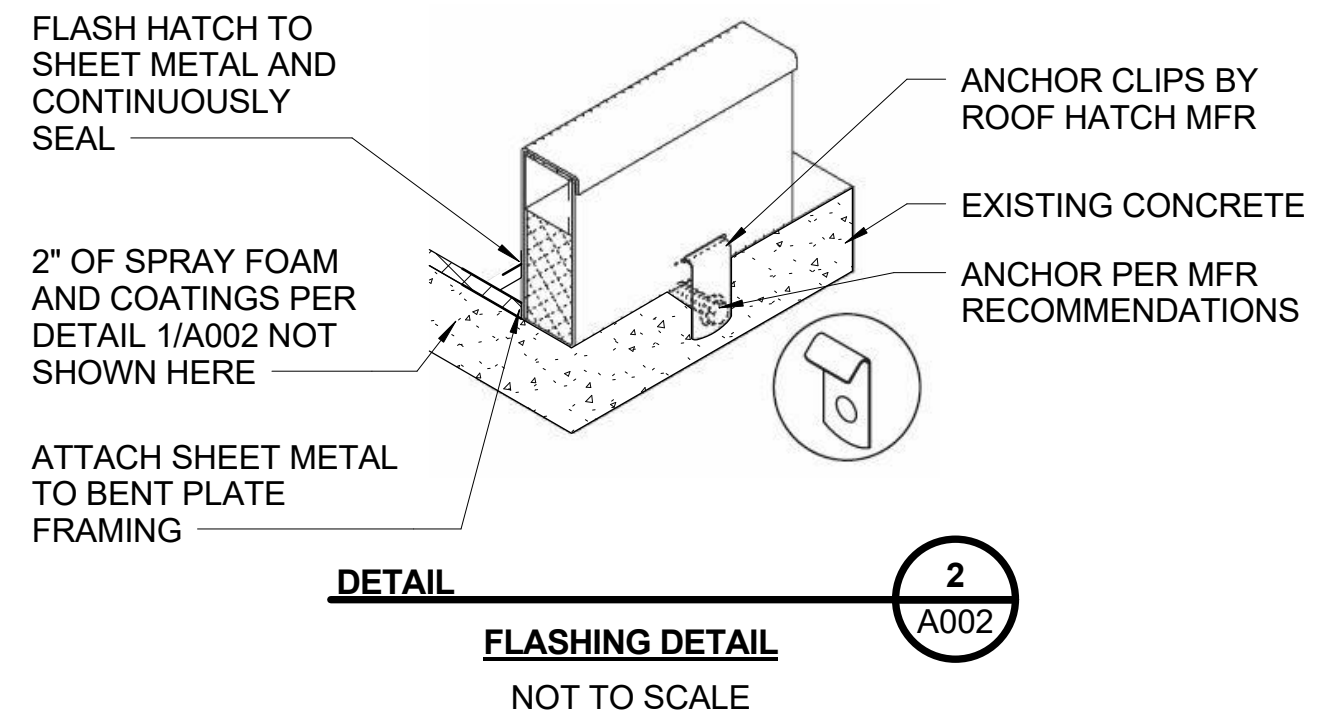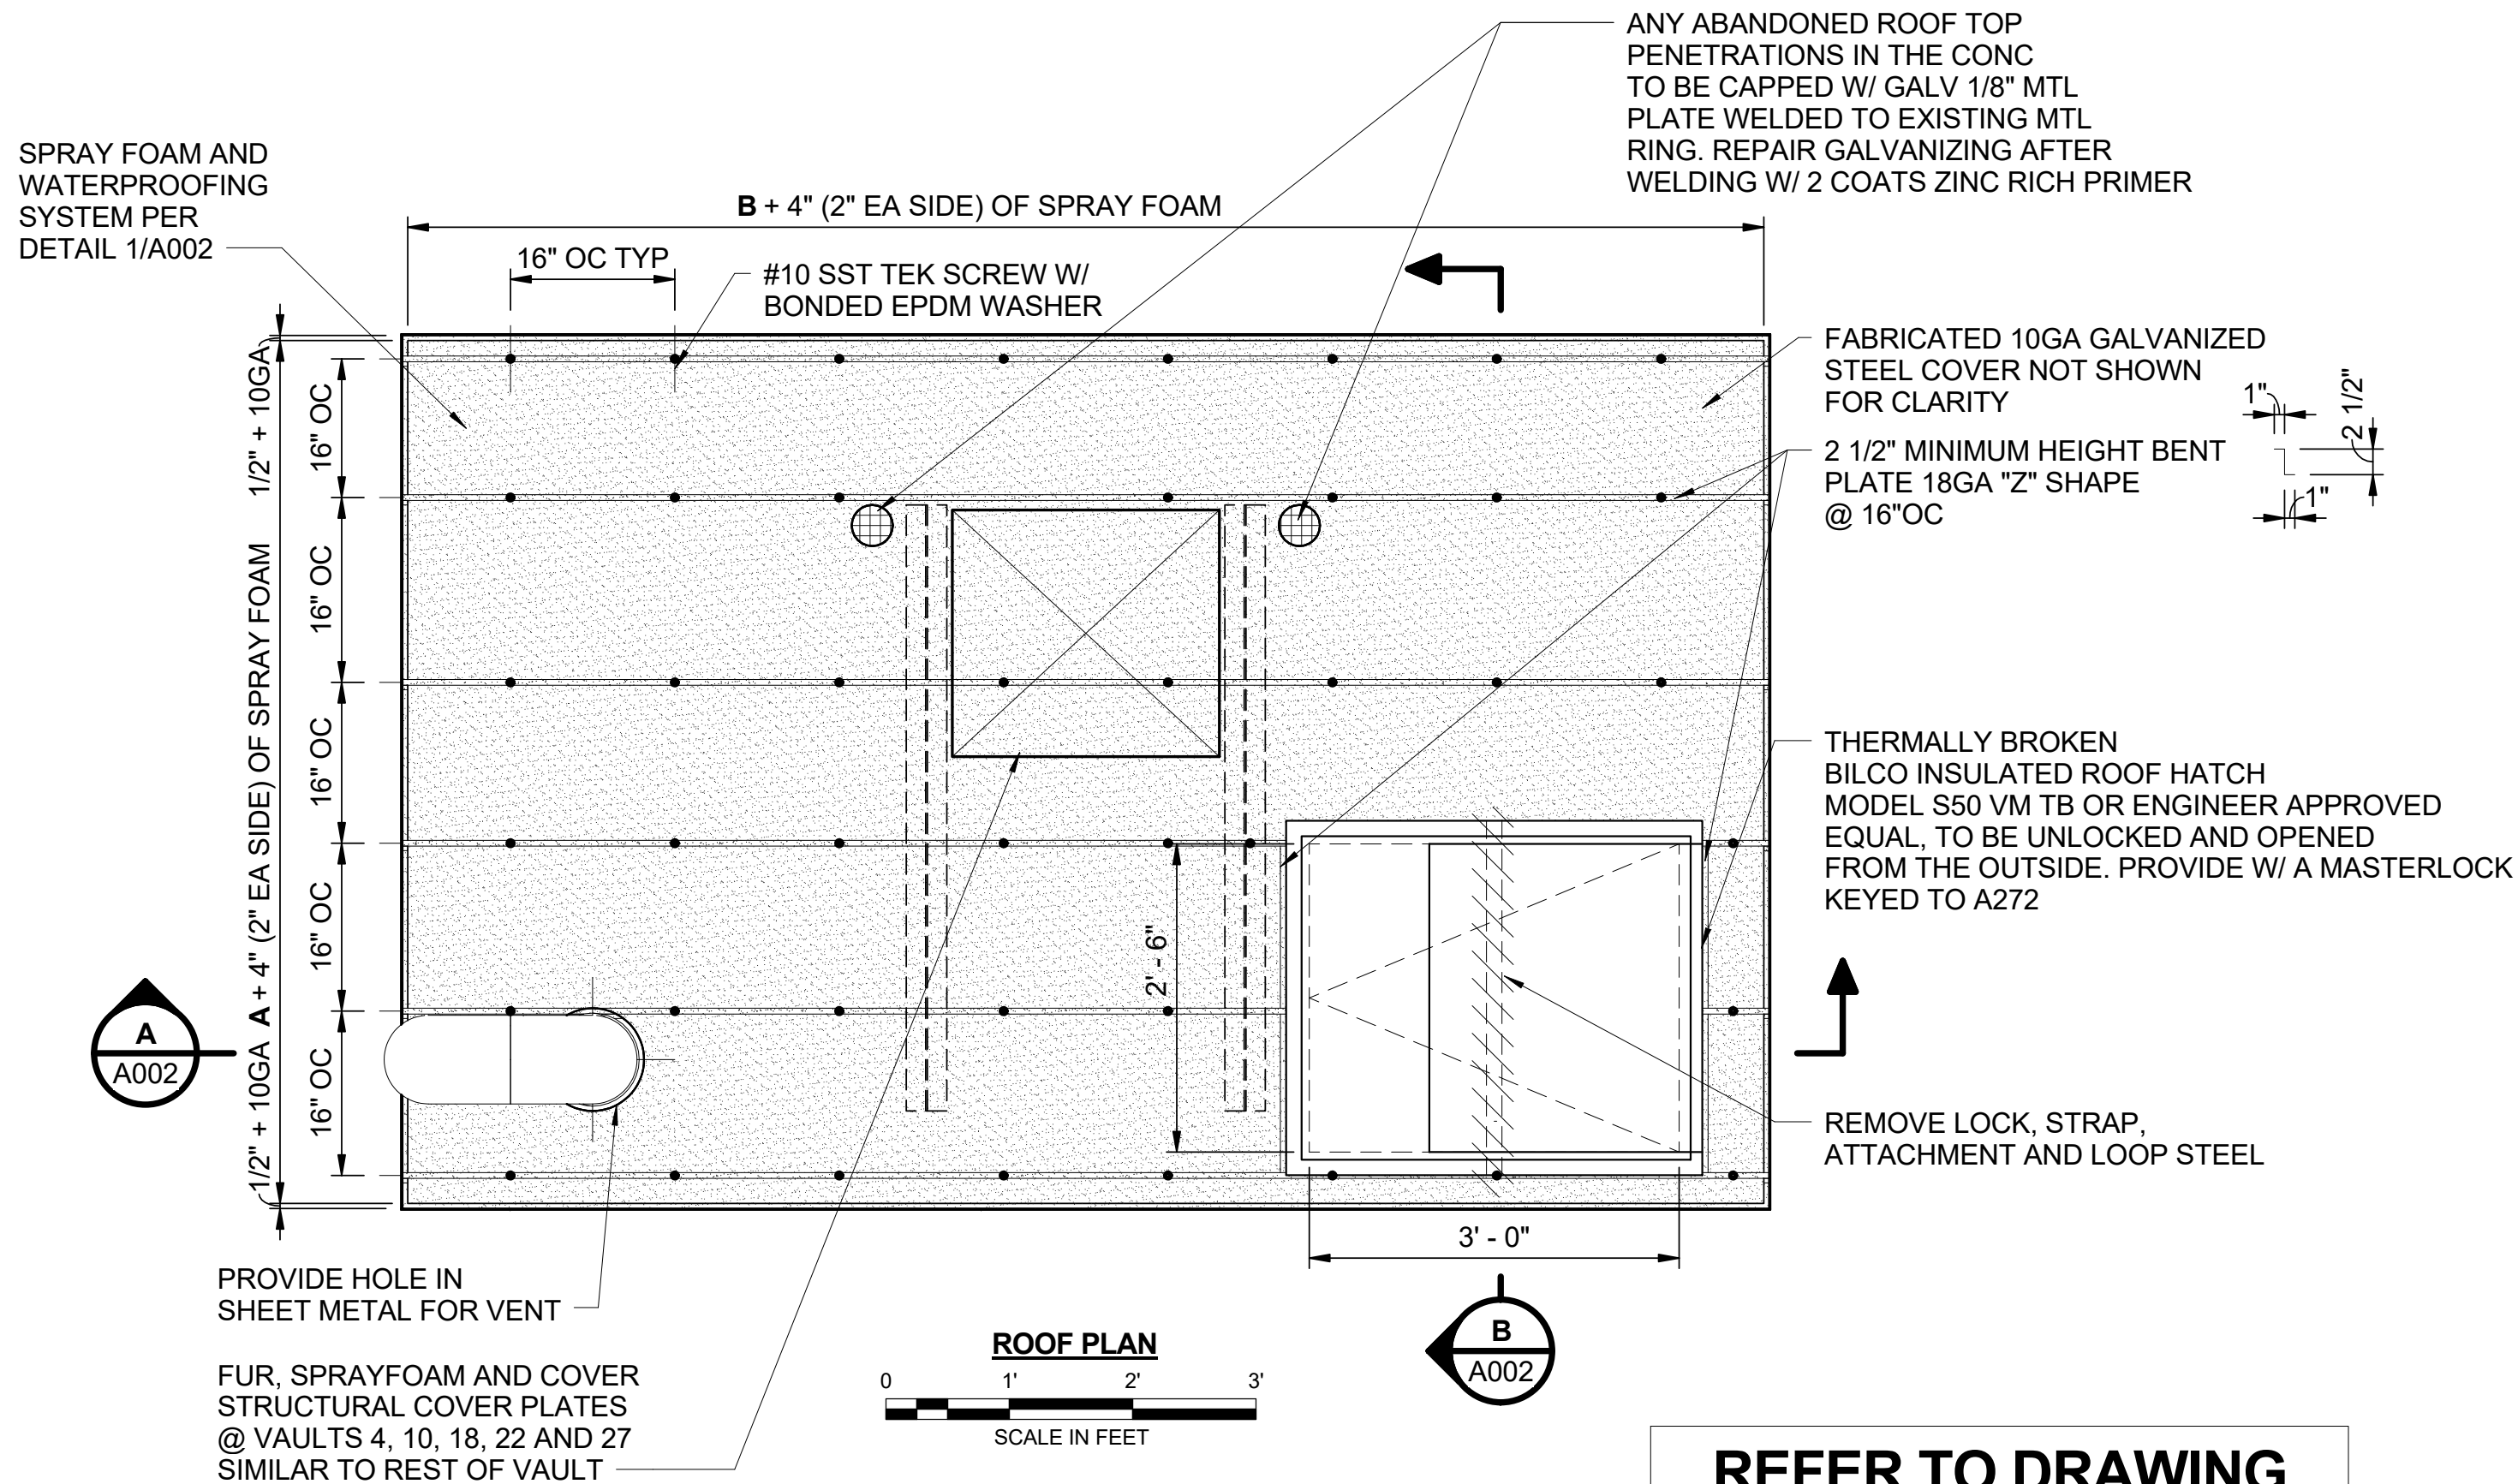

REFER TO DRAWING D001 FOR LETTER A & B DIMENSIONS

BURNS & MCDONNELL

9400 WARD PARKWAY
KANSAS CITY, MO 64114
816-333-9400
LICENSEE NO. E-65

date SEPTEMBER 12, 2017	detailed R. GUIN
designed R. LANG	checked J. TSOULIAS

City of
Wichita, Kansas

SEDGWICK, KANSAS


CHENEY TRANSMISSION LINE FLOOR PLAN

project 97687	contract
drawing A001	rev. 1
sheet	of sheets


file 97687_ARCH_2017.RVT

COPYRIGHT © 2017 BURNS & MCDONNELL ENGINEERING COMPANY, INC.


no.	date	by	ckd	description
0	11/8/17	RPL	JT	ISSUED FOR BID
1	2/5/19	RPL	JT	CONFORMING TO CONSTRUCTION RECORDS

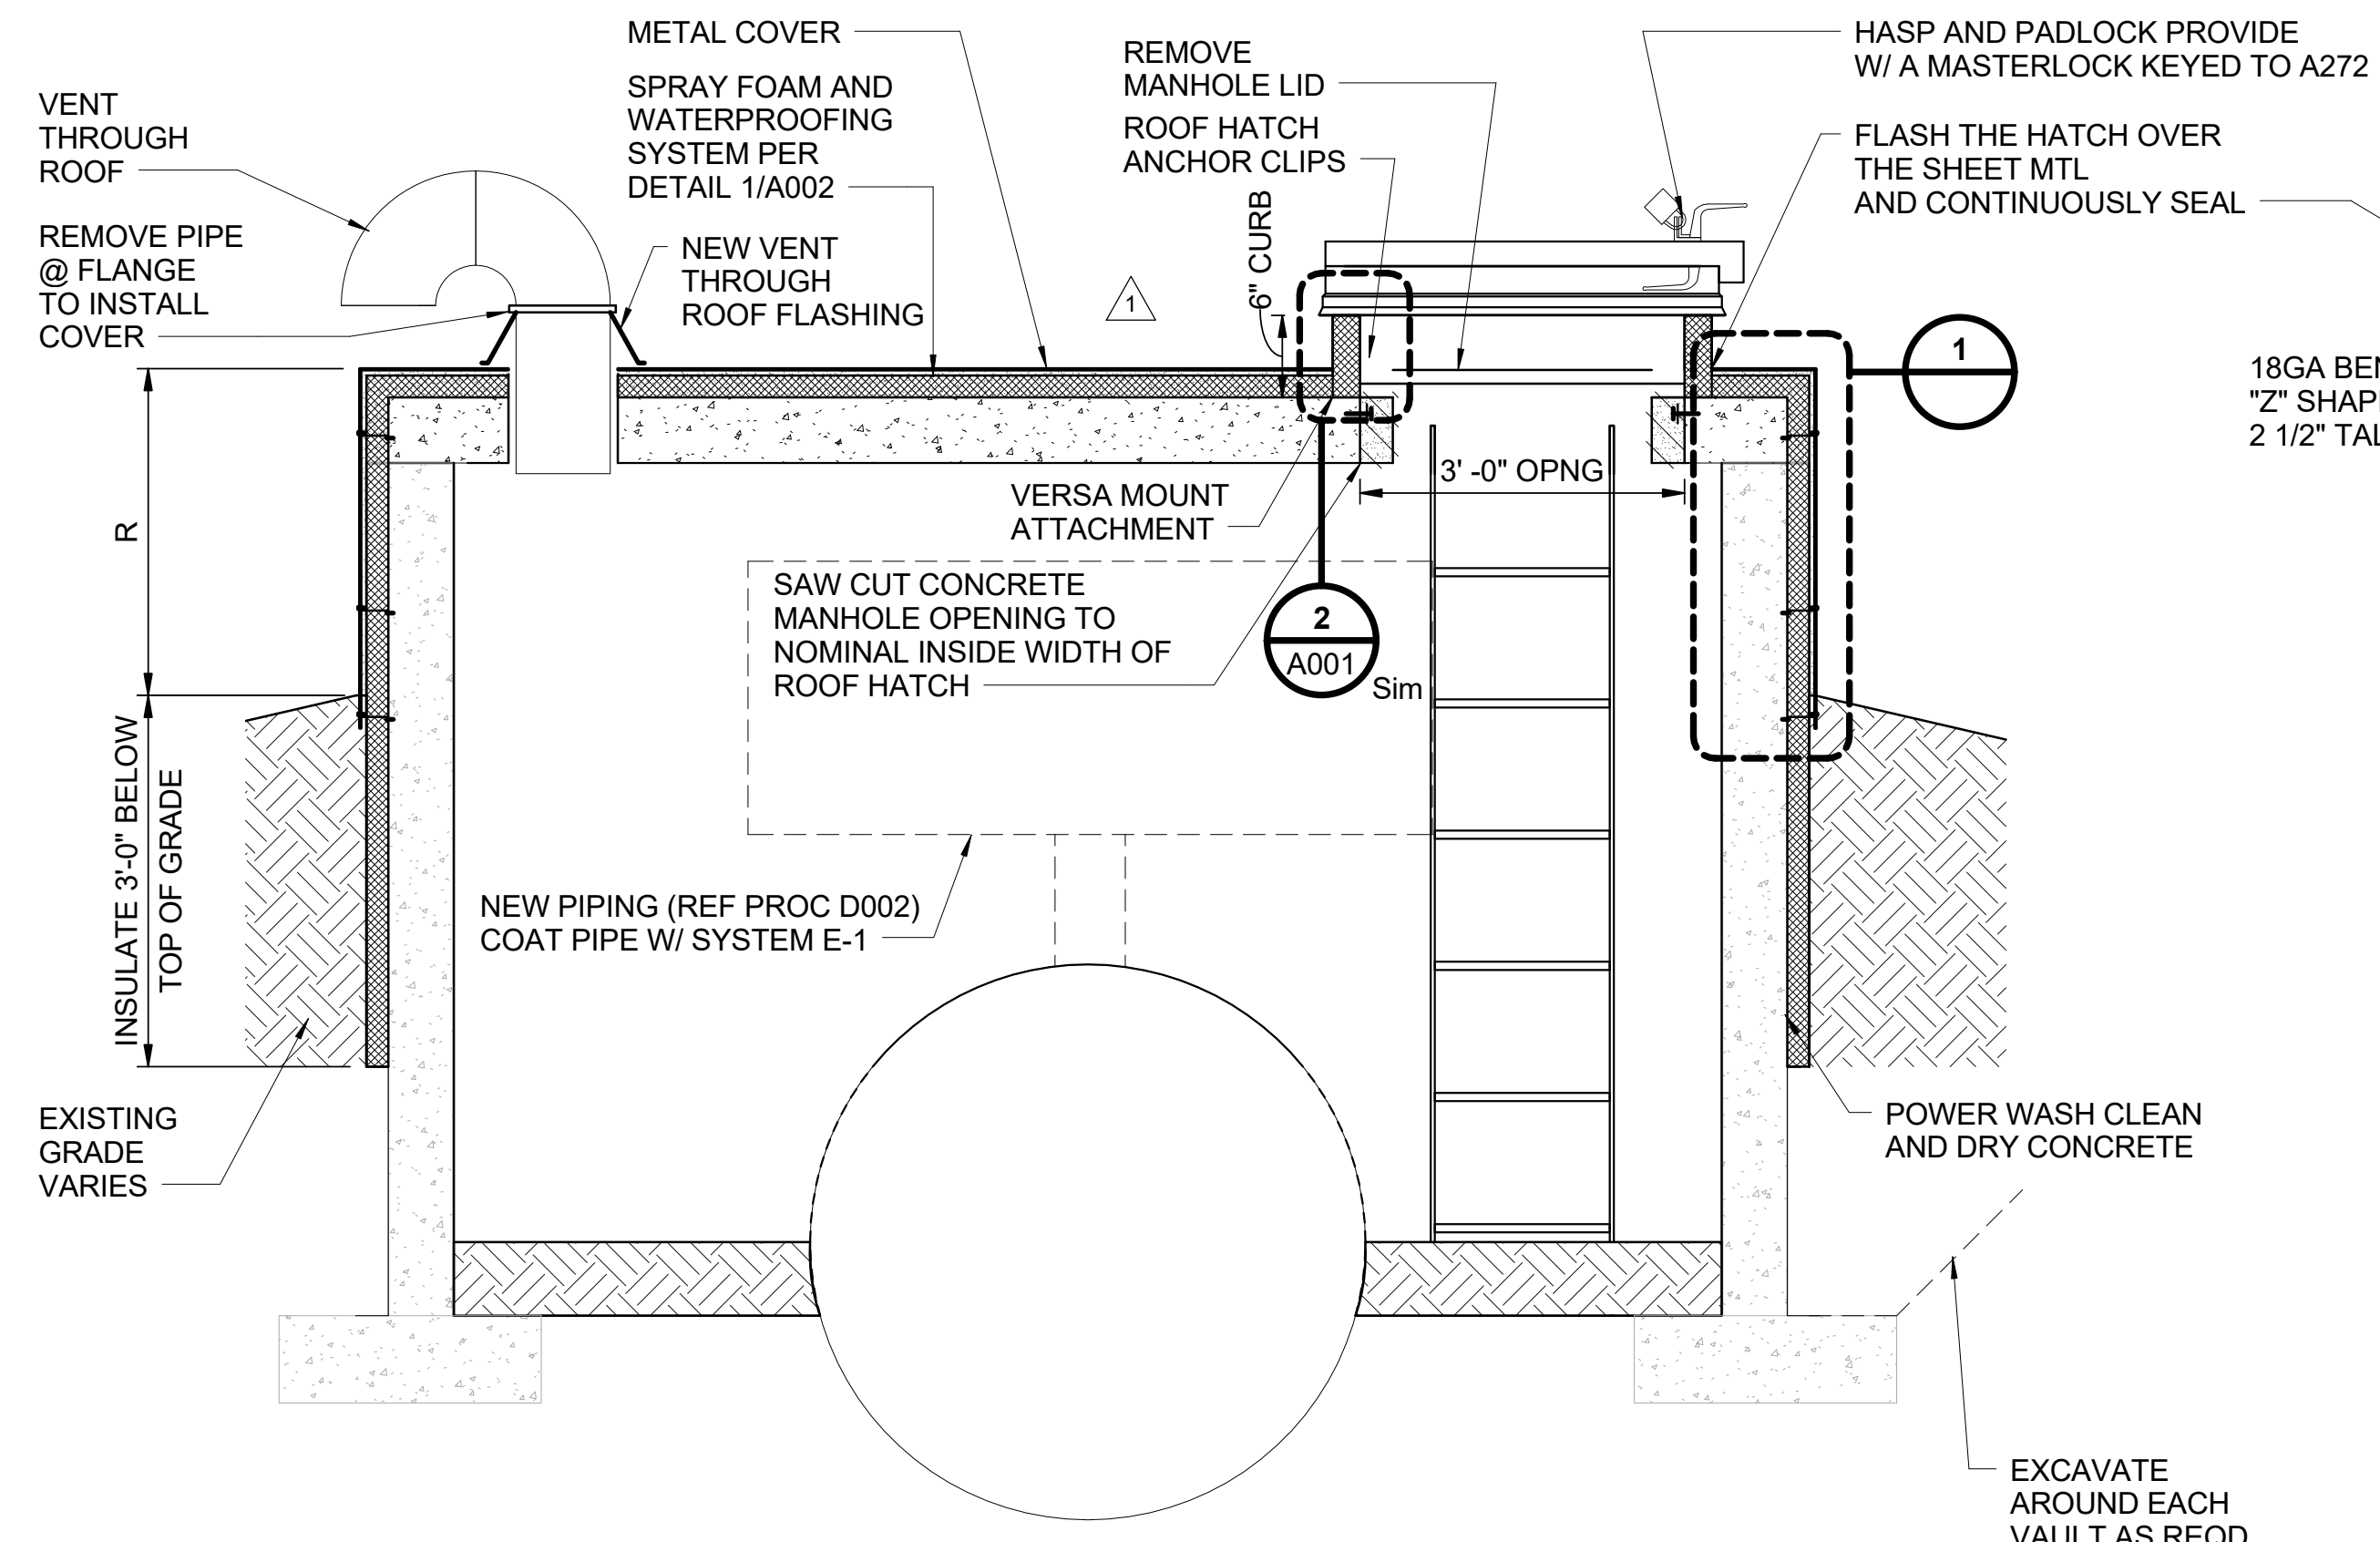


SECTION VAULT
A001
SCALE IN FEET

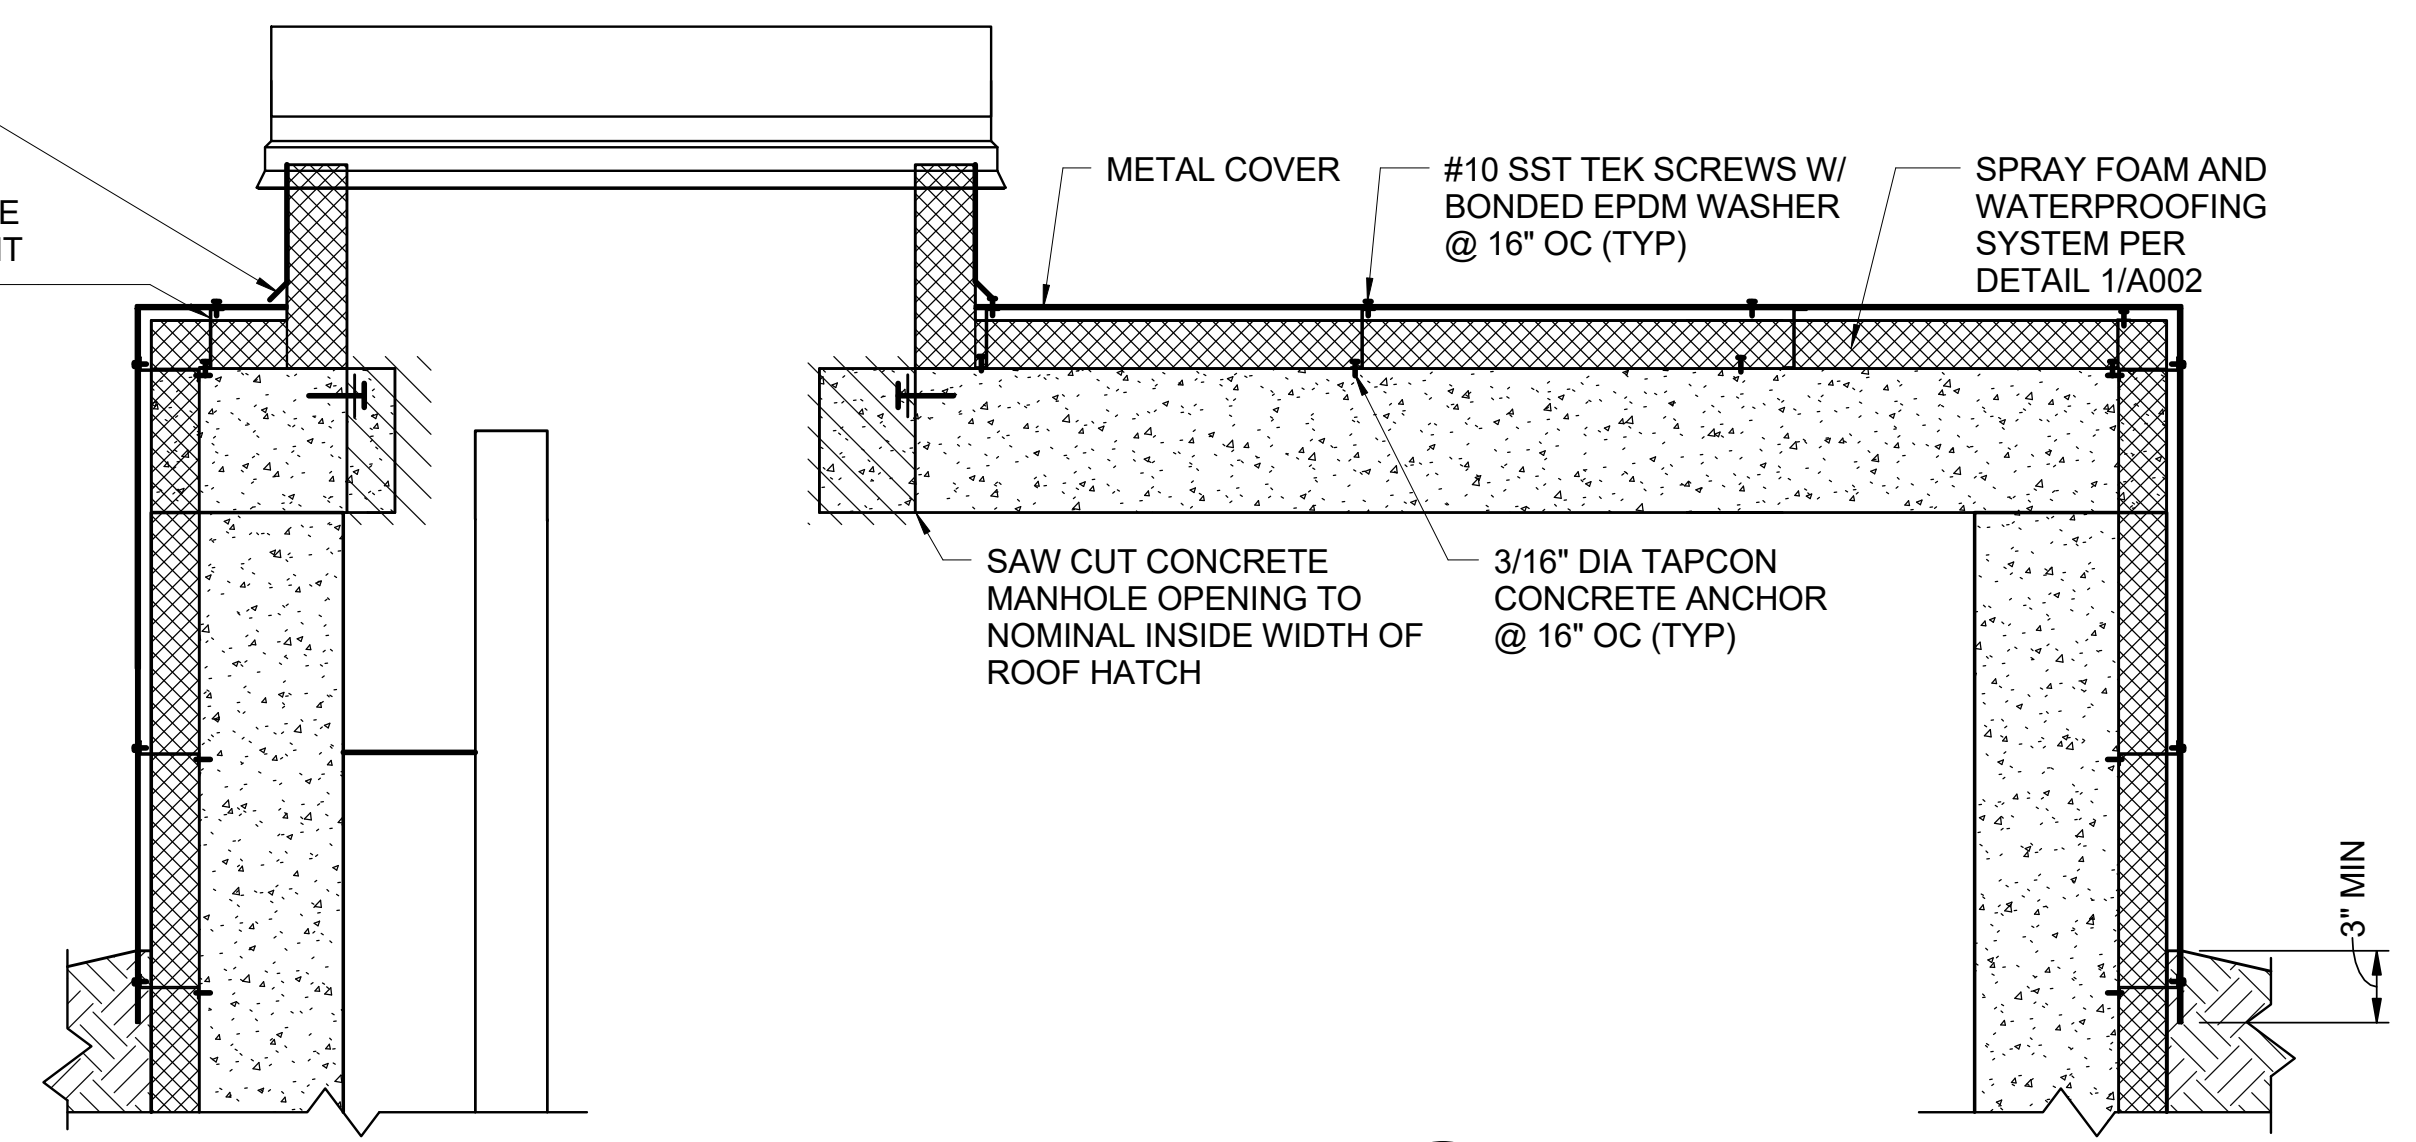

SECTION VAULT
B001
SCALE IN FEET

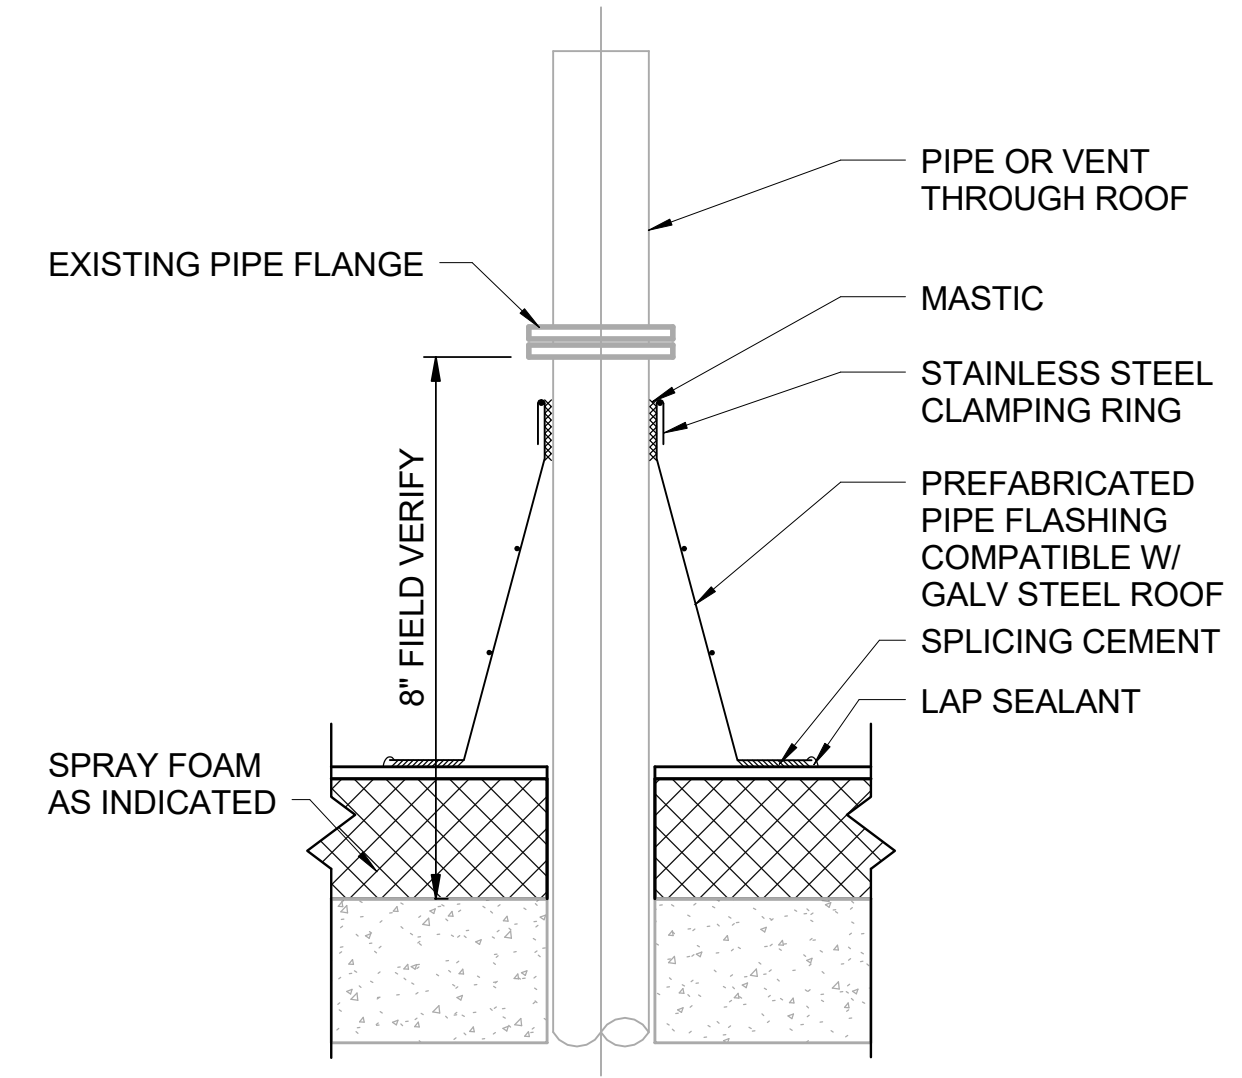

TYP VENT FLASHING
SCALE IN FEET

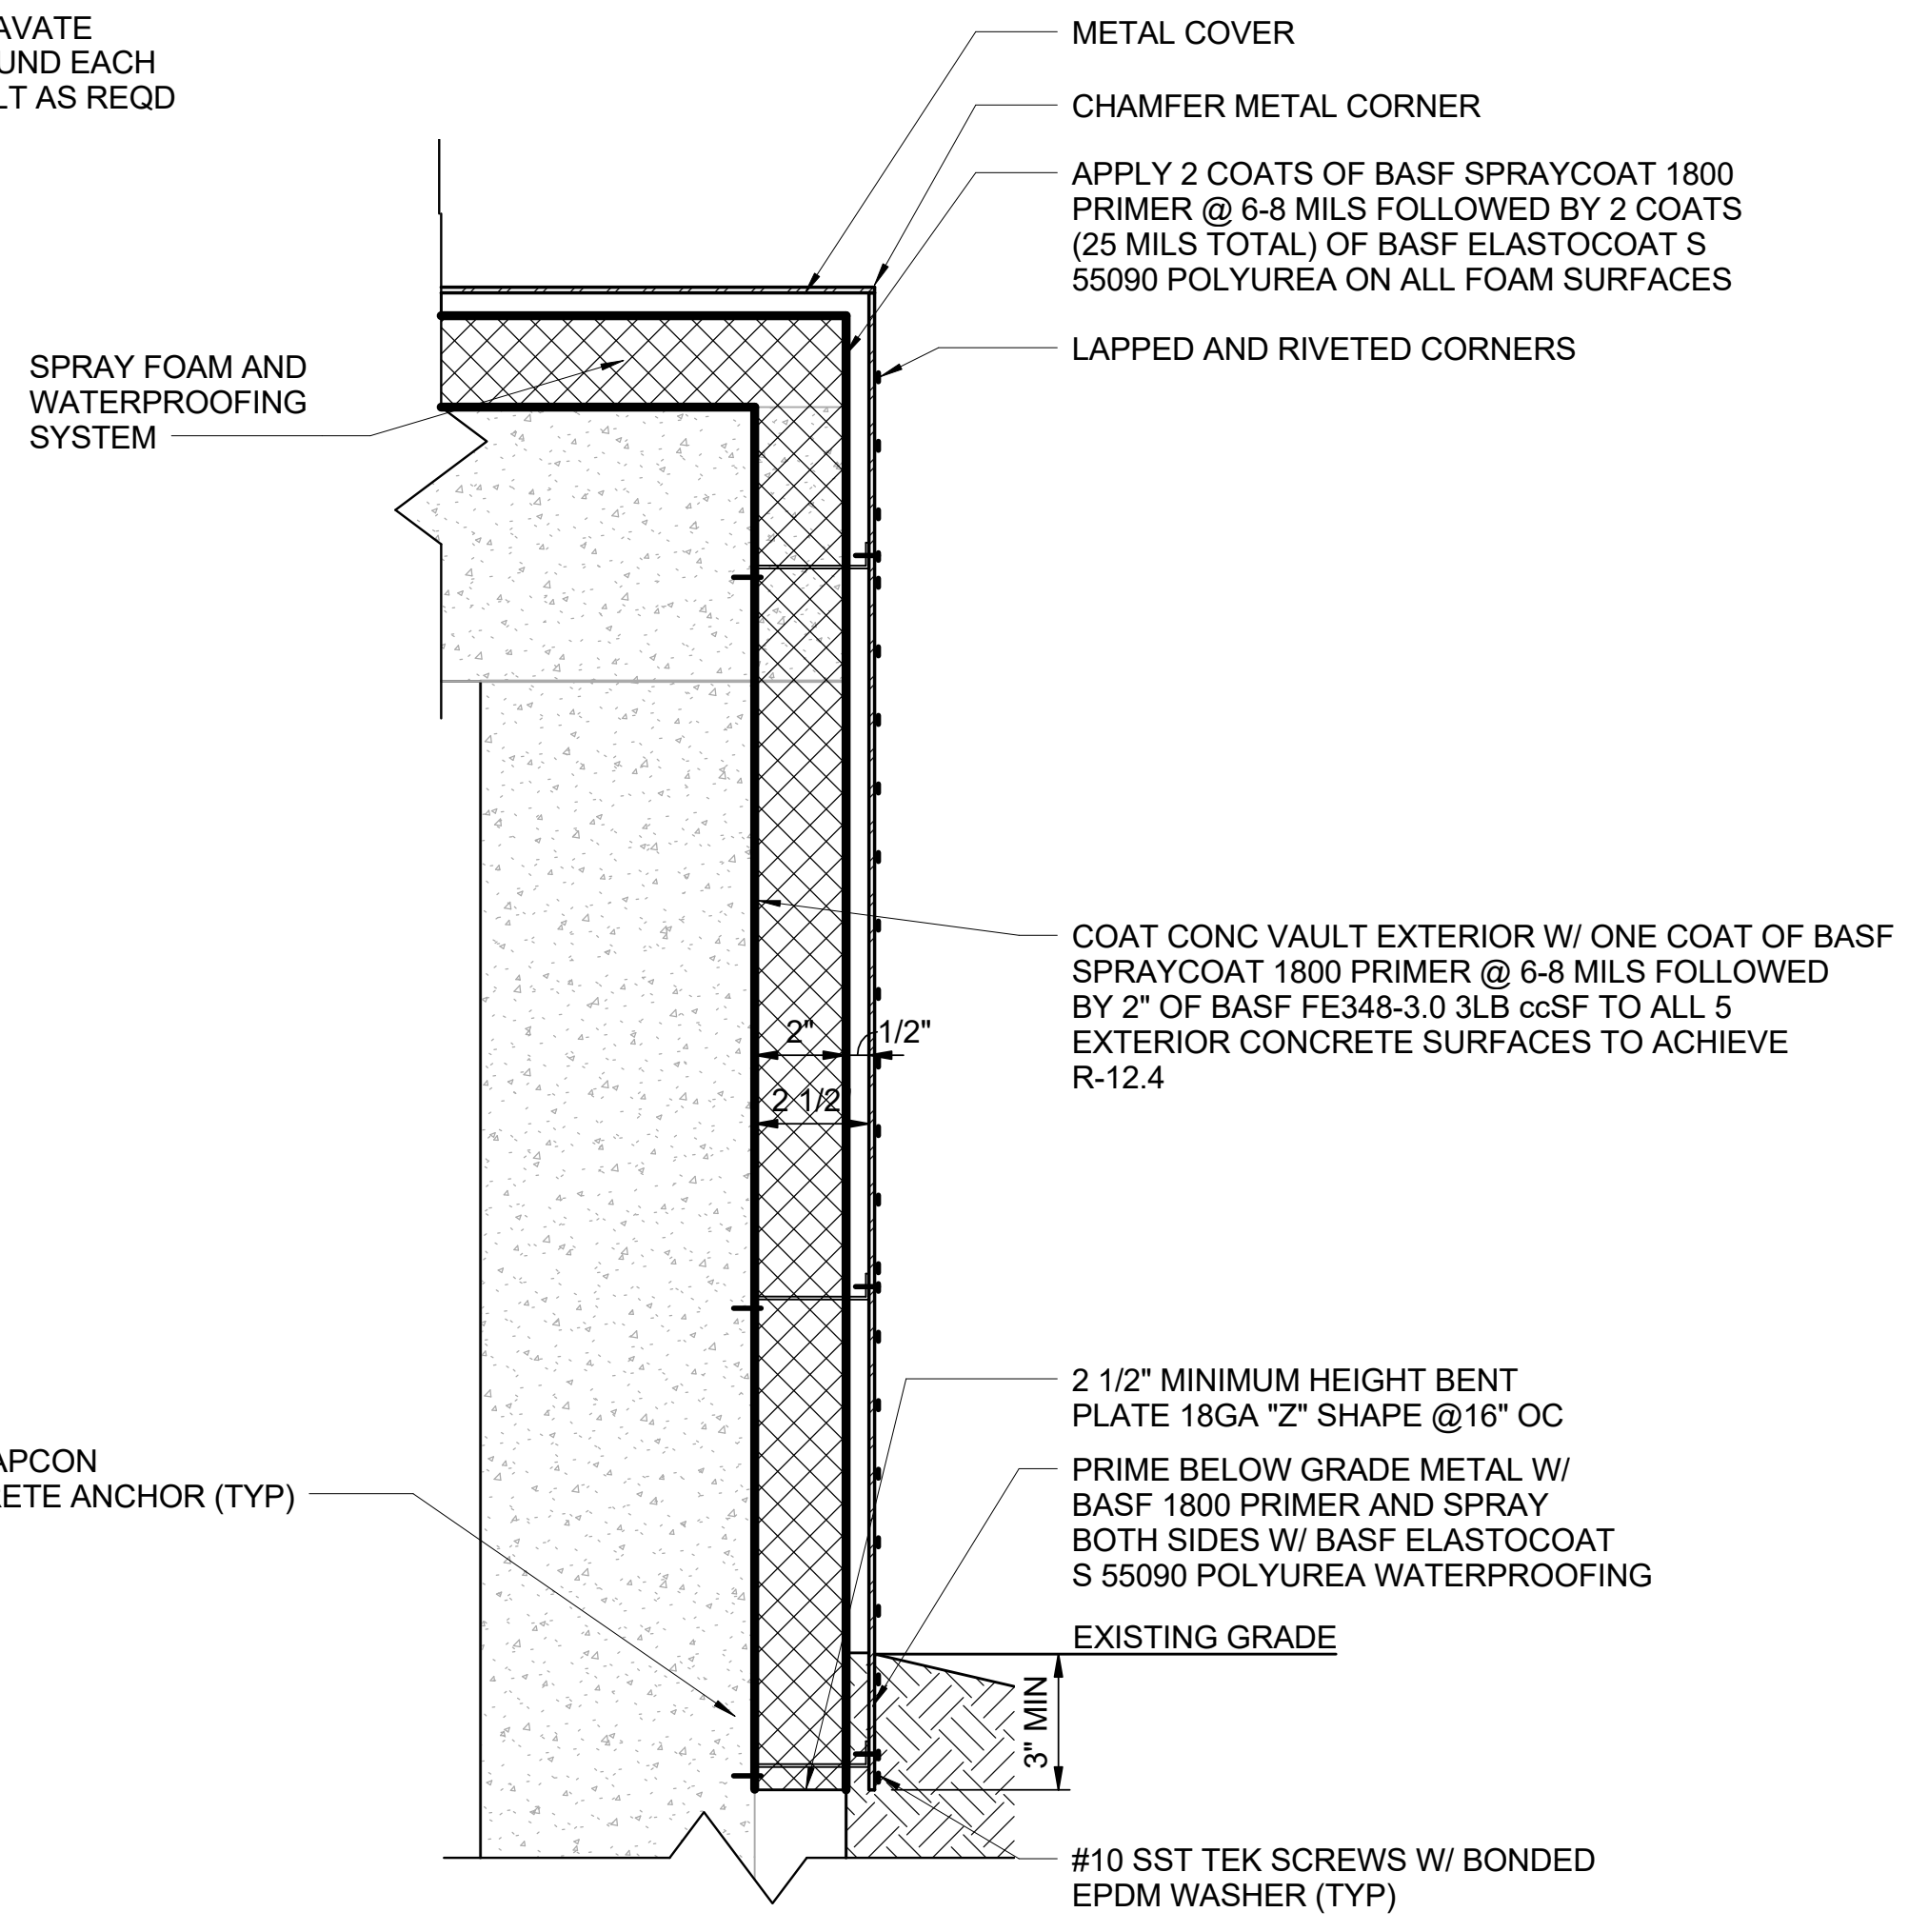

DETAIL SPRAY FOAM/WATER PROOFING
1
SCALE IN FEET

Scale For Microfining
Millimeters


Inches

COPYRIGHT © 2017 BURNS & MCDONNELL ENGINEERING COMPANY, INC.



9400 WARD PARKWAY
KANSAS CITY, MO 64114
816-333-9400
LICENSEE NO. E-65

date	OCTOBER 10, 2017	detailed	R. GUIN
designed	R. LANG	checked	J. TSOULIAS

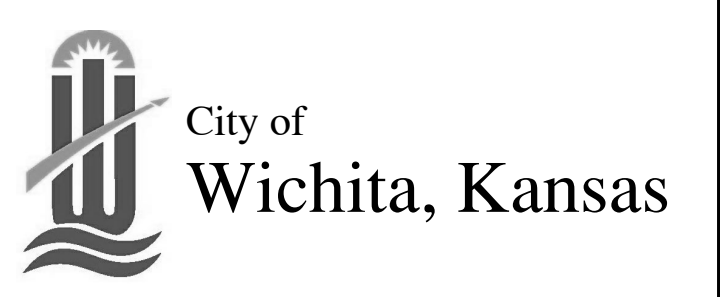

SEDGWICK, KANSAS





CHENEY TRANSMISSION LINE
SECTION AND DETAILS

project	97687	contract	
drawing	A002	rev.	1
sheet	of	sheets	
file	97687_ARCH_2017.RVT		

GENERAL NOTES:

1. MATERIALS:
 - A. STRUCTURAL STEEL:
 1. WIDE FLANGE (WF) SHAPES ASTM A992, GRADE 50.
 2. ANGLES AND PLATE: ASTM A36.
 3. ALL STRUCTURAL STEEL SHALL BE GALVANIZED AND CONFORM TO ASTM A123. NUTS, BOLTS, AND WASHERS SHALL BE HOT-DIPPED GALVANIZED TO CONFORM TO ASTM F2329 OR MECHANICALLY GALVANIZED TO CONFORM TO ASTM B695.
 - B. GROUT:
 1. VOLUME: 1 PART PORTLAND CEMENT TO 2 PARTS SAND.
 2. KEEP WATER TO A MINIMUM AS REQUIRED FOR PLACING BY THE DRY PACK METHOD.
 3. CURE PER MANUFACTURER'S INSTRUCTIONS.
 - C. ADHESIVE FOR POST INSTALLED ANCHORS SHALL BE HILTI HIT-HY 200 OR ENGINEER APPROVED EQUAL.
2. SAWCUT OPENING AS REQUIRED FOR NEW VALVE ASSEMBLY. SUPPORT BEAMS SHALL BE INSTALLED AND GROUT CURED FOR MINIMUM 3 DAYS PRIOR TO SAW CUTTING OPENING.
3. COVER PLATE SHALL BE CONTINUOUSLY WELDED AROUND THE PERIMETER AND AT THE CORNERS. SUBMIT SHOP DRAWING TO ENGINEER FOR REVIEW. INSTALL INSULATION OVER PLATE PER ARCHITECTURAL DRAWINGS.
4. APPLY CORROSION INHIBITOR TO SAWCUT CONCRETE SURFACE. SIKA ARMATEC 110 EPOCEM OR ENGINEER APPROVED EQUAL.

no.	date	by	ckd	description
0	5/24/18	AMG	JT	ISSUED PER ECN001
1	6/15/18	AMG	JT	ISSUED PER ECN002
	2/5/19	AMG	JT	CONFORMING TO CONSTRUCTION RECORDS

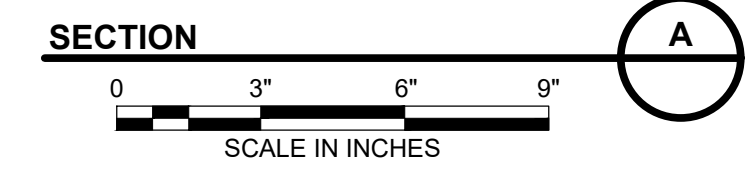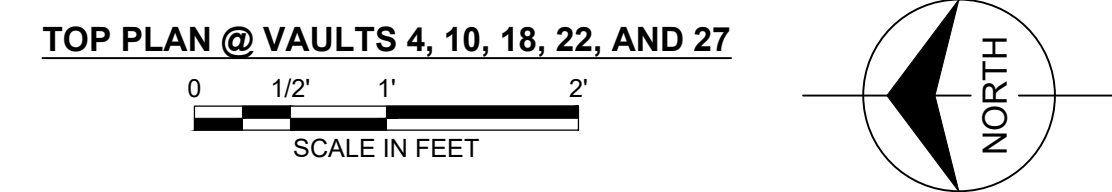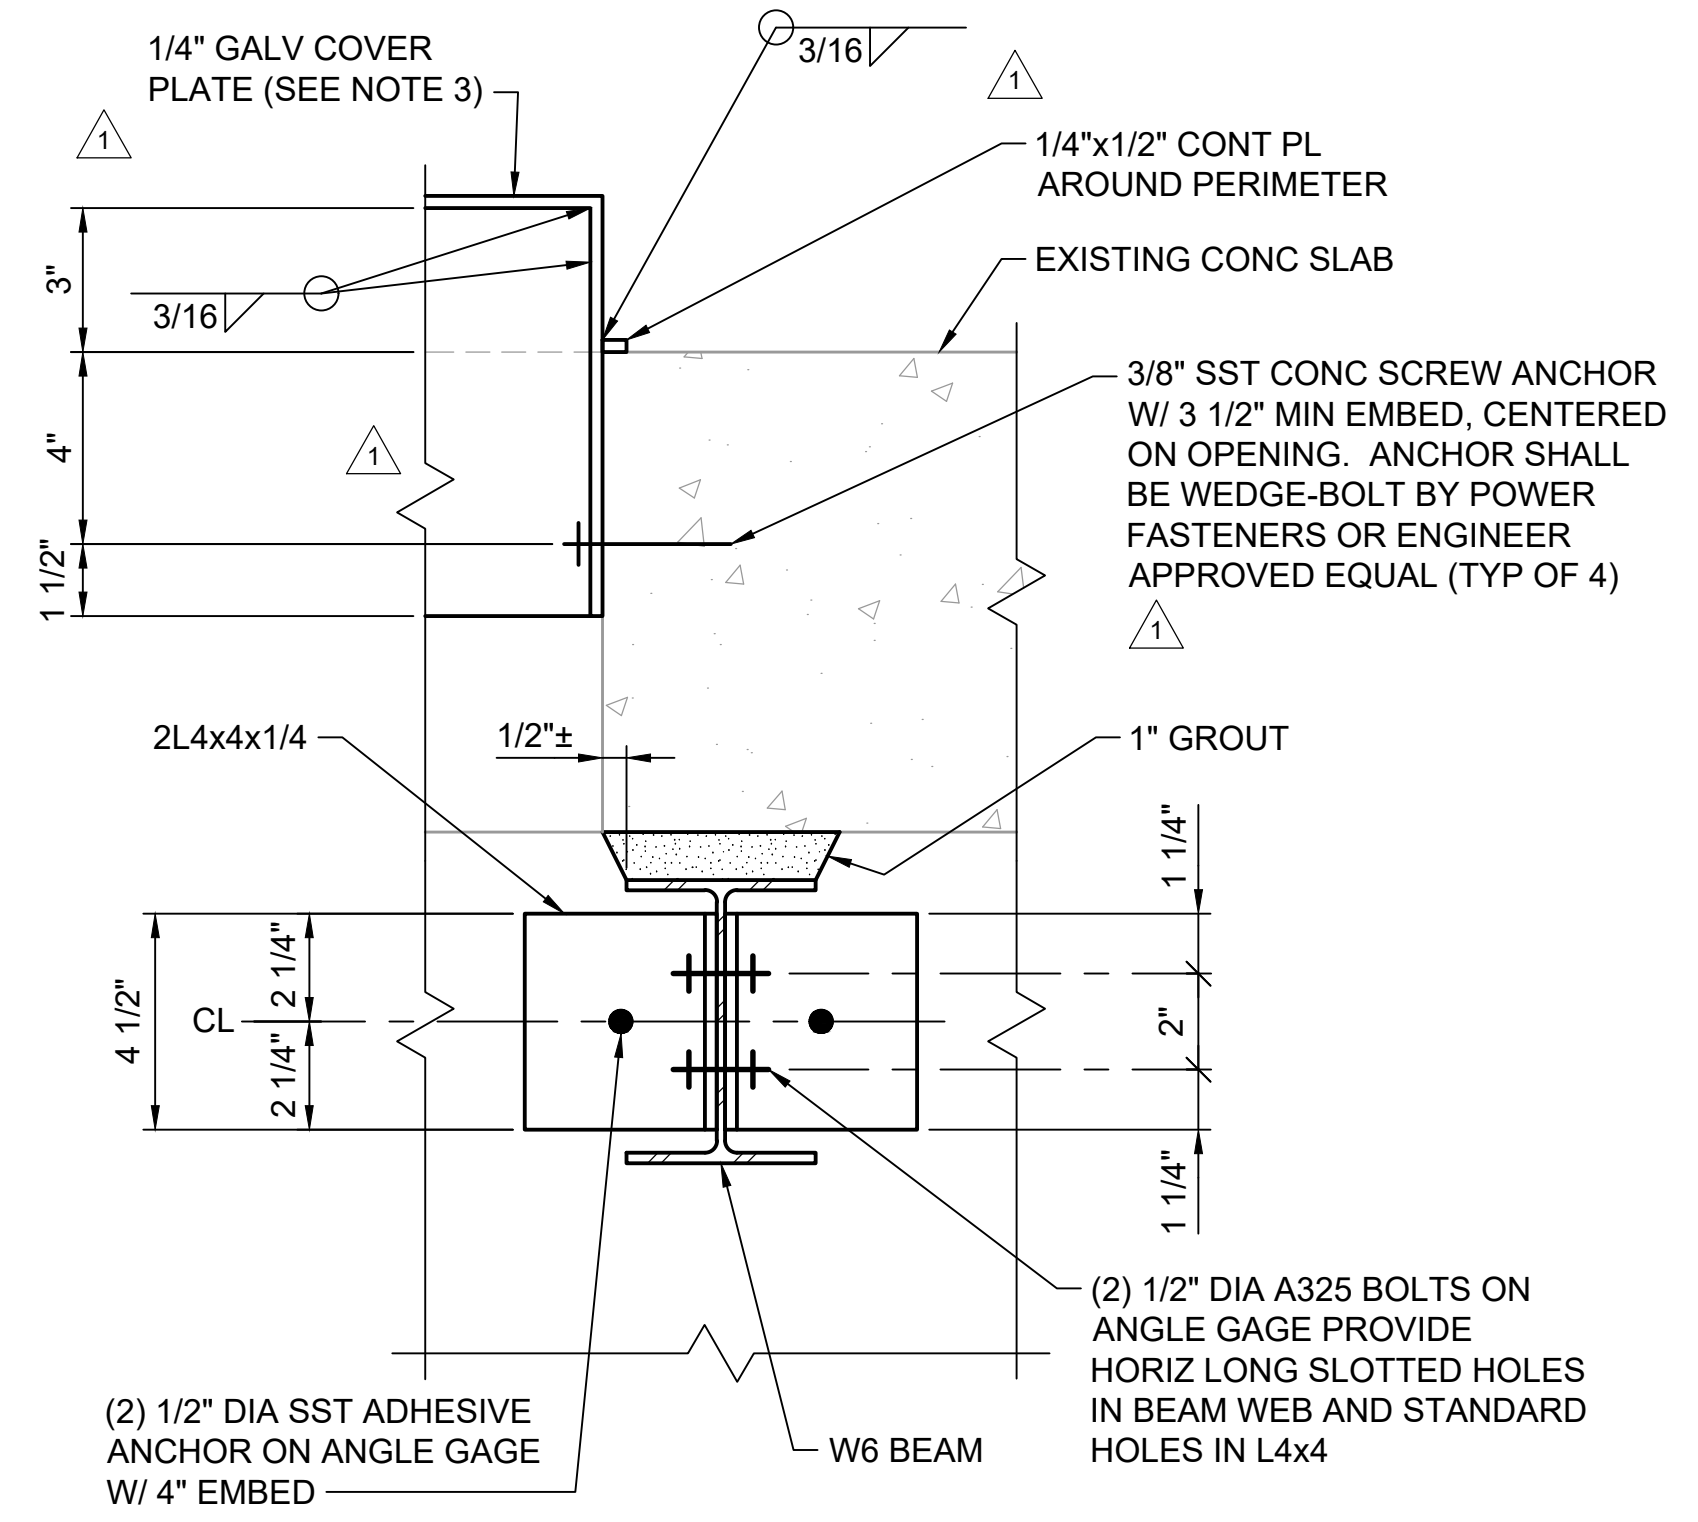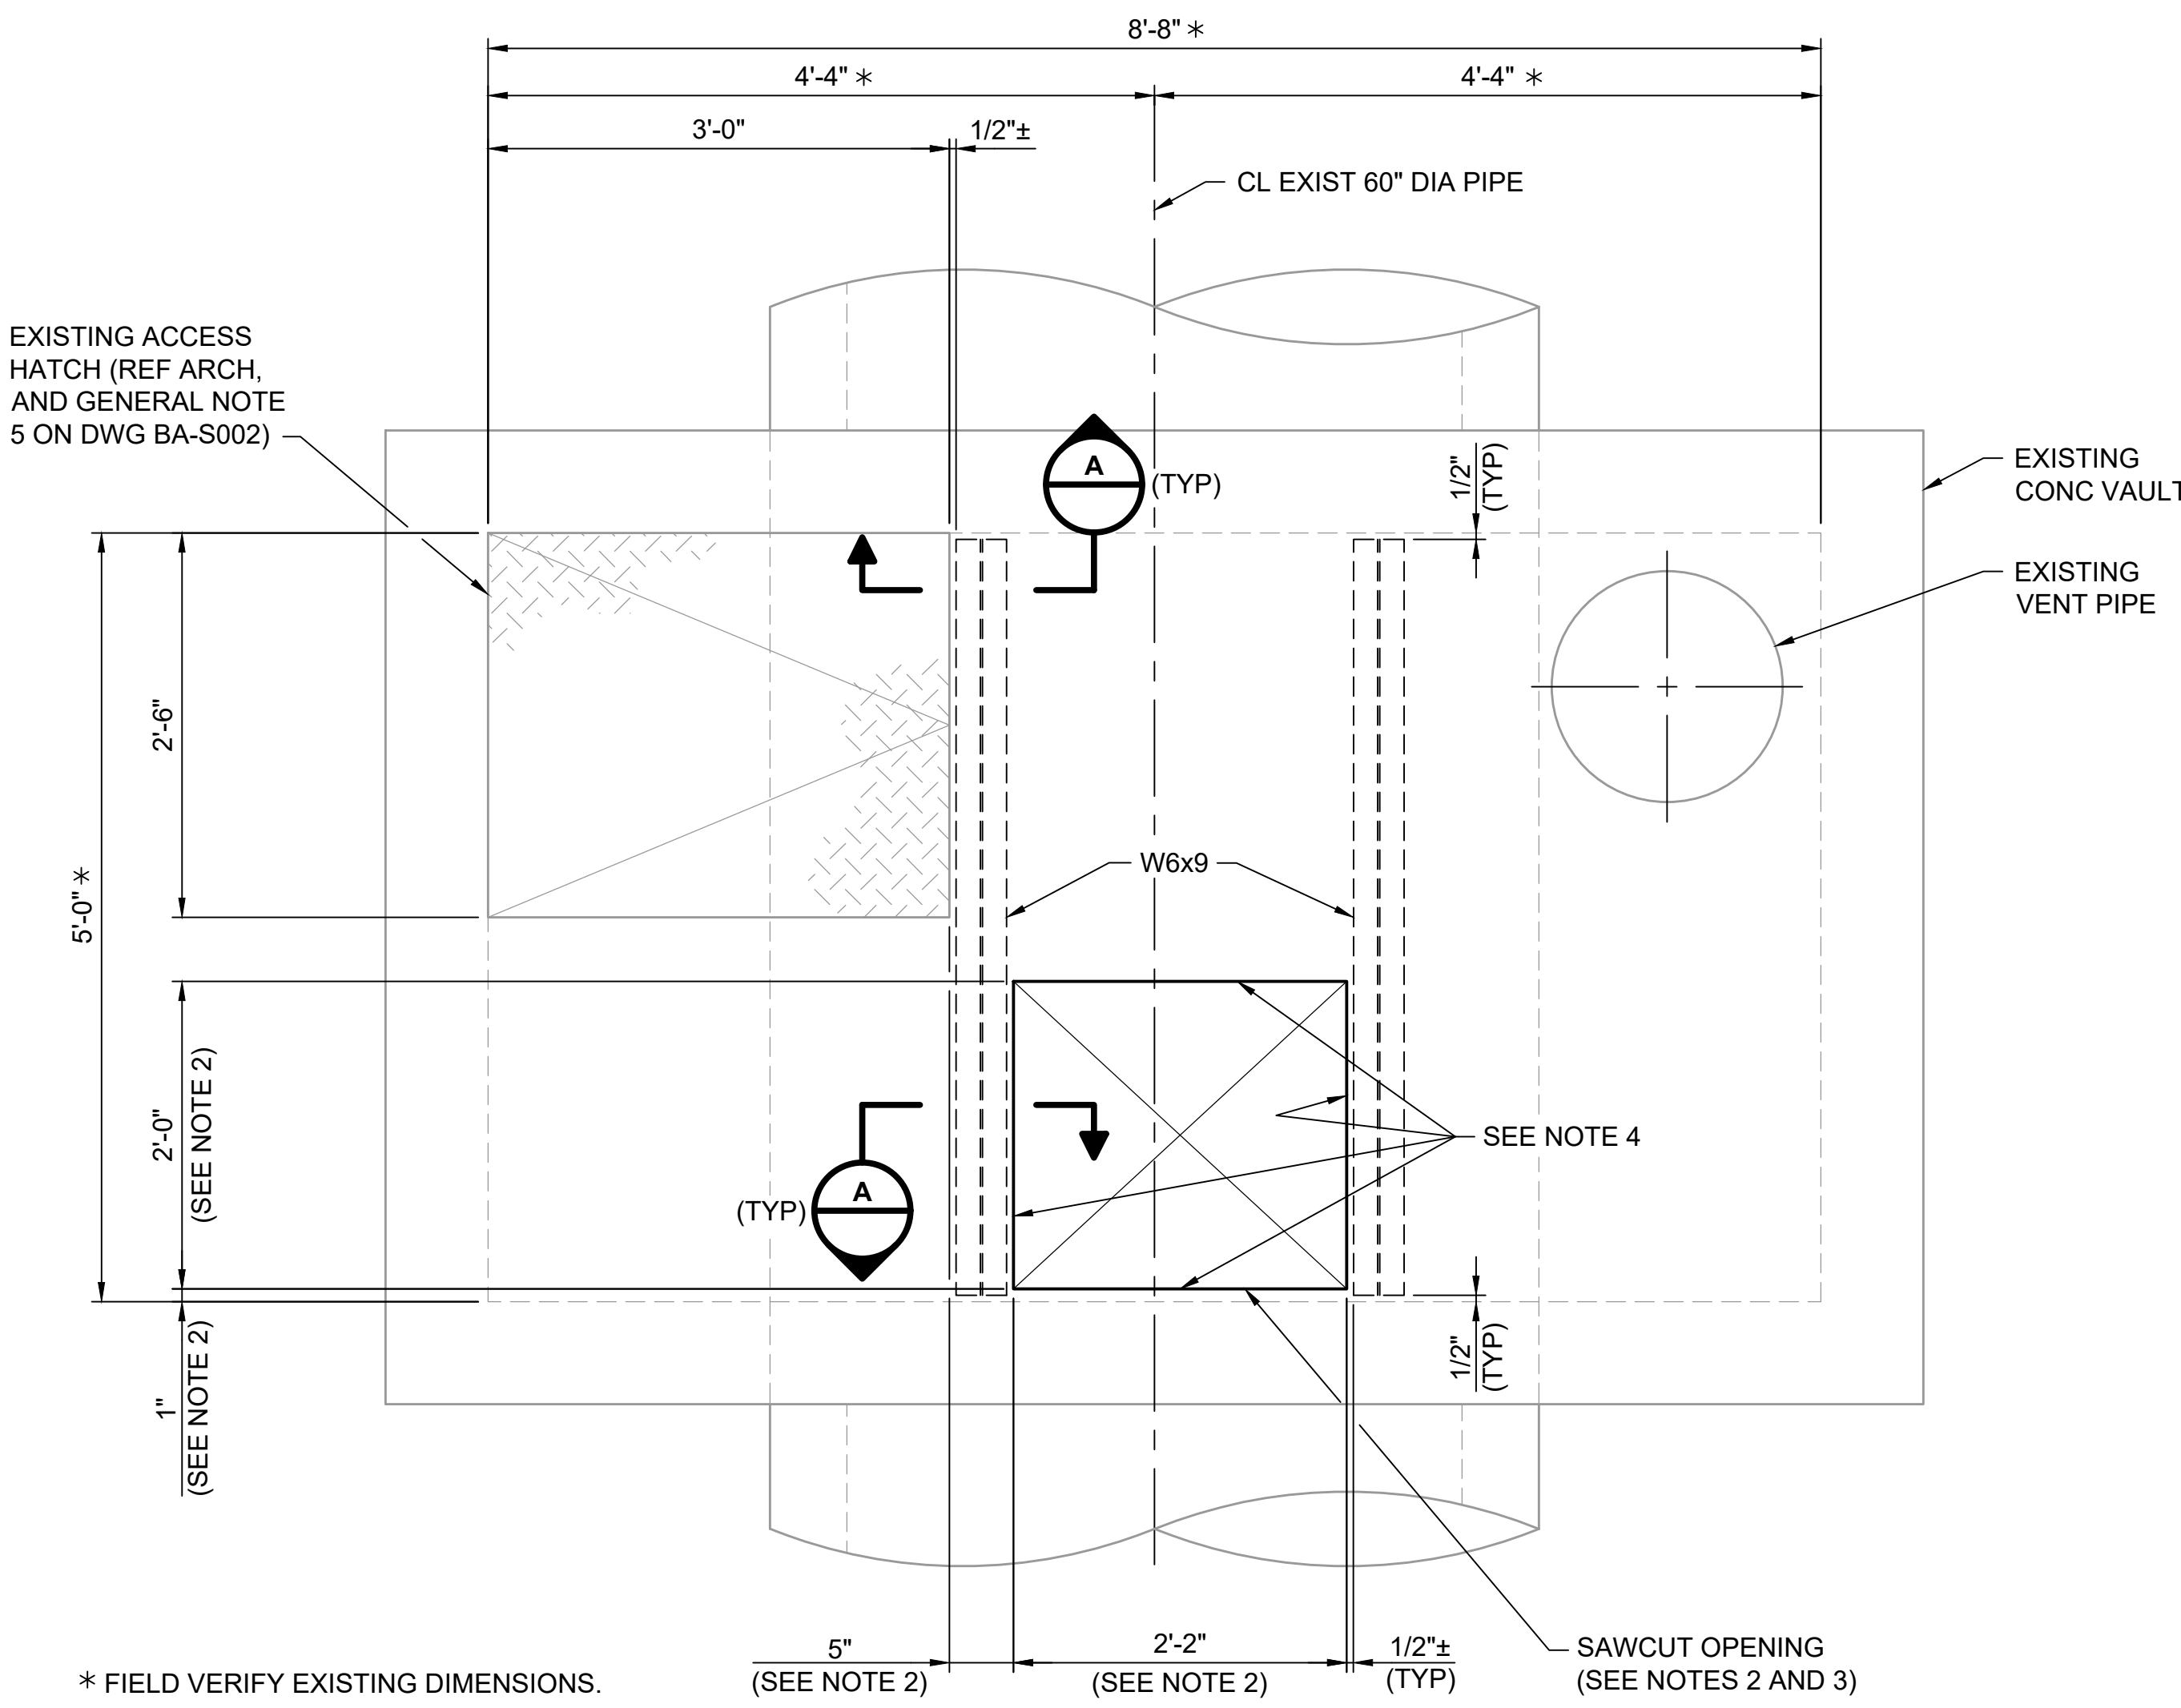

9400 WARD PARKWAY
KANSAS CITY, MO 64114
816-333-9400
LICENSEE NO. E-65

date	MAY 23, 2018	detailed	J. ANAYA
designed	A. GRIFFIN	checked	J. TSOUFLIAS



SEDGWICK, KANSAS

WICHITA CHENEY PIPELINE


VAULT TOP SLAB MODIFICATIONS	
project	contract
97687	
drawing	rev.
S001	1
sheet	of sheets
file 97687_S001.DWG	

COPYRIGHT © 2017 BURNS & MCDONNELL ENGINEERING COMPANY, INC.


EXISTING VAULT DIMENSIONS (INCHES)

VAULT	A	B	C	D	E	F	G	H	I	J	K	L	M	N	O	P	Q	R	S
1	64	112	N/A	N/A	N/A	N/A	N/A	52	67	21	21	N/A	N/A	N/A	N/A	57	27	**	N/A
2	64	112	N/A	N/A	16	22	65	N/A	N/A	N/A	N/A	20	11	33	46	58	28	**	N/A
3	64	112	13	14	14	18	N/A	50	66	19	19	N/A	11	5	46	58	24	**	6
3A	76	120	17	12	N/A	N/A	N/A	N/A	N/A	N/A	N/A	N/A	13	35	40	77	42	**	14
4	76	120	7	7	21	N/A	43	58	75	25	30	26	10	19	10	58	30	**	14
5	76	120	N/A	N/A	23	N/A	47	60	73	25	36	25	13	13	17	57	43	24.00	10
6	64	112	N/A	N/A	15	19	66	N/A	N/A	N/A	N/A	18	9	23	47	58	28	21.00	N/A
7	64	112	N/A	N/A	16	18	65	N/A	N/A	N/A	N/A	20	9	23	43	60	31	27.00	N/A
8	64	112	N/A	N/A	N/A	66	N/A	N/A	N/A	N/A	20	10	24	47	58	31	16.00	N/A	
9	64	112	10	10	15	17	57	66	N/A	N/A	19	20	6	3	42	58	29	13.00	6
10	76	120	7	7	21	25	42	61	75	24	28	24	9	11	9	58	10	26 TO 31	18
11	64	112	10	10	12	17	47	67	N/A	N/A	20	20	7	10	43	58	35	25.00	6
12	64	112	N/A	N/A	12	18	66	N/A	N/A	N/A	N/A	17	7	23	44	58	37	29 TO 33	N/A
13	64	112	N/A	N/A	11	17	66	N/A	N/A	N/A	N/A	17	7	26	44	58	42	24 TO 31	N/A
14*	64	112	10	10	14	18	55	66	N/A	N/A	17	18	7	4	41	58	28	26.00	6
15	64	112	7	8	12	18	52	68	N/A	N/A	20	20	6	1	43	58	29	6.00	6
16	64	112	N/A	N/A	13	19	55	65	N/A	N/A	**	**	8	N/A	43	58	29	26.00	N/A
17	76	120	**	**	23	22	46	61	73	**	**	**	9	20	13	59	22	9.00	14
18	76	120	7	8	21	25	43	63	76	25	30	26	8	19	8	58	10	21.00	18
19*	64	112	N/A	N/A	12	18	67	N/A	N/A	N/A	N/A	20	7	25	44	59	34	**	N/A
20	64	112	N/A	N/A	11	17	67	N/A	N/A	N/A	N/A	19	7	25	45	59	31	21 TO 24	N/A
21*	64	112	10	10	15	18	50	67	N/A	N/A	20	20	2	4	42	59	24	19.00	6
22	76	120	**	**	20	25	41	59	79	**	**	**	11	20	8	59	9	10.00	18
23	64	112	10	10	**	**	52	67	N/A	N/A	20	20	2	19	30	58	22	30 TO 36	6
24	76	120	8	8	22	25	45	60	76	22	27	22	9	14	13	58	20	22 TO 32	14
25	64	112	N/A	N/A	12	19	66	N/A	N/A	N/A	N/A	20	6	24	44	58	30	14.00	N/A
26	64	112	10	10	12	21	52	67	N/A	N/A	21	21	2	10	42	59	24	16 TO 23	6
27	76	120	**	**	17	25	40	61	76	**	**	**	7	20	30	58	12	24 TO 42	18
28	76	120	8	8	20	25	41	60	73	**	**	**	8	12	13	58	22	24 TO 48	14
29	64	112	10	10	12	18	49	68	N/A	N/A	20	20	2	4	43	58	23	26 TO 38	6
30	76	120	8	8	21	24	42	60	73	**	**	**	8	12	13	58	22	14 TO 26	14
STA. 42.04	**	**	**	**	**	**	**	**	**	**	**	**	**	**	**	**	**	**	**

**CONTRACTOR TO FIELD VERIFY DIMENSIONS

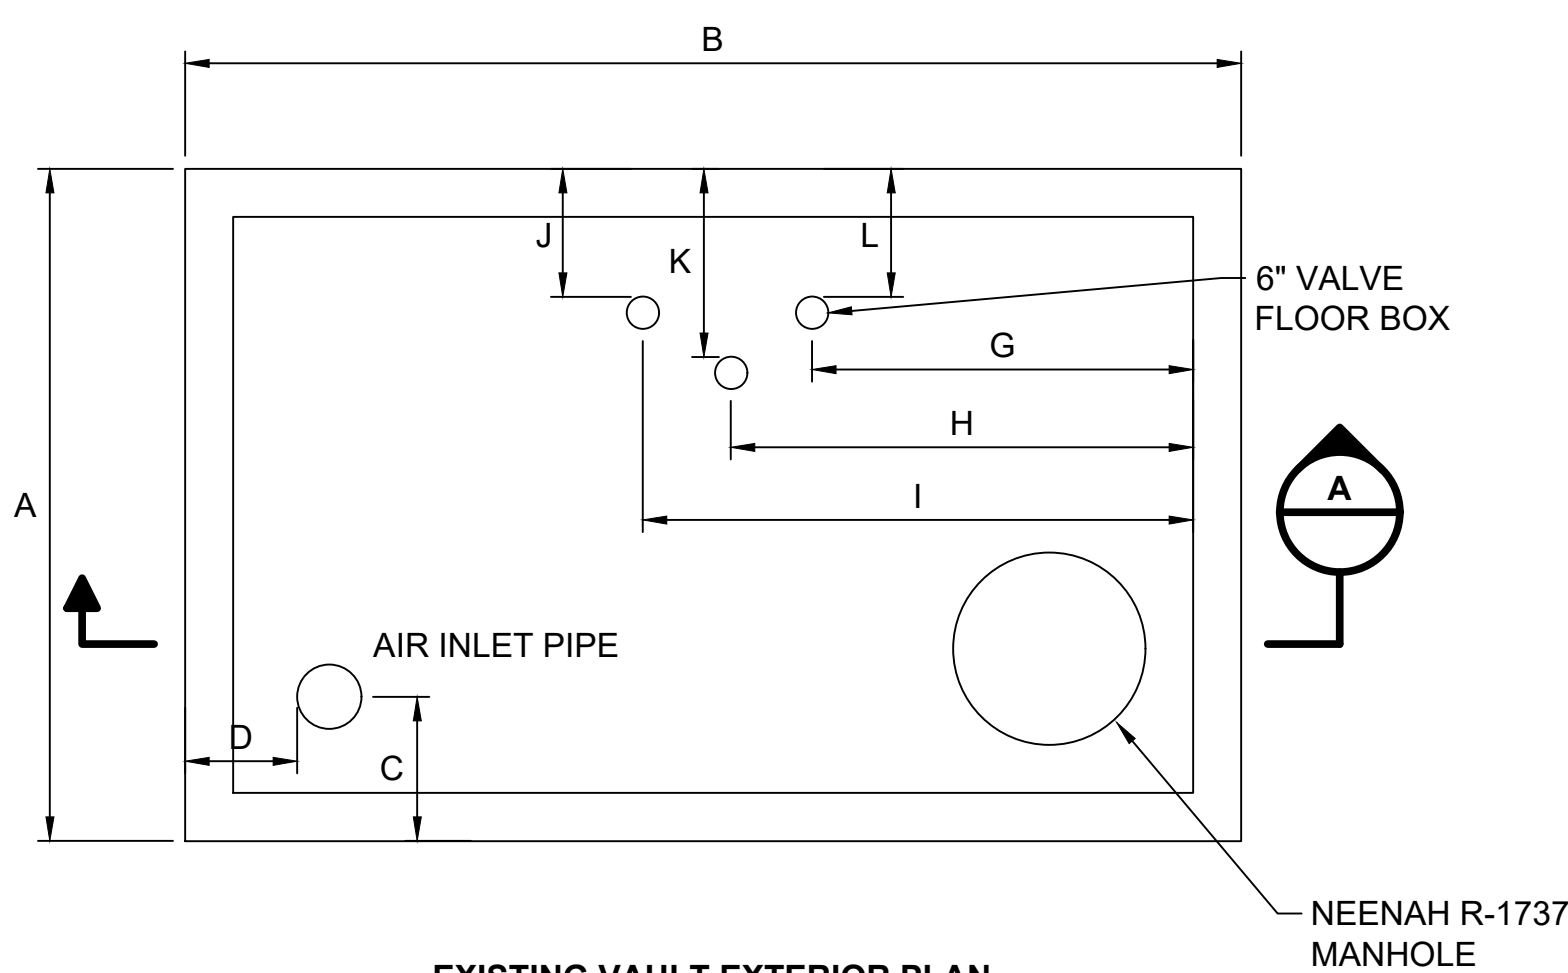


EXISTING VAULT EXTERIOR PLAN
NOT TO SCALE

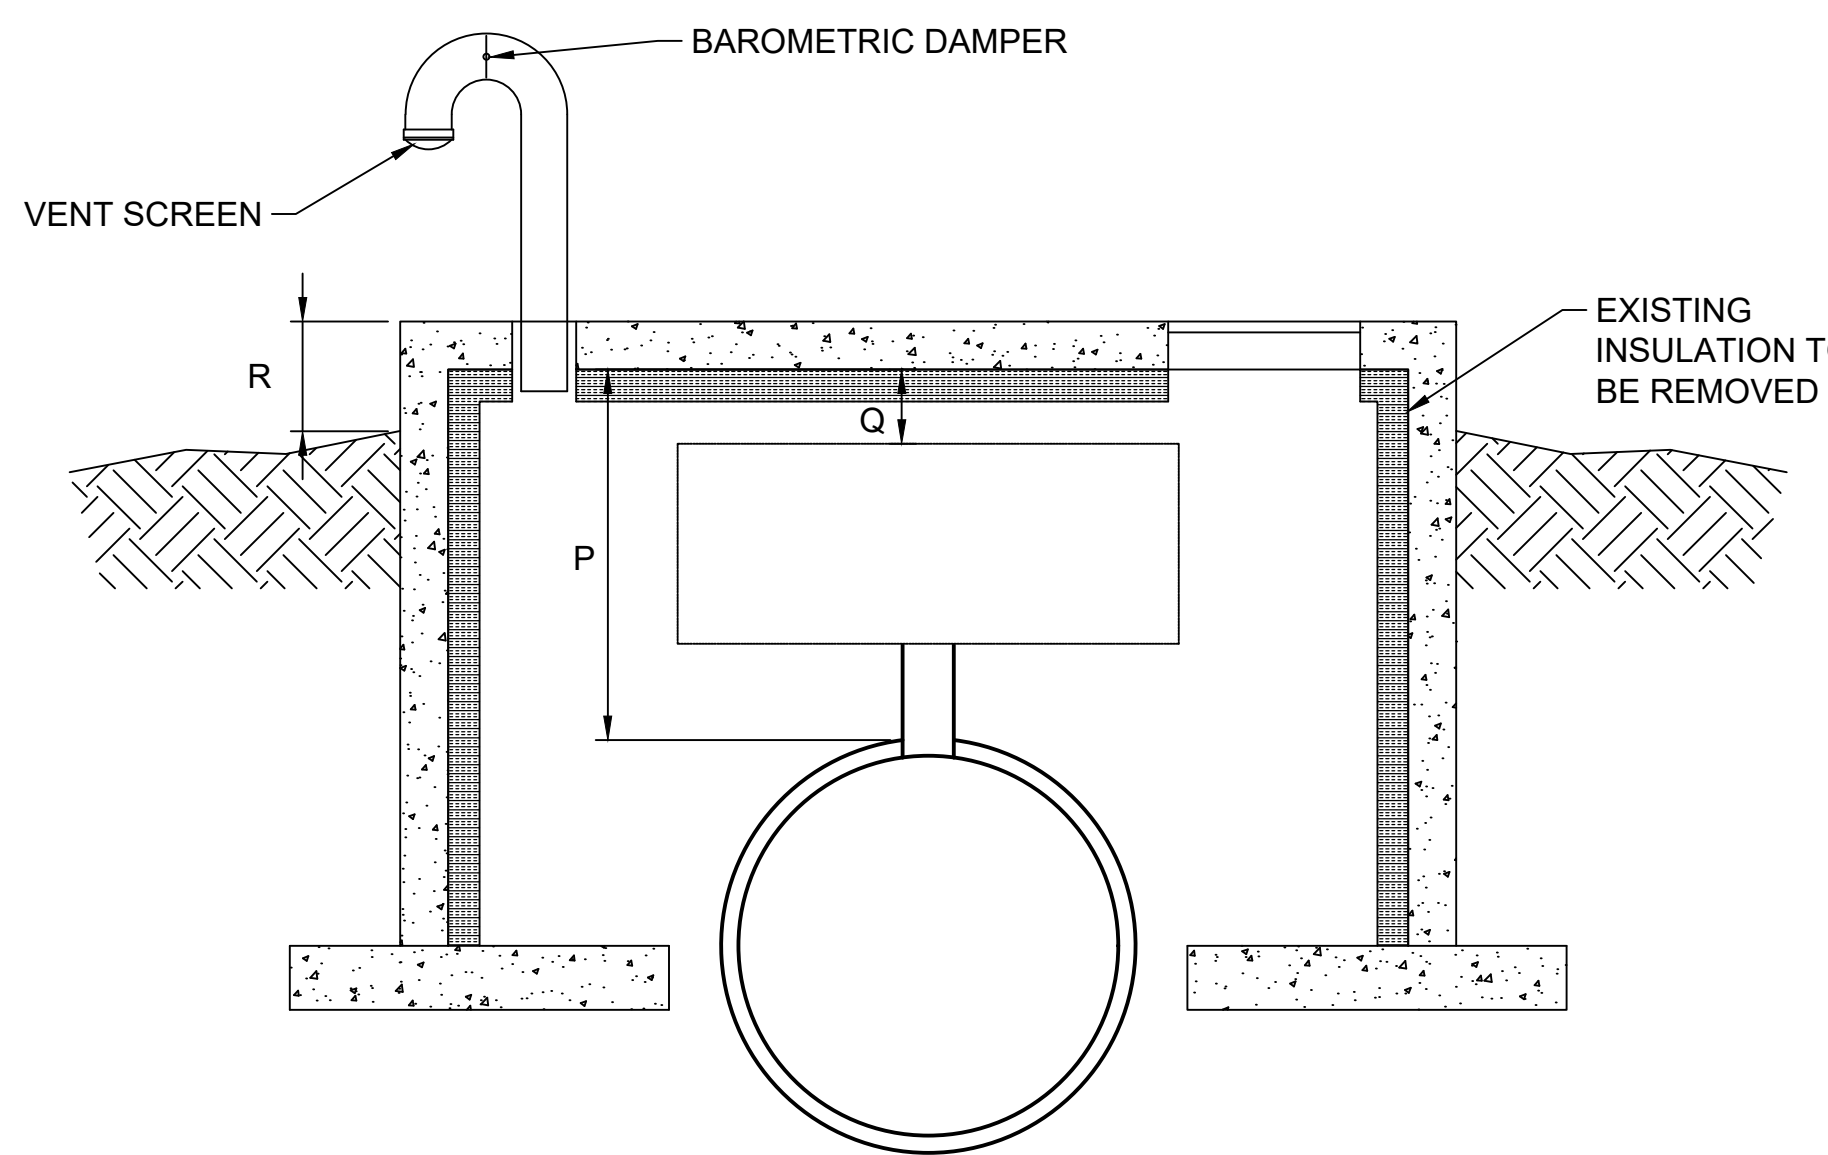

SECTION
EXISTING VAULT
INTERIOR SECTION
NOT TO SCALE

NOTES:

1. BOX REPRESENTS AREA OCCUPIED BY PIPING AND VALVES.
2. DIMENSIONS OF BOXED AREA REPRESENT THE CLOSEST POINT FROM THE PIPING TO THE VAULT WALL

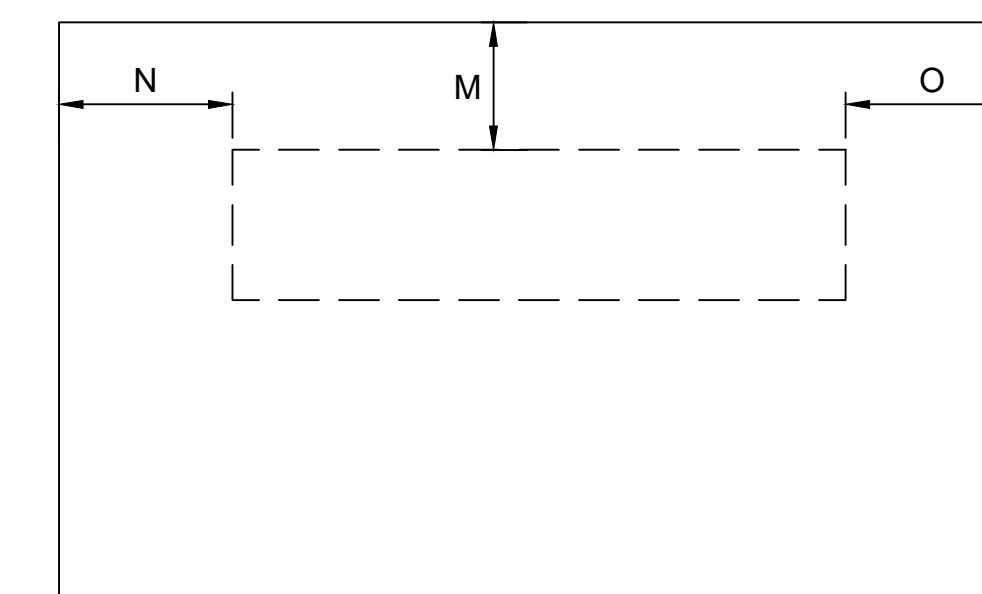

EXISTING VAULT INTERIOR
PLAN
NOT TO SCALE

NOTES:

1. BOX REPRESENTS AREA OCCUPIED BY PIPING AND VALVES.
2. DIMENSIONS OF BOXED AREA REPRESENT THE CLOSEST POINT FROM THE PIPING TO THE VAULT WALL

no.	date	by	ckd	description
0	11/8/17	CAM	LJK	ISSUED FOR BID
	2/5/19	CAM	LJK	CONFORMING TO CONSTRUCTION RECORDS



9400 WARD PARKWAY
KANSAS CITY, MO 64114
816-333-9400
LICENSEE NO. E-65

date	designed	detailed
SEPTEMBER 11, 2017	C. MAGES	B. FIFIELD
	checked	
		L. KLEIN




SEDGWICK, KANSAS

CHENEY TRANSMISSION LINE


EXISTING CONDITIONS

project	contract
97687	CONTRACT
drawing	rev.
D001	0
sheet	of sheets
file 97687_D001.DWG	

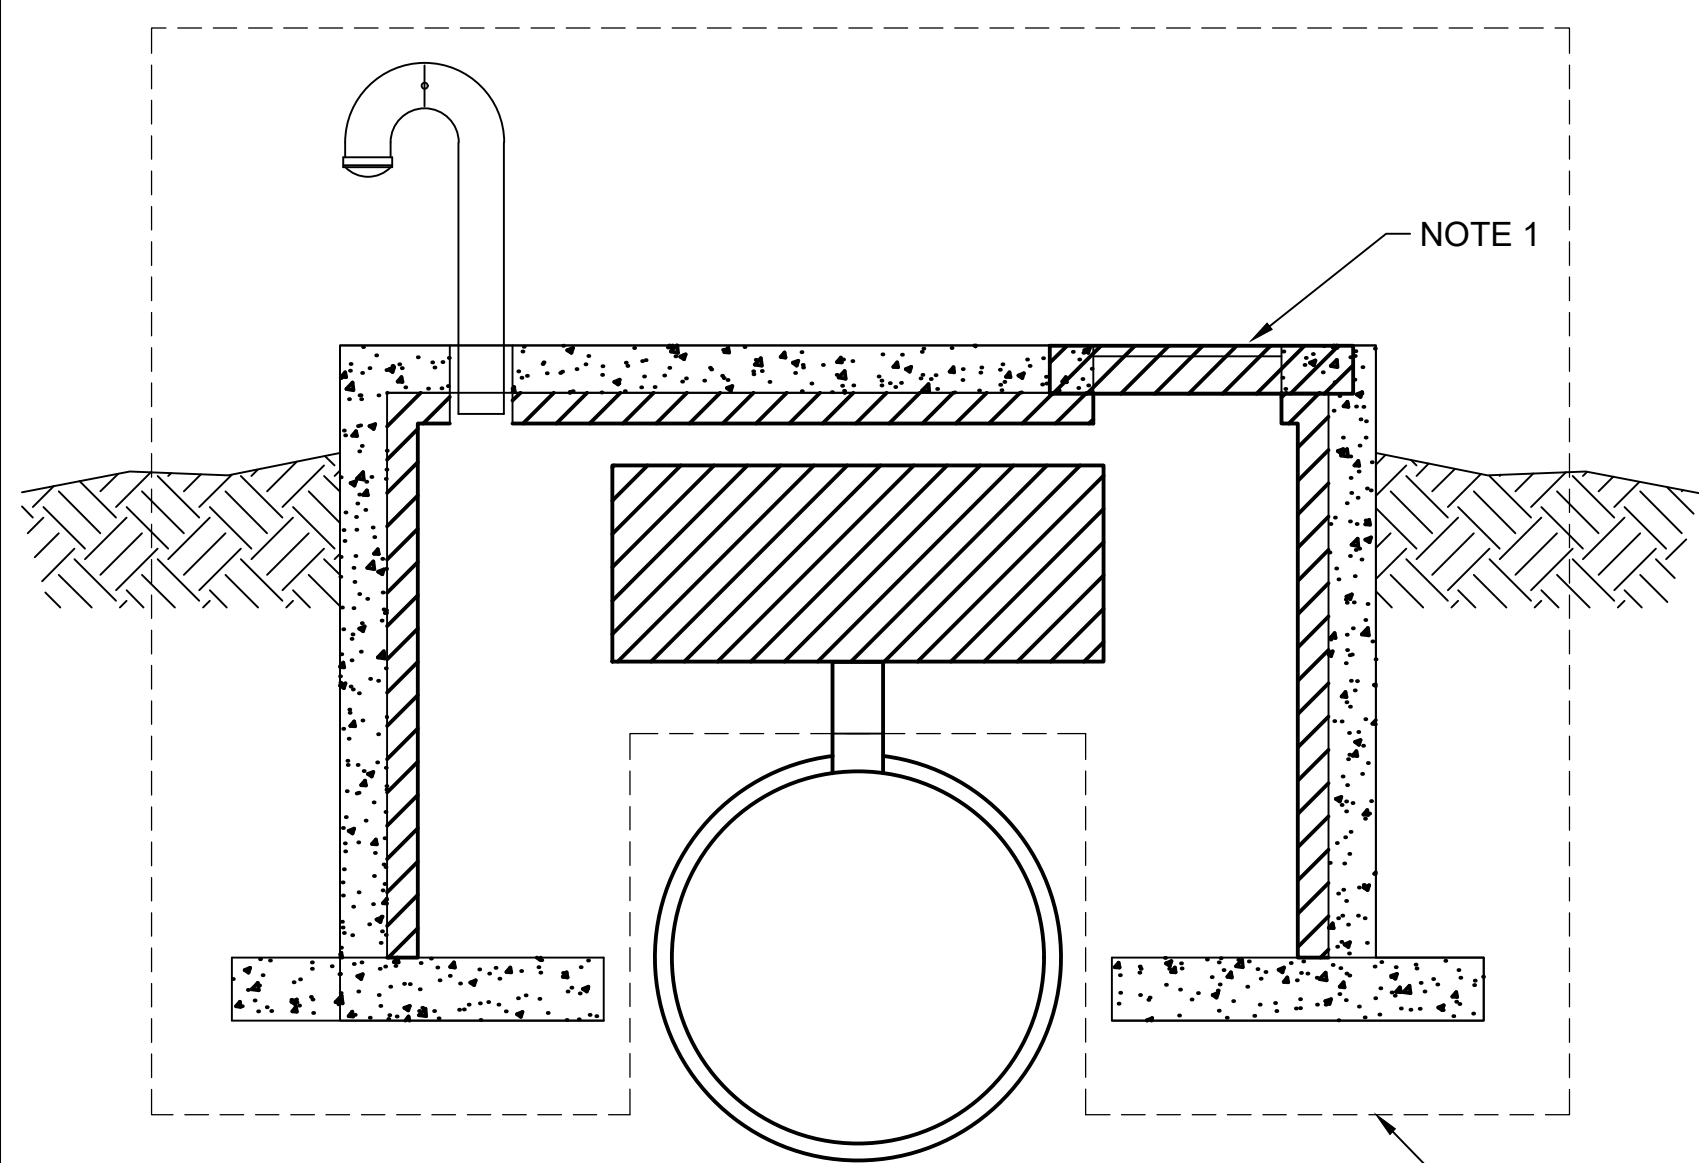

- NOTES:**
1. SAWCUT A 2'-6"x3'-0" OPENING FOR REMOVAL OF EQUIPMENT AND INSTALLATION OF HATCH.
 2. ALTERNATES 1, 2, AND 3 FOR VAULTS 14, 19, AND 21. BID ALTERNATES 1, 2 AND 3 SHALL BE FOR COMPLETE DEMOLITION AND REPLACEMENT OF THESE VAULTS.
 3. VAULTS SHALL BE CLEANED, WALLS SCRAPPED TO BE FREE OF ADHESIVE, AND CLEARED OF ALL DEBRIS.
 4. DEMO ALL INSULATION AS INDICATED.

SECTION A
DEMO OF VAULT INTERIOR
 NOT TO SCALE

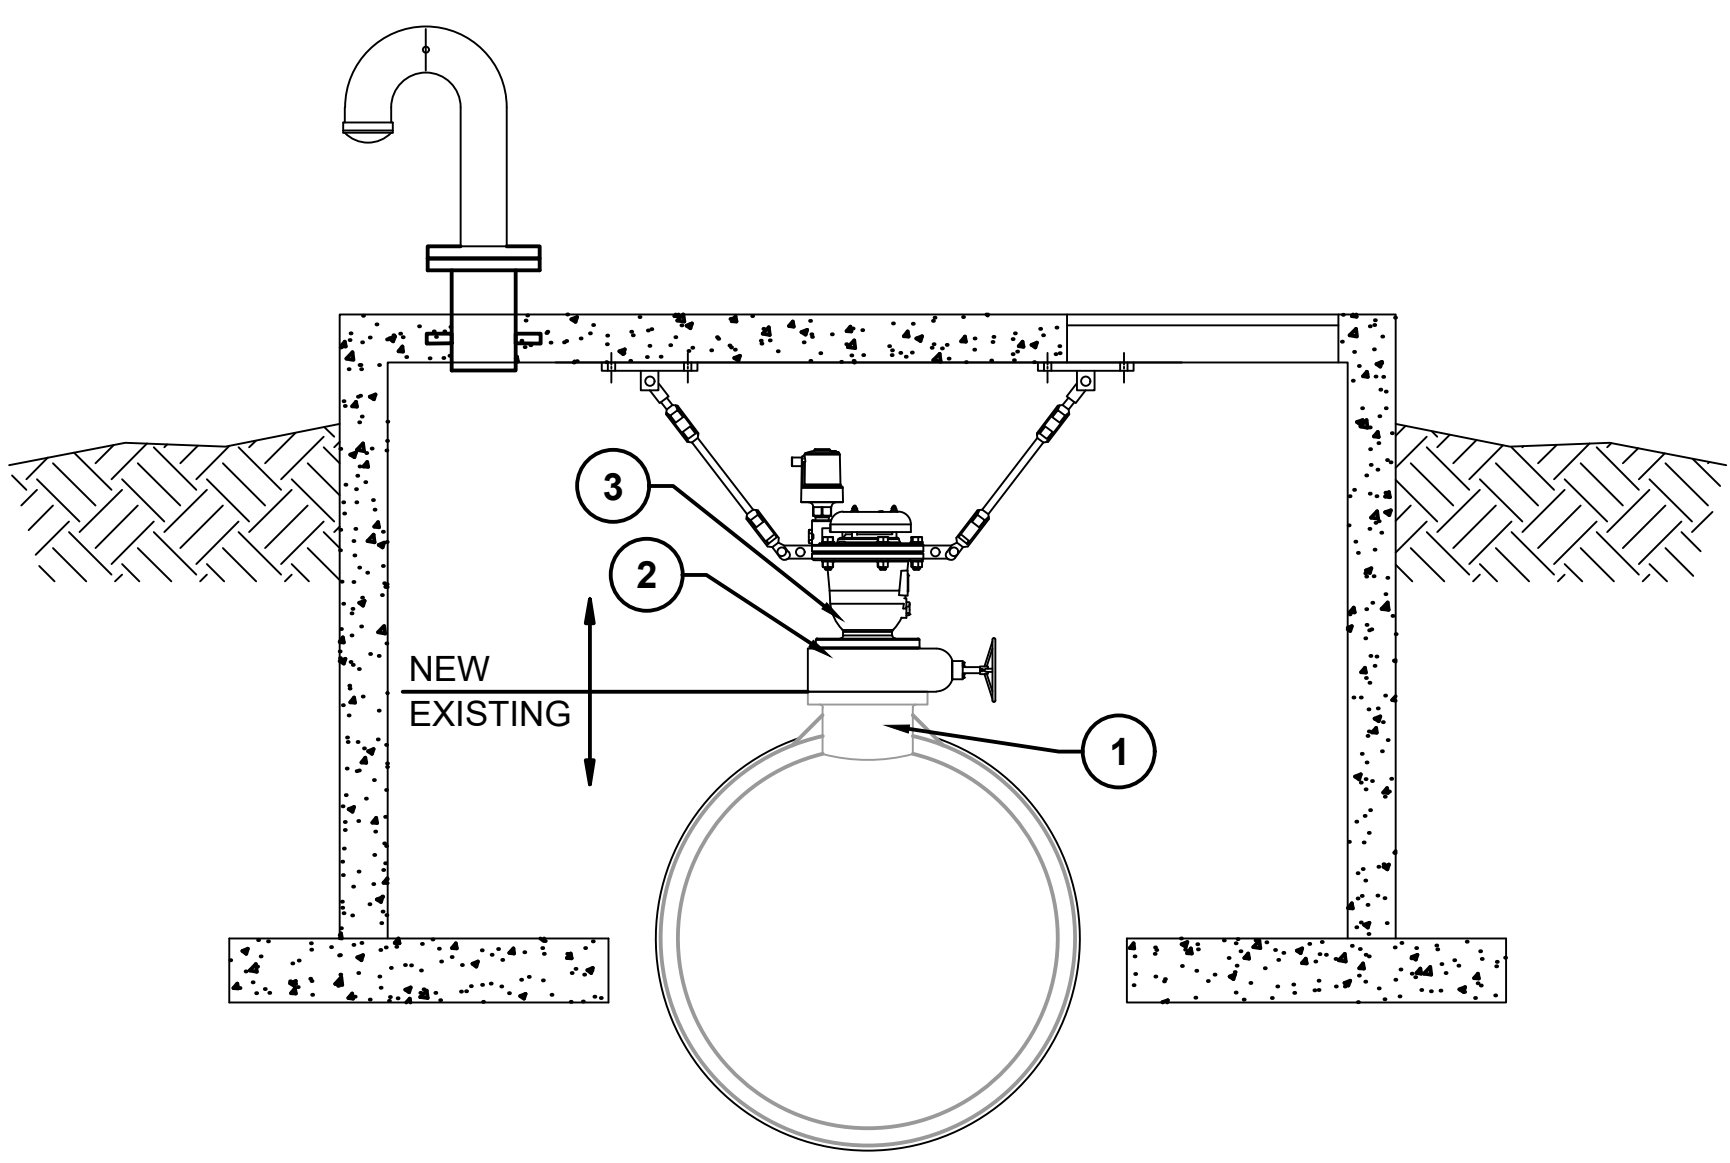


- NOTE:**
1. THIS SHALL APPLY TO VAULTS 1, 3, 3A, 4, 5, 9, 10, 11, 14, 15, 17, 18, 21, 22, 23, 24, 26, 27, 28, 29, 30, AND STA. 42.04

SECTION B
4-INCH AND LARGER OUTLET PIPING
 NOT TO SCALE


VAULT	①	②	③
1	4-INCH	4-INCH FLANGED GV	4-INCH COMBINATION AIR/VACUUM VALVE
2	2-INCH	2-INCH THREADED BALL VALVE	2-INCH AIR/VACUUM VALVE
3	4-INCH	4-INCH FLANGED GV	4-INCH COMBINATION AIR/VACUUM VALVE
3A	10-INCH	10-INCH FLANGED GV	10-INCH COMBINATION AIR/VACUUM VALVE
4	10-INCH	10-INCH FLANGED GV	10-INCH COMBINATION AIR/VACUUM VALVE
5	6-INCH	6-INCH FLANGED GV	6-INCH COMBINATION AIR/VACUUM VALVE
6	2-INCH	2-INCH THREADED BALL VALVE	2-INCH AIR/VACUUM VALVE
7	2-INCH	2-INCH THREADED BALL VALVE	2-INCH AIR/VACUUM VALVE
8	2-INCH	2-INCH THREADED BALL VALVE	2-INCH AIR/VACUUM VALVE
9	4-INCH	4-INCH FLANGED GV	4-INCH COMBINATION AIR/VACUUM VALVE
10	10-INCH	10-INCH FLANGED GV	10-INCH COMBINATION AIR/VACUUM VALVE
11	4-INCH	4-INCH FLANGED GV	4-INCH COMBINATION AIR/VACUUM VALVE
12	2-INCH	2-INCH THREADED BALL VALVE	2-INCH AIR/VACUUM VALVE
13	2-INCH	2-INCH THREADED BALL VALVE	2-INCH AIR/VACUUM VALVE
14	4-INCH	4-INCH FLANGED GV	(2) 2-INCH AIR/VACUUM VALVES
15	4-INCH	4-INCH FLANGED GV	4-INCH COMBINATION AIR/VACUUM VALVE
16	2-INCH	2-INCH THREADED BALL VALVE	2-INCH AIR/VACUUM VALVE
17	8-INCH	8-INCH FLANGED GV	8-INCH COMBINATION AIR/VACUUM VALVE
18	10-INCH	10-INCH FLANGED GV	10-INCH COMBINATION AIR/VACUUM VALVE
19	2-INCH	2-INCH THREADED BALL VALVE	2-INCH AIR/VACUUM VALVE
20	2-INCH	2-INCH THREADED BALL VALVE	2-INCH AIR/VACUUM VALVE
21	4-INCH	4-INCH FLANGED GV	(2) 2-INCH AIR/VACUUM VALVES
22	10-INCH	10-INCH FLANGED GV	10-INCH COMBINATION AIR/VACUUM VALVE
23	4-INCH	4-INCH FLANGED GV	4-INCH COMBINATION AIR/VACUUM VALVE
24	8-INCH	8-INCH FLANGED GV	8-INCH COMBINATION AIR/VACUUM VALVE
25	2-INCH	2-INCH THREADED BALL VALVE	2-INCH AIR/VACUUM VALVE
26	4-INCH	4-INCH FLANGED GV	4-INCH COMBINATION AIR/VACUUM VALVE
27	10-INCH	10-INCH FLANGED GV	10-INCH COMBINATION AIR/VACUUM VALVE
28	8-INCH	8-INCH FLANGED GV	8-INCH COMBINATION AIR/VACUUM VALVE
29	4-INCH	4-INCH FLANGED GV	4-INCH COMBINATION AIR/VACUUM VALVE
30	8-INCH	8-INCH FLANGED GV	8-INCH COMBINATION AIR/VACUUM VALVE
STA. 42.04	8-INCH	8-INCH FLANGED GV	8-INCH COMBINATION AIR/VACUUM VALVE

Scale For Microfinishing

Inches

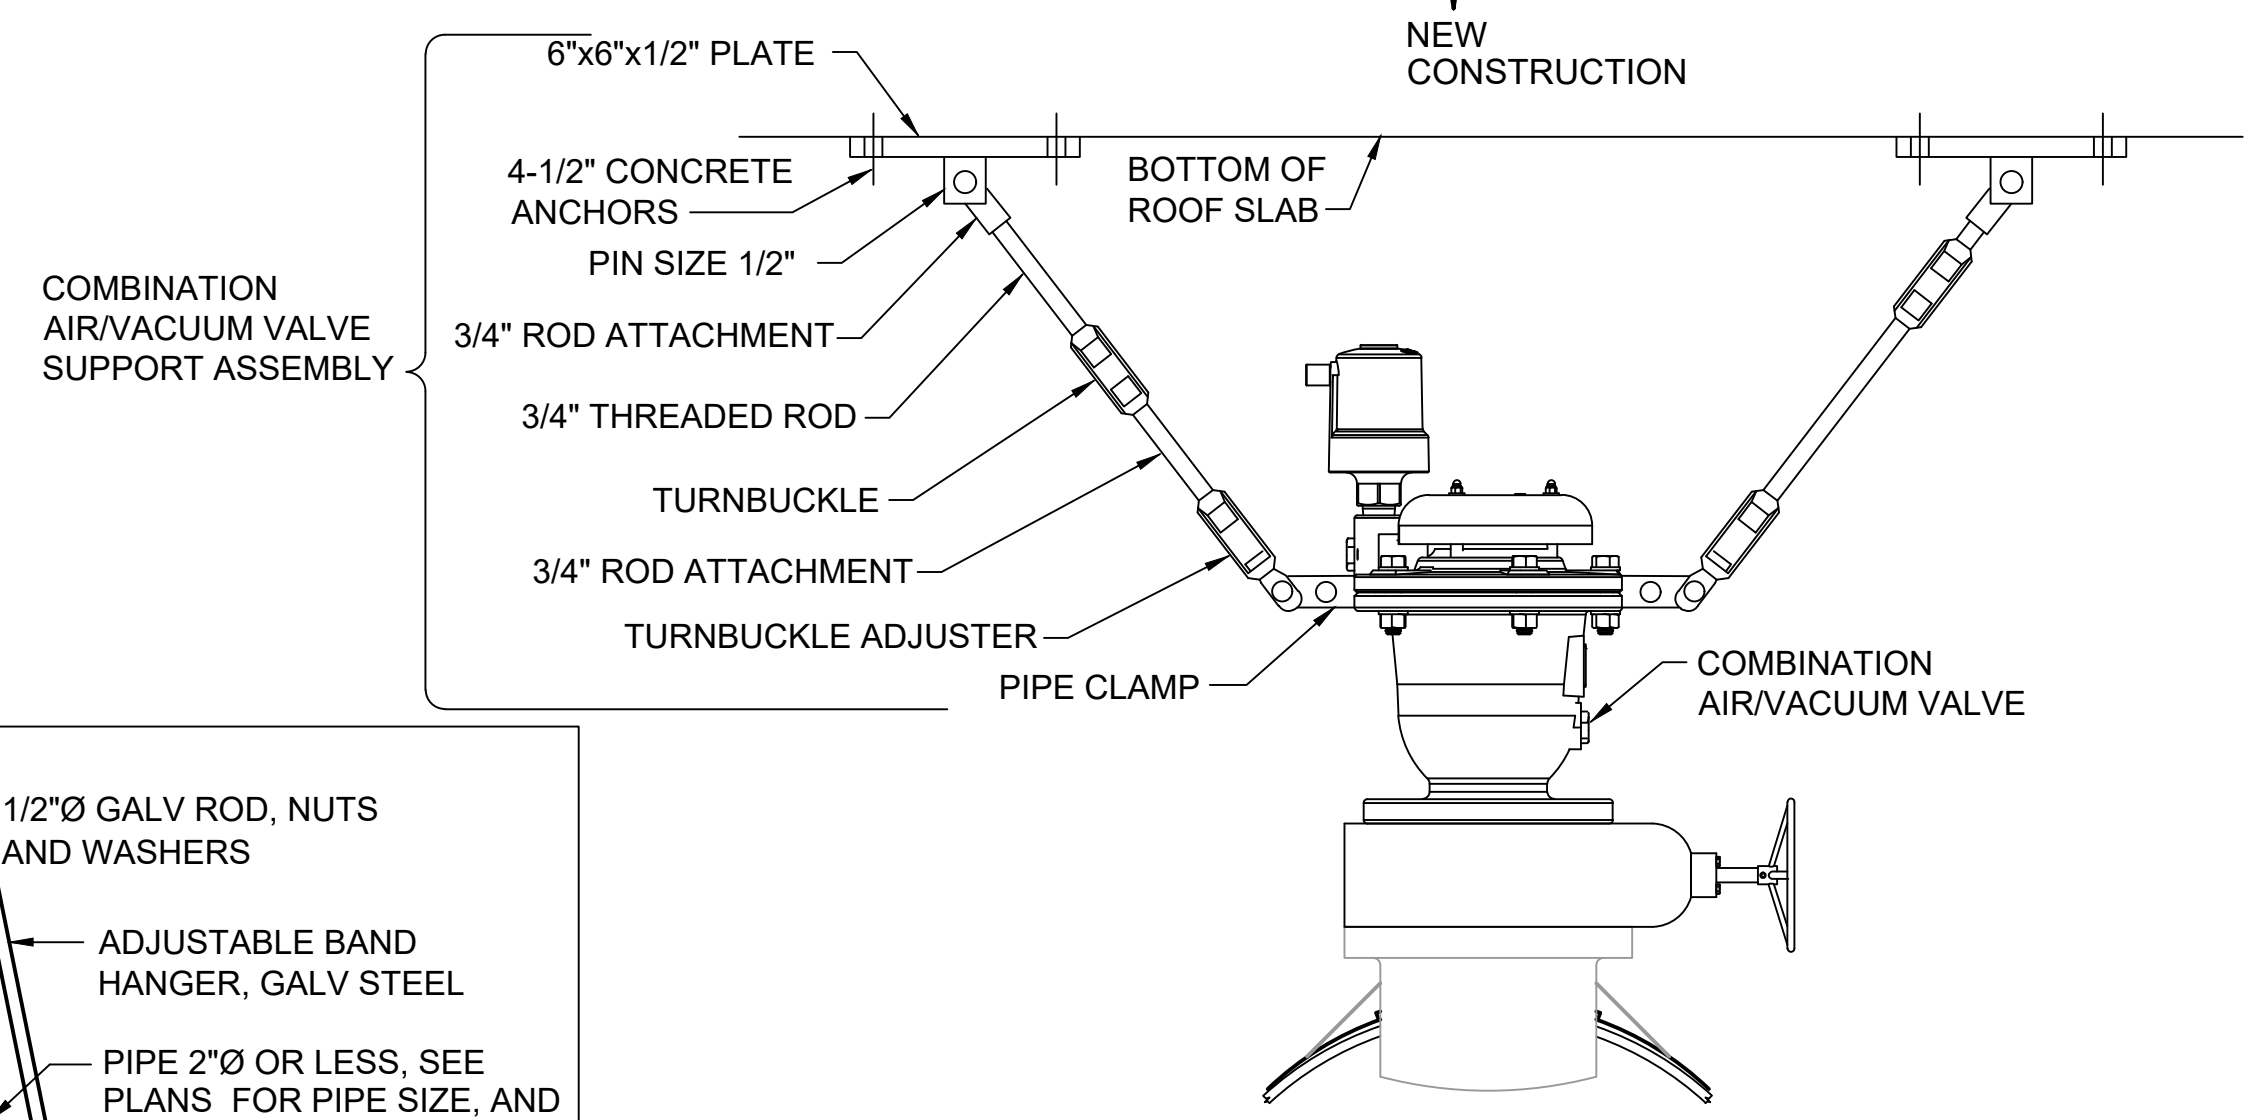


COMBINATION AIR/VACUUM VALVE SUPPORT 4" AND LARGER DETAIL
 NOT TO SCALE

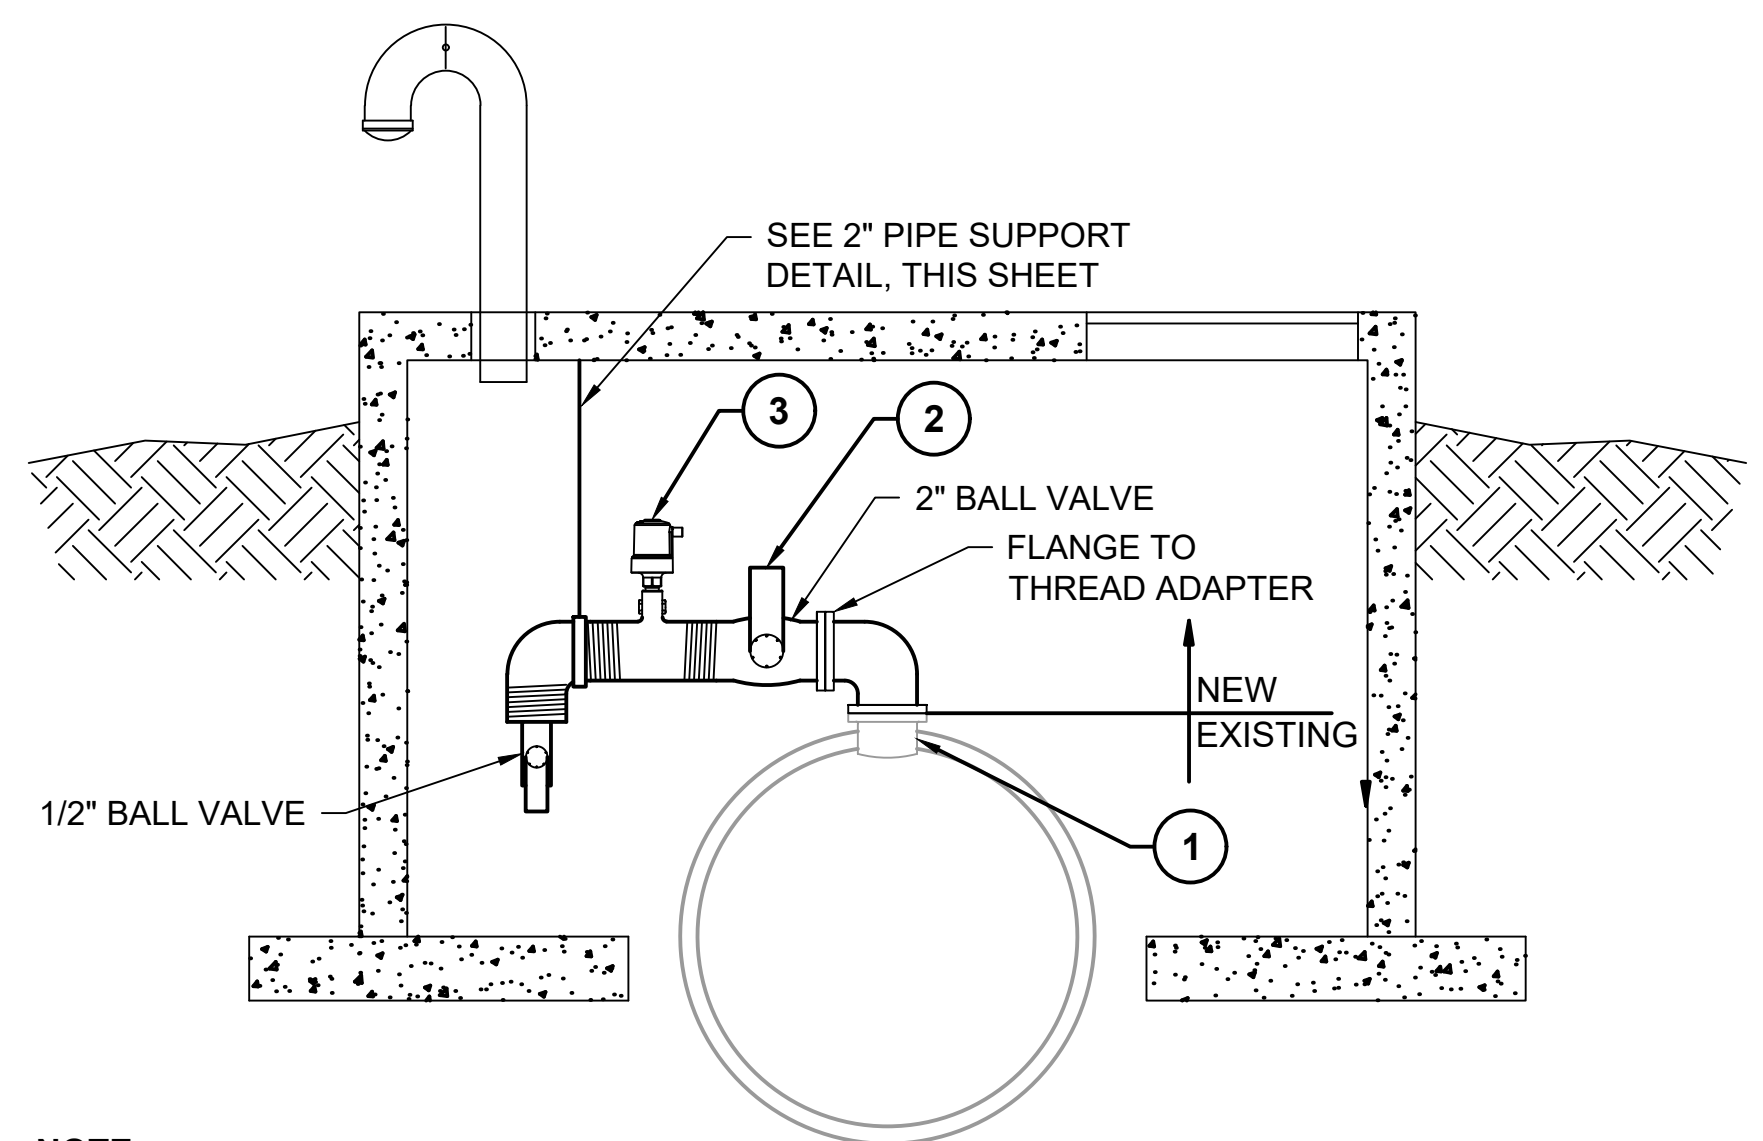

- NOTE:**
1. THIS SHALL APPLY TO VAULTS 2, 6, 7, 8, 12, 13, 16, 19, 20, 25
 2. ARV AND ASSOCIATED PIPING ENLARGED FOR CLARITY.
 3. PIPE ELBOWS, TEES, AND NIPPLES SHALL BE SCHEDULE 40 CARBON STEEL.

SECTION C
2-INCH OUTLET PIPING
 NOT TO SCALE

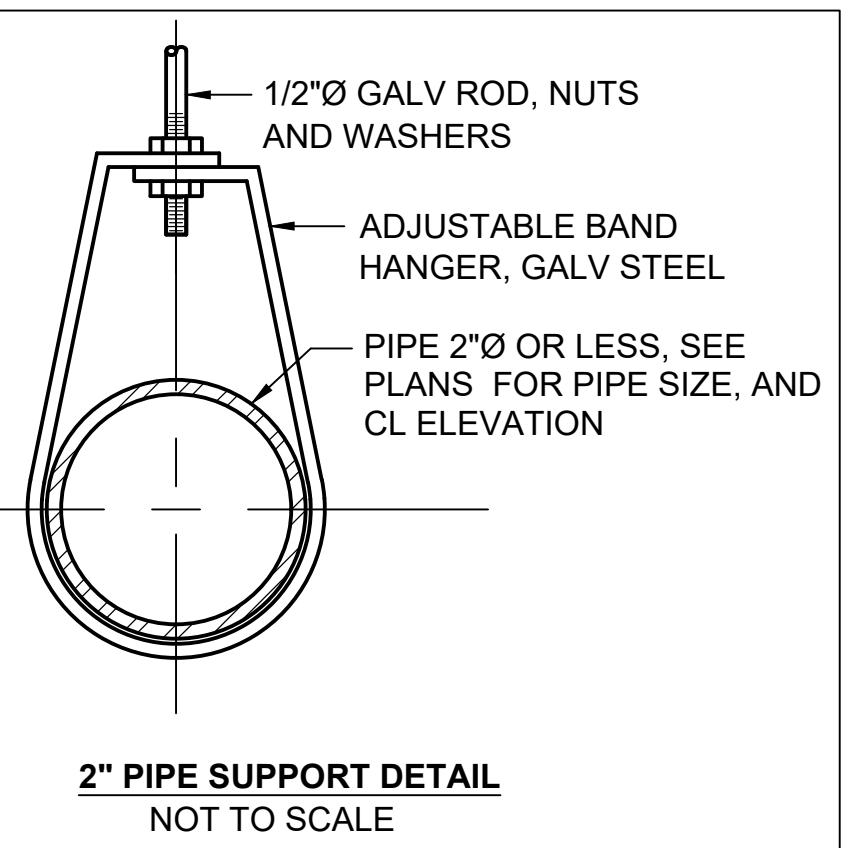

2" PIPE SUPPORT DETAIL
 NOT TO SCALE

no.	date	by	ckd	description
0	11/8/17	CAM	LJK	ISSUED FOR BID
	2/5/19	CAM	LJK	CONFORMING TO CONSTRUCTION RECORDS

BURNS MEDONNELL
 9400 WARD PARKWAY
 KANSAS CITY, MO 64114
 816-333-9400
 LICENSEE NO. E-65


date	detailed
SEPTEMBER 11, 2017	B. FIFIELD
designed	checked
C. MAGES	L. KLEIN

City of Wichita, Kansas
 SEDGWICK, KANSAS

CHENEY TRANSMISSION LINE
 INTERIOR MODIFICATIONS

project	contract	
97687		
drawing	rev.	
D002	0	
sheet	of	sheets
file 97687_D002.DWG		

COPYRIGHT © 2017 BURNS & MEDONNELL ENGINEERING COMPANY, INC.

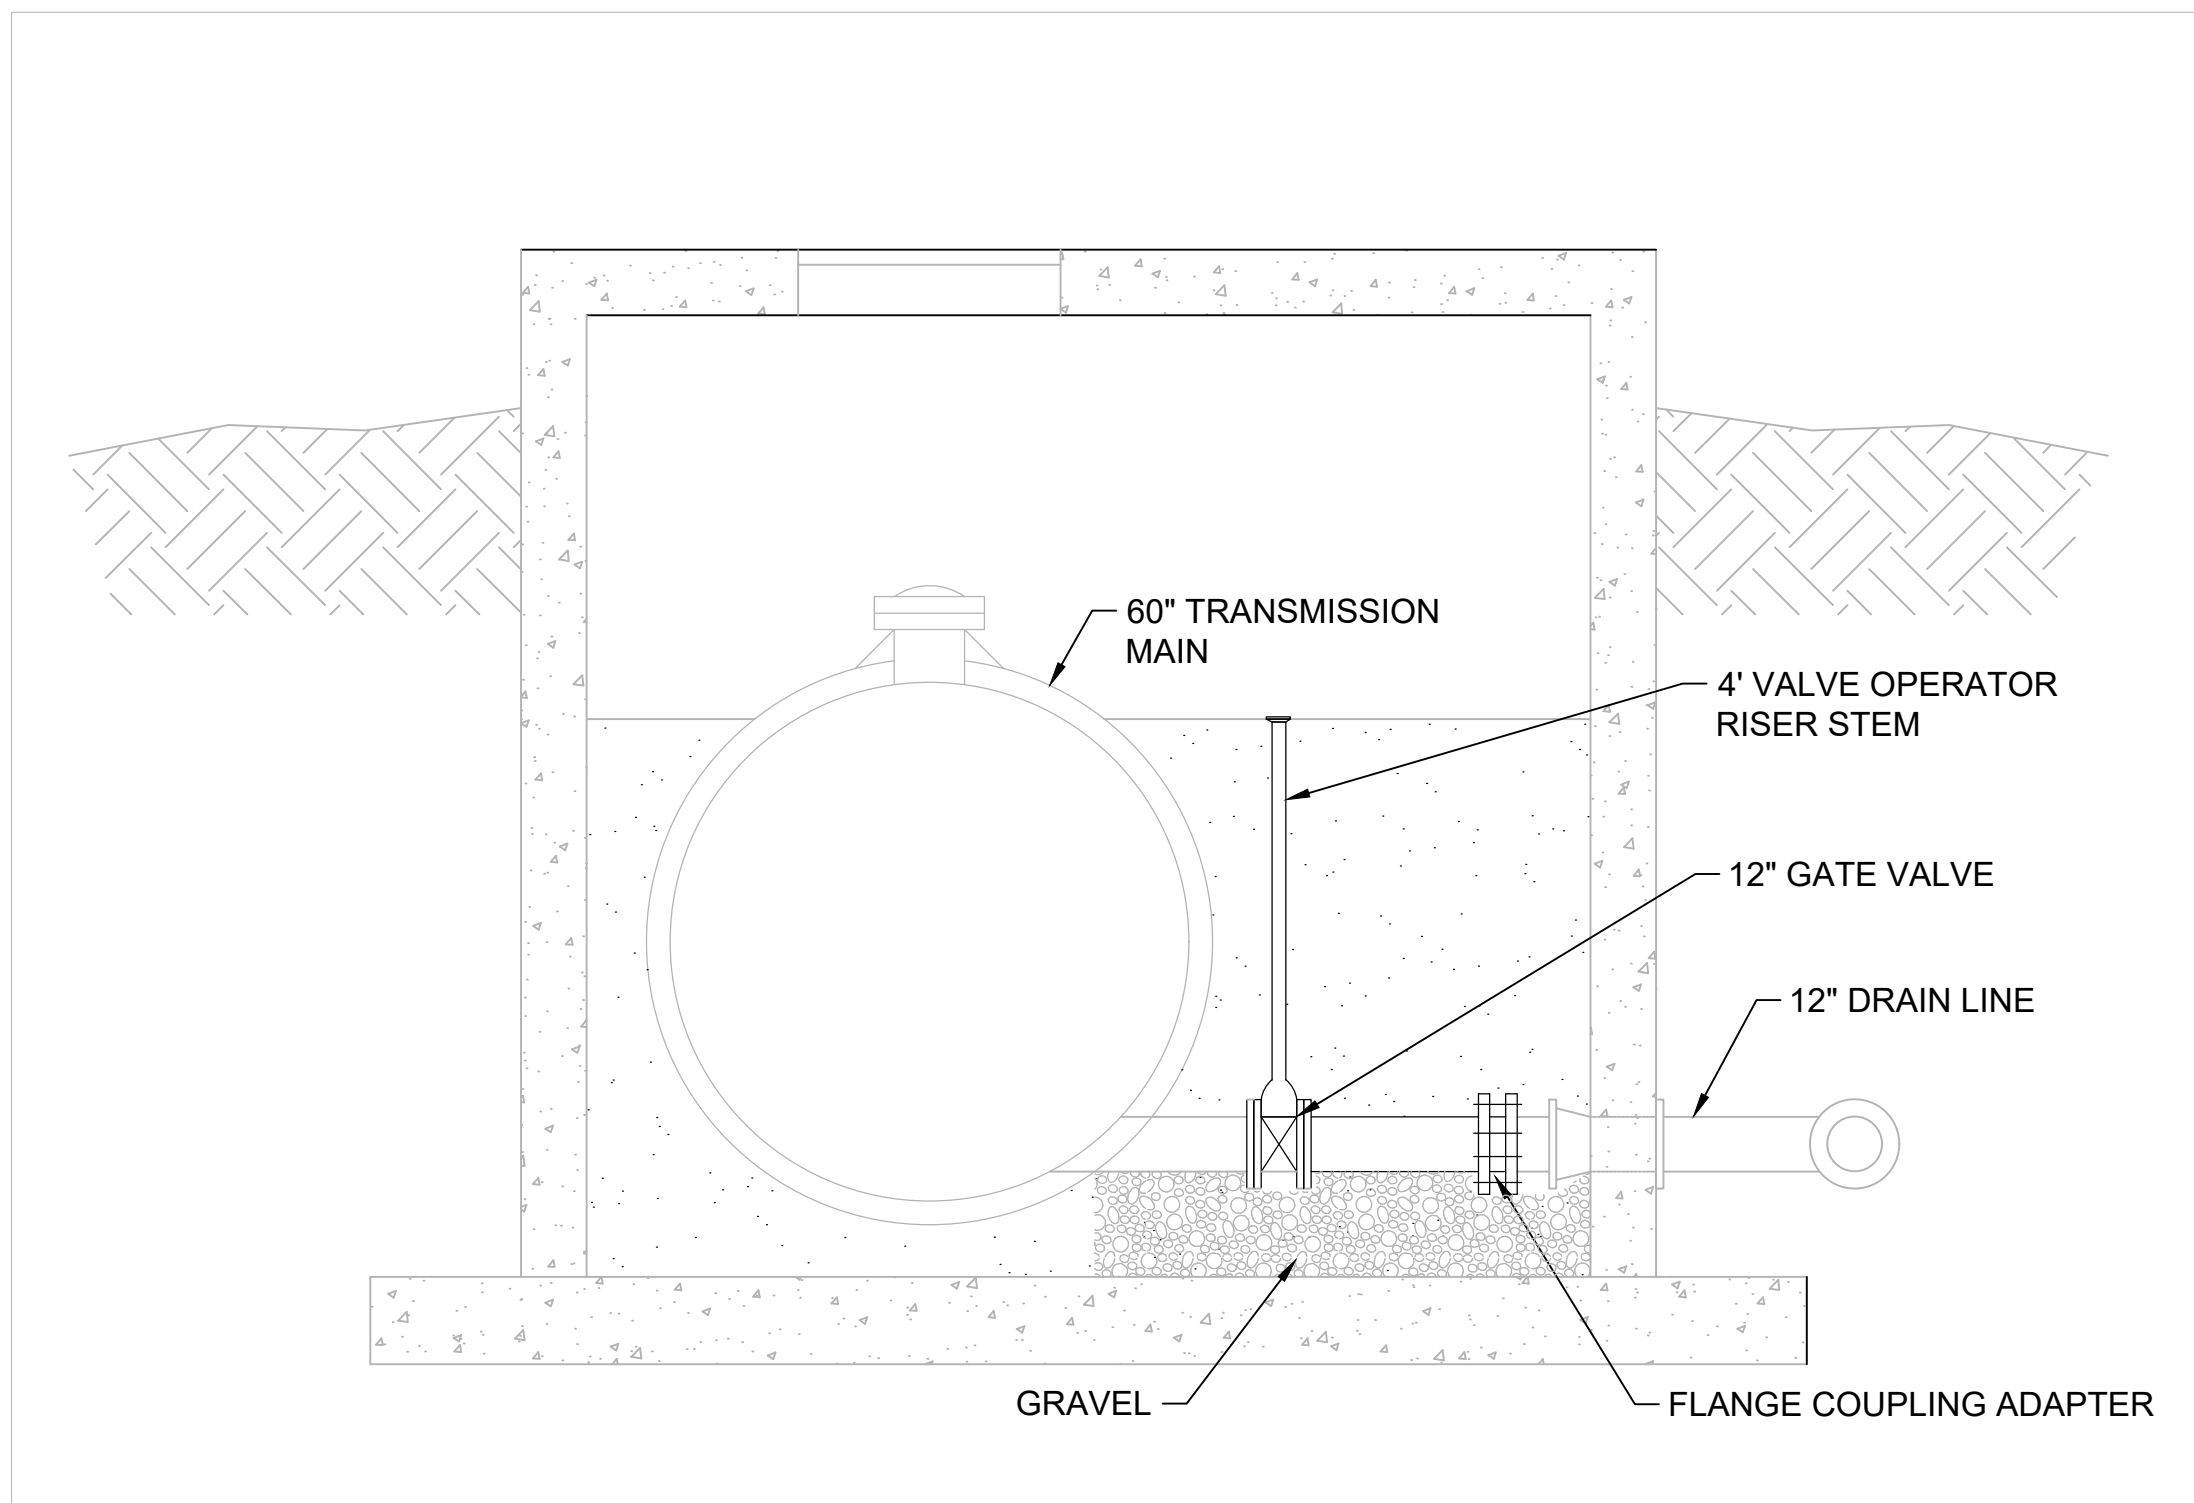

DETAIL
DRAIN VAULT MODIFICATIONS
 NOT TO SCALE

Scale For Microfilming

Inches

COPYRIGHT © 2017 BURNS & MCDONNELL ENGINEERING COMPANY, INC.

no.	date	by	ckd	description
1	1/30/19	CAM	LJK	DRAWING ADDED
	2/5/19	CAM	LJK	CONFORMING TO CONSTRUCTION RECORDS




9400 WARD PARKWAY
 KANSAS CITY, MO 64114
 816-333-9400
 LICENSEE NO. E-65

date	JANUARY 30, 2019	detailed	B. FIFIELD
designed	C. MAGES	checked	L. KLEIN



CHENEY TRANSMISSION LINE
 DRAIN VAULT MODIFICATIONS

project	97687	contract	
drawing	D003	rev.	1
sheet	of	sheets	
file 97687_D003.DWG			

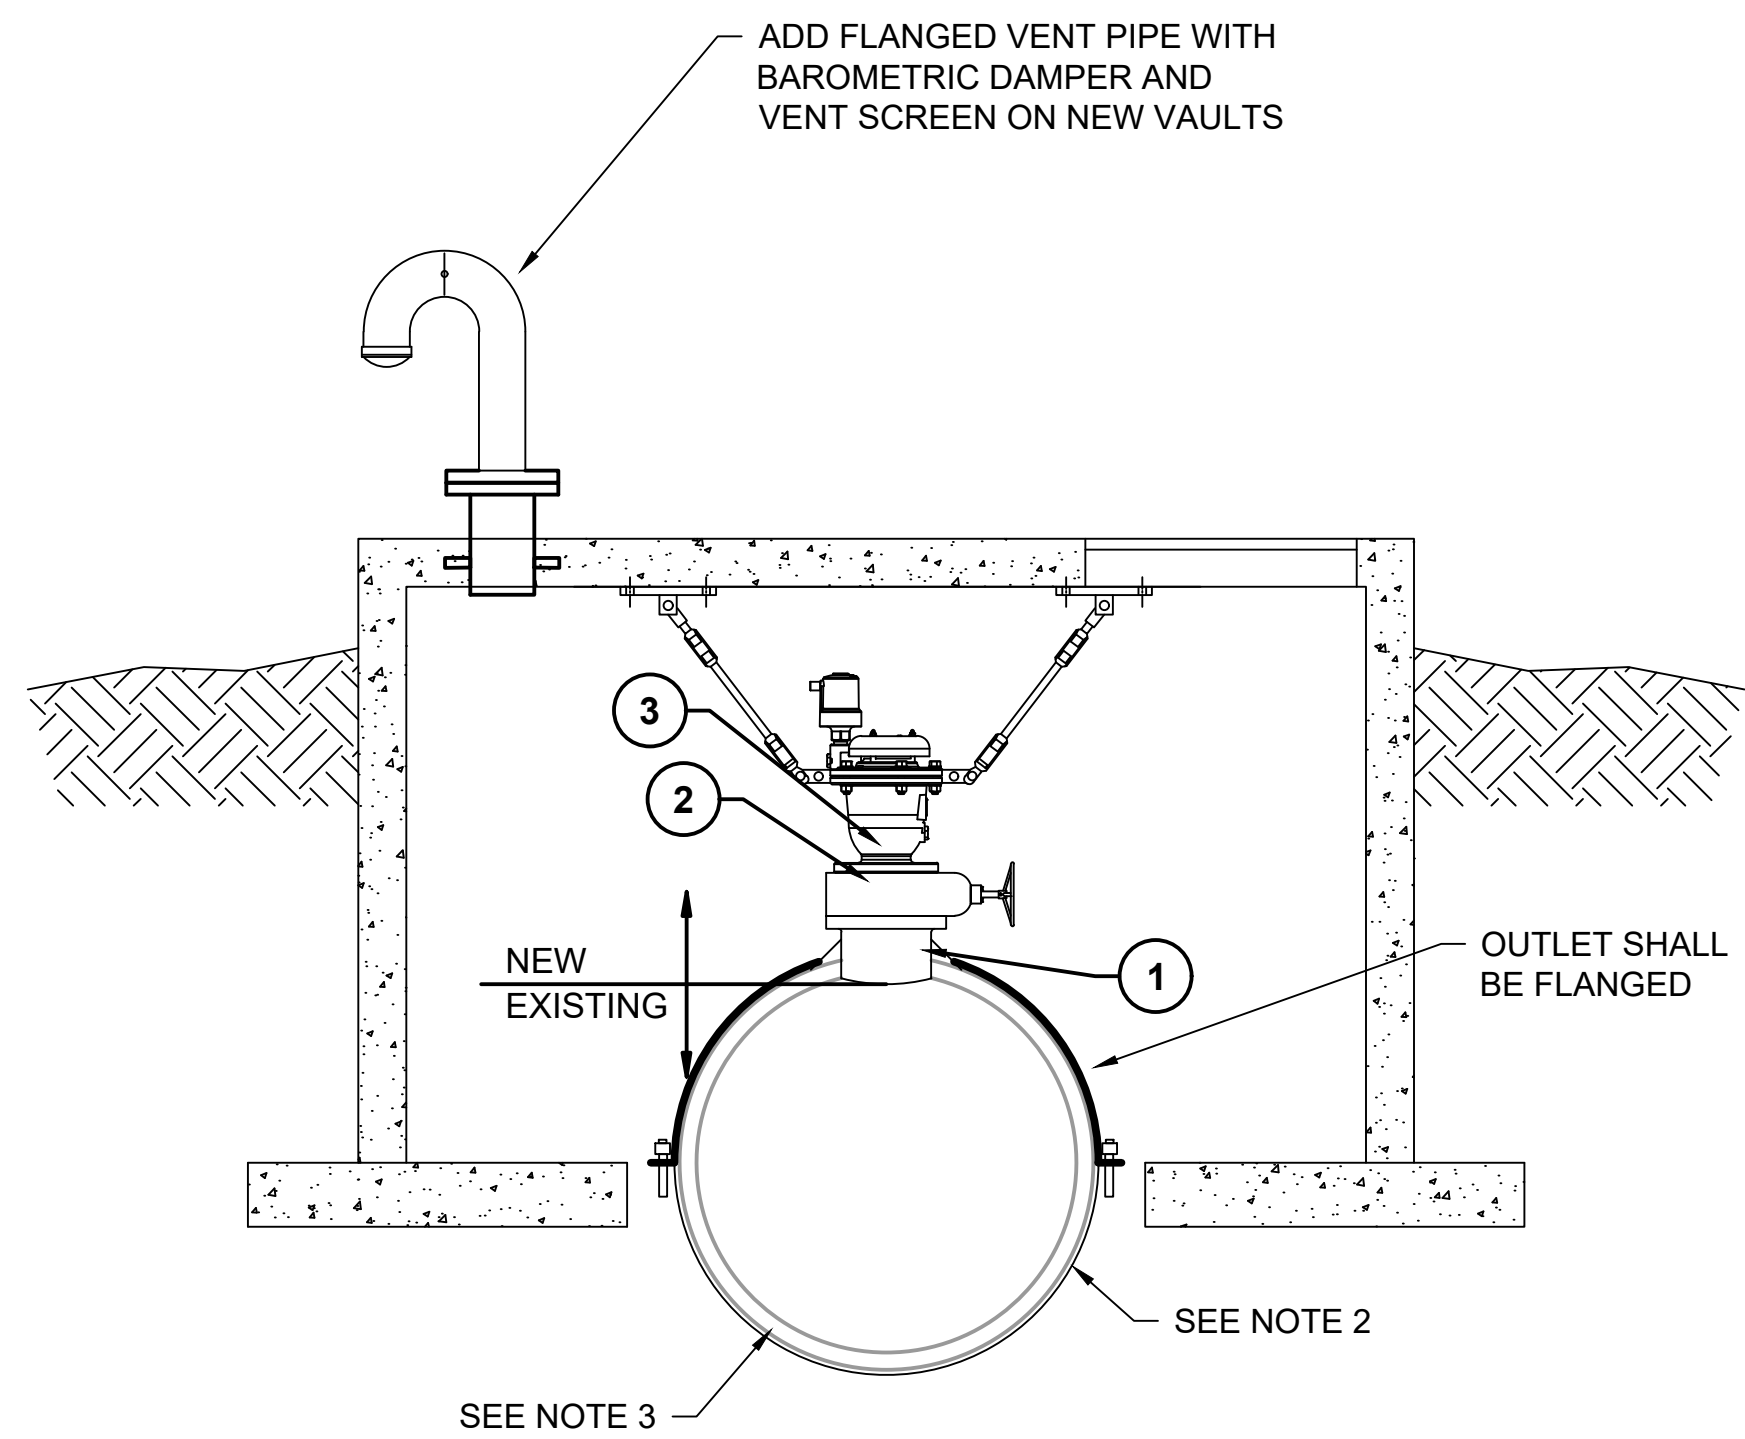


- NOTES:**
1. REFER TO D002 FOR DEMOLITION REQUIREMENTS.
 2. INSULATE AND COVER VAULT PER ARCHITECTURAL DRAWINGS.

SECTION B
VAULT REPLACEMENT
OUTLET PIPING
 NOT TO SCALE

- NOTES:**
1. TAPPING SADDLE FOR VAULTS 14, 19, AND 21 SHALL BE SPECIFICALLY DESIGNED FOR PCCP AT THE RATED PRESSURE OF THE PIPE.
 2. TAPPING SADDLE AS MANUFACTURED BY ROMAC, SMITH-BLAIR, JCM, U.S. PIPE, MUELLER, CASCADE MANUFACTURING, OR ENGINEER APPROVED EQUAL.
 3. RECONSTRUCTED VAULTS 14, 19, AND 21 CONTAIN NEW TAPS AND ORIGINAL TAPS. ORIGINAL TAP DETAILS LISTED ON D002.

VAULT	①	②	③
14*	12-INCH	12-INCH FLANGED GV	12-INCH COMBINATION AIR/VACUUM VALVE
19*	12-INCH	12-INCH THREADED BALL VALVE	12-INCH COMBINATION AIR/VACUUM VALVE
21*	12-INCH	12-INCH FLANGED GV	12-INCH COMBINATION AIR/VACUUM VALVE

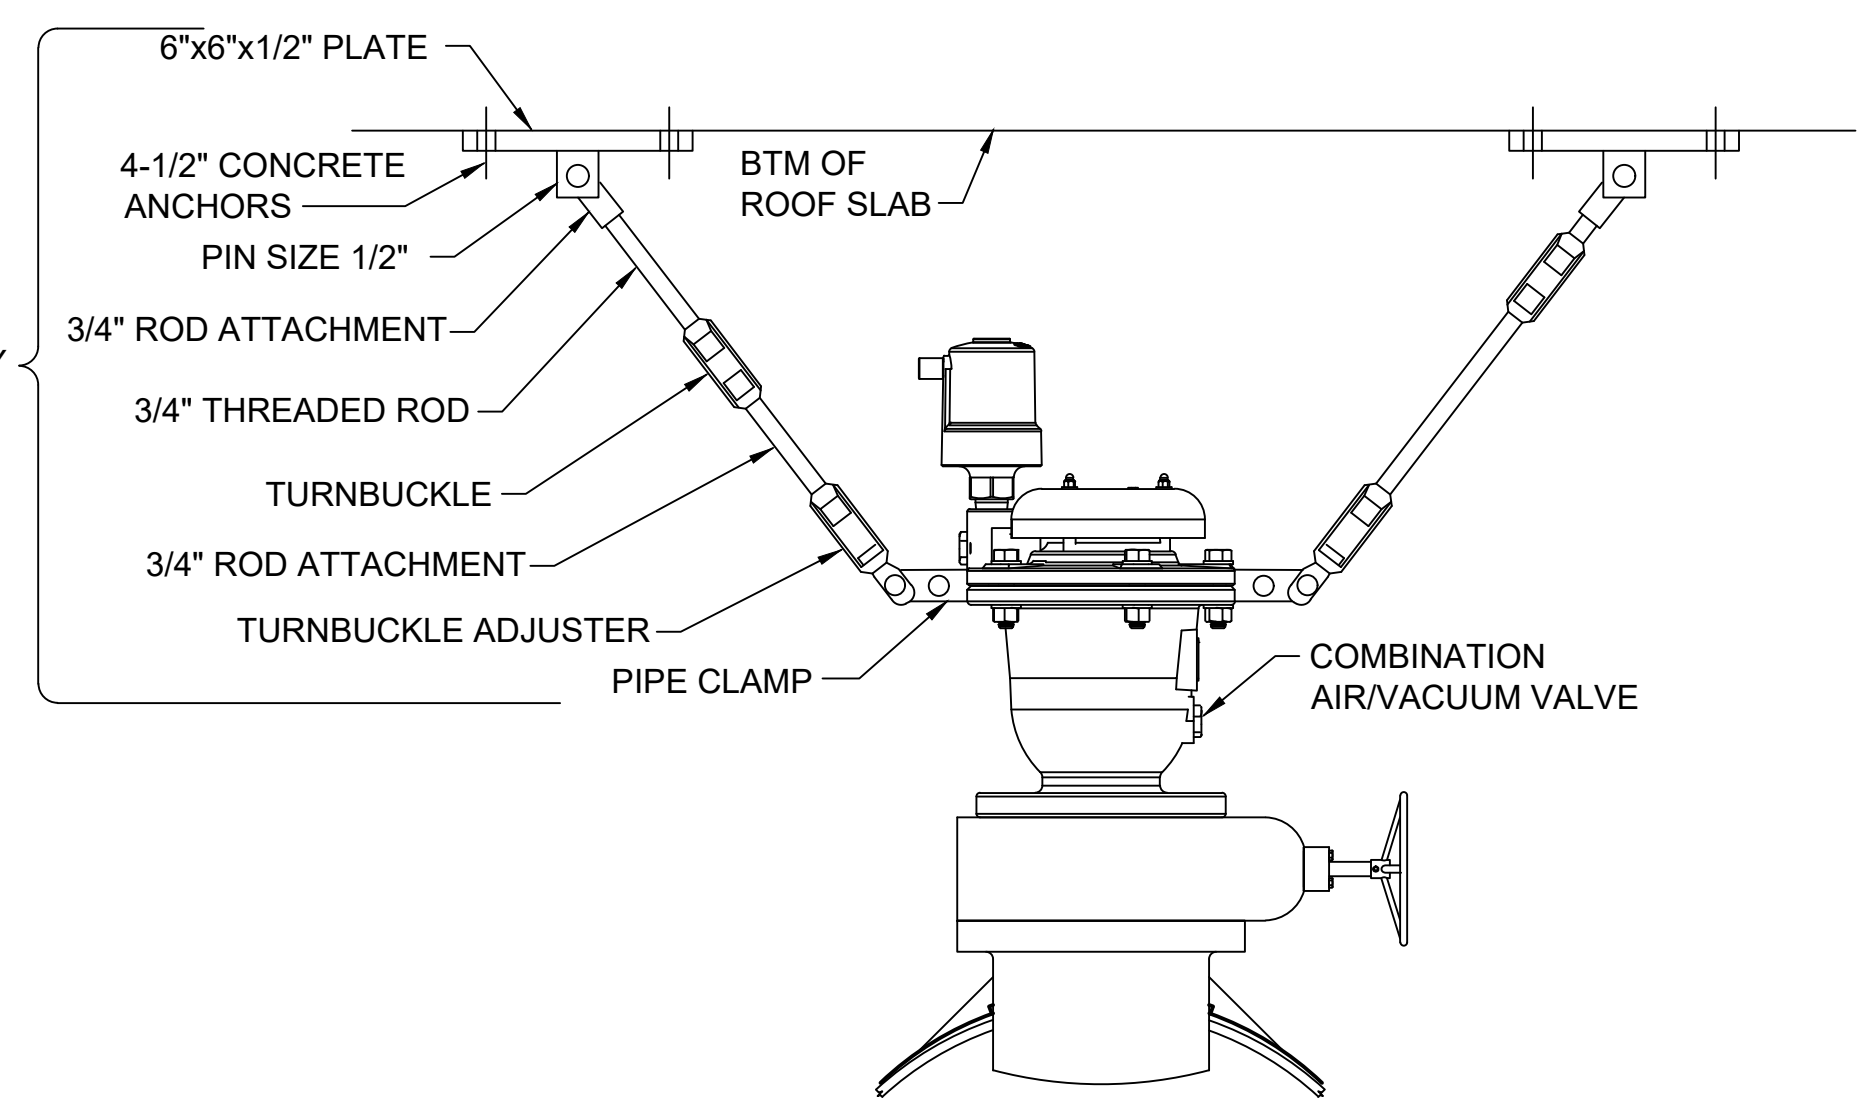

COMBINATION AIR/VACUUM VALVE
SUPPORT 4" AND LARGER DETAIL
 NOT TO SCALE

Scale For Microfinishing
Millimeters

Inches

COPYRIGHT © 2017 BURNS & MCDONNELL ENGINEERING COMPANY, INC.

no.	date	by	ckd	description
0	11/8/17	CAM	LJK	ISSUED FOR BID
1	2/5/19	CAM	LJK	CONFORMING TO CONSTRUCTION RECORDS

BURNS & MCDONNELL
 9400 WARD PARKWAY
 KANSAS CITY, MO 64114
 816-333-9400
 LICENSEE NO. E-65

date SEPTEMBER 11, 2017	detailed B. FIFIELD
designed C. MAGES	checked L. KLEIN

City of
Wichita, Kansas
 SEDGWICK, KANSAS

CHENEY TRANSMISSION LINE

VAULT REPLACEMENT
 INTERIOR MODIFICATIONS

project 97687	contract
drawing BA-D001	rev. 0
sheet	of sheets


file 97687_BA-D001.DWG

no.	date	by	ckd	description
0	11/8/17	AMG	JT	ISSUED FOR BID
1	2/5/19	AMG	JT	CONFORMING TO CONSTRUCTION RECORDS

ABBREVIATIONS

AA ALUMINUM ASSOCIATION	EA EACH	LS LAP SPLICE
AASHTO AMERICAN ASSOCIATION OF STATE HIGHWAY AND TRANSPORTATION OFFICIALS	ED EQUIPMENT DRAIN	M METER
AB ANCHOR BOLT	EF EACH FACE	MATL MATERIAL
ABT ABOUT	EJ EXPANSION JOINT	MAX MAXIMUM
ACI AMERICAN CONCRETE INSTITUTE	EL ELEVATION	MECH MECHANICAL
ACO AT CONTRACTOR'S OPTION	ELEC ELECTRICAL	MEZZ MEZZANINE
ADH ADHESIVE	EMBED EMBEDMENT	MFR MANUFACTURE(R)
AGGR AGGREGATE	EP EQUIPMENT PAD	MH MANHOLE
AHR ANCHOR	ERCPC ELLIPTICAL REINF CONC PIPE	MIN MINIMUM
AHU AIR HANDLING UNIT	EQ EQUAL	MISC MISCELLANEOUS
AISC AMERICAN INSTITUTE OF STEEL CONSTRUCTION	EQ SP EQUALLY SPACED	MJ MECHANICAL JOINT
AISI AMERICAN IRON AND STEEL INSTITUTE	EQUIP EQUIPMENT	MK MARK
AL ALUM	EQUIV EQUIVALENT	MM MILLIMETER
ALTN ALTERNATE	EW EACH WAY	MPa MEGAPASCAL
ANSI AMERICAN NATIONAL STANDARDS INSTITUTE	EXP EXPANSION	MS MECHANICAL SPLICE
APPROX APPROXIMATE	EXIST EXISTING	N NORTH
ARCH ARCHITECTURAL	EXT EXTERIOR	NA NOT APPLICABLE
ASTM AMERICAN SOCIETY FOR TESTING AND MATERIALS	FAB FABRICATE	NE NORTHEAST
AWS AMERICAN WELDING SOCIETY	fc SPECIFIED 28 DAY COMPRESSIVE STRENGTH OF CONCRETE	NF NEAR FACE
B, BOT BOTTOM	FD FLOOR DRAIN	NIC NOT IN CONTRACT
BC BOLT CIRCLE	FDN FOUNDATION	NO NUMBER
BETW BETWEEN	FF FAR FACE	NOM NOMINAL
BLDG BUILDING	FL FLOOR	NS NEAR SIDE
BM BEAM	FLG FLANGE	NTS NOT TO SCALE
BO BOTTOM OF	fm SPECIFIED COMPRESSIVE STRENGTH OF MASONRY	NW NORTHWEST
BOS BOTTOM OF STEEL	FNSH FINISH	OC ON CENTER
BRG BEARING	FRP FIBERGLASS REINFORCED PLASTIC	OD OUTSIDE DIAMETER
BRKT BRACKET	fs PERMISSIBLE STEEL STRESS	OF OUTER FACE
CAP CAPACITY	FS FAR SIDE	OPNG OPENING
CB CORNER BAR	FT FEET, FOOT	OPP OPPOSITE
CC CLEAR COVER	FUT FUTURE	OSHA OCCUPATIONAL SAFETY AND HEALTH ADMINISTRATION
C/C CENTER TO CENTER	Fy, fy YIELD STRESS	OZ OUNCE
CE CONCRETE EDGE	GA GAGE, GAUGE	Pa PASCAL
CF CUBIC FEET	GAL GALLON	PCA PORTLAND CEMENT ASSOCIATION
CHKR CHECKERED	GALV GALVANIZED	PCF POUNDS PER CUBIC FOOT
CIR CIRCLE	GALV GRANULAR FILL	PCI PRESTRESSED CONCRETE INSTITUTE, POUNDS PER CUBIC INCH
CIRCUM CIRCUMFERENTIAL	GND GROUND	PED PEDESTAL
CIS CENTERED IN SLAB	GR GRADE	PEN PENETRATE
CIW CENTERED IN WALL	GRTG GRATING	PERP PERPENDICULAR
CJ CONSTRUCTION JOINT	GS GRATING SUPPORT	PJTN PROJECTION
CL CENTER LINE	H HIGH	PL PLATE, PROPERTY LINE
CLJ CONTROL JOINT	HC HOLLOW CORE	PLCS PLACES
CLR CLEAR	HEX HEXAGON	PLF POUNDS PER LINEAR FOOT
CM CENTIMETER	HK HOOK	PREFAB PREFABRICATED
CMU CONCRETE MASONRY UNIT	HR HANDRAIL	PSF POUNDS PER SQUARE FOOT
CO CONCRETE OPENING	HORIZ HORIZONTAL	PSI POUNDS PER SQUARE INCH
COL COLUMN	HP HORSEPOWER	PRV PRESSURE RELIEF VALVE
CONC CONCRETE	HPT HIGH POINT	PT POINT
CONN CONNECTION	HS HIGH STRENGTH	PVC POLYVINYL CHLORIDE
CONSTR CONSTRUCTION	HVAC HEATING, VENTILATION, AND AIR CONDITIONING	PWS PLASTIC WATERSTOP
CONT CONTINUOUS	IBC INTERNATIONAL BUILDING CODE	R RISERS
CONTR CONTRACT	ID INSIDE DIAMETER	RAD RADIUS
COORD COORDINATE	IF INNER FACE	RD ROOF DRAIN
COR CORNER	IJ ISOLATION JOINT	REF REFERENCE
CRSI CONCRETE REINFORCING STEEL INSTITUTE	INTR INTERIOR	REINF REINFORCEMENT
CTR CENTER	INVT INVERT	REQD REQUIRED
CWB CAPILLARY WATER BARRIER	JT JOINT	REV REVISION
CY CUBIC YARD	K KIP (1000 POUNDS)	RJ ROUGHENED JOINT
db BAR DIAMETER	KB KNEE BRACE	RM ROOM
DBL DOUBLE	KPL KICK PLATE	S SOUTH
DET DETAIL	kg KILOGRAM	SCHED SCHEDULE
DGA DENSE GRADED AGGREGATE	kN KILONEWTON	SD SUBDRAIN
DIA DIAMETER	KSF KIPS PER SQUARE FOOT	SE SOUTHEAST, STEEL EDGE
DIAG DIAGONAL	KSI KIPS PER SQUARE INCH	SECT SECTION
DIM DIMENSION	L ANGLE, LONG	SHT SHEET
DK DECKING	LAD LADDER	SIM SIMILAR
DL DEAD LOAD	LB POUND	SJ SAWED JOINT
DN DOWN	LG LENGTH, LONG	SLO SHORT LEG OUTSTANDING
DT DOUBLE TEE	LL LIVE LOAD	SLP SLOPE
DWG DRAWING	LLH LONG LEG HORIZONTAL	SLV SLEEVE
DWL DOWEL	LLV LONG LEG VERTICAL	SP SPACE
E EAST	LLO LONG LEG OUTSTANDING	SPECS SPECIFICATION
	LNTL LINTEL	SQ SQUARE
	LONG LONGITUDINAL	SS, SST STAINLESS STEEL
	LPT LOW POINT	ST SINGLE TEE
		STD STANDARD
		STIF STIFFENER

CONCRETE REINFORCING BAR NOMENCLATURE

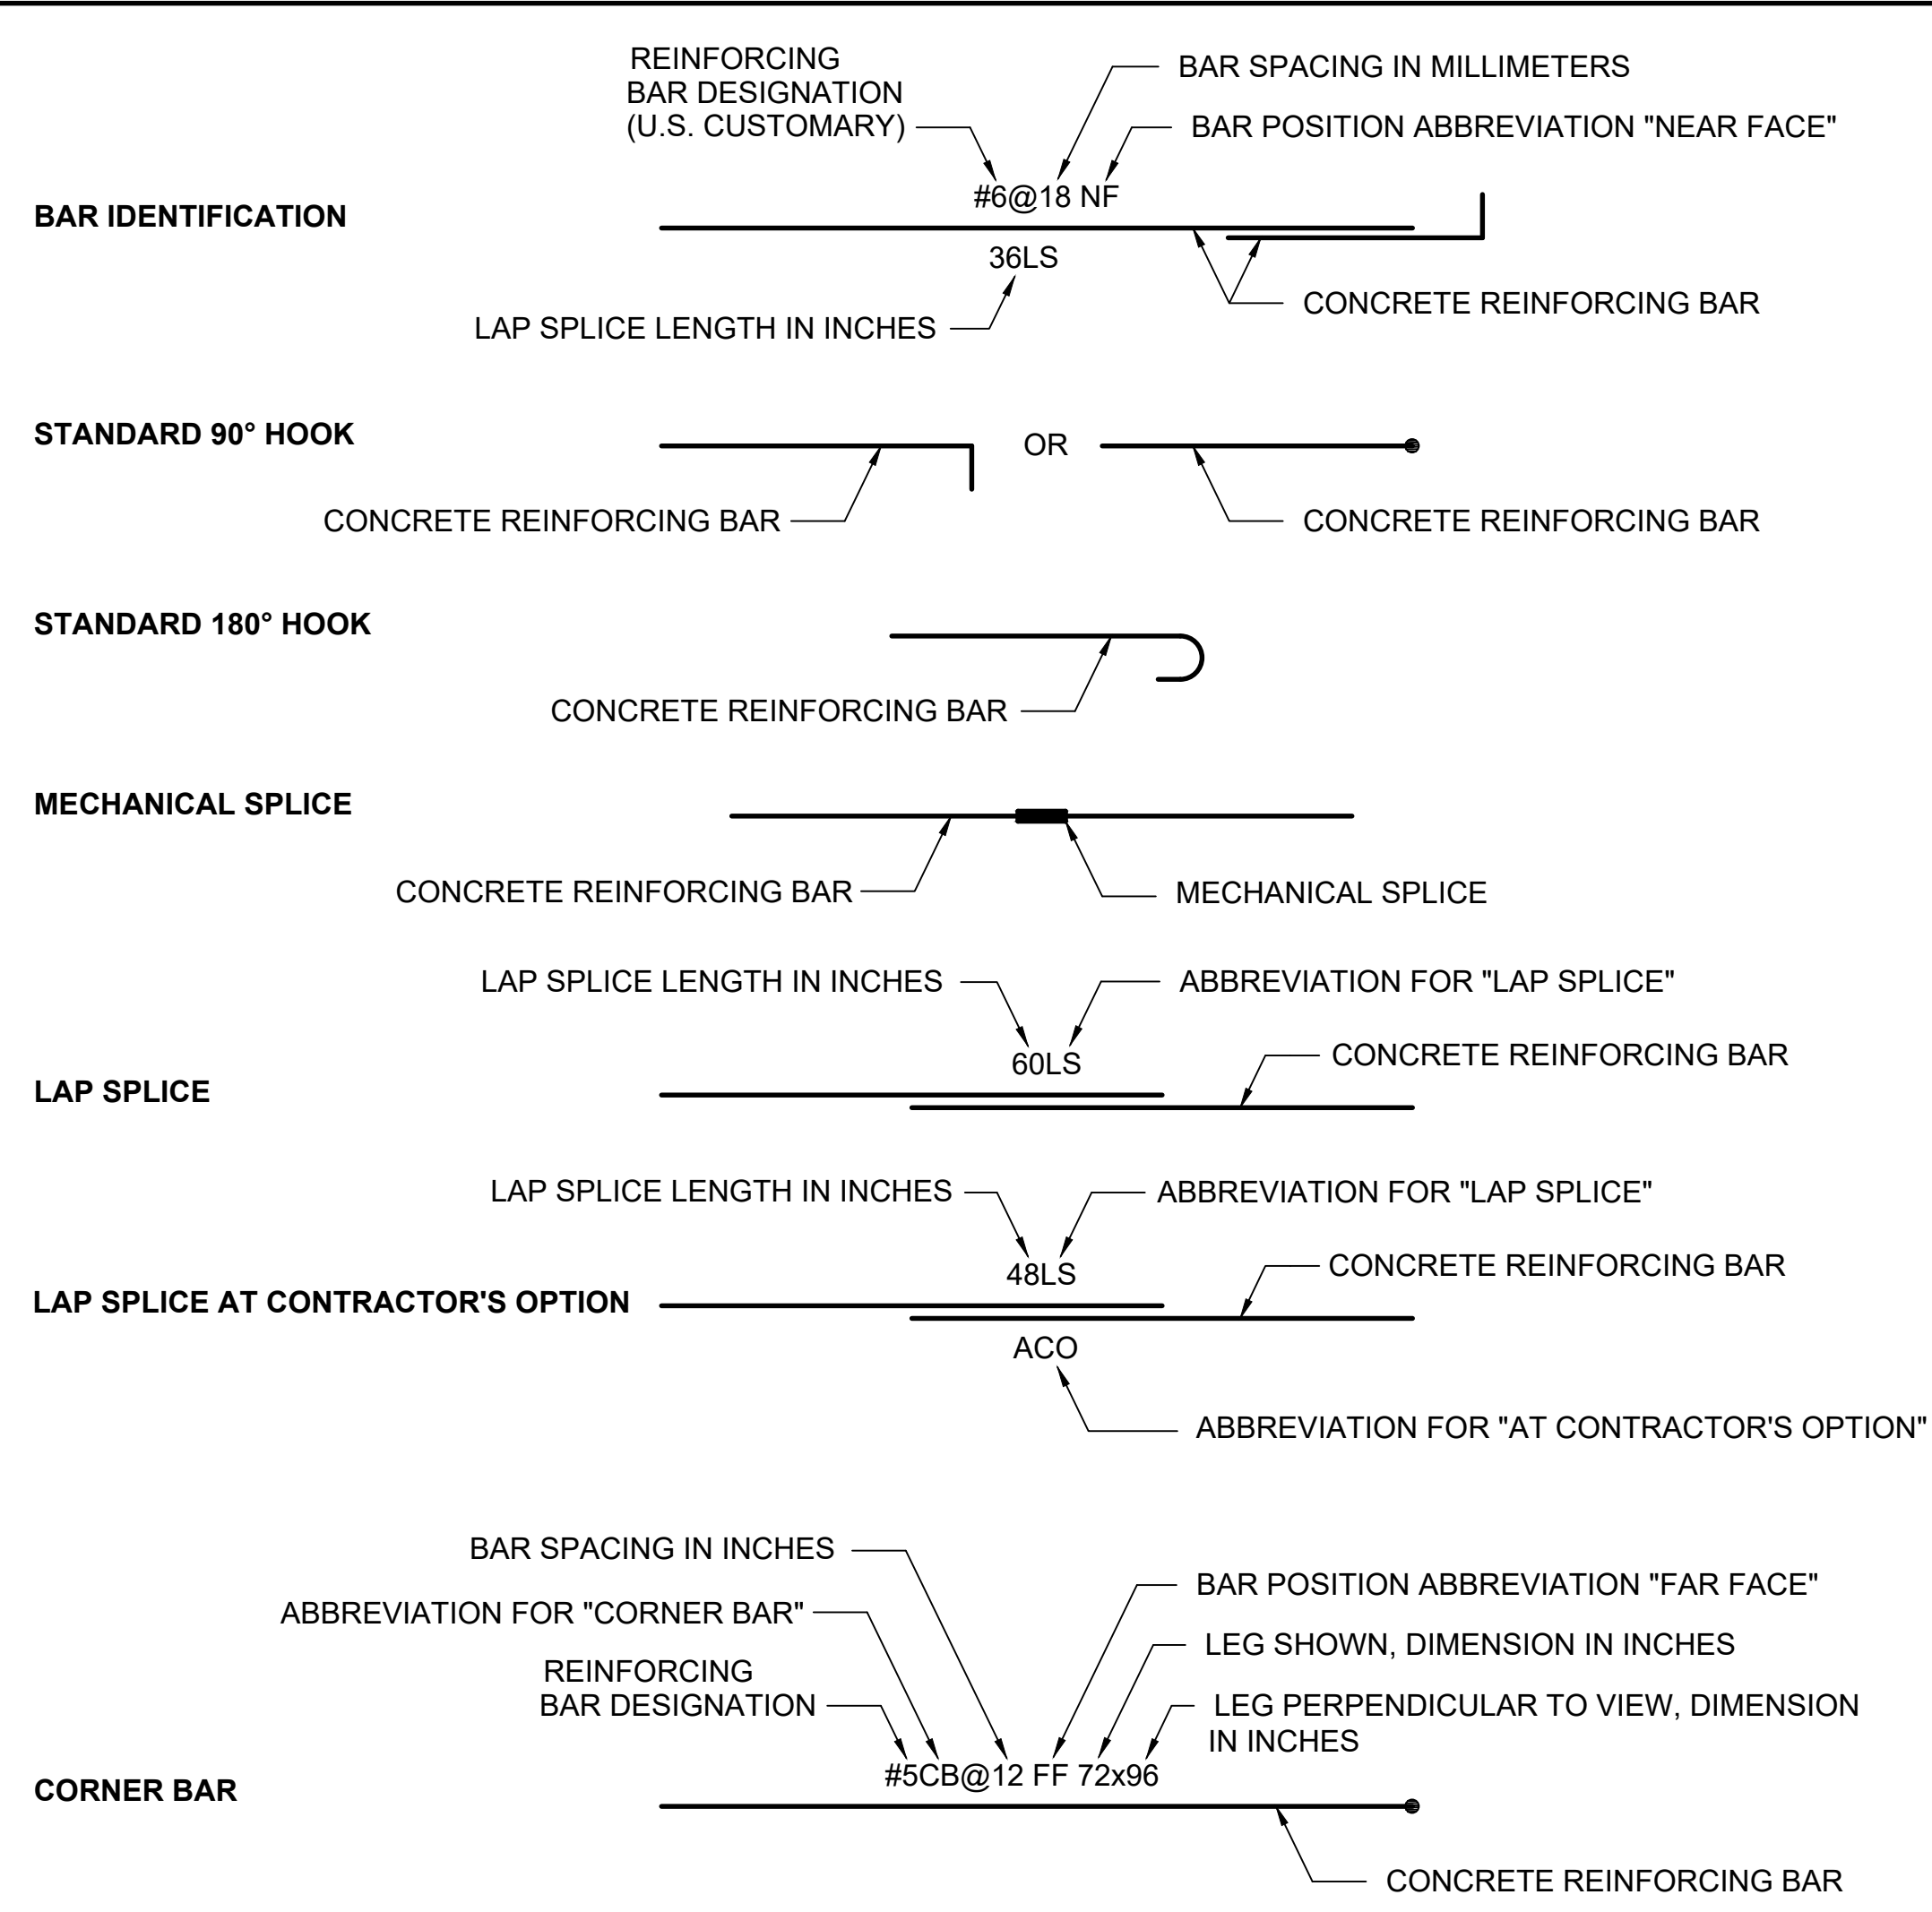

MATERIALS LEGEND

	ALUMINUM		WATER
	CHECKERED PLATE		EXPANSION MATERIAL
	CONCRETE		FASTENERS
	CONCRETE MASONRY UNITS		REINFORCING BARS
	EARTH		STRUCTURAL STEEL (SMALL SCALE)
	GRANULAR FILL		
	GRATING		
	GROUT		
	ROCK		
	STEEL (LARGE SCALE)		

Scale For Microfinishing

Inches

COPYRIGHT © 2017 BURNS & MCDONNELL ENGINEERING COMPANY, INC.



9400 WARD PARKWAY
KANSAS CITY, MO 64114
816-333-9400
LICENSEE NO. E-65

date	designed	checked	rev.
SEPTEMBER 27, 2017	A. GRIFFIN	J. TSOULIAS	B. FIFIELD







SEDGWICK, KANSAS

WICHITA CHENEY PIPELINE

LEGEND AND ABBREVIATIONS

project	contract
97687	
drawing	rev.
BA-S001	1
sheet	of sheets
file 97687_BA-S001.DWG	

no.	date	by	ckd	description
0	11/8/17	AMG	JT	ISSUED FOR BID
1	2/5/19	AMG	JT	CONFORMING TO CONSTRUCTION RECORDS

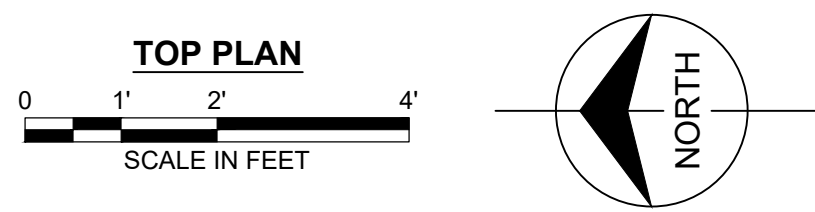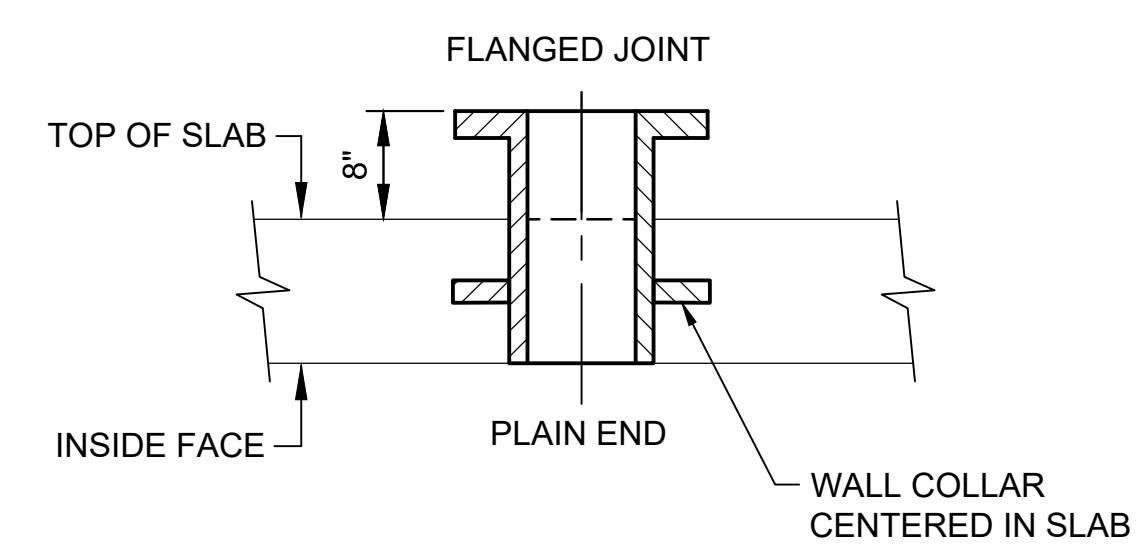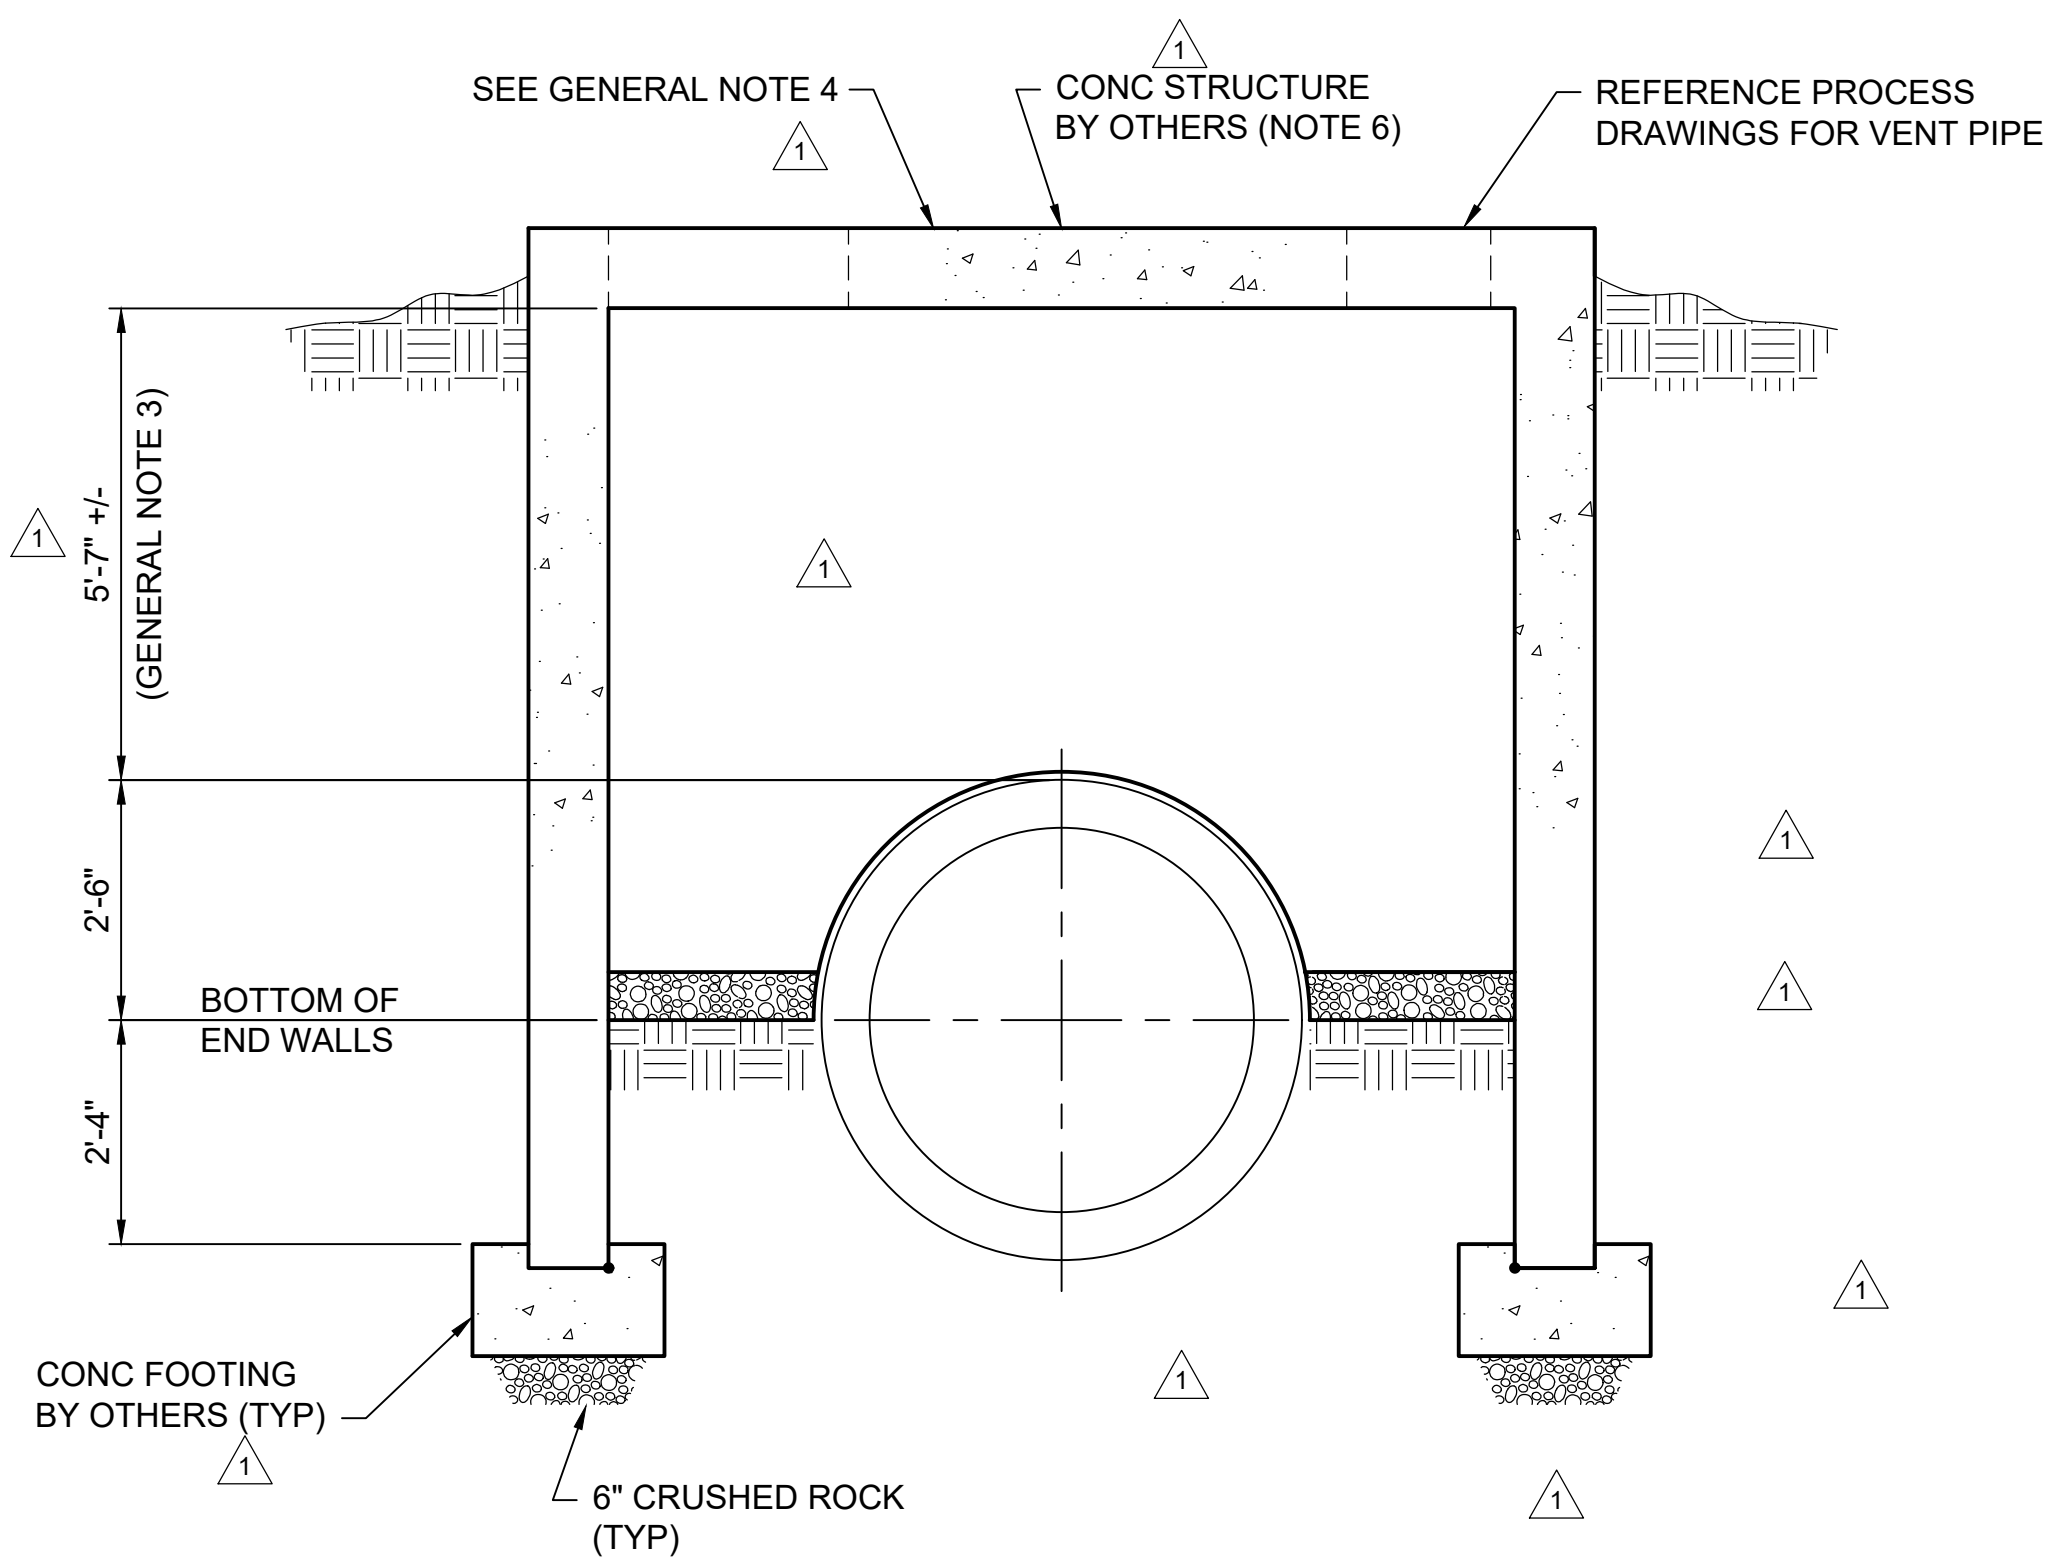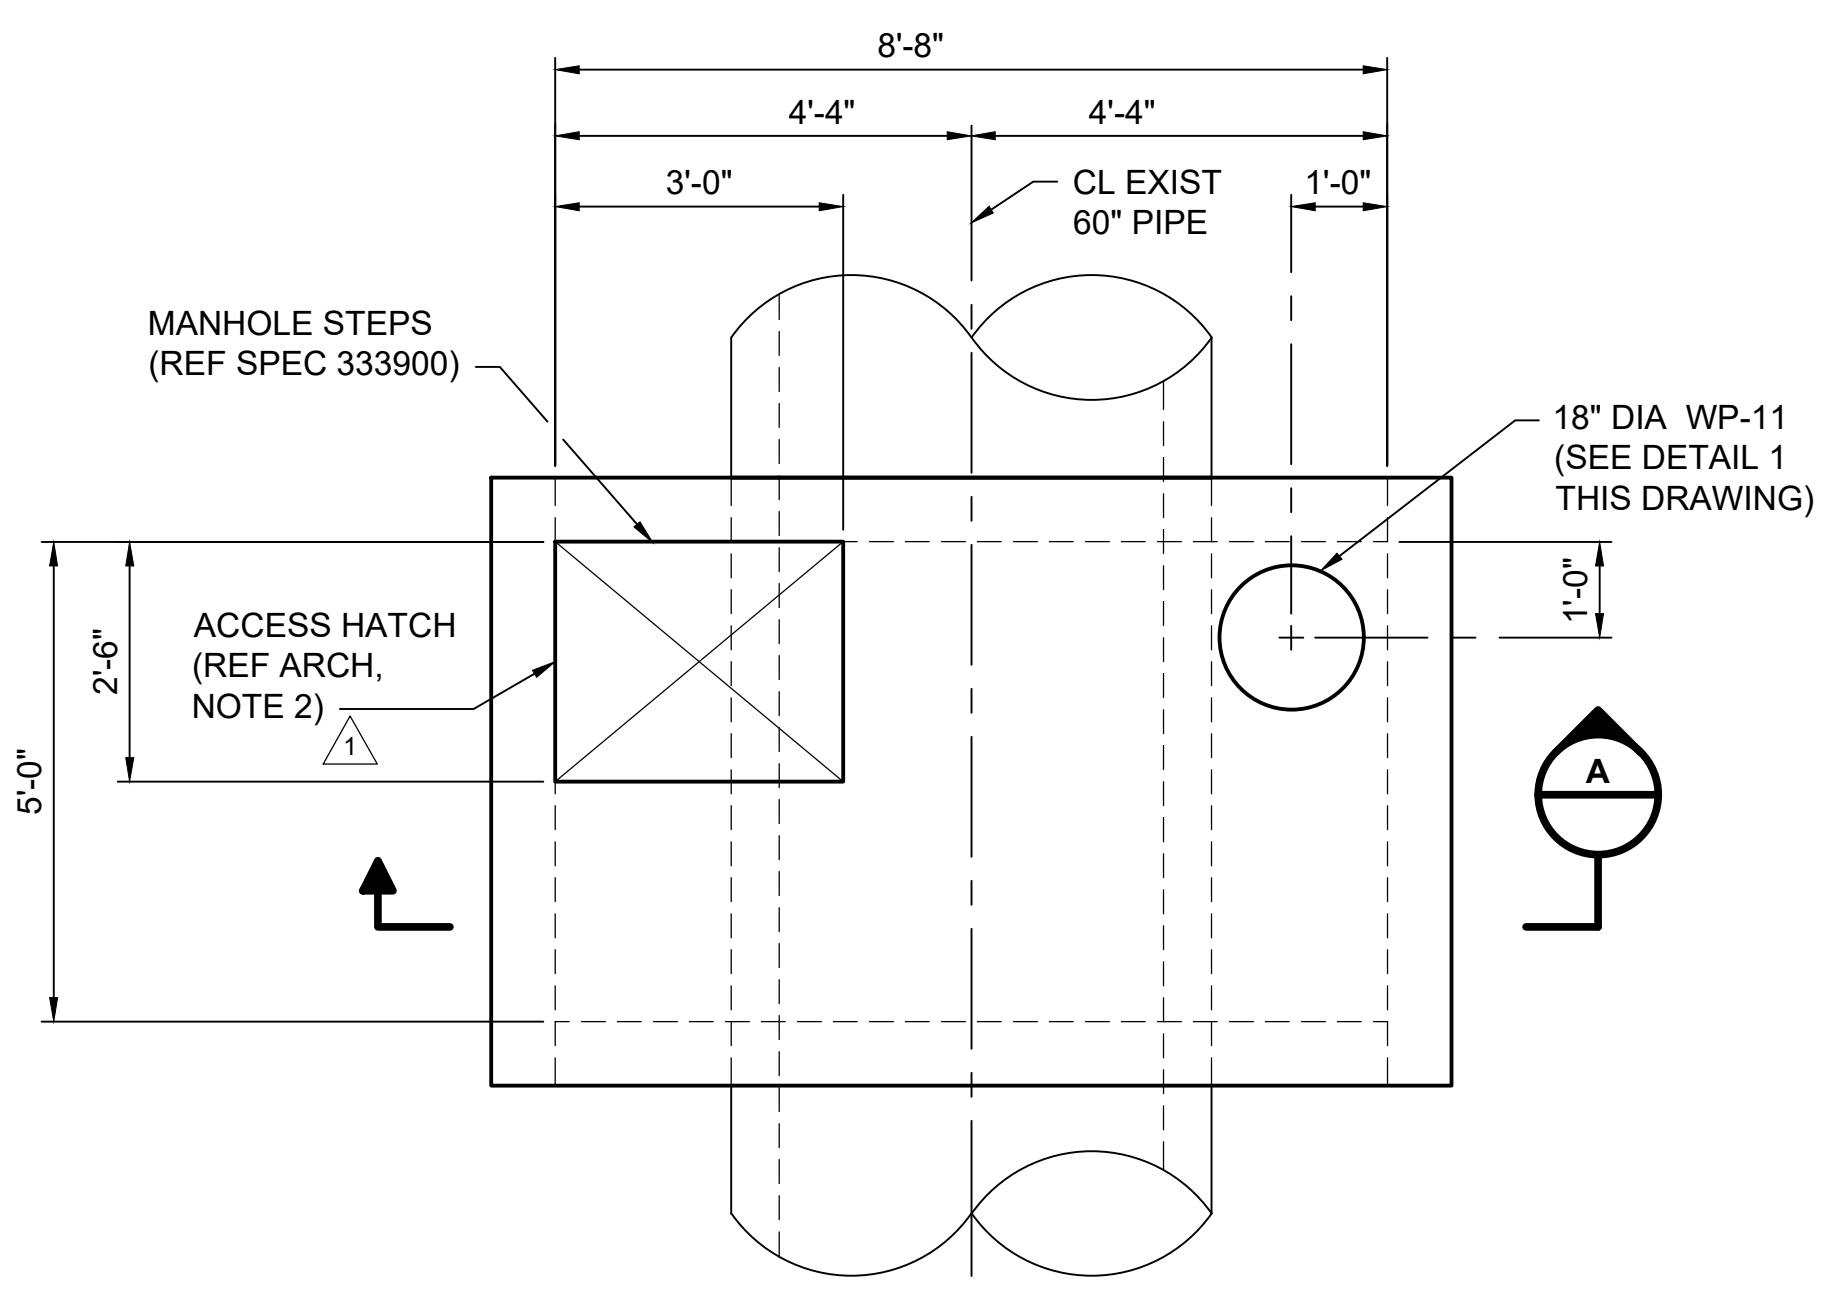

SECTION NOT TO SCALE A

DETAIL NOT TO SCALE 1

GENERAL NOTES:

1. THIS SHEET SHALL APPLY ONLY TO VAULTS 14, 19, AND 21.
2. HATCH ANCHORS SHALL BE 304 SST HILTI HAS ADHESIVE ANCHORS WITH HILTI HIT-HY200 ADHESIVE OR ENGINEER APPROVED EQUAL. ANCHOR DIAMETER AND EMBEDMENT PER HATCH MANUFACTURER.
3. TOP OF CONCRETE VAULT ELEVATION SHALL MATCH EXISTING VAULT ELEVATION.
4. INSULATE AND COVER VAULT PER PROCESS AND ARCHITECTURAL DRAWINGS.
5. ALL ALUMINUM SURFACES IN CONTACT WITH CONCRETE SHALL HAVE A BITUMASTIC COATING.
6. SEE REFERENCE DRAWINGS 1 AND 2 FOR VAULT DETAILS AND REINFORCING.



9400 WARD PARKWAY
KANSAS CITY, MO 64114
816-333-9400
LICENSEE NO. E-65


date	designed	detailed
SEPTEMBER 27, 2017	A. GRIFFIN	B. FIFIELD
	checked	
	J. TSOUFLIAS	



WICHITA CHENEY PIPELINE

VAULT REPLACEMENT
PLANS, SECTIONS, AND DETAILS

project	contract
97687	
drawing	rev.
BA-S002	1
sheet	of sheets
file 97687_BA-S002.DWG	

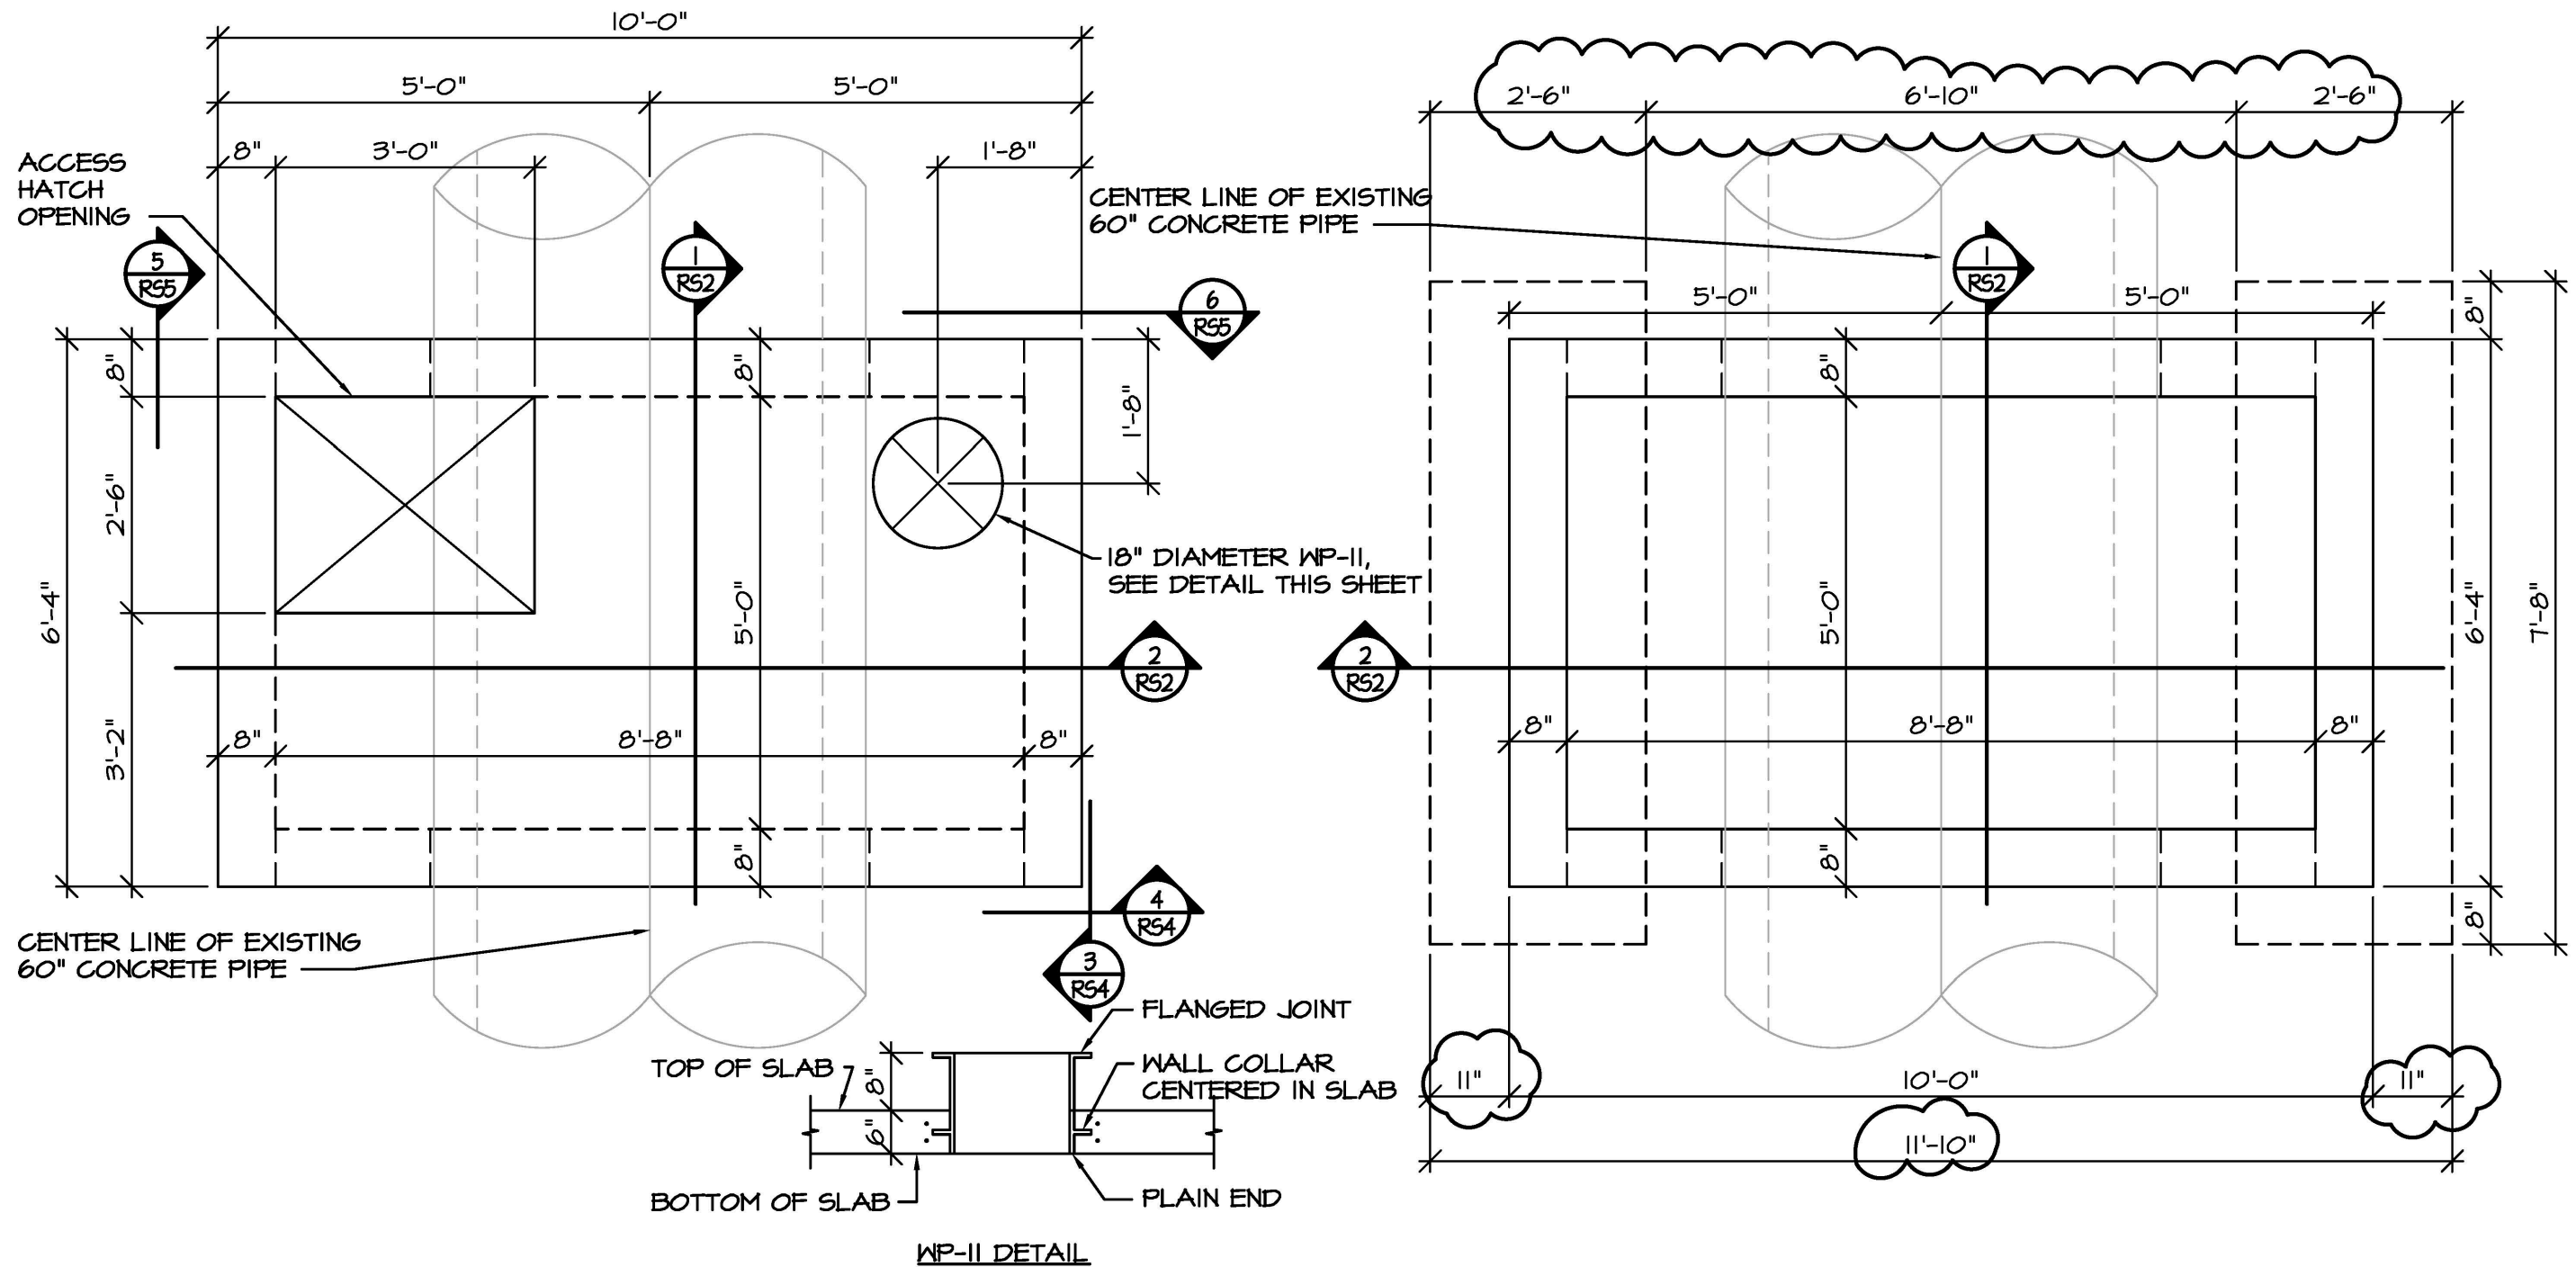

A CAP SLAB PLAN
 $\frac{1}{2}'' = 1'-0''$

B FOUNDATION PLAN
 $\frac{1}{2}'' = 1'-0''$

DESIGN LOADS

CAP SLAB

300 PSF UNIFORM LIVE LOAD
 1500 P CONCENTRATED LOAD AT ANY POINT
 SIMULTANEOUS WITH UNIFORM LOAD

WALLS

62.4 PCF INTERIOR HYDROSTATIC PRESSURE
 100 PCF EXTERIOR EQUIVALENT SOIL FLUID PRESSURE
 WATER TABLE BELOW VAULT LEVEL

MATERIAL REQUIREMENTS

CONCRETE: 4500 PSI AT 28 DAYS
 4.5 TO 7.5% ENTRAINED AIR
 REINFORCING: ASTM A615, GRADE 60
 MINIMUM SOIL BEARING PRESSURE: 1500 PSF
 MAXIMUM EQUIVALENT SOIL FLUID PRESSURE: 100 PCF

NOTE
 DO NOT BACKFILL WALLS
 UNTIL CAP SLAB CONCRETE
 OBTAINS DESIGN STRENGTH.

REFERENCE DRAWING

CITY OF WICHITA
 CHENEY TRANSMISSION LINE IMPROVEMENTS
 VAULTS 14, 19, AND 21 REPLACEMENT
 DONDLINGER CONSTRUCTION


PROJECT NO.
 17-248
 DATE
 DEC. 22, 2017
 REVISED JAN. 12, 2018

RS1

Dudley Williams and Associates, P.A.
 230 Laura • Suite 200 • Wichita, KS 67211-1514
 316-263-7591 • www.dwise.com



Vaults were moved 4' to the west of their original location

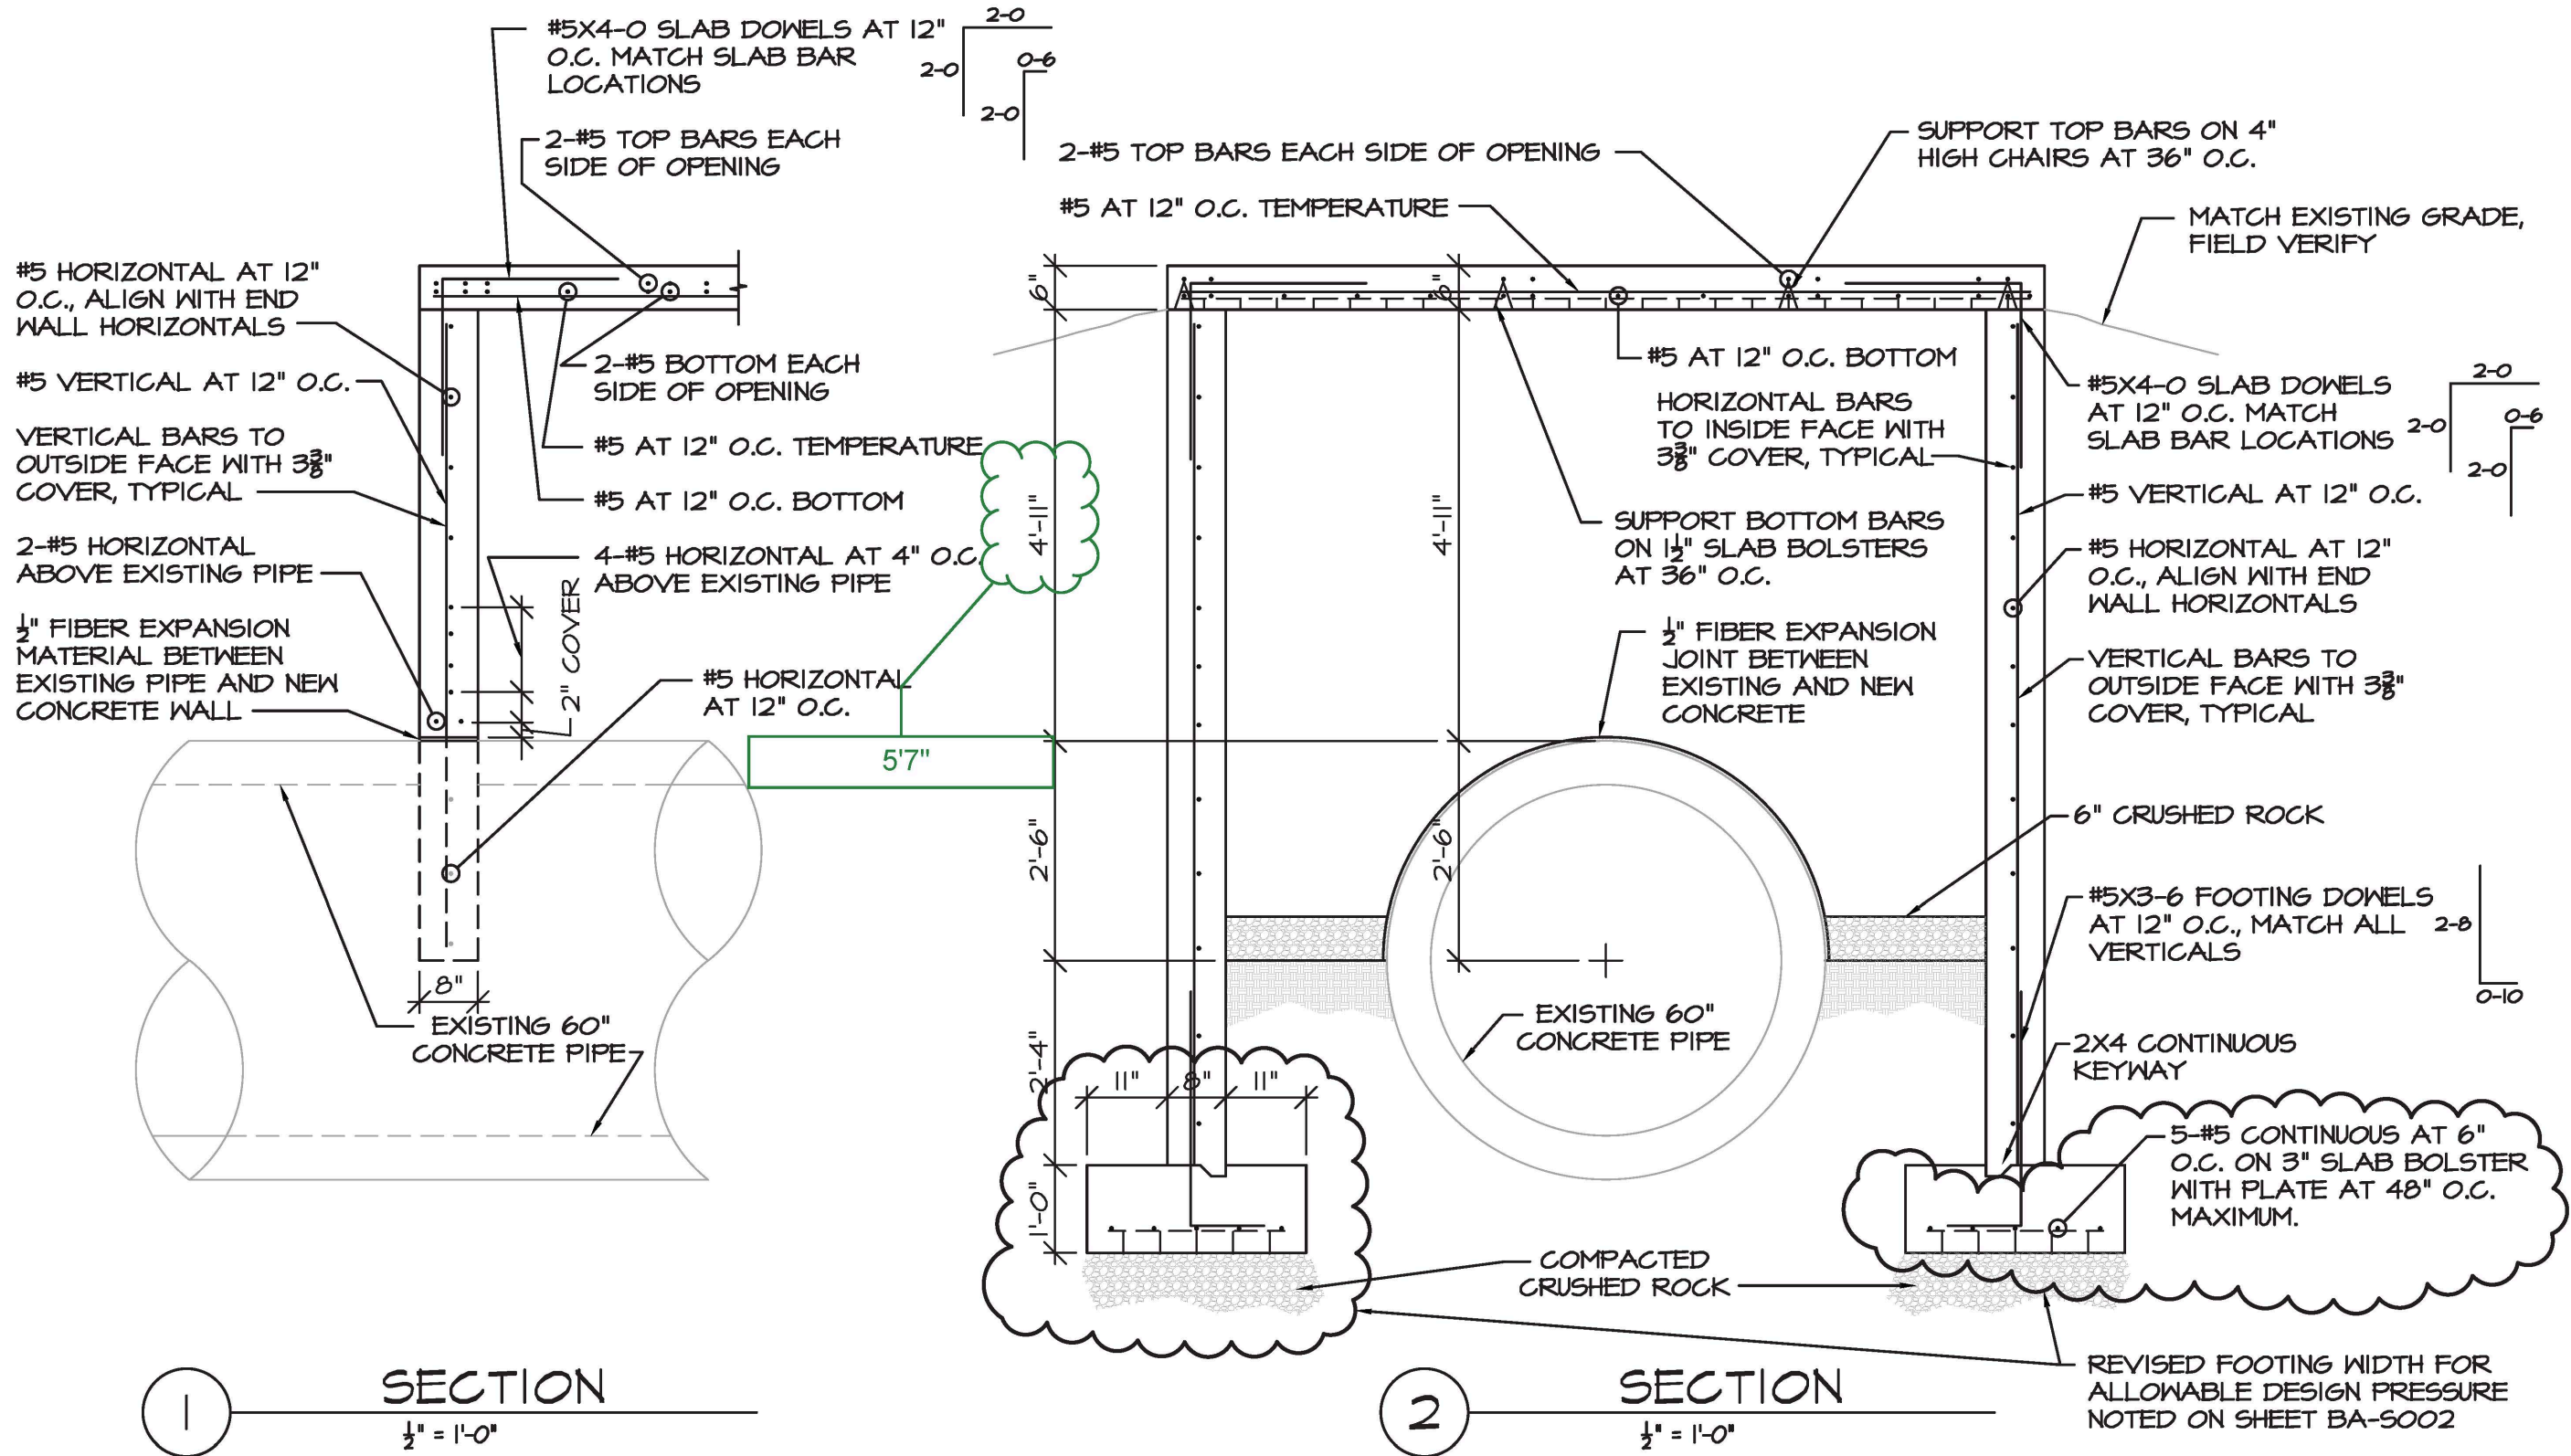

REFERENCE DRAWING

Dudley Williams and Associates, P.A.
 230 Laura • Suite 200 • Wichita, KS 67211-1514
 316-263-7591 • www.dwise.com



CITY OF WICHITA
 CHENEY TRANSMISSION LINE IMPROVEMENTS
 VAULTS 14, 19, AND 21 REPLACEMENT
 DONDLINGER CONSTRUCTION

PROJECT NO.
 17-248
 DATE
 DEC. 22, 2017
 REVISED JAN 12, 2018

RS2