


Saved: 02-18-2016 11:45:23 AM by CAL
 C:\Users\cal\Desktop\Drawings\As-Built\14229-001_C1-Key_Map_RECORD
 U:\Wichita-Final\14229-001\W&W\Drawings\As-Built\14229-001_C1-Key_Map_RECORD

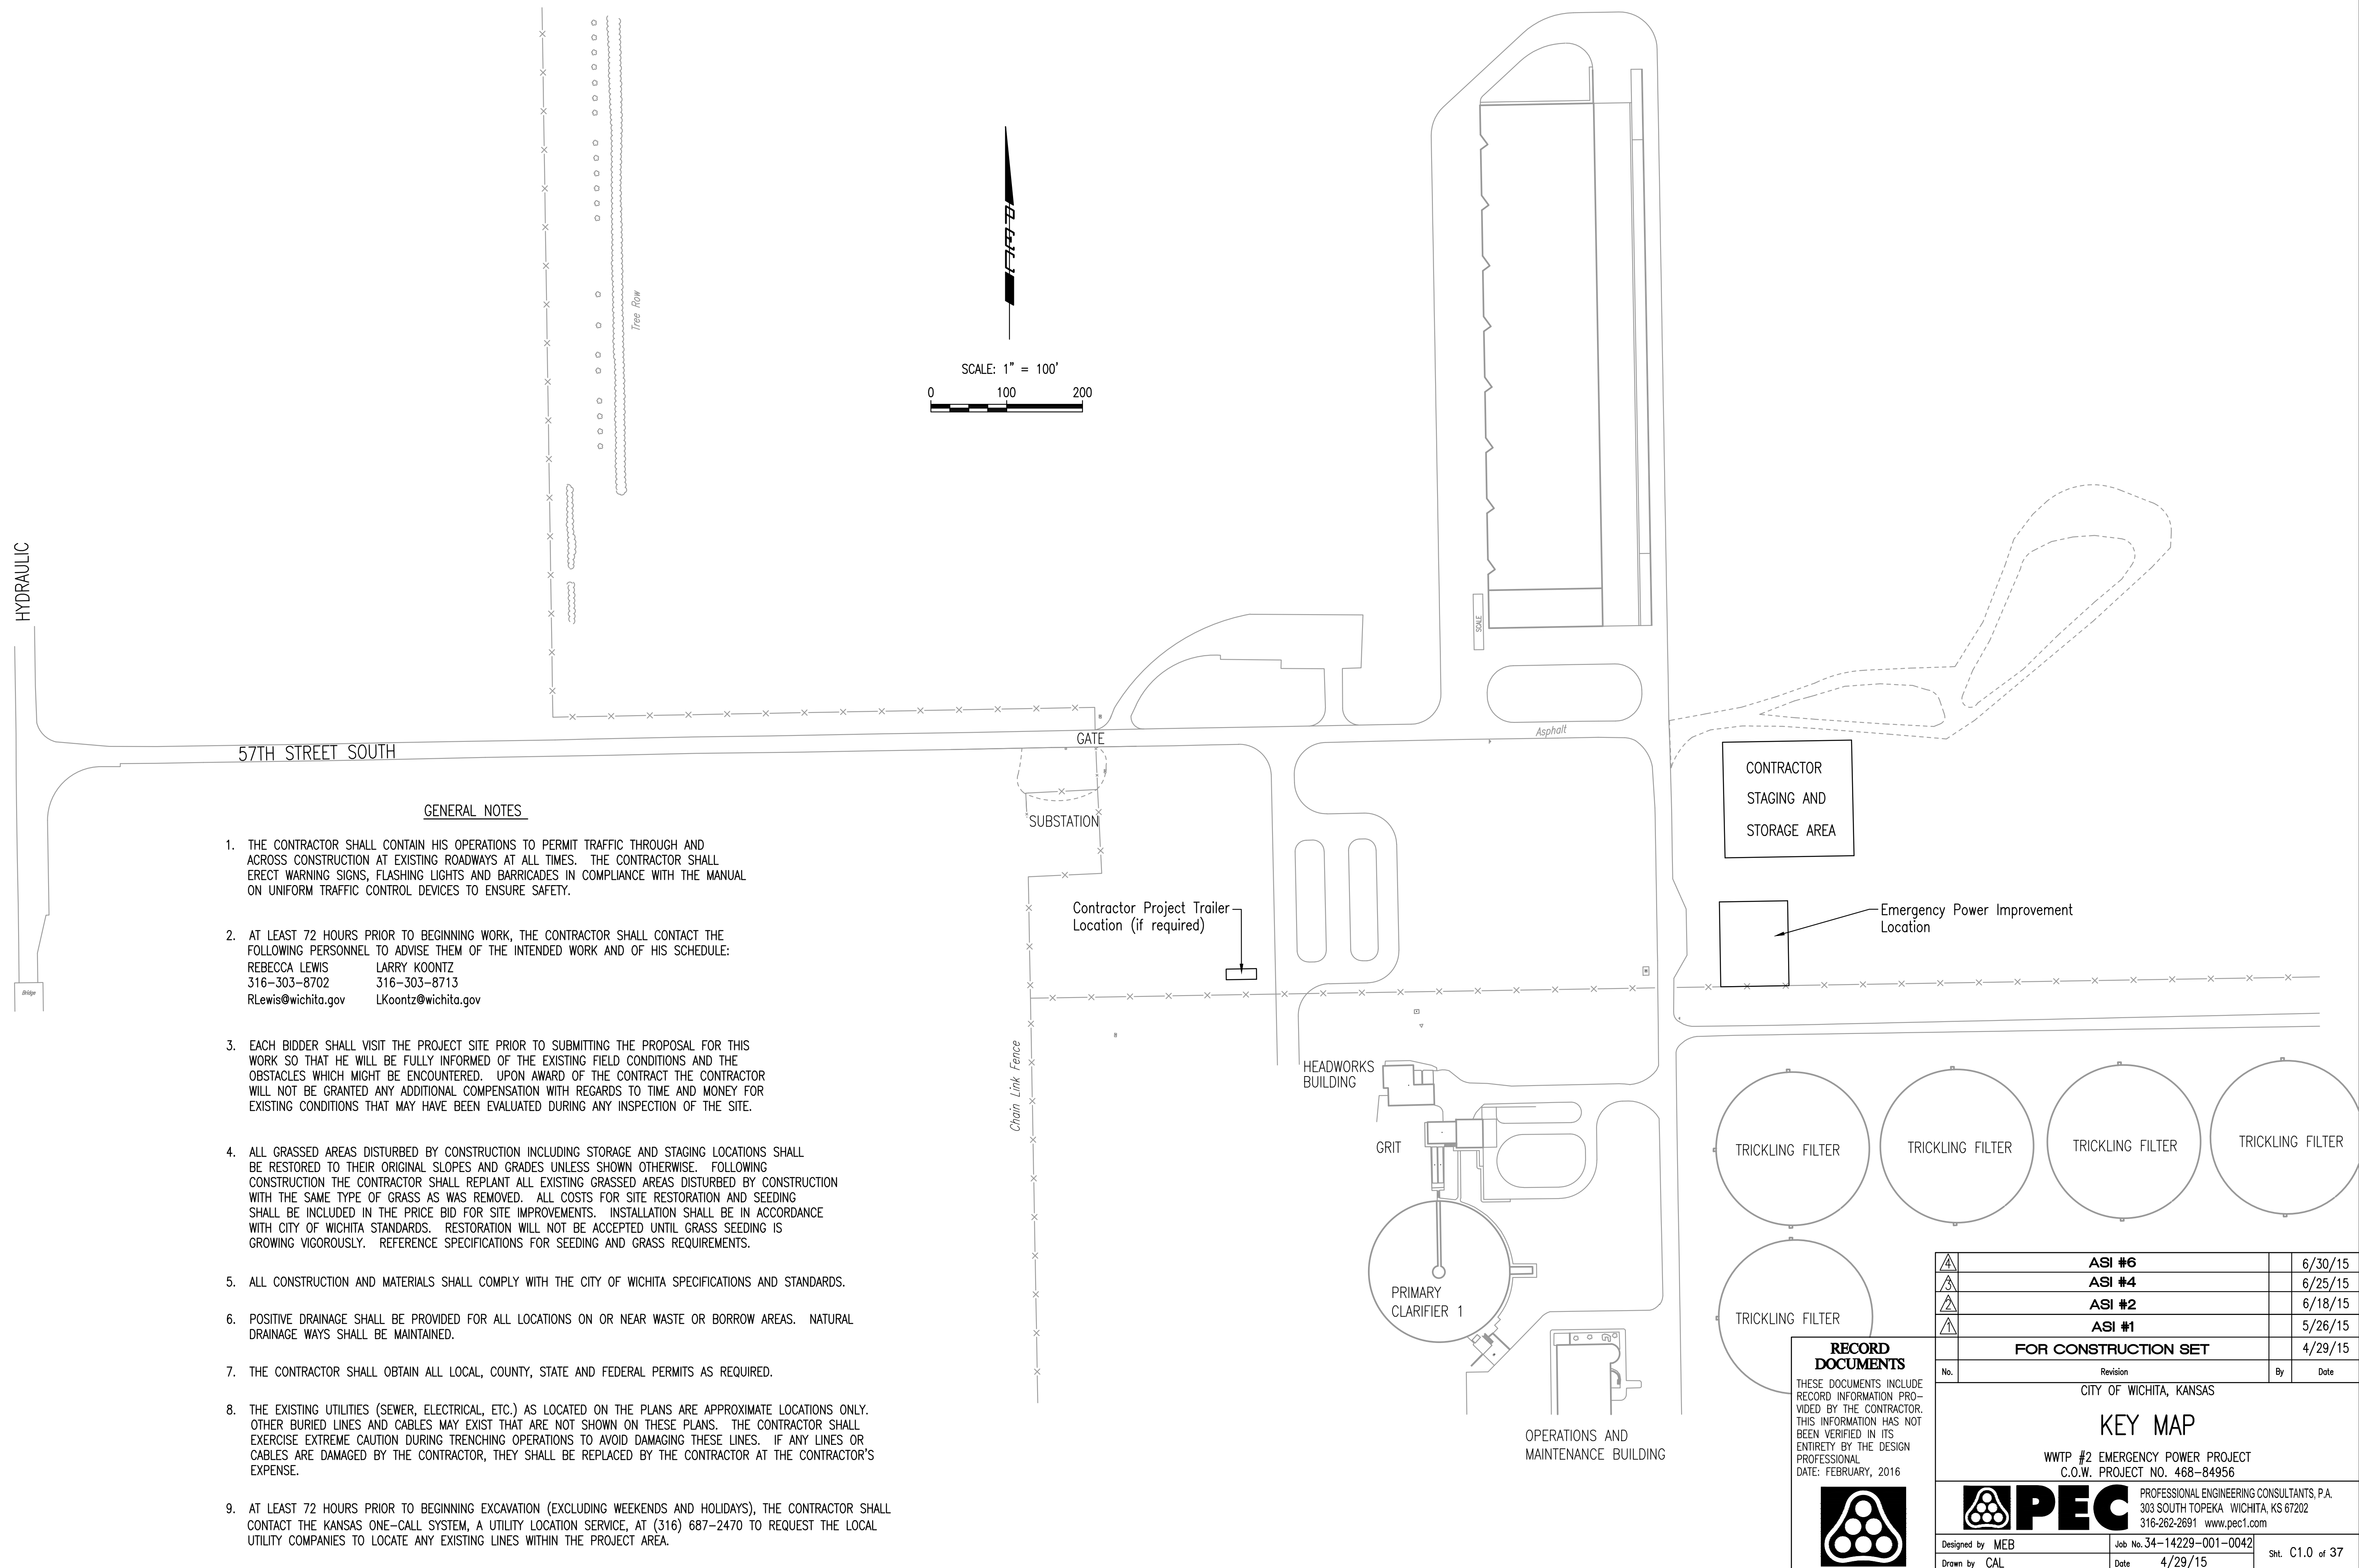


GENERAL NOTES

1. THE CONTRACTOR SHALL CONTAIN HIS OPERATIONS TO PERMIT TRAFFIC THROUGH AND ACROSS CONSTRUCTION AT EXISTING ROADWAYS AT ALL TIMES. THE CONTRACTOR SHALL ERECT WARNING SIGNS, FLASHING LIGHTS AND BARRICADES IN COMPLIANCE WITH THE MANUAL ON UNIFORM TRAFFIC CONTROL DEVICES TO ENSURE SAFETY.
2. AT LEAST 72 HOURS PRIOR TO BEGINNING WORK, THE CONTRACTOR SHALL CONTACT THE FOLLOWING PERSONNEL TO ADVISE THEM OF THE INTENDED WORK AND OF HIS SCHEDULE:
 REBECCA LEWIS LARRY KOONTZ
 316-303-8702 316-303-8713
 RLewis@wichita.gov LKoontz@wichita.gov
3. EACH BIDDER SHALL VISIT THE PROJECT SITE PRIOR TO SUBMITTING THE PROPOSAL FOR THIS WORK SO THAT HE WILL BE FULLY INFORMED OF THE EXISTING FIELD CONDITIONS AND THE OBSTACLES WHICH MIGHT BE ENCOUNTERED. UPON AWARD OF THE CONTRACT THE CONTRACTOR WILL NOT BE GRANTED ANY ADDITIONAL COMPENSATION WITH REGARDS TO TIME AND MONEY FOR EXISTING CONDITIONS THAT MAY HAVE BEEN EVALUATED DURING ANY INSPECTION OF THE SITE.
4. ALL GRASSED AREAS DISTURBED BY CONSTRUCTION INCLUDING STORAGE AND STAGING LOCATIONS SHALL BE RESTORED TO THEIR ORIGINAL SLOPES AND GRADES UNLESS SHOWN OTHERWISE. FOLLOWING CONSTRUCTION THE CONTRACTOR SHALL REPLANT ALL EXISTING GRASSED AREAS DISTURBED BY CONSTRUCTION WITH THE SAME TYPE OF GRASS AS WAS REMOVED. ALL COSTS FOR SITE RESTORATION AND SEEDING SHALL BE INCLUDED IN THE PRICE BID FOR SITE IMPROVEMENTS. INSTALLATION SHALL BE IN ACCORDANCE WITH CITY OF WICHITA STANDARDS. RESTORATION WILL NOT BE ACCEPTED UNTIL GRASS SEEDING IS GROWING VIGOROUSLY. REFERENCE SPECIFICATIONS FOR SEEDING AND GRASS REQUIREMENTS.
5. ALL CONSTRUCTION AND MATERIALS SHALL COMPLY WITH THE CITY OF WICHITA SPECIFICATIONS AND STANDARDS.
6. POSITIVE DRAINAGE SHALL BE PROVIDED FOR ALL LOCATIONS ON OR NEAR WASTE OR BORROW AREAS. NATURAL DRAINAGE WAYS SHALL BE MAINTAINED.
7. THE CONTRACTOR SHALL OBTAIN ALL LOCAL, COUNTY, STATE AND FEDERAL PERMITS AS REQUIRED.
8. THE EXISTING UTILITIES (SEWER, ELECTRICAL, ETC.) AS LOCATED ON THE PLANS ARE APPROXIMATE LOCATIONS ONLY. OTHER BURIED LINES AND CABLES MAY EXIST THAT ARE NOT SHOWN ON THESE PLANS. THE CONTRACTOR SHALL EXERCISE EXTREME CAUTION DURING TRENCHING OPERATIONS TO AVOID DAMAGING THESE LINES. IF ANY LINES OR CABLES ARE DAMAGED BY THE CONTRACTOR, THEY SHALL BE REPLACED BY THE CONTRACTOR AT THE CONTRACTOR'S EXPENSE.
9. AT LEAST 72 HOURS PRIOR TO BEGINNING EXCAVATION (EXCLUDING WEEKENDS AND HOLIDAYS), THE CONTRACTOR SHALL CONTACT THE KANSAS ONE-CALL SYSTEM, A UTILITY LOCATION SERVICE, AT (316) 687-2470 TO REQUEST THE LOCAL UTILITY COMPANIES TO LOCATE ANY EXISTING LINES WITHIN THE PROJECT AREA.

▲	ASI #6	6/30/15
▲	ASI #4	6/25/15
▲	ASI #2	6/18/15
▲	ASI #1	5/26/15
FOR CONSTRUCTION SET		4/29/15

RECORD DOCUMENTS
 THESE DOCUMENTS INCLUDE RECORD INFORMATION PROVIDED BY THE CONTRACTOR. THIS INFORMATION HAS NOT BEEN VERIFIED IN ITS ENTIRETY BY THE DESIGN PROFESSIONAL.
 DATE: FEBRUARY, 2016

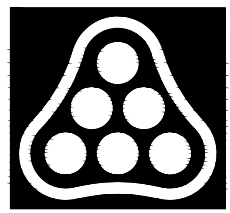

CITY OF WICHITA, KANSAS


KEY MAP

WWTP #2 EMERGENCY POWER PROJECT
 C.O.W. PROJECT NO. 468-84956

PEC PROFESSIONAL ENGINEERING CONSULTANTS, P.A.
 303 SOUTH TOPEKA WICHITA, KS 67202
 316-262-2691 www.pec1.com

Designed by MEB	Job No. 34-14229-001-0042	Sht. C1.0 of 37
Drawn by CAL	Date 4/29/15	

Save: 02-18-2016 1:45:13 AM by CAL
 C:\Users\cal\Desktop\14229-001\Drawings\14229-001\W&W\Drawings\14229-001_C2 Demo Plan_RECORD
 U:\Wichita-Final\14229-001\W&W\Drawings\14229-001_C2 Demo Plan_RECORD

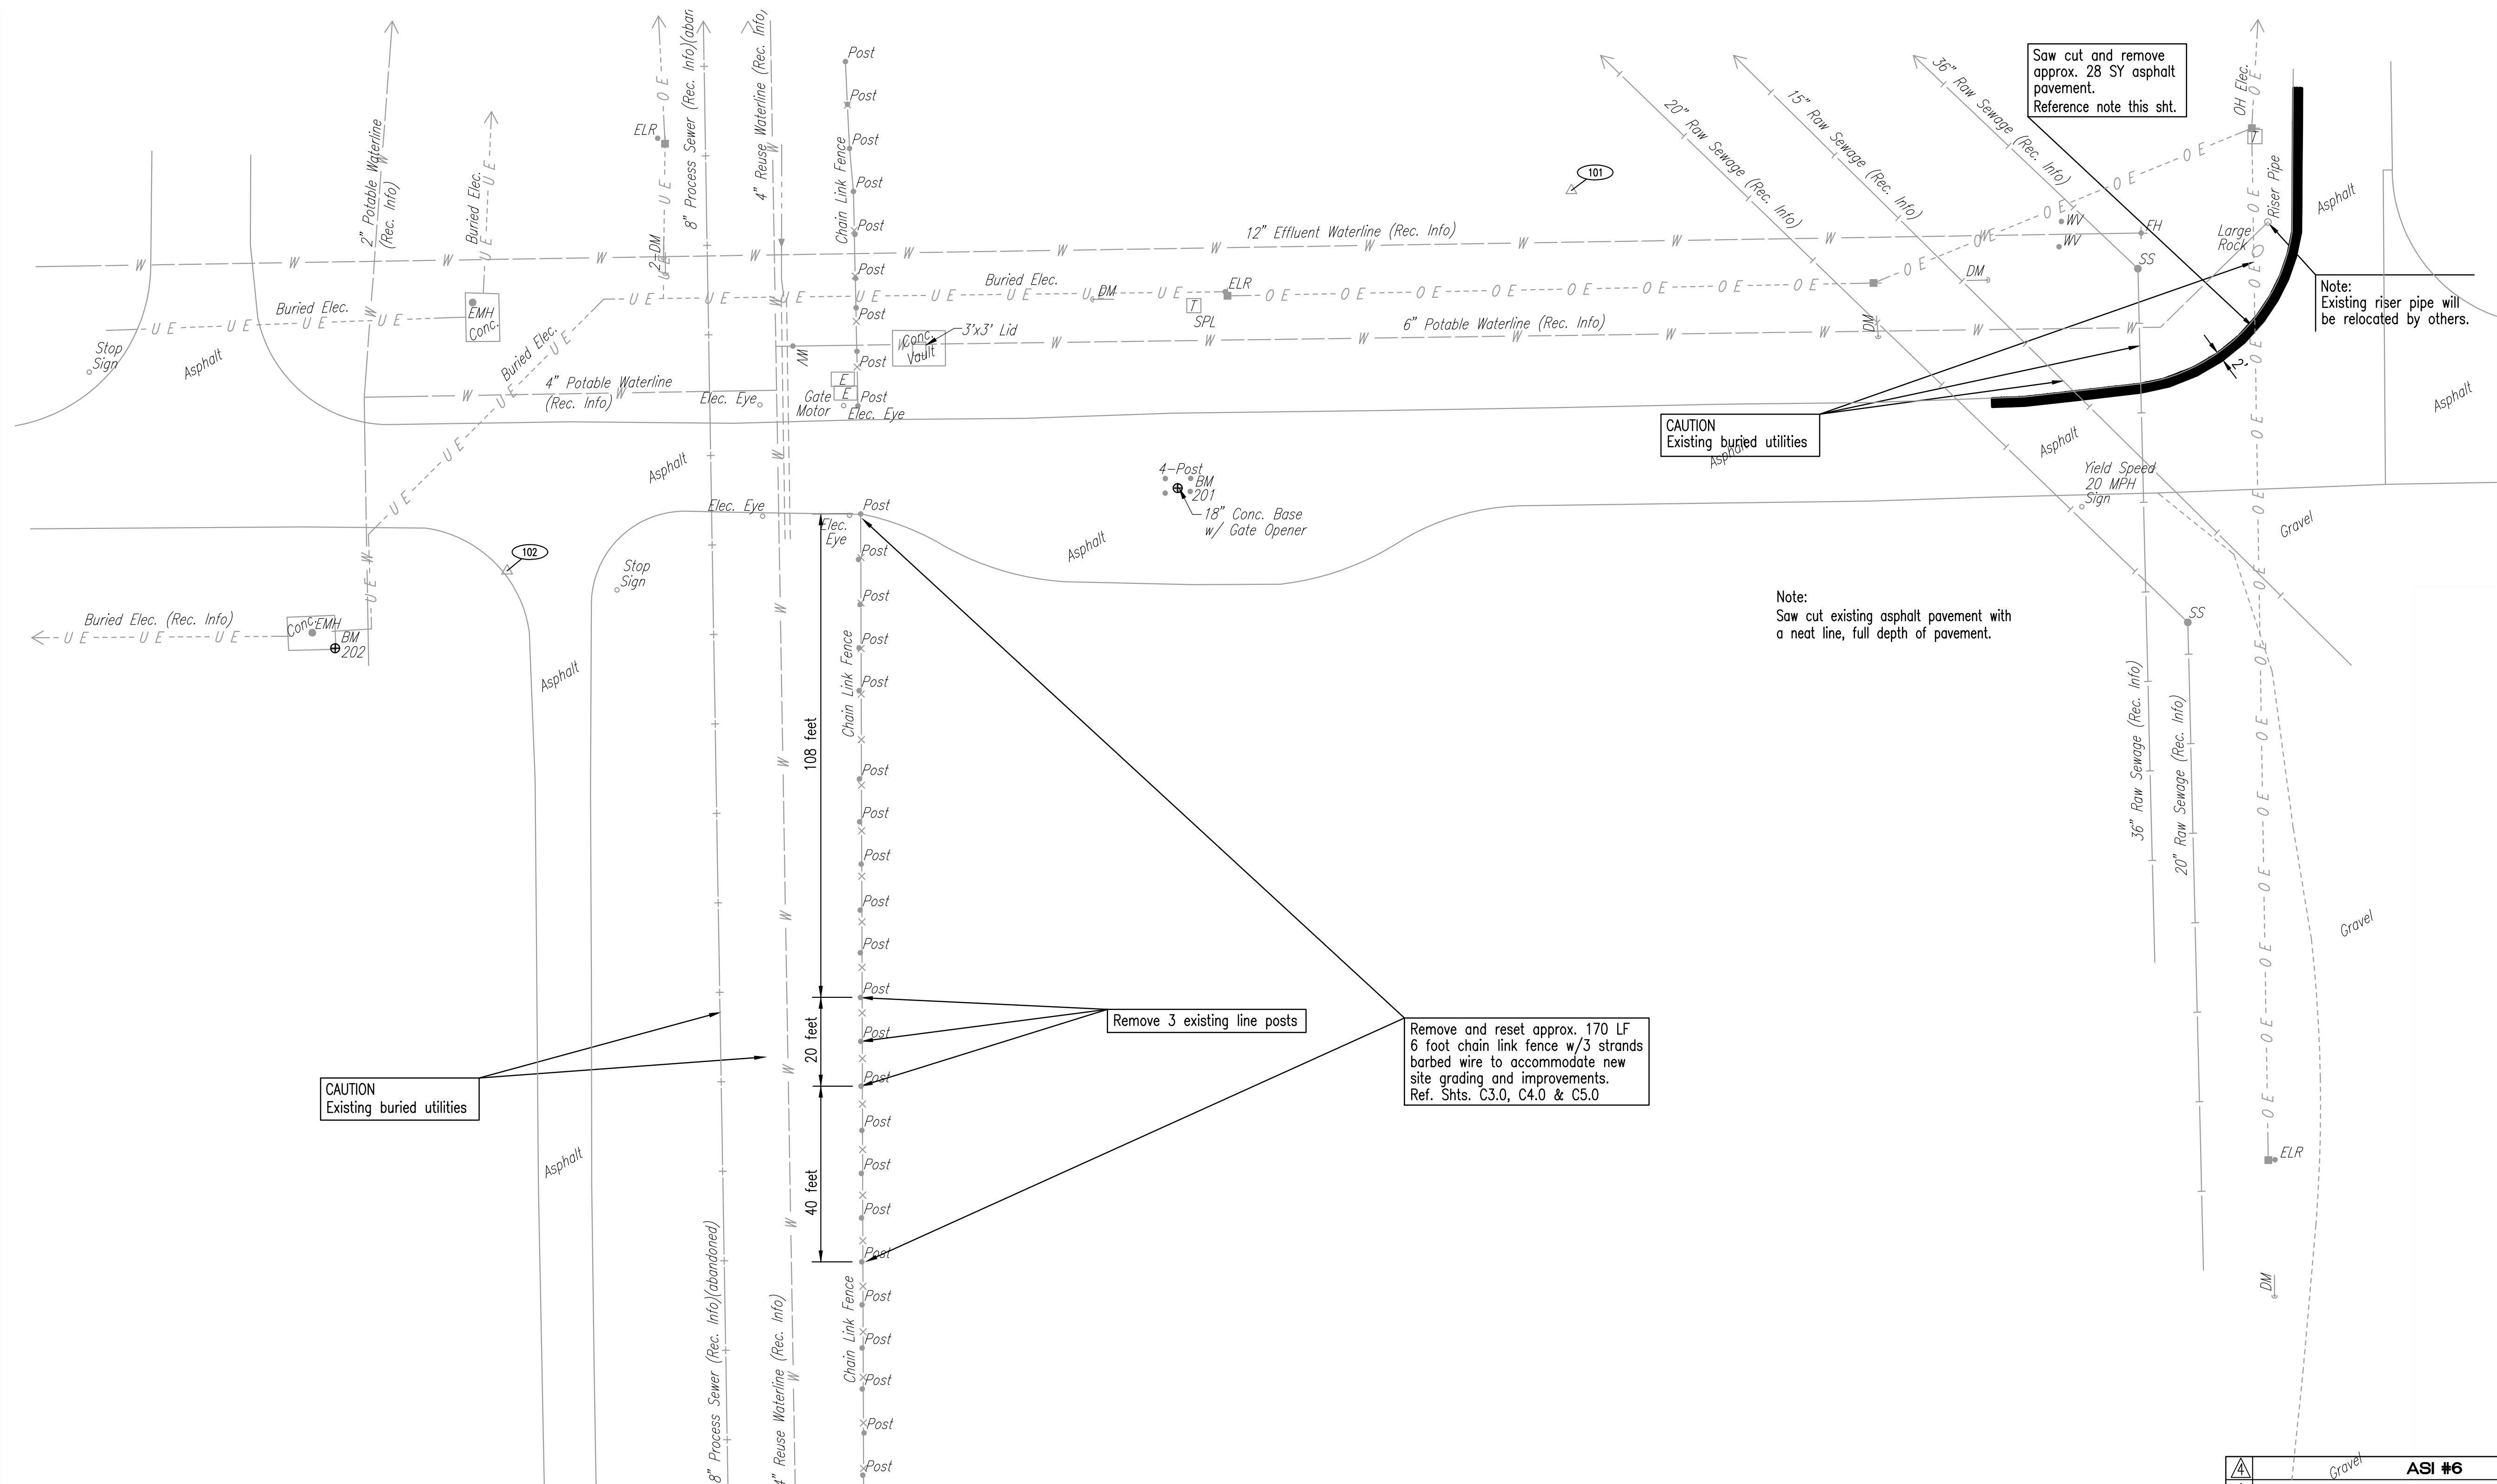

Scale: 1" = 20'


▲	ASI #6	6/30/15
▲	ASI #4	6/25/15
▲	ASI #2	6/18/15
▲	ASI #1	5/26/15
FOR CONSTRUCTION SET		4/29/15

RECORD DOCUMENTS
 THESE DOCUMENTS INCLUDE RECORD INFORMATION PROVIDED BY THE CONTRACTOR. THIS INFORMATION HAS NOT BEEN VERIFIED IN ITS ENTIRETY BY THE DESIGN PROFESSIONAL.
 DATE: FEBRUARY, 2016

CITY OF WICHITA, KANSAS

DEMOLITION SITE PLAN


WWTP #2 EMERGENCY POWER PROJECT
 C.O.W. PROJECT NO. 468-84956



PROFESSIONAL ENGINEERING CONSULTANTS, P.A.
 303 SOUTH TOPEKA WICHITA, KS 67202
 316-262-2691 www.pec1.com

Designed by MEB	Job No. 34-14229-001-0042	Sht. C2.0 of 37
Drawn by CAL	Date 4/29/15	

Saved: 02-18-2016, 1:44:45 AM by CA
 User: C:\Users\ca\Documents\Drawings\14229-001\14229-001\14229-001\14229-001.dwg
 User: C:\Users\ca\Documents\Drawings\14229-001\14229-001\14229-001\14229-001.dwg
 User: C:\Users\ca\Documents\Drawings\14229-001\14229-001\14229-001\14229-001.dwg

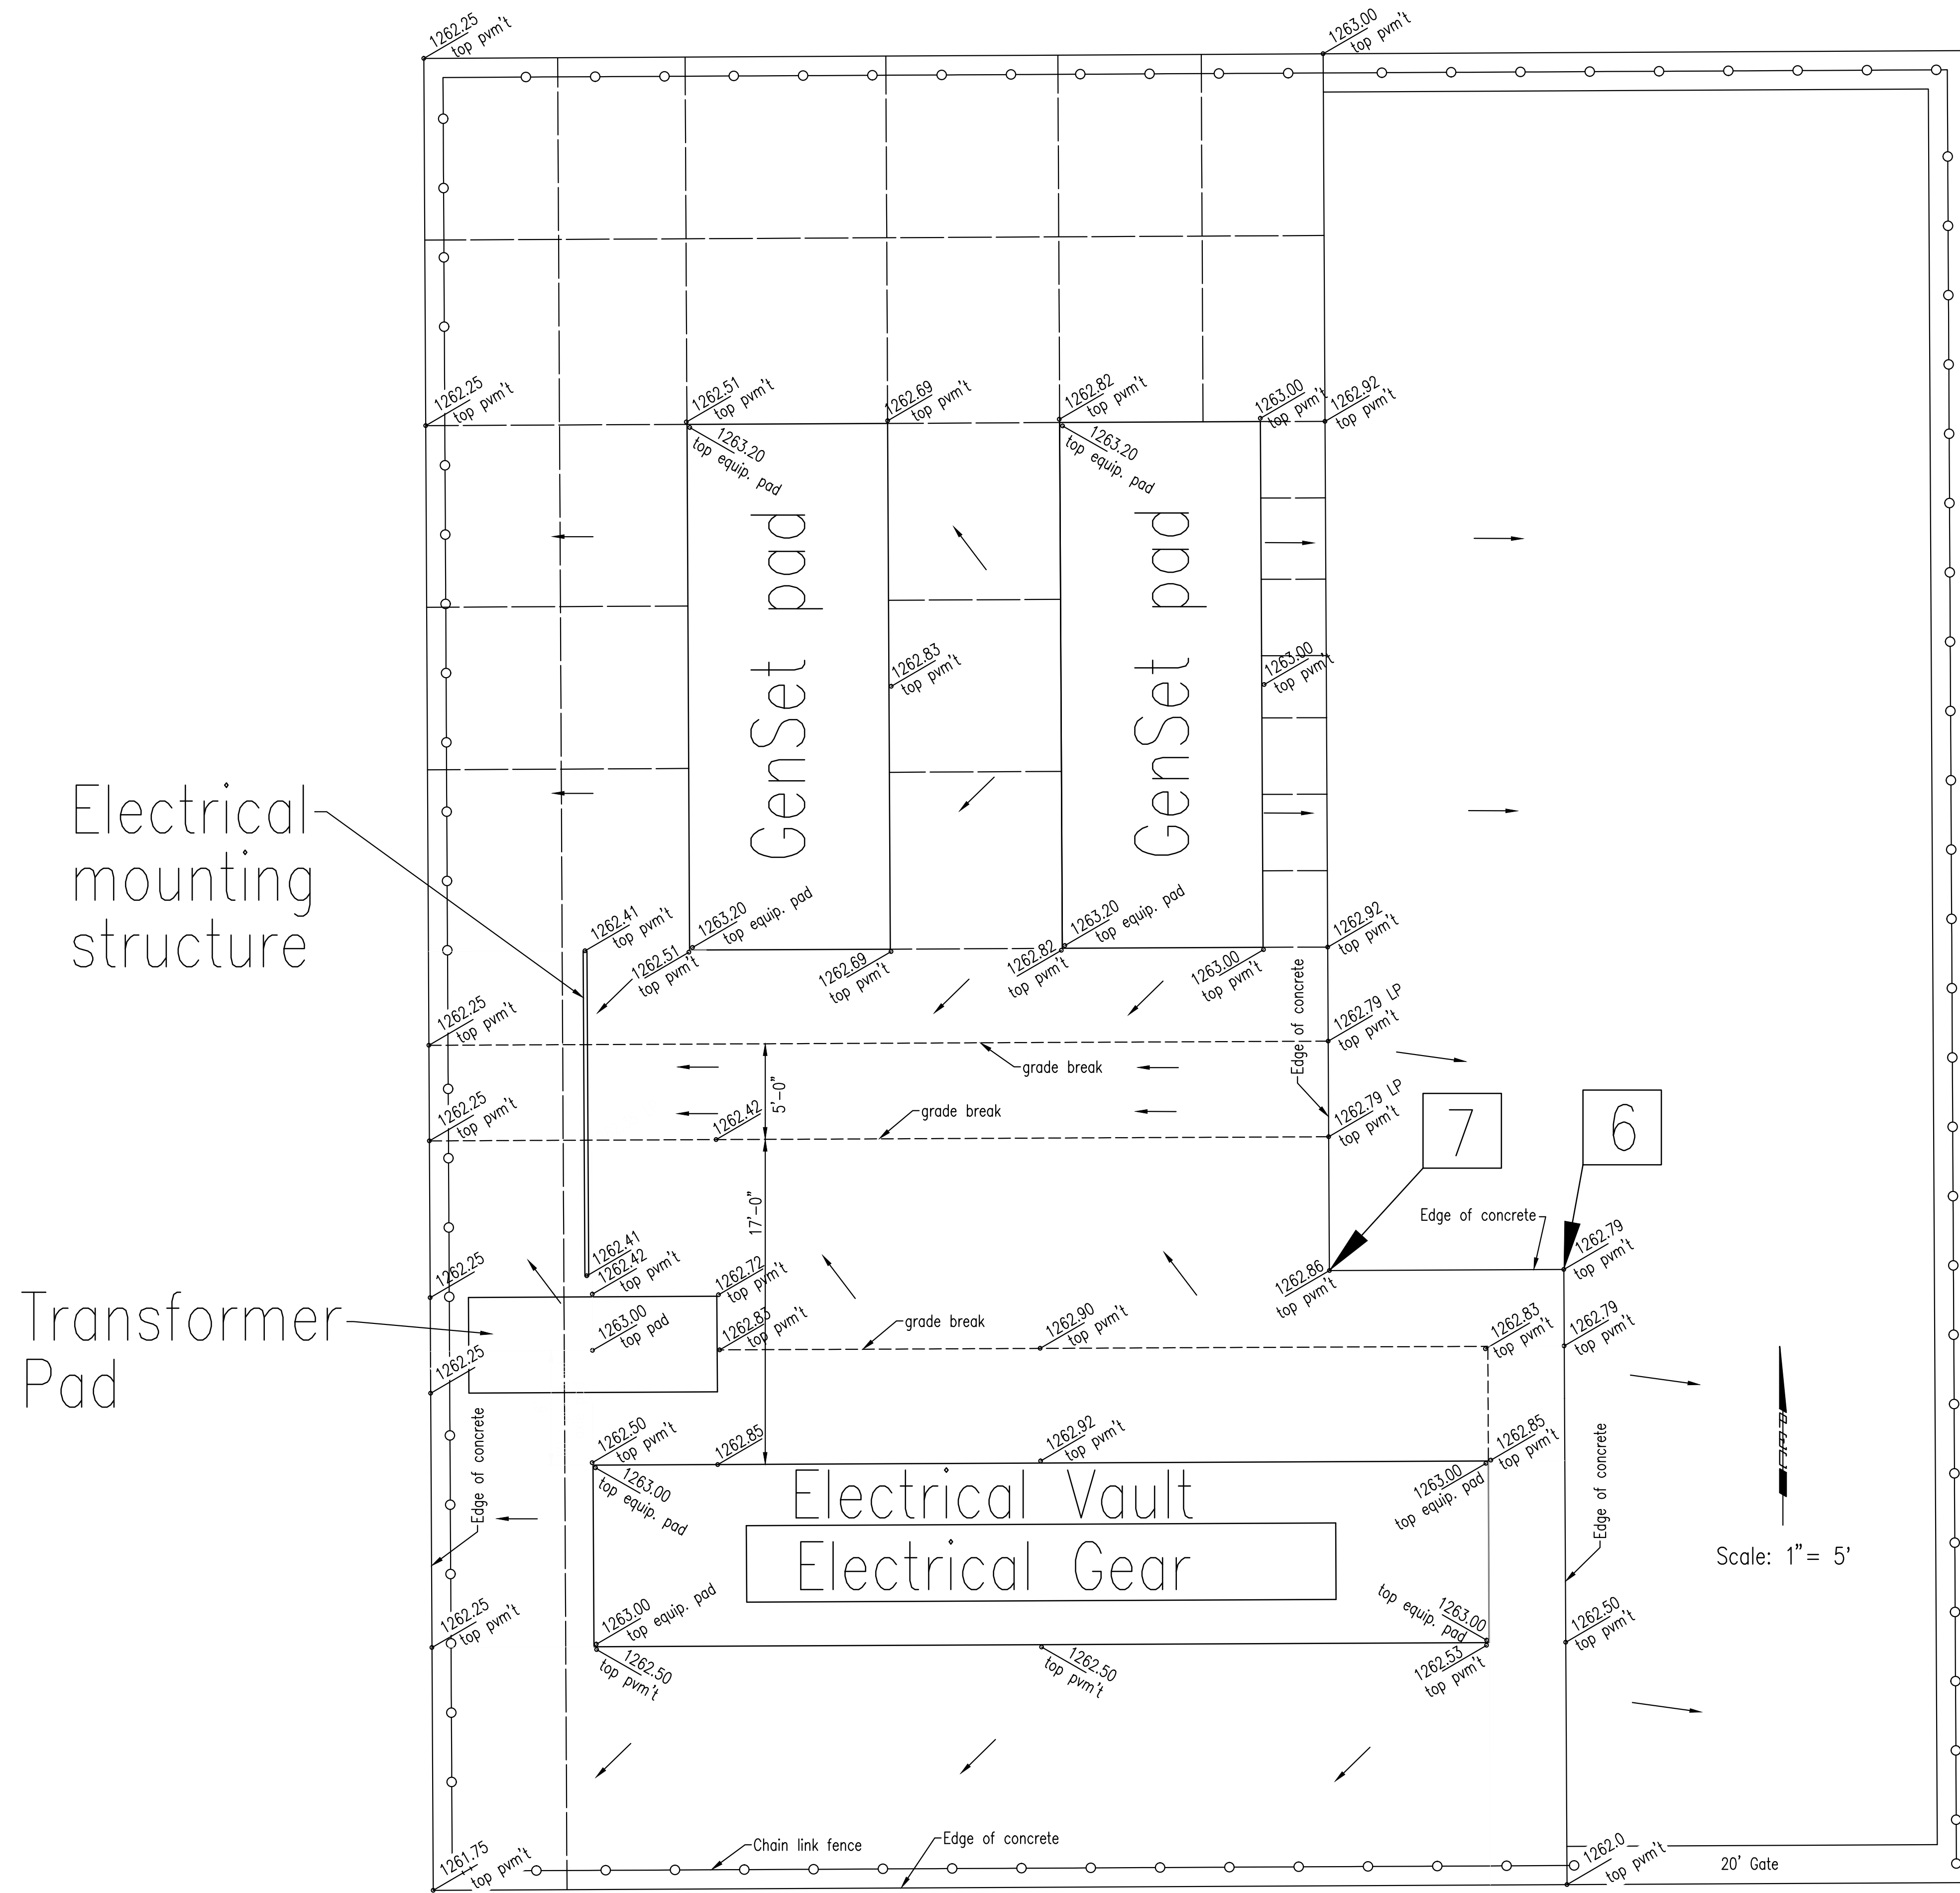

No.	Revision	By	Date
▲	ASI #6		6/30/15
▲	ASI #4		6/25/15
▲	ASI #2		6/18/15
▲	ASI #1		5/26/15

FOR CONSTRUCTION SET
 CITY OF WICHITA, KANSAS
PAVEMENT PLAN REVISION
 WWTP #2 EMERGENCY POWER PROJECT
 C.O.W. PROJECT NO. 468-84956

 PEC PROFESSIONAL ENGINEERING CONSULTANTS, P.A. 303 SOUTH TOPEKA WICHITA, KS 67202 316-262-2691 www.pec1.com	Job No. 34-14229-001-0042 Date 4/29/15	Sht. of 37
---	---	------------

RECORD DOCUMENTS
 THESE DOCUMENTS INCLUDE RECORD INFORMATION PROVIDED BY THE CONTRACTOR. THIS INFORMATION HAS NOT BEEN VERIFIED IN ITS ENTIRETY BY THE DESIGN PROFESSIONAL.
 DATE: FEBRUARY, 2016

STANDARD SPECIFICATIONS FOR CHAIN LINK FENCE AND GATES

GENERAL:

THIS SPECIFICATION COVERS CHAIN LINK FENCE INSTALLATION AND MATERIALS INCLUDING CHAIN LINK FABRIC, FRAMEWORK, GATES AND FITTINGS.

FENCE SHALL BE A MINIMUM OF 7'-0" HIGH ABOVE FINISHED GRADE, USING 6'-0" HIGH CHAIN LINK FABRIC AND SURMOUNTED BY THREE (3) STRANDS OF BARBED WIRE.


MATERIALS:

- A. FABRIC: CHAIN LINK FABRIC SHALL BE 9 GAUGE HOT DIP GALVANIZED WITH A MINIMUM OF 1.2 OUNCES OF ZINC PER SQUARE FOOT OF SURFACE AREA WHEN DETERMINED IN ACCORDANCE WITH THE REQUIREMENTS OF ASTM A-90. FABRIC SHALL BE WOVEN IN A 2" DIAMOND MESH AND SHALL BE 72" HIGH. THE TOP SELVAGE SHALL BE TWISTED AND BARBED AND THE BOTTOM SELVAGE MAY BE KNUCKLED OR TWISTED AND BARBED.
- B. FRAMEWORK: ALL LINE POSTS, TERMINALS, BRACES, TOP RAILS, GATE POSTS, AND GATE FRAMES SHALL BE HOT DIP GALVANIZED. GALVANIZING, EXCEPT HIGH STRENGTH PIPE, SHALL BE 1.8 OUNCES OF ZINC PER SQUARE FOOT OF SURFACE AREA WHEN DETERMINED IN ACCORDANCE WITH THE REQUIREMENTS OF ASTM A-53 OR ASTM A-123. HIGH-STRENGTH PIPE SHALL BE COATED WITH A TYPE B COATING IN ACCORDANCE WITH ASTM F 1234.

1. LINE POSTS SHALL BE 1.875" X 1.700" C-SECTION (STD. - C) WEIGHING 2.28 LBS./FT., 2.375" HIGH STRENGTH PIPE WEIGHING 3.12 LBS./FT., 2.375" SCHEDULE 40 PIPE WEIGHING 3.65 LBS./FT., OR POSTS PROVIDING EQUIVALENT OR GREATER STRENGTH CHARACTERISTICS TO THOSE POSTS NOTED.
2. TERMINAL POSTS (END, CORNER, AND PULL) SHALL BE 2.875" HIGH STRENGTH PIPE WEIGHING 4.64 LBS./FT., 2.875" SCHEDULE 40 PIPE WEIGHING 5.79 LBS./FT., OR POSTS PROVIDING EQUIVALENT OR GREATER STRENGTH CHARACTERISTICS TO THOSE POSTS NOTED.
3. GATE POSTS SHALL BE OF THE SIZE AND TYPE RECOMMENDED BY THE GATE MANUFACTURER.
4. TOP RAIL AND BRACE RAILS SHALL BE 1.625" X 1.250" C-RAIL WEIGHING 1.35 LBS./FT., 1.660" HIGH STRENGTH STEEL WEIGHING 1.82 LBS./FT., 1.660" SCHEDULE 40 PIPE WEIGHING 2.27 LBS./FT., OR SECTION PROVIDING EQUIVALENT OR GREATER STRENGTH CHARACTERISTICS TO THOSE RAIL SECTIONS NOTED. TOP RAIL SECTIONS SHALL BE A MINIMUM OF 20'-0", EXCEPT AS NECESSARY TO MAKE CONNECTIONS TO TERMINAL POSTS, AND BE FITTED OR FURNISHED WITH COUPLINGS TO PROVIDE A SATISFACTORY CONNECTION OF ADJACENT SECTIONS.
5. BOTTOM TENSION WIRE SHALL BE NO. 7 GAUGE GALVANIZED STEEL WIRE WITH 1.2 OUNCES OF ZINC PER SQUARE FOOT OF SURFACE AREA.
6. FITTINGS SHALL BE PRESSED STEEL, MALLEABLE IRON, OR CAST IRON OF GOOD COMMERCIAL QUALITY IN CONFORMANCE WITH ASTM F-626. STEEL FITTINGS SHALL BE GALVANIZED WITH 1.2 OUNCES OF ZINC PER SQUARE FOOT IN ACCORDANCE WITH ASTM A-153.
7. GATE FRAMES SHALL BE A MINIMUM OF 1.900" HIGH STRENGTH PIPE, 1.900" SCHEDULE 40 PIPE, OR SECTION PROVIDING EQUIVALENT OR GREATER STRENGTH CHARACTERISTICS. FRAMES FOR LARGE SWING GATES SHALL BE CONSTRUCTED WITH MATERIALS OF THE SIZE AND TYPE RECOMMENDED BY THE GATE MANUFACTURER.
8. GATE AND OTHER MISCELLANEOUS HARDWARE SHALL BE STRUCTURALLY CAPABLE OF SUPPORTING GATES, FABRIC, RAILS, WIRE OR OTHER ITEMS FOR WHICH SAID HARDWARE IS PROVIDED.
9. BARBED WIRE SHALL BE DOUBLE STRAND TWISTED 12 1/2 GAUGE ZINC COATED WIRE WITH 4-POINT BARBS AND SHALL COMPLY WITH THE REQUIREMENTS OF ASTM A-121, CLASS 3.
10. FENCING CONTRACTOR SHALL PROVIDE AND INSTALL PRIVACY SLATS IN CHAIN LINK FENCE FABRIC. SLAT COLOR SELECTION BY OWNER.

C. GATES:

1. FRAMES MAY BE ASSEMBLED BY WELDING OR WITH USE OF SUITABLE STEEL HARDWARE FITTINGS. ALL WELDED AREAS SHALL BE COVERED WITH A RUST PREVENTATIVE COATING. ALL HARDWARE USED, INCLUDING SUPPORTS, ROLLERS AND LATCHES, SHALL BE OF ADEQUATE DESIGN AND STRENGTH TO PROVIDE SATISFACTORY OPERATION OF THE GATE(S). INTERIOR BRACING SHALL BE PROVIDED AS RECOMMENDED BY THE MANUFACTURER.
2. GATE FABRIC SHALL BE OF THE SAME TYPE, SIZE OF MESH, GAGE SIZE OF WIRE AND SELVAGE AS THAT SPECIFIED FOR FENCE.
3. THE END MEMBERS OF THE GATE FRAMES SHALL EXTEND ONE (1) FOOT ABOVE THE TOP HORIZONTAL SECTION OF THE GATE FRAME. THREE STRANDS OF BARBED WIRE SHALL BE UNIFORMLY SPACED AND SHALL BE ATTACHED TO THE ONE (1) FOOT EXTENSIONS BY BANDS, CLIPS OR EYEBOLTS.
4. LATCHES, HINGES, STOPS AND KEEPERS SHALL BE GALVANIZED STEEL. THE GALVANIZED COATING SHALL BE 1.2 OUNCES OF ZINC PER SQUARE FOOT UNLESS OTHERWISE SPECIFIED.
5. SINGLE GATE LATCHES SHALL BE FORK TYPE, GRAVITY DROP BAR TYPE WITH POSITIVE LOCKING FEATURES OR PLUNGER BAR TYPE OF FULL GATE HEIGHT.
6. DOUBLE GATE LATCHES SHALL BE FORK TYPE LATCH WITH CENTER DROP ROD, OR PLUNGER BAR TYPE OF FULL GATE HEIGHT ARRANGED TO ENGAGE THE GATE STOP, OR A POSITIVE LOCKING GRAVITY DEVICE. LOCKING DEVICES SHALL BE CONSTRUCTED SO THAT THE CENTER DROP ROD OR PLUNGER BAR CANNOT BE RAISED WHEN LOCKED.
7. CENTER GATE STOP SHALL BE PROVIDED FOR ALL DOUBLE GATES AND SHALL BE SUITABLE FOR SETTING IN CONCRETE OR WITH ANCHORS FOR THE CENTER DROP ROD OR PLUNGER.
8. KEEPERS SHALL BE PROVIDED FOR EACH GATE LEAF OVER FIVE (5) FEET WIDE. GATE KEEPERS SHALL CONSIST OF A MECHANICAL DEVICE FOR SECURING THE FREE END OF THE GATE WHEN IN FULL OPEN POSITION.
9. GATE HINGES SHALL BE OF ADEQUATE STRENGTH FOR THE GATE, AND SHALL HAVE LARGE BEARING SURFACES FOR CLAMPING OR BOLTING IN POSITION. HINGE ACTION SHALL BE SUCH THAT GATES MAY BE EASILY OPENED AND CLOSED BY ONE PERSON. HINGES SHALL PROVIDE FOR FULL 180 SWING OF GATE LEAF.
10. SINGLE OR DOUBLE CANTILEVER OR ROLLER GATES SHALL BE FURNISHED WHEN SPECIFIED ON THE PLANS. ROLLER OR CANTILEVER GATES SHALL BE OF A TYPE SUITABLE FOR FITTING OF ELECTROMECHANICAL OPERATORS WHETHER SPECIFIED OR NOT. DIRECTION OF OPERATION AND MINIMUM CLEAR OPENING SHALL BE THAT SHOWN ON THE PLANS OR SPECIFIED BY THE OWNER.
11. PADLOCKS WILL BE FURNISHED BY THE OWNER.
12. ALL GATES FURNISHED SHALL BE INDUSTRIAL STANDARD. SHOP DRAWINGS AND/OR CATALOG CUTS OF PROPOSED GATE DESIGN SHALL BE SUBMITTED FOR THE OWNER'S APPROVAL PRIOR TO ASSEMBLY AND DELIVERY TO THE SITE.

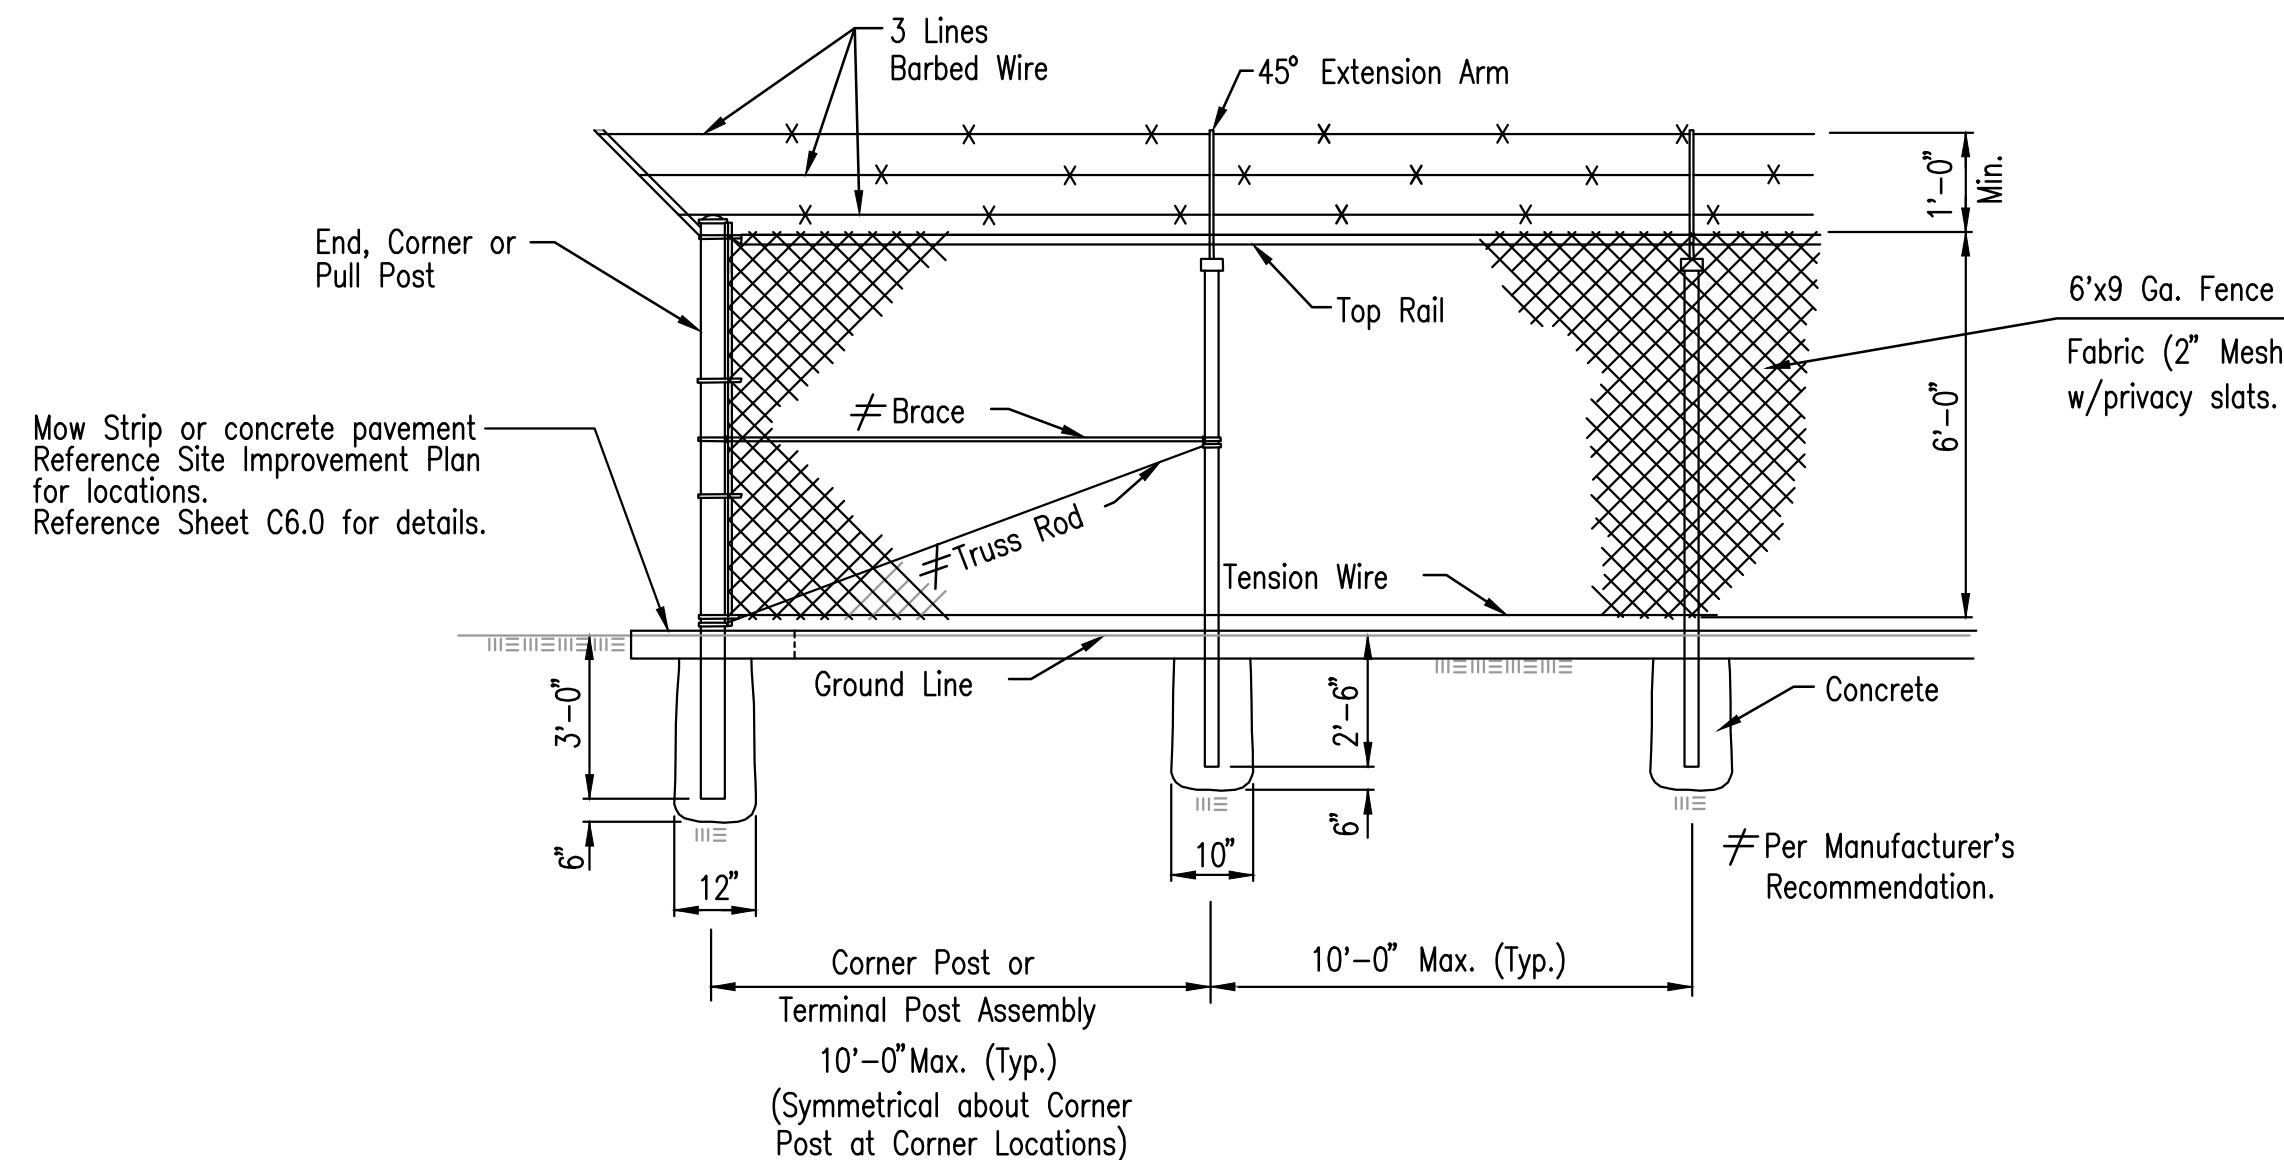

CHAIN LINK FENCE WITH BARBED WIRE

INSTALLATION:

- A. LINE POSTS SHALL BE OF SUFFICIENT LENGTH TO ALLOW FOR AN APPROXIMATE 30" SETTING INTO CONCRETE FOOTINGS. CONCRETE FOOTINGS FOR LINE POSTS SHALL BE A MINIMUM OF 10" DIAMETER WITH A MINIMUM OF 6" OF CONCRETE BELOW THE BOTTOM OF THE POSTS. PULL, END AND CORNER POSTS SHALL BE OF SUFFICIENT LENGTH TO ALLOW FOR AN APPROXIMATE 36" SETTING INTO CONCRETE FOOTINGS. CONCRETE FOOTINGS FOR THESE POSTS SHALL BE A MINIMUM OF 12" IN DIAMETER WITH A MINIMUM OF 6" OF CONCRETE BELOW THE BOTTOM OF THE POSTS. GATE POSTS AND THEIR FOOTINGS SHALL BE IN ACCORDANCE WITH THE RECOMMENDATIONS OF THE GATE MANUFACTURER. POSTS, OTHER THAN GATE POSTS, SHALL BE SET AT 10'-0" MAXIMUM CENTERS. PULL POSTS SHALL BE INSTALLED AT SHARP BREAKS IN VERTICAL GRADE, OR AT MAXIMUM 330' CENTERS ON STRAIGHT RUNS, OR AS OTHERWISE DIRECTED BY THE ENGINEER.
- B. CHAIN LINK FABRIC SHALL BE ATTACHED TO TERMINAL POSTS WITH MINIMUM 1/4" X 3/4" TENSION BARS AND 12 GAUGE BY 1" WIDE CLAMPS USING MINIMUM 3/8" DIAMETER CARRIAGE BOLTS. FABRIC SHALL BE FASTENED TO TOP RAIL, LINE POSTS AND TENSION WIRE WITH 9-GAUGE MINIMUM FABRIC TIE WIRES SPACED AT 24" MAXIMUM CENTERS OR WEAVED DIRECTLY INTO INTEGRAL LOCK LOOPS AS MAY BE FORMED IN THE POST(S) PROVIDED.
- C. EXTENSION ARMS TO ACCOMMODATE THE SURMOUNTED BARBED WIRE SHALL SLOPE AT A 45 DEGREE ANGLE TO THE OUTSIDE OF THE AREA BEING PROTECTED BY THE FENCE AND SHALL PROVIDE FOR AN APPROXIMATE 5" SPACING OF THE BARBED WIRE. SURMOUNTED BARBED WIRE SHALL BE SECURELY ATTACHED TO THE GATES AS RECOMMENDED BY THE GATE MANUFACTURER AND MAY BE MOUNTED IN A VERTICAL PLANE PARALLEL TO THAT OF THE GATE.
- D. ALL WORK SHALL BE ACCOMPLISHED BY MECHANICS SKILLED IN THE TRADE. ALL WORK, NOT OTHERWISE SHOWN ON THE PLANS OR DIRECTLY DESCRIBED HEREIN, SHALL BE IN ACCORDANCE WITH THE RECOMMENDATIONS OF THE MANUFACTURER AND THE CHAIN LINK FENCE MANUFACTURER'S INSTITUTE, UNLESS OTHERWISE APPROVED BY THE OWNER.
- E. ALL DIMENSIONS AND GAUGES OF MATERIAL ARE SUBJECT TO ACCEPTED INDUSTRY TOLERANCE STANDARDS. THE JOB SITE SHALL BE CLEARED OF ALL EXCESS SPILLAGE OF CONCRETE, CUT WIRES, ETC., AND MATERIAL REMOVED FROM POST HOLES SHALL BE REMOVED FROM THE SITE OR UNIFORMLY SCATTERED AS MAY BE APPROVED BY THE OWNER.
- F. UPON REQUEST OF THE OWNER OR OWNER'S AUTHORIZED REPRESENTATIVE, SAMPLES OF EACH COMPONENT AND/OR MILL CERTIFICATES CONFIRMING COMPLIANCE WITH THESE SPECIFICATIONS SHALL BE FURNISHED. ANY AND ALL MATERIAL AND WORK FOUND NOT TO BE IN COMPLIANCE WITH THE HEREIN DESCRIBED SPECIFICATIONS SHALL BE REMOVED AND REPLACED TO THE OWNER'S SATISFACTION AT THE CONTRACTOR'S EXPENSE.

Sheet 02-18-2016 11:55:04 AM by CAL
 User: C:\Users\cal\AppData\Local\Temp\14229-001\WkM\Drawings\A-Build\14229-001-C5 Fence Details RECORD
 U:\Wichita-Fence\14229-001\WkM\Drawings\A-Build\14229-001-C5 Fence Details RECORD

▲	ASI #6	6/30/15
▲	ASI #4	6/25/15
▲	ASI #2	6/18/15
▲	ASI #1	5/26/15

FOR CONSTRUCTION SET		
No.	Revision	By Date

CITY OF WICHITA, KANSAS

FENCE DETAILS


WWTP #2 EMERGENCY POWER PROJECT
 C.O.W. PROJECT NO. 468-84956

 PROFESSIONAL ENGINEERING CONSULTANTS, P.A. 303 SOUTH TOPEKA WICHITA, KS 67202 316-262-2691 www.pec1.com	Job No. 34-14229-001-0042 Date 4/29/15	Sht. C5.0 of 37
---	---	-----------------

Designed by MEB
 Drawn by CAL


RECORD DOCUMENTS

THESE DOCUMENTS INCLUDE RECORD INFORMATION PROVIDED BY THE CONTRACTOR. THIS INFORMATION HAS NOT BEEN VERIFIED IN ITS ENTIRETY BY THE DESIGN PROFESSIONAL.
 DATE: FEBRUARY, 2016

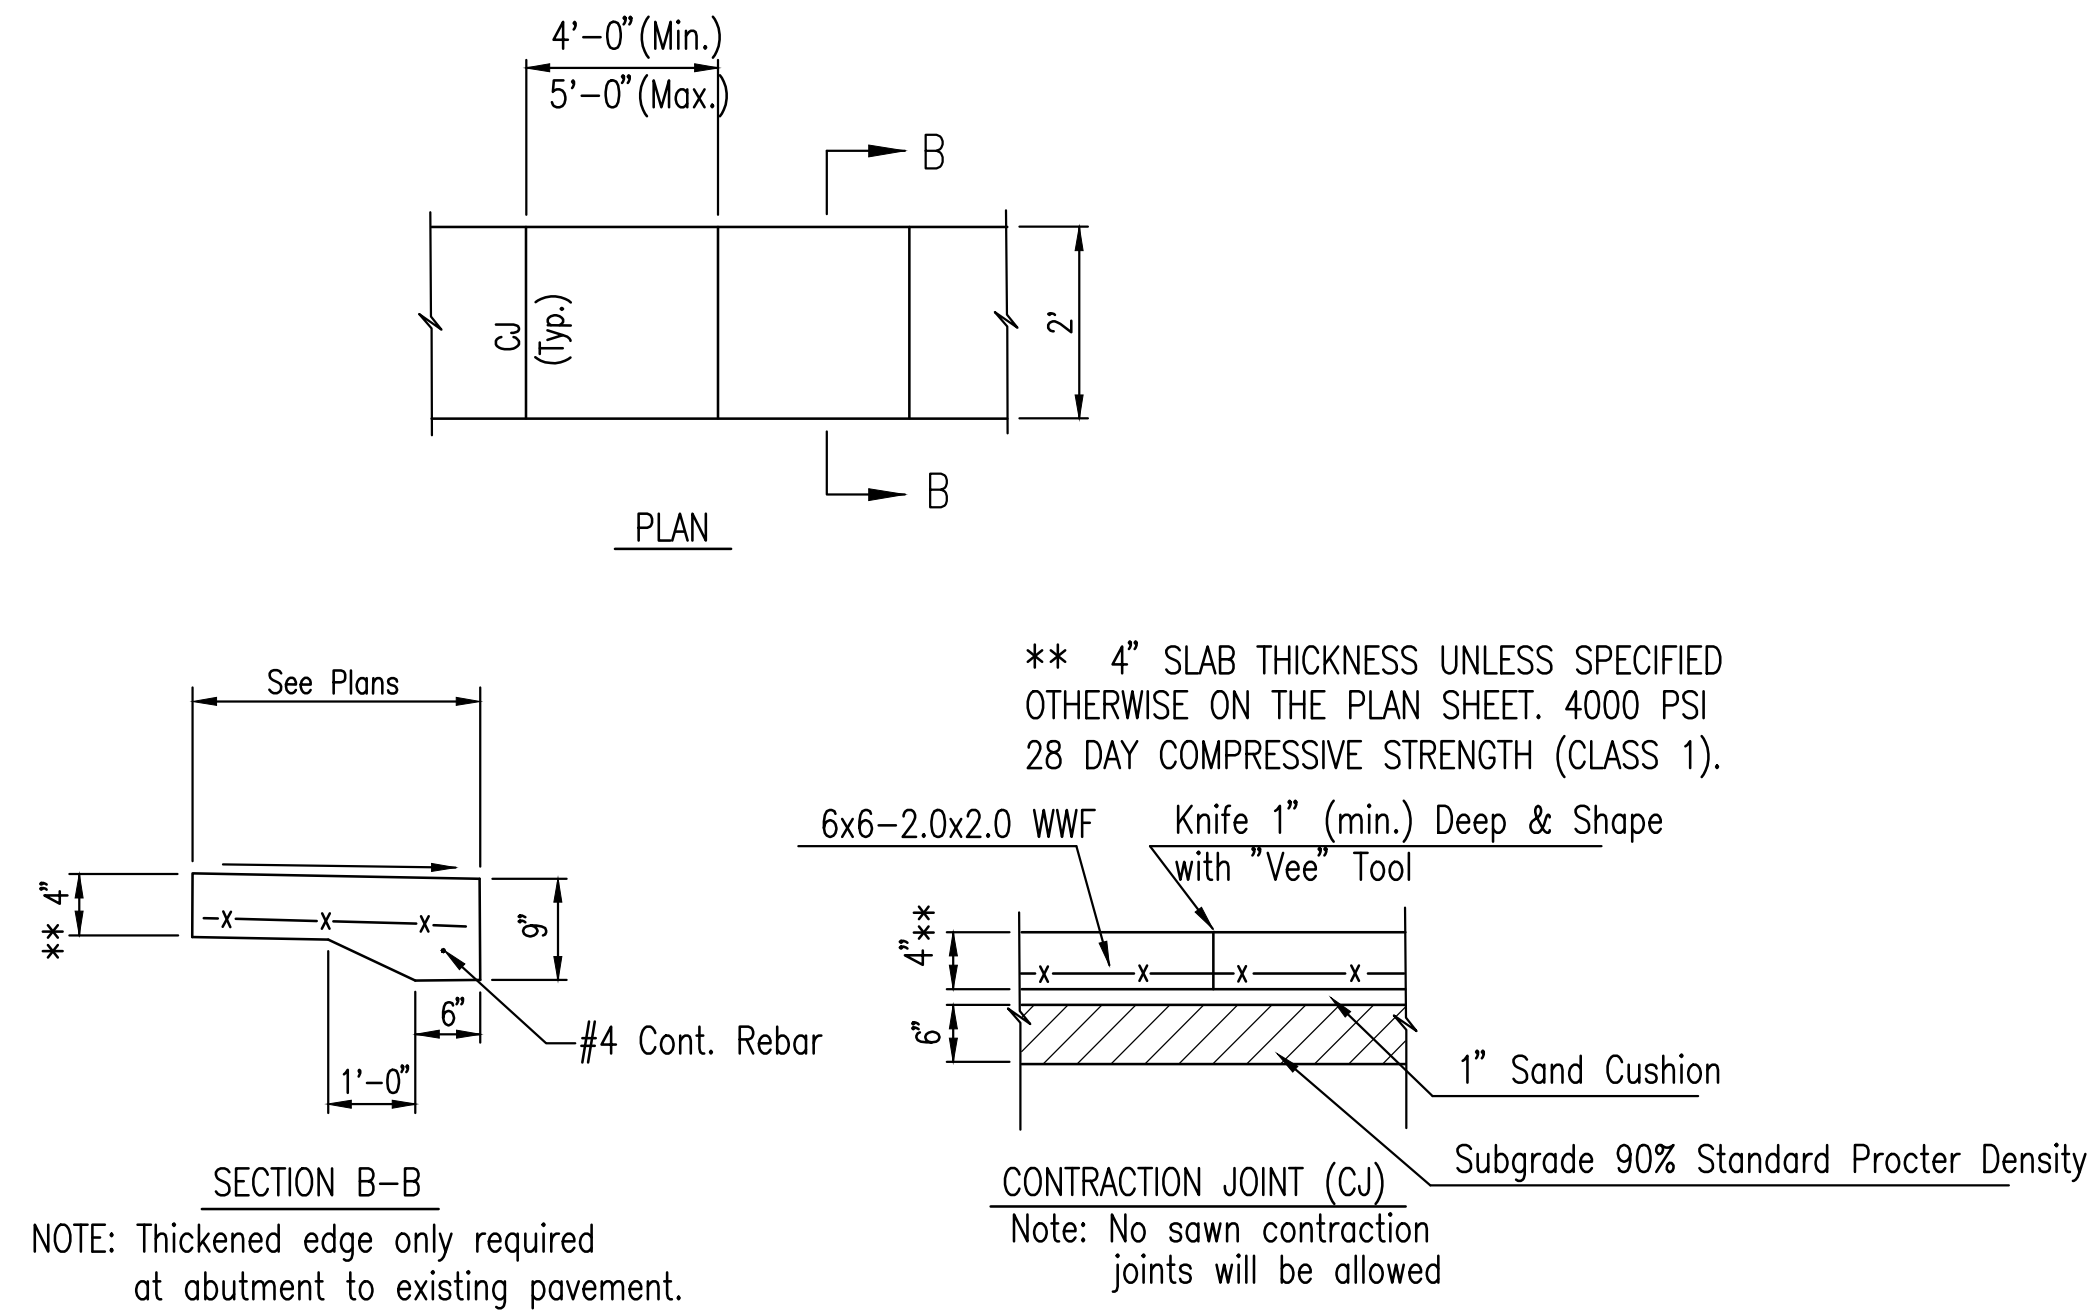


CONCRETE PAVEMENT/MOW STRIP DETAILS


Note: Mow Strip shall be 2'-0" wide.

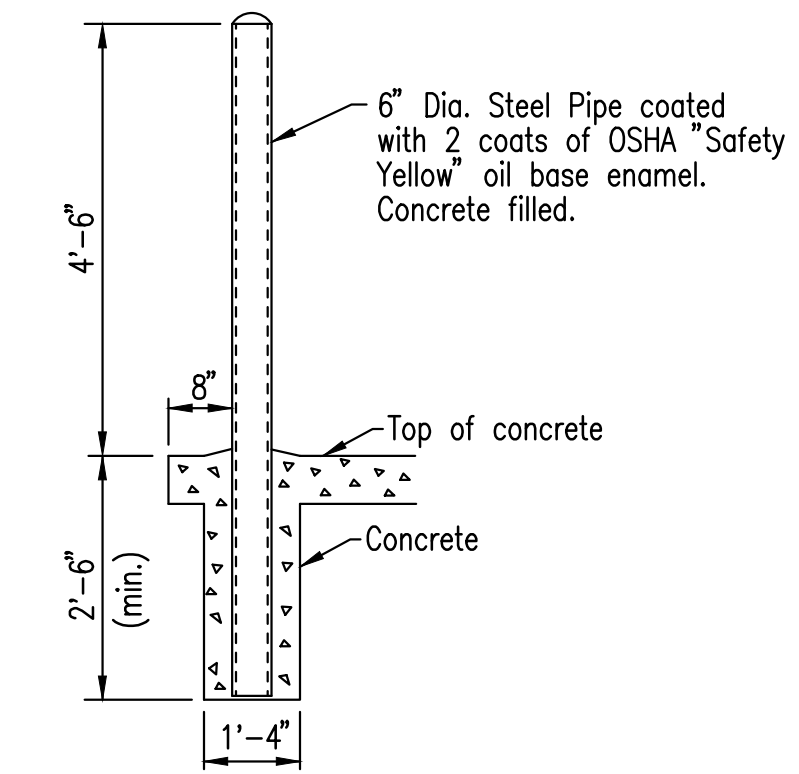


PIPE BOLLARD DETAIL

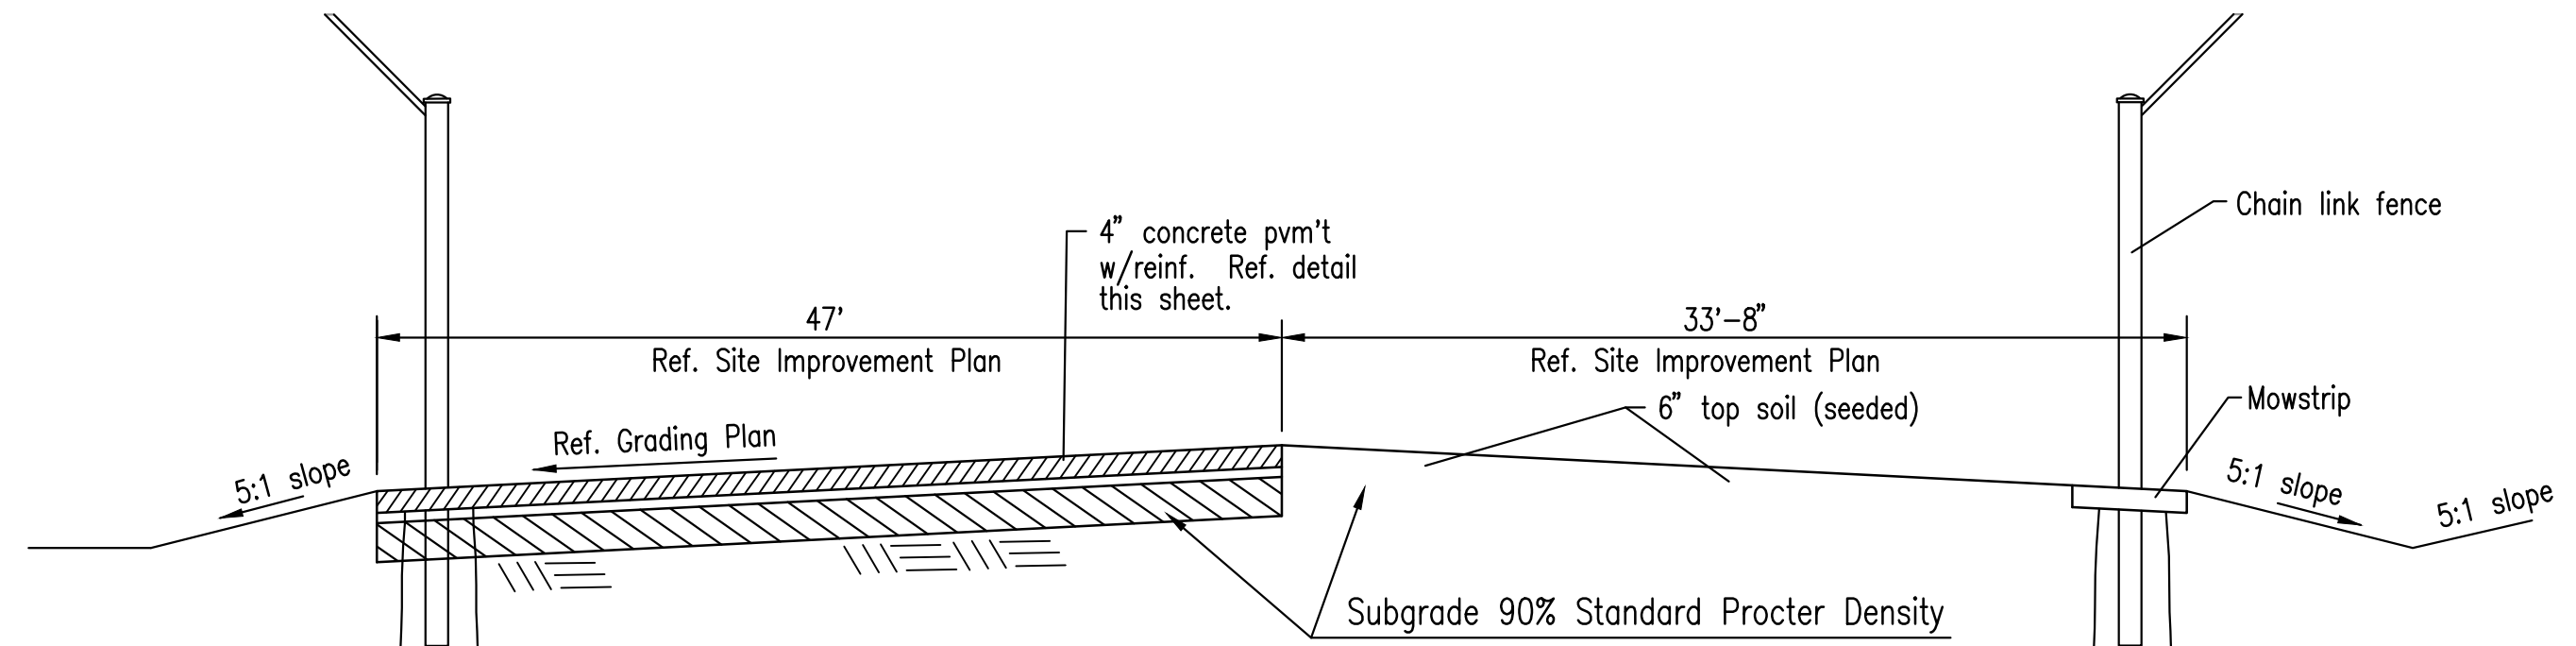


2 EQUIPMENT PAD SECTION
C6.0

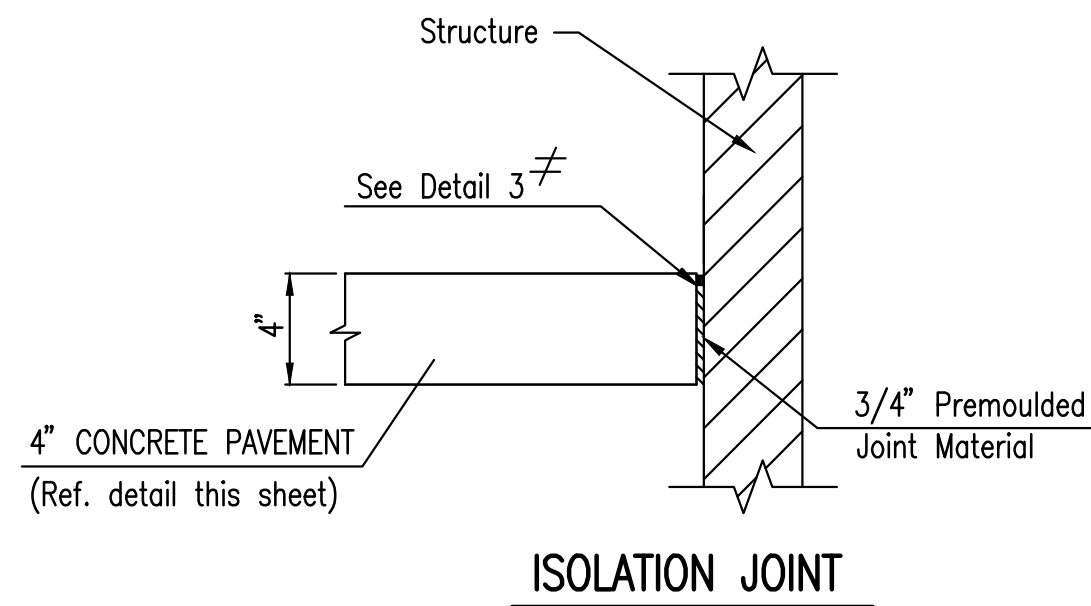

ISOLATION JOINT

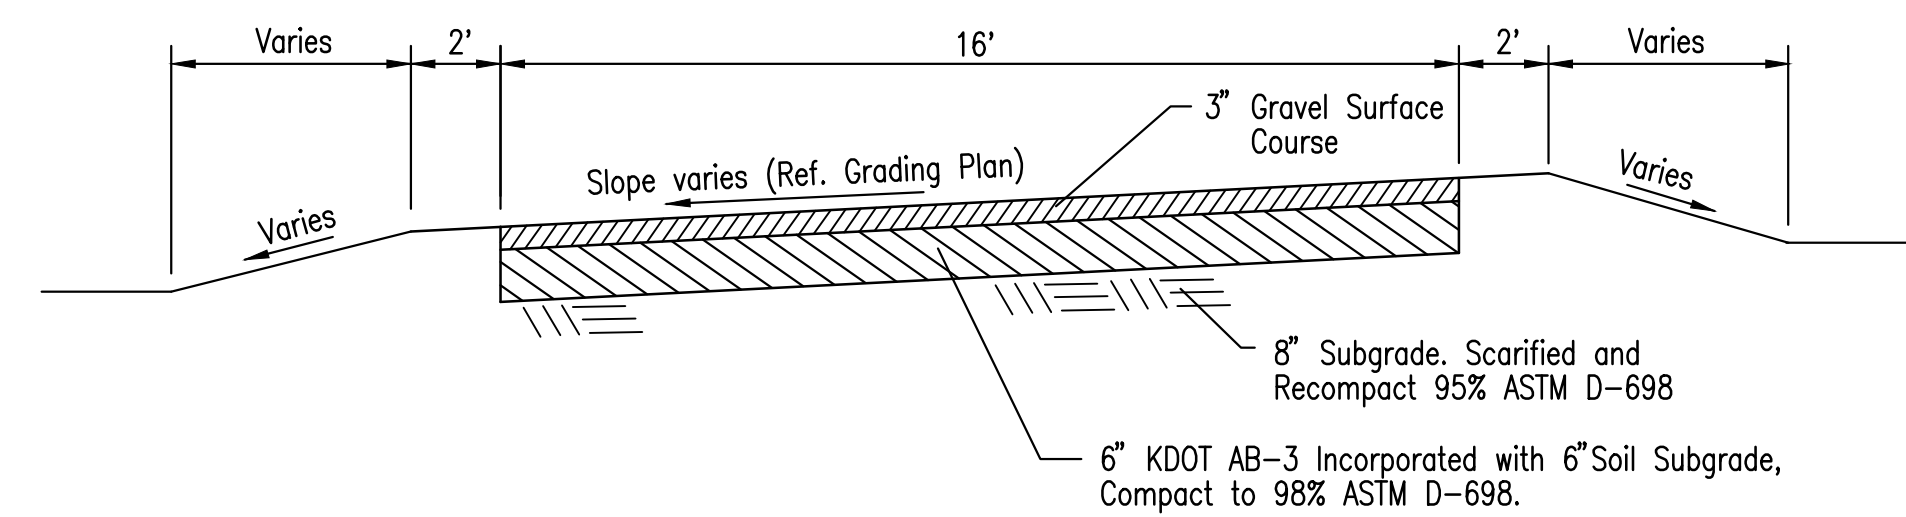

1 ACCESS ROAD SECTION (GRAVEL DRIVE)
C6.0 NOT TO SCALE

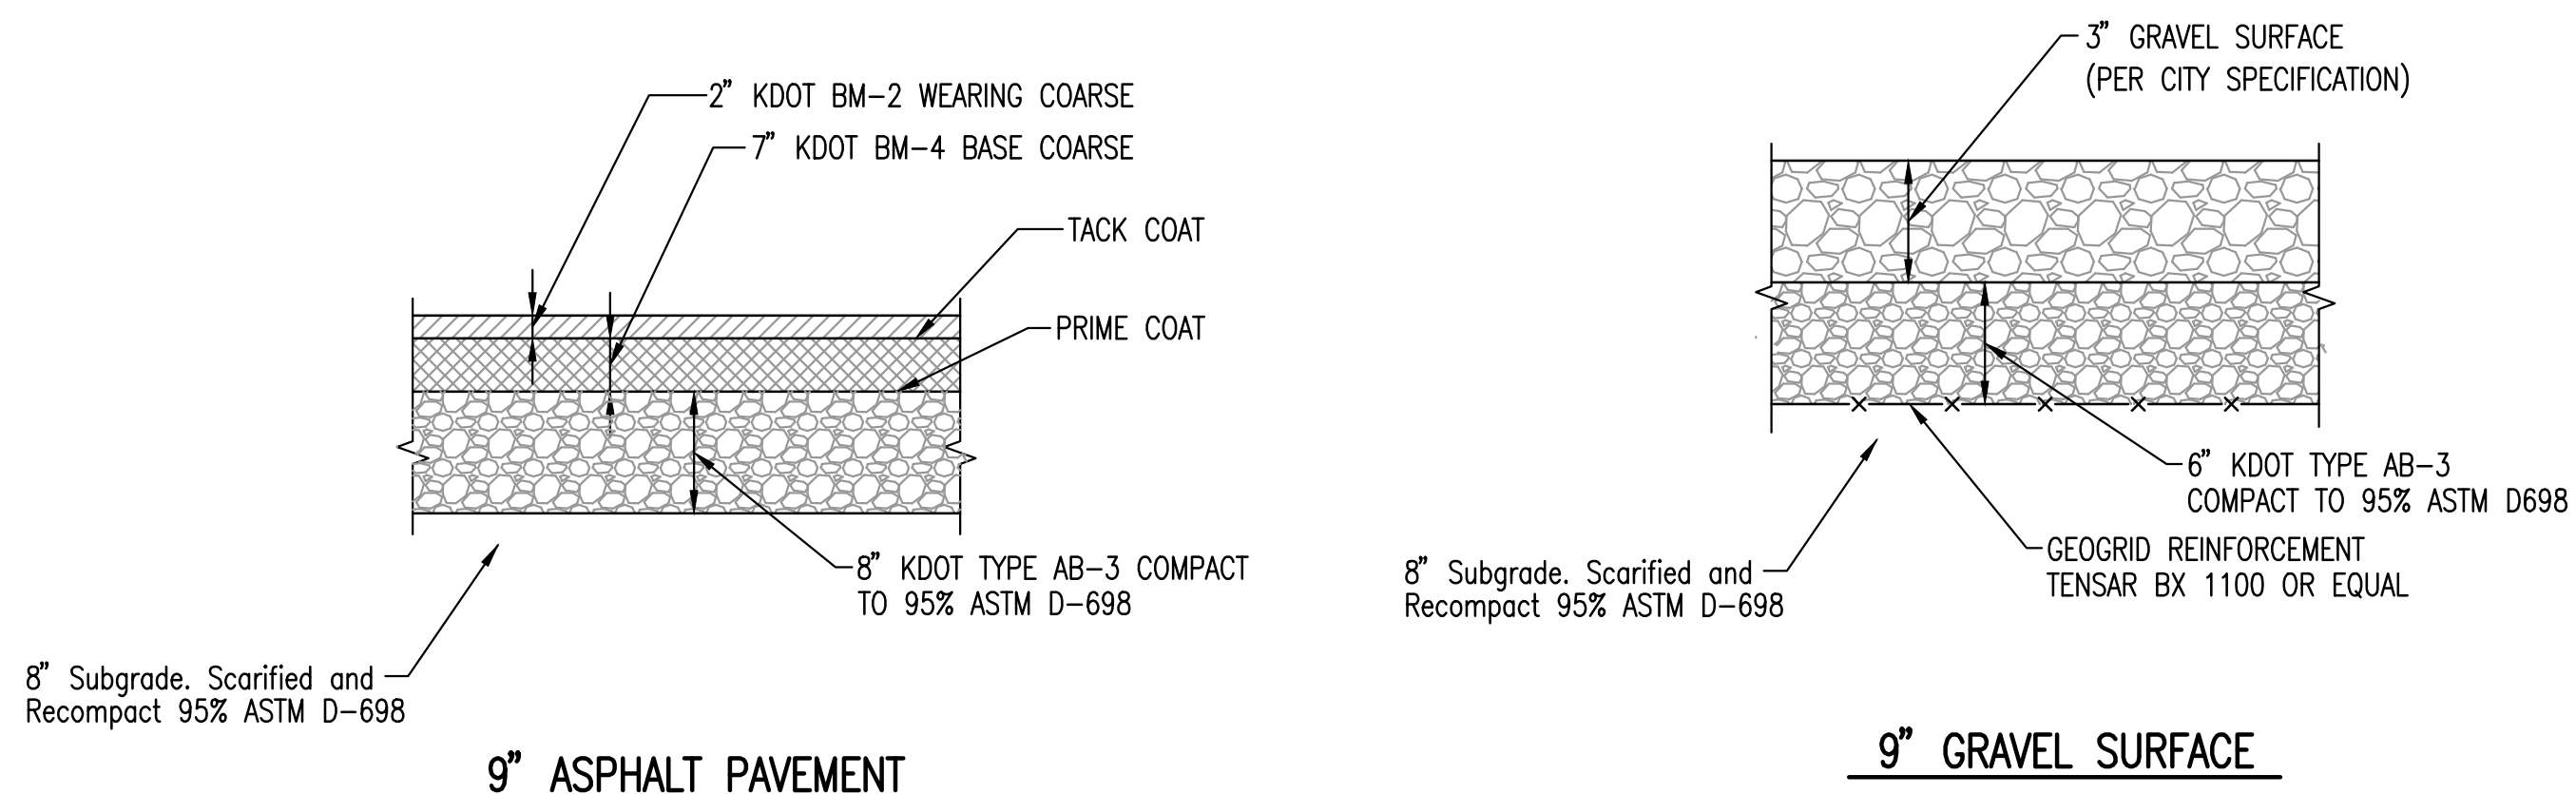


9" ASPHALT PAVEMENT

9" GRAVEL SURFACE

▲	ASI #6	6/30/15
▲	ASI #4	6/25/15
▲	ASI #2	6/18/15
▲	ASI #1	5/26/15
FOR CONSTRUCTION SET		
No.	Revision	By Date

RECORD DOCUMENTS
THESE DOCUMENTS INCLUDE RECORD INFORMATION PROVIDED BY THE CONTRACTOR. THIS INFORMATION HAS NOT BEEN VERIFIED IN ITS ENTIRETY BY THE DESIGN PROFESSIONAL.
DATE: FEBRUARY, 2016

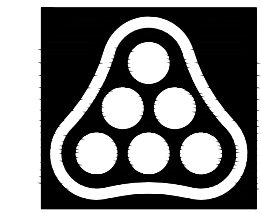

CITY OF WICHITA, KANSAS

MISCELLANEOUS DETAILS

WWTP #2 EMERGENCY POWER PROJECT
C.O.W. PROJECT NO. 468-84956

PEC PROFESSIONAL ENGINEERING CONSULTANTS, P.A.
303 SOUTH TOPEKA WICHITA, KS 67202
316-262-2691 www.pec1.com

Designed by MEB	Job No. 34-14229-001-0042	Sht. C6.0 of 37
Drawn by CAL	Date 4/29/15	

SOURCE: 02-18-2016 11:55:37 AM BY: CAL
 303 SOUTH TOPEKA WICHITA, KS 67202
 316-262-2691 www.pec1.com
 C:\VICTOR\14229\14229-001-0042\MISC\DETAILS\RECORD

MECHANICAL SYMBOL SCHEDULE



SYMBOL	DESCRIPTION
FOS	FUEL OIL SUPPLY
FOR	FUEL OIL RETURN
VTR	VENT THRU ROOF
— —	CAP
— — —	PIPE RISE
— — —	PIPE DROP
— — —	UNION OR FLANGE CONNECTION
— — —	DIRECTION OF FLOW
— — —	ANCHOR
— — —	CONCENTRIC REDUCER OR INCREASER
— — —	ECCENTRIC REDUCER
— — —	TOP CONNECTION, 45° OR 90°
— — —	BOTTOM CONNECTION, 45° OR 90°
— — —	SIDE CONNECTION
— — —	CAPPED OUTLET
— — —	GAS COCK
— — —	VALVE IN DROP
— — —	VALVE IN RISER
BOS	BOTTOM OF STEEL
— — —	ELECTRIC WIRING (WITH 2 WIRES) - LOW VOLTAGE
120V --- ---	120V POWER WIRING
--- --- ---	CONTROL COMMUNICATION WIRING
M.C.	MECHANICAL CONTRACTOR
P.C.	PLUMBING CONTRACTOR
E.C.	ELECTRICAL CONTRACTOR
G.C.	GENERAL CONTRACTOR
(111)	ROOM CALLOUT
⚠	REVISION NUMBER
⊕	CONNECT NEW TO EXISTING. VERIFY EXACT LOCATION.
(#)	REFER TO PLAN NOTES

DRAWING SYMBOLS

EQUIPMENT CALLOUT	SECTIONS	DETAILS
<p>— — — EQUIPMENT TYPE (P=PUMP) UNIQUE I.D. (PUMP NO. 3) — — — TYPICAL EQUIPMENT NUMBER</p>	<p>SECTION LETTER B SHEET NUMBER WHERE DRAWN M3.6</p>	<p>DETAIL NUMBER 5 SHEET NUMBER WHERE DRAWN M3.6</p>

GENERAL NOTES

1. VERIFY JOB SITE CONDITIONS AND DIMENSIONS BEFORE BEGINNING WORK. PLANS ARE SCHEMATIC IN NATURE. LAYOUT IS BASED ON BEST AVAILABLE INFORMATION. CONTRACTOR SHALL FIELD VERIFY EXISTING CONDITIONS AND DIMENSIONS.
2. IT IS THE CONTRACTOR'S RESPONSIBILITY TO FIELD VERIFY EXACT LOCATION, CONFIGURATION AND ROUTING OF EXISTING SYSTEMS REQUIRED TO REMAIN IN OPERATION DURING THE PROJECT TO PREVENT DAMAGE DURING DEMOLITION AND PHASING.
3. COORDINATE ALL WORK WITH OTHER TRADES PRIOR TO INSTALLATION.
4. COORDINATE SIZE AND LOCATION OF MECHANICAL EQUIPMENT PADS WITH G.C.
5. ALL WORK IS TO CONFORM WITH APPLICABLE CODES AND STANDARDS.
6. ALL EQUIPMENT SUPPORT STANDS SHALL BE PRIMED AND PAINTED WITH EPOXY ENAMEL.
7. UNDERGROUND-TYPE UTILITY MARKER: PROVIDE A CAST ALUMINUM UTILITY MARKER AT EVERY 100 FEET FOR ALL UNDERGROUND UTILITIES. 4"x7" TOP WITH 10" MINIMUM SPIKE; LABEL WITH THE APPROPRIATE UTILITY. MARKERS AS MANUFACTURED BY LAKE SHORE MARKERS, ERIE, PENNSYLVANIA.
8. THESE DRAWINGS ARE ACCOMPANIED BY SPECIFICATIONS. REFER TO SPECIFICATIONS FOR FURTHER INFORMATION.

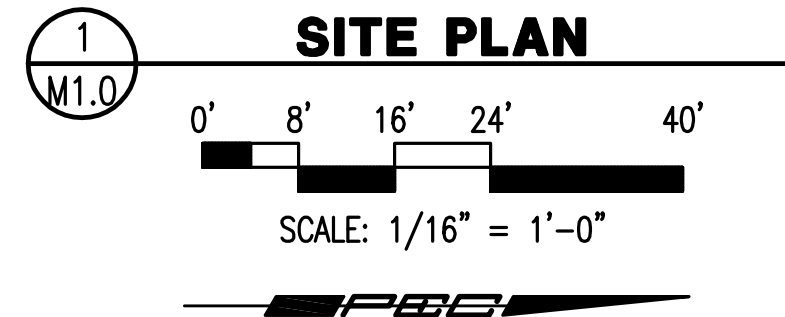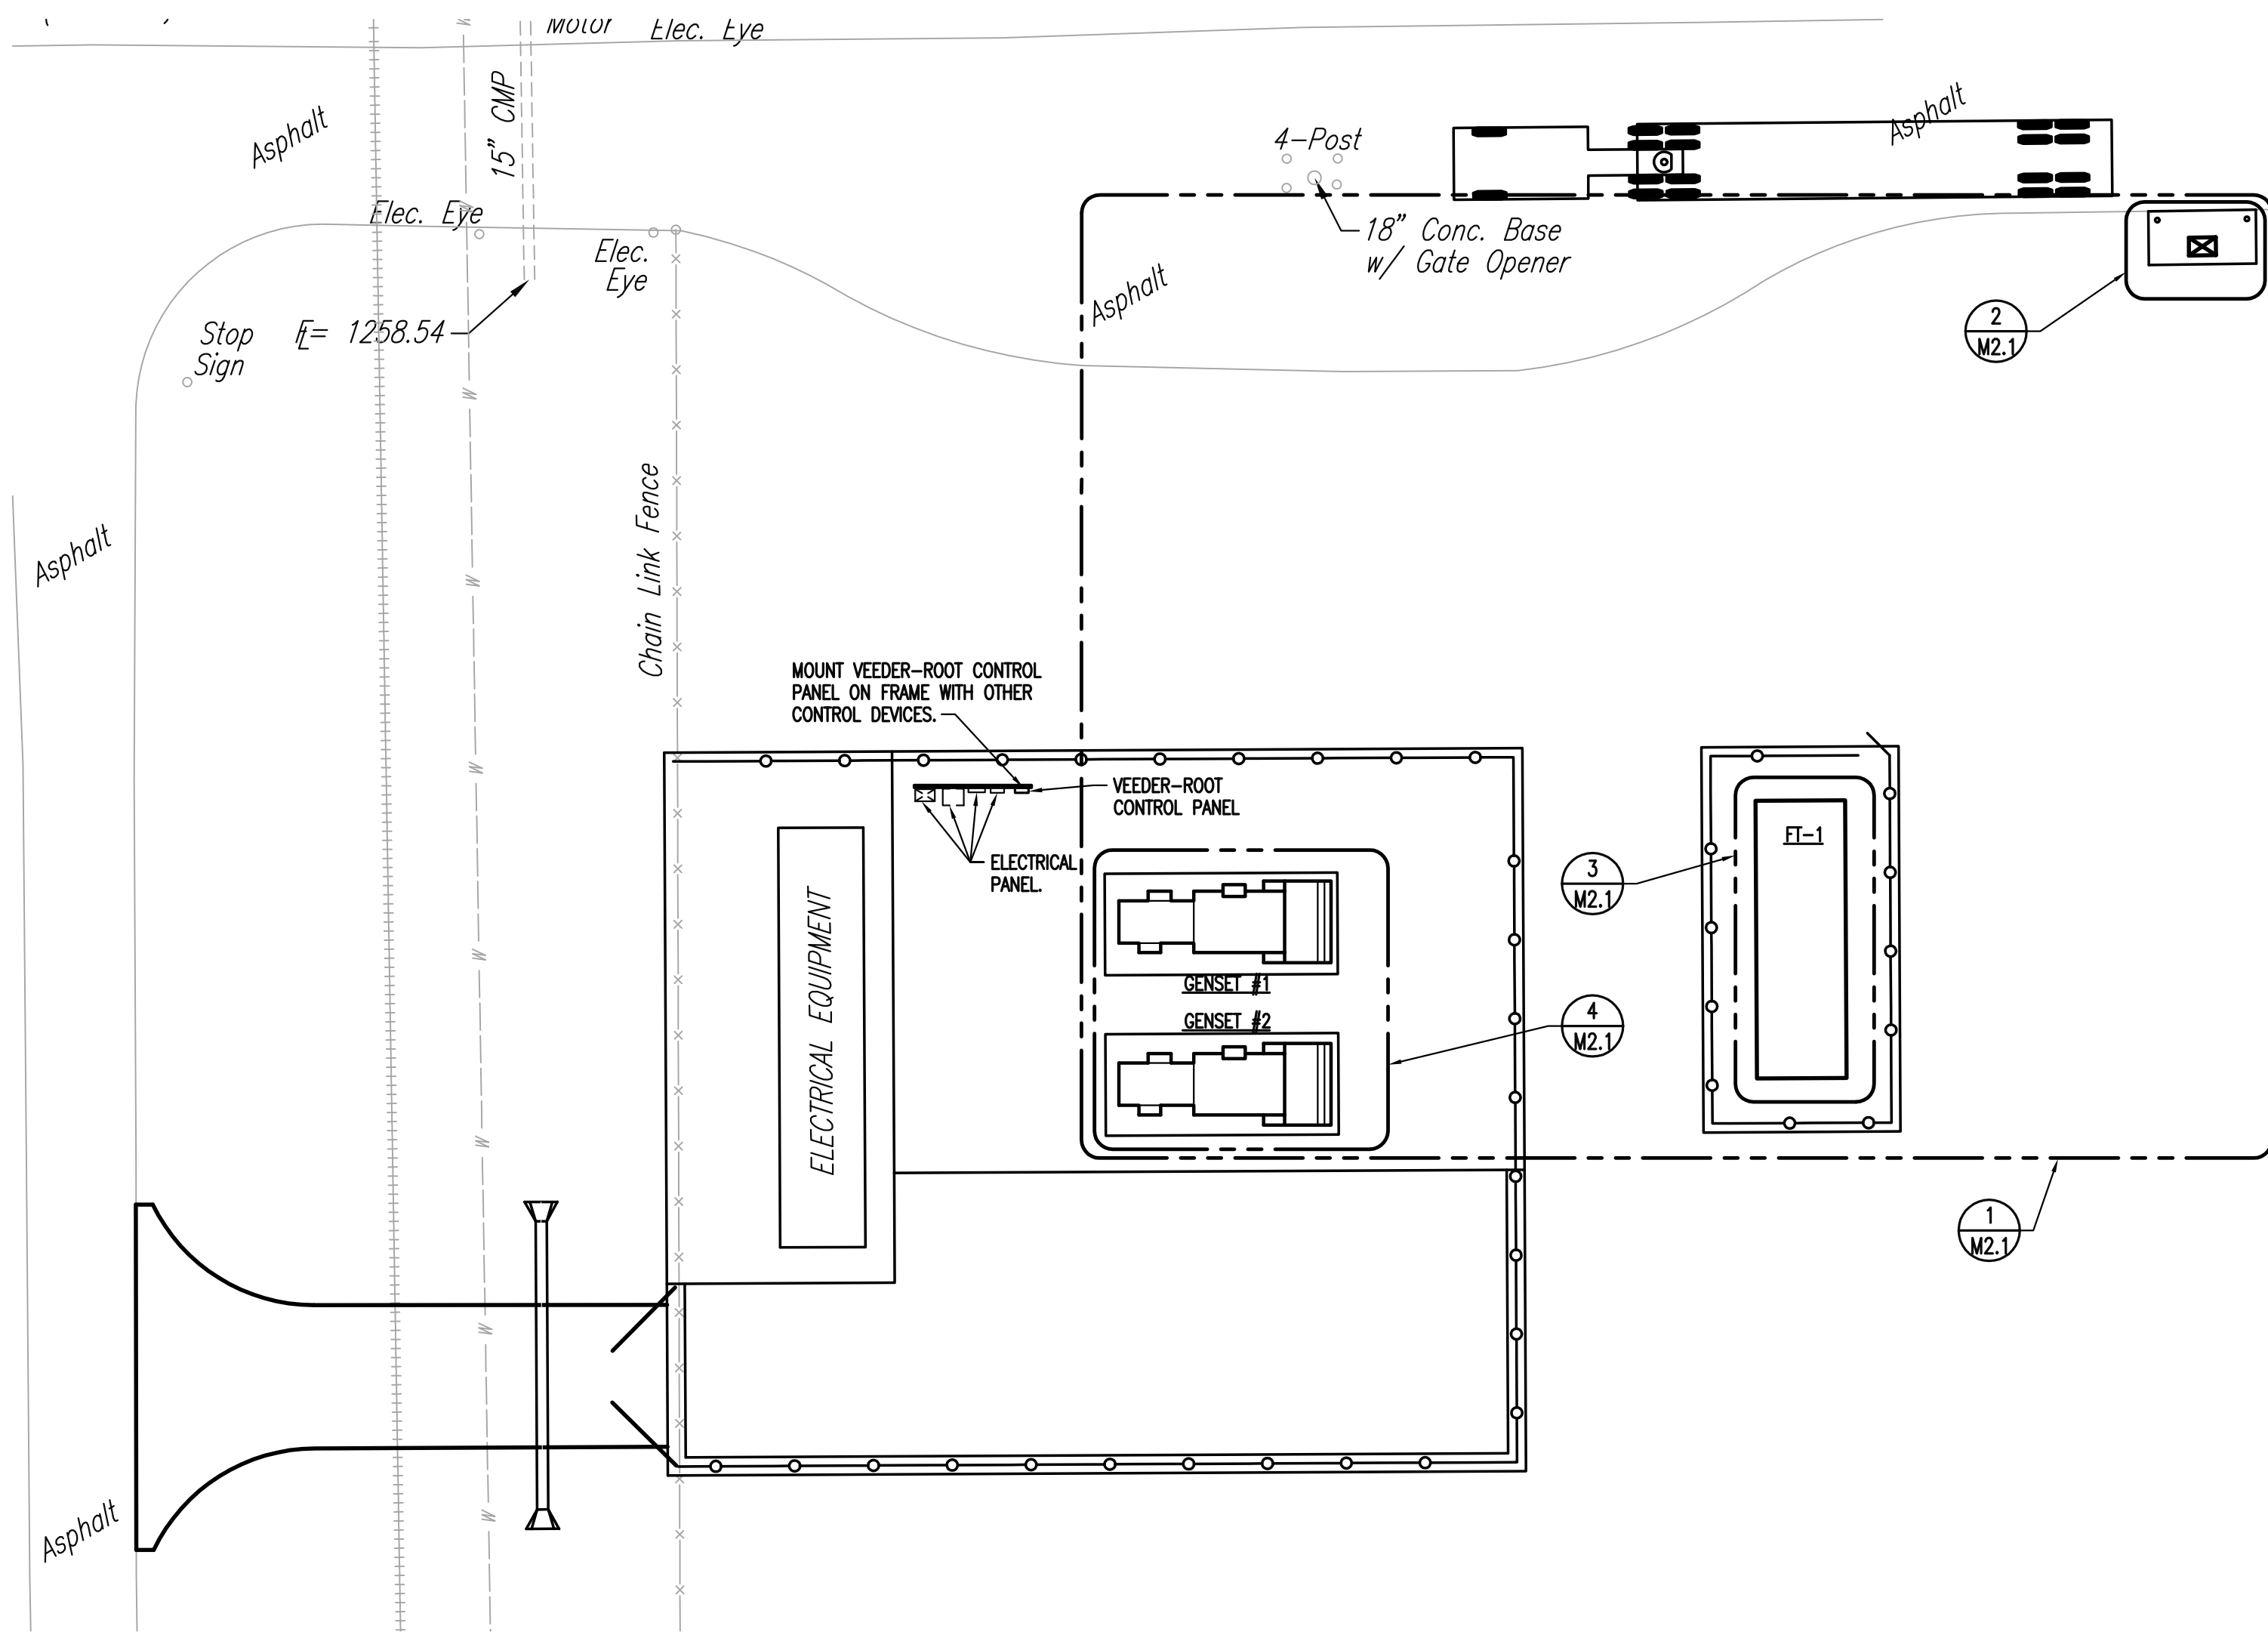


MECHANICAL SHEET INDEX

- M1.0 MECHANICAL COVER SHEET
- M2.1 MECHANICAL ENGINE FUEL PLAN
- M3.1 ENGINE FUEL DETAILS AND SCHEDULES

No.	Revision	By	Date
	ASI #6		6/30/15
	ASI #4		6/25/15
	ASI #2		6/18/15
	ASI #1		5/26/15
FOR CONSTRUCTION SET			
		QAM	4/29/15

RECORD DOCUMENTS

THESE DOCUMENTS INCLUDE RECORD INFORMATION PROVIDED BY THE CONTRACTOR. THIS INFORMATION HAS NOT BEEN VERIFIED IN ITS ENTIRETY BY THE DESIGN PROFESSIONAL.
DATE: MARCH, 2016

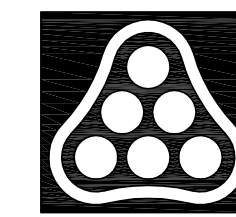


MECHANICAL COVER SHEET

WWTP #2 EMERGENCY POWER PROJECT
C.O.W. PROJECT NO. 468-84956

Designed by	QAM	Job No. 34-14229-001-0042	Sht. M1.0 of 37
Drawn by	JML	Date	4/29/15

Saved: 04-04-2016 8:23:21 AM by JEREMY LEE
 P:\Projects\14229-001-0042\14229-001-0042-Mech\Drawings\As-Built\14229-001-M1.0-MECHANICAL COVER SHEET

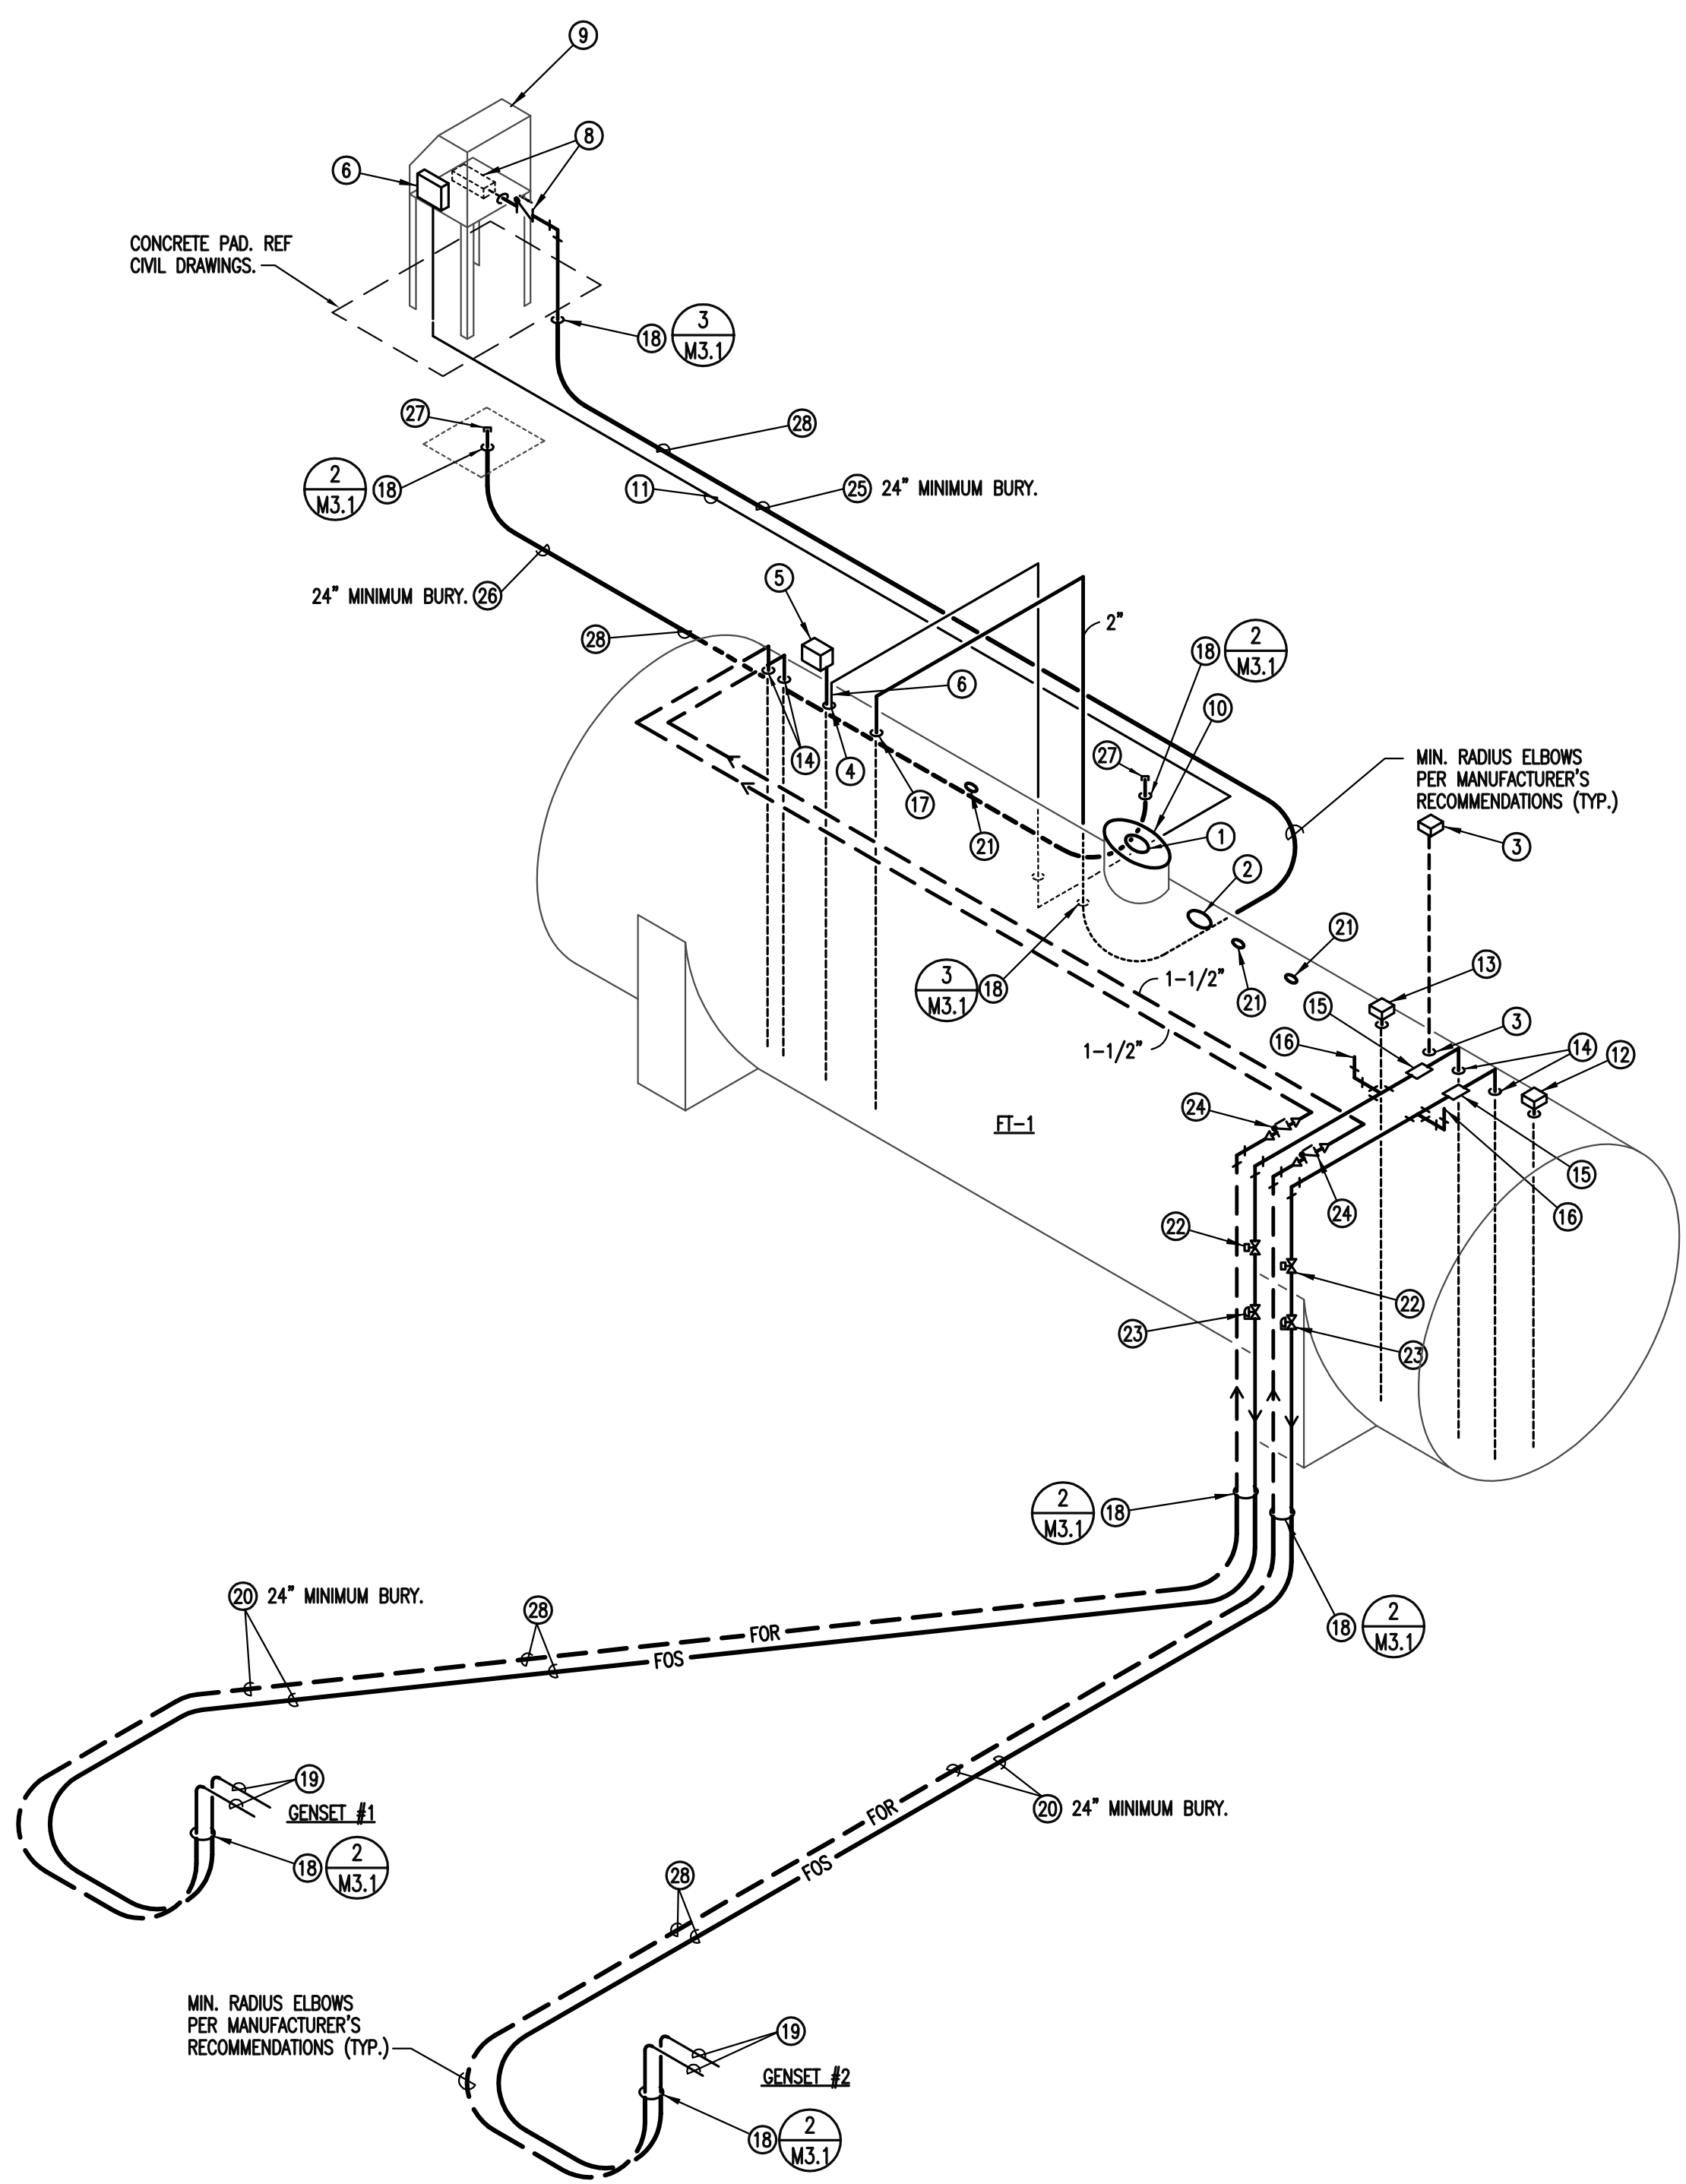

1 GENSET FUEL PIPING ISOMETRIC
SCALE: NONE




NOTE:
M.C. TO COORDINATE WITH FUEL TANK SUPPLIER
TO PROVIDE A COMPLETE AND WORKING SYSTEM.

GENERAL NOTES:

- CONTACT CITY PERSONNEL - CITY WILL PROVIDE INITIAL FILL OF FUEL TANK. CONTRACTOR SHALL PERFORM ALL TESTING AND UPON COMPLETION OF PROJECT SHALL PROVIDE FULL, FUEL TANK.

- PLAN NOTES:**
- PRIMARY EMERGENCY 8" VENT EQUIVALENT TO OPW 202-0680. MANUAL RESET AFTER ACTUATION.
 - 8" INTERSTITIAL EMERGENCY VENT EQUIVALENT TO OPW 202-0680 THRU OUTER SHELL ONLY. MANUAL RESET OF CAP AFTER ACTUATION. MARK WITH SPECIAL WARNING LABEL "INTERSTITIAL EMERGENCY VENT ONLY".
 - PROVIDE BUSHING FOR 2" VENT PIPE IN 4" HOLE. 2" VENT PIPE UP WITH PRESSURE/VACUUM CAP. TERMINATE 12"-0" ABOVE GRADE.
 - PROVIDE 4" TANK BUNG GAUGE AND ALARM COMBO FITTING EQUIVALENT TO OPW TGT-0400.
 - PROVIDE MECHANICAL TANK GAUGE WITH 304 SS FLOAT, DROP TUBE, LARGE EASY READ FACE IN ENGLISH UNITS TO READ FEET AND INCHES. EQUIVALENT TO OPW 200TG AST.
 - PROVIDE SINGLE CHANNEL LIQUID LEVEL TANK ALARM AT FUEL TANK. EQUIVALENT TO 144TA-0100.
 - NOT USED
 - INSTALL A 2" OPW SWING CHECK VALVE AND AN OPW SERIES 1611AN KAMVALOK WITH DUST CAP AND A POPPETED 1711D KAMVALOK DRY BREAK COUPLER. MOUNT 36" ABOVE GRADE.
 - PROVIDE STAINLESS STEEL 34"Wx 24"Dx 24"H REMOTE FILL ABOVE GROUND STORAGE TANK SPILL CONTAINER WITH BOTTOM AT 24" TO 30" ABOVE GRADE. EQUIVALENT TO OPW 211-RMOT.
 - 24" TIGHT BOLT MANWAY WITH 8" PRIMARY VENT MOUNTED IN COVER.
 - CONDUIT - REF ELECTRICAL.
 - INSTALL LEAK DETECTION SENSOR PROVIDED AS PART OF THE VEEDER-ROOT TLS-300C FUEL MANAGEMENT SYSTEM IN THE LEAK DETECTION PORT.
 - INSTALL FUEL LEVEL SENSOR PROVIDED AS PART OF THE VEEDER-ROOT TLS-300C FUEL MANAGEMENT SYSTEM.
 - PROVIDE 2" TANK BUNG COMBO FITTING FOR 1-1/2" PIPING CONNECTION AND DROP TUBES FOR EACH CONNECTION DOWN TO 6" ABOVE FLOOR OF TANK.
 - 1-1/2" ANTI-SYPHON VALVE.
 - PLUGGED 90° ELL TURNED UP FOR PIPE VENTING AND PRIMING FILL.
 - INSTALL A 2" OPW MODEL 6150 OVERFILL PREVENTION VALVE IN TANK FILL CONNECTION.
 - TRANSITION TO FUEL OIL CONTAINMENT PIPING AT 12" ABOVE GRADE, WHERE PIPING CONTINUES BELOW GRADE.
 - 1-1/2" FUEL HOSE WITH STAINLESS STEEL BRAID EXTERIOR MIN. 24" LENGTH RATED FOR SERVICE INTENDED.
 - 1-1/2" SUPPLY AND 1-1/2" RETURN COAXIAL PIPING BELOW GRADE IN FUEL OIL CONTAINMENT PIPING.
 - COORDINATE ADDITIONAL 4" CONNECTION PORT IN TOP OF TANK WITH TANK MANUFACTURER FOR FUTURE PUMPING CONNECTION.
 - 1-1/2" SUPPLY PIPING WITH 1-1/2" OPW 821-0100AC 110V N.C. SOLENOID VALVE.
 - 1-1/2" SUPPLY PIPING TRANSITIONED TO 1-1/2" OPW 346DI-0400AV EXTERNAL AST EMERGENCY SHUT-OFF VALVE OR EQUAL, THEN TRANSITIONED BACK TO 1-1/2" SUPPLY.
 - 1-1/2" RETURN PIPING TRANSITIONED TO 1-1/2" OPW 246ADI-0200AV SWING CHECK VALVE OR EQUAL, THEN TRANSITIONED BACK TO 1-1/2" RETURN.
 - 2" FUEL FILL PIPING IN CONTAINMENT PIPING.
 - INSTALL 1-1/2" COAXIAL SUPPLY PIPING IN CONTAINMENT PIPING.
 - ROUTE 1-1/2" SUPPLY PIPING ABOVE GRADE AND CAP FOR FUTURE FUEL DISPENSING PIPING. COORDINATE LOCATION WITH OWNER.
 - BURY 12 GA COPPER WIRE AND SAFETY TAPE OVER THE TOP OF BURIED FUEL PIPING.

FUEL TANK SCHEDULE						
MARK	LOCATION	CONSTRUCTION TYPE	WALL THICKNESS	MAX. CAP. (GAL.)	WEIGHT (lbs.)	REMARKS
FT-1	ABV. GRND	DOUBLE WALL	1/4"	15,000	35,821	①
① BASED ON HIGHLAND TANK FIREGUARD CYLINDRICAL ABOVEGROUND DOUBLE WALL TANK WITH THERMAL PROTECTION, BALLISTICS RATED, UL-2085 LISTED. PROVIDE (7) 4" FEMALE FIREGUARD COUPLINGS, PROVIDE (2) 8" FITTINGS FOR EMERGENCY VENTING, PROVIDE (1) 2" FEMALE FIREGUARD COUPLING FOR INTERSTITIAL MONITOR PIPE, AND PROVIDE (1) 24" DIA. MANHOLE, PROVIDE (4) 2" FEMALE FIREGUARD COUPLING FOR FUEL SUPPLY AND RETURN PIPING.						

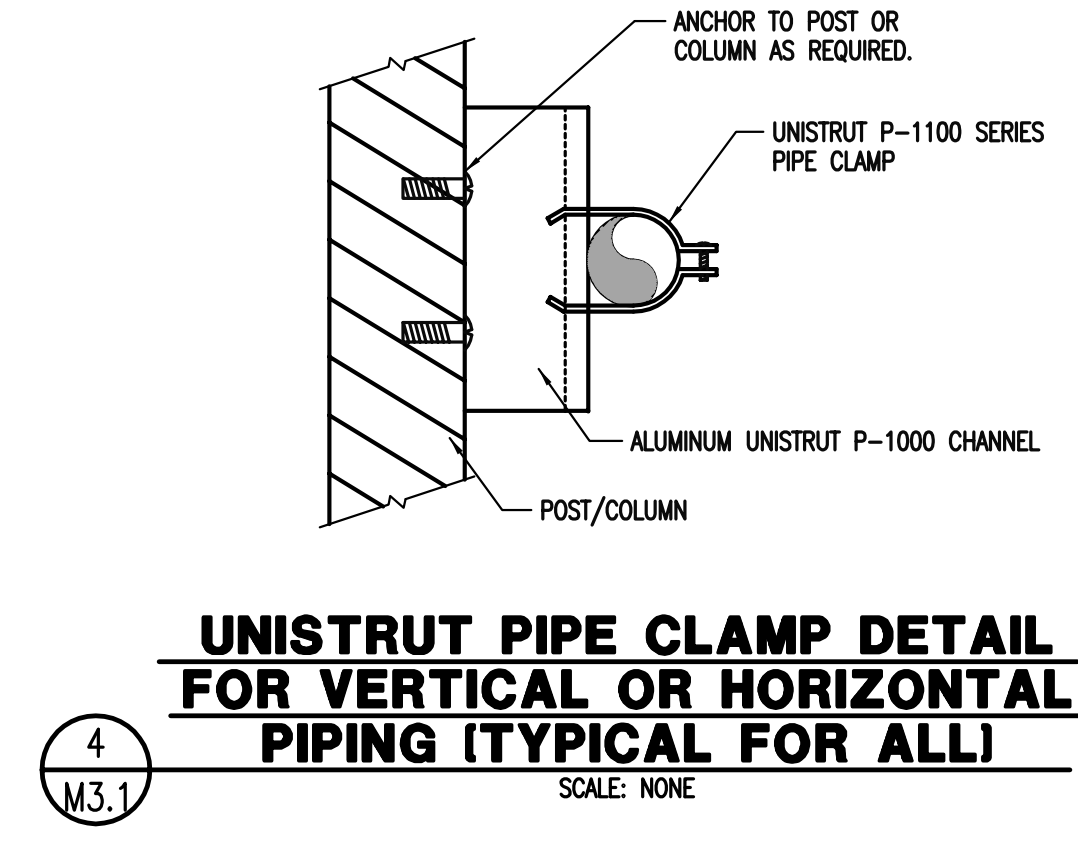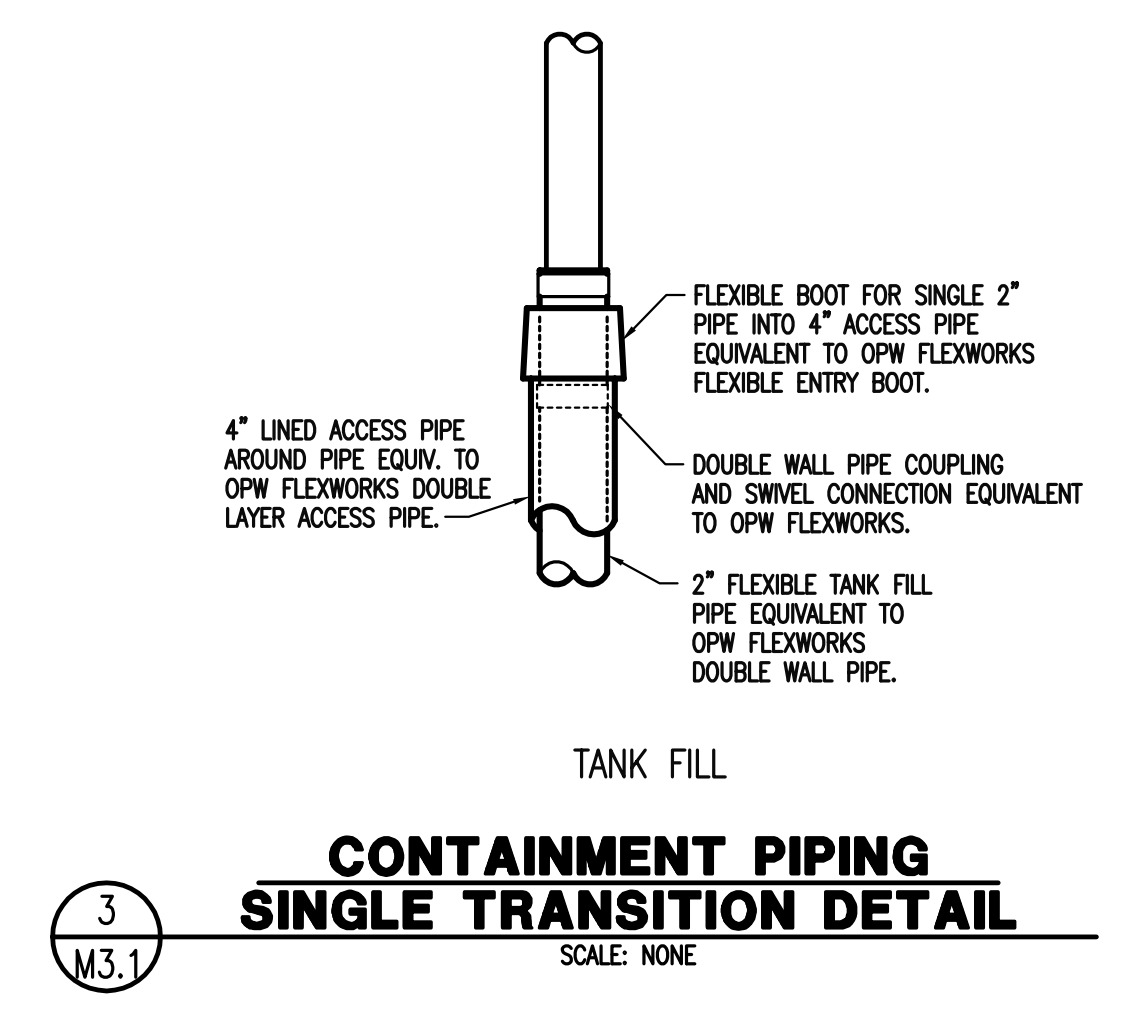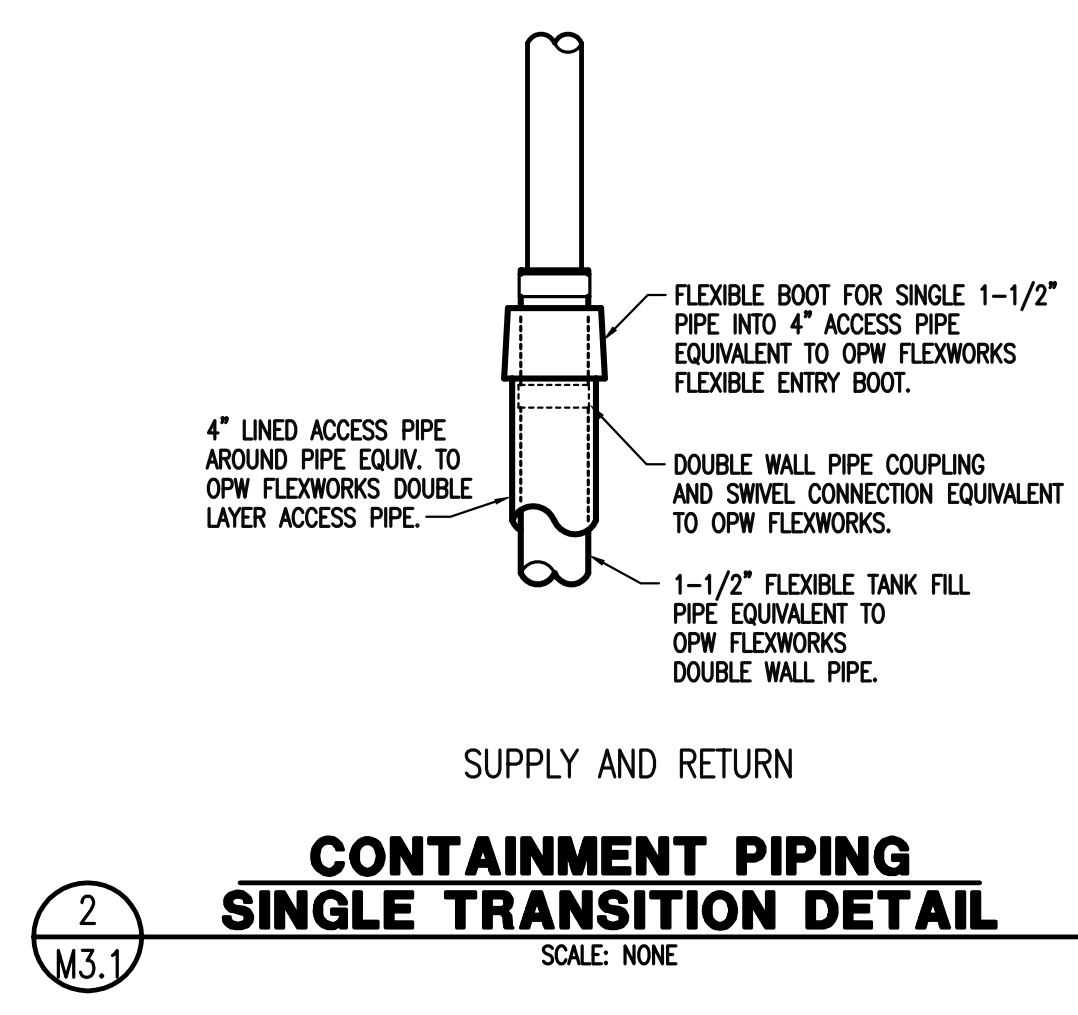

Revision	By	Date
ASI #6		6/30/15
ASI #4		6/25/15
ASI #2		6/18/15
ASI #1		5/26/15
FOR CONSTRUCTION SET		
No.	Revision	By
		Date

RECORD DOCUMENTS

THESE DOCUMENTS INCLUDE RECORD INFORMATION PROVIDED BY THE CONTRACTOR. THIS INFORMATION HAS NOT BEEN VERIFIED IN ITS ENTIRETY BY THE DESIGN PROFESSIONAL.

DATE: MARCH, 2016

CITY OF WICHITA, KANSAS

ENGINE FUEL DETAILS AND SCHEDULES

WWTP #2 EMERGENCY POWER PROJECT
C.O.W. PROJECT NO. 468-84956

PEC PROFESSIONAL ENGINEERING CONSULTANTS, P.A.
303 SOUTH TOPEKA WICHITA, KS 67202
316-262-2691 www.pec1.com

Designed by	QAM	Job No. 34-14229-001-0042	Sht. M3.1 of 37
Drawn by	JML	Date 4/29/15	

Sheet 05-03-2016 10:25:36 PM by: MEB/ML/EE
 User: C:\Users\meb\OneDrive\Documents\14229-001-M3.1-ENGINE FUEL DETAILS AND SCHEDULES
 File: C:\Users\meb\OneDrive\Documents\14229-001-M3.1-ENGINE FUEL DETAILS AND SCHEDULES.dwg

(P.E.C.)

① ②	LIGHTING FIXTURE SCHEDULE									
FIXT. LTR.	MANUFACTURER CATALOG NUMBER	MANUFACTURER CATALOG NUMBER	MANUFACTURER CATALOG NUMBER	MANUFACTURER CATALOG NUMBER	DESCRIPTION	LAMP TYPE	LENS\LOUVER\FINISH	W	L	D
EG	WILLIAMS 96-4-L40-840-HIA-DRY FULLY ENCLOSED AND GASKETED.	LITHONIA FEM4LED-4L-IMACD	OR APPROVED EQUAL		4' STRIP	40W LED 82CRI 4000K	WHITE		4.0	
SL	RAB LIGHTING FXLED125SF	OR APPROVED EQUAL			FLOOD LIGHT	133W LED 82CRI 4000K	DARK BRONZE	1.5	1.5	
	MOUNT AT 25' - 0" AFG. ROUTE THRU FIXTURE 'SLPC'.					1 UNV	10,700 DELIVERED LUMENS WITH L70 = 100,000 HOURS			
SLPC	RAB LIGHTING FXLED125SF/PCS	OR APPROVED EQUAL			FLOOD LIGHT	133W LED 82CRI 4000K	DARK BRONZE	1.5	1.5	
	MOUNT AT 25' - 0" AFG. PROVIDE WITH INTEGRAL PHOTOCELL.					1 UNV	10,700 DELIVERED LUMENS WITH L70 = 100,000 HOURS			

① MANUFACTURERS LISTED IN THIS SCHEDULE OR APPROVED BY WRITTEN ADDENDUM WILL BE THE ONLY APPROVED MANUFACTURERS TO BID THE LIGHTING FIXTURES FOR THIS PROJECT. CONTRACTORS AND SUPPLIERS USING PRICING FROM MANUFACTURERS NOT LISTED ON SCHEDULE OR BY ADDENDUM DO SO AT THEIR OWN RISK.

② LIGHT FIXTURE SELECTIONS ARE BASED ON THE MANUFACTURER IN THE LEFT MOST COLUMN AS LISTED IN THE SCHEDULE. FIXTURES APPROVED AS EQUALS IN THIS SCHEDULE OR BY ADDENDUM SHALL BE EQUAL TO THE UNIT SPECIFIED IN THE LEFT MOST COLUMN, IE: SPRING LOADED LATCHES, POST PAINTED FINISH, AND PHOTOMETRICS.

PANELBOARD: PG-LV 208/120 VOLTS, 3 PHASE, 4 WIRE
225 AMP MAIN BKR, SURFACE MTD.
22000 AIC LABELED

CIRC NO.	LOAD V. A.	LOAD TYPE	LOAD DESCRIPTION	P	AMP SIZE	USE	AMP SIZE	P	LOAD DESCRIPTION	LOAD TYPE	LOAD V. A.	CIRC NO.
1	1400	PWR	GEN-1 BATTERY CHARGER	1	20	A	20	1	LTG - GENERATOR STATION	LGT	931	2
3	1400	PWR	GEN-1 ALTERNATOR HTR	1	20	B	20	1	LTG - PMSG VAULT	LGT	160	4
5	1400	PWR	GEN-2 BATTERY CHARGER	1	20	C	20	1	SPARE	SPR		6
7	1400	PWR	GEN-2 ALTERNATOR HTR	1	20	A	20	1	VEEDER ROOT CONTROLLER	PWR	500	8
9	6000	HEAT	GEN-1 BLOCK HEATER	2	35	B	20	1	GEN-CP	PWR	500	10
11						C	20	1	SPARE	SPR		12
13	1000	PWR	GEN-1 ENC PWR & LTS	1	20	A	20	1	CONVENIENCE RECEPTACLE	RTT	200	14
15	6000	HEAT	GEN-1 BLOCK HEATER	2	35	B	20	1	SPARE	SPR		16
17						C	20	1	SPARE	SPR		18
19		SPR	SPARE	1	20	A	20	1	SPARE	SPR		20
21	6000	HEAT	GEN-2 BLOCK HEATER	2	35	B	20	1	PMSG DMC	PWR	1400	22
23						C	20	1	PMSG BATT. CHARGER	PWR	800	24
25	1000	PWR	GEN-2 ENC PWR & LTS	1	20	A	20	1	SPARE	SPR		26
27	6000	HEAT	GEN-2 BLOCK HEATER	2	35	B	20	1	SPARE	SPR		28
29						C	20	1	SPARE	SPR		30
31		SPR	SPARE	1	20	A	20	1	SPARE	SPR		32
33	3000	HEAT	ATS HEATER	2	20	B	20	1	SPARE	SPR		34
35						C	20	1	SPARE	SPR		36
37		SPR	SPARE	1	20	A	20	1	SPARE	SPR		38
39		SPR	SPARE	1	20	B	20	1	SPARE	SPR		40
41		SPR	SPARE	1	20	C	20	1	SPARE	SPR		42

PEN WEIGHT LEGEND


SYMBOL	DESCRIPTION
	ALL DEVICES, LIGHT FIXTURES, ETC., DRAWN IN DARK SOLID LINES ARE NEW TO BE INSTALLED.
	NEW DUPLEX GROUNDED RECEPTACLE
	NEW LIGHT FIXTURE
	ALL DEVICES, LIGHT FIXTURES, ETC., DRAWN IN LIGHT SOLID LINES ARE EXISTING TO REMAIN.
	EXISTING DUPLEX GROUNDED RECEPTACLE TO REMAIN
	EXISTING LIGHT FIXTURE TO REMAIN
	ALL DEVICES, LIGHT FIXTURES, ETC., DRAWN IN DARK DASHED LINES ARE TO BE REMOVED.

SPECIAL OUTLET SCHEDULE

SYMBOL	DESCRIPTION
	GENERATOR EMERGENCY REMOTE SHUT DOWN SWITCH. REFER TO SPECIFICATIONS.
	GROUND LUG LOCATION. PROVIDE A 1" CONDUIT WITH #4/0 CU PIG TAIL AT THIS LOCATION FOR CONNECTION TO GENERATOR FOR GROUNDING. ROUTE #4/0 DOWN TO GROUNDING GRID CONDUCTOR BELOW SLAB AND CAD WELD. PROVIDE CONNECTION FROM GENERATOR TO THIS LOCATION.

- ### GENERAL NOTES
- ALL ELECTRICAL WORK SHALL COMPLY WITH THE LATEST EDITION OF THE NATIONAL ELECTRICAL CODE (NEC) & THE AMERICANS WITH DISABILITIES ACT (ADA).
 - REFER TO RELATED CIVIL AND STRUCTURAL DRAWINGS FOR RELATED INFORMATION.
 - REFER TO THE SPECIFICATIONS FOR DATA NOT ON THE DRAWINGS.
 - ALL MOUNTING HEIGHTS TO CENTERLINE OF ITEM UNLESS OTHERWISE NOTED. VERIFY ALL OUTLET LOCATIONS ON THE JOB PRIOR TO ROUGH-IN.
 - CONDUIT RUN W/CONDUCTORS AS INDICATED & GROUND WIRE SIZED PER N.E.C. 250.122. CONDUIT SIZE AS REQUIRED.
 - WHEN INCREASED CONDUCTOR SIZES ARE SHOWN ON THE PLANS, THE LARGER CONDUCTOR SIZE SHALL BE USED THROUGHOUT THE LENGTH OF THE CIRCUIT, INCLUDING NEUTRAL AND GROUND.
 - BRANCH CIRCUITS ARE INDICATED AS ONE CIRCUIT HOME RUNS WITH INDIVIDUAL NEUTRALS. A MAXIMUM OF THREE CIRCUITS (MAXIMUM OF THREE PHASE CONDUCTORS) MAY BE GROUPED IN A SINGLE CONDUIT. WHERE MULTIPLE CIRCUITS ARE LOCATED IN THE SAME RACEWAY, JUNCTION BOX OR ENCLOSURE, NEUTRALS SHALL BE MARKED OR LABELED TO INDICATE WHICH CIRCUIT THEY ARE ASSOCIATED WITH. SEE SPECIFICATION SECTION "LOW VOLTAGE ELECTRICAL POWER CONDUCTORS AND CABLES" FOR ADDITIONAL INFORMATION.
 - RUN CABLES CONTINUOUS FROM JACK TO ASSOCIATED SYSTEM PATCH PANEL IN CONDUIT, CABLE TRAY, OR J-HOOKS PER THE PLANS AND SPECIFICATIONS. NUMBER BESIDE CABLE SYMBOL INDICATES QUANTITY OF CABLES REQUIRED PER HOME RUN.

ONE-LINE SYMBOLS LEGEND:

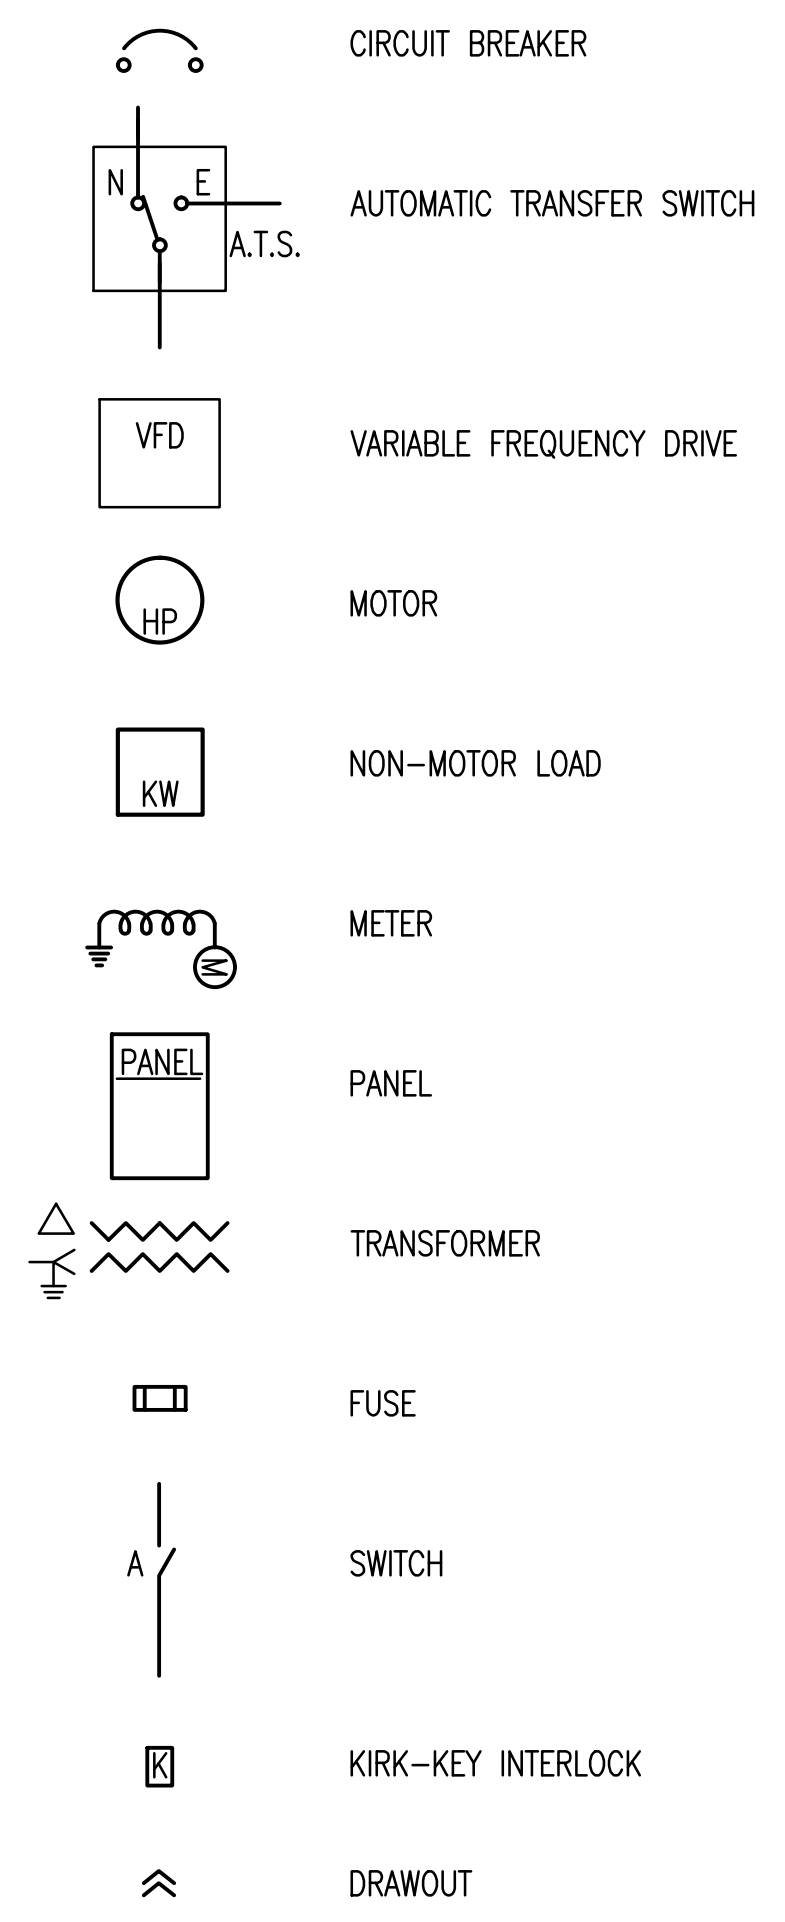

SYMBOL LIST

SYMBOL	DESCRIPTION	MOUNTING
	LIGHT FIXTURE & FIXTURE LETTER	POLE
	STRIP LIGHT FIXTURE & FIXTURE LETTER	CEILING
	GROUND FAULT DUPLEX RECEPTACLE	18" AFF
	SWITCHES (1-POLE, 2-POLE, 3-WAY, 4-WAY)	46" AFF
	WEATHERPROOF	
	ABOVE FINISHED GRADE	
	UNLESS OTHERWISE NOTED	
	SPECIAL OUTLET (SEE SCHEDULE OR AS NOTED)	FLOOR/WALL
	JUNCTION BOX	
	BRANCH CIRCUIT PANEL & PANEL DESIG.	72" TO TOP
	ELECTRICAL DISTRIBUTION EQUIPMENT	
	FEEDER DESIGNATION	
	CONDUIT HOME RUN, 1 CIRCUIT. 2#10 & 1#10 GRD. GEN. NOTE 5 & 6	CEIL./WALL
	CONDUIT RUN 2#12 & 1#12 GRD.- 1/2" C.	CEIL./WALL
	CONDUIT RUN 2#12 & 1#12 GRD.- 3/4" C.	EARTH/FLOOR
	CONDUIT HOME RUN, 1 CIRCUIT. 2#12 & 1#12 GRD. 1/2" C.	CEIL./WALL
	CONDUIT RUN PARTIAL CIRCUIT. 2#12 & 1#12 GRD. 1/2" C.	CEIL./WALL
	CONDUIT HOME RUN, 2 CIRCUITS PHASE CONDUCTORS (#12 UON) NEUTRAL CONDUCTOR (#12 UON) SWITCH LEGS (#12 UON) GROUND CONDUCTOR (#12 UON)	CEIL./WALL
	VOICE UTP CABLE HOME RUN	GEN NOTE T2
	FIBER OPTIC CABLE HOME RUN (MULTI MODE)	GEN NOTE T2
	GROUND ROD	
	GROUND TEST WELL	

ABBREVIATIONS:

A	AMPS
A.I.C.	AMPS INTERRUPTING CAPACITY
A.T.S.	AUTOMATIC TRANSFER SWITCH
AF	AMP FRAME
AT	AMP TRIP
E	EMERGENCY POWER
GEN	GENERATOR
HP	HORSE POWER
KW	KILOWATT
N	NORMAL POWER
PH	PHASE
SPD	SURGE PROTECTION DEVICE
V	VOLTAGE
VFD	VARIABLE FREQUENCY DRIVE
W	WIRE
XFMR	TRANSFORMER

Revision	By	Date
ASI #6		6/30/15
ASI #4		6/25/15
ASI #2		6/18/15
ASI #1		5/26/15

No.	Revision	By	Date
FOR CONSTRUCTION SET			
CITY OF WICHITA, KANSAS			
ELECTRICAL LEAD SHEET			
WWTP #2 EMERGENCY POWER PROJECT C.O.W. PROJECT NO. 468-84956			
PEC PROFESSIONAL ENGINEERING CONSULTANTS, P.A. 303 SOUTH TOPEKA WICHITA, KS 67202 316-262-2891 www.pec1.com			
Designed by	RWW	Job No. 34-14229-001-0042	Sht. E0.0 of 37
Drawn by	CJV	Date 4/29/15	



RECORD DOCUMENTS

THESE DOCUMENTS INCLUDE RECORD INFORMATION PROVIDED BY THE CONTRACTOR. THIS INFORMATION HAS NOT BEEN VERIFIED IN ITS ENTIRETY BY THE DESIGN PROFESSIONAL.

DATE: FEBRUARY, 2016

Saved: 04-04-2016 1:20:20 PM by: CJV
 Plot: 04-04-2016 1:21:46 PM by: CHERS, VALL
 U:\Wichita-Facility\2014\14229\001\Elec\Drawings\As-Built\14229-001-ED.0

TO PARALLELING SWITCHGEAR. SEE SHEET E0.13 FOR CONTINUATION.

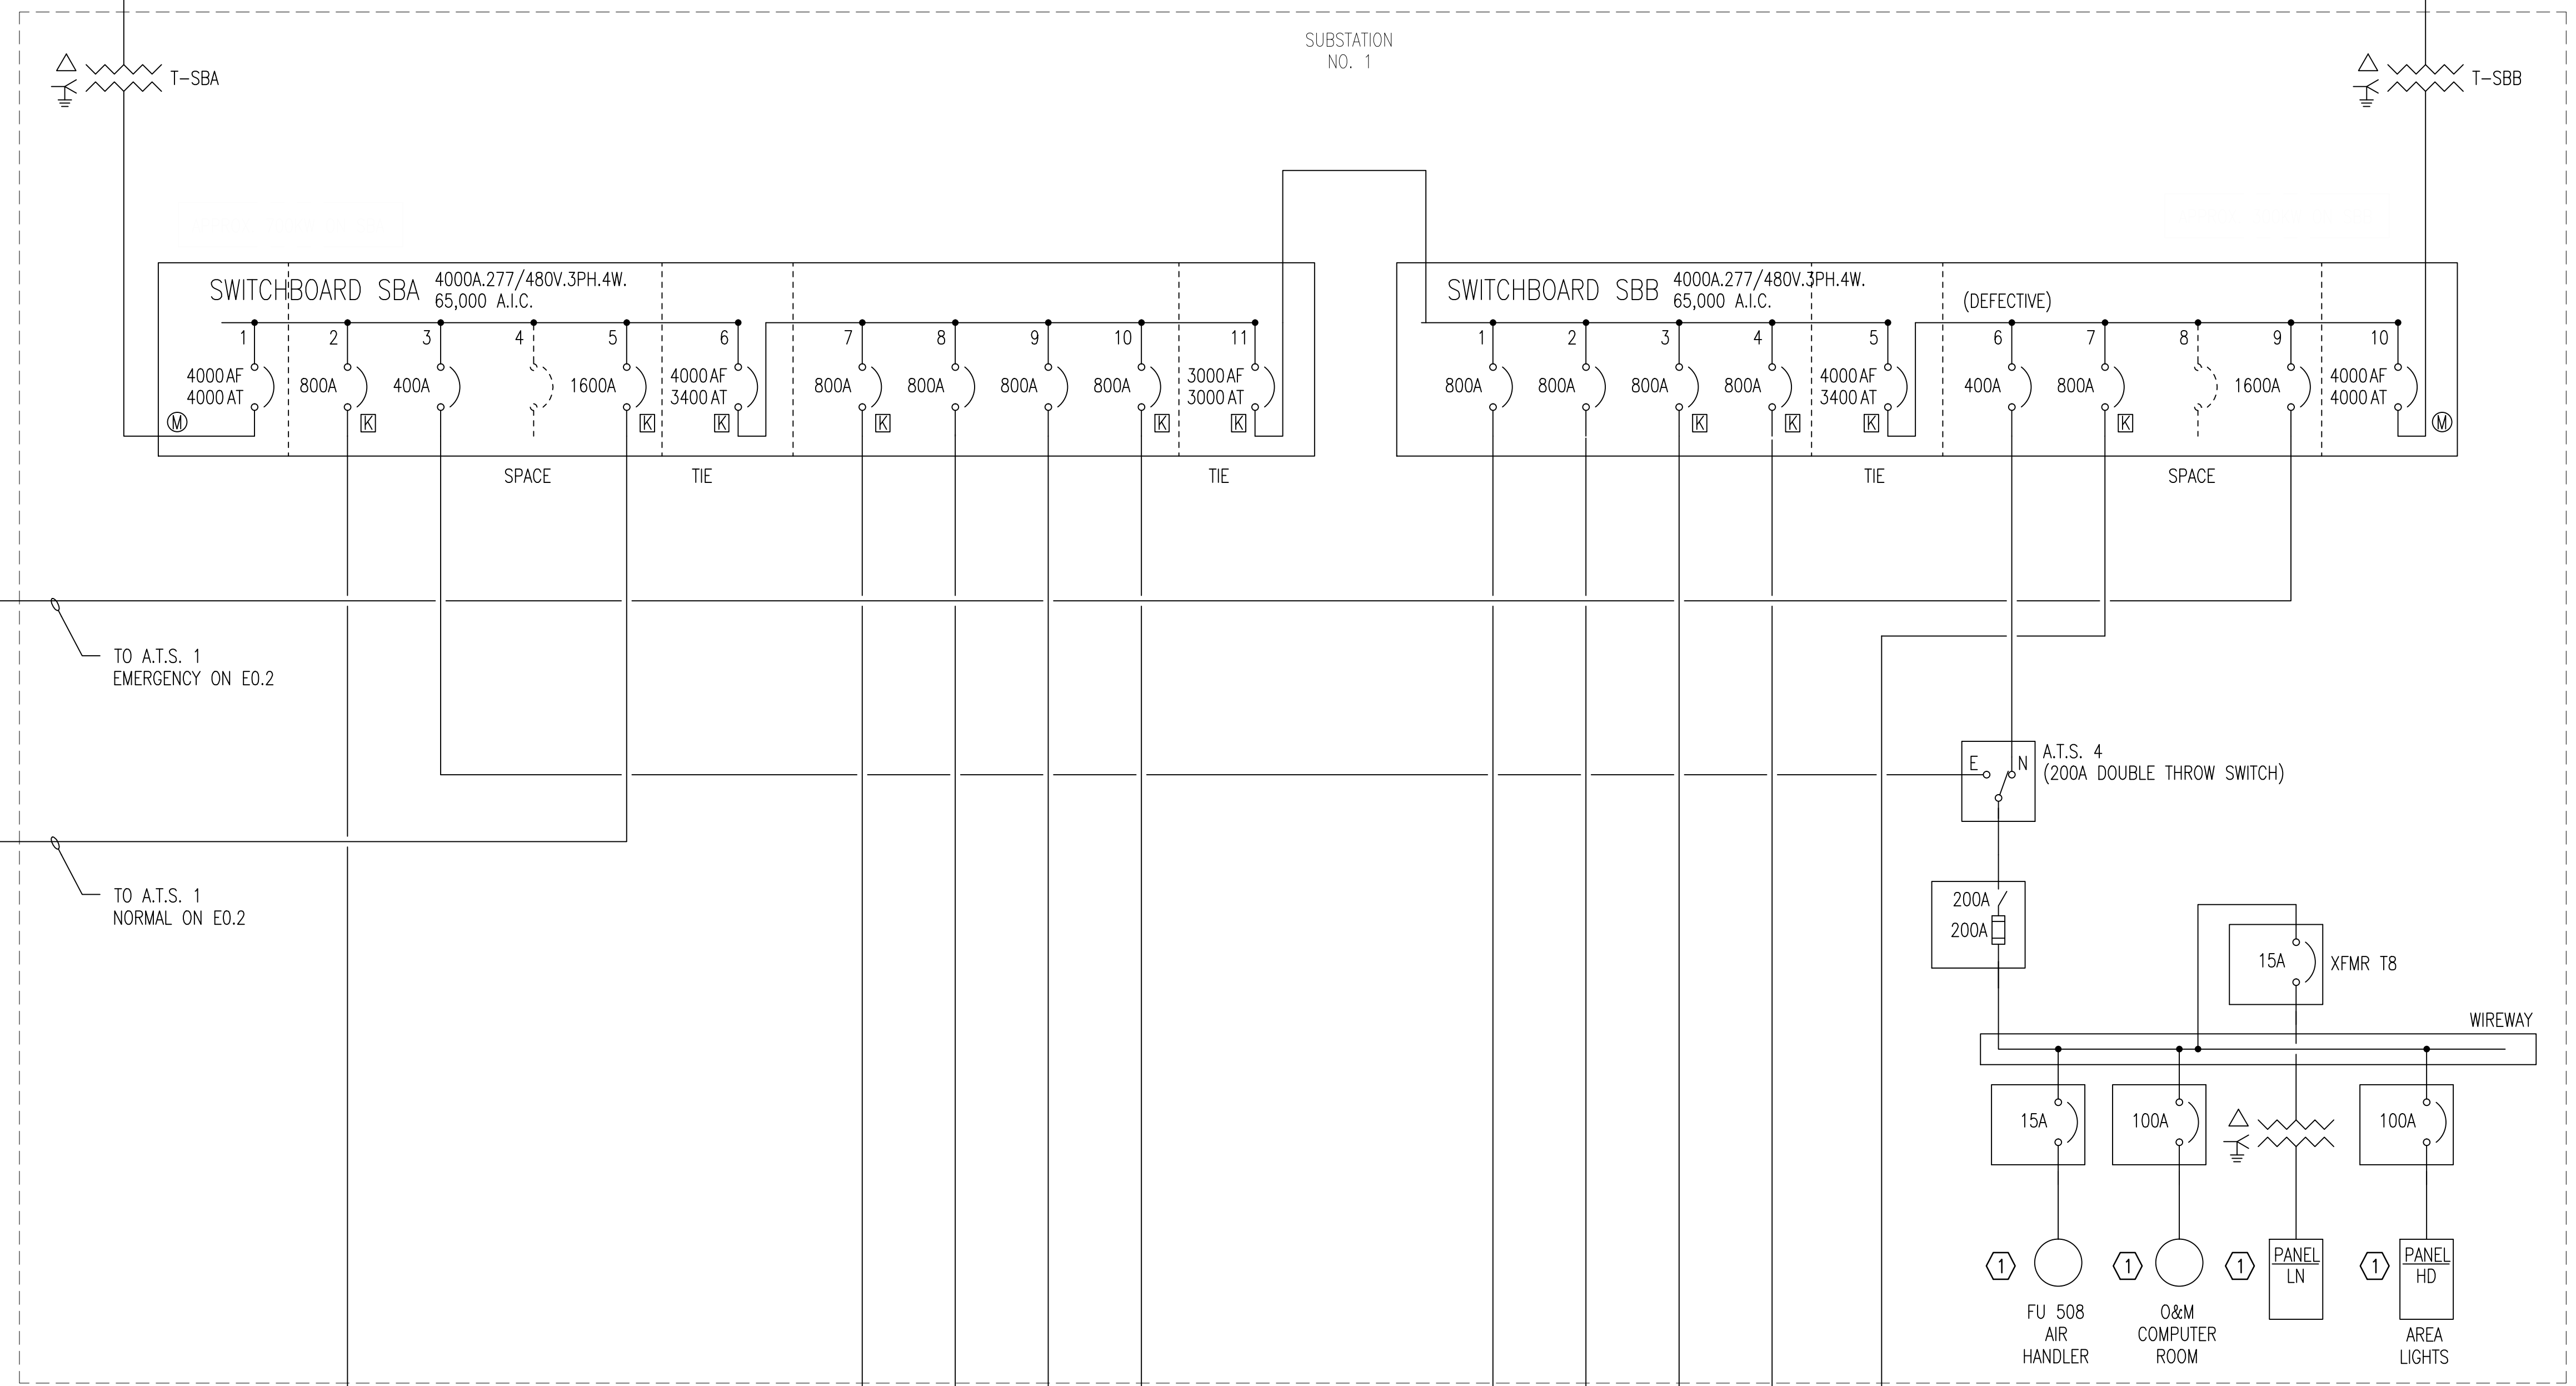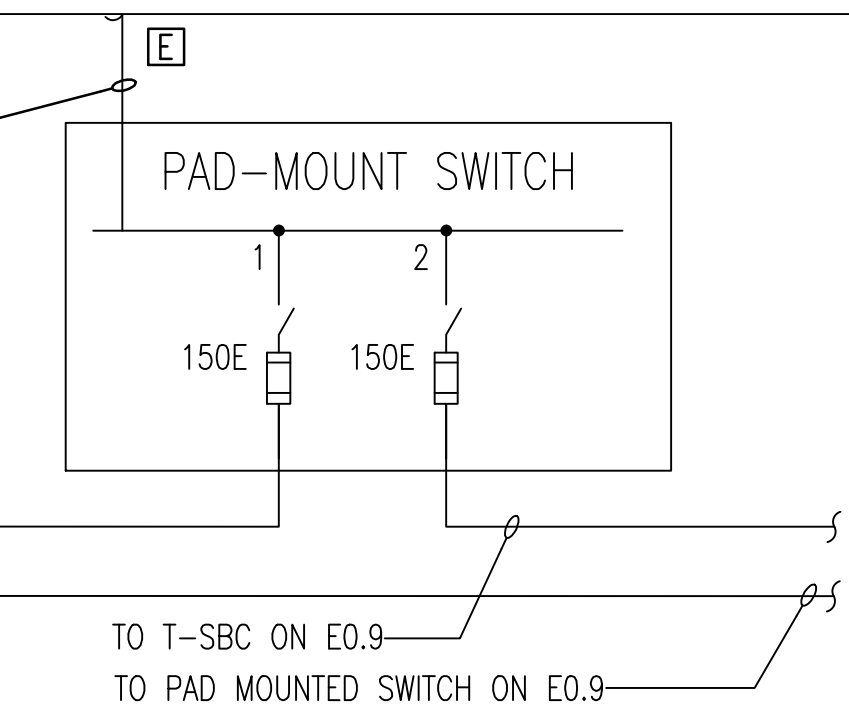

- GENERAL ONE-LINE DIAGRAM NOTES:**
- UNLESS OTHERWISE NOTED, ALL CIRCUIT BREAKERS AND/OR SWITCHES ARE THREE POLE.
 - ALL ELECTRICAL EQUIPMENT AND WIRING SHOWN IN A LIGHT LINE, IS EXISTING TO REMAIN.


- KEYED NOTES:**
- ① CRITICAL LOAD ON STANDBY POWER.

1 EXISTING ONE-LINE DIAGRAM
NOT TO SCALE

⚠	ASI #6	6/30/15
⚠	ASI #4	6/25/15
⚠	ASI #2	6/18/15
⚠	ASI #1	5/26/15

FOR CONSTRUCTION SET		
No.	Revision	By Date

RECORD DOCUMENTS
THESE DOCUMENTS INCLUDE RECORD INFORMATION PROVIDED BY THE CONTRACTOR. THIS INFORMATION HAS NOT BEEN VERIFIED IN ITS ENTIRETY BY THE DESIGN PROFESSIONAL.
DATE: FEBRUARY, 2016

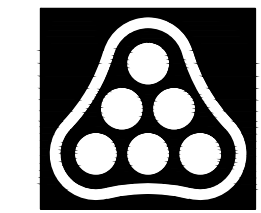

CITY OF WICHITA, KANSAS
EXISTING ONE-LINE DIAGRAM
WWTP #2 EMERGENCY POWER PROJECT
C.O.W. PROJECT NO. 468-84956


PEC PROFESSIONAL ENGINEERING CONSULTANTS, P.A.
303 SOUTH TOPEKA WICHITA, KS 67202
316-262-2891 www.pec1.com

Designed by	RWW	Job No. 34-14229-001-0042	Sht. E0.1 of 37
Drawn by	CJV	Date 4/29/15	


Saved: 04-04-2016 1:00:31 PM by CJV
 Plot: 04-04-2016 1:01:04 PM by CJV
 U:\Wichita-Facility\2014\14229\001\Elec\Drawings\As-Built\14229-001-E0.1

- TO MCC-G1 ON E0.7
- TO MCC-K ON E0.3
- TO MCC-E ON E0.6
- TO A.T.S. 2 EMERGENCY ON E0.5
- TO MCC-F1 ON E0.4
- TO MCC-G2 ON E0.7
- TO A.T.S. 2 NORMAL ON E0.5
- TO MCC-D ON E0.8
- TO MDP ON E0.2

SBB:9 ON E0.1
SBA:5 ON E0.1

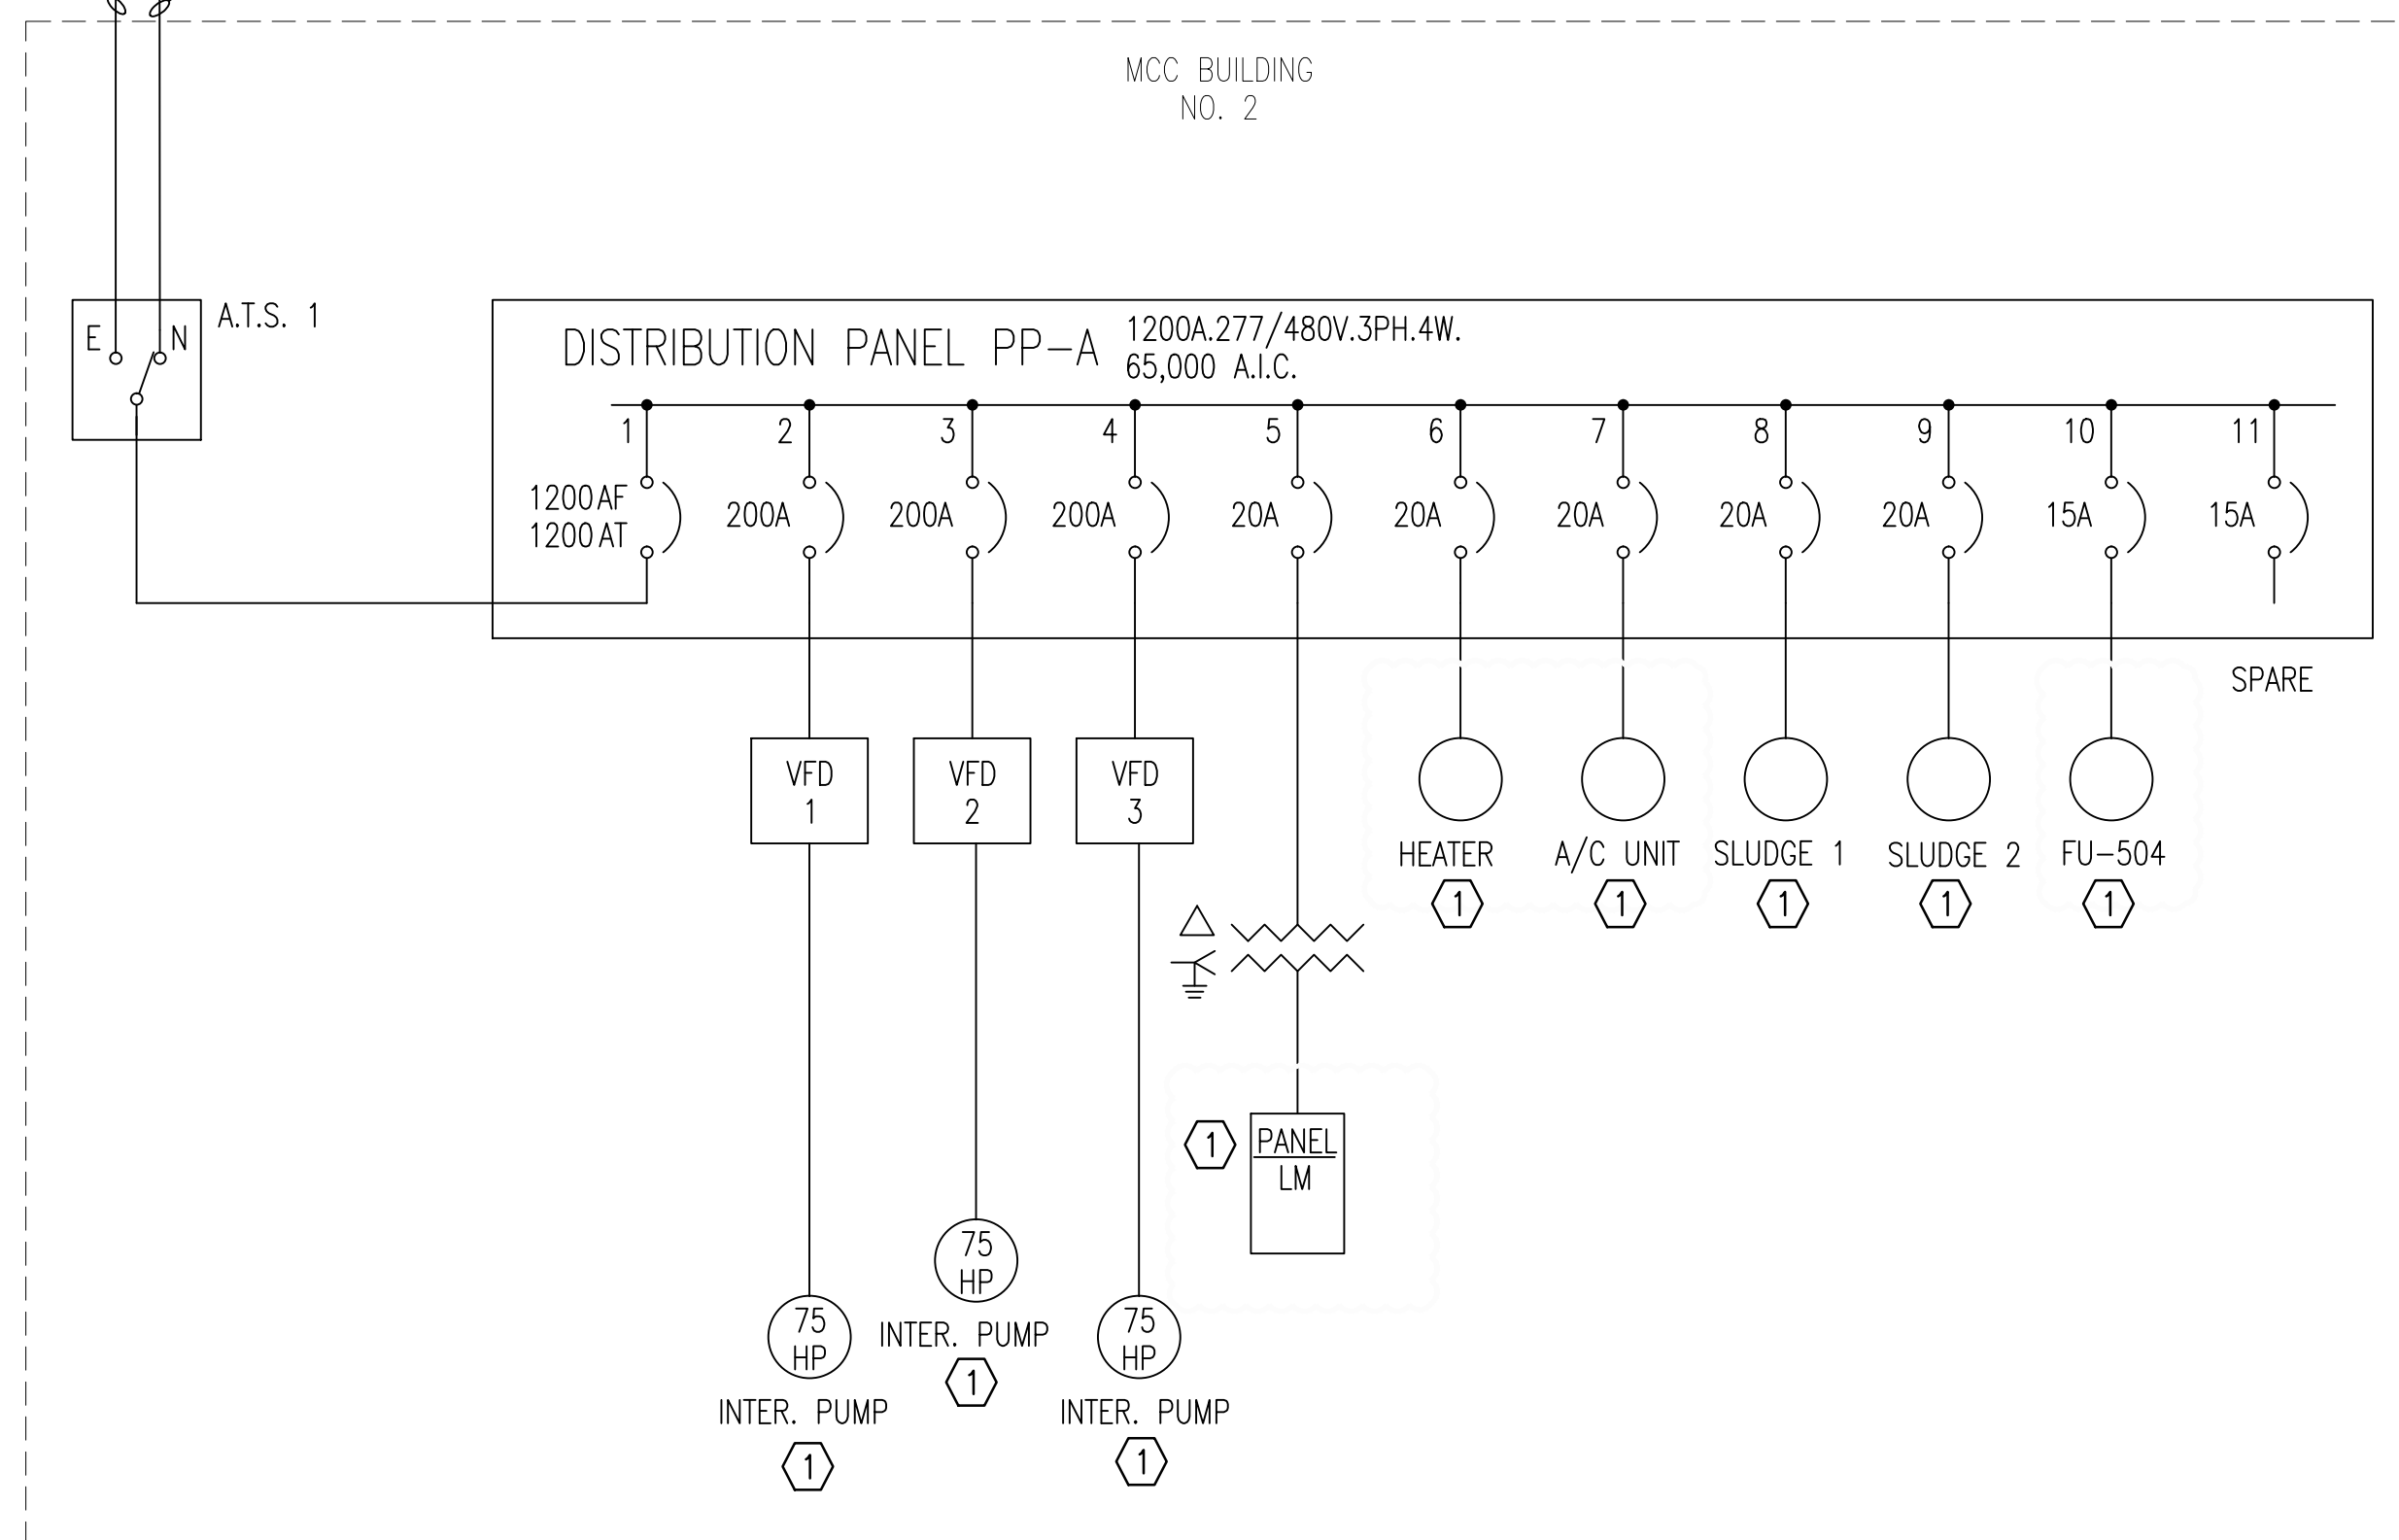

SBB:1 ON E0.1

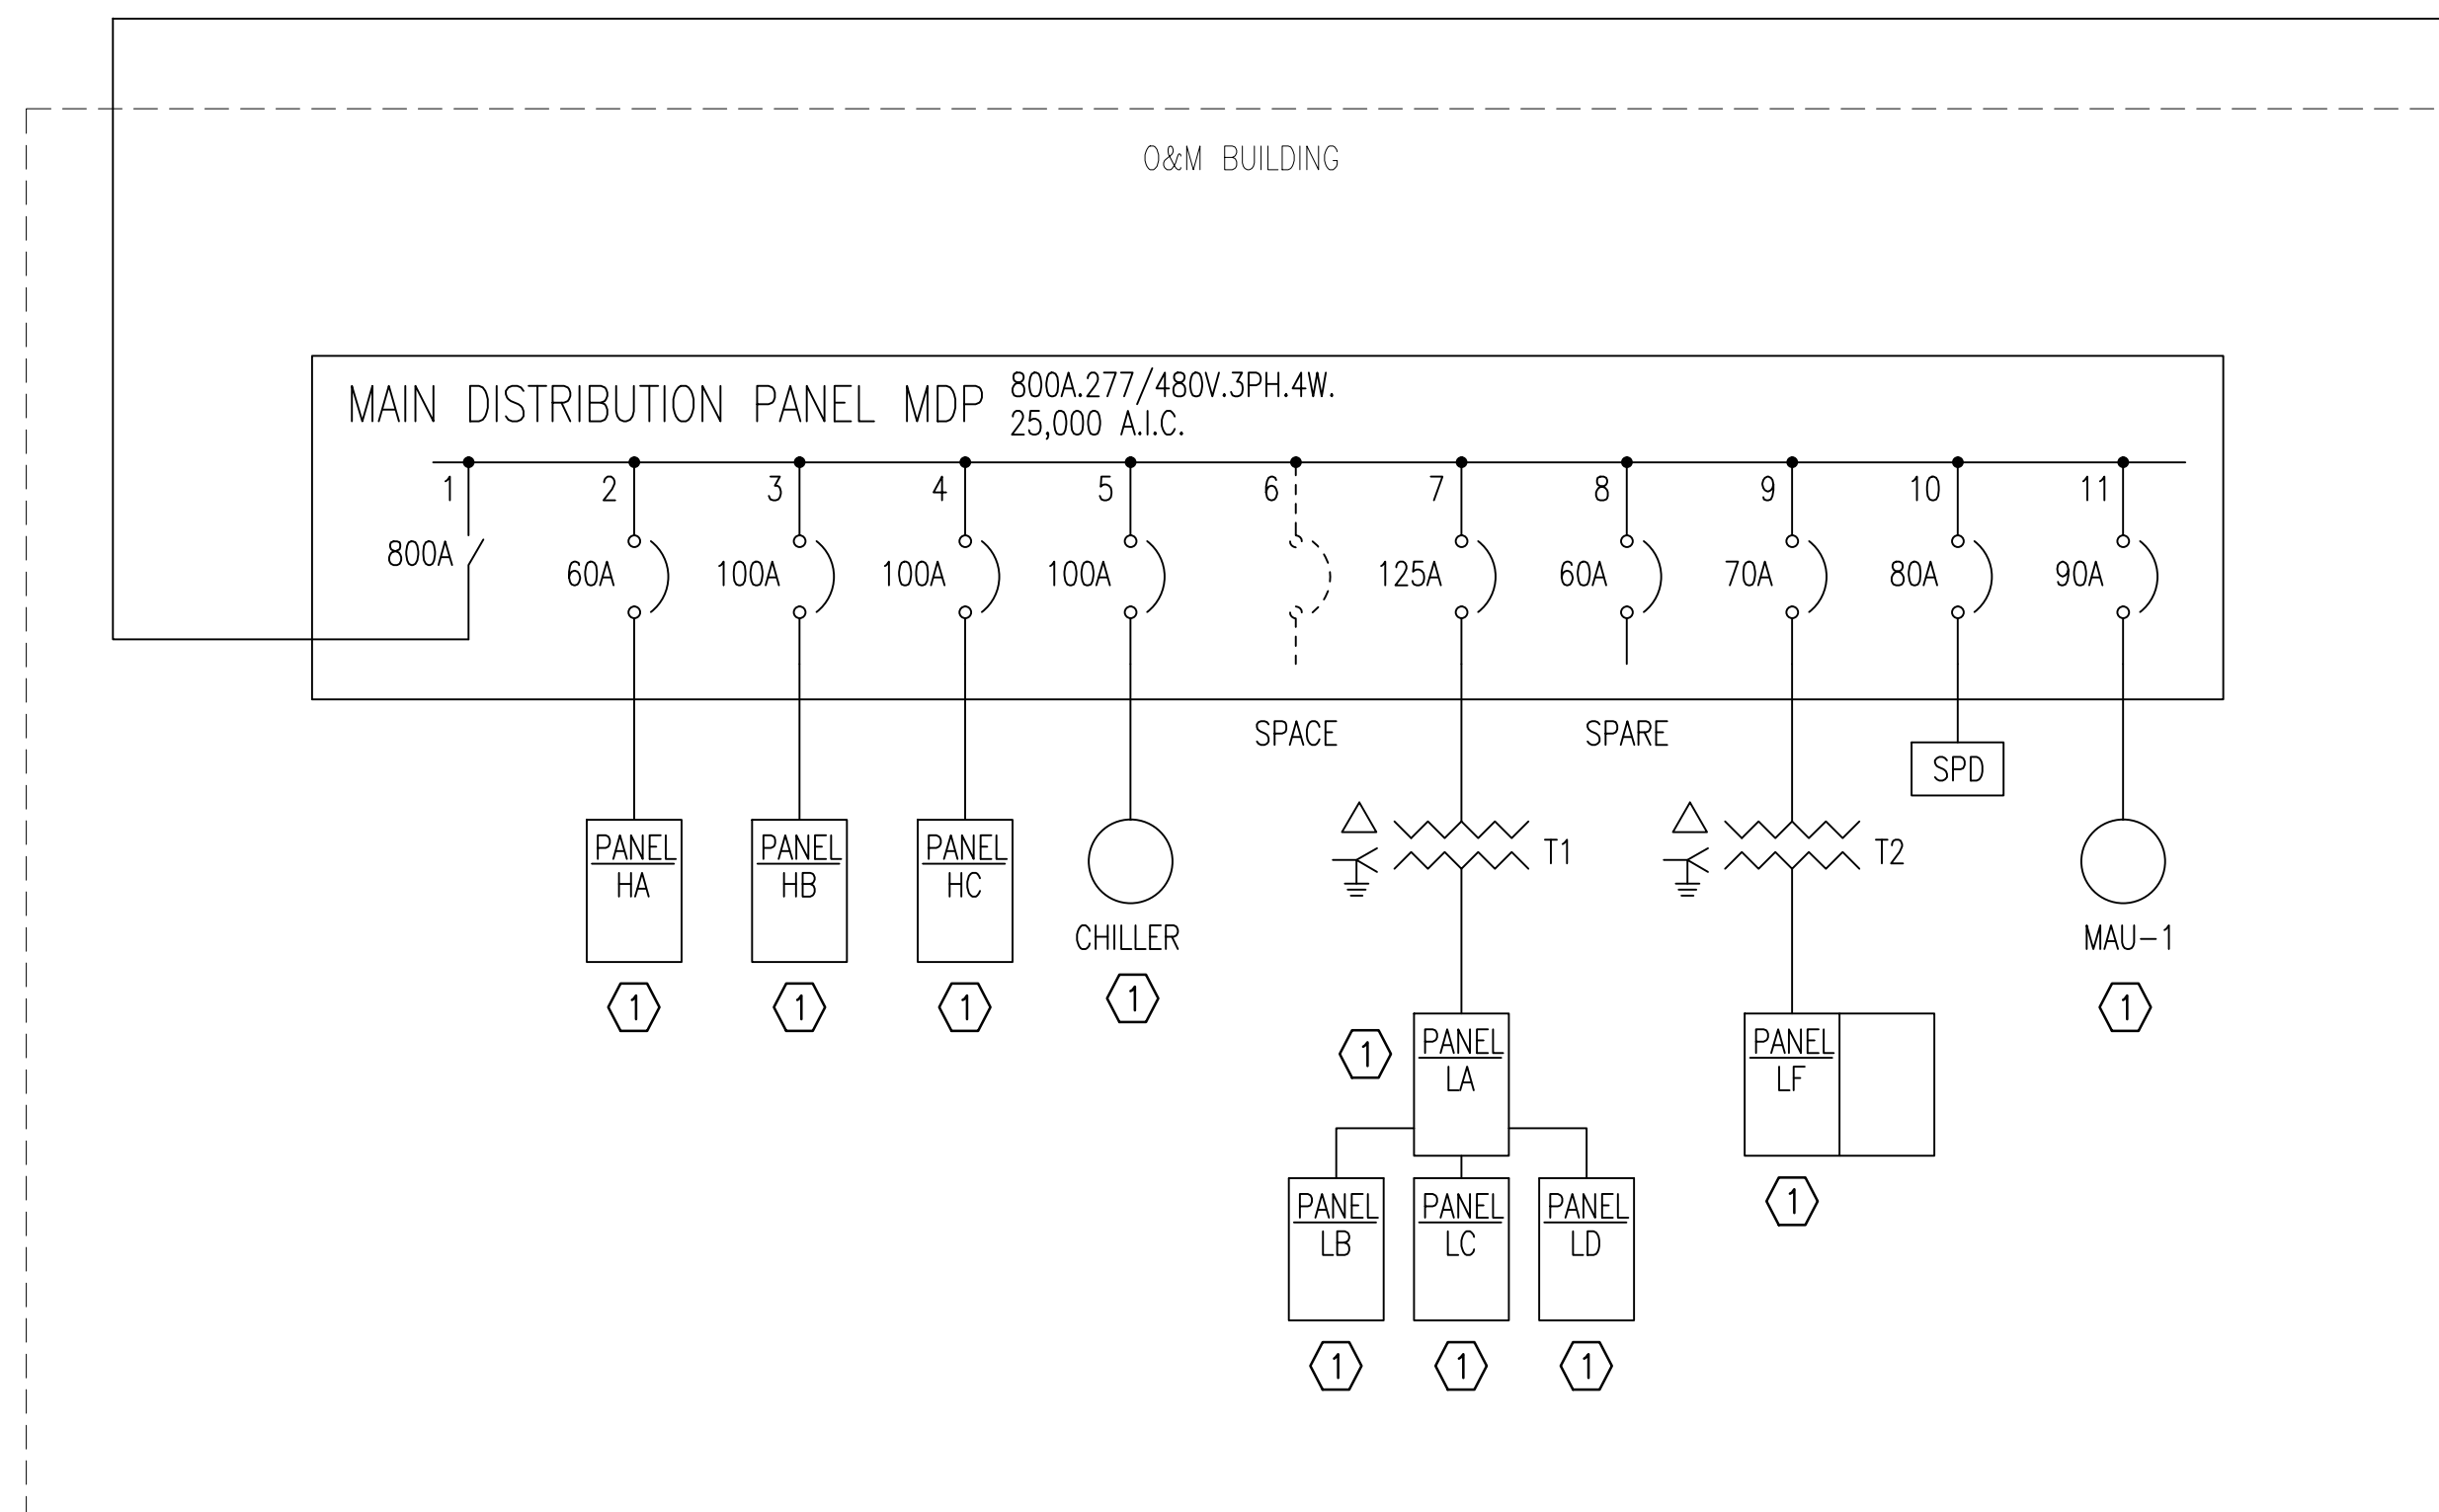

GENERAL ONE-LINE DIAGRAM NOTES:

- UNLESS OTHERWISE NOTED, ALL CIRCUIT BREAKERS AND/OR SWITCHES ARE THREE POLE.
- ALL ELECTRICAL EQUIPMENT AND WIRING SHOWN IN A LIGHT LINE, IS EXISTING TO REMAIN.

KEYED NOTES:

- ① CRITICAL LOAD ON STANDBY POWER.

1 EXISTING ONE-LINE DIAGRAM
NOT TO SCALE

⚠	ASI #6	6/30/15
⚠	ASI #4	6/25/15
⚠	ASI #2	6/18/15
⚠	ASI #1	5/26/15


FOR CONSTRUCTION SET		
No.	Revision	By Date

CITY OF WICHITA, KANSAS
EXISTING ONE-LINE DIAGRAM


WWTP #2 EMERGENCY POWER PROJECT
C.O.W. PROJECT NO. 468-84956

PEC PROFESSIONAL ENGINEERING CONSULTANTS, P.A.
303 SOUTH TOPEKA WICHITA, KS 67202
316-262-2891 www.pec1.com

RECORD DOCUMENTS
THESE DOCUMENTS INCLUDE RECORD INFORMATION PROVIDED BY THE CONTRACTOR. THIS INFORMATION HAS NOT BEEN VERIFIED IN ITS ENTIRETY BY THE DESIGN PROFESSIONAL.
DATE: FEBRUARY, 2016

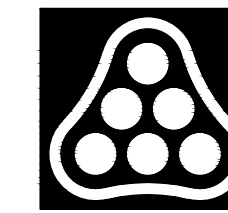

Designed by	RWW	Job No. 34-14229-001-0042	Sht. E0.2 of 37
Drawn by	CJV	Date 4/29/15	

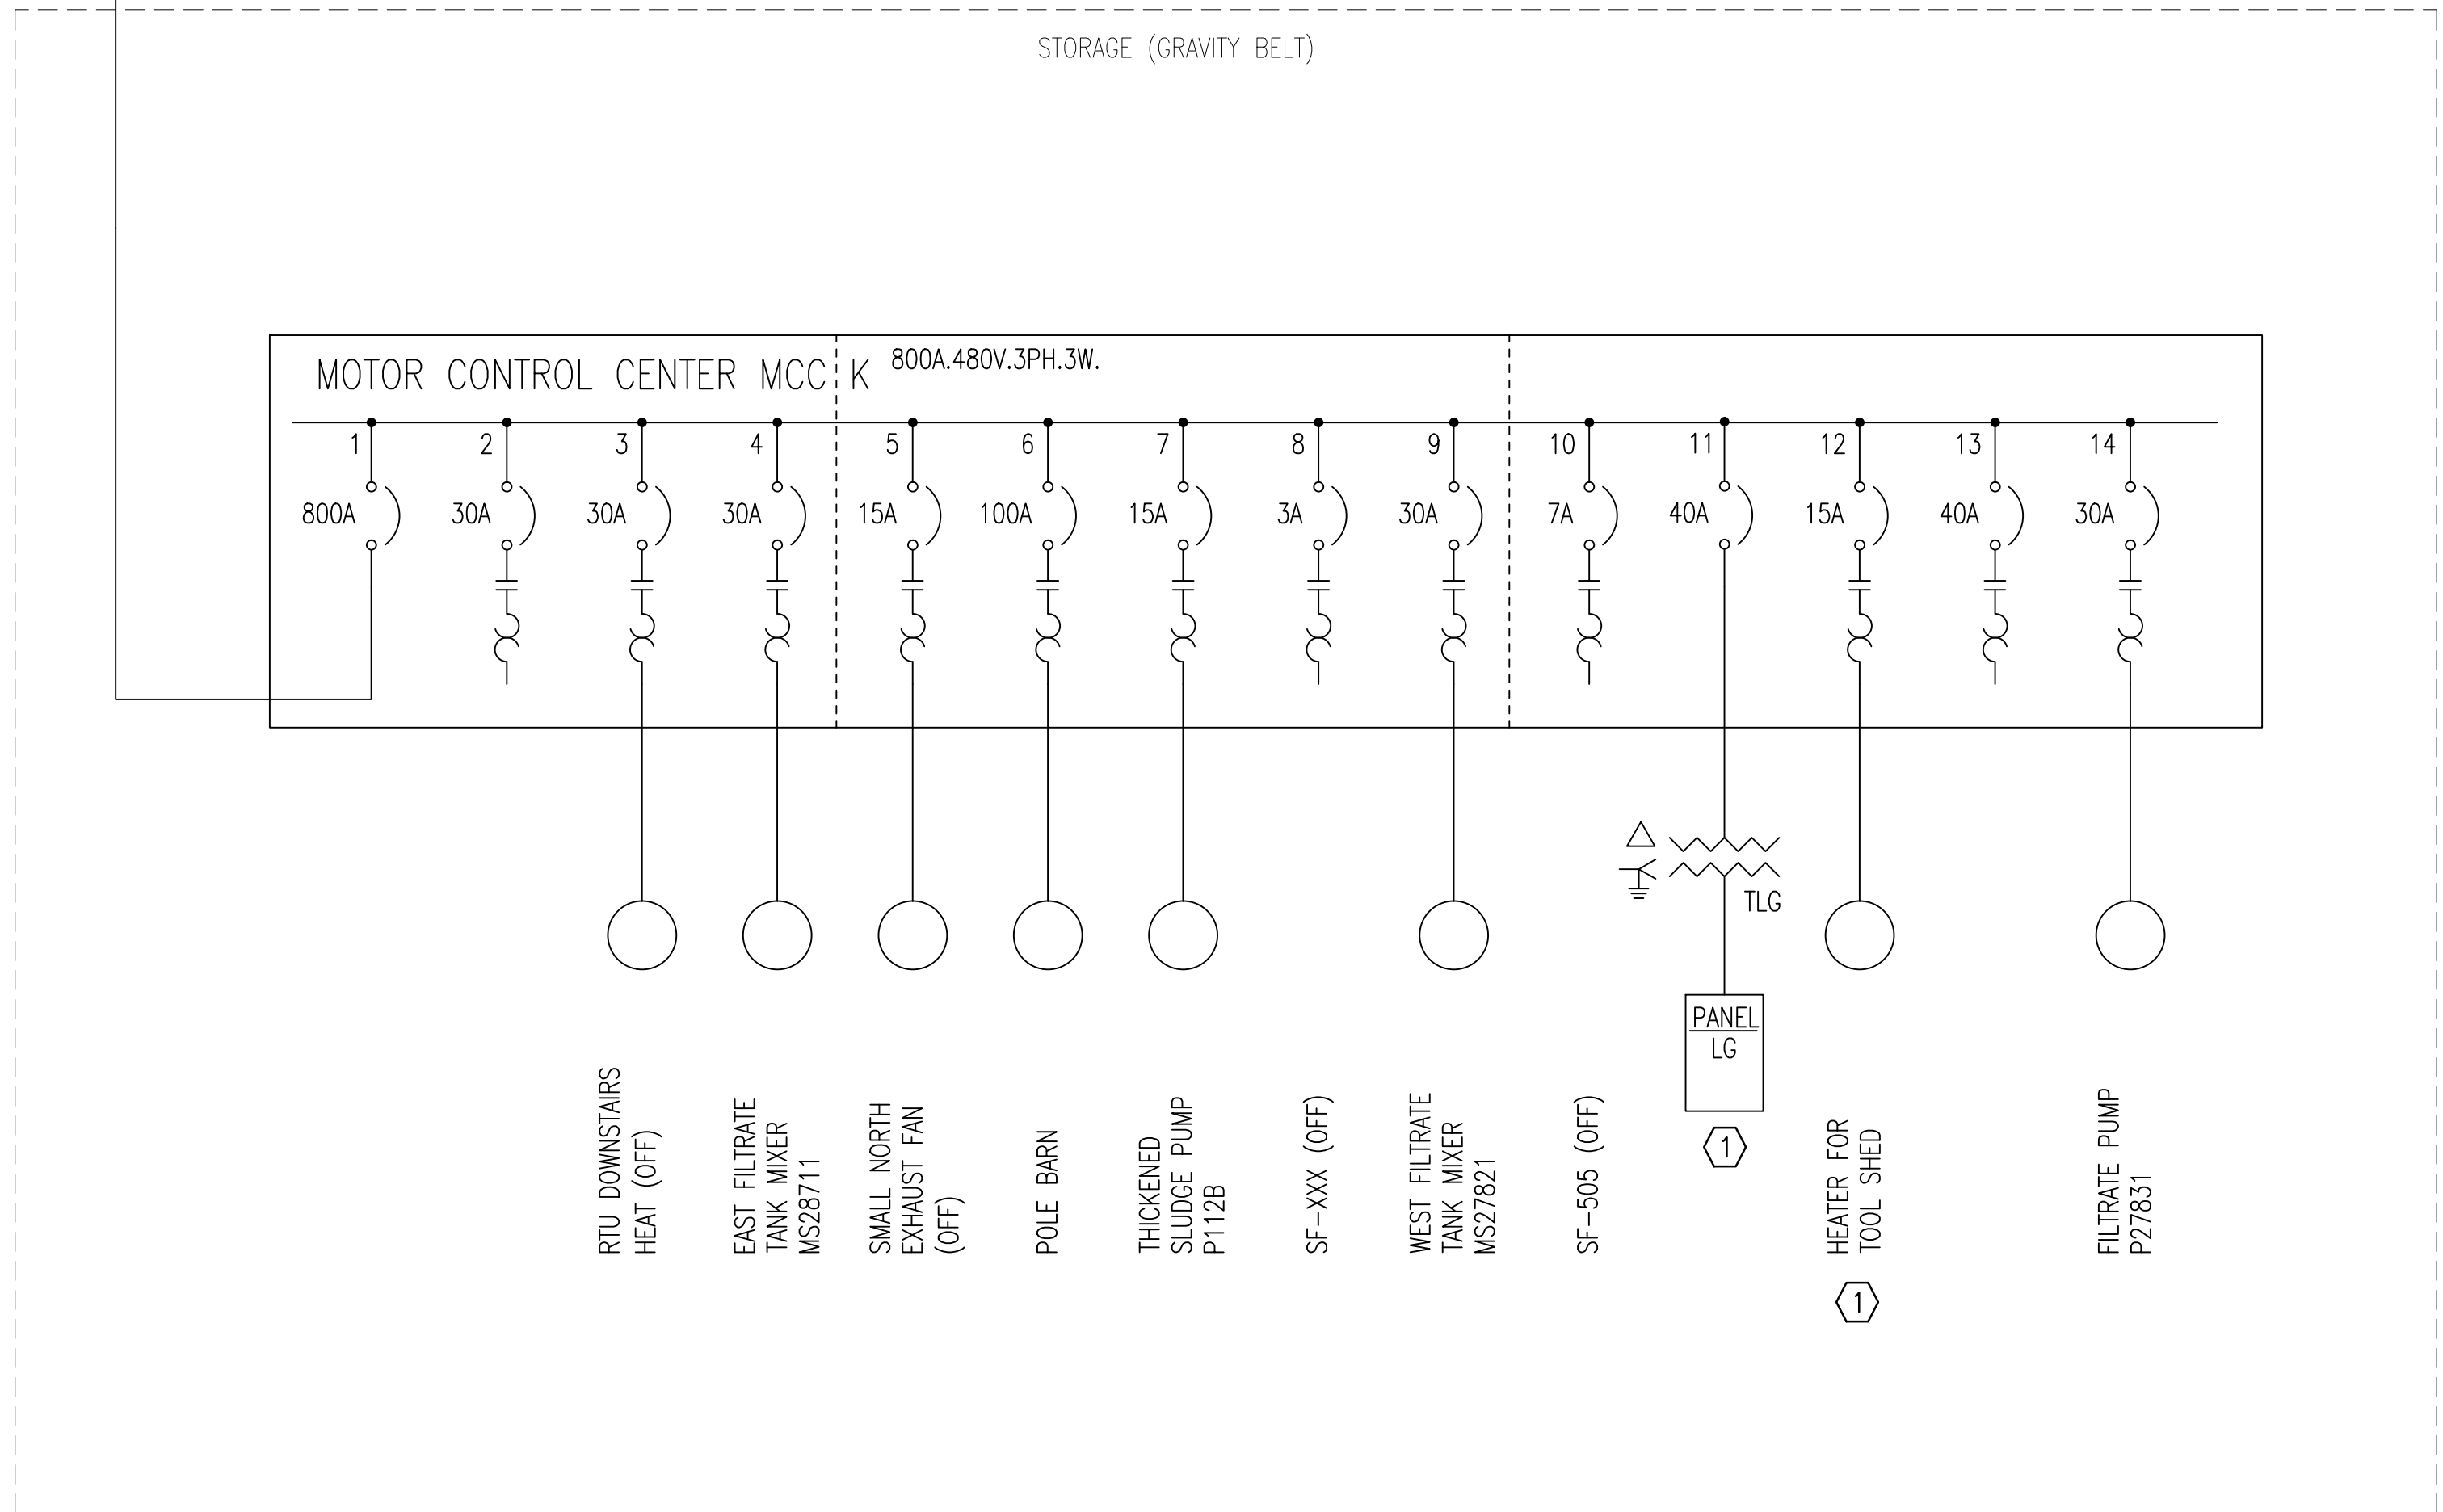

GENERAL ONE-LINE DIAGRAM NOTES:

1. UNLESS OTHERWISE NOTED, ALL CIRCUIT BREAKERS AND/OR SWITCHES ARE THREE POLE.
2. ALL ELECTRICAL EQUIPMENT AND WIRING SHOWN IN A LIGHT LINE, IS EXISTING TO REMAIN.

KEYED NOTES:

- ① CRITICAL LOAD ON STANDBY POWER.


1 EXISTING ONE-LINE DIAGRAM
NOT TO SCALE

▲	ASI #6	6/30/15
▲	ASI #4	6/25/15
▲	ASI #2	6/18/15
▲	ASI #1	5/26/15

FOR CONSTRUCTION SET		
No.	Revision	By Date

RECORD DOCUMENTS
THESE DOCUMENTS INCLUDE RECORD INFORMATION PROVIDED BY THE CONTRACTOR. THIS INFORMATION HAS NOT BEEN VERIFIED IN ITS ENTIRETY BY THE DESIGN PROFESSIONAL.
DATE: FEBRUARY, 2016


CITY OF WICHITA, KANSAS
EXISTING ONE-LINE DIAGRAM
WWTP #2 EMERGENCY POWER PROJECT
C.O.W. PROJECT NO. 468-84956

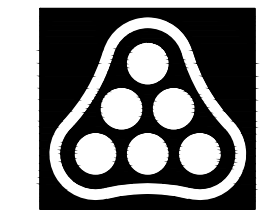

PEC PROFESSIONAL ENGINEERING CONSULTANTS, P.A.
303 SOUTH TOPEKA WICHITA, KS 67202
316-262-2891 www.pec1.com

Designed by	RWW	Job No. 34-14229-001-0042	Sht. E0.3 of 37
Drawn by	CJV	Date 4/29/15	

Saved: 04-04-2016, 1:20:16 PM by: C:\V
 P:\S...
 U:\Wichita-Facility\14229\001\Elec\Drawings\As-Built\14229-001-ED.4

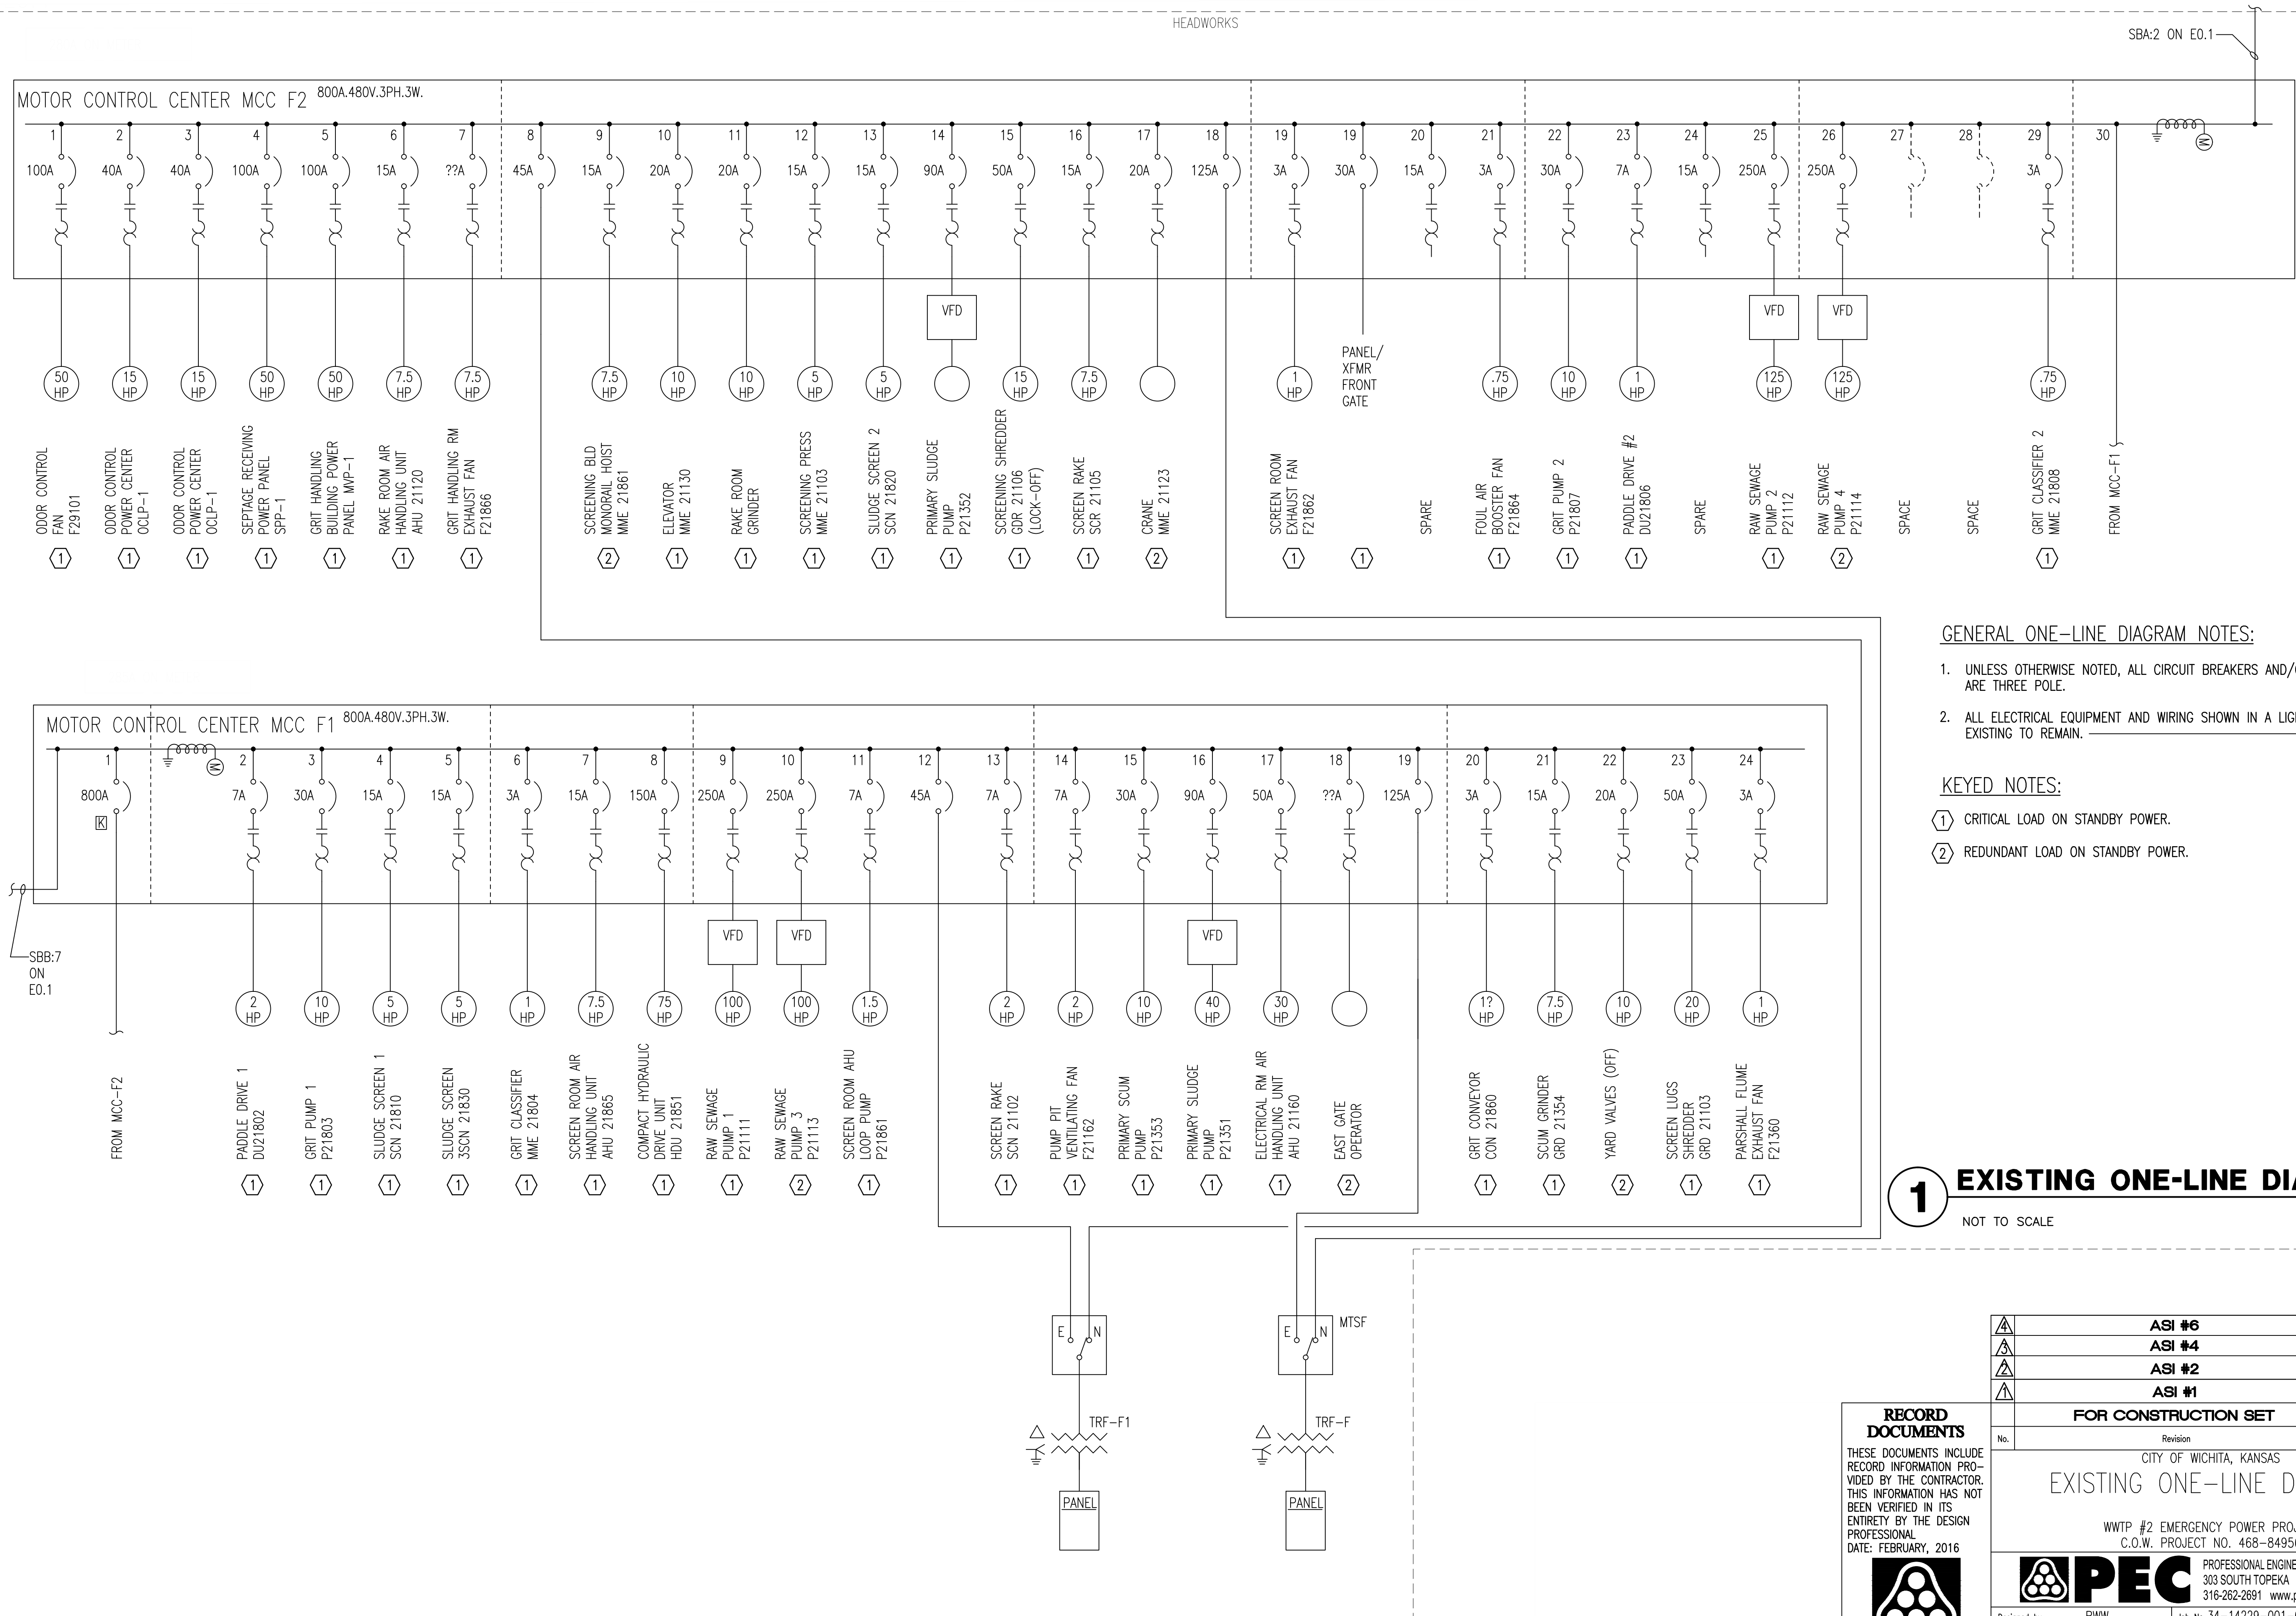


- GENERAL ONE-LINE DIAGRAM NOTES:**
- UNLESS OTHERWISE NOTED, ALL CIRCUIT BREAKERS AND/OR SWITCHES ARE THREE POLE.
 - ALL ELECTRICAL EQUIPMENT AND WIRING SHOWN IN A LIGHT LINE, IS EXISTING TO REMAIN.



- KEYED NOTES:**
- ① CRITICAL LOAD ON STANDBY POWER.
 - ② REDUNDANT LOAD ON STANDBY POWER.

1 EXISTING ONE-LINE DIAGRAM
NOT TO SCALE

RECORD DOCUMENTS
THESE DOCUMENTS INCLUDE RECORD INFORMATION PROVIDED BY THE CONTRACTOR. THIS INFORMATION HAS NOT BEEN VERIFIED IN ITS ENTIRETY BY THE DESIGN PROFESSIONAL.
DATE: FEBRUARY, 2016

▲	ASI #6	6/30/15
▲	ASI #4	6/25/15
▲	ASI #2	6/18/15
▲	ASI #1	5/26/15
FOR CONSTRUCTION SET		
No.	Revision	By Date
CITY OF WICHITA, KANSAS		
EXISTING ONE-LINE DIAGRAM		
WWTP #2 EMERGENCY POWER PROJECT C.O.W. PROJECT NO. 468-84956		
 PEC PROFESSIONAL ENGINEERING CONSULTANTS, P.A. 303 SOUTH TOPEKA WICHITA, KS 67202 316-262-2691 www.pec1.com		
Designed by	RWW	Job No. 34-14229-001-0042
Drawn by	CJV	Date 4/29/15
		Sht. E0.4 of 37

Saved: 04-04-2016 1:20:18 PM by CJV
 Project: 14229-001-ED-5
 U:\Wichita-Facility\14229\001\Elec\Drawings\As-Built\14229-001-ED-5

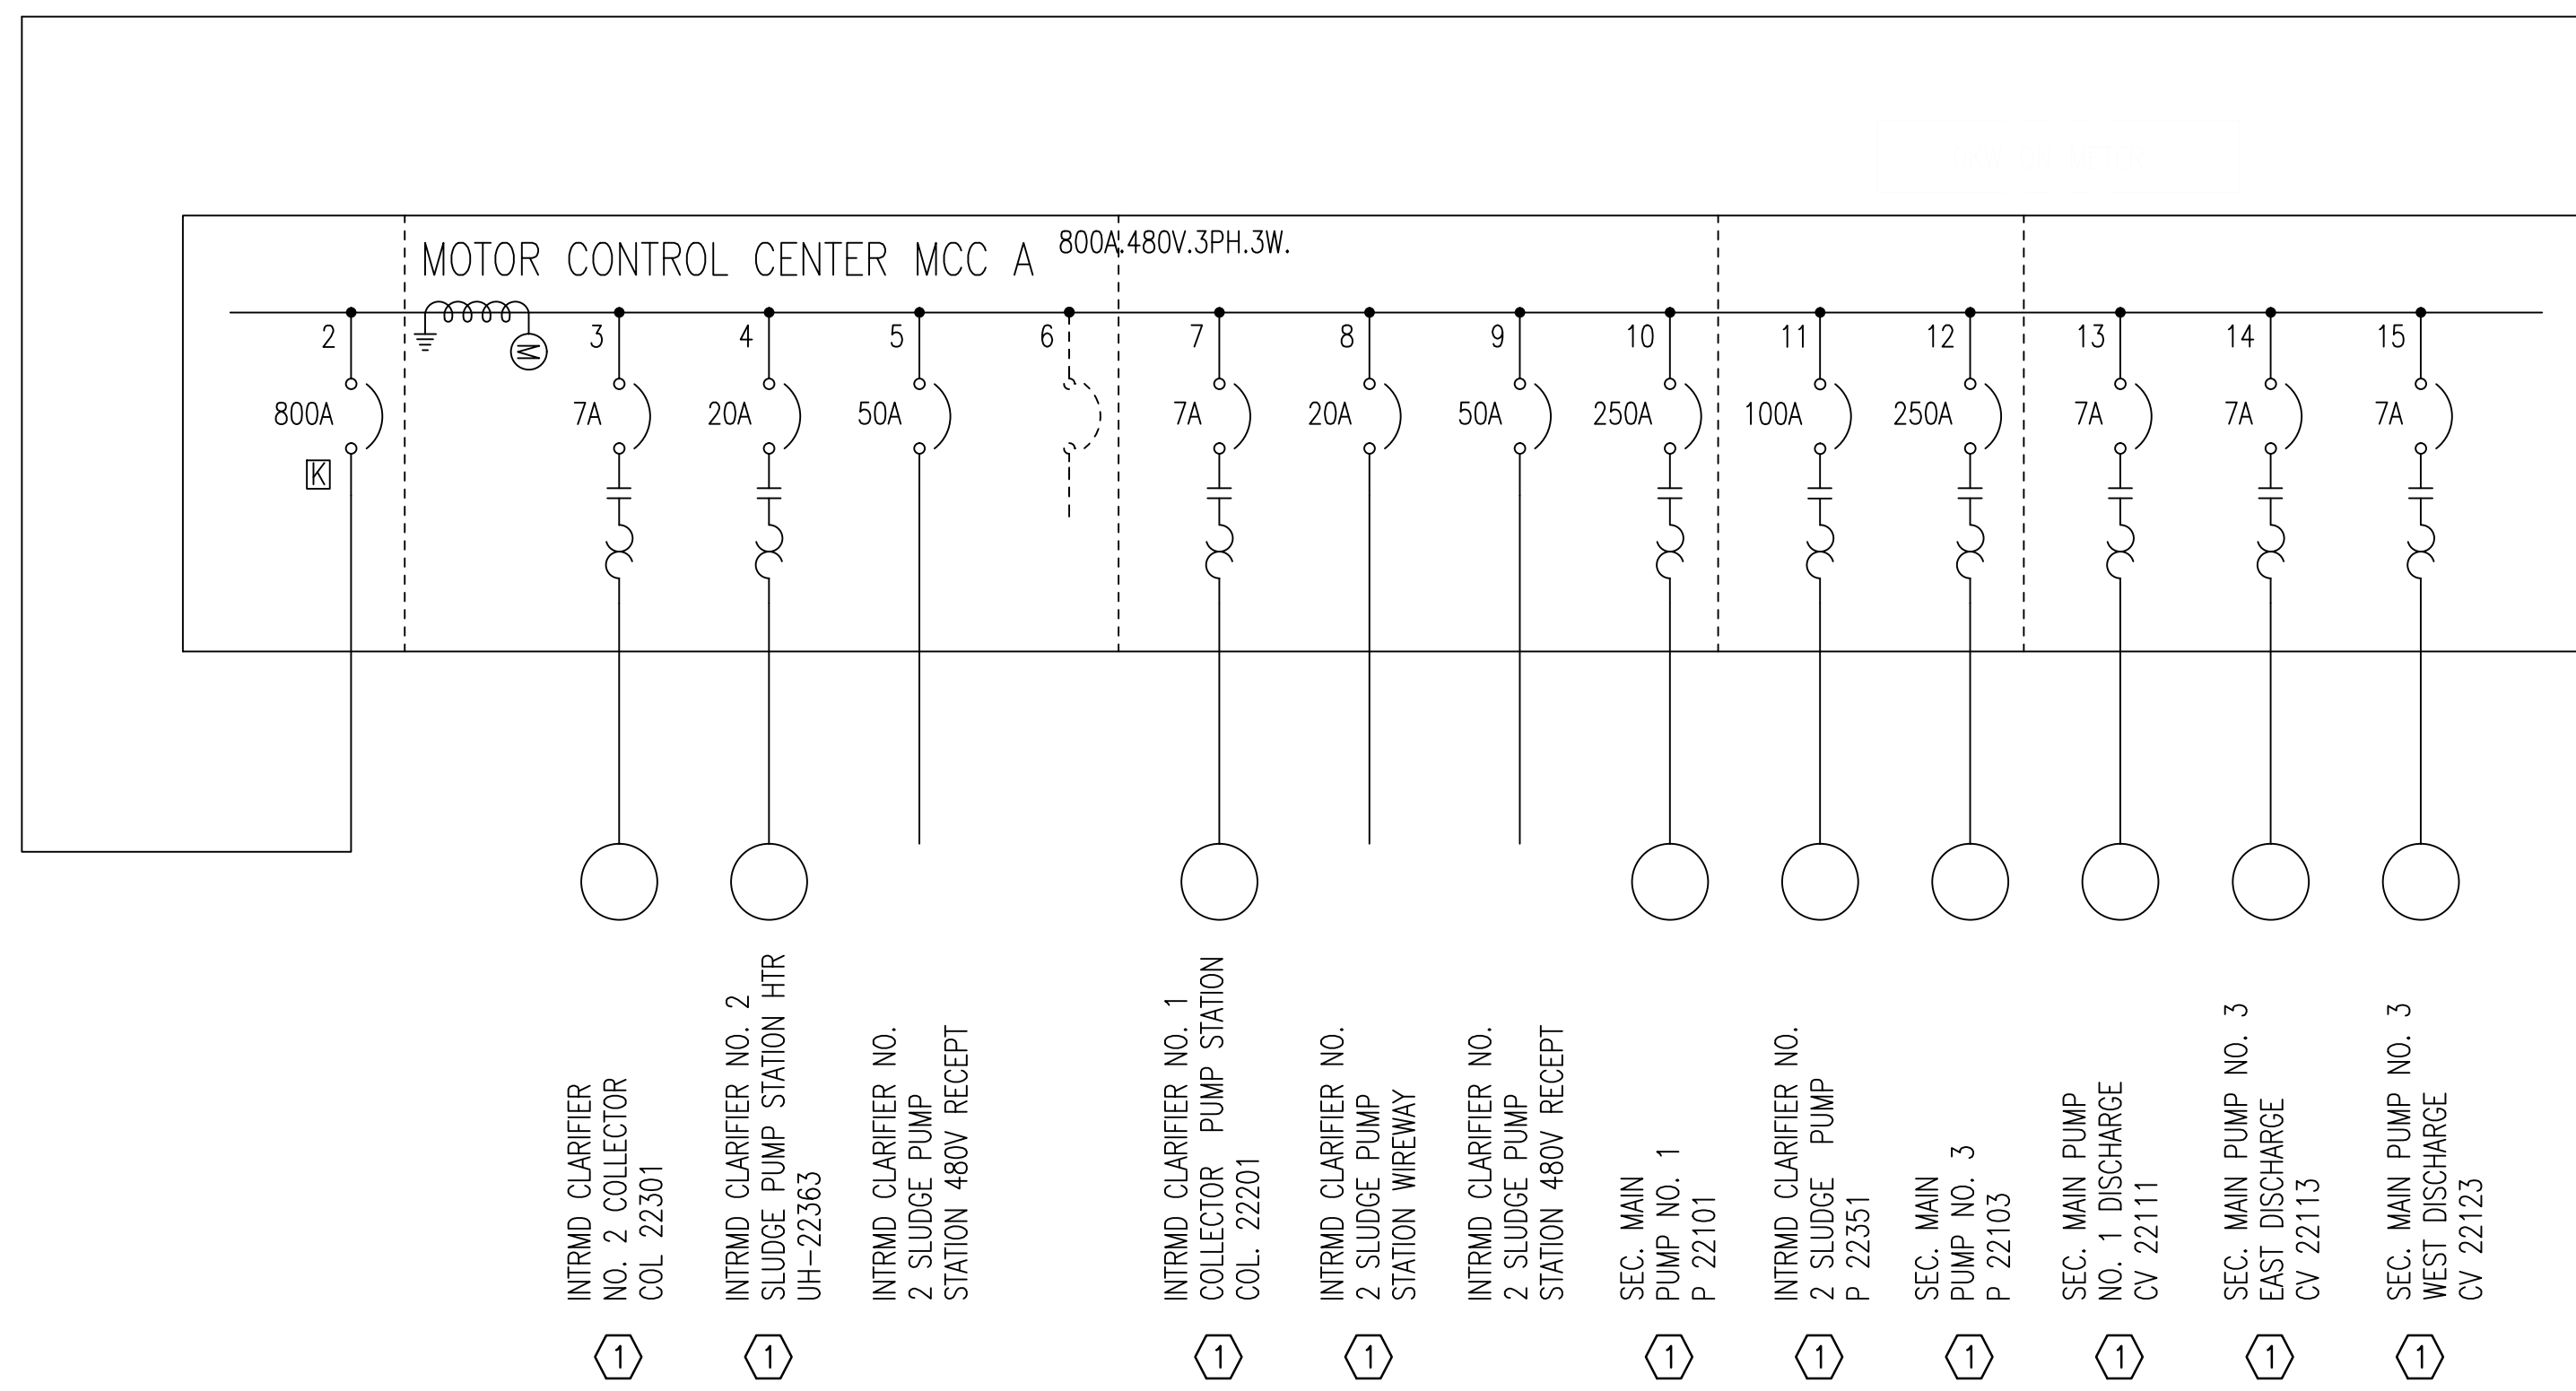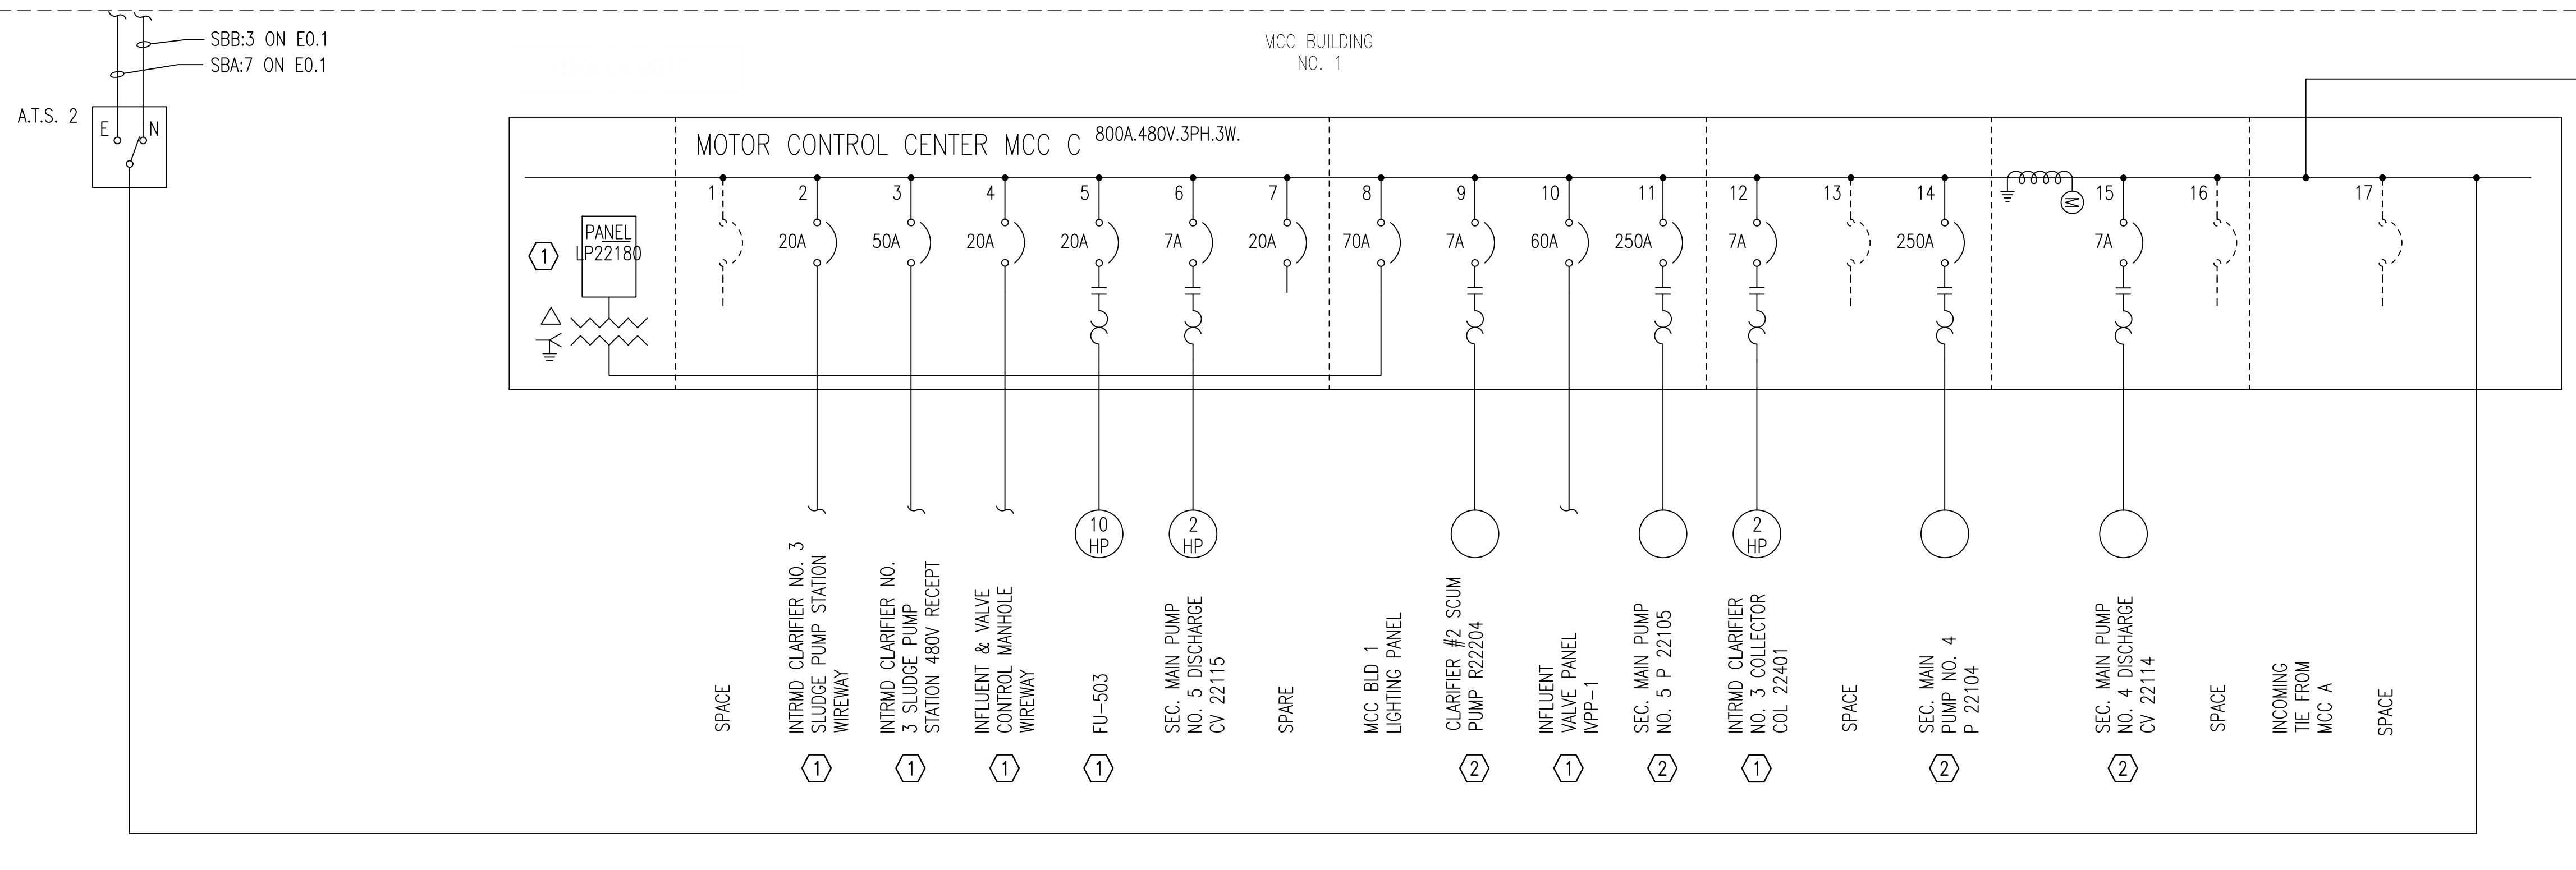

GENERAL ONE-LINE DIAGRAM NOTES:

- UNLESS OTHERWISE NOTED, ALL CIRCUIT BREAKERS AND/OR SWITCHES ARE THREE POLE.
- ALL ELECTRICAL EQUIPMENT AND WIRING SHOWN IN A LIGHT LINE, IS EXISTING TO REMAIN.


KEYED NOTES:

- (1) CRITICAL LOAD ON STANDBY POWER.
- (2) REDUNDANT LOAD ON STANDBY POWER.

1 EXISTING ONE-LINE DIAGRAM
NOT TO SCALE

▲	ASI #6	6/30/15
▲	ASI #4	6/25/15
▲	ASI #2	6/18/15
▲	ASI #1	5/26/15
FOR CONSTRUCTION SET		4/29/15


RECORD DOCUMENTS
 THESE DOCUMENTS INCLUDE RECORD INFORMATION PROVIDED BY THE CONTRACTOR. THIS INFORMATION HAS NOT BEEN VERIFIED IN ITS ENTIRETY BY THE DESIGN PROFESSIONAL.
 DATE: FEBRUARY, 2016

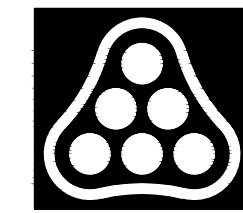

PEC PROFESSIONAL ENGINEERING CONSULTANTS, P.A.
 303 SOUTH TOPEKA WICHITA, KS 67202
 316-262-2891 www.pec1.com

Designed by	RWW	Job No. 34-14229-001-0042	Sht. E0.5 of 37
Drawn by	CJV	Date 4/29/15	

Save: 04-04-2016, 1:20:24 PM by CJV
 P:\S...
 U:\Wichita-Facility\14229\001\Elec\Drawings\AS-Builds\14229-001-ED.6

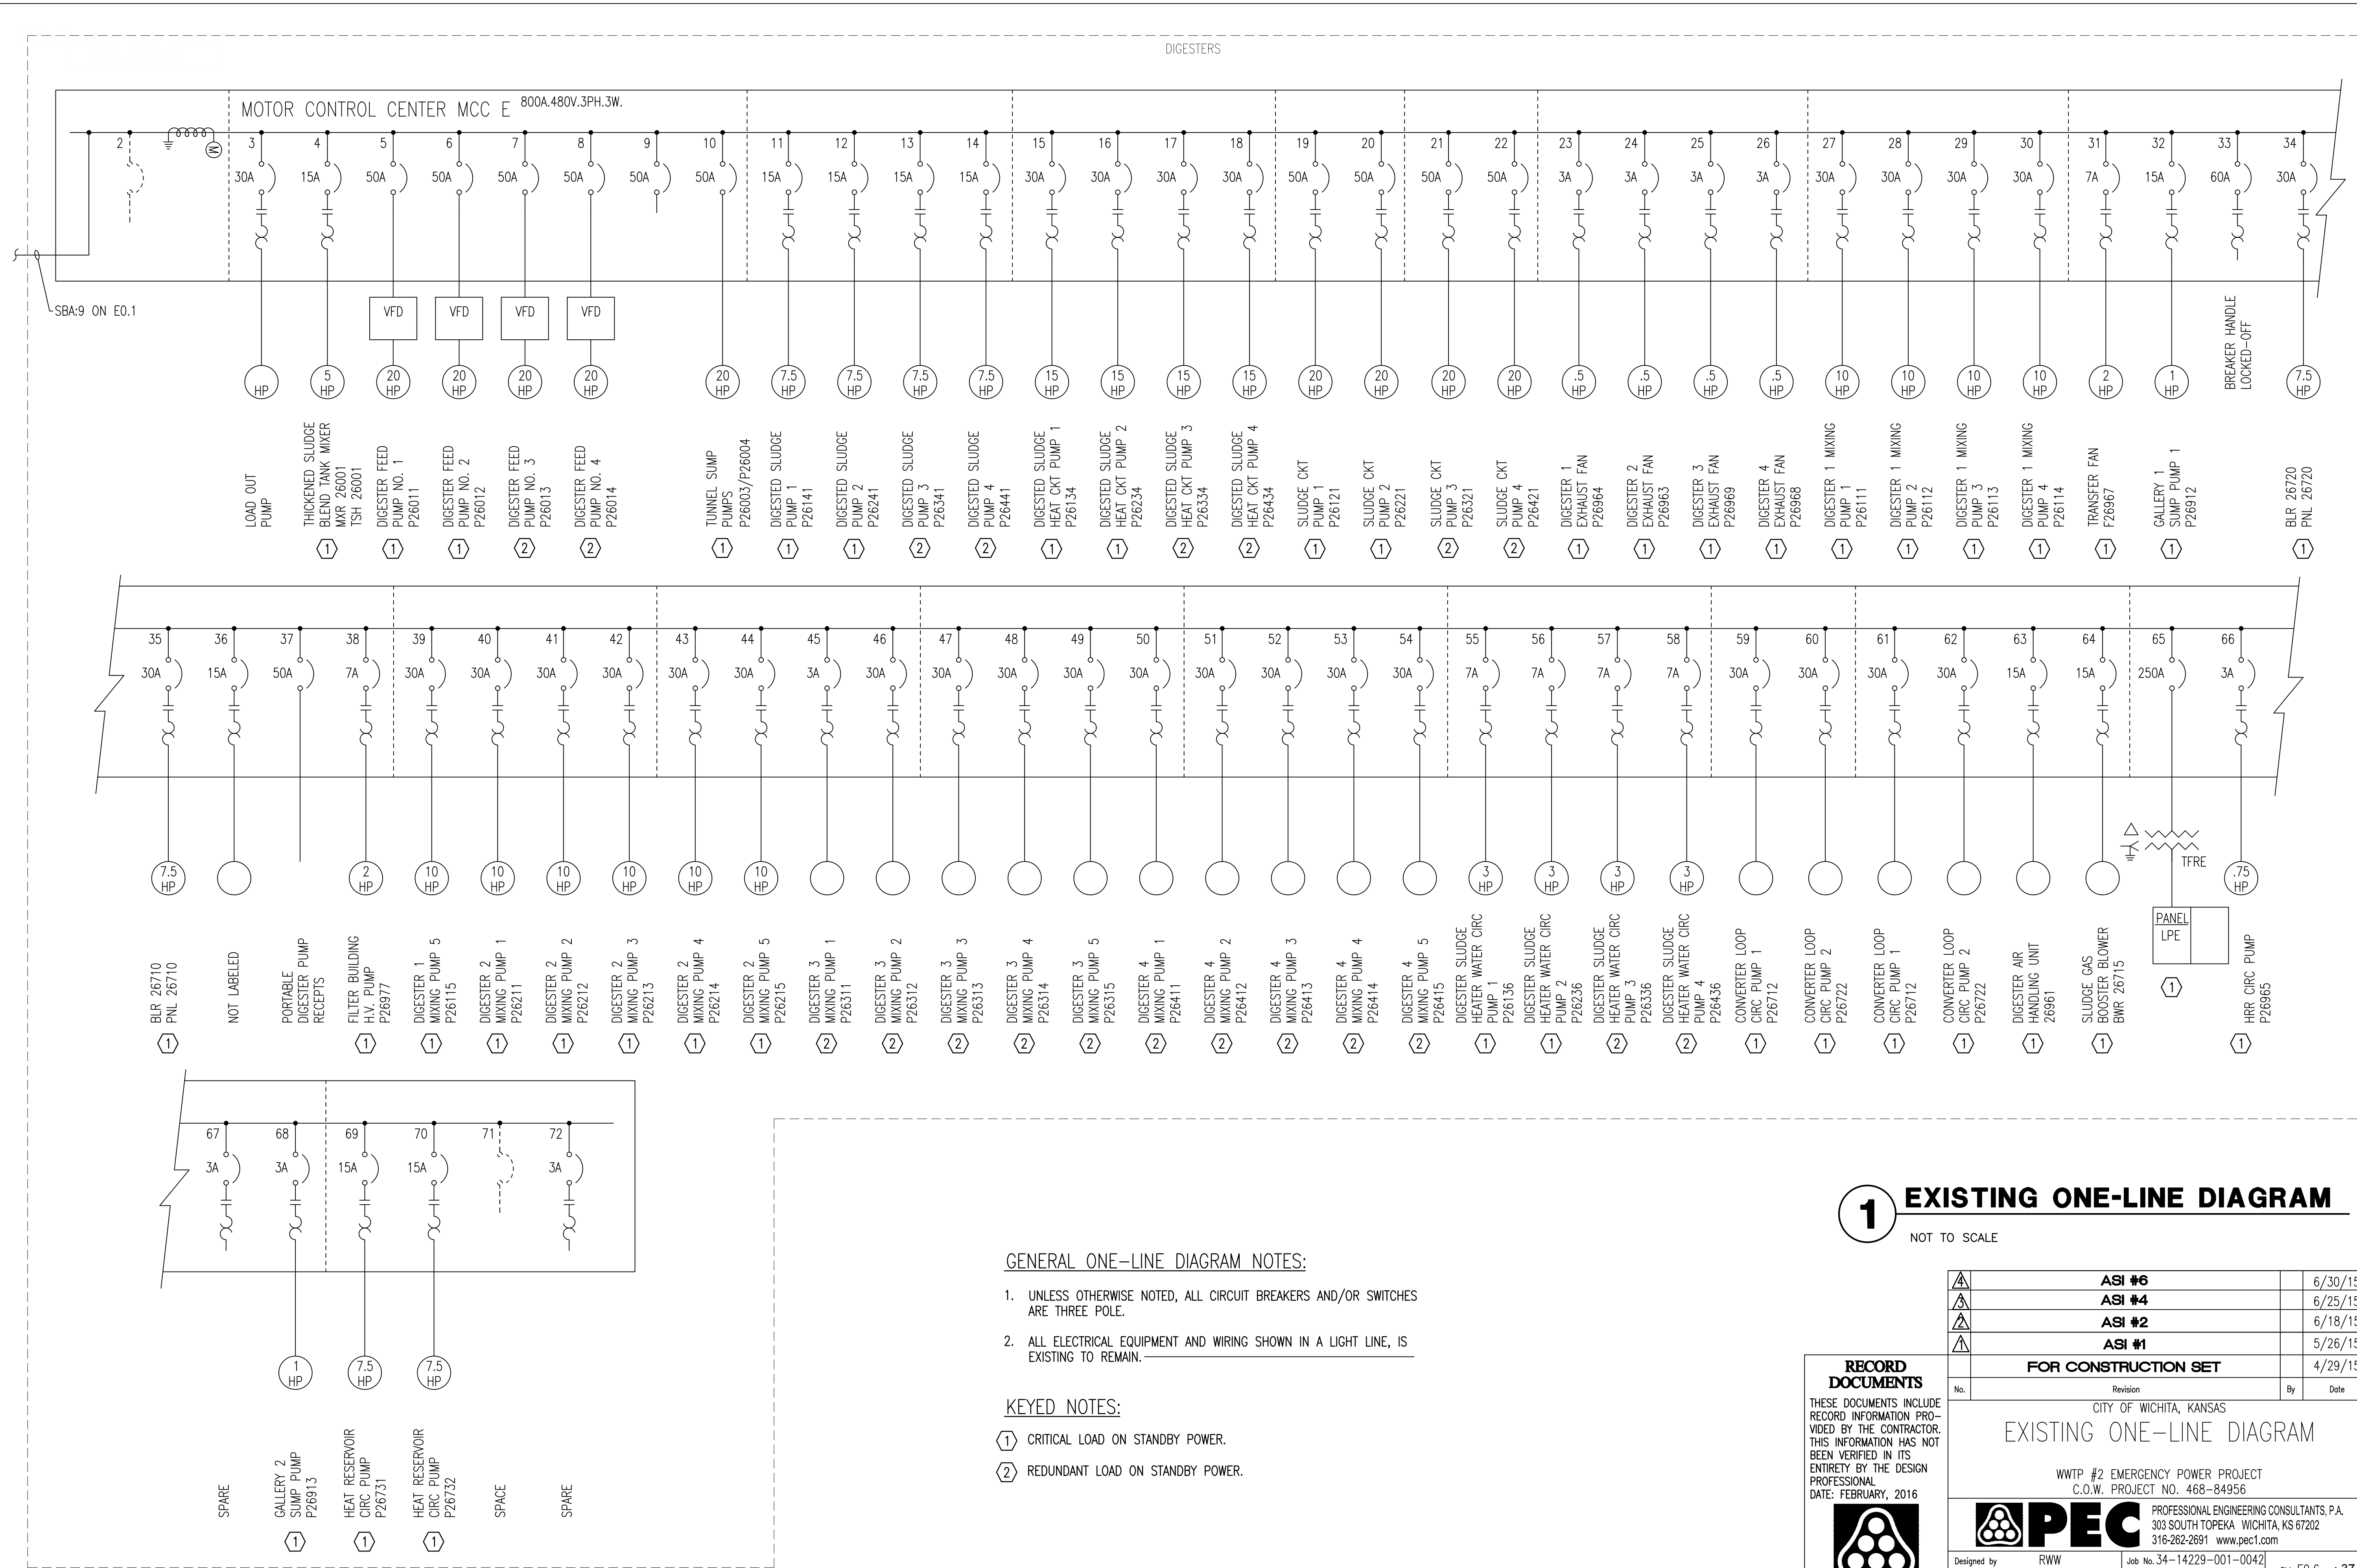

1 EXISTING ONE-LINE DIAGRAM
 NOT TO SCALE

- GENERAL ONE-LINE DIAGRAM NOTES:**
- UNLESS OTHERWISE NOTED, ALL CIRCUIT BREAKERS AND/OR SWITCHES ARE THREE POLE.
 - ALL ELECTRICAL EQUIPMENT AND WIRING SHOWN IN A LIGHT LINE, IS EXISTING TO REMAIN.

- KEYED NOTES:**
- (1) CRITICAL LOAD ON STANDBY POWER.
 - (2) REDUNDANT LOAD ON STANDBY POWER.

▲	ASI #6	6/30/15
▲	ASI #4	6/25/15
▲	ASI #2	6/18/15
▲	ASI #1	5/26/15
FOR CONSTRUCTION SET		
No.	Revision	By Date

RECORD DOCUMENTS
 THESE DOCUMENTS INCLUDE RECORD INFORMATION PROVIDED BY THE CONTRACTOR. THIS INFORMATION HAS NOT BEEN VERIFIED IN ITS ENTIRETY BY THE DESIGN PROFESSIONAL.
 DATE: FEBRUARY, 2016



CITY OF WICHITA, KANSAS

EXISTING ONE-LINE DIAGRAM

WWTP #2 EMERGENCY POWER PROJECT
 C.O.W. PROJECT NO. 468-84956

PEC PROFESSIONAL ENGINEERING CONSULTANTS, P.A.
 303 SOUTH TOPEKA WICHITA, KS 67202
 316-262-2891 www.pec1.com

Designed by	RWW	Job No. 34-14229-001-0042	Sht. E0.6 of 37
Drawn by	CJV	Date 4/29/15	

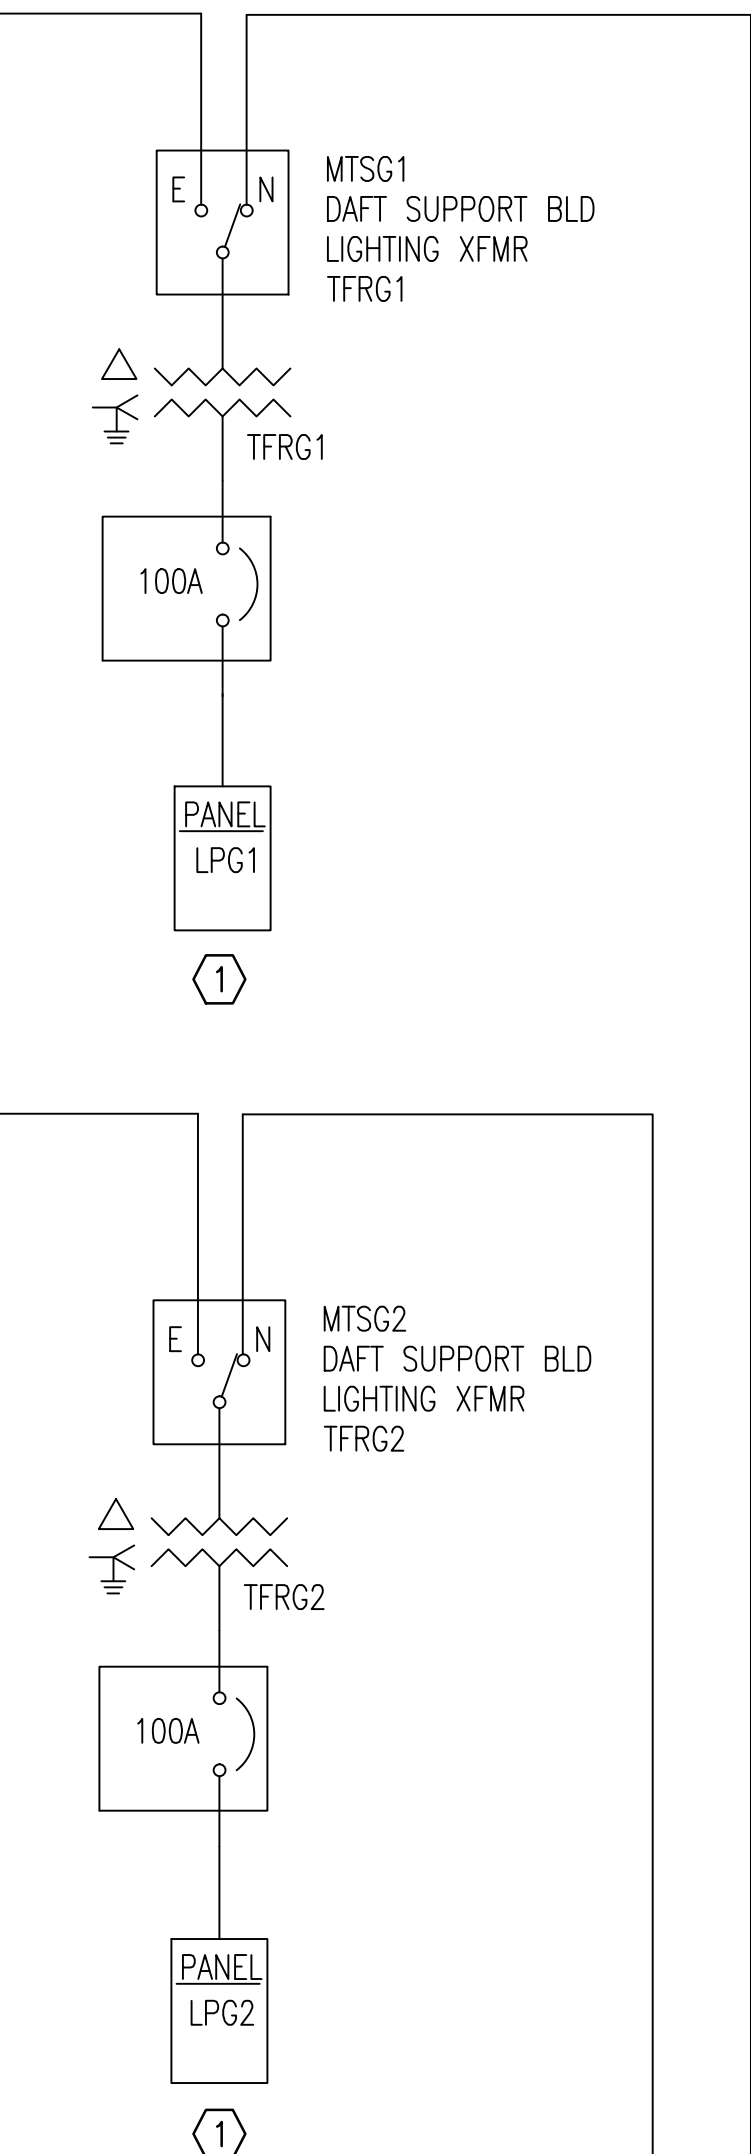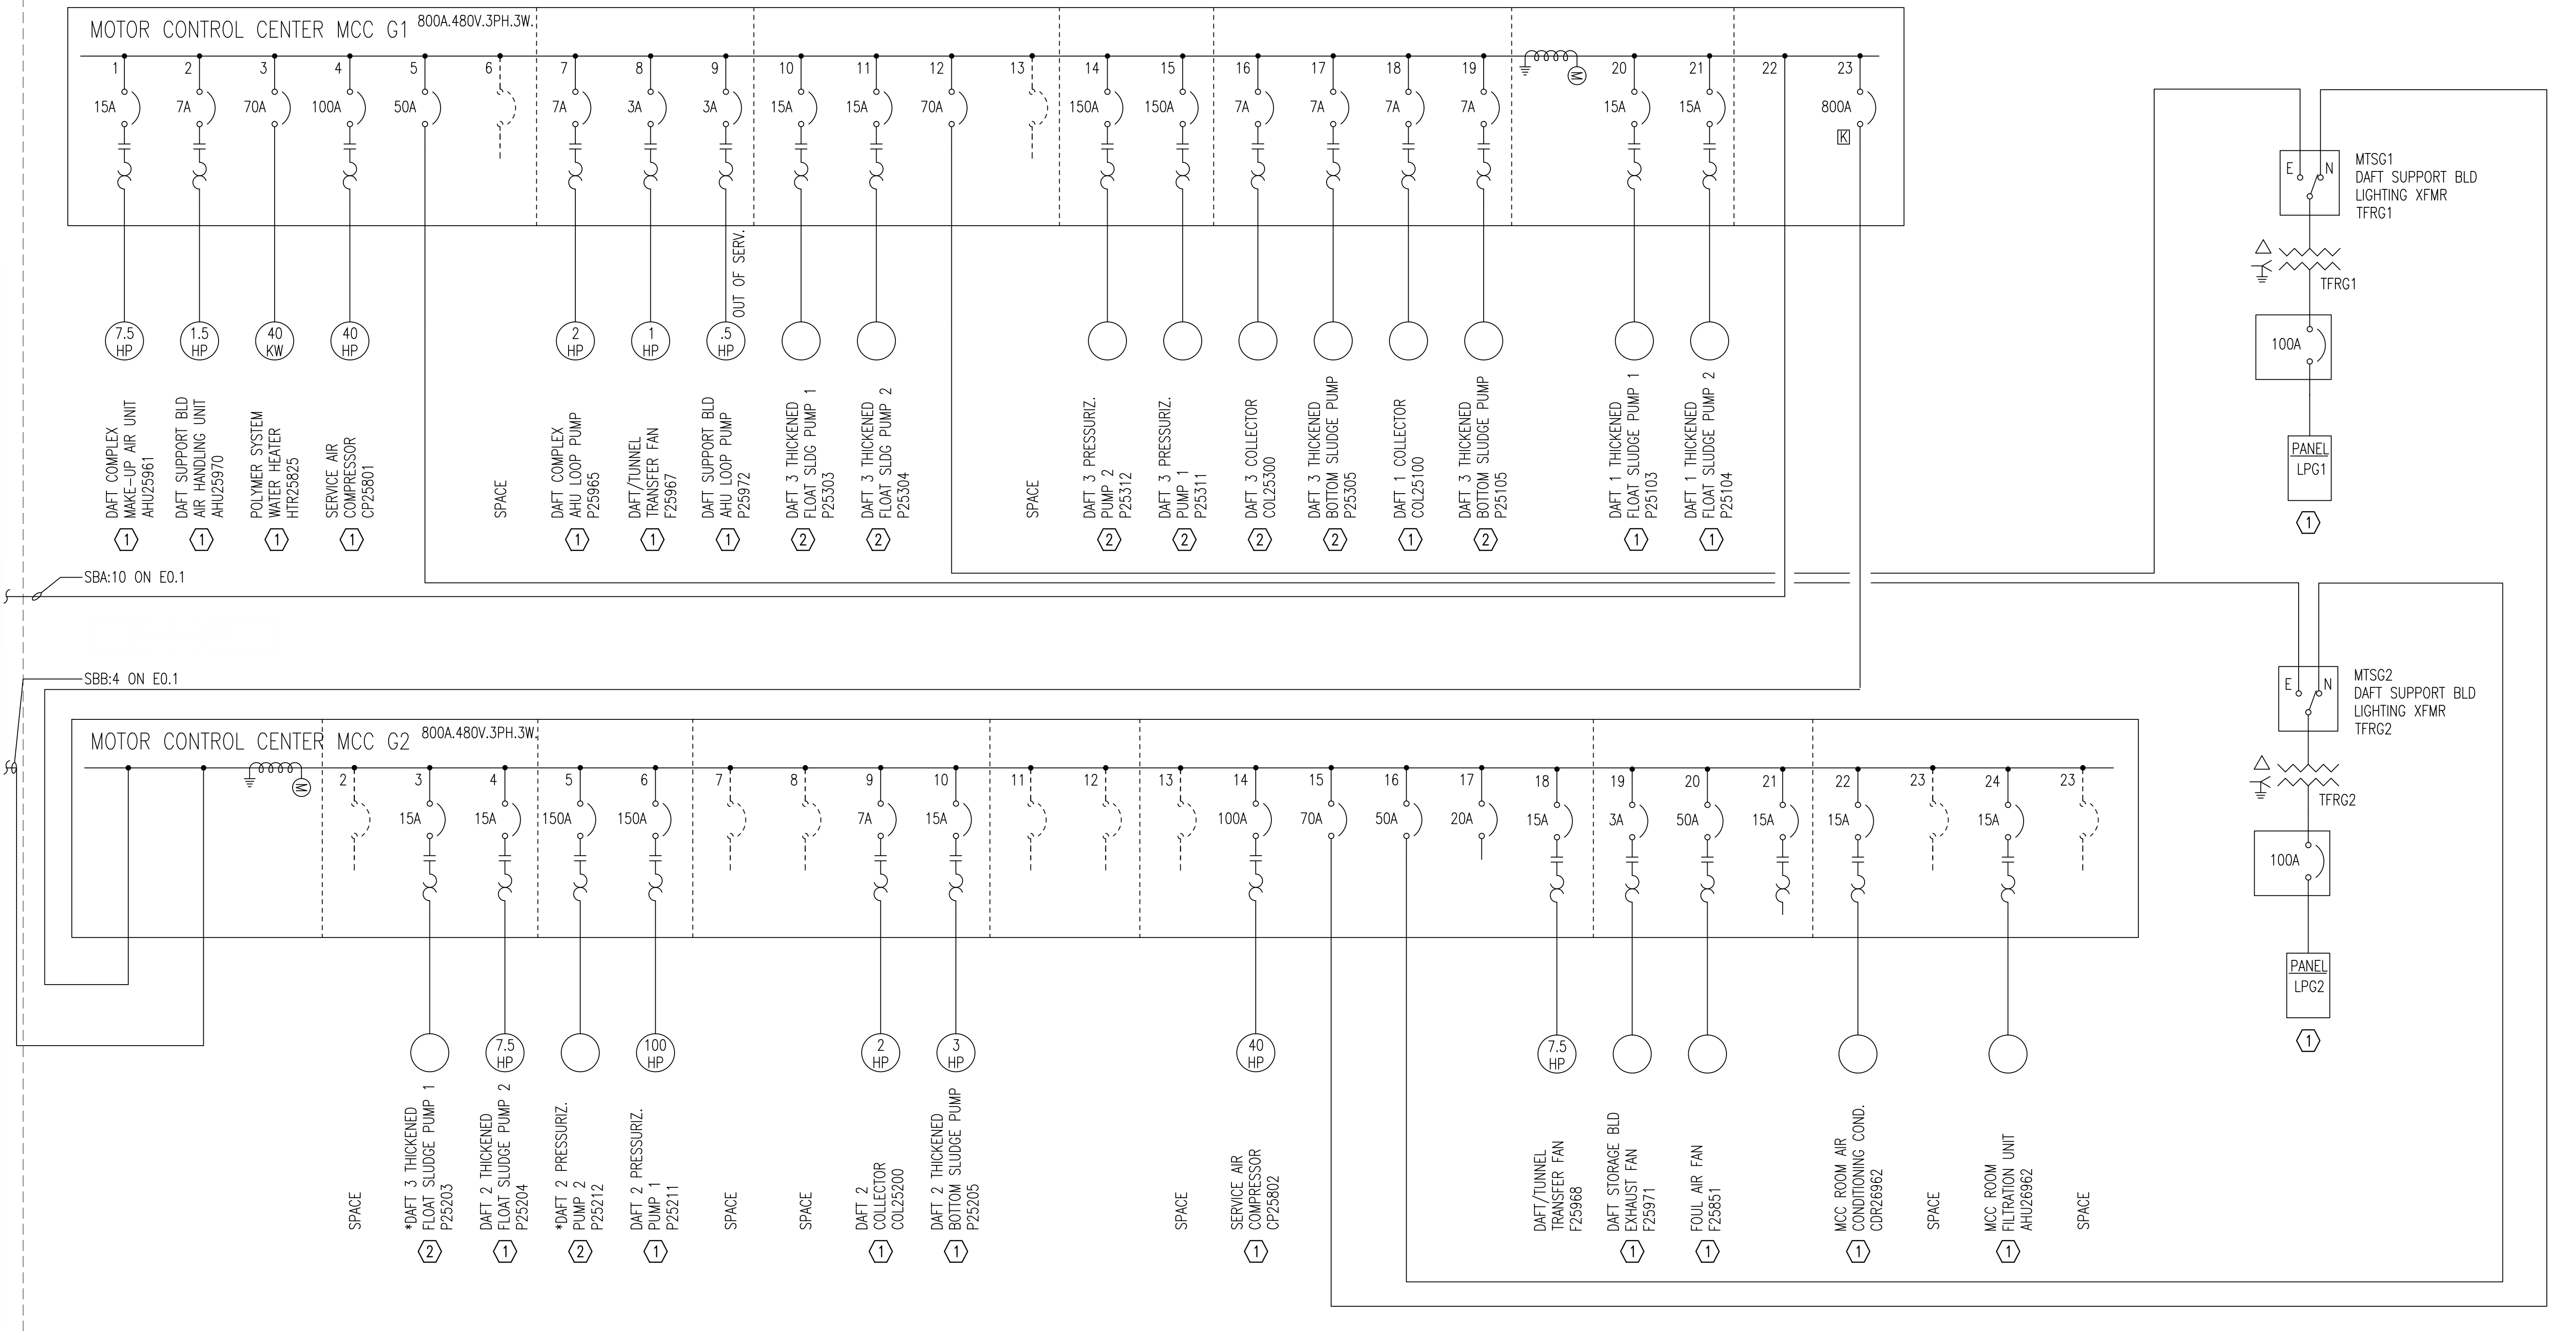

1 EXISTING ONE-LINE DIAGRAM
NOT TO SCALE

GENERAL ONE-LINE DIAGRAM NOTES:

- UNLESS OTHERWISE NOTED, ALL CIRCUIT BREAKERS AND/OR SWITCHES ARE THREE POLE.
- ALL ELECTRICAL EQUIPMENT AND WIRING SHOWN IN A LIGHT LINE, IS EXISTING TO REMAIN.

KEYED NOTES:

- ① CRITICAL LOAD ON STANDBY POWER.
- ② REDUNDANT LOAD ON STANDBY POWER.


Saved: 04-04-2016 1:20:33 PM by CJV
 P:\S\14229-001\14229-001-ED.7
 U:\Wichita-Facility\14229\001\14229-001-ED.7

RECORD DOCUMENTS

THESE DOCUMENTS INCLUDE RECORD INFORMATION PROVIDED BY THE CONTRACTOR. THIS INFORMATION HAS NOT BEEN VERIFIED IN ITS ENTIRETY BY THE DESIGN PROFESSIONAL. DATE: FEBRUARY, 2016

▲	ASI #6	6/30/15
▲	ASI #4	6/25/15
▲	ASI #2	6/18/15
▲	ASI #1	5/26/15
FOR CONSTRUCTION SET		
No.	Revision	By Date
CITY OF WICHITA, KANSAS		
EXISTING ONE-LINE DIAGRAM		
WWTP #2 EMERGENCY POWER PROJECT C.O.W. PROJECT NO. 468-84956		
PROFESSIONAL ENGINEERING CONSULTANTS, P.A. 303 SOUTH TOPEKA WICHITA, KS 67202 316-262-2891 www.pec1.com		
Designed by	RWW	Job No. 34-14229-001-0042
Drawn by	CJV	Date 4/29/15

Saved: 04-04-2016, 1:27:46 PM by CJV
 Project: 14229-001-ED.8
 U:\Wichita-Facility\2014\14229\001\Elec\Drawings\AS-Builds\14229-001-ED.8

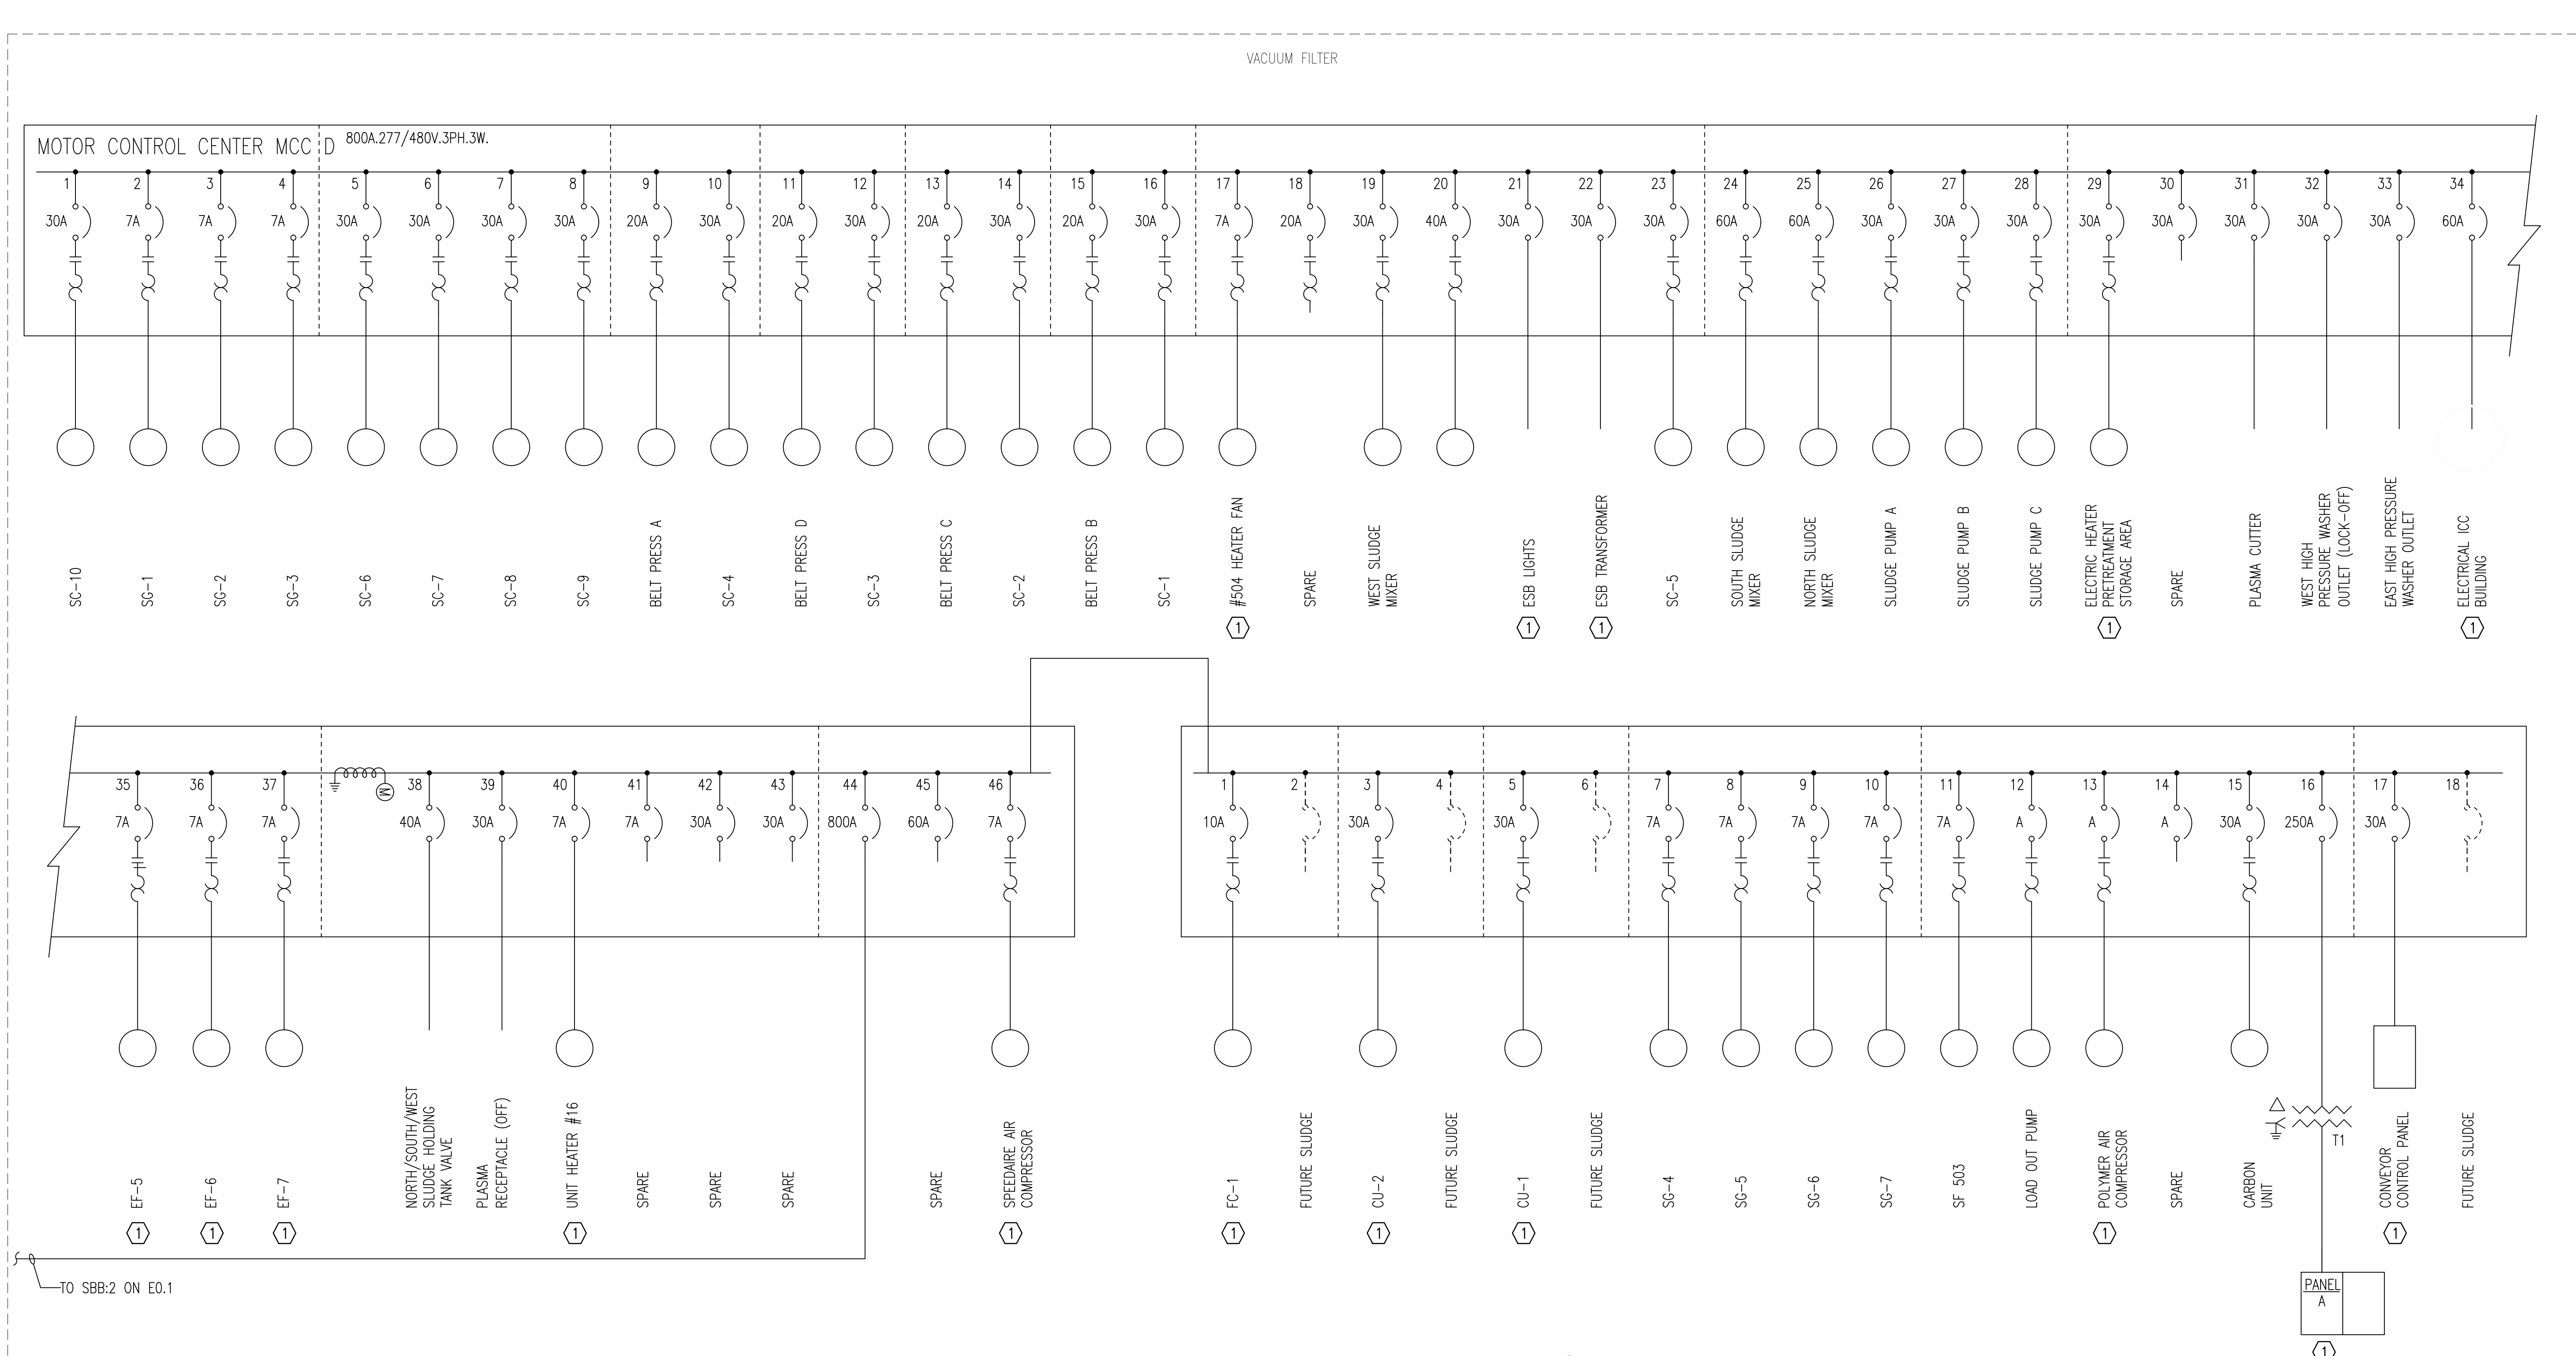


1 EXISTING ONE-LINE DIAGRAM
NOT TO SCALE

- GENERAL ONE-LINE DIAGRAM NOTES:**
- UNLESS OTHERWISE NOTED, ALL CIRCUIT BREAKERS AND/OR SWITCHES ARE THREE POLE.
 - ALL ELECTRICAL EQUIPMENT AND WIRING SHOWN IN A LIGHT LINE, IS EXISTING TO REMAIN.

- KEYED NOTES:**
- ① CRITICAL LOAD ON STANDBY POWER.

▲	ASI #6	6/30/15
▲	ASI #4	6/25/15
▲	ASI #2	6/18/15
▲	ASI #1	5/26/15
FOR CONSTRUCTION SET		4/29/15


RECORD DOCUMENTS
 THESE DOCUMENTS INCLUDE RECORD INFORMATION PROVIDED BY THE CONTRACTOR. THIS INFORMATION HAS NOT BEEN VERIFIED IN ITS ENTIRETY BY THE DESIGN PROFESSIONAL.
 DATE: FEBRUARY, 2016

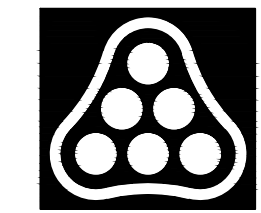

PEC PROFESSIONAL ENGINEERING CONSULTANTS, P.A.
 303 SOUTH TOPEKA WICHITA, KS 67202
 316-262-2891 www.pec1.com

CITY OF WICHITA, KANSAS	
EXISTING ONE-LINE DIAGRAM	
WWTP #2 EMERGENCY POWER PROJECT C.O.W. PROJECT NO. 468-84956	
Designed by	RWW
Drawn by	CJV
Job No.	34-14229-001-0042
Date	4/29/15
Sht. E0.8 of 37	


TO PARALLELING SWITCHGEAR. SEE SHEET E0.13 FOR CONTINUATION.

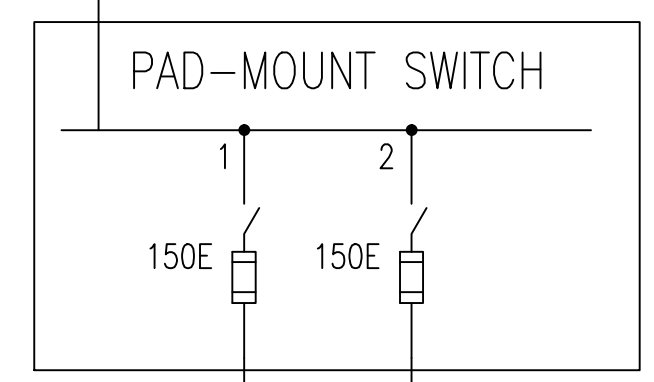

TO PAD MOUNTED SWITCH ON E0.1
TO T-SBB ON E0.1

- GENERAL ONE-LINE DIAGRAM NOTES:**
- UNLESS OTHERWISE NOTED, ALL CIRCUIT BREAKERS AND/OR SWITCHES ARE THREE POLE.
 - ALL ELECTRICAL EQUIPMENT AND WIRING SHOWN IN A LIGHT LINE, IS EXISTING TO REMAIN.

- KEYED NOTES:**
- CRITICAL LOAD ON STANDBY POWER.

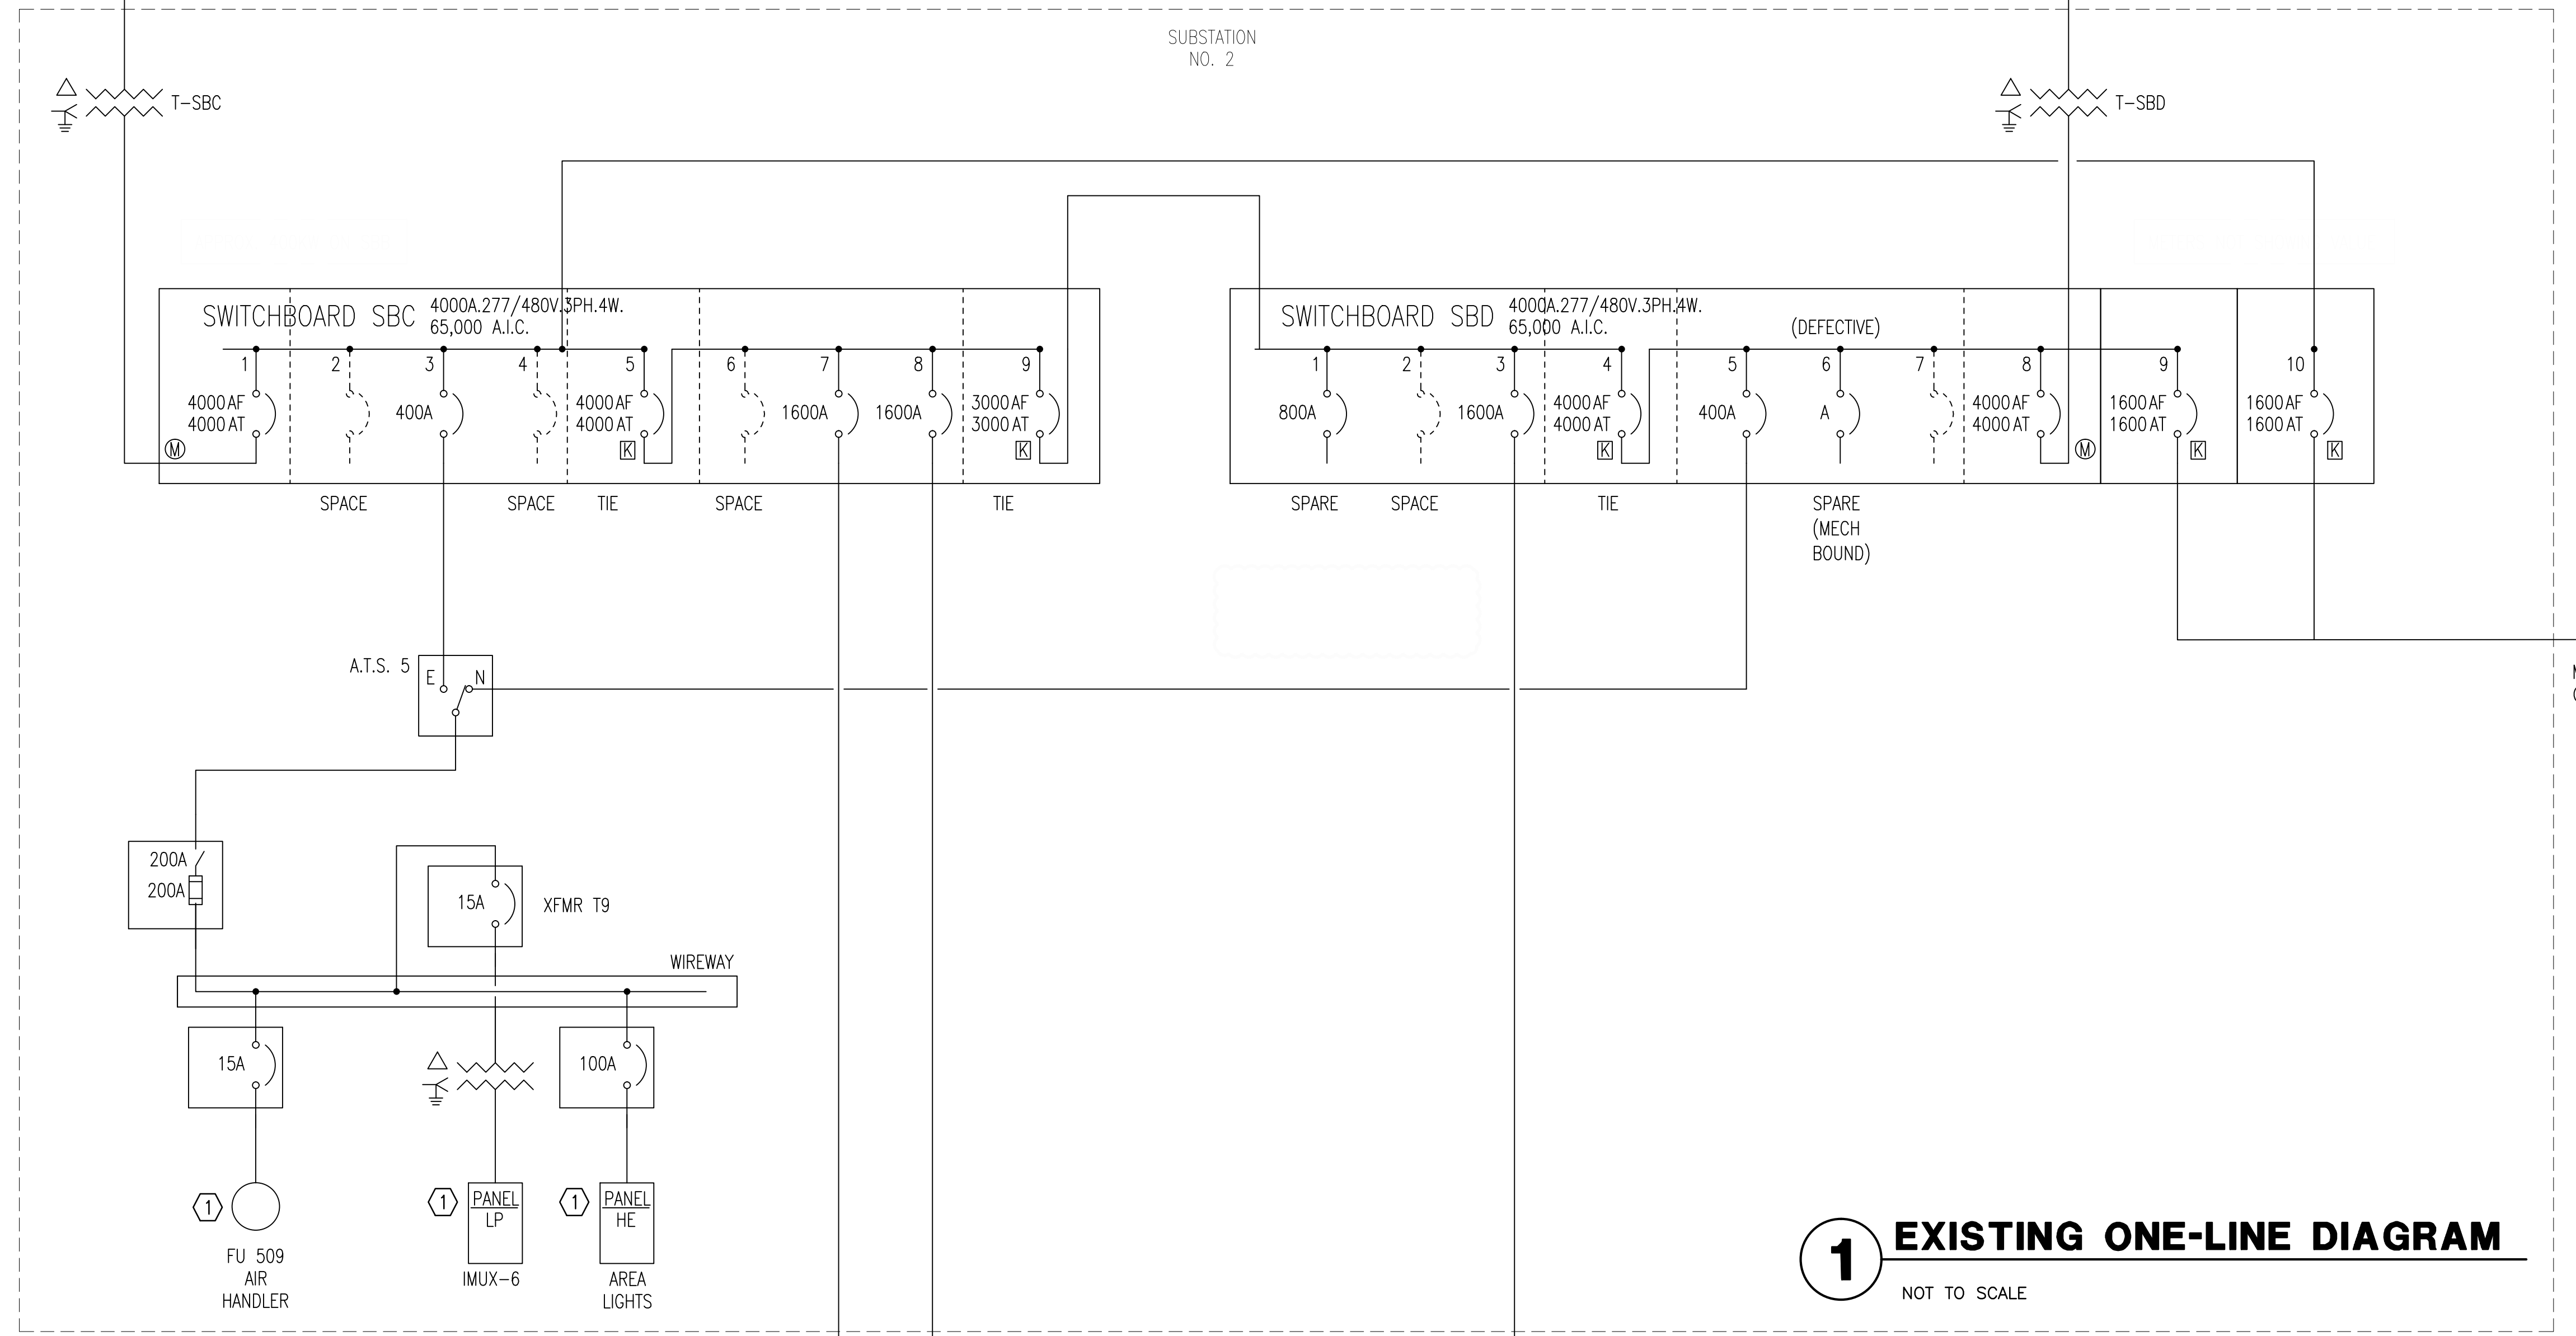


1 EXISTING ONE-LINE DIAGRAM
NOT TO SCALE

Saved: 04-04-2016 1:27:51 PM by CJV
 Project: 14229-001-ED.9
 U:\Wichita-Facility\2014\14229\001\Elec\Drawings\As-Built\14229-001-ED.9

▲	ASI #6	6/30/15
▲	ASI #4	6/25/15
▲	ASI #2	6/18/15
▲	ASI #1	5/26/15
FOR CONSTRUCTION SET		4/29/15

RECORD DOCUMENTS
 THESE DOCUMENTS INCLUDE RECORD INFORMATION PROVIDED BY THE CONTRACTOR. THIS INFORMATION HAS NOT BEEN VERIFIED IN ITS ENTIRETY BY THE DESIGN PROFESSIONAL.
 DATE: FEBRUARY, 2016

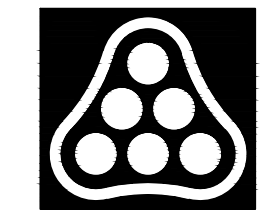

CITY OF WICHITA, KANSAS		
EXISTING ONE-LINE DIAGRAM		
WWTP #2 EMERGENCY POWER PROJECT C.O.W. PROJECT NO. 468-84956		
PEC PROFESSIONAL ENGINEERING CONSULTANTS, P.A. 303 SOUTH TOPEKA WICHITA, KS 67202 316-262-2891 www.pec1.com		
Designed by	RWW	Job No. 34-14229-001-0042
Drawn by	CJV	Date 4/29/15
		Sht. E0.9 of 37


GENERAL ONE-LINE DIAGRAM NOTES:

1. UNLESS OTHERWISE NOTED, ALL CIRCUIT BREAKERS AND/OR SWITCHES ARE THREE POLE.
2. ALL ELECTRICAL EQUIPMENT AND WIRING SHOWN IN A LIGHT LINE, IS EXISTING TO REMAIN.

KEYED NOTES:

- ① CRITICAL LOAD ON STANDBY POWER.

TO SBD:9/SDB:10 ON E0.9

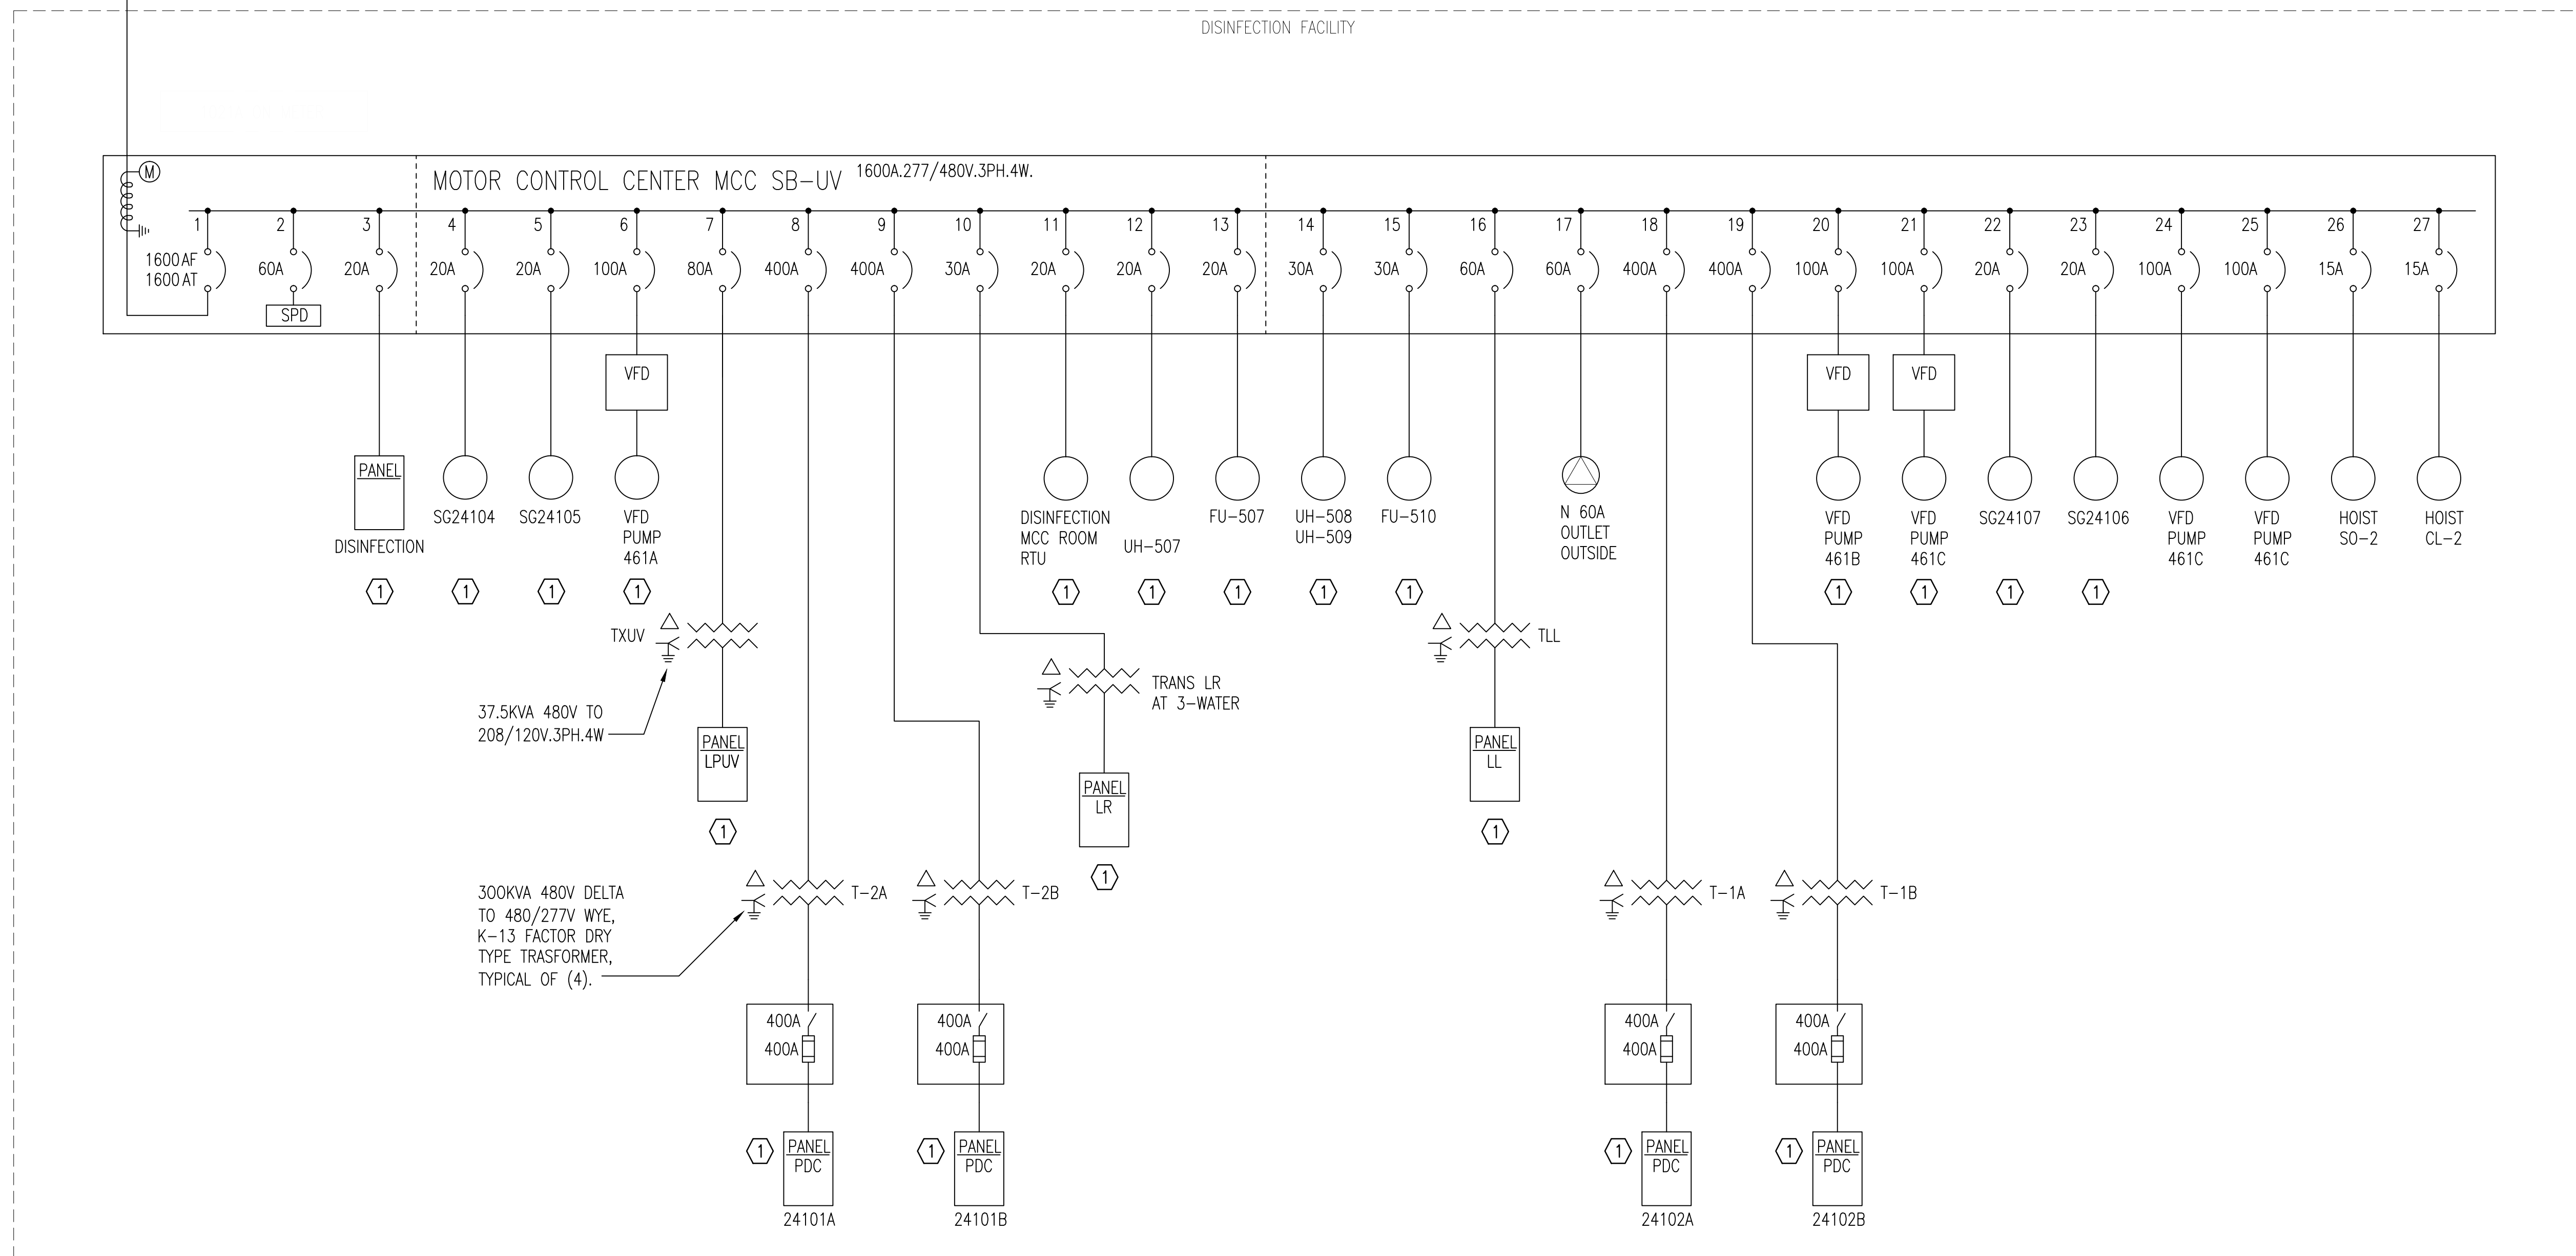

1 EXISTING ONE-LINE DIAGRAM
NOT TO SCALE

▲	ASI #6	6/30/15
▲	ASI #4	6/25/15
▲	ASI #2	6/18/15
▲	ASI #1	5/26/15
FOR CONSTRUCTION SET		4/29/15

RECORD DOCUMENTS
THESE DOCUMENTS INCLUDE RECORD INFORMATION PROVIDED BY THE CONTRACTOR. THIS INFORMATION HAS NOT BEEN VERIFIED IN ITS ENTIRETY BY THE DESIGN PROFESSIONAL.
DATE: FEBRUARY, 2016


CITY OF WICHITA, KANSAS
EXISTING ONE-LINE DIAGRAM
WWTP #2 EMERGENCY POWER PROJECT
C.O.W. PROJECT NO. 468-84956

PEC PROFESSIONAL ENGINEERING CONSULTANTS, P.A.
303 SOUTH TOPEKA WICHITA, KS 67202
316-262-2891 www.pec1.com

Designed by	RWW	Job No. 34-14229-001-0042	Sht.E0.10 of 37
Drawn by	CJV	Date 4/29/15	

Saved: 04-04-2016 1:20:31 PM by: CJV
 Project: 34-14229-001-0042
 U:\Wichita-Facilities\14229\001\Elec\Drawings\As-Built\14229-001-ED.10

Saved: 04-04-2016, 1:20:01 PM by: CJV
 Plot Size: 11.70 x 17.00 (inches) 1:20/20
 U:\Wichita-Fossil\2014\14229\001\Elec\Drawings\AS-Builds\14229-001-ED.11

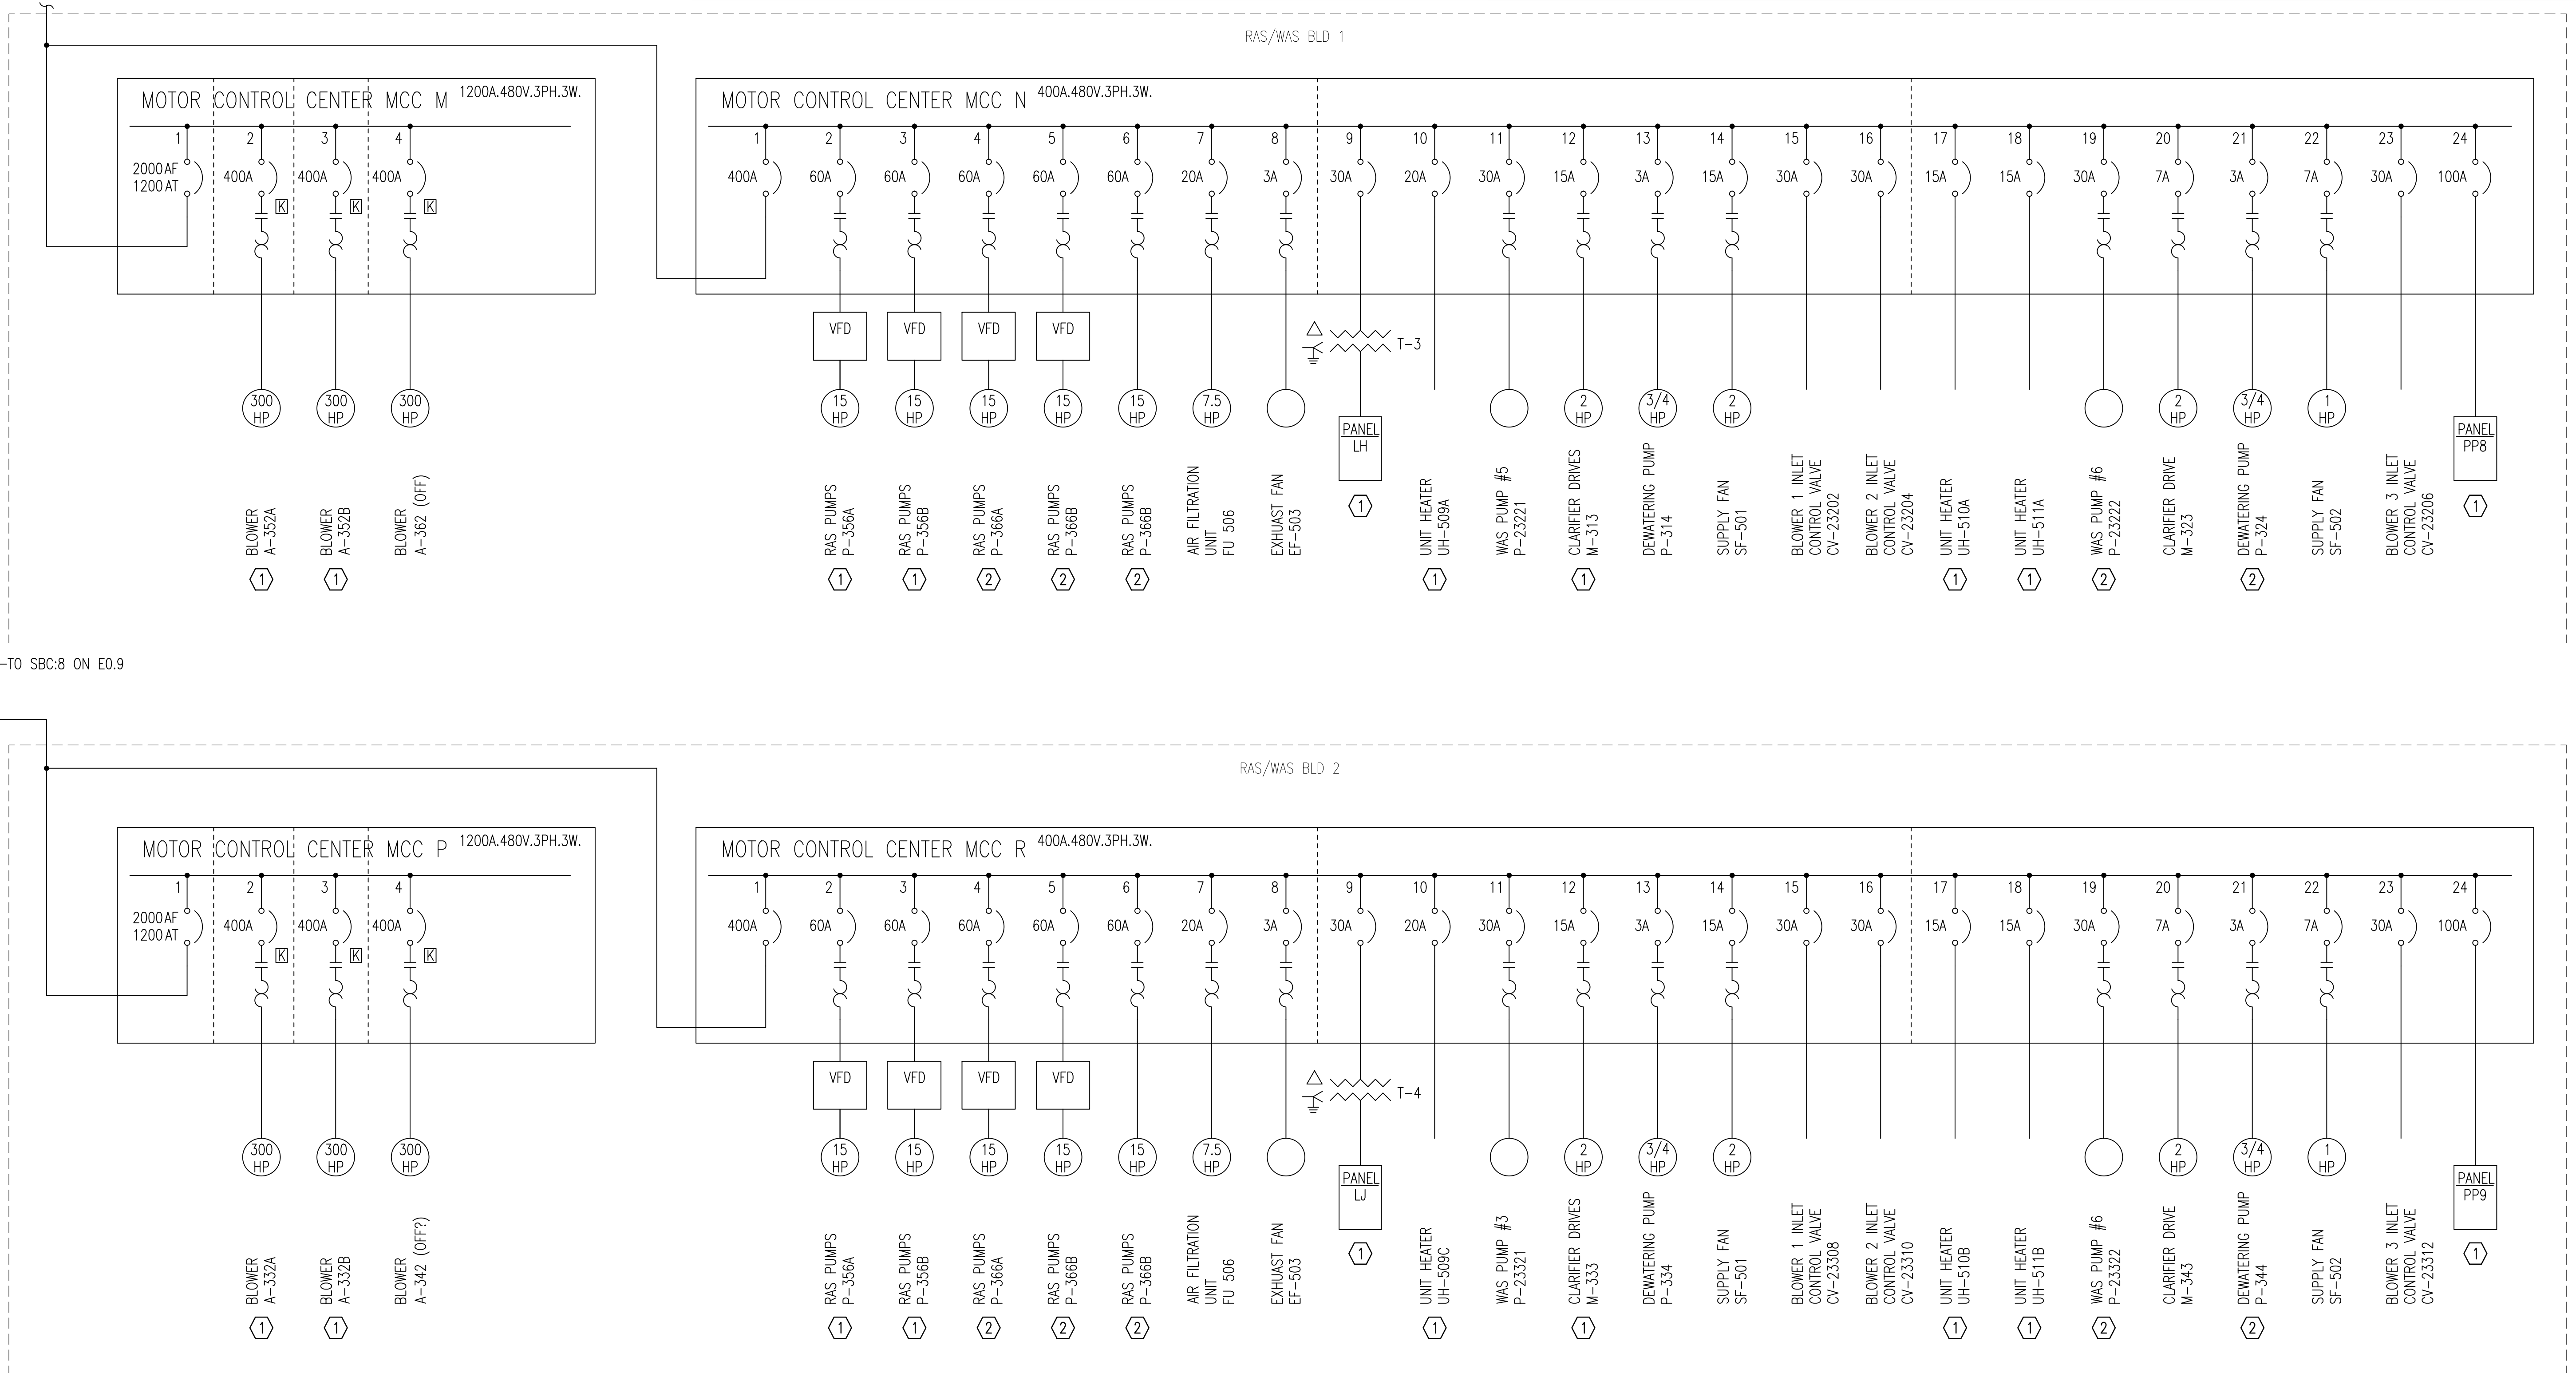

GENERAL ONE-LINE DIAGRAM NOTES:

- UNLESS OTHERWISE NOTED, ALL CIRCUIT BREAKERS AND/OR SWITCHES ARE THREE POLE.
- ALL ELECTRICAL EQUIPMENT AND WIRING SHOWN IN A LIGHT LINE, IS EXISTING TO REMAIN.

KEYED NOTES:


- ① CRITICAL LOAD ON STANDBY POWER.
- ② REDUNDANT LOAD ON STANDBY POWER.

1 EXISTING ONE-LINE DIAGRAM

NOT TO SCALE

▲	ASI #6	6/30/15
▲	ASI #4	6/25/15
▲	ASI #2	6/18/15
▲	ASI #1	5/26/15
FOR CONSTRUCTION SET		4/29/15

RECORD DOCUMENTS
 THESE DOCUMENTS INCLUDE RECORD INFORMATION PROVIDED BY THE CONTRACTOR. THIS INFORMATION HAS NOT BEEN VERIFIED IN ITS ENTIRETY BY THE DESIGN PROFESSIONAL.
 DATE: FEBRUARY, 2016

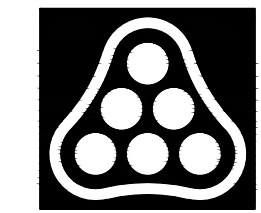



No.	Revision	By	Date
CITY OF WICHITA, KANSAS			
EXISTING ONE-LINE DIAGRAM			
WWT# #2 EMERGENCY POWER PROJECT C.O.W. PROJECT NO. 468-84956			
PEC PROFESSIONAL ENGINEERING CONSULTANTS, P.A. 303 SOUTH TOPEKA WICHITA, KS 67202 316-262-2891 www.pec1.com			
Designed by	RWW	Job No. 34-14229-001-0042	Sht. E0.11 of 37
Drawn by	CJV	Date 4/29/15	

TO SBD:3 ON E0.9

RAS/WAS BLD 3

MOTOR CONTROL CENTER MCC S 1200A.480V.3PH.3W.

MOTOR CONTROL CENTER MCC T 400A.480V.3PH.3W.

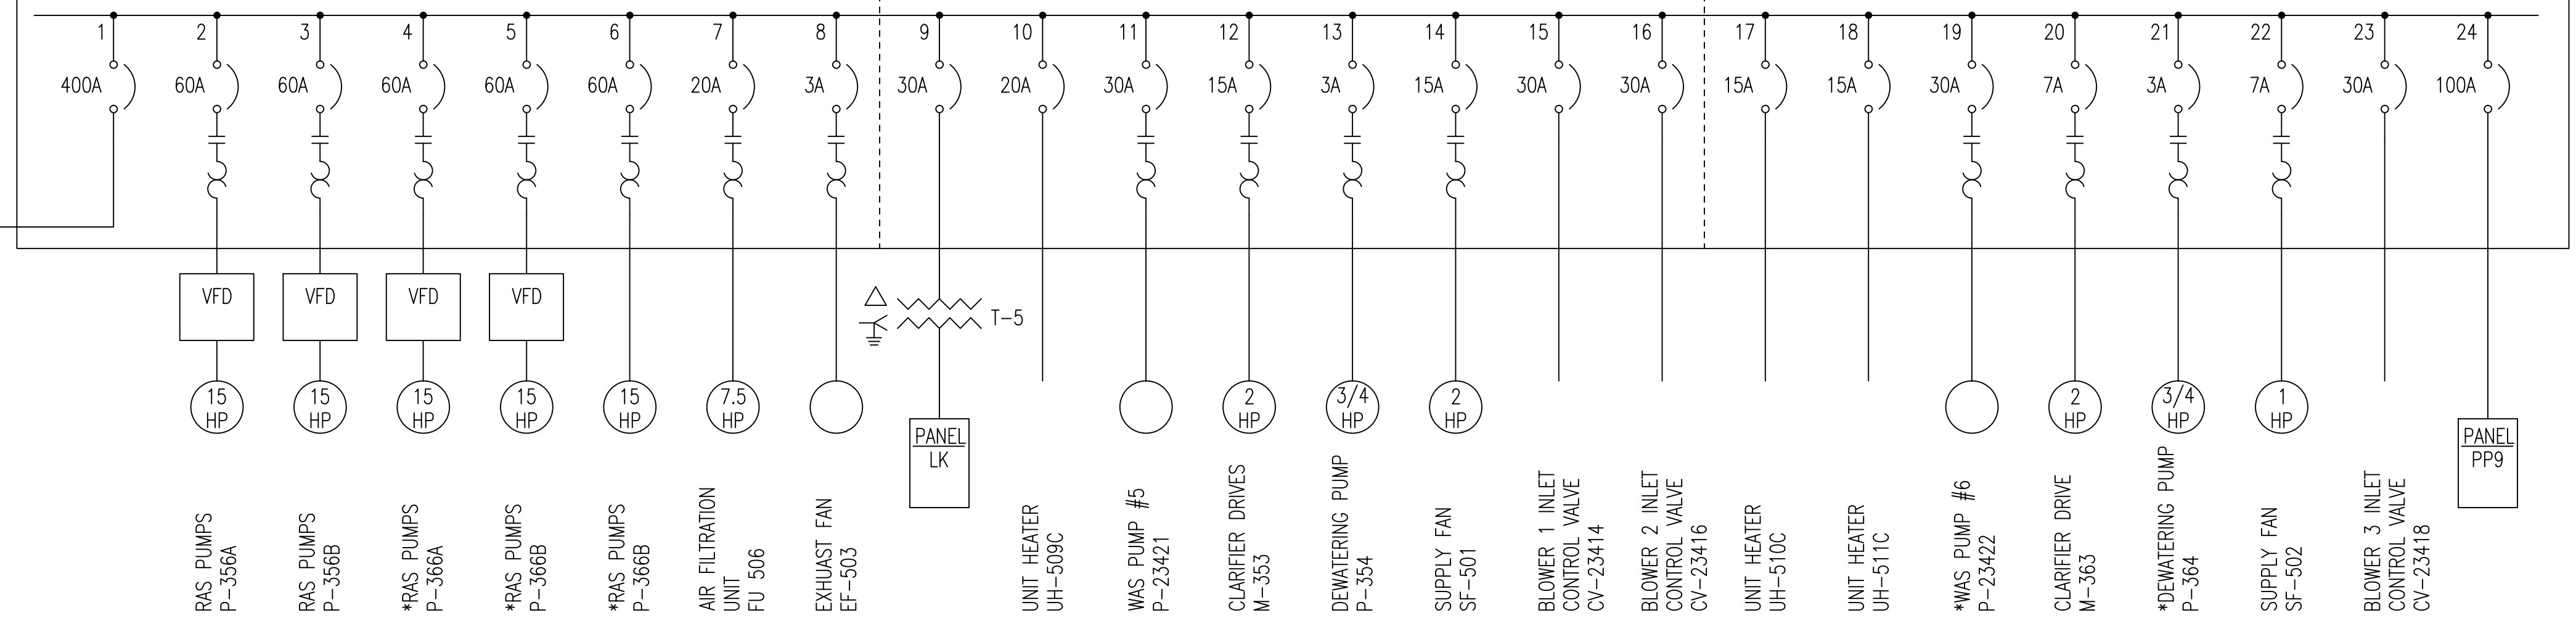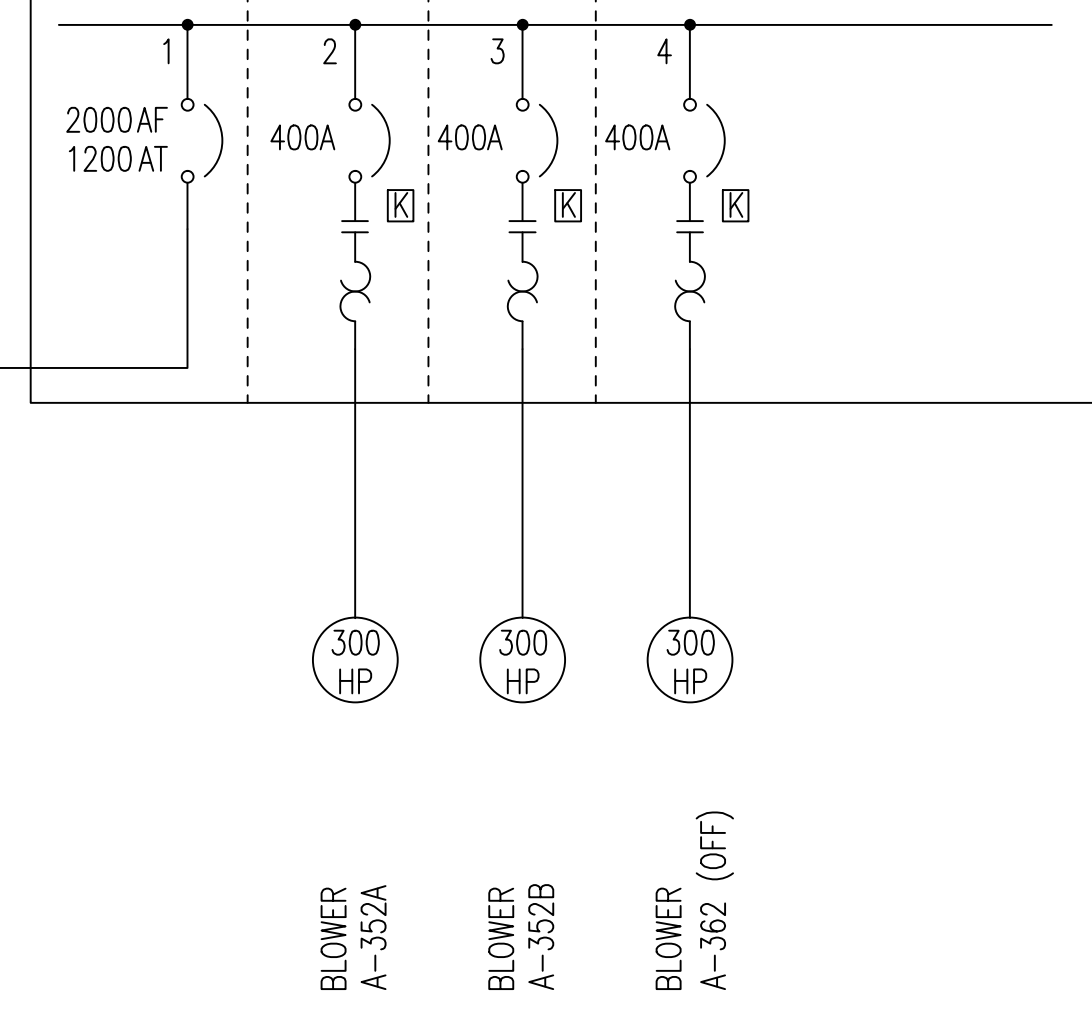

GENERAL ONE-LINE DIAGRAM NOTES:

1. UNLESS OTHERWISE NOTED, ALL CIRCUIT BREAKERS AND/OR SWITCHES ARE THREE POLE.
2. ALL ELECTRICAL EQUIPMENT AND WIRING SHOWN IN A LIGHT LINE, IS EXISTING TO REMAIN.

1 EXISTING ONE-LINE DIAGRAM


NOT TO SCALE

▲	ASI #6	6/30/15
▲	ASI #4	6/25/15
▲	ASI #2	6/18/15
▲	ASI #1	5/26/15
FOR CONSTRUCTION SET		4/29/15

RECORD DOCUMENTS
 THESE DOCUMENTS INCLUDE RECORD INFORMATION PROVIDED BY THE CONTRACTOR. THIS INFORMATION HAS NOT BEEN VERIFIED IN ITS ENTIRETY BY THE DESIGN PROFESSIONAL.
 DATE: FEBRUARY, 2016

No.	Revision	By	Date
CITY OF WICHITA, KANSAS			
EXISTING ONE-LINE DIAGRAM			
WWTP #2 EMERGENCY POWER PROJECT C.O.W. PROJECT NO. 468-84956			
PROFESSIONAL ENGINEERING CONSULTANTS, P.A. 303 SOUTH TOPEKA WICHITA, KS 67202 316-262-2891 www.pec1.com			
Designed by	RWW	Job No. 34-14229-001-0042	Sht.E0.12 of 37
Drawn by	CJV	Date 4/29/15	

PARALLELING MAIN SWITCHGEAR 'PMSG'
12470V, 3ø 3W, 2000A, 95KV BIL, 50KA/1000MVA RMS SYM BRACING

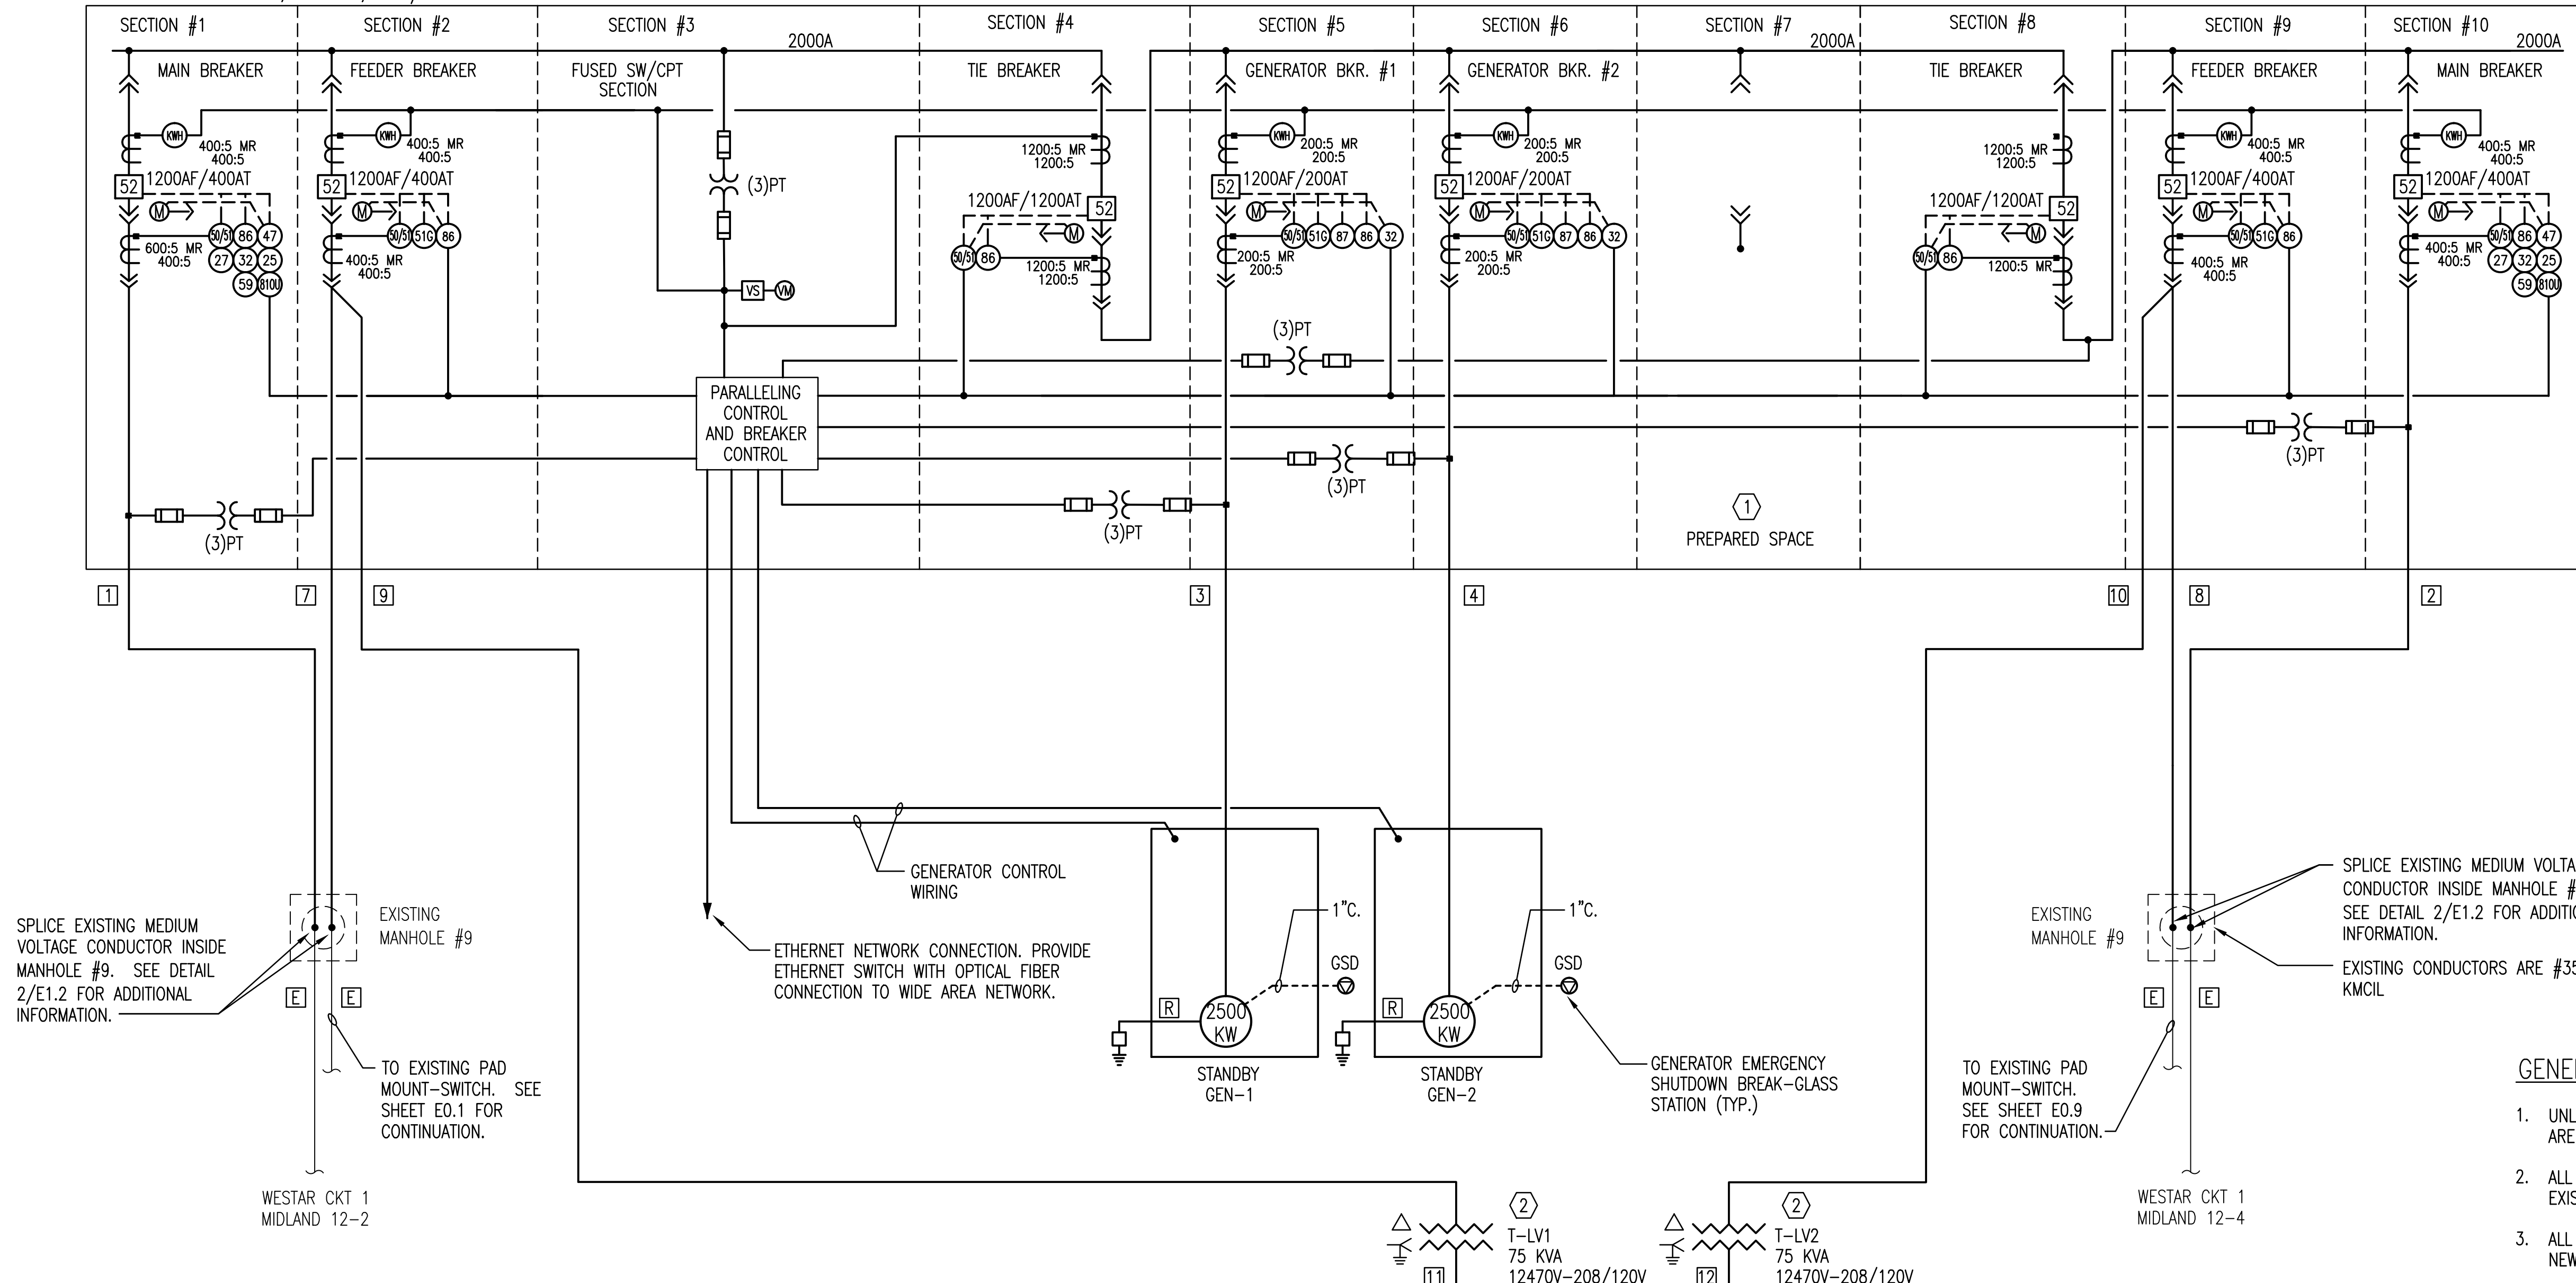

ANSI SYMBOLS LEGEND

- (25) SYNCHRONIZATION CHECK
- (27) UNDERVOLTAGE
- (32) REVERSE POWER
- (47) UNBALANCE-VOLTAGE PROTECTION AND/OR PHASE SEQUENCE MONITORING
- (50) DEFINITE-TIME PHASE OVERCURRENT PROTECTION
- (51) INVERSE PHASE OVERCURRENT PROTECTION
- (59) OVERVOLTAGE
- (810U) OVER/UNDER FREQUENCY
- (86) LOCKOUT
- (87) DIFFERENTIAL RELAY

GENERAL ONE-LINE DIAGRAM NOTES:

1. UNLESS OTHERWISE NOTED, ALL CIRCUIT BREAKERS AND/OR SWITCHES ARE THREE POLE.
2. ALL ELECTRICAL EQUIPMENT AND WIRING SHOWN IN A LIGHT LINE, IS EXISTING TO REMAIN.
3. ALL ELECTRICAL EQUIPMENT AND WIRING SHOWN IN A DARK LINE, IS NEW WORK UNDER THIS CONTRACT.

KEYED NOTES:

- (1) PROVIDE QUOTE AS OPTIONAL ADDER TO PROVIDE 3RD GENERATOR CIRCUIT BREAKER AND RELAYS EQUIVALENT TO GENERATOR BREAKER #1 AND #2.
- (2) PROVIDE WITH PRIMARY FUSES.
- (3) CONTINUOUS RATED LOW RESISTANCE GROUNDING RESISTOR TO PROTECT THE GENERATOR DURING A SINGLE PHASE GROUND FAULT.

FEEDER SCHEDULE

DESIG.	EQUIPMENT SERVED	CONDUCTORS			GROUND SIZE PER SET	CONDUIT SIZE PER SET
		SETS	NO.	SIZE		
(1)(2)	[1] MAIN SWITCHGEAR PMSG	1	3	#350 KMCIL CU MV-105	#3	5"
(1)(2)	[2] MAIN SWITCHGEAR PMSG	1	3	#350 KMCIL CU MV-105	#3	5"
(1)(2)	[3] STANDBY GEN-1	1	3	#2/0 AWG CU MV-105	#6	5"
(1)(2)	[4] STANDBY GEN-2	1	3	#2/0 AWG CU MV-105	#6	5"
	[5] NOT USED	-	-	-	-	-
	[6] NOT USED	-	-	-	-	-
(1)(2)	[7] EXISTING MANHOLE #9	1	3	#350 KMCIL CU MV-105	#1	5"
(1)(2)	[8] EXISTING MANHOLE #9	1	3	#350 KMCIL CU MV-105	#1	5"
(1)(3)	[9] TRANSFORMER T-LV1	1	3	#2 AWG CU MV-105	#8	4"
(1)(3)	[10] TRANSFORMER T-LV2	1	3	#2 AWG CU MV-105	#8	4"
	[11] ATS-LV	1	4	#250 KCMIL CU	#2	3"
	[12] ATS-LV	1	4	#250 KCMIL CU	#2	3"
	[13] PANEL PG-LV	1	4	#250 KCMIL CU	#2	3"
	[E] EXISTING TO REMAIN	-	-	-	-	-
(1)	[R] GENERATOR RESISTOR	1	1	#2/0 KCMIL CU MV-105	-	4"

TRANSFORMER SCHEDULE

TRANSF. DESIG.	KVA RATING	PRIMARY VOLTAGE			SECONDARY VOLTAGE			OIL FILLED PAD MOUNTED	DRY TYPE	PRIMARY FEEDER (SEE FEEDER SCHEDULE)	SECONDARY FEEDER (SEE FEEDER SCHEDULE)	GROUND WIRE TO NEAREST GROUNDING SOURCE PER NEC SECTION 250.30(A)(7)	REMARKS
		480 3ø, 3W.	12470 3ø, 4W.	7200 1ø, 2W.	120/208 3ø, 4W.	277/480 3ø, 4W.							
T-LV1	75		●		●		●		[9]	[11]	#2		
T-LV2	75		●		●		●		[10]	[12]	#2		

RECORD DOCUMENTS

THESE DOCUMENTS INCLUDE RECORD INFORMATION PROVIDED BY THE CONTRACTOR. THIS INFORMATION HAS NOT BEEN VERIFIED IN ITS ENTIRETY BY THE DESIGN PROFESSIONAL. DATE: FEBRUARY, 2016


Revision	By	Date
ASI #6		6/30/15
ASI #4		6/25/15
ASI #2		6/18/15
ASI #1		5/26/15

FOR CONSTRUCTION SET


CITY OF WICHITA, KANSAS
PROPOSED ONE-LINE DIAGRAM
WWTP #2 EMERGENCY POWER PROJECT
C.O.W. PROJECT NO. 468-84956
PEC PROFESSIONAL ENGINEERING CONSULTANTS, P.A.
303 SOUTH TOPEKA WICHITA, KS 67202
316-262-2891 www.pec1.com
Designed by RWW Job No. 34-14229-001-0042 Sht.E0.13 of 37
Drawn by CJV Date 4/29/15

Saved: 04-04-2016 1:20:10 PM by CJV
 File Path: C:\Users\CJV\Documents\14229-001-0042_P1.dwg
 User: C:\Users\CJV\Documents\14229-001-0042_P1.dwg
 User: C:\Users\CJV\Documents\14229-001-0042_P1.dwg

- (1) 15KV/TS 133% INSULATION.
- (2) PROVIDE (1) SPARE 5" WITH PULL ROPE.
- (3) PROVIDE (1) SPARE 4" WITH PULL ROPE.

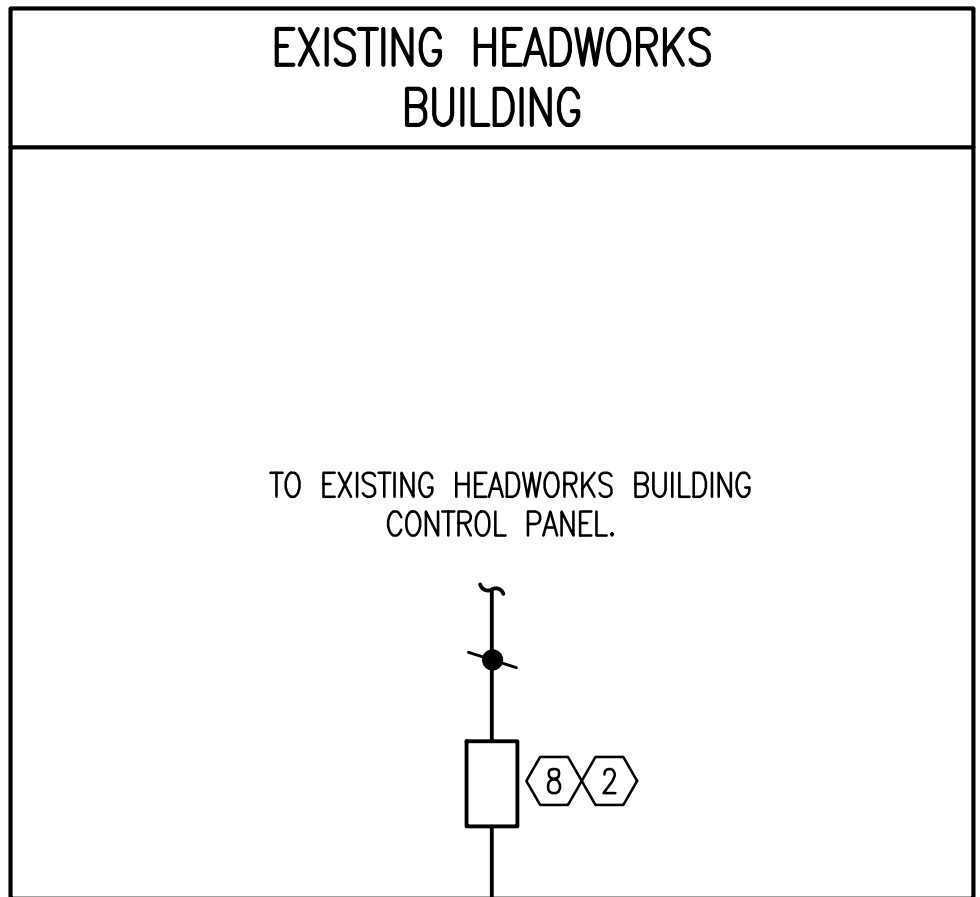


INSTALL INNERDUCT IN EXISTING PATHWAY.
INSTALL FIBER OPTIC CABLE IN THE INNERDUCT.
FIELD VERIFY EXISTING PATHWAY ROUTING.

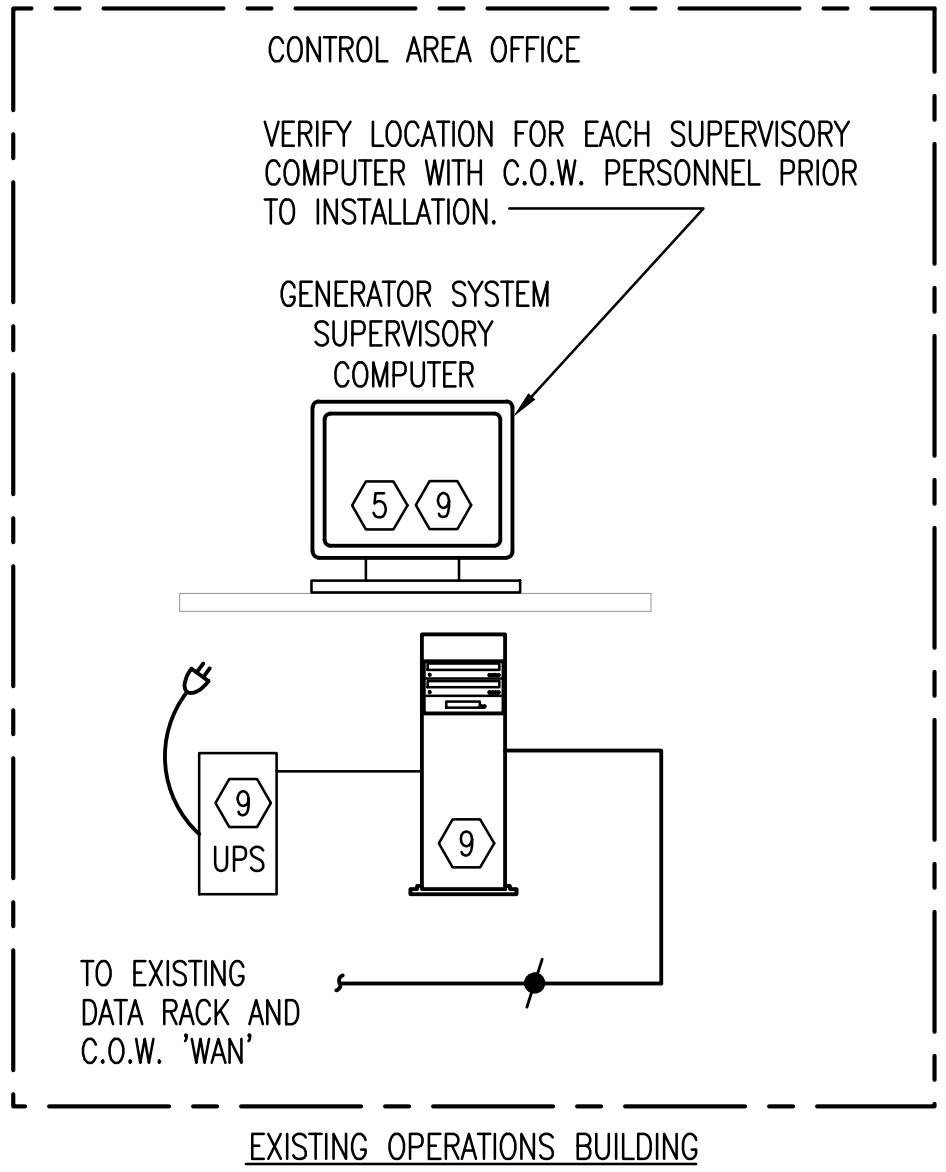

KEY NOTES:

- ① PROVIDE (AS A MINIMUM) THE FOLLOWING CABLES FROM EACH GENERATOR TO THE SWITCHGEAR CONTROLLER:
1 - 2 CONDUCTOR #18 AWG TWISTED PAIR FOR ENGINE COMMUNICATIONS
1 - 3 CONDUCTOR #18 AWG TWISTED TRIAD FOR SPEED CONTROL
1 - 2 CONDUCTOR #18 AWG TWISTED PAIR FOR VOLTAGE CONTROL
3 - #14 AWG FOR MANUAL VOLTAGE CONTROL
4 - #10 AWG FOR 24VDC POWER
16 - #14 AWG FOR DISCRETE SIGNAL TO ENGINE
2 - #14 AWG FOR START WIRES
- ② BY SYSTEMS INTEGRATOR.
- ③ ALL CONTROL PANELS SHALL BE PROVIDED WITH AN ETHERNET PORT FOR CONNECTION OF A LAPTOP COMPUTER.
- ④ CONTROL PANEL PROVIDED BY GENERATOR EQUIPMENT SUPPLIER.
- ⑤ 20" FLAT PANEL LCD MONITOR
- ⑥ FIBER OPTIC PATCH PANEL.
- ⑦ PROVIDED BY FUEL TANK SUPPLIER.
- ⑧ PROVIDE ADDITIONAL EQUIPMENT AS REQUIRED TO CONNECT TO CITY OF WICHITA LAN/WAN.
- ⑨ COMPUTER PROVIDED, PROGRAMMED AND INSTALLED BY GENERATOR MANUFACTURER. SYSTEMS INTEGRATOR AND ELECTRICAL CONTRACTOR TO COORDINATE INSTALLATION LOCATION AND PROVIDE POWER AND COMMUNICATIONS CABLING TO THIS LOCATION.

- FIBER OPTIC CABLE SPECIFICATIONS**
- A. MANUFACTURERS: SUBJECT TO COMPLIANCE WITH REQUIREMENTS, PROVIDE PRODUCTS BY ONE OF THE FOLLOWING:
 1. ADC TELECOMMUNICATIONS, INC.
 2. BELDEN CDT INC.; ELECTRONICS DIVISION.
 3. BERK-TEK; A NEXANS COMPANY.
 4. COMMSCOPE, INC.
 5. MOHAWK; A DIVISION OF BELDEN CDT.
 6. SUPERIOR ESSEX INC.
 - B. DESCRIPTION:
 1. COMPLY WITH ICEA S-87-596 FOR MECHANICAL PROPERTIES.
 2. COMPLY WITH TIA/EIA-568-B.3 FOR PERFORMANCE SPECIFICATIONS.
 3. COMPLY WITH TIA/EIA-492AAAA-B (50/125 MICROMETER CABLE) OR TIA/EIA-492AAAA-A (62.5/125 MICROMETER CABLE) FOR DETAILED SPECIFICATIONS.
 4. LISTED AND LABELED BY AN NRTL ACCEPTABLE TO AUTHORITIES HAVING JURISDICTION AS COMPLYING WITH UL 444, UL 1651, AND NFPA 70 FOR THE APPROPRIATE ENVIRONMENT IN WHICH IT IS INSTALLED.
 - C. MULTIMODE: 62.5/125-MICROMETER, MINIMUM 2-STRAND, LOOSE TUBE.
 1. OUTSIDE PLANT MULTIMODE CABLES SHALL NOT EXCEED THE RECOMMENDED DISTANCE OF 6560 FEET (2000 METERS).
 2. JACKET SHALL BE BLACK (OR AS DIRECTED BY OWNER) AND SHALL BE IMPRINTED WITH FIBER COUNT AND FIBER TYPE AT REGULAR INTERVALS NOT TO EXCEED 40 INCHES (1000 MM).
 - D. OPTICAL FIBER CABLE HARDWARE
 1. MANUFACTURERS: SUBJECT TO COMPLIANCE WITH REQUIREMENTS, PROVIDE PRODUCTS BY ONE OF THE FOLLOWING:
 - A. ADC TELECOMMUNICATIONS, INC.
 - B. BELDEN CDT INC.; ELECTRONICS DIVISION.
 - C. BERK-TEK; A NEXANS COMPANY.
 - D. COMMSCOPE, INC.
 - E. HUBBELL PREMISE WIRING.
 - F. SIEMON CO. (THE).
 2. CABLE CONNECTING HARDWARE: SHALL HAVE THE FOLLOWING CHARACTERISTICS:
 - A. COMPLY WITH OPTICAL FIBER CONNECTOR INTERMATEABILITY STANDARDS (FOCIS) SPECIFICATIONS OF TIA/EIA-604-2, TIA/EIA-604-3-A, AND TIA/EIA-604-12. COMPLY WITH TIA/EIA-568-B.3.
 - B. QUICK-CONNECT, SIMPLEX AND DUPLEX, CONNECTORS.
 - C. HAVE A TERMINATION PROCESS, WHICH INCORPORATES USE OF A RELIABLE ANAEROBIC ADHESIVE, WHICH HAS A HIGH RESISTANCE TO ENVIRONMENTAL EXTREMES.
 - D. UTILIZE A PRECISION ZIRCONIA CERAMIC FERRULE.
 - E. HAVE A TYPICAL INSERTION LOSS NOT MORE THAN 0.5 DB VIA MANUAL POLISH METHOD OR 0.2 DB VIA AUTOMATIC FIBER POLISHER.
 - F. VERIFY ALL FIBER CONNECTOR TYPES WITH OWNER.

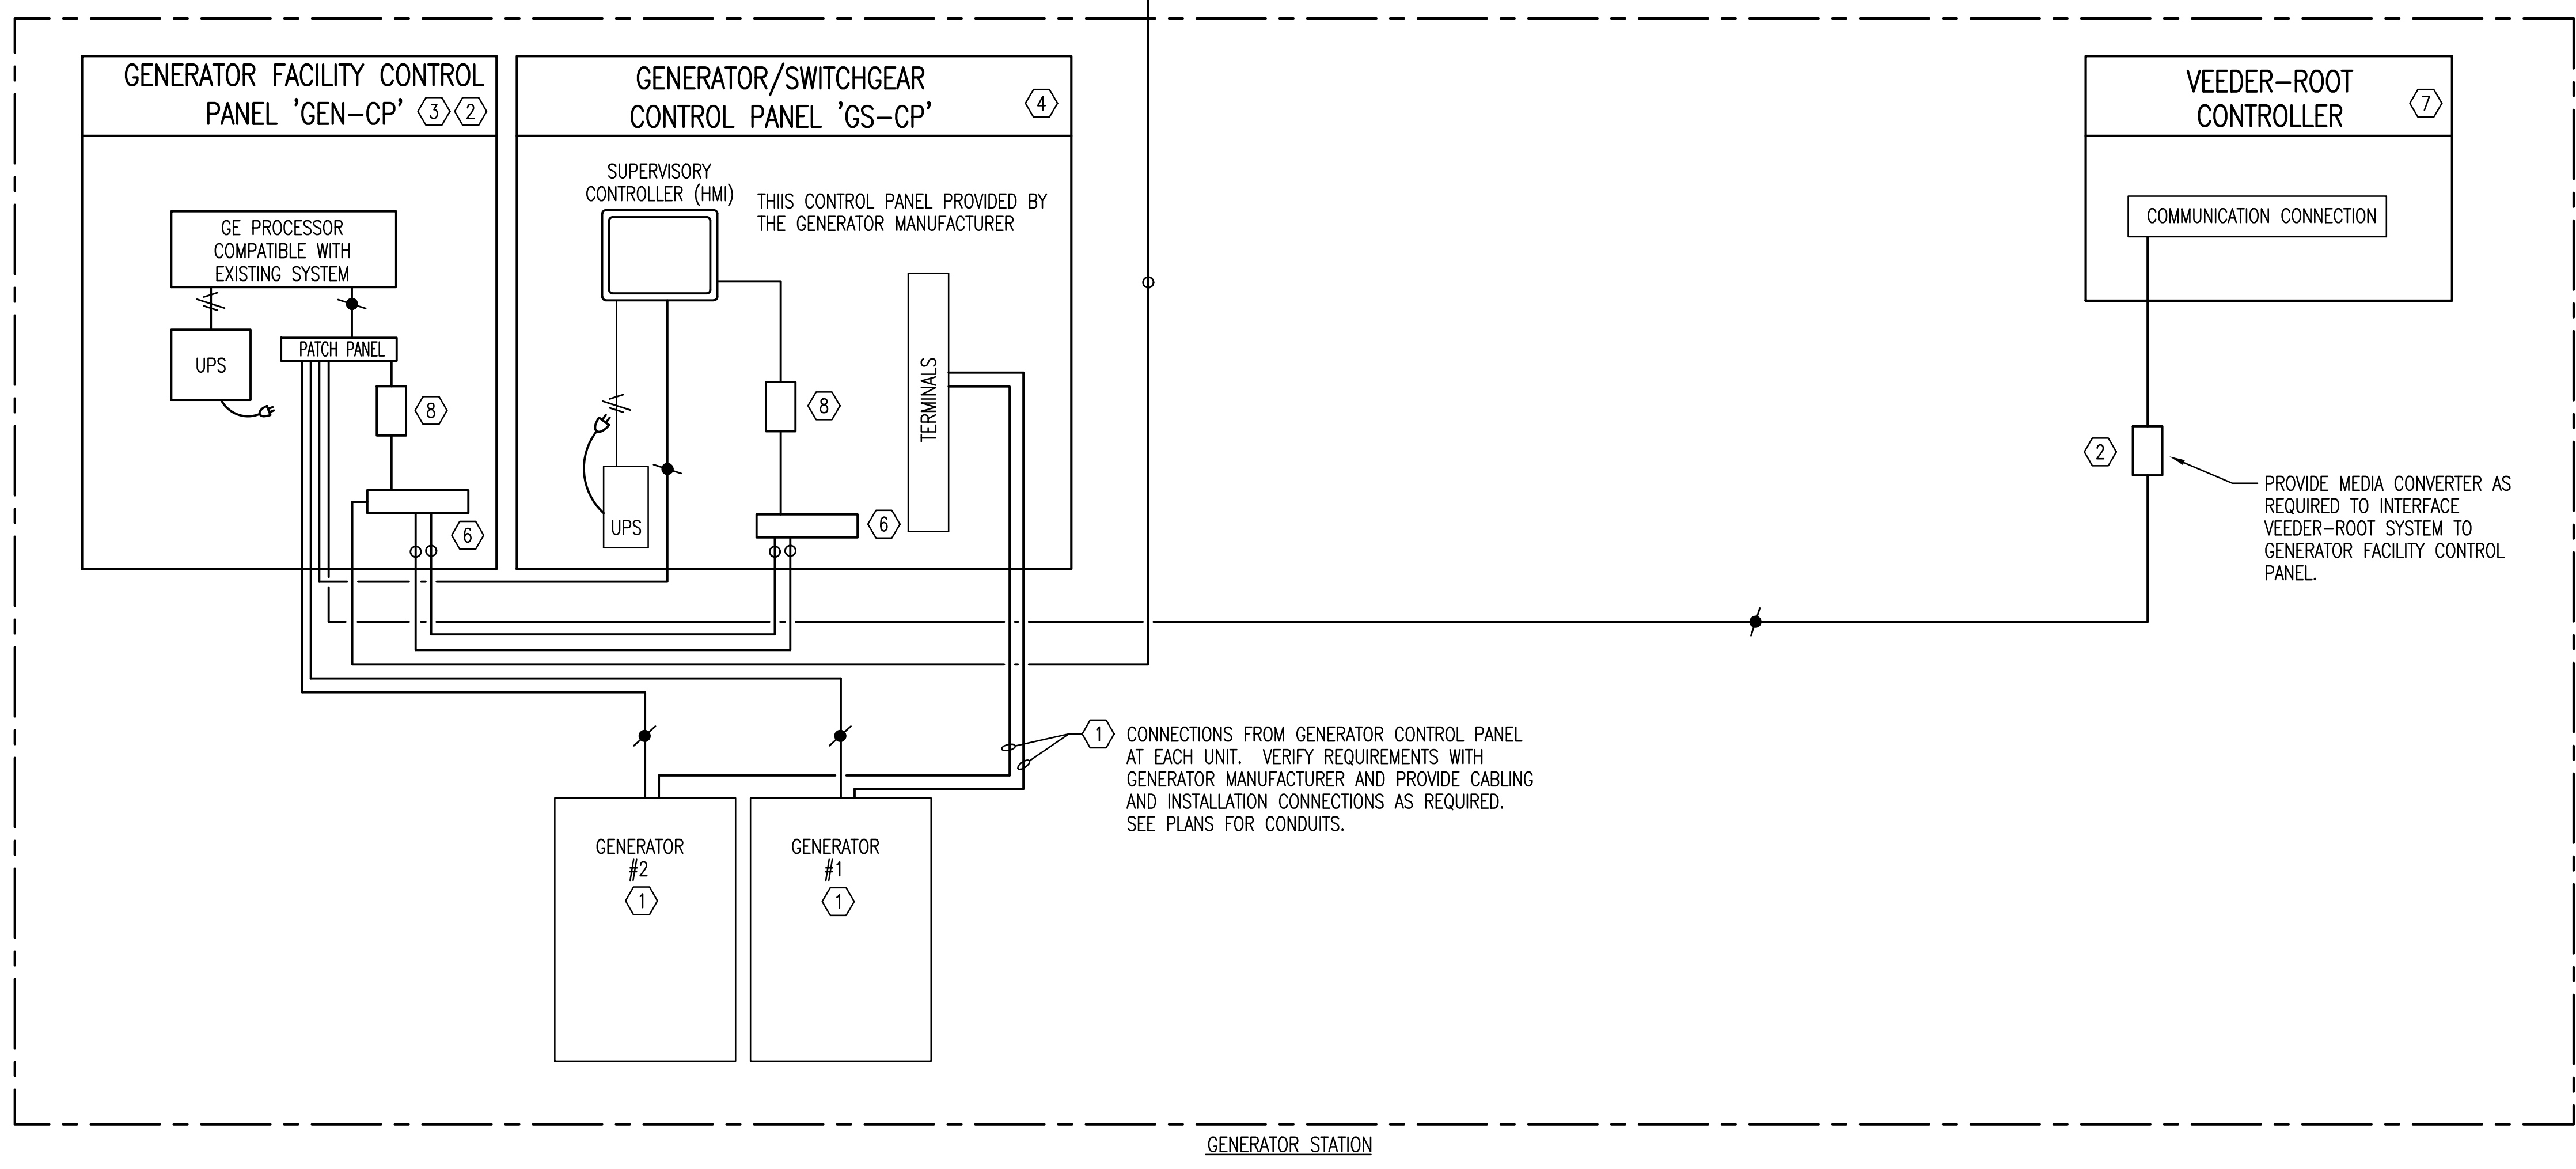

GENERATOR STATION

1 CONTROLS SCHEMATIC
NOT TO SCALE

Saved: 04-04-2016 1:00:07 PM by: CJV
 Plot: 1:2, 04-04-2016 1:20:47 PM by: CJV
 U:\Wichita-Facility\2014\14229\001\Elec\Drawings\As-Built\14229-001-ED.14

RECORD DOCUMENTS
THESE DOCUMENTS INCLUDE RECORD INFORMATION PROVIDED BY THE CONTRACTOR. THIS INFORMATION HAS NOT BEEN VERIFIED IN ITS ENTIRETY BY THE DESIGN PROFESSIONAL.
DATE: FEBRUARY, 2016

▲	ASI #6	6/30/15
▲	ASI #4	6/25/15
▲	ASI #2	6/18/15
▲	ASI #1	5/26/15
FOR CONSTRUCTION SET		
No.	Revision	By Date
CITY OF WICHITA, KANSAS		
CONTROLS SCHEMATIC		
WWTP #2 EMERGENCY POWER PROJECT C.O.W. PROJECT NO. 468-84956		
PEC PROFESSIONAL ENGINEERING CONSULTANTS, P.A. 303 SOUTH TOPEKA WICHITA, KS 67202 316-262-2891 www.pec1.com		
Designed by	RWW	Job No. 34-14229-001-0042
Drawn by	CJV	Date 4/29/15
		Sht.E0.14 of 37


CONTROL PANEL GEN-CP											LOCATION: GENERATOR STATION	
CIRCUIT NO.	EQUIPMENT SERVED/MARK	CONNECT			DESCRIPTION/FUNCTION	CONDUCTORS IN CABLE	DISCRETE ANALOG	DIGITAL	INPUT	OUTPUT	REMARKS	
		DEVICE	C.T. PNL	STARTER								VFD
1	GEN 1	-	X	-	GENSET READY	LAN	-	X	X	-	FROM GENERATOR CONTROL PANEL AT UNIT	
2	GEN 1	-	X	-	GENSET RUNNING	LAN	-	X	X	-	FROM GENERATOR CONTROL PANEL AT UNIT	
3	GEN 1	-	X	-	GENSET FAIL	LAN	-	X	X	-	FROM GENERATOR CONTROL PANEL AT UNIT	
4	GEN 1	-	X	-	GENSET VOLTAGE	LAN	-	X	X	-	FROM GENERATOR CONTROL PANEL AT UNIT	
5	GEN 1	-	X	-	GENSET AMPS	LAN	-	X	X	-	FROM GENERATOR CONTROL PANEL AT UNIT	
6					SPACE	LAN	-	X	X	-		
7	GEN 2	-	X	-	GENSET READY	LAN	-	X	X	-	FROM GENERATOR CONTROL PANEL AT UNIT	
8	GEN 2	-	X	-	GENSET RUNNING	LAN	-	X	X	-	FROM GENERATOR CONTROL PANEL AT UNIT	
9	GEN 2	-	X	-	GENSET FAIL	LAN	-	X	X	-	FROM GENERATOR CONTROL PANEL AT UNIT	
10	GEN 2	-	X	-	GENSET VOLTAGE	LAN	-	X	X	-	FROM GENERATOR CONTROL PANEL AT UNIT	
11	GEN 2	-	X	-	GENSET AMPS	LAN	-	X	X	-	FROM GENERATOR CONTROL PANEL AT UNIT	
12					SPACE	LAN	-	X	X	-		
13	GS CP	-	X	-	STEP 1 STEP LOAD AVAILABLE	LAN	-	X	X	-	FROM GENERATOR CONTROLLER	
14	GS CP	-	X	-	STEP 2 STEP LOAD AVAILABLE	LAN	-	X	X	-	FROM GENERATOR CONTROLLER	
15	GS CP	-	X	-	STEP 3 STEP LOAD AVAILABLE	LAN	-	X	X	-	FROM GENERATOR CONTROLLER	
16	GS CP	-	X	-	STEP 4 STEP LOAD AVAILABLE	LAN	-	X	X	-	FROM GENERATOR CONTROLLER	
17	GS CP	-	X	-	STEP 5 STEP LOAD AVAILABLE	LAN	-	X	X	-	FROM GENERATOR CONTROLLER	
18					SPACE							
19	ALARM	-	X	-	LEAK DETECTION (VEEDER-ROOT CONTROLLER)	LAN	-	X	X	-	FUEL TANK CONTROL PANEL	
20	ALARM	-	X	-	LOW LEVEL (VEEDER-ROOT CONTROLLER)	LAN	-	X	X	-	FUEL TANK CONTROL PANEL	
21	ALARM	-	X	-	OVER-FILL (VEEDER-ROOT CONTROLLER)	LAN	-	X	X	-	FUEL TANK CONTROL PANEL	
22	ALARM	-	X	-	SUDDEN LOSS (VEEDER-ROOT CONTROLLER)	LAN	-	X	X	-	FUEL TANK CONTROL PANEL	
23	ALARM	-	X	-	HIGH WATER (VEEDER-ROOT CONTROLLER)	LAN	-	X	X	-	FUEL TANK CONTROL PANEL	
24	ALARM	-	X	-	DELIVERY NEEDED (VEEDER-ROOT CONTROLLER)	LAN	-	X	X	-	FUEL TANK CONTROL PANEL	
25	ALARM	-	X	-	TEST FAILURE (VEEDER-ROOT CONTROLLER)	LAN	-	X	X	-	FUEL TANK CONTROL PANEL	
26	ALARM	-	X	-	TEST NO PERFORMED (VEEDER-ROOT CONTROLLER)	LAN	-	X	X	-	FUEL TANK CONTROL PANEL	
27					SPACE							
28	ATS	-	X	-	ATS POSITION	1	X	-	X	-		
29												
30												

CONTROL PANEL NOTES:


- CONDUIT FOR ANALOG CABLES SHALL TERMINATE IN EQUIPMENT ENCLOSURE AS CLOSE AS POSSIBLE TO THE TERMINALS. ANALOG CABLES SHALL NOT PASS NEAR TO CABLES OR EQUIPMENT OPERATING OVER 24V.
- INTERNAL AND EXTERNAL I/O SHALL BE LANDED ON TERMINAL STRIPS.
- I/O IDENTIFIED ON CONTROL DIAGRAM SHEETS ARE FOR INPUTS AND OUTPUTS EXTERNAL TO THE EQUIPMENT CONTROL PANEL. I/O NECESSARY FOR THE COMPLETE FUNCTIONALITY OF THE EQUIPMENT (INTERNAL I/O) SHALL BE PROVIDED BY THE EQUIPMENT MANUFACTURER. THE CONTRACTOR SHALL FURNISH AND INSTALL ALL CONDUIT AND WIRING AS REQUIRED FOR COMPLETE FUNCTIONALITY OF EQUIPMENT AS SPECIFIED AND AS IDENTIFIED BY THE MANUFACTURER. COORDINATE FIELD WIRING REQUIREMENTS WITH EQUIPMENT MANUFACTURER.
- ALL I/O SHOWN SHALL BE AVAILABLE AT THE MAIN HESS PUMP STATION CONTROL PANEL LOCATED IN THE HESS PUMP STATION.
- THE SYSTEMS INTEGRATOR SHALL PROVIDE I/O CARDS FOR ALL FUTURE EQUIPMENT AND CONNECTIONS AS INDICATED WITHIN THE SCHEDULE IN ADDITION TO THE SPARE REQUIRED IN THE SPECIFICATIONS. NO WIRING WILL BE INSTALLED AS PART OF THIS PROJECT FOR THE FUTURE I/O. ALL FUTURE I/O SHALL BE LABELED AS SHOWN IN SCHEDULE AND SHALL BE WIRED INTERNAL TO THE CONTROL PANEL READY FOR FUTURE CONNECTION TO FIELD EQUIPMENT.

Saved: 04-04-2016 1:20:27 PM by: C:\Users\WILLIAMS\Documents\14229-001-ED-15-CONTROLS SCHEDULE
 P:\S\14229-001-ED-15-CONTROLS SCHEDULE.dwg
 U:\Wichita-Facility\14229\001\Eds\Drawings\As-Built\14229-001-ED-15-CONTROLS SCHEDULE


RECORD DOCUMENTS
 THESE DOCUMENTS INCLUDE RECORD INFORMATION PROVIDED BY THE CONTRACTOR. THIS INFORMATION HAS NOT BEEN VERIFIED IN ITS ENTIRETY BY THE DESIGN PROFESSIONAL.
 DATE: FEBRUARY, 2016

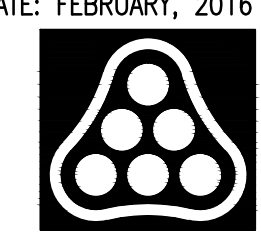


▲	ASI #6	6/30/15
▲	ASI #4	6/25/15
▲	ASI #2	6/18/15
▲	ASI #1	5/26/15
FOR CONSTRUCTION SET		4/29/15
No.	Revision	By Date
CITY OF WICHITA, KANSAS		
CONTROLS SCHEDULE		
WWTP #2 EMERGENCY POWER PROJECT C.O.W. PROJECT NO. 468-84956		
PEC PROFESSIONAL ENGINEERING CONSULTANTS, P.A. 303 SOUTH TOPEKA WICHITA, KS 67202 316-262-2891 www.pec1.com		
Designed by	RWW	Job No. 34-14229-001-0042
Drawn by	CJV	Date 4/29/15
		Sht. E0.15 of 37

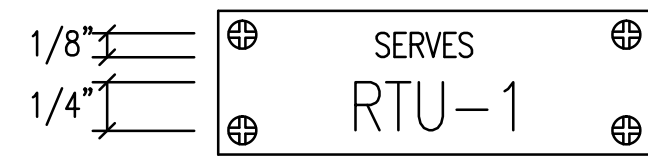

SWITCHBOARD/DISTRIBUTION PANEL/MOTOR CONTROL CENTER BREAKER/SWITCH

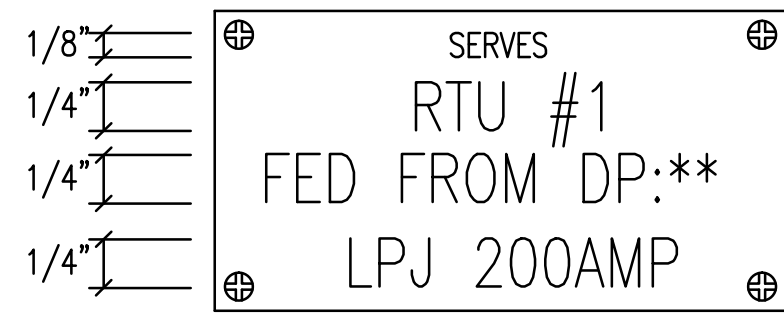


DISCONNECT SWITCH

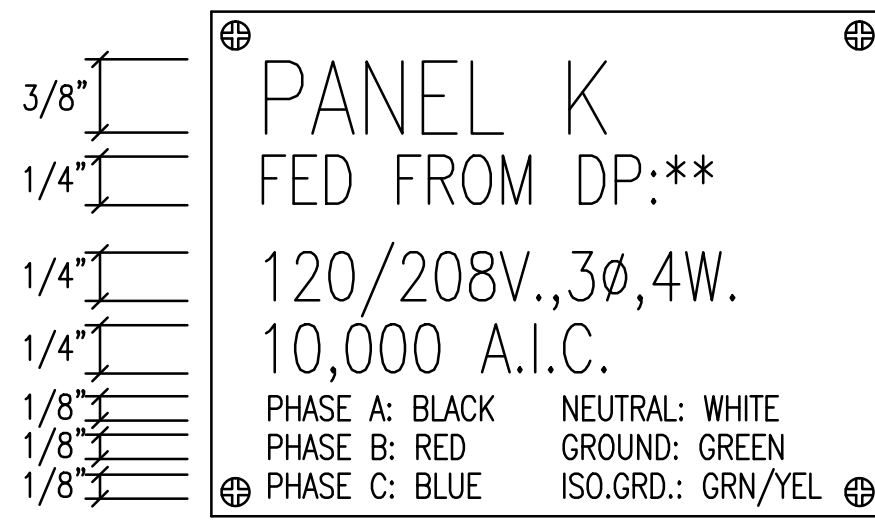


BRANCH CIRCUIT/DISTRIBUTION PANEL

1 TYPICAL NAME PLATES
NO SCALE

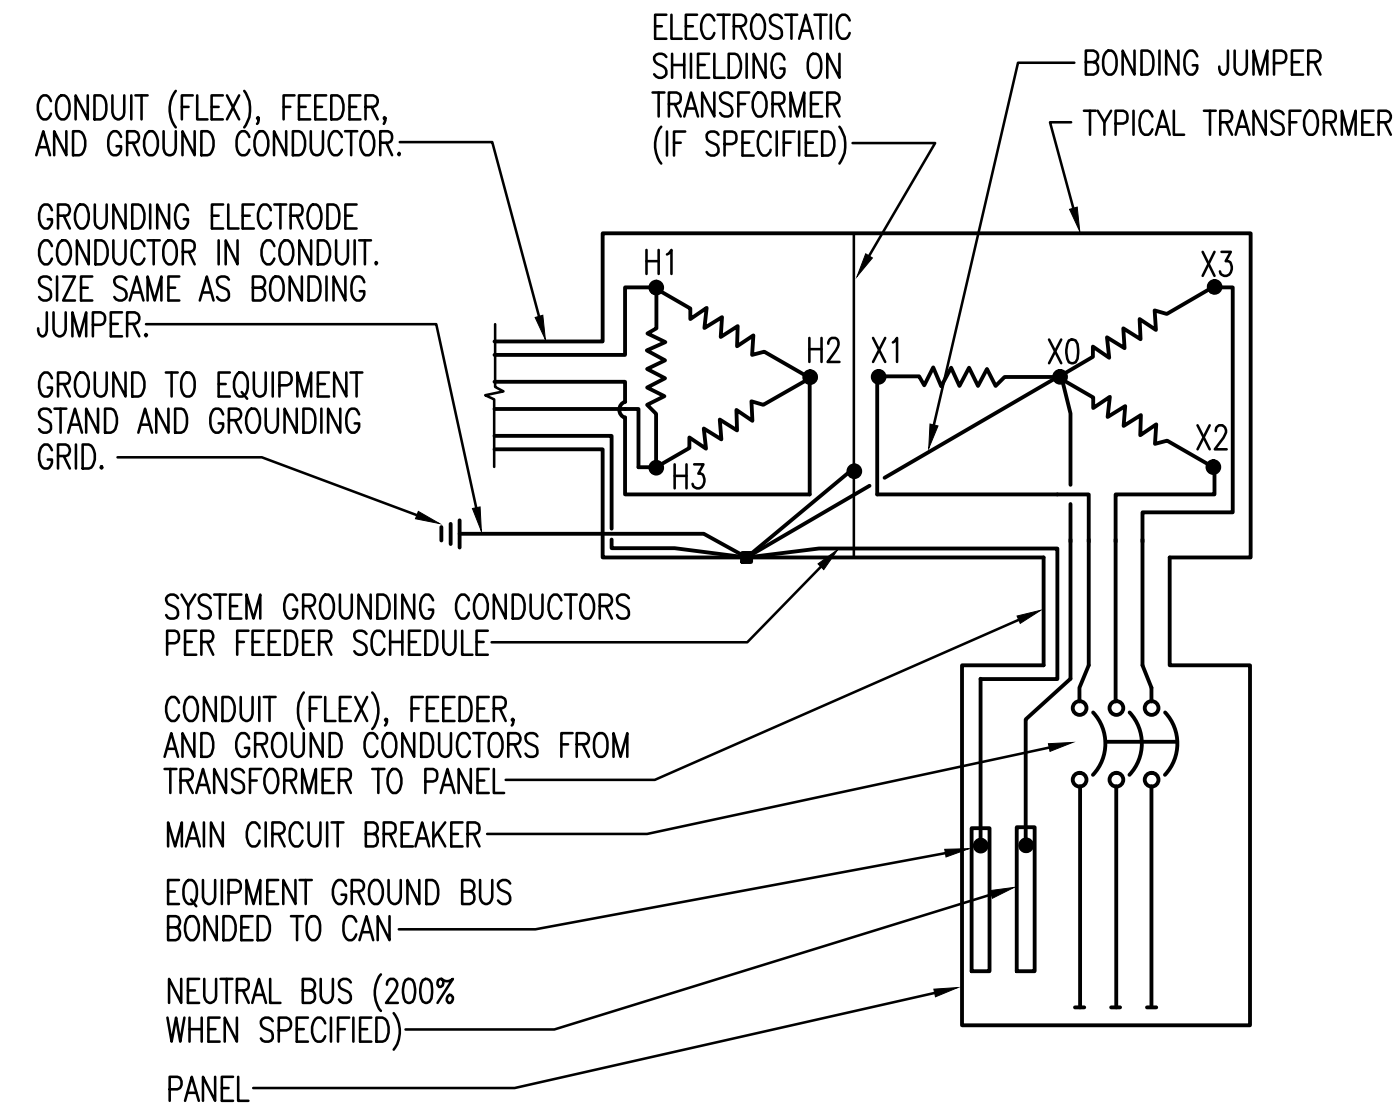


2 TYPICAL TRANSFORMER GROUNDING DETAIL
NO SCALE

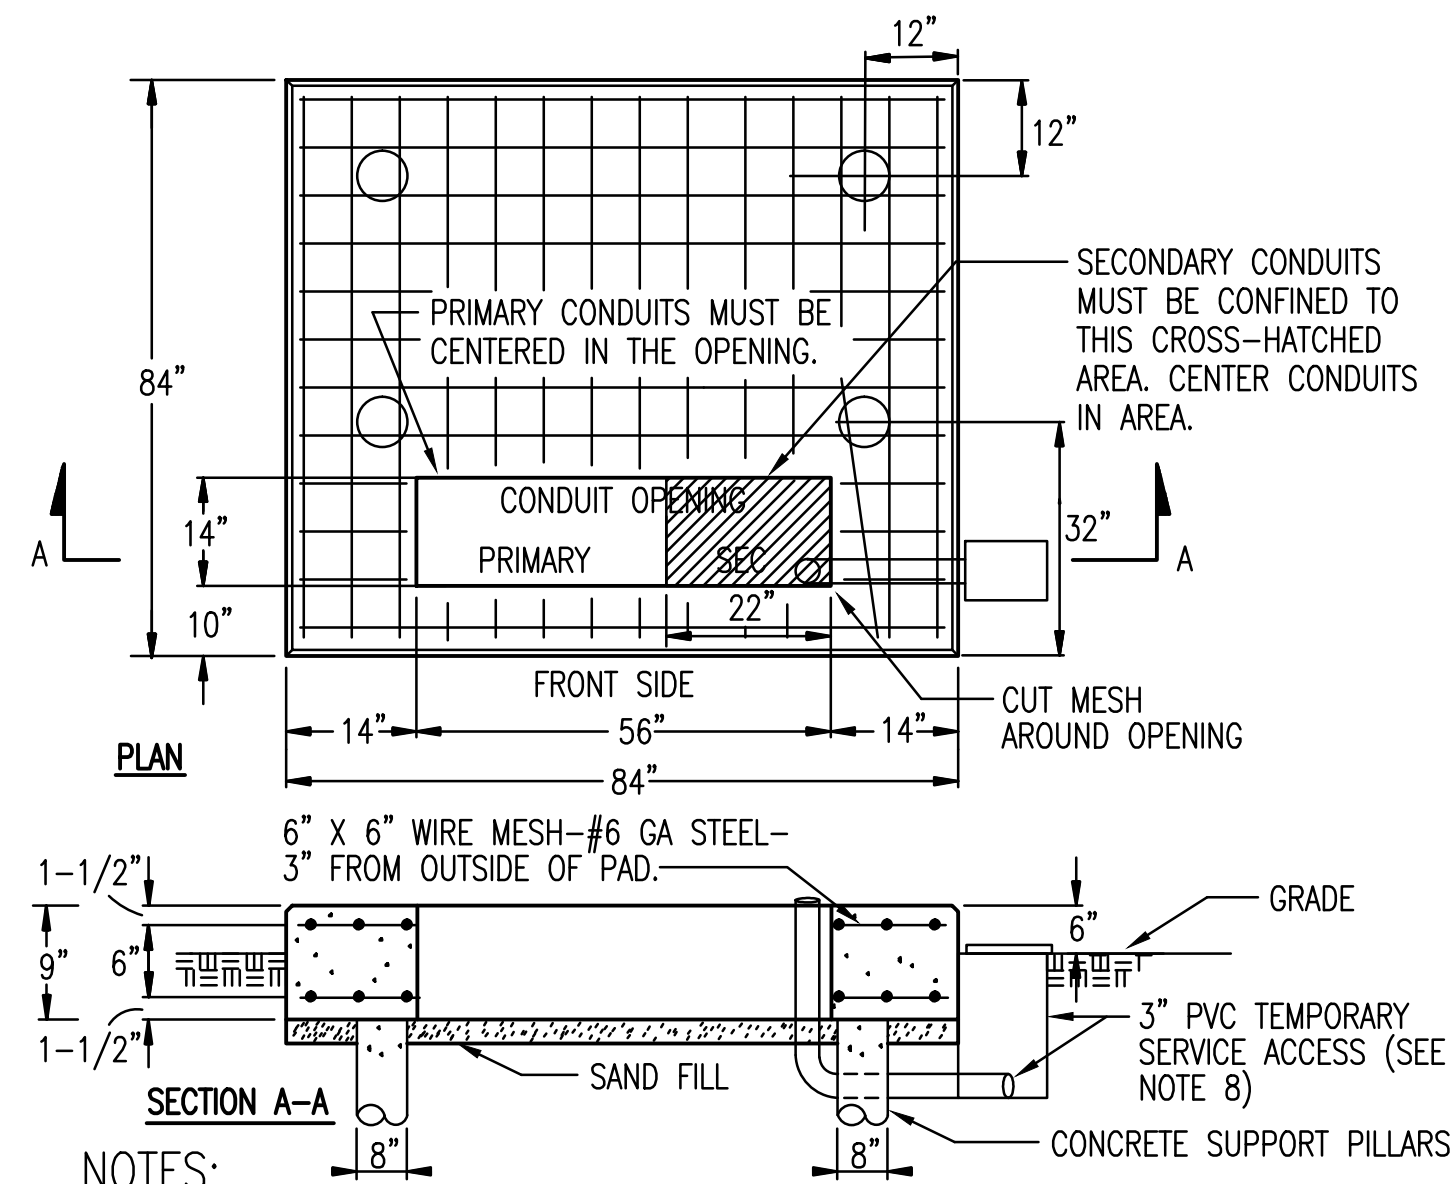

- NOTES:
1. VERIFY PAD LOCATION, DIMENSIONS & ALL REQUIREMENTS WITH LOCAL UTILITY CO.
 2. THE TOP OF THE TRANSFORMER PAD SHALL RECEIVE A SMOOTH TROWEL FINISH. THE CORNERS AND EDGES SHALL BE ROUNDED OR BEVELLED.
 3. THE CONCRETE SHALL BE A MINIMUM OF 3,000 LB. MIX.
 4. CONTRACTOR SHALL EXTEND FORMS DOWN TO AT LEAST 3" BELOW AVERAGE GROUND LINE.
 5. TOP OF CONDUITS SHALL BE FLUSH WITH TOP OF PAD.
 6. THE CONDUIT OPENING SHALL BE FREE AND CLEAR OF CONCRETE.
 7. PILLARS ARE FORMED BY AUGERING AN 8" DIAMETER HOLE TO A DEPTH OF UNDISTURBED EARTH. A SEPARATOR, SUCH AS TAR PAPER, SHOULD BE PLACED BETWEEN THE PILLAR AND THE PAD SO THE PAD CAN BE LEVELLED AT A LATER TIME IF NECESSARY.
 8. VERIFY IF 3" PVC TEMPORARY SERVICE ACCESS IS REQUIRED. IF REQUIRED, CONDUIT TO EXTEND 1' TO 2' BEYOND EDGE OF PAD. DO NOT BACKFILL. USE 3/4" PLAYWOOD OR COMPARABLE COVER TO SECURE HOLE. CAP CONDUIT PRIOR TO BACKFILLING HOLE AT COMPLETION OF PROJECT.

6 TRANSFORMER PAD DETAIL
NO SCALE 75-500KVA

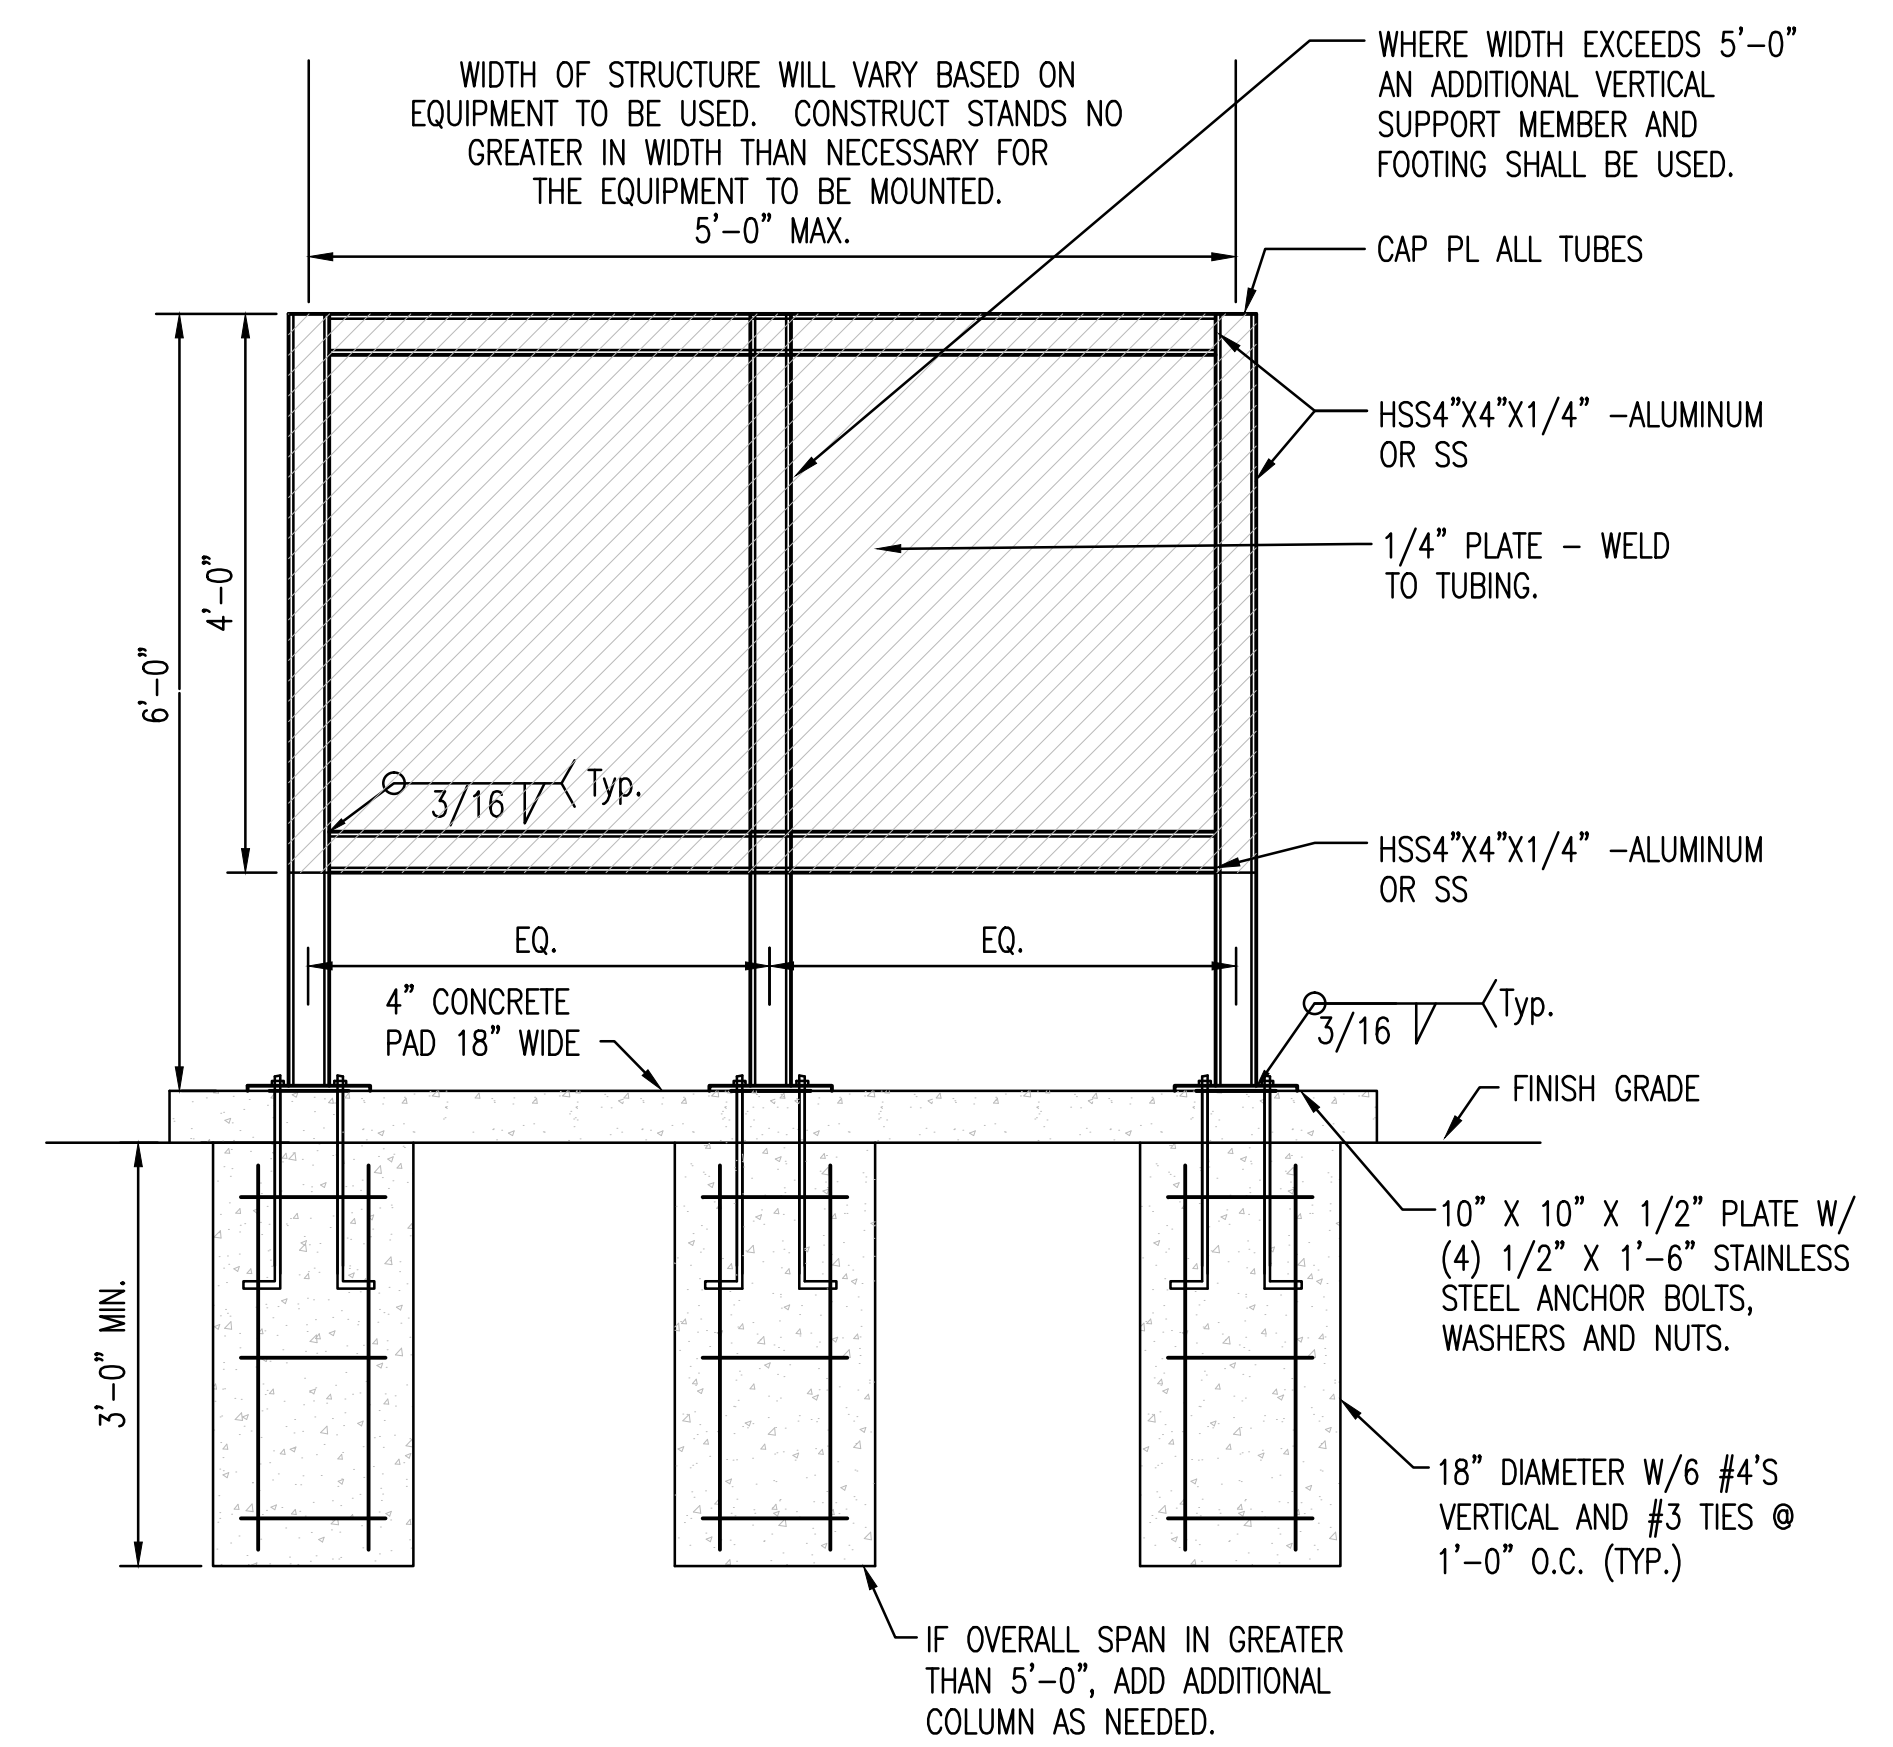

CONTRACTOR OPTION TO FABRICATE ENTIRE STRUCTURE OF STAINLESS STEEL OR ALUMINUM. IF STAND IS CONSTRUCTED OF STAINLESS STEEL THE SAME TUBING, PLATE SIZES, AND WELDS SHALL BE USED.


CONNECT ALL EQUIPMENT TO STRUCTURE USING STAINLESS STEEL BOLT AND/OR SCREWS.

IF ALUMINUM IS USED A 10" X 10" X 1/16" RUBBER PAD SHALL BE INSTALLED BETWEEN THE HOUSEKEEPING PAD AND THE PLATES AT THE BOTTOM OF EACH STAND VERTICAL MEMBER WHERE THEY ATTACH TO THE ANCHOR BOLTS

WHERE STANDS ARE TO BE INSTALLED ON THE INTERIOR OF THE PROCESS BUILDING, THE STANDS SHALL BE ANCHORED TO THE FLOOR WITH STAINLESS STEEL ANCHOR BOLTS EPOXIED IN PLACES IN LIEU OF PROVIDING FOUNDATIONS AS SHOWN.


WHERE STANDS ARE TO BE INSTALLED ON THE INTERIOR OF THE PROCESS BUILDING, THE STRUCTURE MAY BE CONSTRUCTED OF BACK-TO-BACK UNISTRUT FOR VERTICAL MEMBERS AND UNISTRUT FOR HORIZONTAL MEMBERS WITH A 1/4" PLATE INSTALLED FOR MOUNTING EQUIPMENT ON. ALL MEMBERS SHALL BE EITHER ALUMINUM OR STAINLESS STEEL.

3 TYPICAL ELECTRICAL STRUCTURE DETAIL
NO SCALE

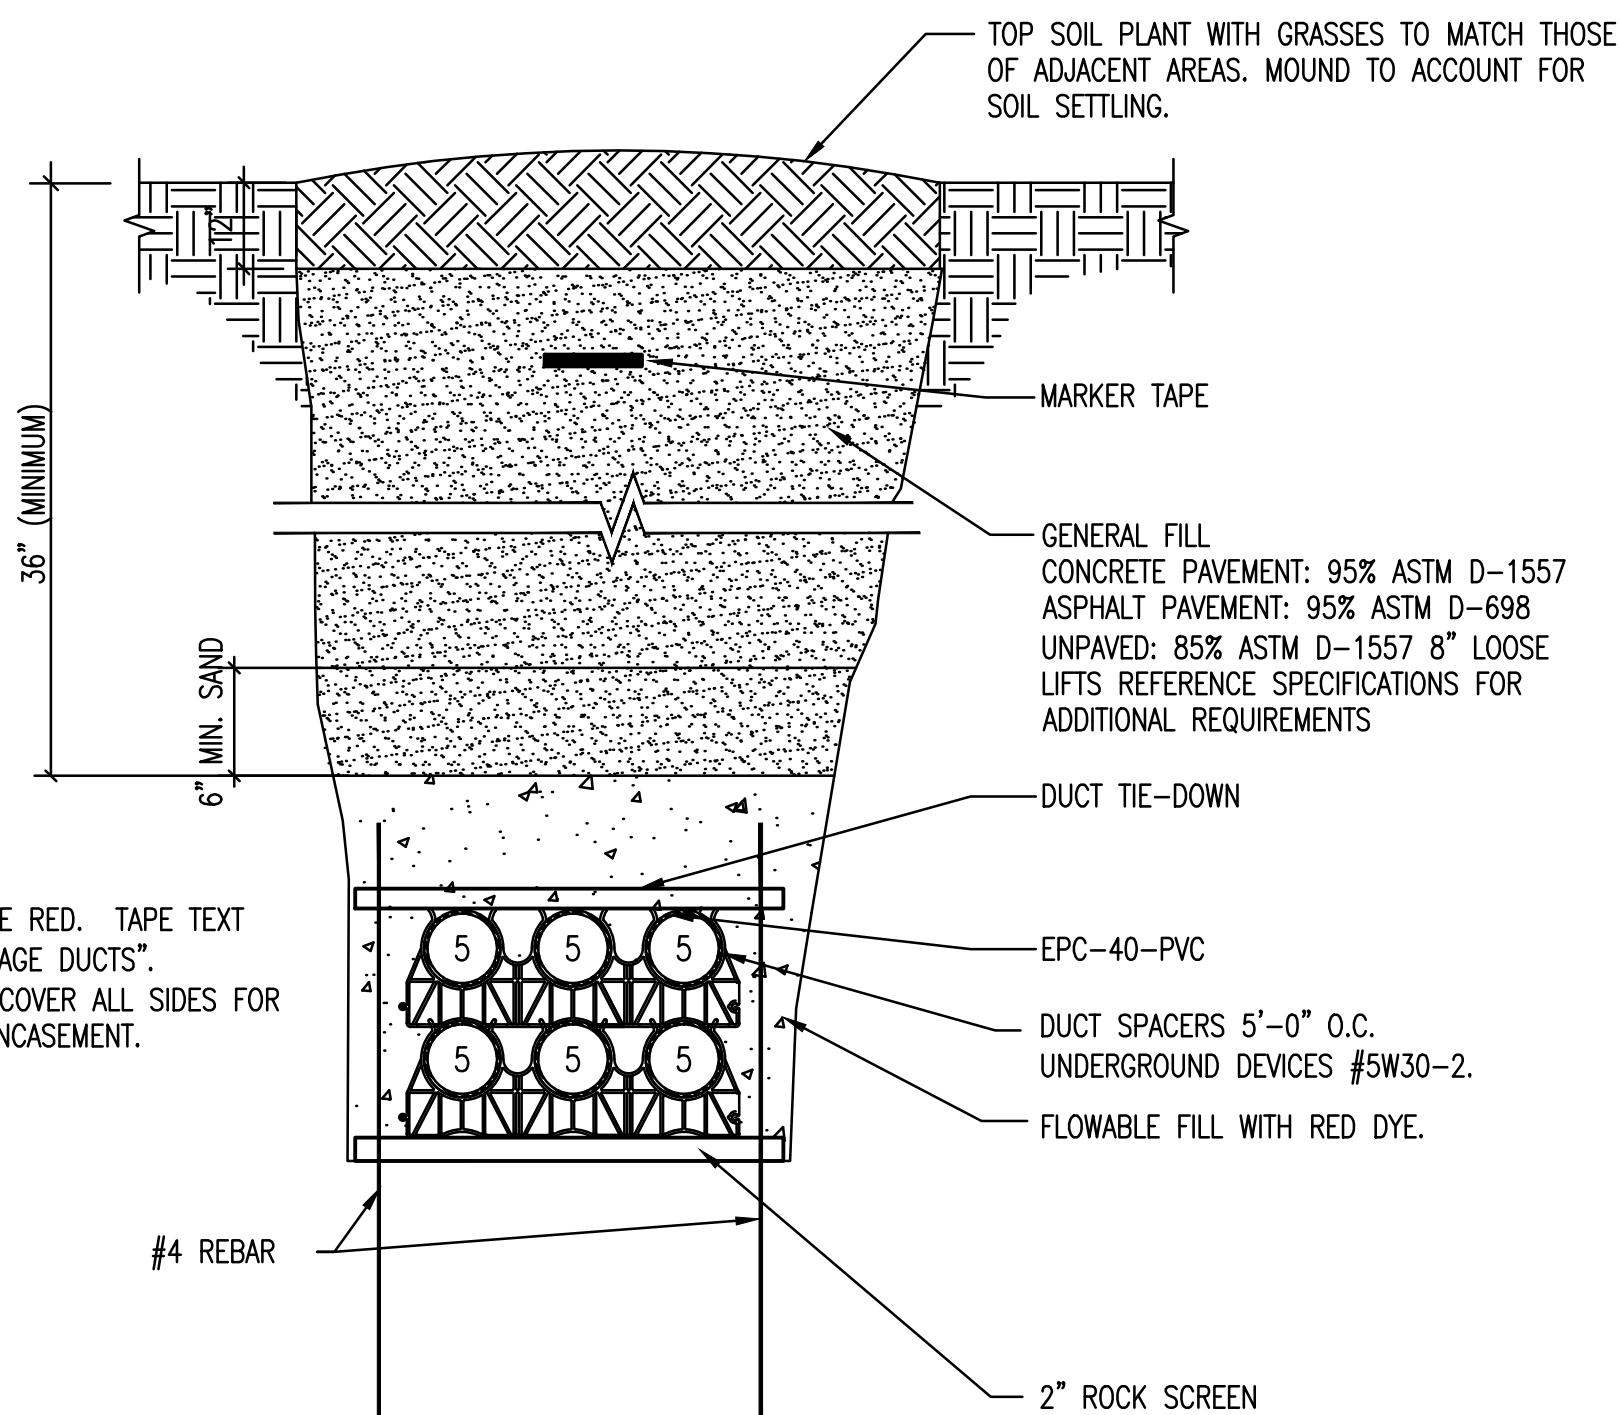

- NOTES:
1. TAPE COLOR SHALL BE RED. TAPE TEXT SHALL BE "HIGH VOLTAGE DUCTS".
 2. PROVIDE 6" MINIMUM COVER ALL SIDES FOR ALL FLOWABLE FILL ENCASMENT.

4 DUCTBANK DETAIL - CONCRETE ENCASED
NO SCALE 6-WAY

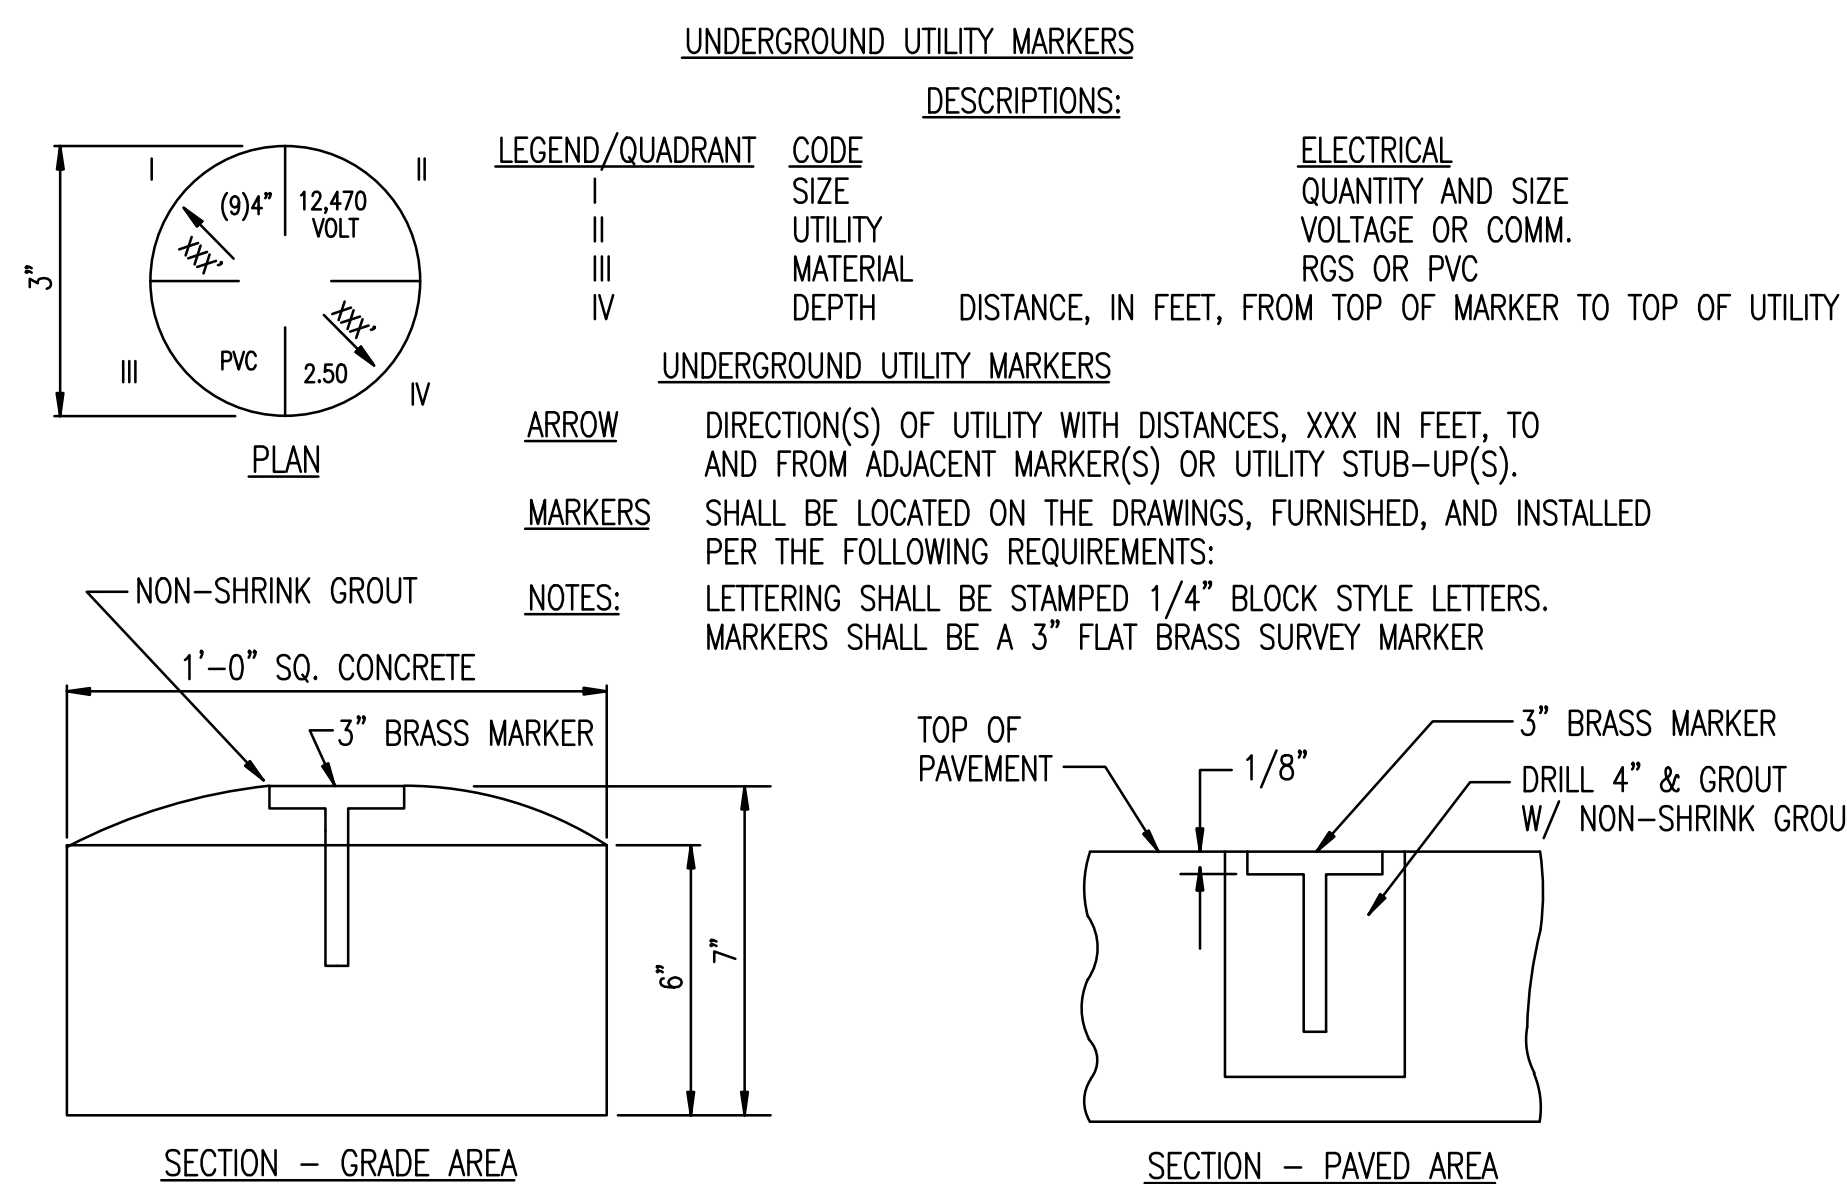

NOTE: PROVIDE MARKERS AT 100'-0" ON CENTER, AND AT ALL CHANGE IN DIRECTION, FOR ALL UNDERGROUND DUCTS AND CABLES.


5 UTILITY MARKER DETAIL
NO SCALE

RECORD DOCUMENTS

THESE DOCUMENTS INCLUDE RECORD INFORMATION PROVIDED BY THE CONTRACTOR. THIS INFORMATION HAS NOT BEEN VERIFIED IN ITS ENTIRETY BY THE DESIGN PROFESSIONAL. DATE: FEBRUARY, 2016


Revision	By	Date
AS1 #6		6/30/15
AS1 #4		6/25/15
AS1 #2		6/18/15
AS1 #1		5/26/15
FOR CONSTRUCTION SET		
CITY OF WICHITA, KANSAS		
ELECTRICAL DETAILS		
WWTP #2 EMERGENCY POWER PROJECT C.O.W. PROJECT NO. 468-84956		
PEC PROFESSIONAL ENGINEERING CONSULTANTS, P.A. 303 SOUTH TOPEKA WICHITA, KS 67202 316-262-2891 www.pec1.com		
Designed by	RWW	Job No. 34-14229-001-0042
Drawn by	CJV	Date 4/29/15

NOTE:
TYPICAL OF (2) GENERATORS.

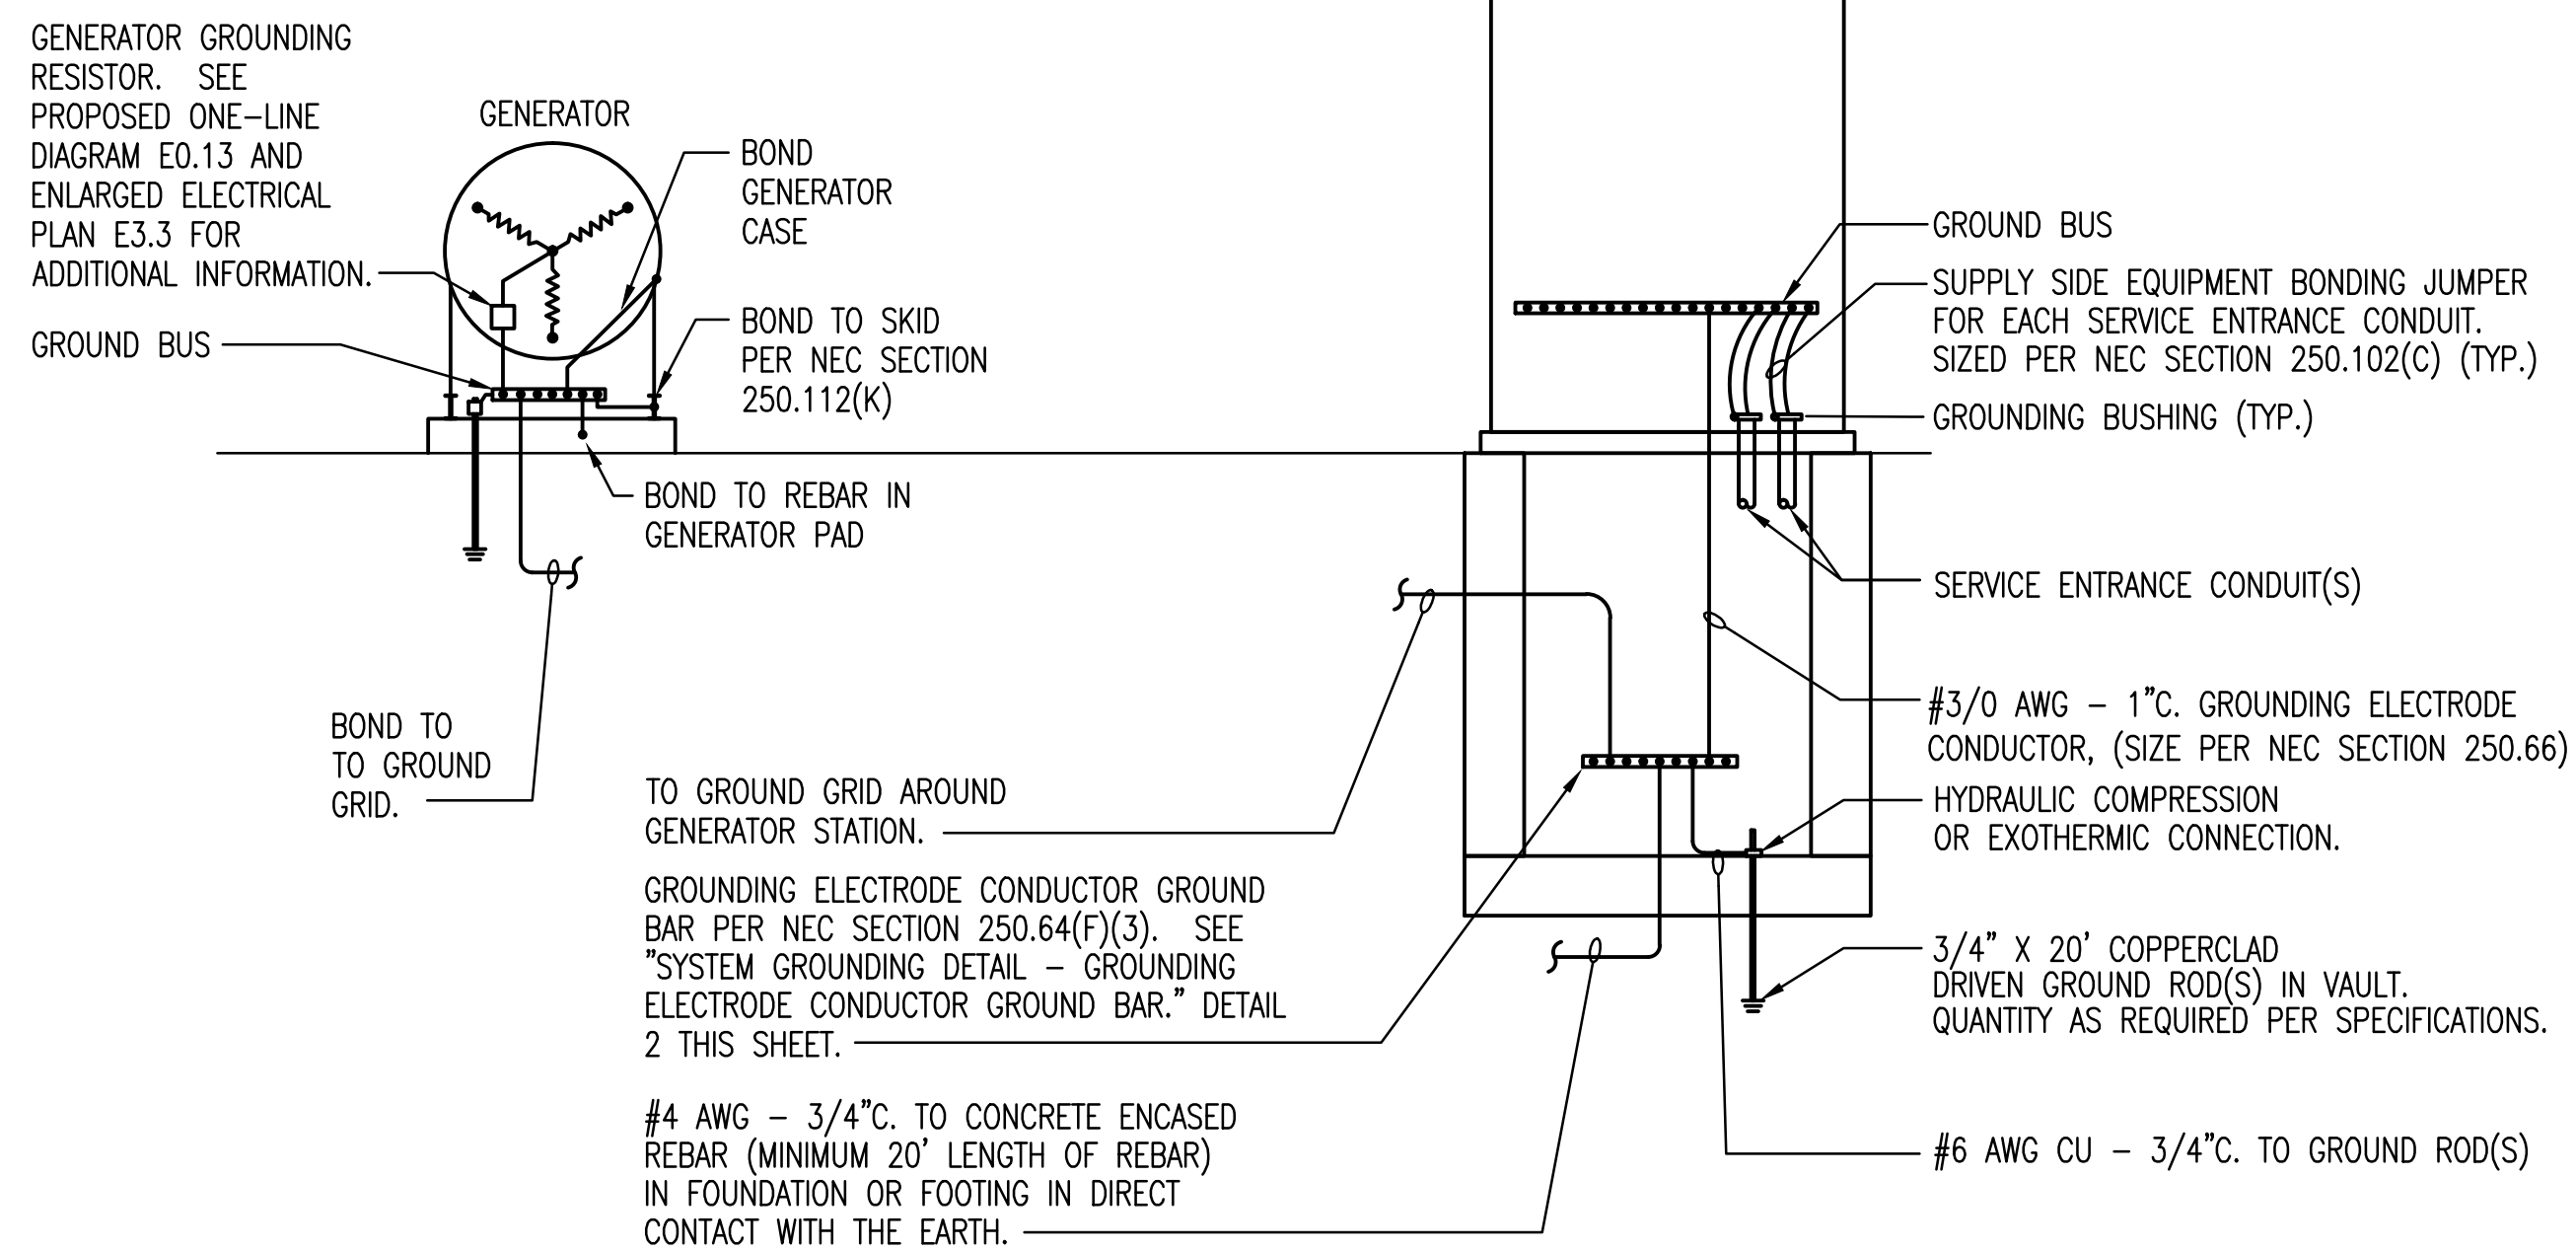


- NOTES:
1. PROVIDE OTHER GROUNDING CONNECTIONS AS SPECIFIED IN NEC SECTION 250.50.
 2. LABEL EACH GROUNDING ELECTRODE CONDUCTOR AND BONDING JUMPER.
 3. WHERE CONDUCTORS ARE ROUTED IN FERROUS CONDUIT, BOND BOTH ENDS OF THE CONDUIT TO THE CONDUCTOR.

1 SYSTEM GROUNDING DETAIL
NO SCALE

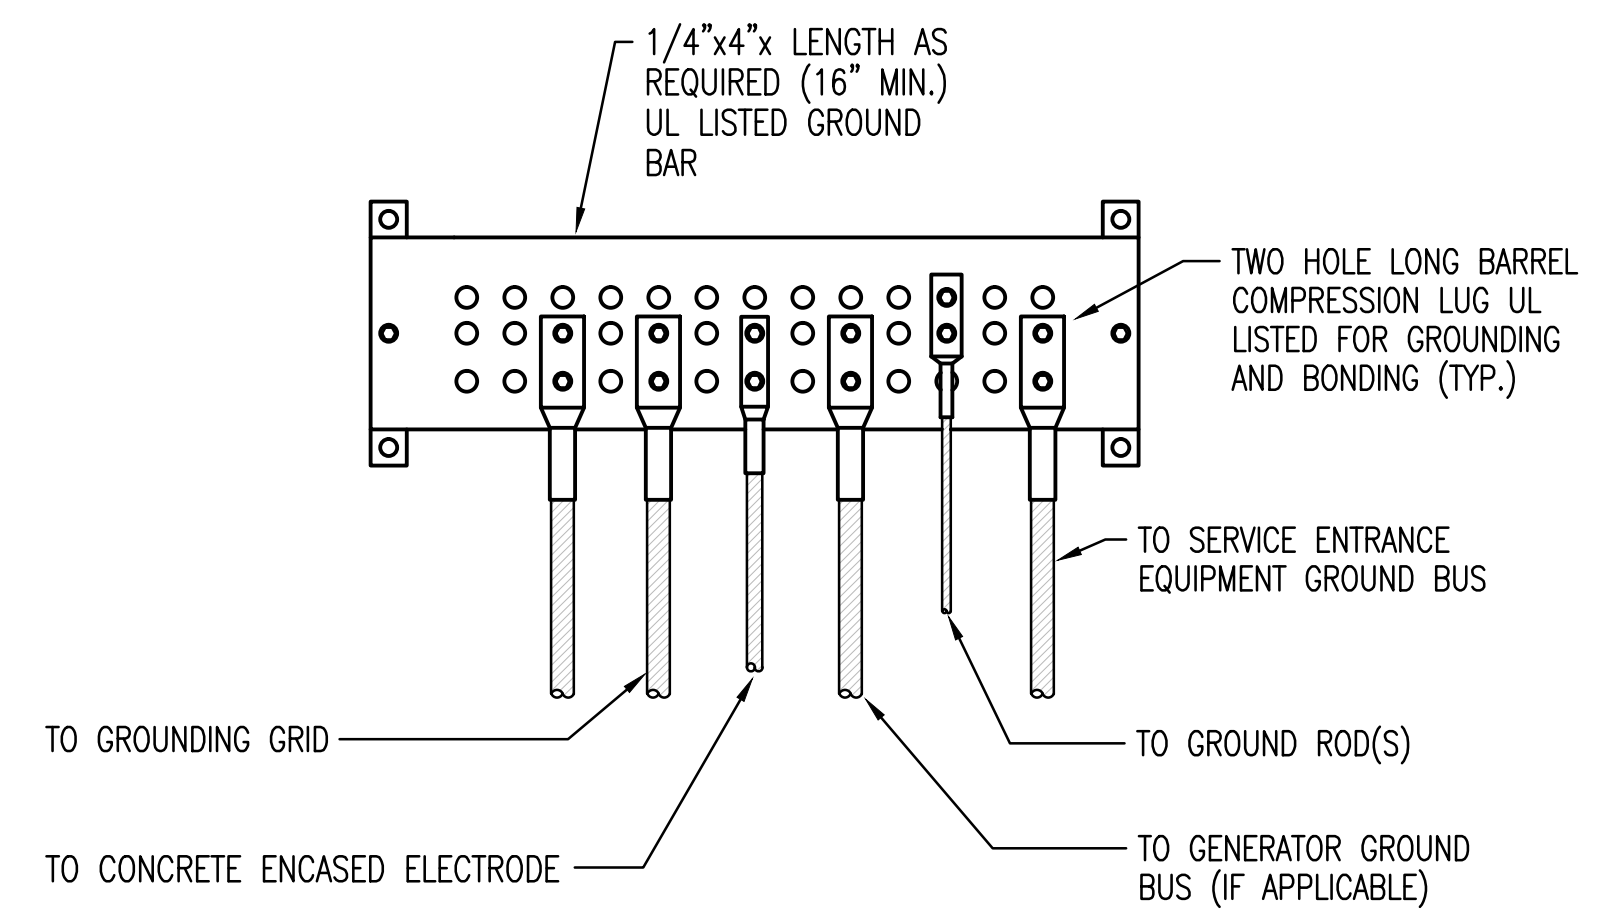


- NOTES:
1. PROVIDE OTHER GROUNDING CONNECTIONS AS SPECIFIED IN NEC SECTION 250.50.
 2. LABEL EACH GROUND CONDUCTOR TO INDICATE USE.
 3. PROVIDE NON-FERROUS CONDUIT (SIZE AS NOTED) WHERE CONDUCTORS ARE SUBJECT TO PHYSICAL DAMAGE. IF FERROUS CONDUIT IS USED, BOND EACH END OF THE CONDUCTOR TO THE CONDUIT.


2 SYSTEM GROUNDING DETAIL - GROUNDING ELECTRODE CONDUCTOR GROUND BAR
NO SCALE

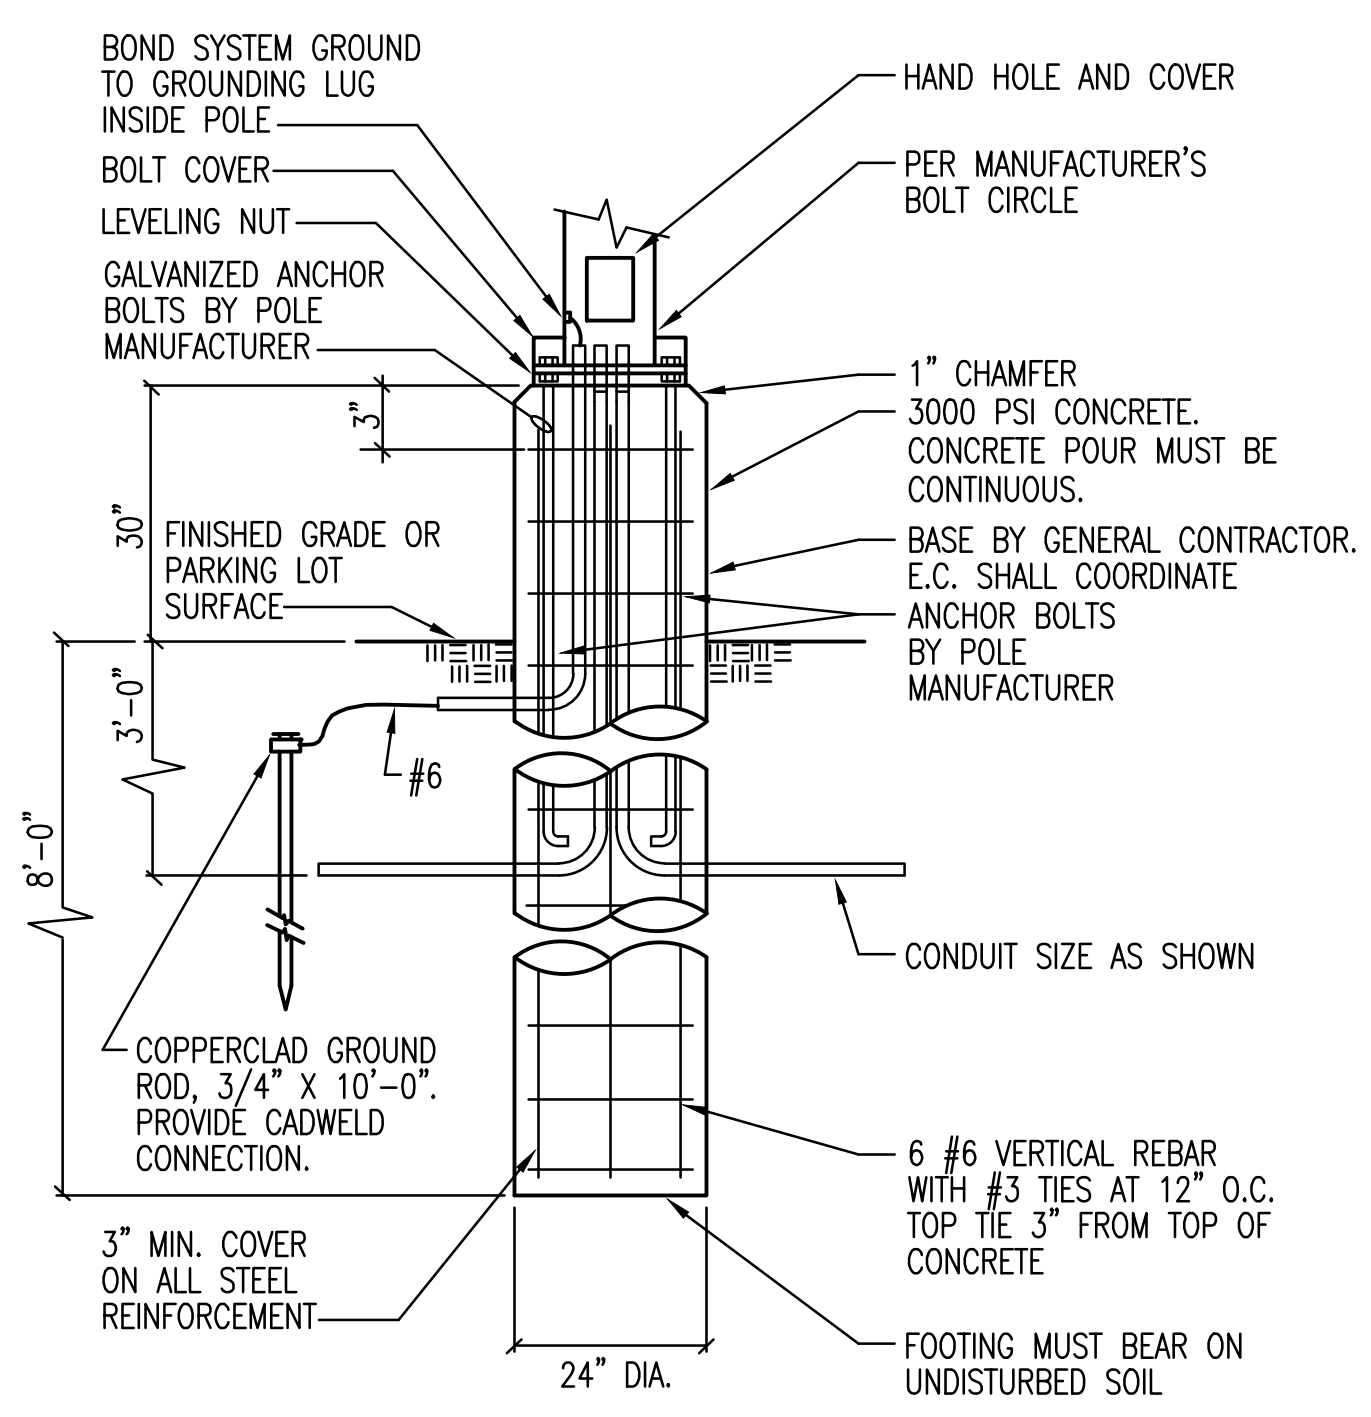


3 POLE BASE DETAIL
NO SCALE (30' MAX. POLE)

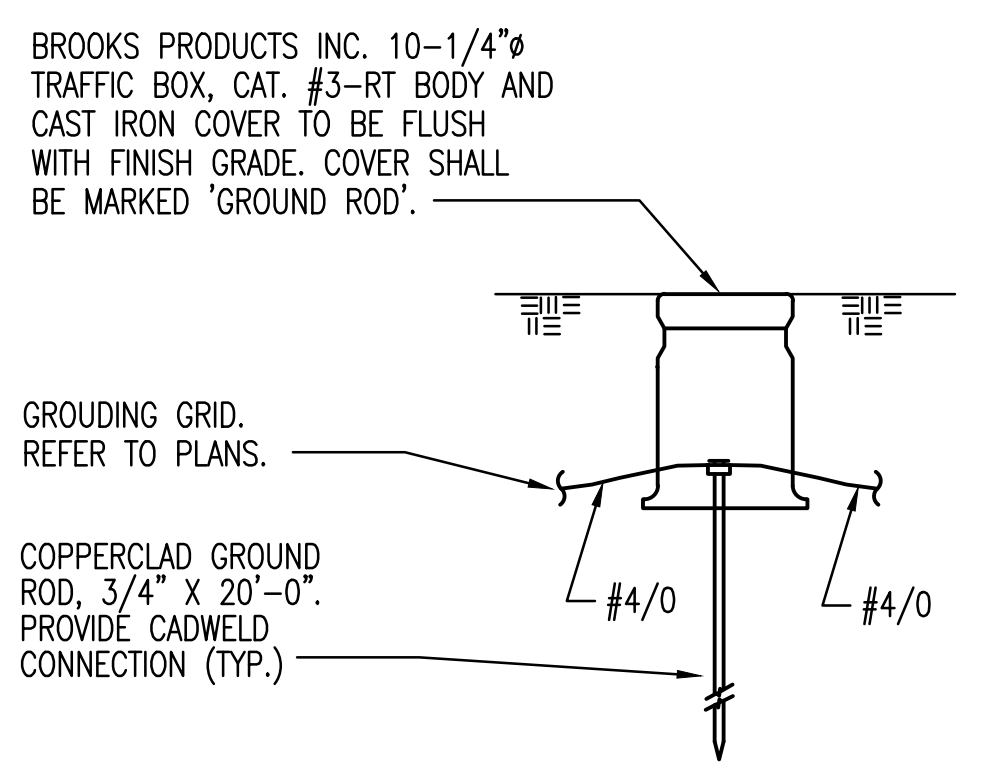


5 GROUNDING SYSTEM TEST WELL
NO SCALE

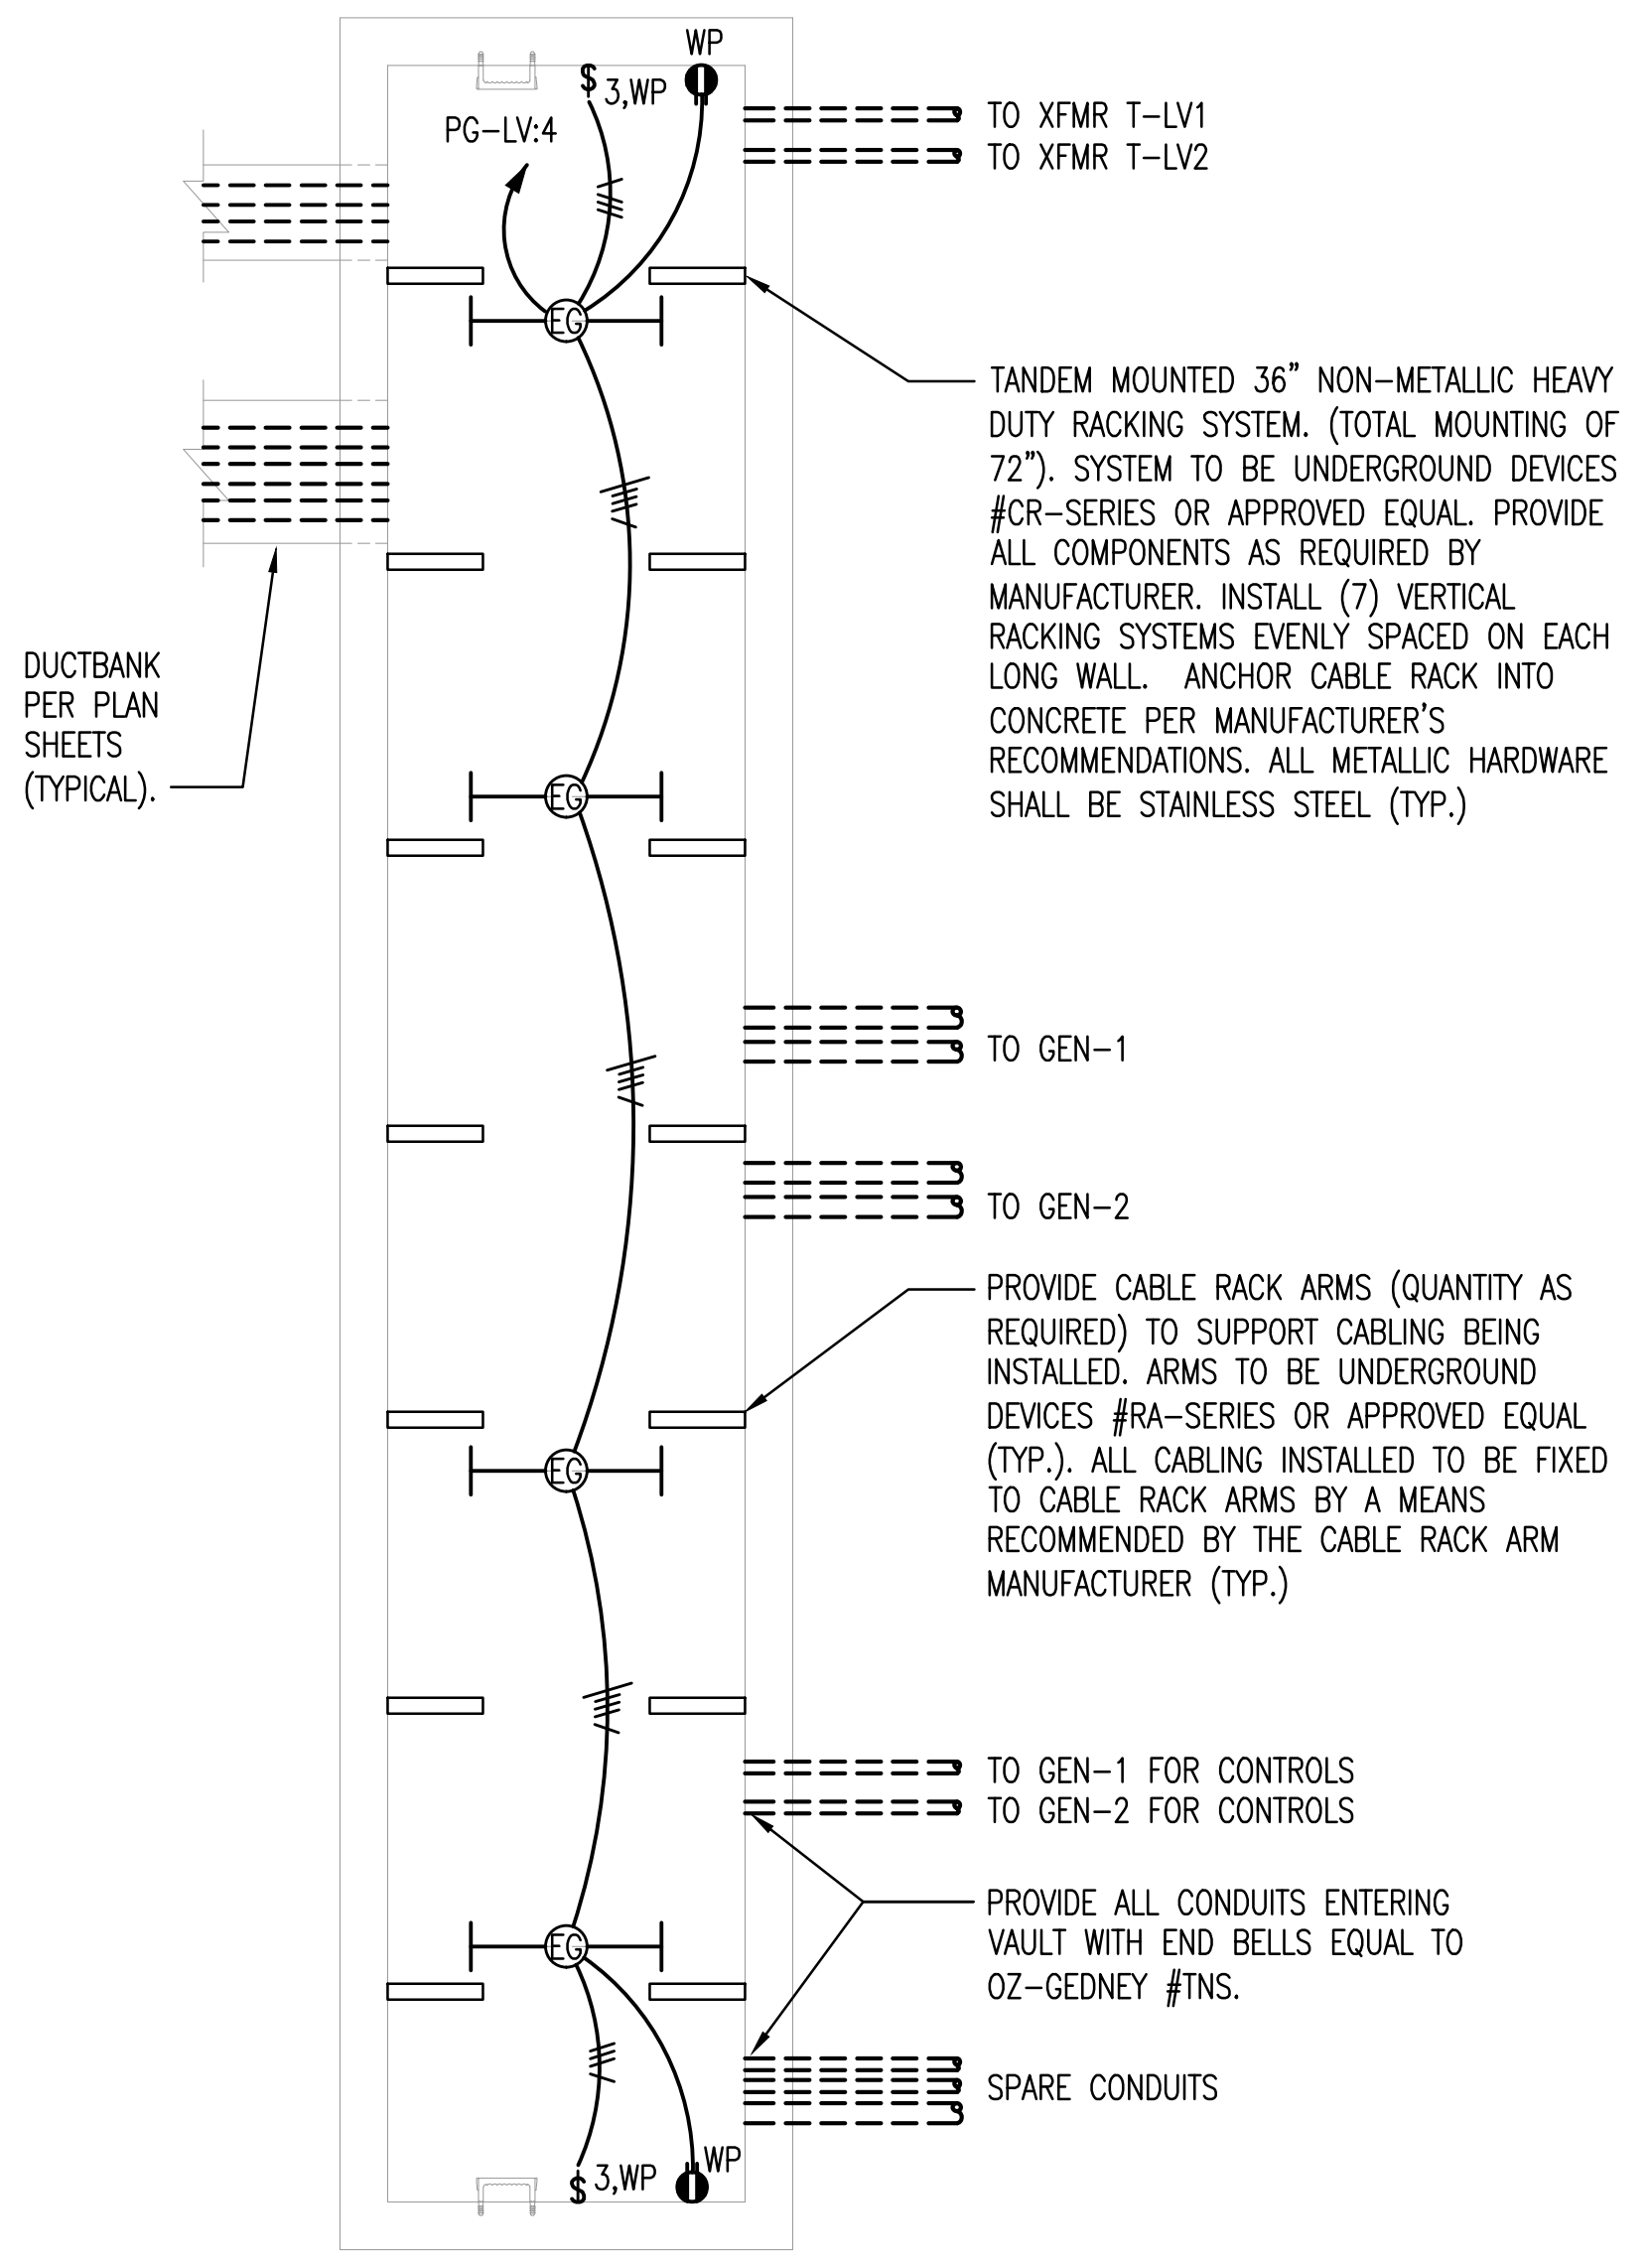

A VAULT ELECTRICAL PLAN
0' 4' 8' 12' 1/8"=1'-0"

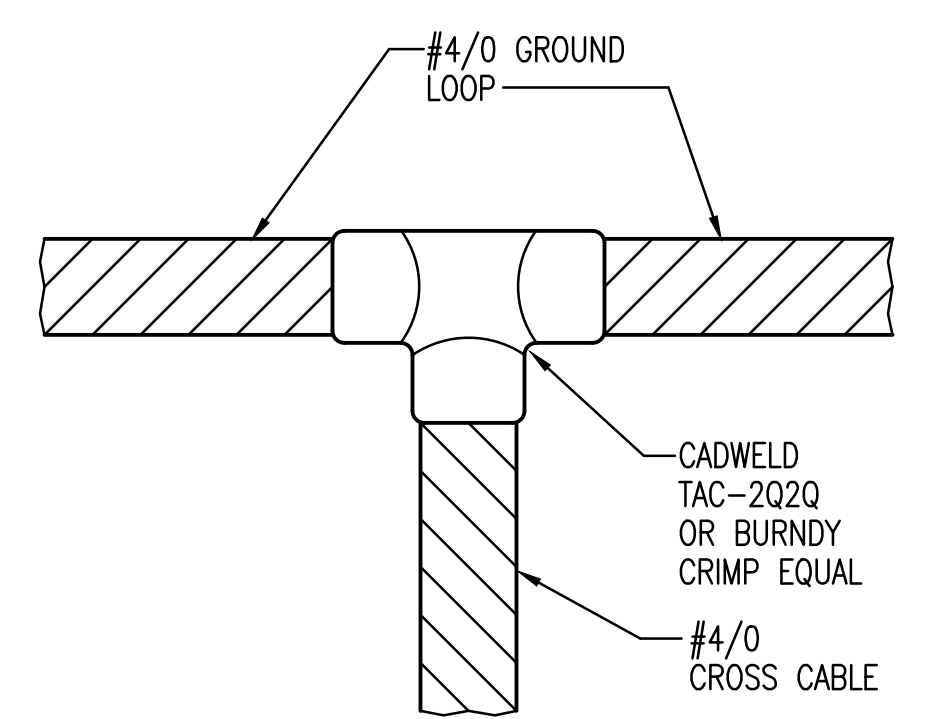


4 CABLE CONNECTION DETAIL
NO SCALE

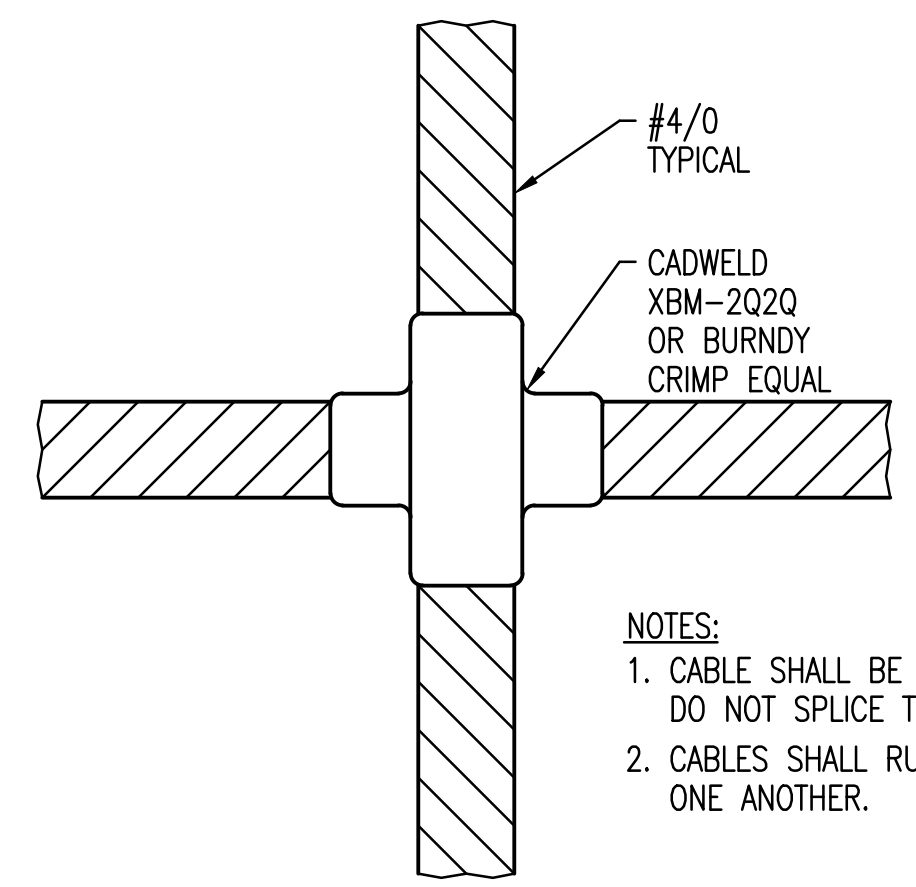

6 CABLE CONNECTION DETAIL
NO SCALE

- NOTES:
1. CABLE SHALL BE CONTINUOUS. DO NOT SPLICE TOGETHER.
 2. CABLES SHALL RUN ON TOP OF ONE ANOTHER.

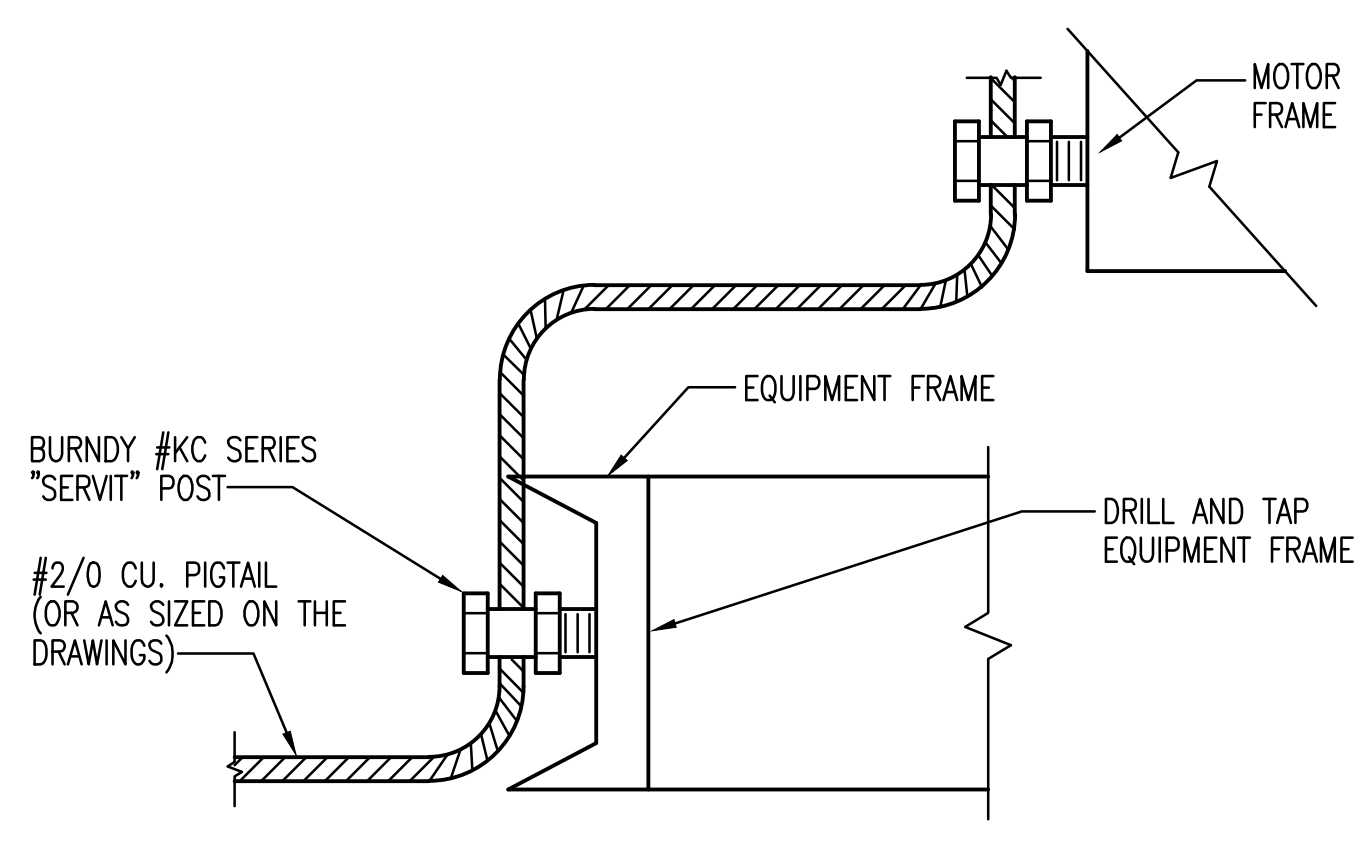


7 EQUIPMENT BONDING DETAIL
NO SCALE

Saved: 04-04-2016 1:20:22 PM by CJV
 Plot Scale: 1"=4'-0" (2016 12:27 PM)
 U:\Wichita-Facility\2014\14229\001\Elec\Drawings\As-Built\14229-001-E1.3 ELECTRICAL DETAILS


RECORD DOCUMENTS

THESE DOCUMENTS INCLUDE RECORD INFORMATION PROVIDED BY THE CONTRACTOR. THIS INFORMATION HAS NOT BEEN VERIFIED IN ITS ENTIRETY BY THE DESIGN PROFESSIONAL. DATE: FEBRUARY, 2016


ASI #6	6/30/15
ASI #4	6/25/15
ASI #2	6/18/15
ASI #1	5/26/15
FOR CONSTRUCTION SET	
No.	Revision
CITY OF WICHITA, KANSAS	
ELECTRICAL DETAILS	
WTP #2 EMERGENCY POWER PROJECT C.O.W. PROJECT NO. 468-84956	
PEC PROFESSIONAL ENGINEERING CONSULTANTS, P.A. 303 SOUTH TOPEKA WICHITA, KS 67202 316-262-2891 www.pec1.com	
Designed by	RWW
Job No.	34-14229-001-0042
Drawn by	CJV
Date	4/29/15
Sht. E.1.3 of 37	

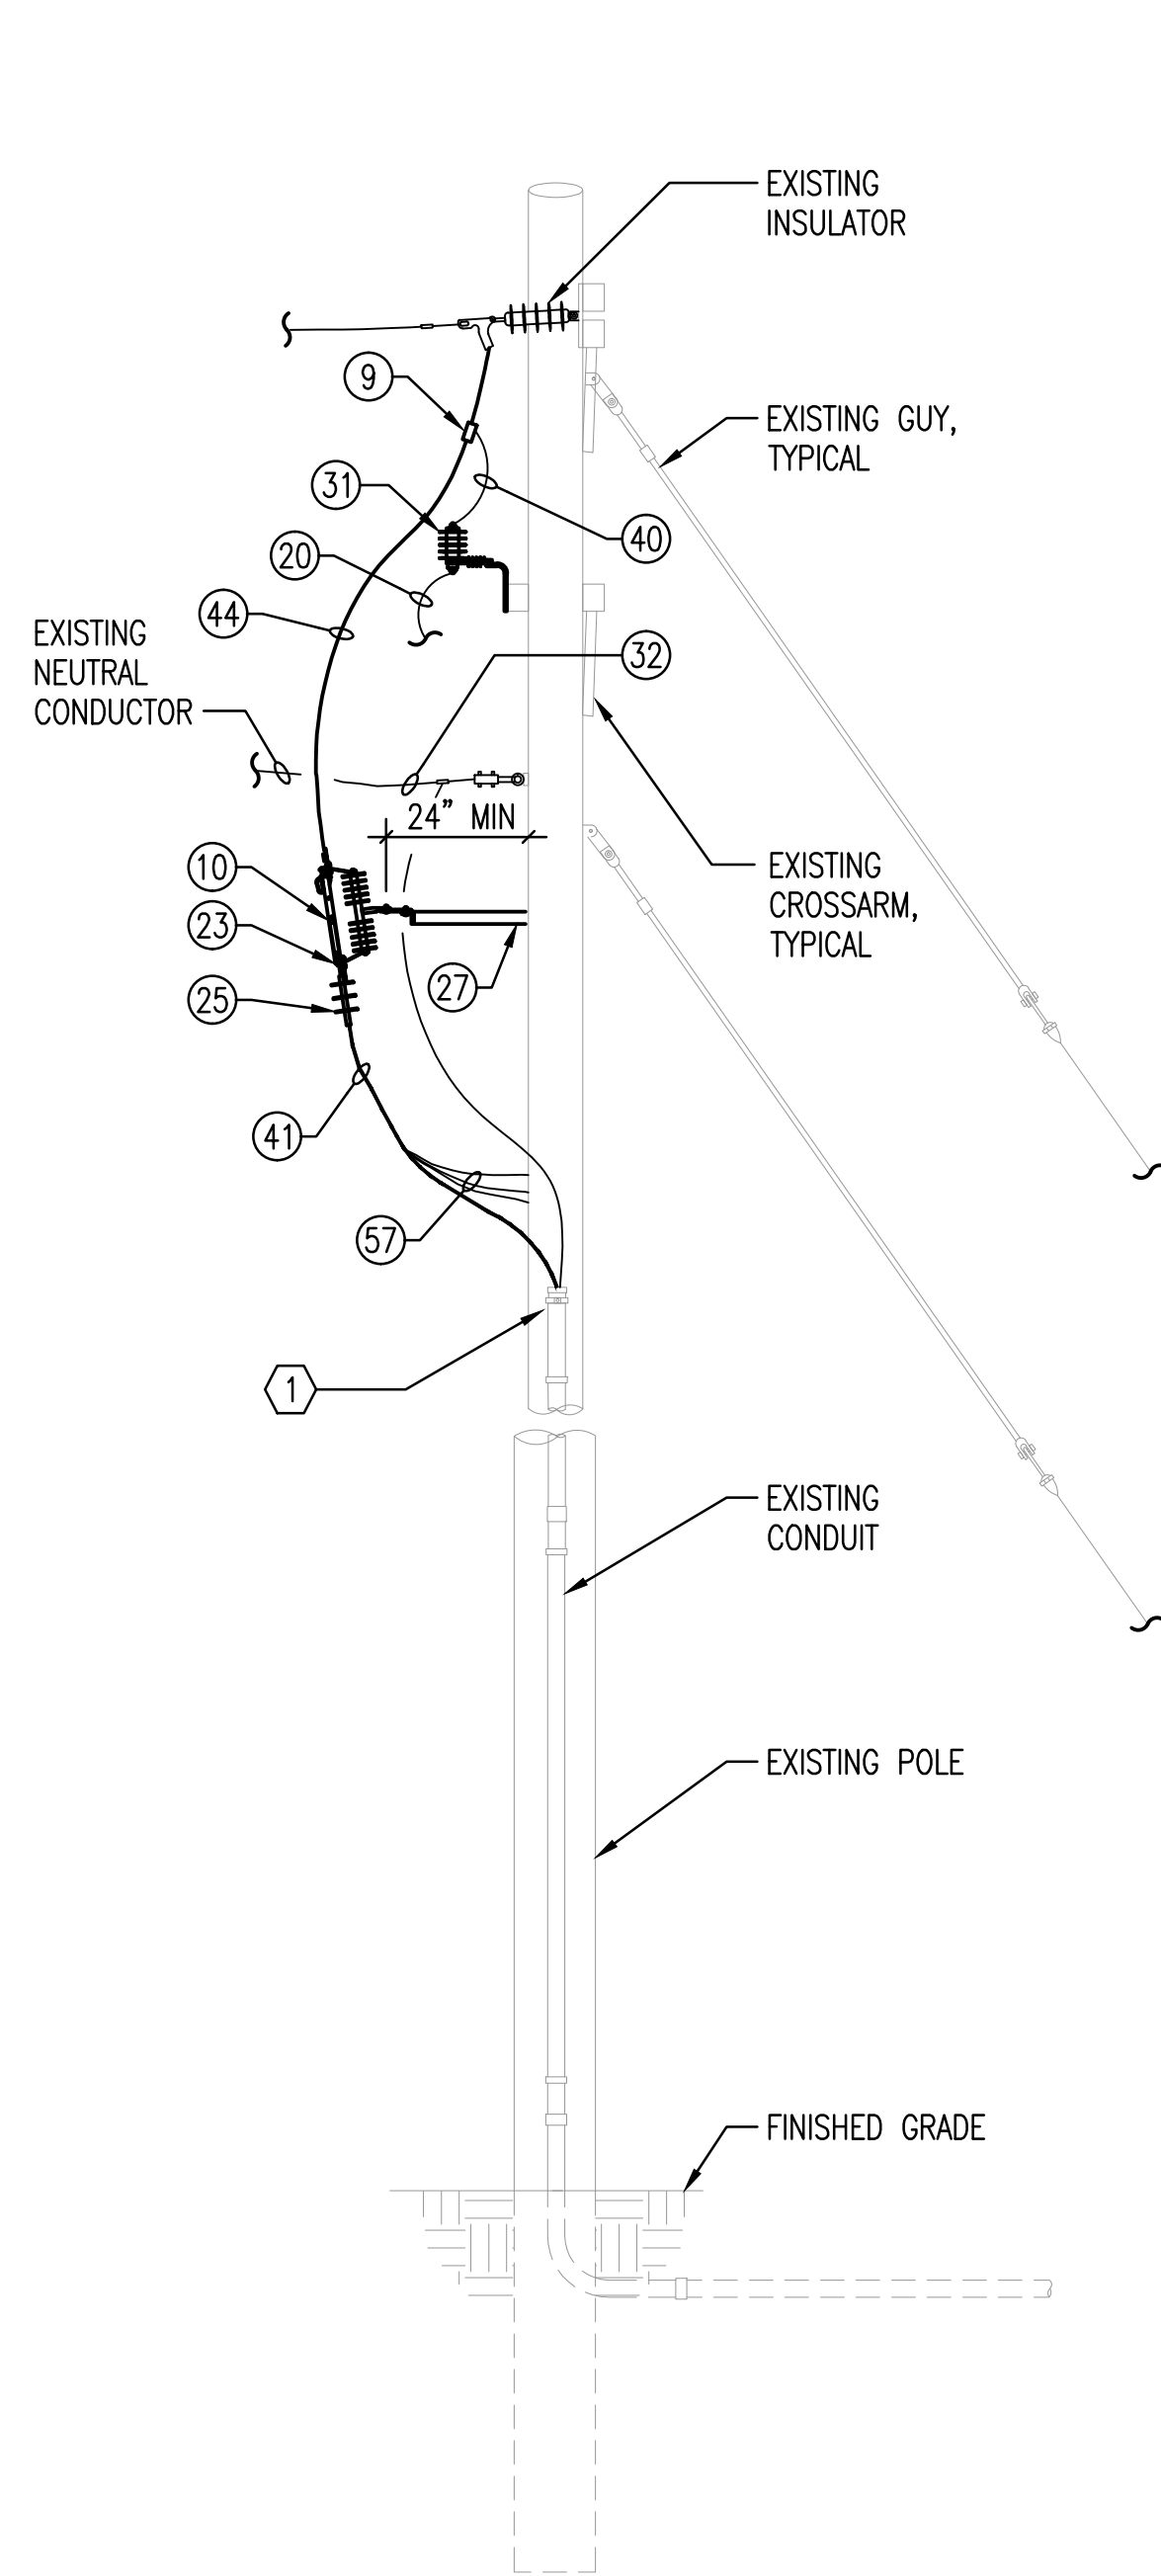


LONGITUDINAL ELEVATION

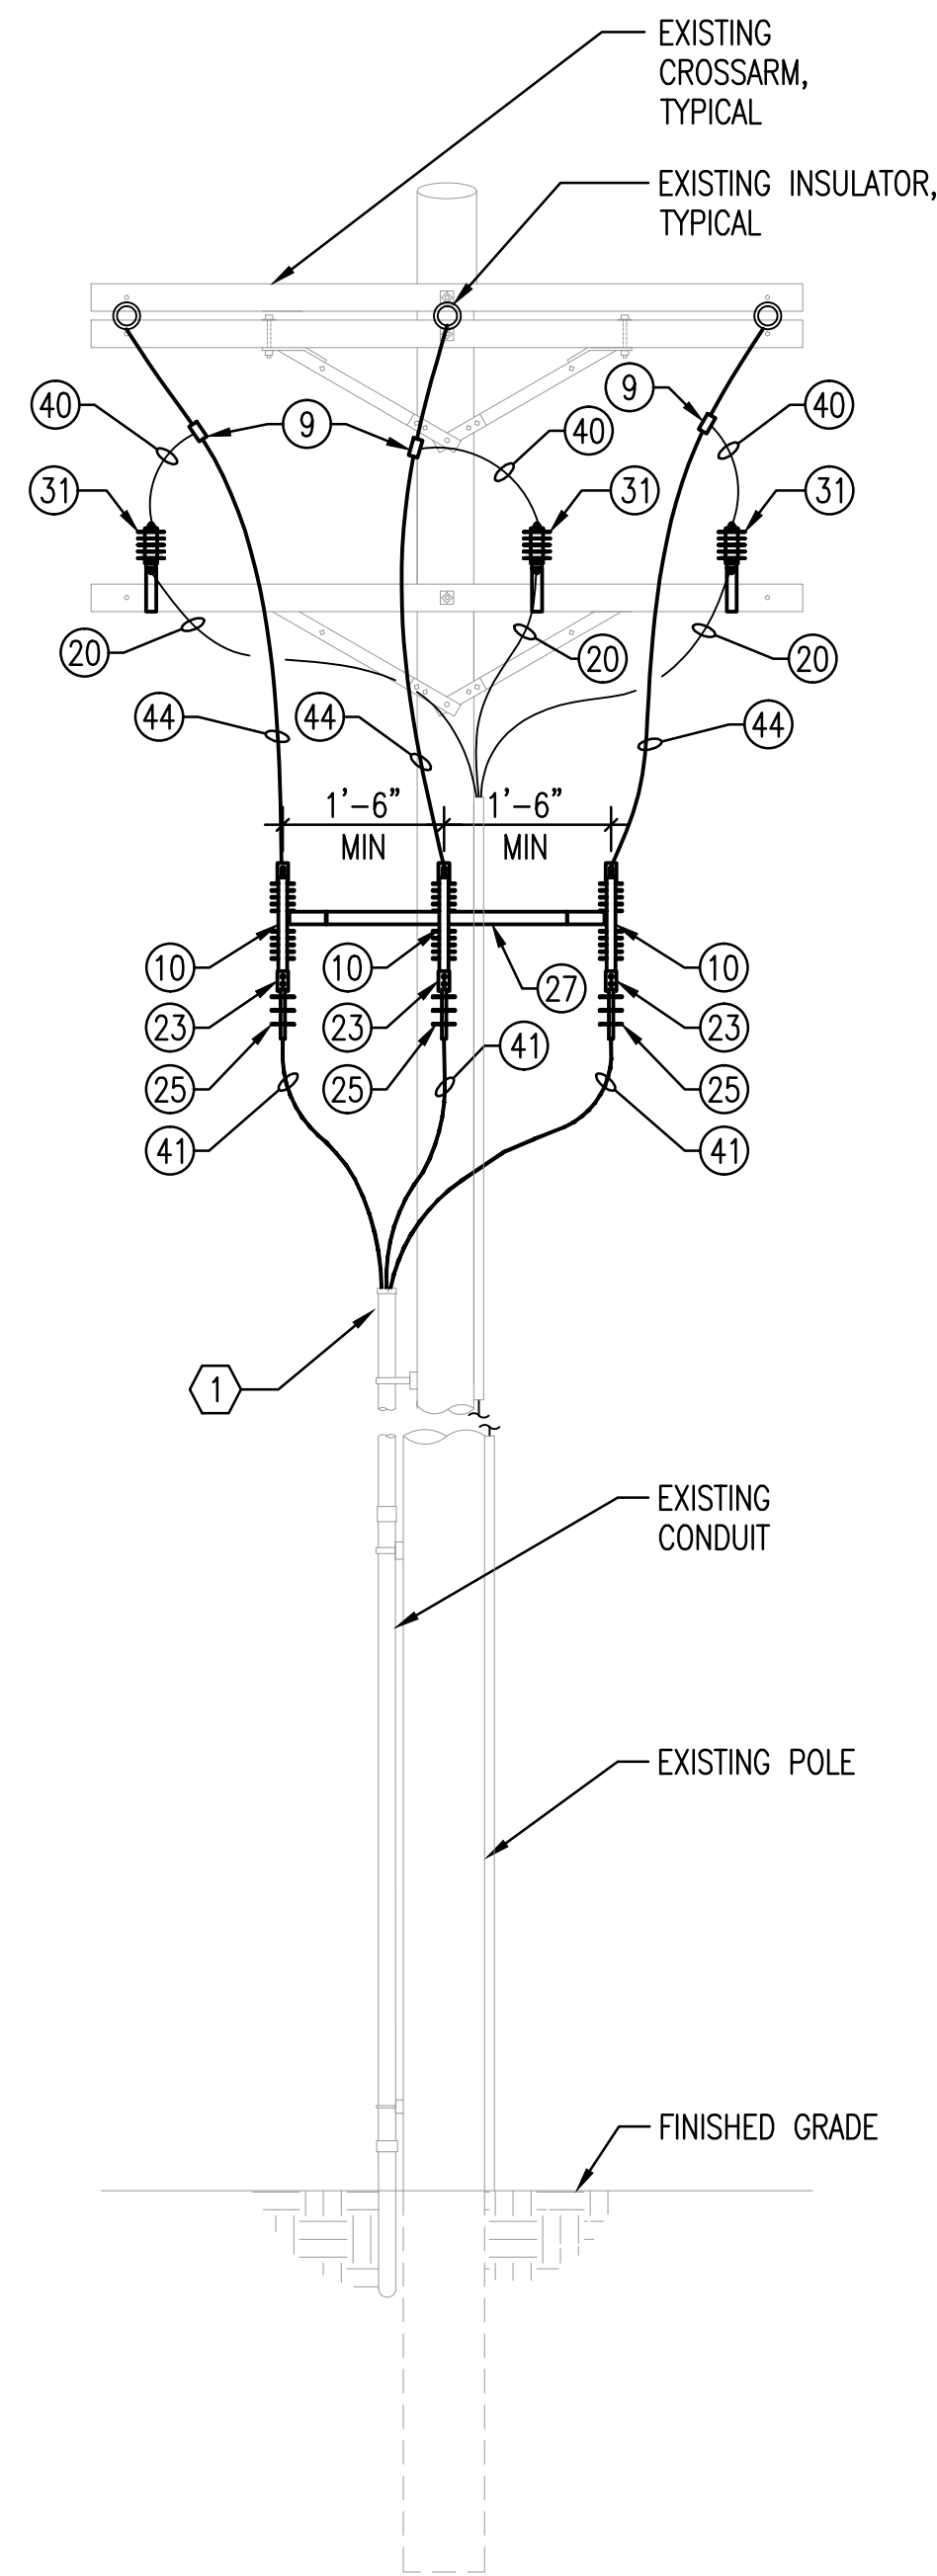

TRANSVERSE ELEVATION

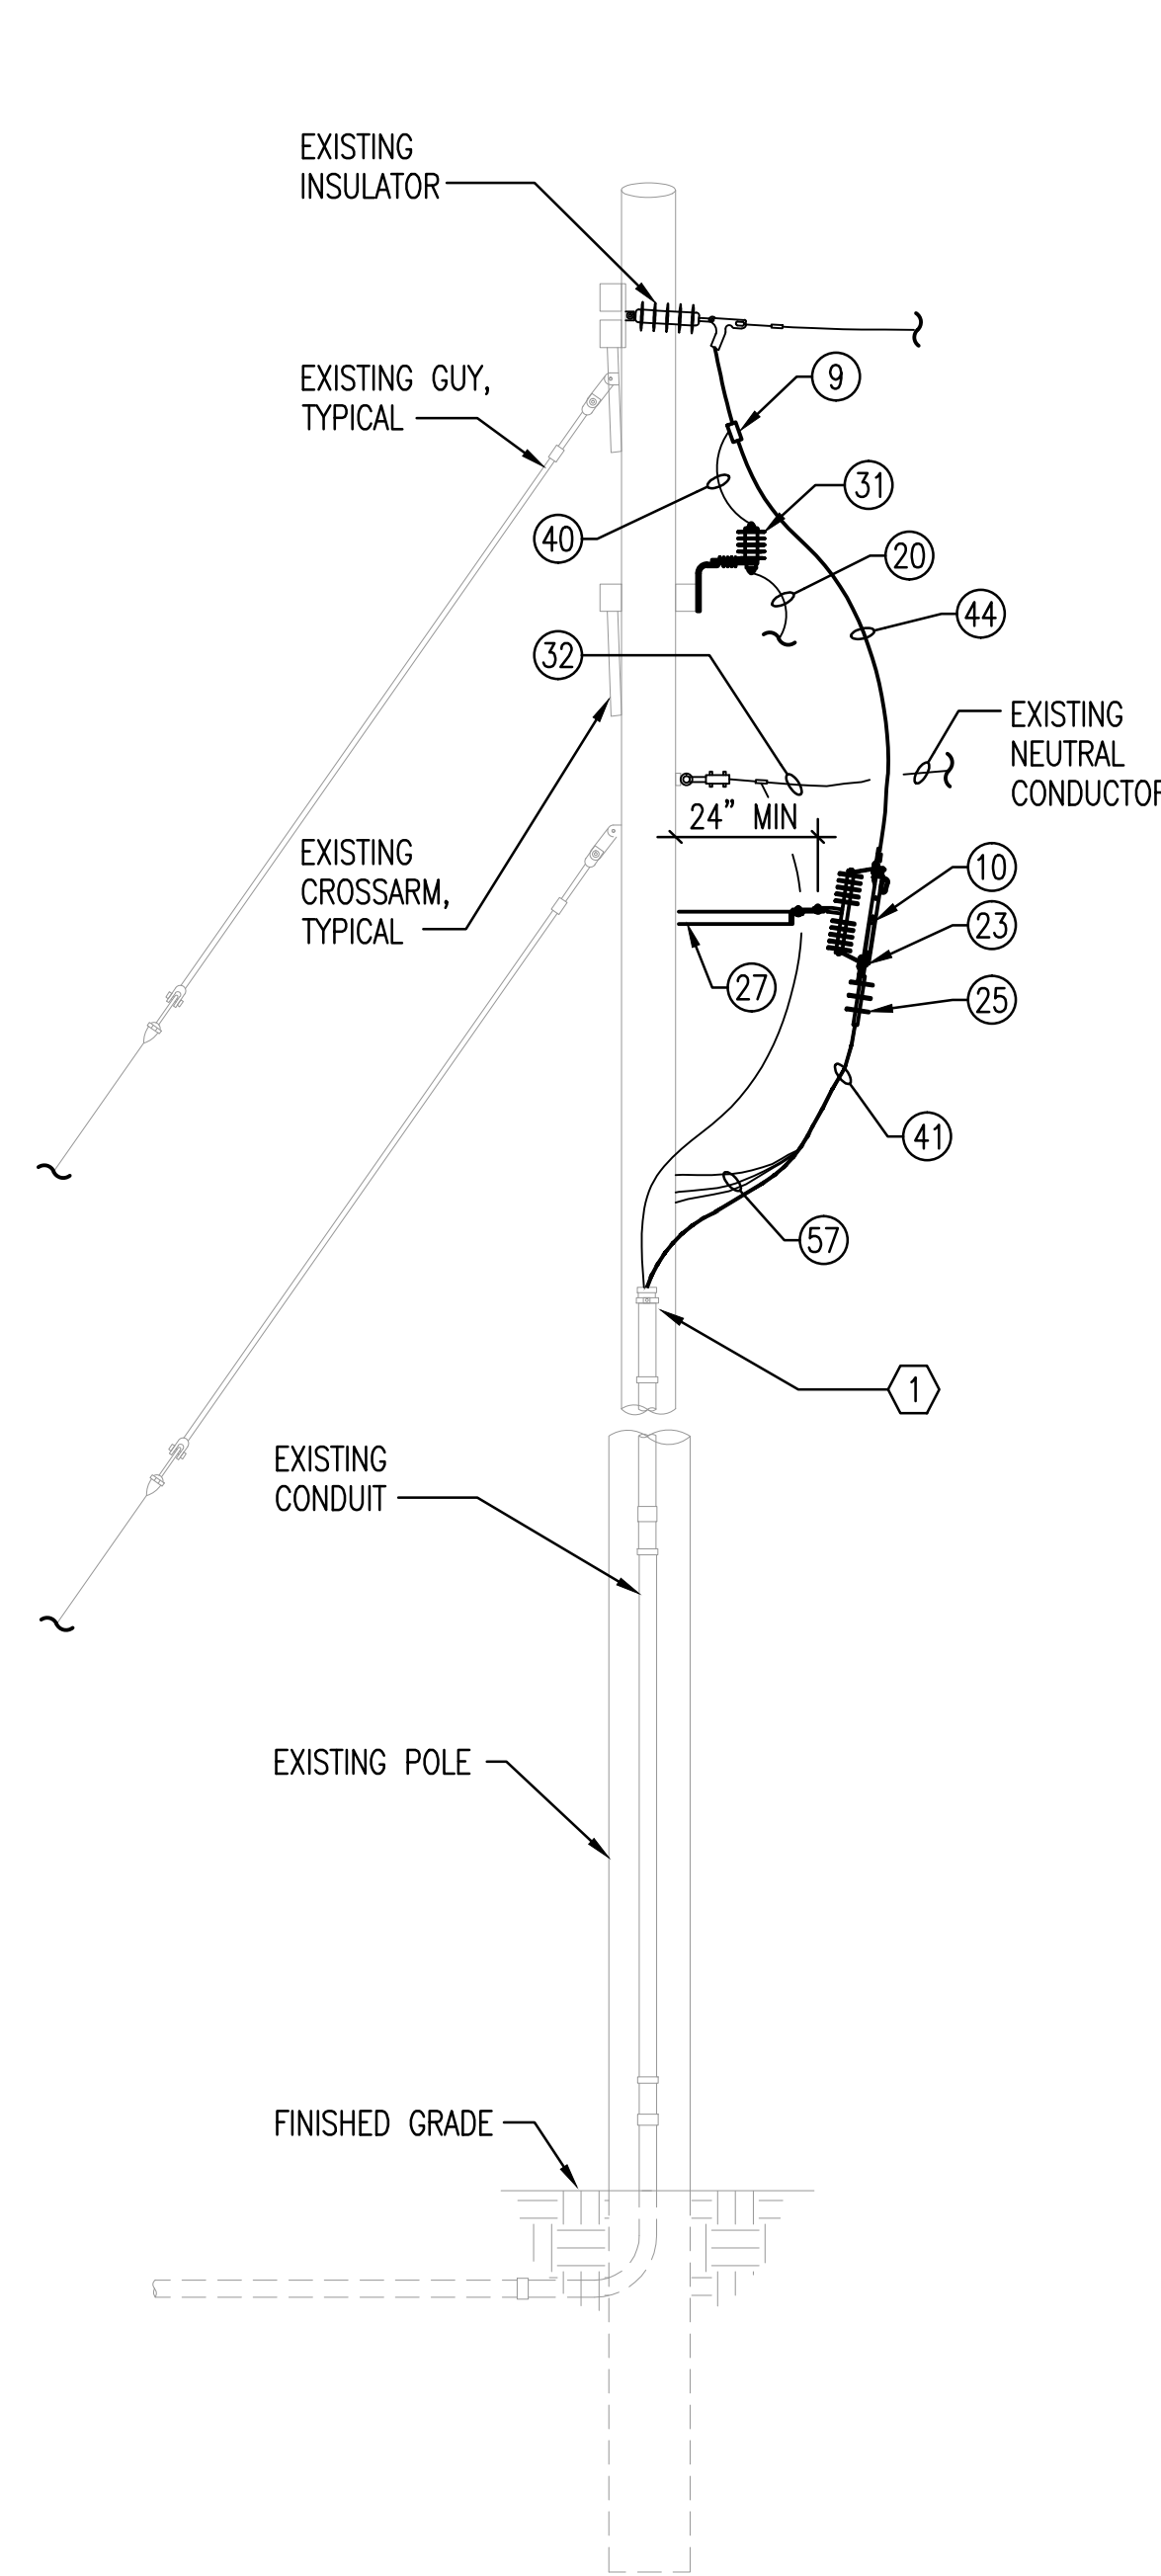

LONGITUDINAL ELEVATION

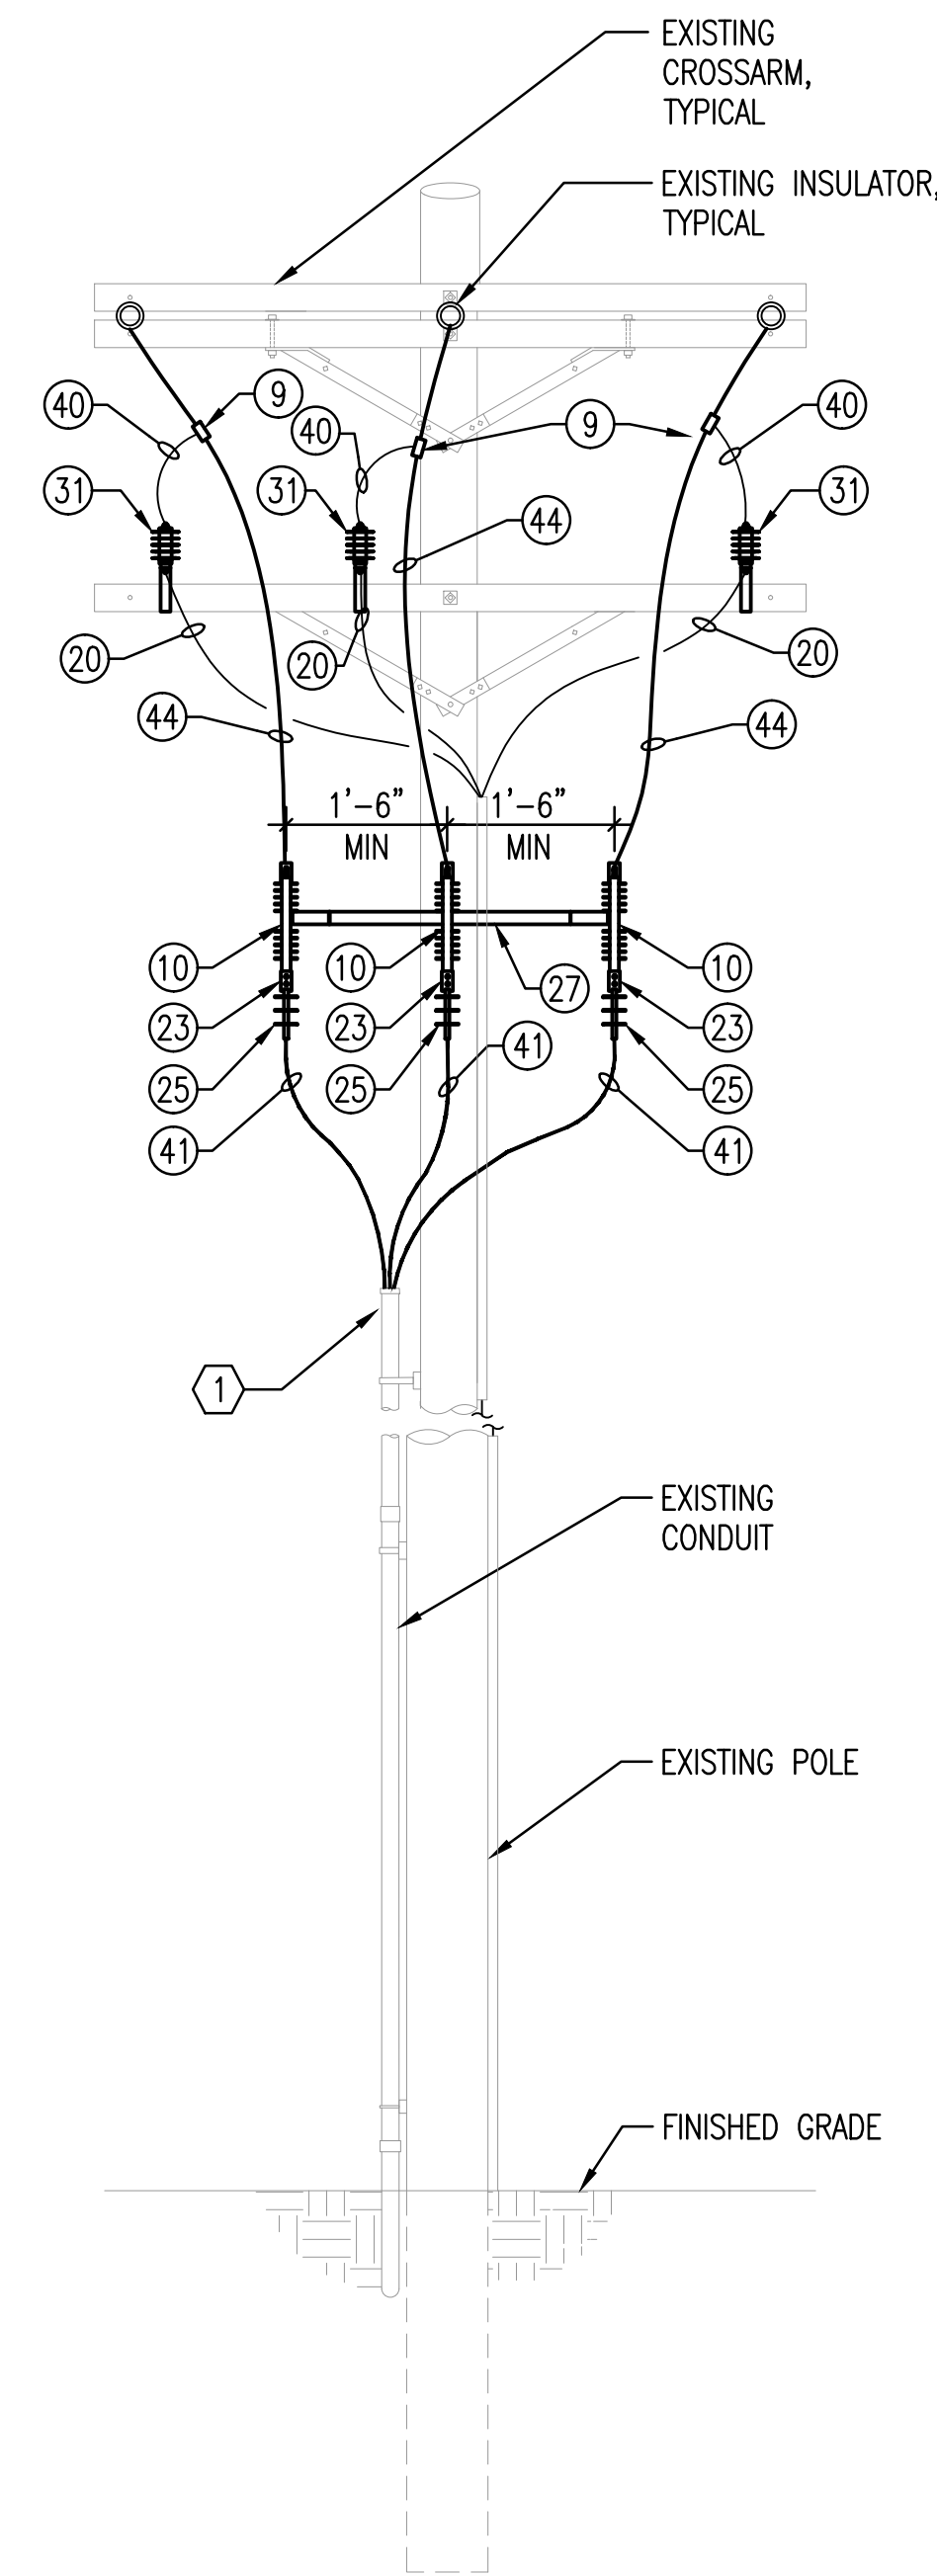

TRANSVERSE ELEVATION

1 POLE NORTH ELEVATIONS
NO SCALE

SCOPE OF WORK:

1. REMOVE EXISTING SURGE ARRESTORS.
2. UNTERMINATE MEDIUM VOLTAGE FEEDERS SERVING THE PLANT.
3. PROVIDE FUSED CUTOUTS, MOUNTING BRACKETS, AND 9.0 KV SURGE ARRESTORS AS SHOWN.
4. RECONNECT EXISTING MEDIUM VOLTAGE FEEDERS SERVING THE PLANT TO PROPOSED CUTOUTS.
5. PROVIDE MEDIUM VOLTAGE CONDUCTORS FROM EXISTING INSULATORS TO PROPOSED CUTOUTS.
6. PROVIDE ALL HARDWARE AS REQUIRED FOR A COMPLETE INSTALLATION.

2 POLE SOUTH ELEVATIONS
NO SCALE

SCHEDULE OF POLE EQUIPMENT	
NO.	DESCRIPTION
1	WOOD POLE, SEE POLE HEIGHT SCHEDULE
2	POLE BAND
4	INSULATOR, PIN TYPE, NEMA CLASS 54-1L, 15KV
5	PIN
6	INSULATOR, SUSPENSION TYPE, NEMA CLASS 52-1 OR 52-9, 15KV
7	EXTENSION LINK
8	QUADRANT STRAIN CLAMP, DEAD END (DISTRIBUTION)
9	TEE CONNECTOR, ALUMINUM; COMPRESSION
10	600A, 15.5KV SINGLE INSULATOR HOOK DISCONNECT SWITCH
11	CROSSARM ASSEMBLY
12	5/8" LOCK NUT
20	EXISTING GROUND CONNECTION #4 CU. TO POLE GROUND
22	BOLT, DOUBLE ARMING, 5/8" X REQ. LENGTH
23	TWO HOLE, LONG BARREL COMPRESSION LUG
25	15KV CABLE TERMINATOR
26	STAPLES, INSTALL 2'-6" O.C.
27	SWITCH MOUNTING BRACKET
30	EYE NUT; 5/8"
31	SURGE ARRESTOR; MOV, 9.0 KV MCOV
32	EXISTING #4/0 CU NEUTRAL, BOND TO O.H. NEUTRAL
33	#4 SOLID CU WIRE, GROUND
34	GROUNDING JUMPER, #4 COPPER
35	MOULDING; 1/2"
38	STAND-OFF BRACKET, FOR CONDUIT SUPPORT
40	EXISTING CONDUCTOR - 4/0 DAISY AAC CONDUCTOR TO CORNER POLE (ALLOWABLE AMPACITY 403A BASED ON AMBIENT 25°C, CONDUCTOR 75°C, WIND 2 FT/SEC, SUN)
41	EXISTING 3#500KCMIL CU, #4/0 GND 15KV EPR 133% POWER SHIELDED CABLE, TYPE MV-105
42	5" RGS CONDUIT
43	5" PVC COATED RGS ELBOW AND RISER TO BE ABOVE GRADE
44	CONDUCTOR - 447 ACSR PELICAN TO CORNER POLE (ALLOWABLE AMPACITY 646A BASED ON AMBIENT 25°C, CONDUCTOR 75°C, WIND 2 FT/SEC, SUN)
45	GUY WIRE
46	CONDUIT - SCHEDULE 40 PVC
47	PVC TO RGS CONDUIT COUPLING
48	PVC COATED RGS CONDUIT COUPLING
49	ROD, GROUND, 5/8" MIN. DIAMETER
50	CONCRETE ENCASES EPC-40-PVC, 5"
51	NEUTRAL CONDUCTOR - 4/0 ACSR PENGUIN
52	5/8" X AS REQ. LENGTH DIA. BOLT
53	CONDUIT/PIPE HANGER
54	EYENUT
56	13/16" SQ. WASHER
57	EXISTING #4 CU BONDING CONDUCTORS TO TAPE SHIELD
60	SEAL TOP OF CONDUIT
61	COPPER COMPRESSION CONNECTOR
62	ANCHORS, SHACKLE
63	CABLE SUPPORT
64	EYE SCREW, ELLIPTICAL OR DRIVE HOOK
65	CLAMP, GROUND ROD
66	INSULATOR, PIN TYPE, NEMA CLASS 54-1L, 15KV, WHITE
67	LETTERS, 2" C, 2" N, WITH 1" NAILS
68	5" PVC COATED RGS CONDUIT
69	CONCRETE ENCASEMENT
70	BUTT GROUND
71	HIGH STRENGTH DOUBLE CROSSARM

GENERAL NOTES:

1. COORDINATE ALL OVERHEAD WORK WITH UTILITY COMPANY.
2. COORDINATE ALL POWER OUTAGES WITH OWNER AND UTILITY COMPANY. REFERENCE SPECIFICATIONS.

KEYED NOTES:

1	▲ CUT BACK CONDUIT AS REQUIRED TO ALLOW ROOM FOR MEDIUM VOLTAGE CUTOUTS AND STAND-OFF BRACKET. PROVIDE BUSHING ON END OF CONDUIT.	ASI #6 6/30/15	ASI #2 6/25/15	ASI #1 6/18/15	5/26/15
---	---	-------------------	-------------------	-------------------	---------

RECORD DOCUMENTS			
FOR CONSTRUCTION SET			
No.	Revision	By	Date

THESE DOCUMENTS INCLUDE RECORD INFORMATION PROVIDED BY THE CONTRACTOR. THIS INFORMATION HAS NOT BEEN VERIFIED IN ITS ENTIRETY BY THE DESIGN PROFESSIONAL.
DATE: FEBRUARY, 2016

CITY OF WICHITA, KANSAS
ELECTRICAL DETAILS


WWTP #2 EMERGENCY POWER PROJECT
C.O.W. PROJECT NO. 468-84956

PEC PROFESSIONAL ENGINEERING CONSULTANTS, P.A.
303 SOUTH TOPEKA WICHITA, KS 67202
316-262-2891 www.pec1.com


Designed by RWW Job No. 34-14229-001-0042
Drawn by CJV Date 4/29/15

Sht. E1.4 of 37

THIS PLAN IS FOR LOCATION REFERENCES ONLY. DO NOT SCALE OFF OF THESE DRAWINGS.

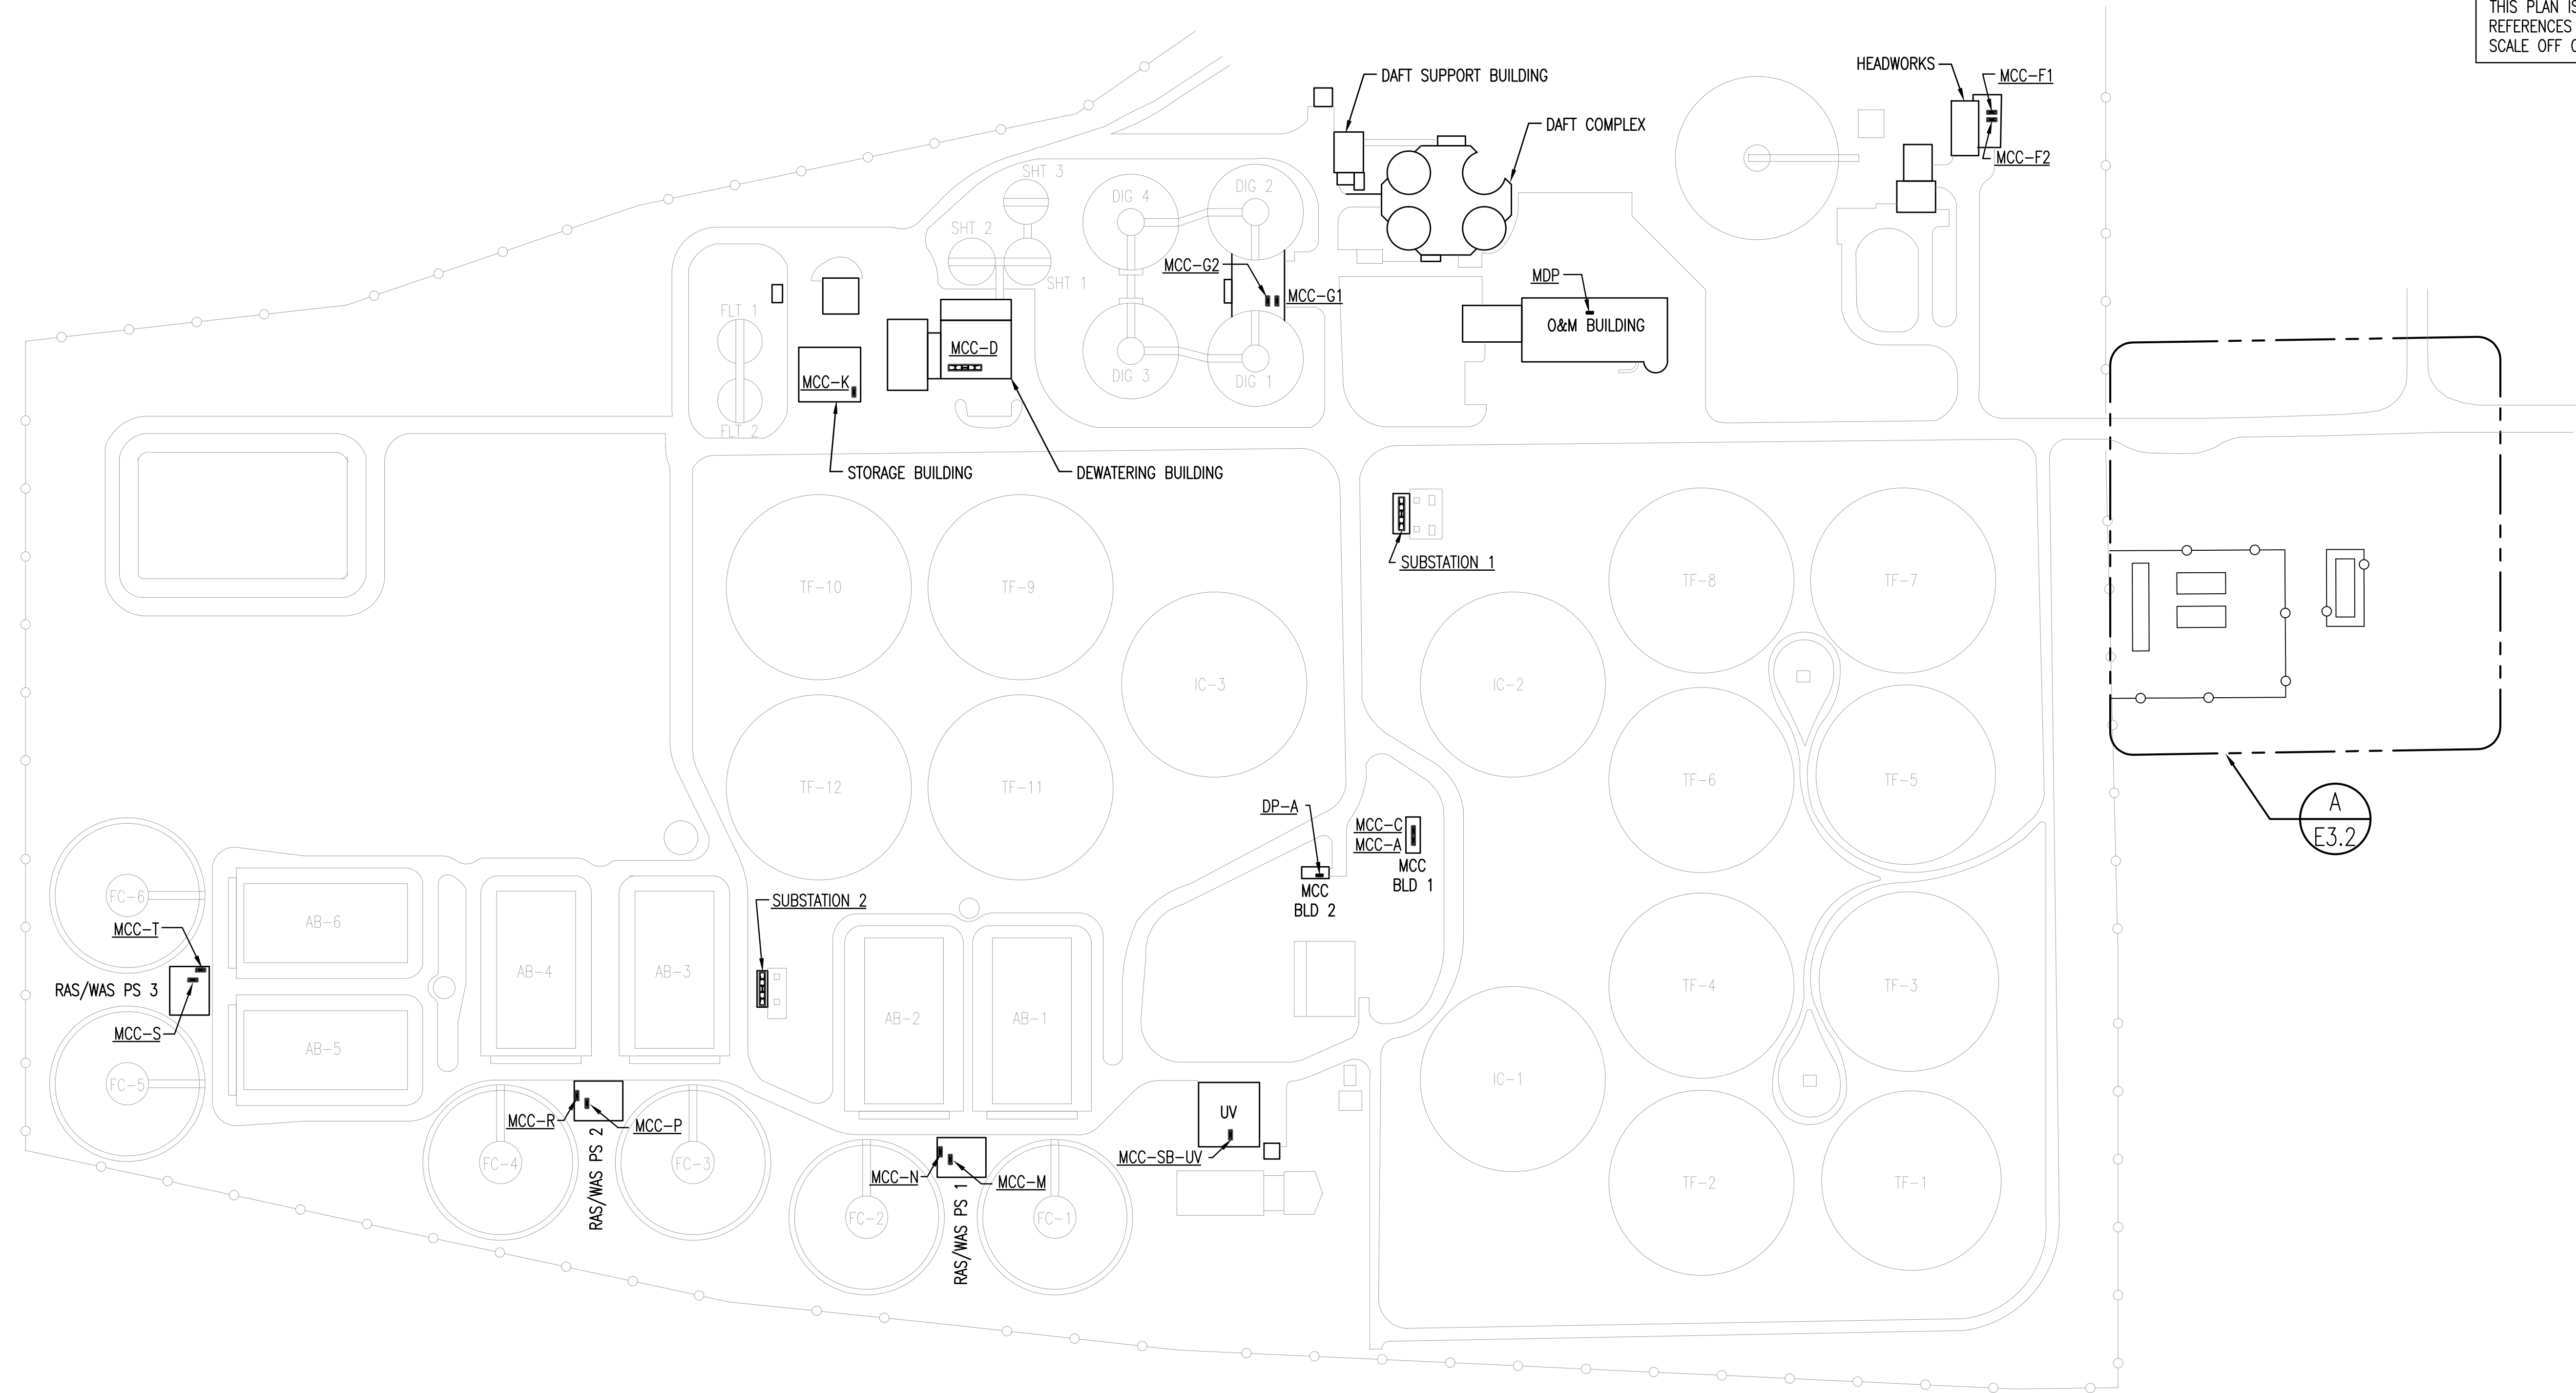

A ELECTRICAL SITE MAP
NO SCALE

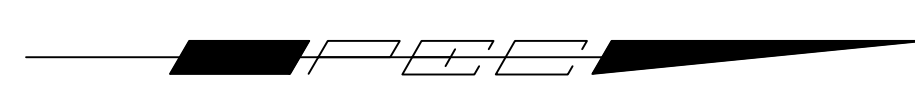


▲	ASI #6	6/30/15
▲	ASI #4	6/25/15
▲	ASI #2	6/18/15
▲	ASI #1	5/26/15
FOR CONSTRUCTION SET		4/29/15

RECORD DOCUMENTS
THESE DOCUMENTS INCLUDE RECORD INFORMATION PROVIDED BY THE CONTRACTOR. THIS INFORMATION HAS NOT BEEN VERIFIED IN ITS ENTIRETY BY THE DESIGN PROFESSIONAL.
DATE: FEBRUARY, 2016

No.	Revision	By	Date
CITY OF WICHITA, KANSAS			
ELECTRICAL SITE MAP			
WWTP #2 EMERGENCY POWER PROJECT C.O.W. PROJECT NO. 468-84956			
 PEC PROFESSIONAL ENGINEERING CONSULTANTS, P.A. 303 SOUTH TOPEKA WICHITA, KS 67202 316-262-2891 www.pec1.com			
Designed by	RWW	Job No. 34-14229-001-0042	Sht. E3.1 of 37
Drawn by	CJV	Date 4/29/15	

Saved: 04-04-2016 1:00:03 PM by: CJV
 Plot: 04-04-2016 1:01:04 PM by: CJV
 U:\Wichita-Facilities\14229\001\Elec\Drawings\As-Built\14229-001-E3.1 ELECTRICAL SITE MAP

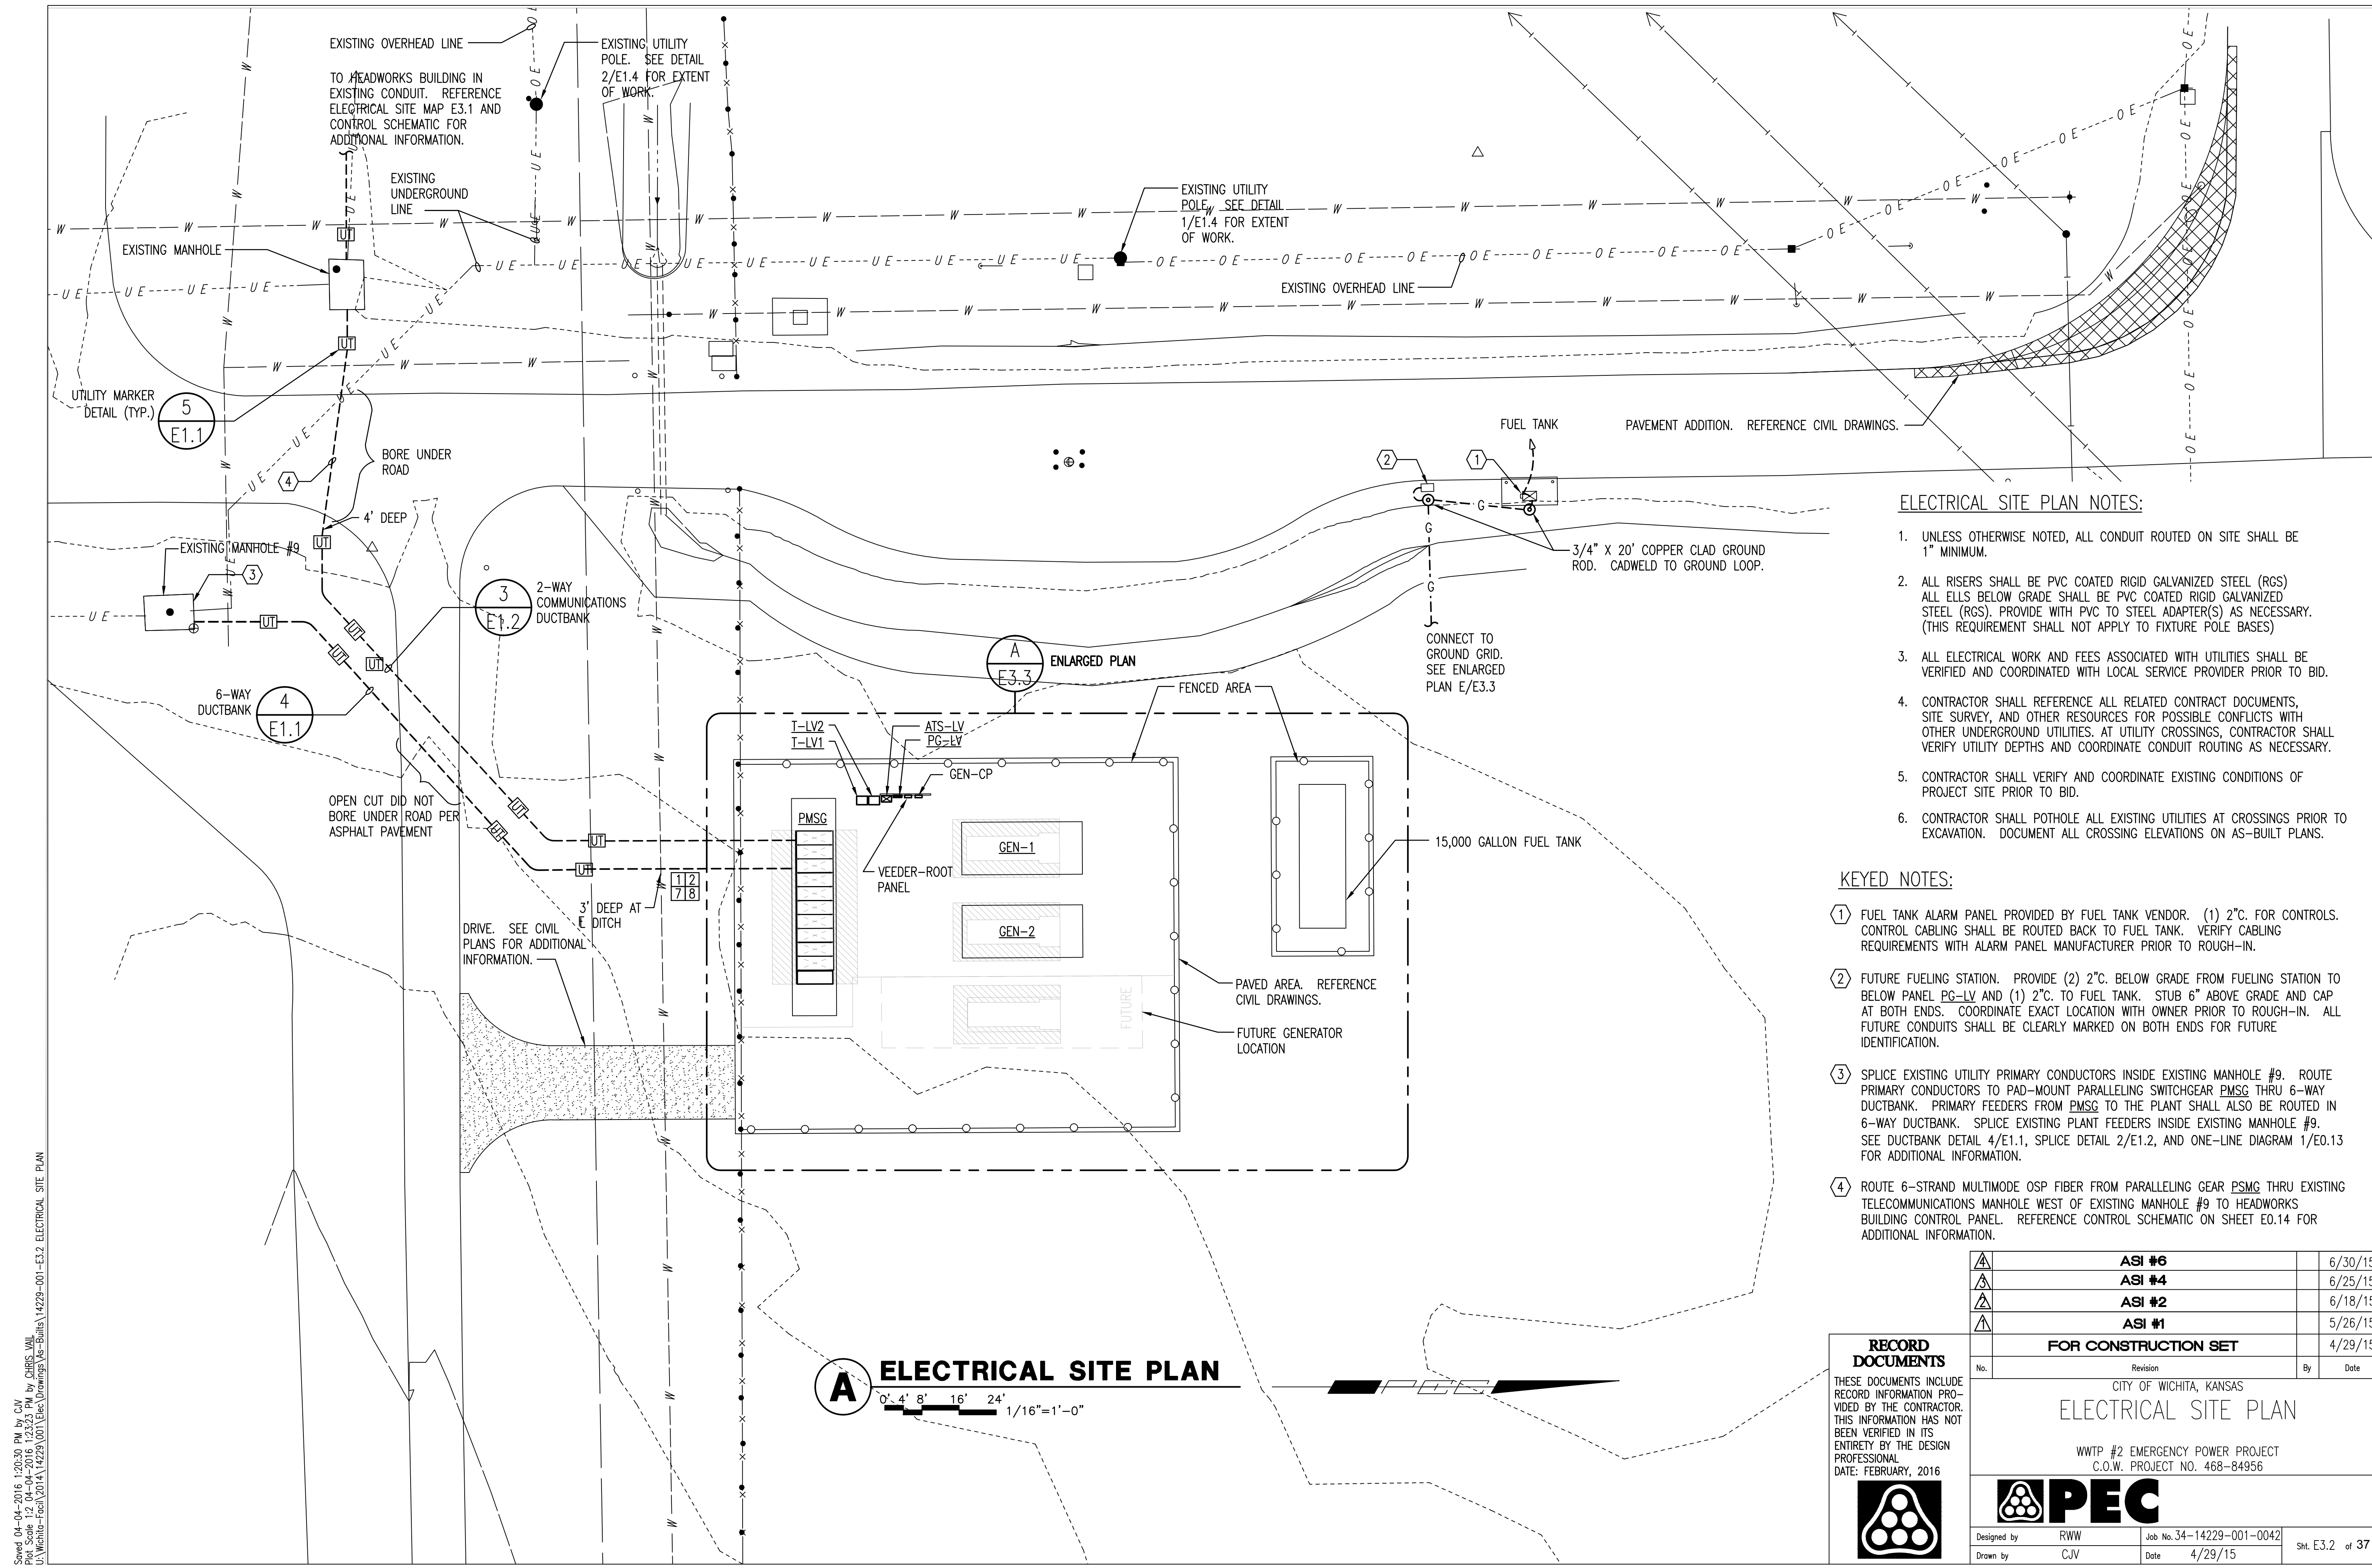

- ELECTRICAL SITE PLAN NOTES:**
- UNLESS OTHERWISE NOTED, ALL CONDUIT ROUTED ON SITE SHALL BE 1" MINIMUM.
 - ALL RISERS SHALL BE PVC COATED RIGID GALVANIZED STEEL (RGS) ALL ELLS BELOW GRADE SHALL BE PVC COATED RIGID GALVANIZED STEEL (RGS). PROVIDE WITH PVC TO STEEL ADAPTER(S) AS NECESSARY. (THIS REQUIREMENT SHALL NOT APPLY TO FIXTURE POLE BASES)
 - ALL ELECTRICAL WORK AND FEES ASSOCIATED WITH UTILITIES SHALL BE VERIFIED AND COORDINATED WITH LOCAL SERVICE PROVIDER PRIOR TO BID.
 - CONTRACTOR SHALL REFERENCE ALL RELATED CONTRACT DOCUMENTS, SITE SURVEY, AND OTHER RESOURCES FOR POSSIBLE CONFLICTS WITH OTHER UNDERGROUND UTILITIES. AT UTILITY CROSSINGS, CONTRACTOR SHALL VERIFY UTILITY DEPTHS AND COORDINATE CONDUIT ROUTING AS NECESSARY.
 - CONTRACTOR SHALL VERIFY AND COORDINATE EXISTING CONDITIONS OF PROJECT SITE PRIOR TO BID.
 - CONTRACTOR SHALL POTHOLE ALL EXISTING UTILITIES AT CROSSINGS PRIOR TO EXCAVATION. DOCUMENT ALL CROSSING ELEVATIONS ON AS-BUILT PLANS.

- KEYED NOTES:**
- FUEL TANK ALARM PANEL PROVIDED BY FUEL TANK VENDOR. (1) 2" C. FOR CONTROLS. CONTROL CABLING SHALL BE ROUTED BACK TO FUEL TANK. VERIFY CABLING REQUIREMENTS WITH ALARM PANEL MANUFACTURER PRIOR TO ROUGH-IN.
 - FUTURE FUELING STATION. PROVIDE (2) 2" C. BELOW GRADE FROM FUELING STATION TO BELOW PANEL PG-LV AND (1) 2" C. TO FUEL TANK. STUB 6" ABOVE GRADE AND CAP AT BOTH ENDS. COORDINATE EXACT LOCATION WITH OWNER PRIOR TO ROUGH-IN. ALL FUTURE CONDUITS SHALL BE CLEARLY MARKED ON BOTH ENDS FOR FUTURE IDENTIFICATION.
 - SPLICE EXISTING UTILITY PRIMARY CONDUCTORS INSIDE EXISTING MANHOLE #9. ROUTE PRIMARY CONDUCTORS TO PAD-MOUNT PARALLELING SWITCHGEAR PMSG THRU 6-WAY DUCTBANK. PRIMARY FEEDERS FROM PMSG TO THE PLANT SHALL ALSO BE ROUTED IN 6-WAY DUCTBANK. SPLICE EXISTING PLANT FEEDERS INSIDE EXISTING MANHOLE #9. SEE DUCTBANK DETAIL 4/E1.1, SPLICE DETAIL 2/E1.2, AND ONE-LINE DIAGRAM 1/E0.13 FOR ADDITIONAL INFORMATION.
 - ROUTE 6-STRAND MULTIMODE OSP FIBER FROM PARALLELING GEAR PMSG THRU EXISTING TELECOMMUNICATIONS MANHOLE WEST OF EXISTING MANHOLE #9 TO HEADWORKS BUILDING CONTROL PANEL. REFERENCE CONTROL SCHEMATIC ON SHEET E0.14 FOR ADDITIONAL INFORMATION.


▲	ASI #6	6/30/15
▲	ASI #4	6/25/15
▲	ASI #2	6/18/15
▲	ASI #1	5/26/15
FOR CONSTRUCTION SET		4/29/15

RECORD DOCUMENTS
 THESE DOCUMENTS INCLUDE RECORD INFORMATION PROVIDED BY THE CONTRACTOR. THIS INFORMATION HAS NOT BEEN VERIFIED IN ITS ENTIRETY BY THE DESIGN PROFESSIONAL.
 DATE: FEBRUARY, 2016

CITY OF WICHITA, KANSAS		By		Date	
ELECTRICAL SITE PLAN					
WTP #2 EMERGENCY POWER PROJECT C.O.W. PROJECT NO. 468-84956					
PEC					
Designed by	RWW	Job No. 34-14229-001-0042			
Drawn by	CJV	Date	4/29/15	Sht. E3.2 of 37	

A ELECTRICAL SITE PLAN
 0' 4' 8' 16' 24' 1/16"=1'-0"

Saved: 04-04-2016, 1:20:30 PM by CJV
 Plot Size: 11.70 x 17.00
 U:\Wichita-Facility\2014\14229\001\Elec\Drawings\As-Built\14229-001-E3.2 ELECTRICAL SITE PLAN

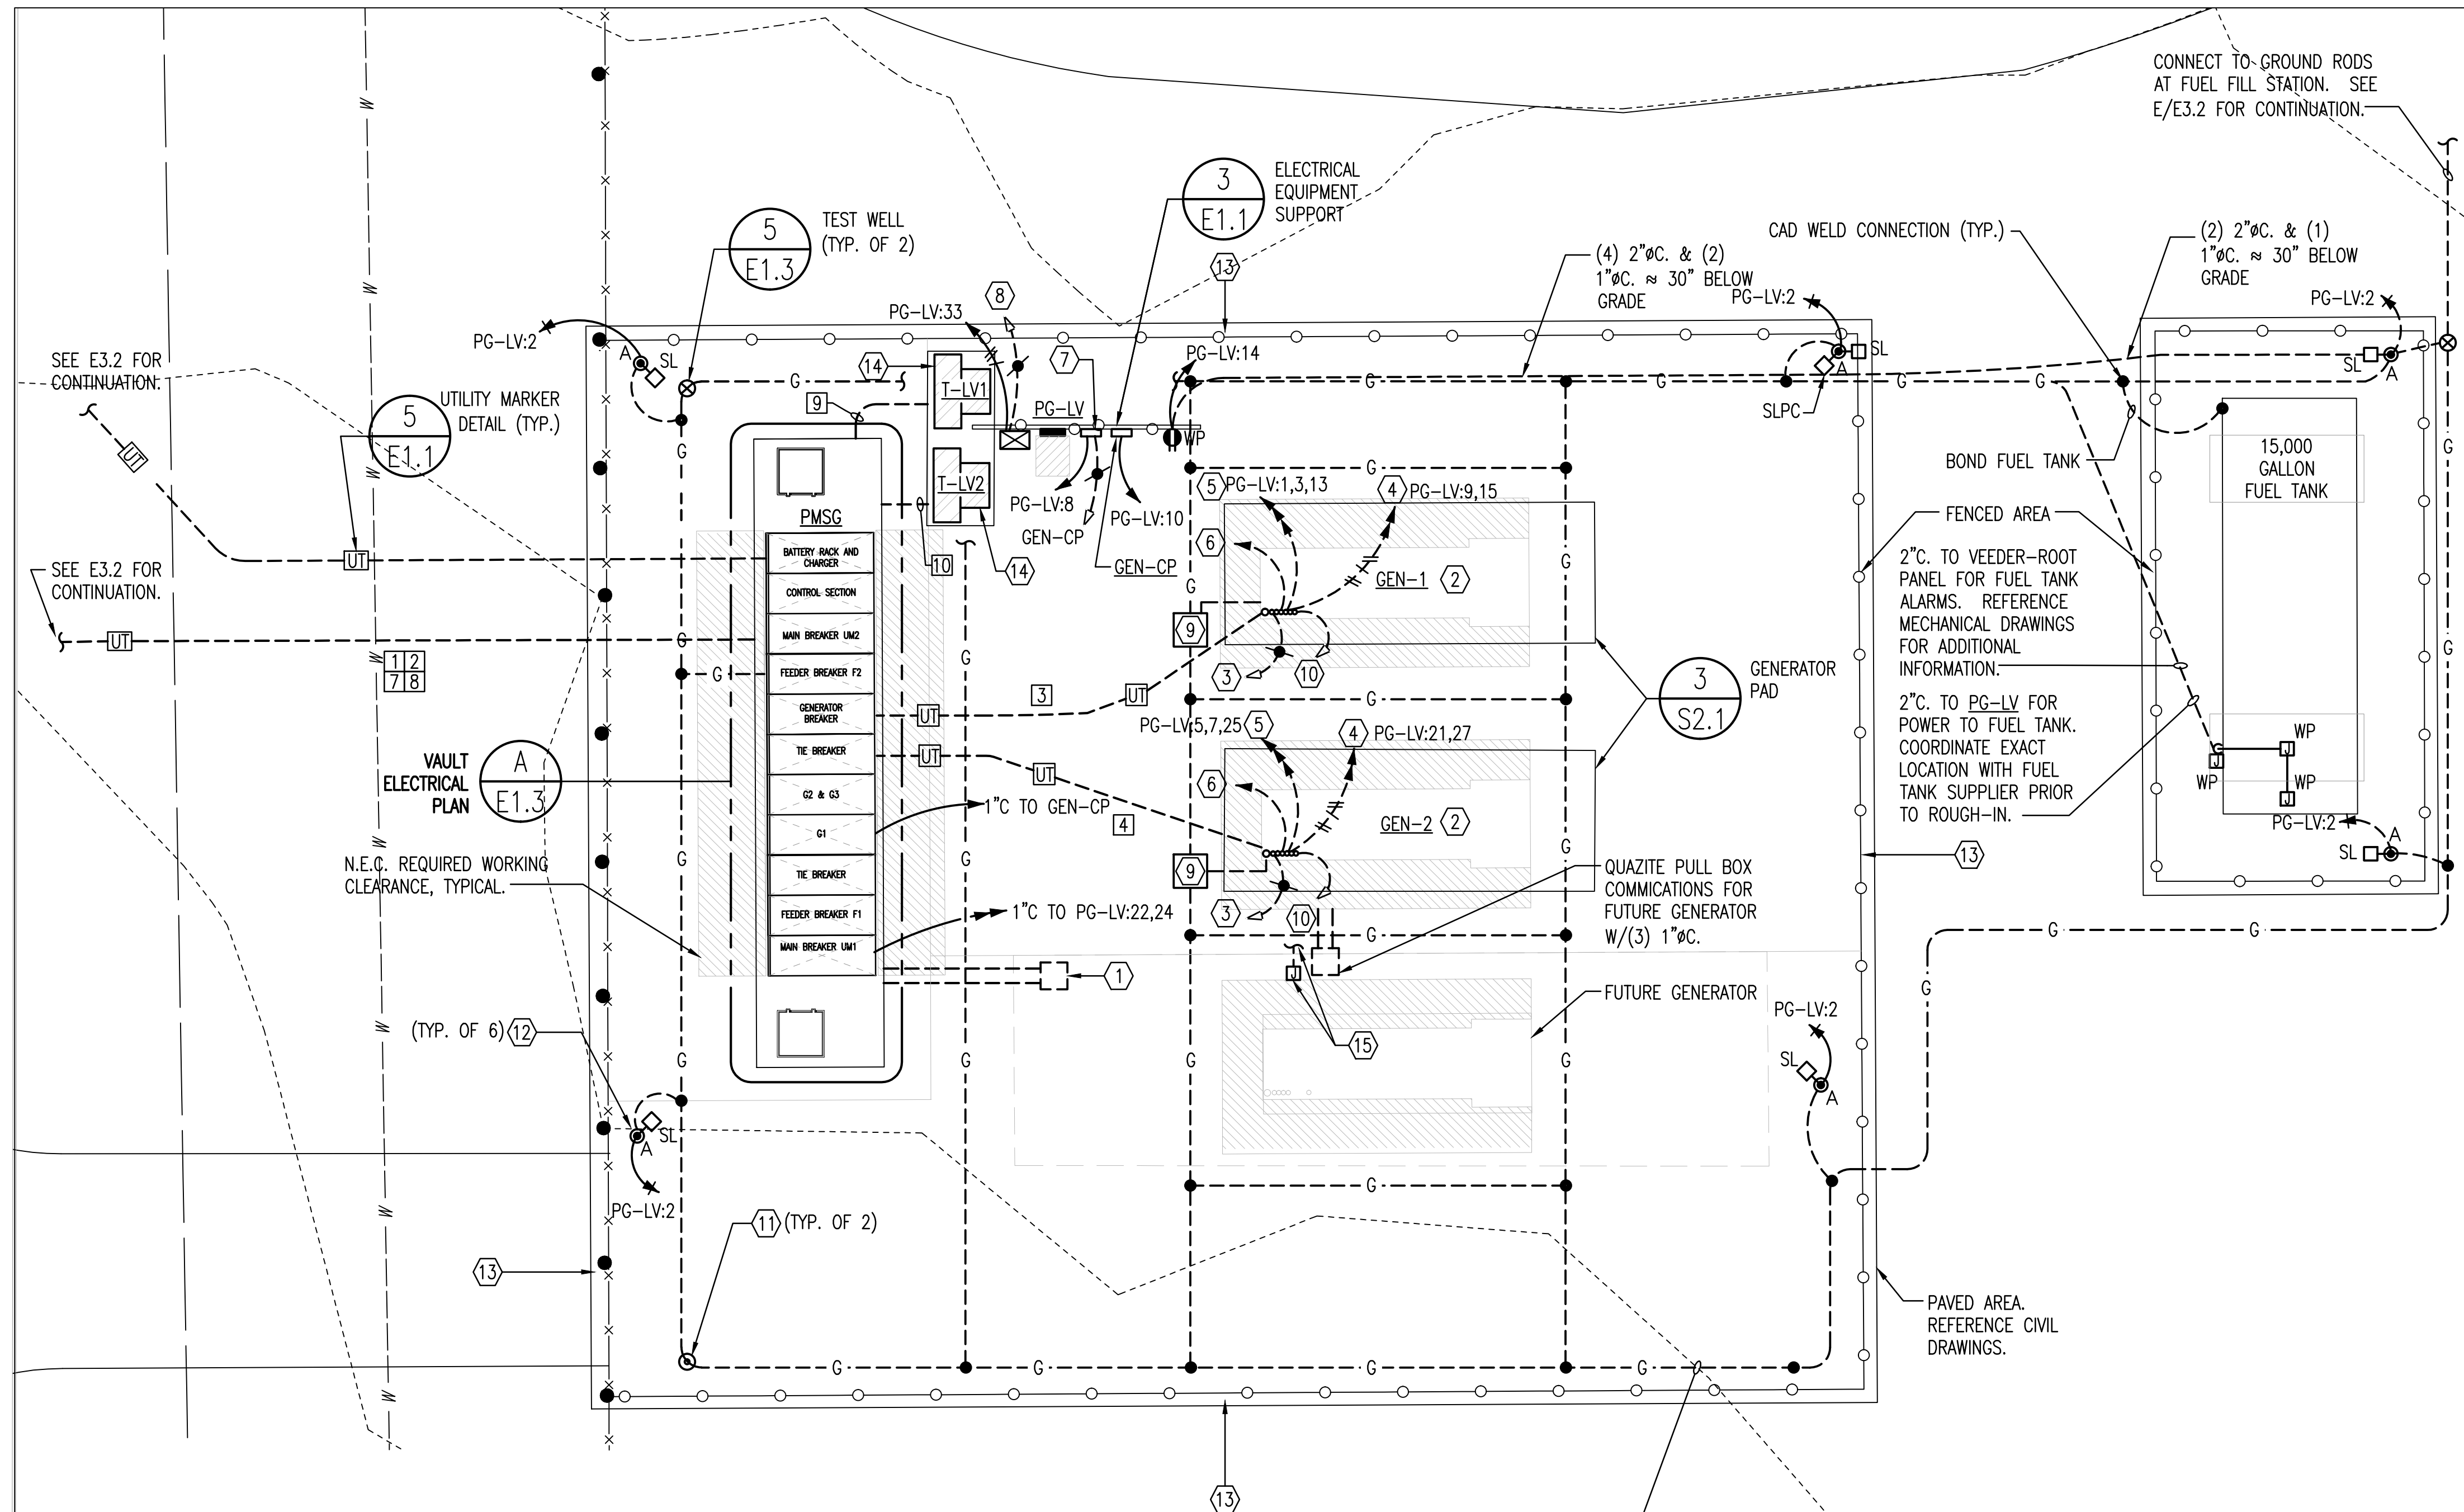


- KEYED NOTES:**
- 1 PROVIDE IN-GRADE WEATHERPROOF JUNCTION BOX IN UNPAVED AREA FOR CONNECTION TO FUTURE GENERATOR. PROVIDE (1) SPARE 4", (1) SPARE 2", AND (6) SPARE 1" CONDUITS WITH PULL ROPES FROM JUNCTION BOX TO PAD-MOUNTED SWITCHGEAR VAULT. CAP BOTH ENDS.
 - 2 VERIFY EXACT LOCATION OF ALL CONDUITS BEING STUBBED UP FROM BELOW GENERATOR WITH GENERATOR MANUFACTURER PRIOR TO ROUGH-IN.
 - 3 2"C. FROM GENERATOR CONTROLLER TO PMSG CONTROLS FOR CONTROL AND MONITORING OF GENERATOR. VERIFY EXACT CONDUIT AND CABLING REQUIREMENTS WITH GENERATOR MANUFACTURER PRIOR TO ROUGH-IN.
 - 4 6#12,#12G IN 1"C. FOR BLOCK HEATER. VERIFY CONDUCTOR, CONDUIT, AND OVERCURRENT SIZE WITH EQUIPMENT PROVIDED.
 - 5 4#12,#12G IN 1"C. FOR BATTERY CHARGERS. VERIFY CONDUCTOR, CONDUIT, AND OVERCURRENT SIZE WITH EQUIPMENT PROVIDED.
 - 6 2-1" CONDUITS TO PMSG FOR AC AND DC CONTROL.
 - 7 VEEDER-ROOT TANK AND PIPING MONITORING CONTROL PANEL IN NEMA 4 ENCLOSURE. PROVIDE ALL CONDUIT AND WIRING REQUIRED FROM CONTROL PANEL TO THE 15,000 GALLON ABOVE GROUND DIESEL FUEL STORAGE TANK FOR MONITORING AND CONTROLS. CONTROL PANEL SHALL PROVIDE CONTINUOUS LEAK SENSING FOR INTERSTITIAL SPACE, PIPING SUMP, LEAK, OVERFILL, LOW LEVEL, SUDDEN LOSS, HIGH WATER, DELIVERY NEEDED, TEST FAILURE, TANK TEST NOT PERFORMED, AND LEVEL SENSING. UNIT SHALL COMMUNICATE WITH GEN-CP VIA MODBUS TCP/IP COMMUNICATION INTERFACE. COORDINATE COMMUNICATIONS INTERFACE WITH SYSTEMS INTEGRATOR.
 - 8 1"C. WITH 2#14 FROM ATS TO GEN-CP FOR CONTROL AND MONITORING OF HOUSE PANEL ATS. VERIFY EXACT CONDUIT AND CABLING REQUIREMENTS WITH ATS MANUFACTURER PRIOR TO ROUGH-IN.
 - 9 RESISTOR FOR GENERATOR MOUNTED INSIDE GENERATOR ENCLOSURE. COORDINATE MOUNTING WITH GENERAL CONTRACTOR AND GENERATOR MANUFACTURER. ROUTE #4 AWG GROUND CONDUCTOR IN 1" CONDUIT TO GROUNDING GRID BELOW GRADE. PROVIDE CADWELD CONNECTION TO GROUNDING GRID. SEE 1/E1.3 FOR SYSTEM GROUNDING DETAIL.
 - 10 1" C. FROM GENERATOR CONTROLLER TO GEN-CP FOR MONITORING OF GENERATOR.
 - 11 3/4" X 20' COPPER CLAD GROUND ROD. CADWELD TO GROUND LOOP.
 - 12 'A': 25' RTS POLE WITH SOLID COPPER AIR TERMINAL AND BARE COPPER GROUND TO GROUND LOOP. SEE DETAIL 1/E1.2 FOR ADDITIONAL INFORMATION. VERIFY ALL REQUIREMENTS AND QUANTITIES WITH LIGHTNING PROTECTION DESIGNER PRIOR TO BID. PROPOSED LAYOUT DESIGNED AROUND THOMPSON LIGHTNING PROTECTION.
 - 13 CAUTION SIGN PER 263213.
 - 14 8" CONCRETE EQUIPMENT PAD ON 12" LVC. REINFORCE CONCRETE WITH #4 AT 12" O.C.. REFERENCE STRUCTURAL GENERAL NOTES FOR CONCRETE REQUIREMENTS.
 - 15 PROVIDE IN-GRADE WEATHERPROOF JUNCTION BOX IN UNPAVED AREA FOR CONNECTION TO FUTURE GENERATOR. ROUTE (1) 2" PVC FOR COMM CABLE, (1) 1" PVC FOR AC CONTROL SIGNALS, AND (1) 1" PVC FOR DC CONTROL SIGNALS TO GEN-2 AND FROM GEN-1 TO GEN-2. STUB UP 4" ABOVE SLAB.

ELECTRICAL SITE PLAN NOTES:

1. UNLESS OTHERWISE NOTED, ALL CONDUIT ROUTED ON SITE SHALL BE 1" MINIMUM.
2. ALL RISERS SHALL BE PVC COATED RIGID GALVANIZED STEEL (RGS) ALL ELLS BELOW GRADE SHALL BE PVC COATED RIGID GALVANIZED STEEL (RGS). PROVIDE WITH PVC TO STEEL ADAPTER(S) AS NECESSARY. (THIS REQUIREMENT SHALL NOT APPLY TO FIXTURE POLE BASES)
3. ALL ELECTRICAL WORK AND FEES ASSOCIATED WITH UTILITIES SHALL BE VERIFIED AND COORDINATED WITH LOCAL SERVICE PROVIDER PRIOR TO BID.
4. CONTRACTOR SHALL REFERENCE ALL RELATED CONTRACT DOCUMENTS, SITE SURVEY, AND OTHER RESOURCES FOR POSSIBLE CONFLICTS WITH OTHER UNDERGROUND UTILITIES. AT UTILITY CROSSINGS, CONTRACTOR SHALL VERIFY UTILITY DEPTHS AND COORDINATE CONDUIT ROUTING AS NECESSARY.
5. CONTRACTOR SHALL VERIFY AND COORDINATE EXISTING CONDITIONS OF PROJECT SITE PRIOR TO BID.
6. ALL ELECTRICAL EQUIPMENT SHALL BE BONDED TO THE GROUNDING GRID.

#4/0 BARE CU GROUNDING GRID. ROUTE CONDUCTOR AROUND PERIMETER OF GENERATOR STATION APPROXIMATELY 3'-4" FROM FOUNDATION APPROXIMATELY 24"-36" DEEP. PROVIDE 20'-0" COPPER CLAD GROUND RODS AT LOCATIONS AS SHOWN. ALL CONNECTIONS SHALL BE CAD WELDED. PROVIDE TEST WELLS AT LOCATIONS AS SHOWN TO BE USED TO TEST SYSTEM.

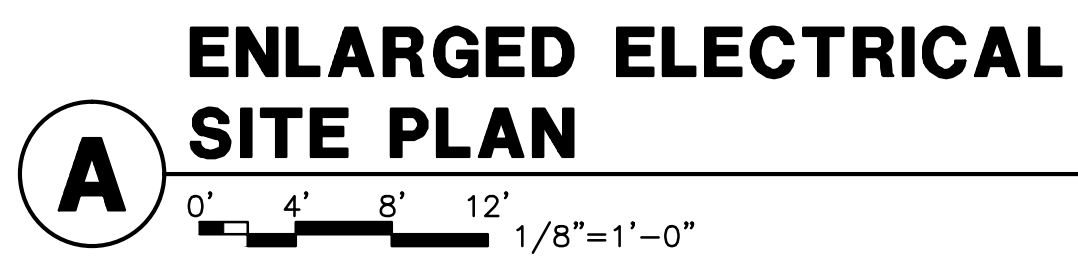

Saved: 04-04-2016 1:20:05 PM by CJV
 Plot Scale: 1/8" = 1'-0"
 U:\Wichita-Fossil\2014\14229\001\Elec\Drawings\As-Builts\14229-001-E3.3

RECORD DOCUMENTS
 THESE DOCUMENTS INCLUDE RECORD INFORMATION PROVIDED BY THE CONTRACTOR. THIS INFORMATION HAS NOT BEEN VERIFIED IN ITS ENTIRETY BY THE DESIGN PROFESSIONAL.
 DATE: FEBRUARY, 2016

▲	ASI #6	6/30/15
▲	ASI #4	6/25/15
▲	ASI #2	6/18/15
▲	ASI #1	5/26/15
FOR CONSTRUCTION SET		
No.	Revision	By Date
CITY OF WICHITA, KANSAS		
ENLARGED SITE PLAN		
WWTP #2 EMERGENCY POWER PROJECT C.O.W. PROJECT NO. 468-84956		
PROFESSIONAL ENGINEERING CONSULTANTS, P.A. 303 SOUTH TOPEKA WICHITA, KS 67202 316-262-2891 www.pec1.com		
Designed by	RWW	Job No. 34-14229-001-0042
Drawn by	CJV	Date 4/29/15
		Sht. E3.3 of 37

GENERAL STRUCTURAL NOTES

A. DESIGN CRITERIA

- BUILDING CODE: INTERNATIONAL BUILDING CODE (IBC), 2006 EDITION, INCLUDING LOCAL SUPPLEMENTS.
- GRAVITY LOADS:

LOCATION	LIVE LOAD	DEAD LOAD*
VAULT COVER	200 PSF	5 PSF

*DEAD LOAD WHICH IS SUPERIMPOSED ONTO ACTUAL STRUCTURAL WEIGHTS.

3. SOIL LOADS

SOIL WEIGHT:	120 PCF
EXTERNAL SOIL PRESSURE	90 PCF (SATURATED)

B. SOIL PREPARATION AND FOUNDATIONS

- THE FOUNDATION SYSTEM IS DESIGNED AS RECOMMENDED IN THE GEOTECHNICAL INVESTIGATION PREPARED BY ALLIED LABORATORIES JOB NO. 74-14229-001-0147. A COPY IS IN THE SPECIFICATIONS OR IS AVAILABLE FOR INSPECTION AT THE ENGINEER'S PLACE OF BUSINESS.
- REMOVE TOP SOIL CONTAINING ORGANIC MATERIAL AND PREPARE THE BUILDING PAD IN ACCORDANCE WITH THE CIVIL ENGINEERING PLANS, SPECIFICATIONS, AND GEOTECHNICAL INVESTIGATION.
- REMOVE SOIL AS REQUIRED TO ALLOW FOR A LOW VOLUME CHANGE ZONE 18" THICK UNDER SLABS. FILL TO SUBGRADE ELEVATION SHOWN ON THE DRAWINGS WITH NON-EXPANSIVE FILL OR STABILIZED SOIL PER SPECIFICATION.
- SOIL SUPPORTED FOUNDATIONS:
 - DESIGN BEARING PRESSURE (NET) IS 1500 PSF FOR FOUNDATIONS BEARING ON UNDISTURBED SOIL OR APPROVED ENGINEERED FILL MATERIAL.
 - ALL FOUNDATIONS ARE DESIGNED WITH EARTH FORMED SIDES; THE TOP 7/8" OF THE FOUNDATION SHALL BE FORMED TO THE DESIGN DIMENSION WHEN VISIBLE AFTER CONSTRUCTION IS COMPLETE. THE CONSTRUCTED FOUNDATION DIMENSION SHALL BE NO LESS THAN THE DESIGN DIMENSION, AND NO MORE THAN 6" GREATER THAN THE DESIGN DIMENSION.
- DO NOT BACKFILL FOUNDATION WALLS UNTIL THE RESTRAINING COVER SLAB OR ADEQUATE BRACING ARE IN PLACE AND CONCRETE STRENGTH HAS REACHED 75% OF DESIGN STRENGTH. ALL BACKFILL SHALL BE PLACED AND COMPACTED IN ACCORDANCE WITH THE SPECIFICATION.

C. CONCRETE

- ALL STRUCTURAL CONCRETE HAS BEEN DESIGNED IN ACCORDANCE WITH THE ACI 318 AND THE BUILDING CODE, AND IN CONFORMANCE WITH THE CURRENT "ACI MANUAL OF CONCRETE PRACTICE."
- THE CONCRETE REQUIREMENTS ARE:

- CEMENT SHALL BE TYPE I OR II CONFORMING TO ASTM C150. FLY ASH CONFORMING TO ASTM C618 TYPE C OR F MAY BE USED TO REPLACE A MAXIMUM OF 20% OF THE CEMENT.
- FINE AND COARSE AGGREGATES FOR NORMAL WEIGHT CONCRETE SHALL CONFORM TO ASTM C33. COARSE AGGREGATES SHALL BE NO LESS THAN 50% OF THE TOTAL AGGREGATE BY WEIGHT, UNLESS APPROVED BY THE ENGINEER PRIOR TO MIX DESIGN SUBMITTAL.
- MIX REQUIREMENTS ARE:

LOCATION	MIN. F'C PSI	MIN. CEM. PCY	MAX. W/C RATIO	COARSE AGGREGATE GRADE	AIR ENT. %	SLUMP§ INCHES
FOUNDATION	4000	470	0.45	#67	5%+/-1%	2-5

§ PRIOR TO THE ADDITION OF HIGH RANGE WATER REDUCERS, IF APPROVED BY ENGINEER, AFTER ADDITION THE SLUMP MAY NOT EXCEED 8".

F'C SPECIFIED IS BASED ON THE 28 DAY COMPRESSIVE STRENGTH IN ACCORDANCE WITH ACI 318 ACCEPTANCE CRITERIA

3. ADMIXTURES, HARDENERS, & CURING COMPOUNDS

- ALL CONCRETE ADMIXTURES SHALL, WHEN MIXED INTO CONCRETE, BE NON-CHLORIDE AND NON-CHLORIDE FORMING.
- THE FOLLOWING ADMIXTURES MAY BE USED TO MEET THE CONCRETE MIX DESIGNS SPECIFIED:

PURPOSE	ASTM	TYPE
WATER REDUCER (NORMAL, MID, & HIGH RANGE)	C-494	A, F, & G
AIR ENTRAINING	C-260	
SET RETARDING	C-494	B & D
SET ACCELERATING	C-494	C & E
CORROSION INHIBITING	C-494	C

C. CONCRETE CURING COMPOUND AND SEALERS SHALL MEET ASTM C-309 TYPE 1 OR 1D

D. THE CONTRACTOR SHALL VERIFY THAT ALL ADMIXTURES, HARDENERS, CURING COMPOUNDS, AND FLOOR COVERING ADHESIVES ARE COMPATIBLE WITH EACH OTHER.

4. MISCELLANEOUS CONCRETE DETAILS:

- ALL EXPOSED EDGES OF CONCRETE SHALL BE CHAMFERED 3/4" INSIDE FORMS OR TOOLED TO 3/4" RADIUS UNLESS NOTED OTHERWISE.
- THE CONTRACTOR SHALL BE RESPONSIBLE FOR THE DESIGN OF ALL FORMING AND SHORING. SHORING FOR ELEVATED SLABS SHALL BE SET SO THAT ANY LOAD DUE TO THE CONCRETE OPERATIONS DOES NOT CAUSE THE FORMS TO SETTLE (SLACK, TAKE-UP, ETC.).
- NO ALUMINUM SHALL BE EMBEDDED IN CONCRETE. CONDUITS AND PIPING EMBEDDED IN CONCRETE WALLS, SLABS, OR BEAMS SHALL BE SPACED A MINIMUM OF FOUR DIAMETERS AND THE OUTSIDE DIAMETER SHALL BE LESS THAN 30% OF THE MEMBER THICKNESS AND PLACED BETWEEN LAYERS OF REINFORCING.
- WATERSTOP AT CAST IN PLACE JOINTS SHALL BE PVC WATERSTOP MODEL NO. 702 BY GREENSTREAK OR APPROVED EQUAL.
- PROVIDE EXTERIOR WATERPROOFING AT ALL CONCRETE SURFACES BELOW GRADE. USE 2 COATS OF SEAL MASTIC BY W.R. MEADOWS OR APPROVED EQUAL. APPLY PER MANUFACTURER'S RECOMMENDATIONS.

D. CONCRETE REINFORCING (CAST-IN-PLACE)

1. MATERIALS:

REINFORCING BARS:	ASTM A615	GRADE 60
-------------------	--------------	-------------

2. DETAILS:

- WELDING OF REINFORCING BARS IS PROHIBITED.

3. PLACEMENT

- ALL REINFORCING (BARS, ANCHOR RODS, EMBEDMENTS, WWF, ETC.) SHALL BE SUPPORTED ON CHAIRS/BOLSTERS TO THE DESIGN DIMENSIONS. SPACING SHALL BE SUFFICIENTLY CLOSE TO PREVENT DISPLACEMENT OR PERMANENT DEFORMATION DUE TO CONCRETE PLACEMENT, FOOT TRAFFIC, OR VIBRATION. "PUDDLING IN" OR "PULLING UP" REINFORCING IS NOT AN ACCEPTABLE METHOD FOR PLACING REINFORCING. CHAIRS/BOLSTERS SHALL HAVE PLASTIC COATED FEET OR BE MADE OF STAINLESS STEEL. CHAIRS/BOLSTERS IN CONTACT WITH EARTH SHALL HAVE BOTTOM PLATES AND BE COATED TO PREVENT CORROSION. ANCHOR RODS SHALL BE HELD IN PLACE WITH TEMPLATES SUFFICIENTLY STRONG TO PREVENT DISPLACEMENT OR TILTING.

B. MAINTAIN ACI CLEAR COVER ON REINFORCING AS LISTED BELOW UNLESS NOTED OTHERWISE.

CAST AGAINST EARTH (BOTTOM OR SIDES):	3"
FORMED - EXPOSED TO SOIL, WEATHER OR LIQUIDS:	2"

C. PROVIDE CORNER BARS OF THE SAME SIZE AND SPACING AS ADJACENT REINFORCING. REFERENCE DETAILS. CONTINUOUS WALL FOOTING REINFORCING NEED ONLY TO OVERLAP.

D. OPENINGS IN WALLS OR STRUCTURAL SLABS SHALL BE REINFORCED PER DETAIL.

E. ALL REINFORCING BARS ARE TO BE MADE CONTINUOUS OR LAPPED PER TABLE A.

E. POST INSTALLED ANCHORING SYSTEMS

- ANCHORS SHALL BE INSTALLED IN ACCORDANCE WITH THE MANUFACTURER'S PRINTED INSTALLATION INSTRUCTIONS (MPI) AND THE EVALUATION REPORT (ER/ESR) SPECIFIED INCLUDING HOLE PREPARATION, TEMPERATURE AND MOISTURE CONDITIONS.

2. ADHESIVE ANCHORS:

- THE CONTRACTOR SHALL ARRANGE AN ANCHOR MANUFACTURER'S REPRESENTATIVE TO PROVIDE ONSITE INSTALLATION TRAINING FOR ALL ANCHOR PRODUCTS SPECIFIED. THE CONTRACTOR MUST MAINTAIN TRAINING RECORDS OF ALL CONTRACTOR PERSONNEL INSTALLING ANCHORS AND SUBMIT TO THE ENGINEER OF RECORD PRIOR TO INSTALLING ANCHORS UPON REQUEST.

B. ADHESIVE ANCHORS SHALL BE USED IN CONJUNCTION WITH THE APPROPRIATE ADHESIVE SYSTEM.

C. APPROVED ADHESIVE ANCHORS FOR PREVIOUSLY CAST CONCRETE:

MANUFACTURER/PRODUCT	REPORT NUMBER
HILTI HIT-HY200 SSS* WITH HIT-Z ROD	ICC-ES ESR-3187
HILTI HIT-HY200 SSS* WITH HOLLOW BIT & HAS-E ROD	ICC-ES ESR-3187

*SAFE SET SYSTEM

F. CONTRACT/CONSTRUCTION DOCUMENTS

- THE CONTRACT DOCUMENTS SHALL INCLUDE ALL PLANS, SPECIFICATIONS, ADDENDAS, AND SUPPLEMENTAL INSTRUCTIONS.
- THE CONTRACTOR SHALL BE RESPONSIBLE TO OBTAIN A FULL SET OF THE MOST RECENT REVISIONS OF EACH DOCUMENT.
- THE CONTRACTOR SHALL REVIEW THE DOCUMENTS PRIOR TO FABRICATION AND/OR INSTALLATION OF ANY MATERIALS FOR CONFLICTS. IF CONFLICTS OCCUR THE CONTRACTOR SHALL USE THE MOST STRINGENT REQUIREMENT. ALTERNATELY, THE CONTRACTOR MAY REQUEST A CLARIFICATION THROUGH A REQUEST FOR INFORMATION (RFI).
- THE DOCUMENTS MAY NOT BE REPRODUCED IN WHOLE OR IN PART FOR USE ON PROJECTS OTHER THAN IDENTIFIED IN THE TITLE BLOCK. SHOULD THE CONTRACTOR USE THE DOCUMENTS AS A PORTION OF A SHOP DRAWING SUBMITTAL, THE CONTRACTOR SHALL BE RESPONSIBLE FOR ANY CONSEQUENCES RESULTING FROM ERRORS IN THE REPRODUCED DOCUMENTS.

5. DETAILS LABELED TYPICAL ARE INTENDED TO REPRESENT A CONDITION THAT OCCURS AT SEVERAL LOCATIONS IN THE PLANS WHETHER OR NOT THE DETAIL IS REFERENCED.

6. DO NOT SCALE THE PLANS AND DETAILS FOR THE PURPOSE OF ESTABLISHING DIMENSIONS.

G. CONSTRUCTION MEANS AND METHODS ISSUES


- SLABS ON GRADE AND ELEVATED SLABS ARE NOT DESIGNED TO SUPPORT CRANES, FORKLIFTS, TRUCKS, MANLIFTS, OR OTHER CONSTRUCTION RELATED EQUIPMENT UNLESS NOTED AS SUCH. IT IS THE CONTRACTOR'S RESPONSIBILITY TO DETERMINE IF CONSTRUCTION EQUIPMENT CAN BE SAFELY OPERATED ON THESE SLABS AND TO REPAIR ANY DAMAGE THE EQUIPMENT MAY CAUSE.
- THE CONTRACTOR SHALL PROVIDE ANY TEMPORARY BRACING AND/OR SHORES TO SAFELY CONSTRUCT THE STRUCTURE AND PREVENT DAMAGE DURING CONSTRUCTION.
- THE CONTRACTOR SHALL VERIFY ALL DIMENSIONS AND ELEVATIONS OF EXISTING CONSTRUCTION THAT MAY AFFECT THE PROJECT AND REPORT DISCREPANCIES TO THE ENGINEER. EXISTING BUILDING ELEMENTS THAT ARE TO BE ABANDONED THAT INTERFERE WITH NEW CONSTRUCTION SHALL BE REMOVED.
- WHEN A PIECE OF EQUIPMENT IS PROVIDED THAT IS DIFFERENT THAN THE EQUIPMENT THAT THE STRUCTURE WAS DESIGNED FOR EITHER BY SIZE, WEIGHT OR CONFIGURATION, THE CONTRACTOR SHALL BE RESPONSIBLE FOR ALL COSTS ASSOCIATED WITH THE REMEDY OF THE SITUATION.

H. STRUCTURAL TESTS, INSPECTIONS, AND QUALITY ASSURANCE

- ALL STRUCTURAL TESTS AND INSPECTIONS SHALL BE PERFORMED PER CHAPTER 17 OF THE BUILDING CODE WITH LOCAL SUPPLEMENTS, UNLESS MORE STRINGENT REQUIREMENTS ARE SPECIFIED.


TABLE A - REINFORCEMENT LAPS, EMBEDMENTS, AND HOOK LENGTHS																
f _y = 60000 PSI f' _c = 4000 PSI																
BAR SIZE (d)	CLEAR SPACING (s) (in)			EMBEDMENT & CLASS A LAP (in)				CLASS B LAP (in)				HOOK (in)				
				TOP BAR		OTHER BARS		TOP BAR		OTHER BARS						
	2d	3d	5d	2d < s < 3d	s ≥ 3d	s ≥ 5d	2d < s < 3d	s ≥ 3d	s ≥ 5d	2d < s < 3d	s ≥ 3d					
3	3/4	1 1/8	1 1/8	28	18	12	21	14	12	36	24	14	28	18	12	8
4	1	1 1/2	2 1/2	37	25	15	28	19	12	48	32	19	37	25	15	10
5	1 1/4	1 7/8	3 1/8	46	31	18	36	24	14	60	40	24	46	31	18	12
6	1 1/2	2 1/4	3 3/4	55	37	22	43	28	17	72	48	29	55	37	22	15
7	1 3/4	2 5/8	4 3/8	81	54	32	62	42	25	105	70	42	81	54	32	18
8	2	3	5	92	62	37	71	47	28	120	80	48	92	62	37	20
9	2 1/4	3 5/8	5 5/8	104	70	42	80	54	32	136	90	54	104	70	42	22
10	2.54	3.81	6.35	117	78	47	90	60	36	153	102	61	117	78	47	25
11	2.82	4.23	7.05	130	87	52	100	67	40	170	113	68	130	87	52	27

1 **TABLE A**
SO.1 NO SCALE

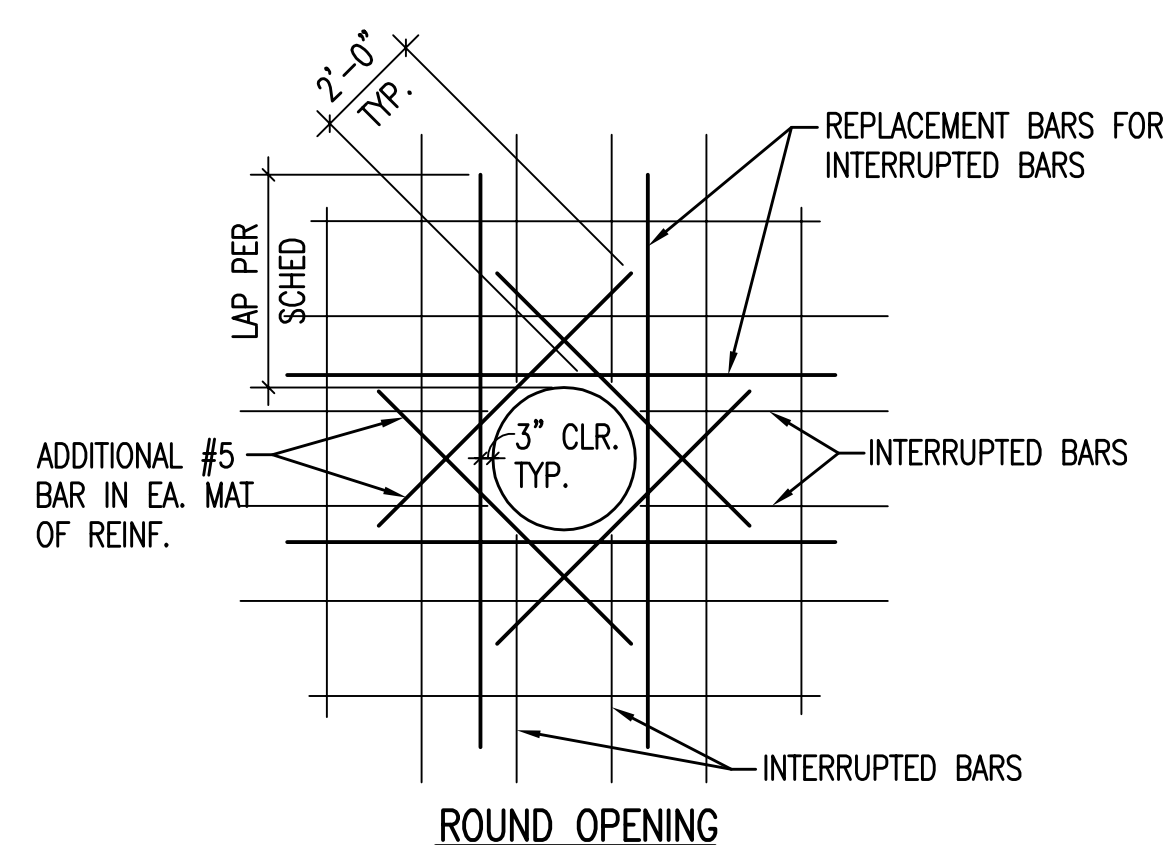

- NOTES:**
- USE THIS DETAIL FOR ALL OPENINGS GREATER THAN 8" IN CONCRETE WALLS AND ELEVATED SLABS, PROVIDE #5 ON DIAGONAL AT EACH CORNER AS SHOWN. EXTEND BARS 2'-0" PAST OPENING. REPLACE ALL VERTICAL AND HORIZONTAL BARS INTERRUPTED BY THE OPENING WITH AN EQUAL NUMBER AND SIZE BARS EVENLY DIVIDED ON EACH SIDE OF THE OPENING UNLESS NOTED OTHERWISE.
 - REFER TO ARCHITECTURAL, STRUCTURAL & MECHANICAL PLANS FOR ALL OPENING LOCATIONS.

2 **TYP. WALL/ELEVATED SLAB OPENING REINF.**
SO.1 NO SCALE

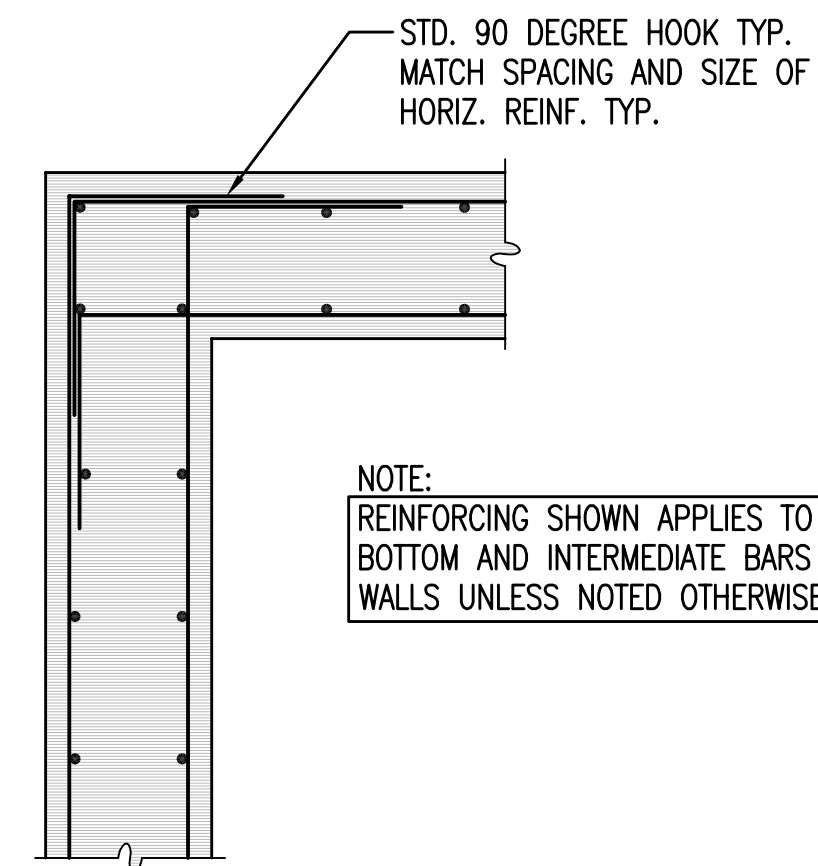

NOTE:
REINFORCING SHOWN APPLIES TO TOP, BOTTOM AND INTERMEDIATE BARS IN WALLS UNLESS NOTED OTHERWISE.

3 **TYP. CORNER AND INTERSECT. REINF.**
SO.1 NO SCALE

ASI #	Revision	By	Date
ASI #6			6/30/15
ASI #4			6/25/15
ASI #2			6/18/15
ASI #1			5/26/15
FOR CONSTRUCTION SET			
4/29/15			


RECORD DOCUMENTS
THESE DOCUMENTS INCLUDE RECORD INFORMATION PROVIDED BY THE CONTRACTOR. THIS INFORMATION HAS NOT BEEN VERIFIED IN ITS ENTIRETY BY THE DESIGN PROFESSIONAL.
DATE: MARCH, 2016

CITY OF WICHITA, KANSAS

STRUCTURAL GENERAL NOTES
WWTP #2 EMERGENCY POWER PROJECT
C.O.W. PROJECT NO. 468-84956


PEC PROFESSIONAL ENGINEERING CONSULTANTS, P.A. 303 SOUTH TOPEKA WICHITA, KS 67202 316-262-2691 www.pec1.com	
Designed by DKC	Job No. 34-14229-001-0042
Drawn by JTR	Date 4/29/15

Saved: 03-22-2016 5:18:48 PM by: PKC
 File: 24-1016 Rev: 27.dwg
 User: david.carrington
 Path: \\server\local\2014\14229\001\Struct\Drawings\see-tables\14229-001_S01

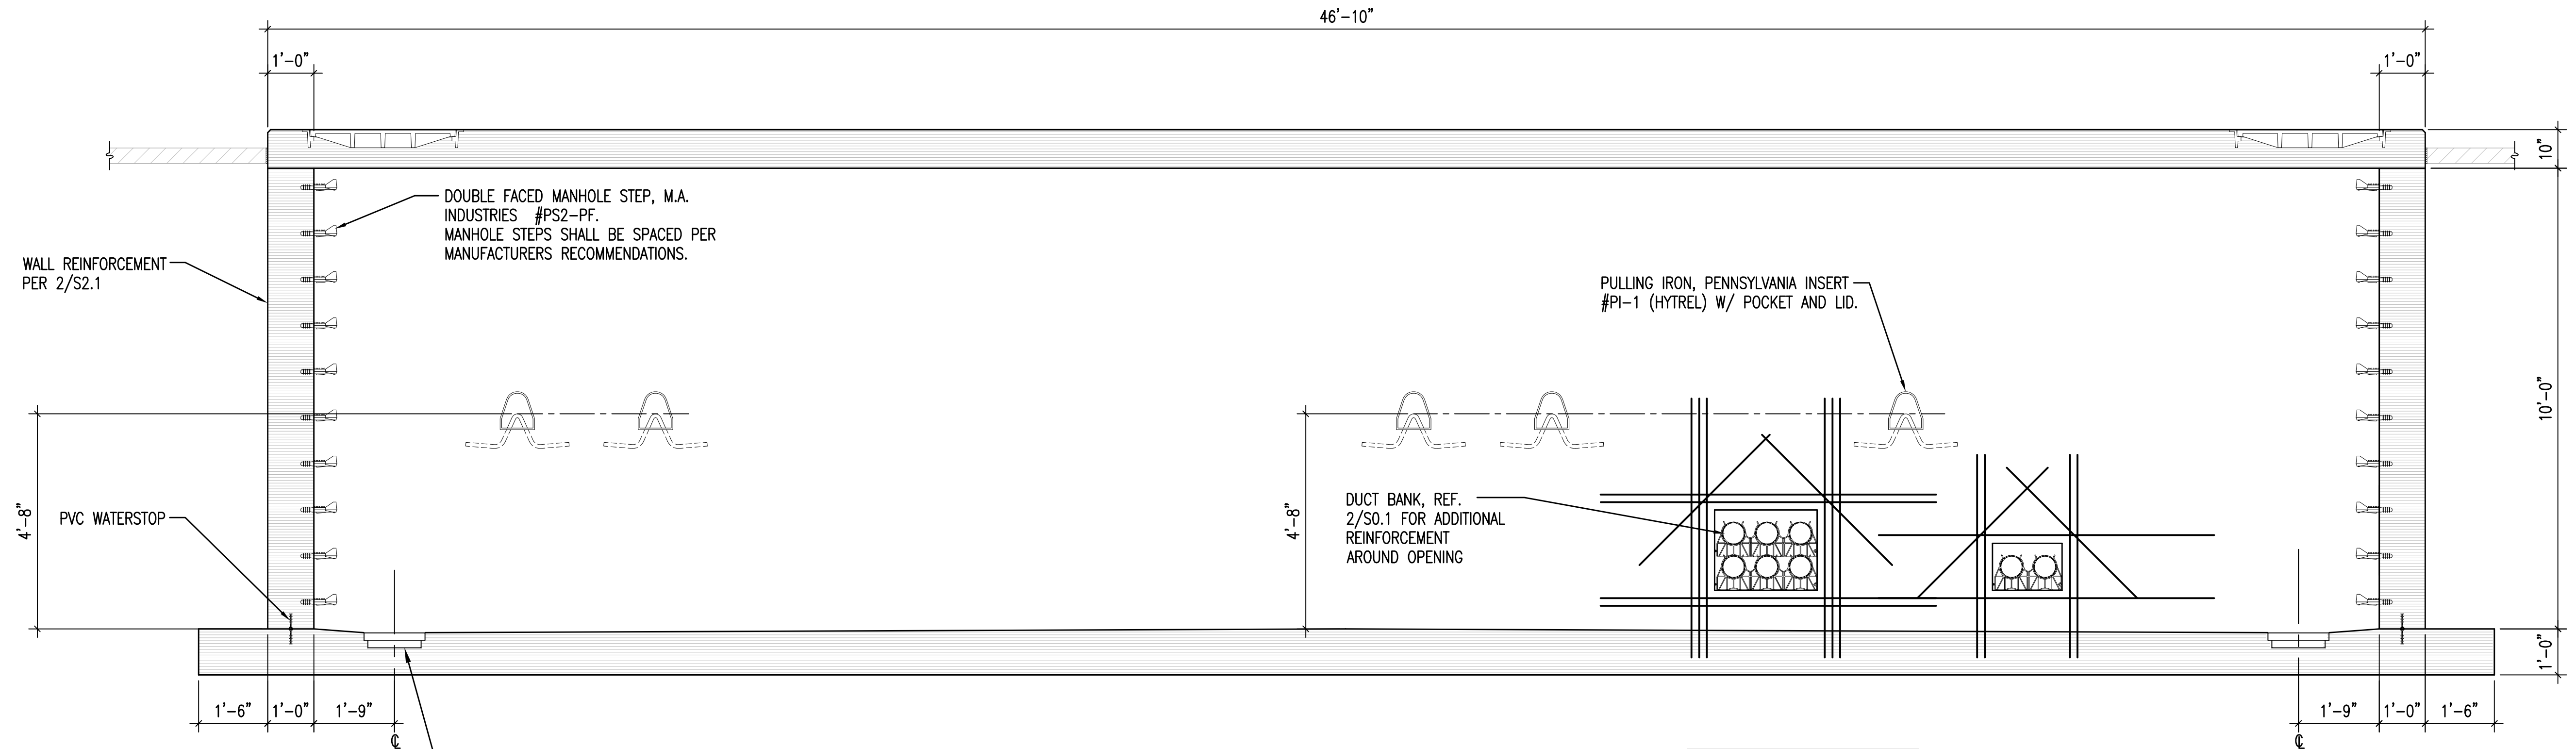


1 VAULT SECTION
S2.1 1/2"=1'0"


COORDINATE DUCT BANK, PULLING IRONS, AND ELECTRICAL PENETRATION LOCATIONS WITH ELECTRICAL CONTRACTOR.

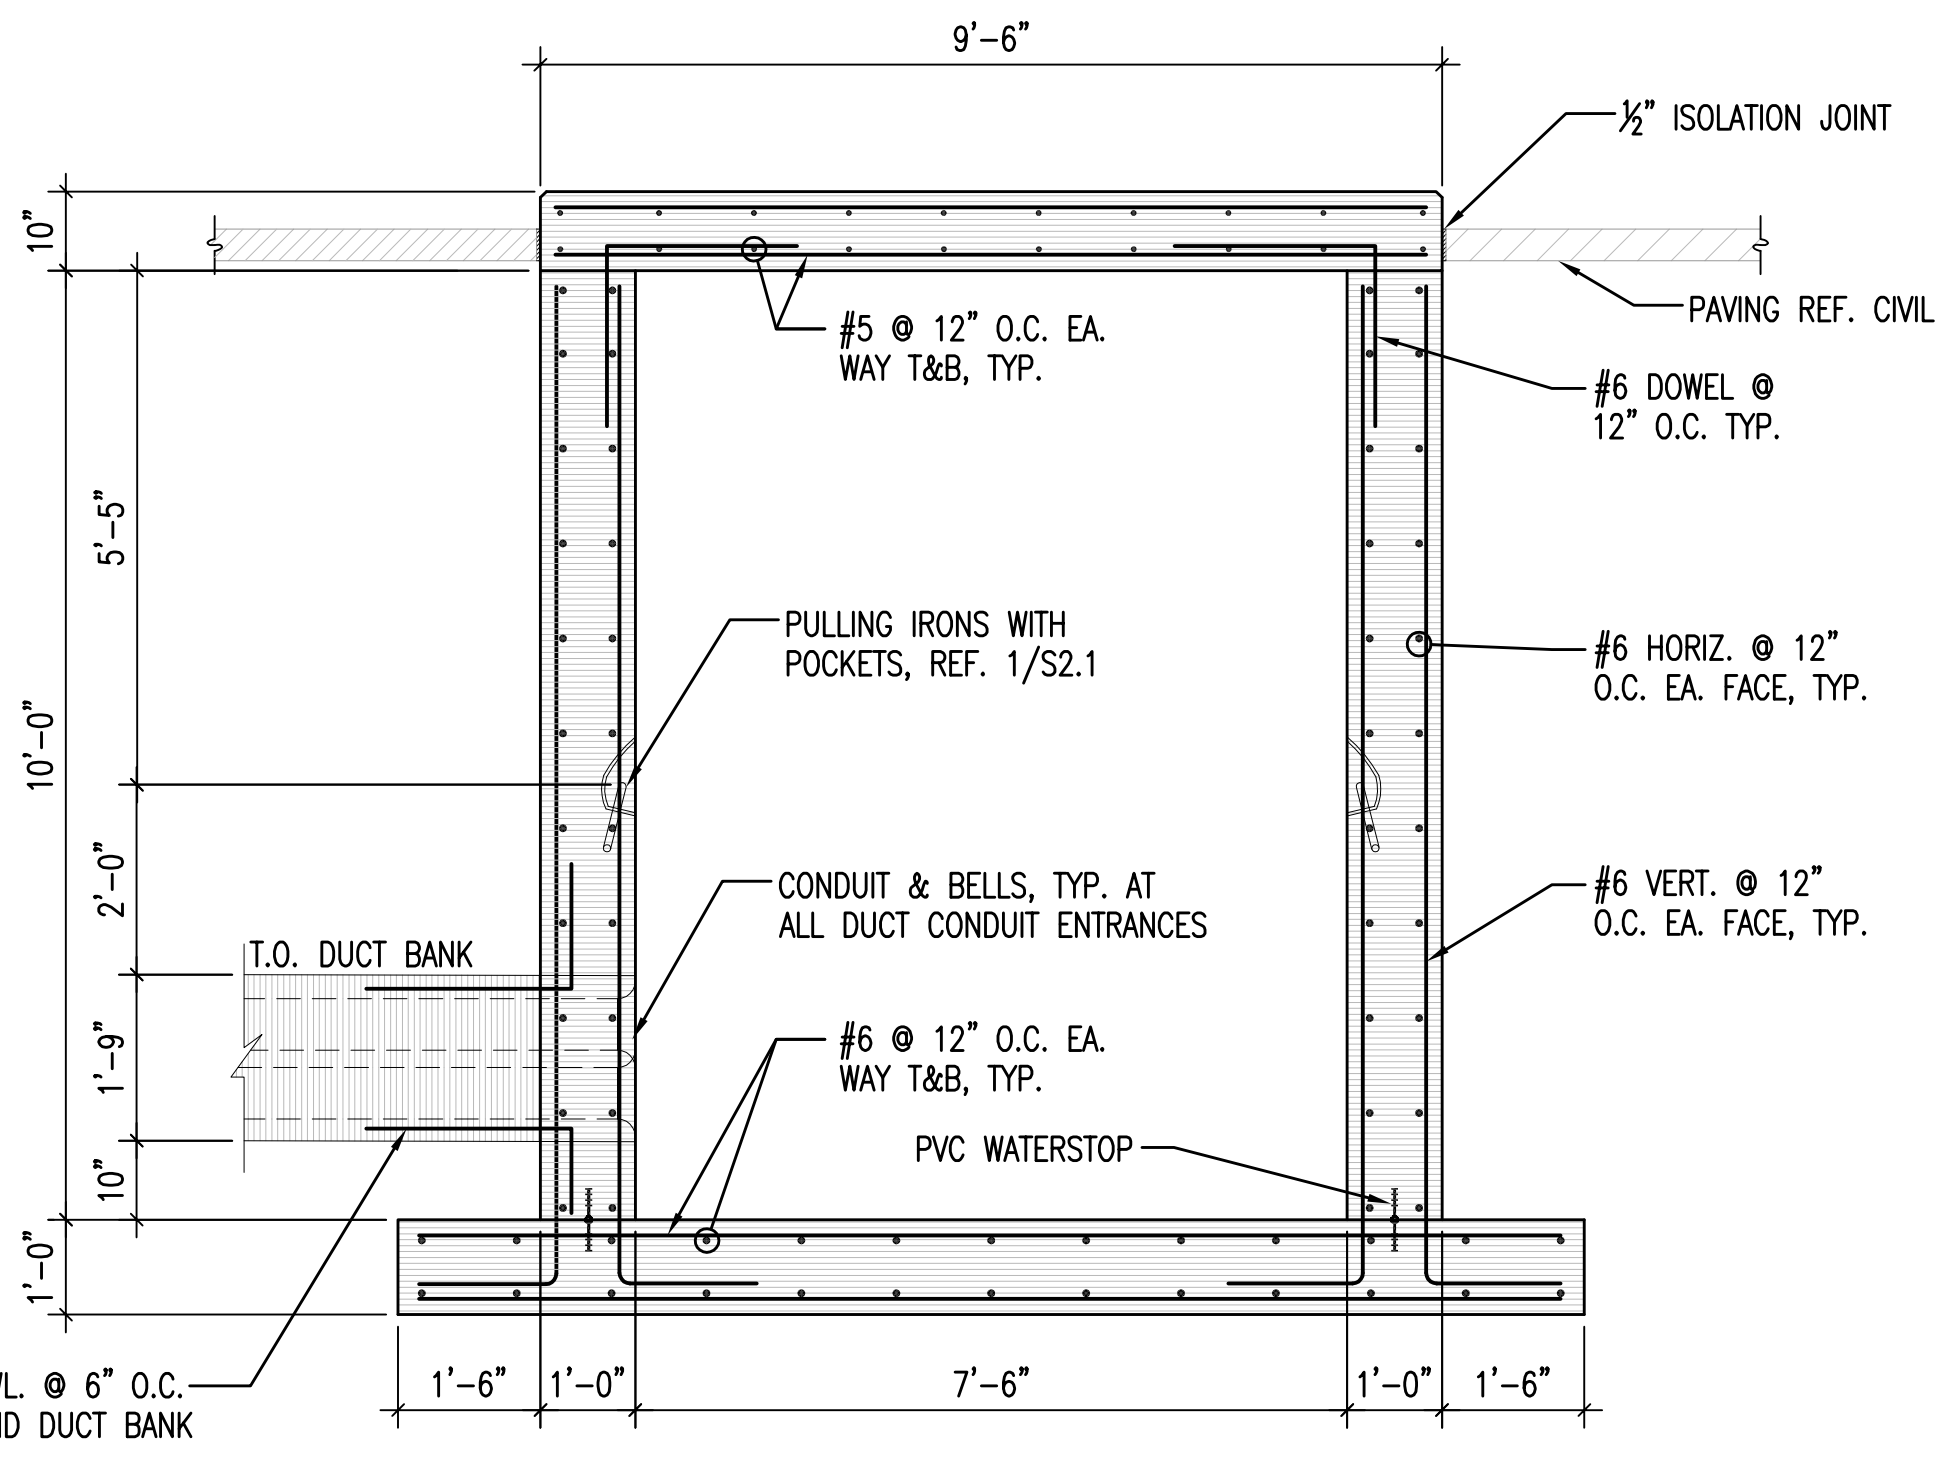

2 VAULT SECTION
S2.1 1/2"=1'0"

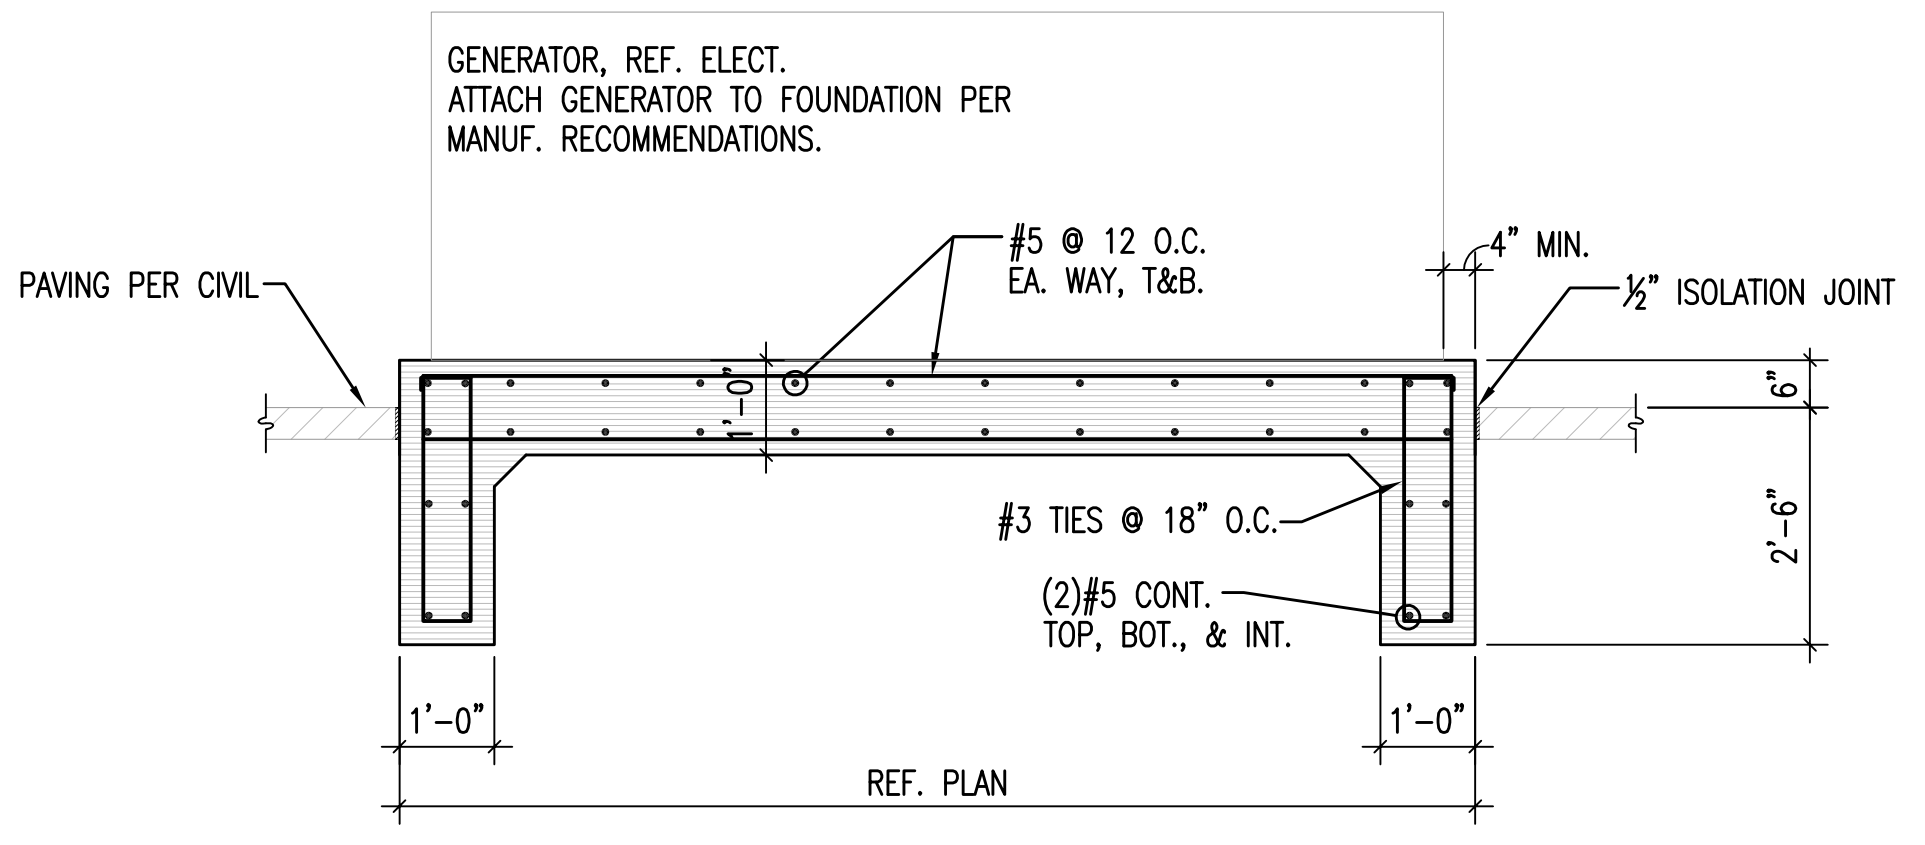

3 GENERATOR PAD SECTION
S2.1 1/2"=1'-0"

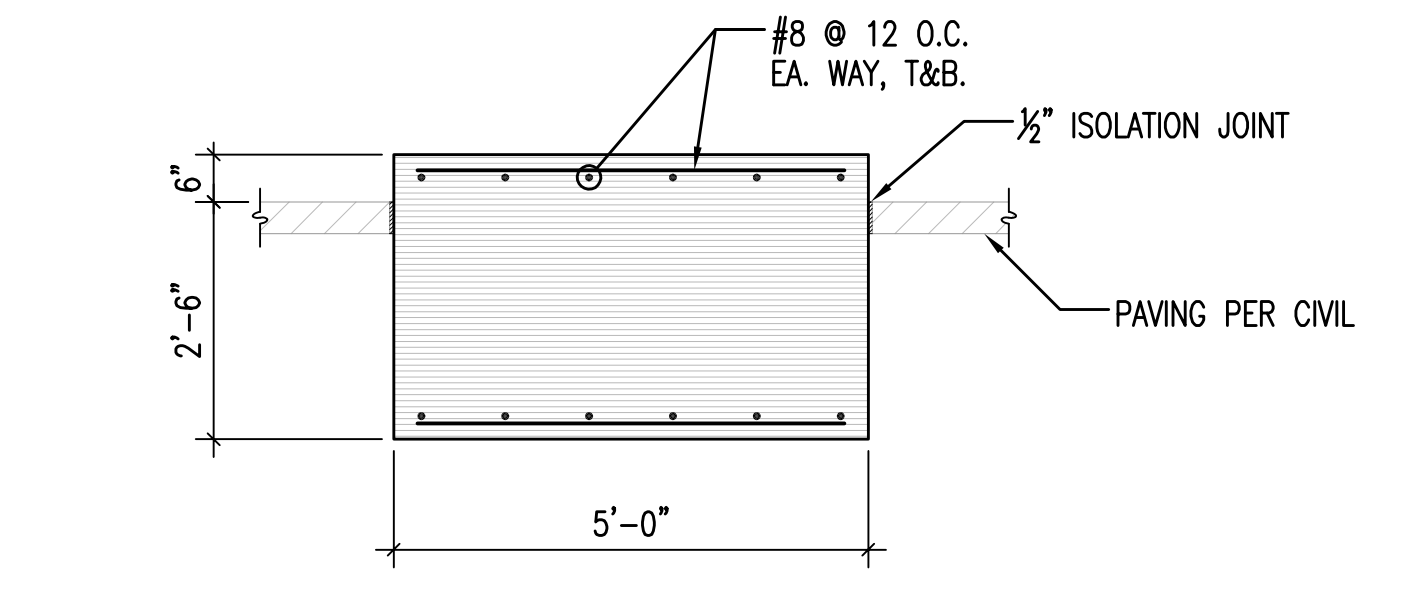

4 FUEL TANK FOUNDATION SECTION
S2.1 1/2"=1'-0"

Saved: 03-29-2016 6:21:00 PM by DAVID CARPENTER
 Project: 11-0116 03-27-15 11:27:37 AM by DAVID CARPENTER
 User: dcarp@pec.com
 Path: \\wchita-fac\2014\14229\001\Struct\Drawings\as-builts\14229-001_S2.1

No.	Revision	By	Date
▲	ASI #6		6/30/15
▲	ASI #4		6/25/15
▲	ASI #2		6/18/15
▲	ASI #1		5/26/15
FOR CONSTRUCTION SET			4/29/15

RECORD DOCUMENTS
 THESE DOCUMENTS INCLUDE RECORD INFORMATION PROVIDED BY THE CONTRACTOR. THIS INFORMATION HAS NOT BEEN VERIFIED IN ITS ENTIRETY BY THE DESIGN PROFESSIONAL.
 DATE: MARCH, 2016

CITY OF WICHITA, KANSAS

STRUCTURAL SECTIONS
 WWTP #2 EMERGENCY POWER PROJECT
 C.O.W. PROJECT NO. 468-84956

PEC PROFESSIONAL ENGINEERING CONSULTANTS, P.A.
 303 SOUTH TOPEKA WICHITA, KS 67202
 316-262-2691 www.pec1.com

Designed by	DKC	Job No.	34-14229-001-0042
Drawn by	JTR	Date	4/29/15

Sht. S2.1 of 37