

SERVICE RECORD

CONSTRUCTION RECORD

TRAP AREA


EAST SUB MAIN "A" ON GILBERT & LAT. N.

S.S.#1-1889

Plat 9-55

Rep-2000-02029- 8335 Market - 9/13/00 - Wichita Ex 4"sch40, Repl trap in alley 4' from main - Dirt Alley cut

RECONSTRUCT SANITARY SEWER 1420 - PHASE III
PROJ. NO. 468-81966 (630541)
BUILT BY W.B. CARTER
BOOKED 5-4-95 FROM AS BUILTS

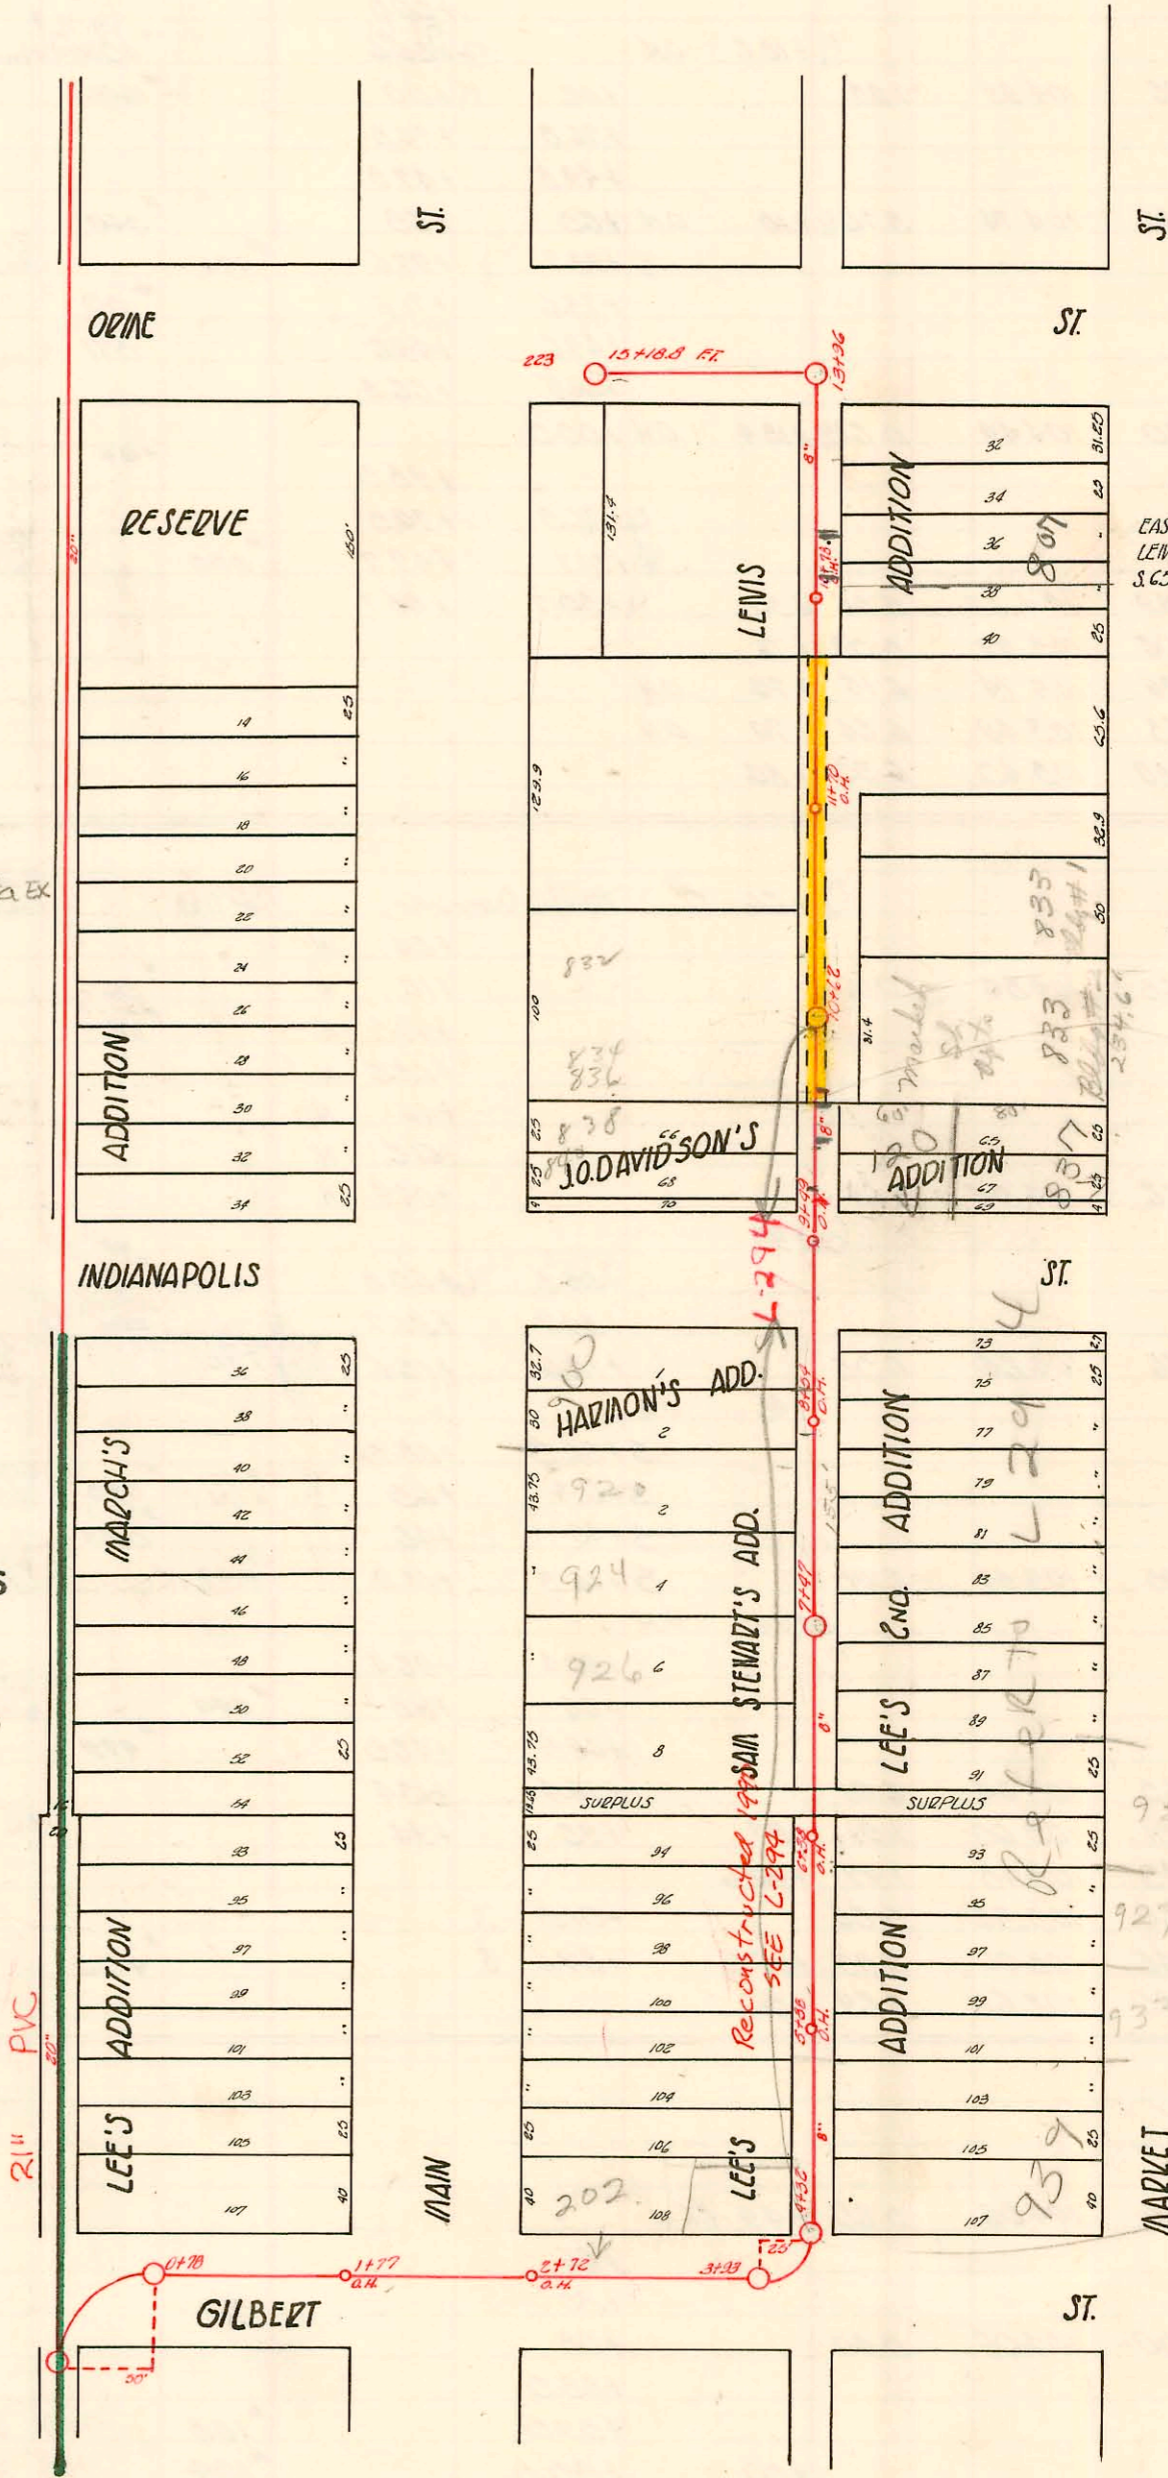

CONSTRUCTION RECORD						SERVICE RECORD						
STATION	ELEVATION		Depth	MANHOLE	4-INCH "Y" BRANCHES		No. of Permit		House Number		DATE OF PERMITS	
	Ground	Grade			North West	South East	North West	South East	North West	South East	North West	South East
15	108.00	105.66	2.34	+19 FT.	+17.5	S						
					+93.5	S						
					+69.6	S						
14	107.32	105.34	12.08	+96	+41.2	S						
					+84.2		#15213		800 S.		12-24-85	
					+60.3		#7468		Main		2-23-56	
					+36.4		#15314		804 S.		12-28-85	
							166		Main		4-28-16	
13	103.92	105.02	-1.10	13 +78	+10.5	S	#593		803 S.		9-17-09	
				12 +78	+28.7	S	#20604		Market		5-11-88	
					+90.4		#22		809 S.		3-12-07	6-11-09
					+66.3		#20605		Market		5-11-88	
					+38.5		#612		810 S.		12-27-12	6-28-10
					+40.5		#13		Market		2-26-08	4-14-17
12	102.62	104.70	-2.08	+70	+14.4	S	#34910		806 S.		10-7-91	
				O.H.	+90.5	S	327		Main		7-5-12	
					+66.4		#2322		801 S.		9-9-50	
					+42.4		C43953		Market		3-13-74	
11	103.68	104.38	-0.70		+18.3	S	#227		805 S.		4-8-80	
					+94.2		563		Market		4-18-83	10-31-72
				10 +62	+70.3	S	#35701		821 S.		7-18-10	
					+45.9		409		Market			
					+47.9							
10	104.00	104.06	-0.06		+81.6	S	#971		839 S.		8-9-88	3-13-74
				9 +49	+95.5	S	C43954		Market		2-3-10	
				O.H.	+71.5	S	#48		839 S.			
					+73.5		#237		Market		2-20-63	
					+47.8							
					+45.8							
9	103.55	103.74	-0.19		+61.9	S	#27029		900 S.		2-7-91	
				8 +54	+98.2	S	447		Main		8-12-13	
				O.H.	+74	S	#3192		Market		3-18-41	10-27-36
					+50.5	S	27049		Market		3-20-89	
					+24.6	S	77		Market		4-23-83	2-3-86
8	103.44	103.42	0.02		+40.3	S	#78		Market		2-3-86	
					+76.4	S	13723		Market		1-3-61	
				7 +47	+50.6	S	425		Market		7-10-09	
					+84.4							
					+100.3	S	#51		Market		2-24-09	2-4-10
					+76.6		#61		Market			
					+52.4	S	#99		Market		6-14-05	4-10-09
6	103.77	102.78	0.99		+28.5	S	#177		Market		12-18-06	3-4-09
					+40.5	S	#260		Market		4-13-08	
					+81.1	S	#234		Market			
					+57.1	S	#1765		Market		10-17-88	
					+33	S	742		Market		5-29-11	
5	104.17	102.46	1.71		+89	S	#247		Market		12-19-05	
					+87	S	#480		Market		5-11-82	5-5-05
					+61	S	#190		Market		8-21-08	
4	104.69	102.25	2.44		+39.4	S	#461		Market		7-26-09	9-27-04
					+14.4	S						
3	104.95	101.82	3.13		+93	S						
2	105.62	101.50	3.72		+72	S						
1	107.58	101.18	6.50		+77	S						
0	108.14	101.11	7.23		+78	S						

C42300 - 819 S. Market - Sewer - Al Henning - 11-16-73 (11+70.7)

C56881 - 925 S. Market - Sewer - Al Henning - 7-26-76 (46.7 ft of 1 pipe line)

#2355 - Tap - 115 E. Olive - S - 27.53 - Cas Clayton

93-28947-12625 Bonduy - 130 E. Indianapolis - Sewer - 4-11-60 (10+16)

93-28947 - 5/8 5 ft South of NPL - 1 ft inside WPL (11-12-93)