

N




SCALE: 1" = 100'

MAIN "A" FROM LEWIS TO ENGLISH

S.S. #1 - 1889

TRAP AREA

Plot 9-52

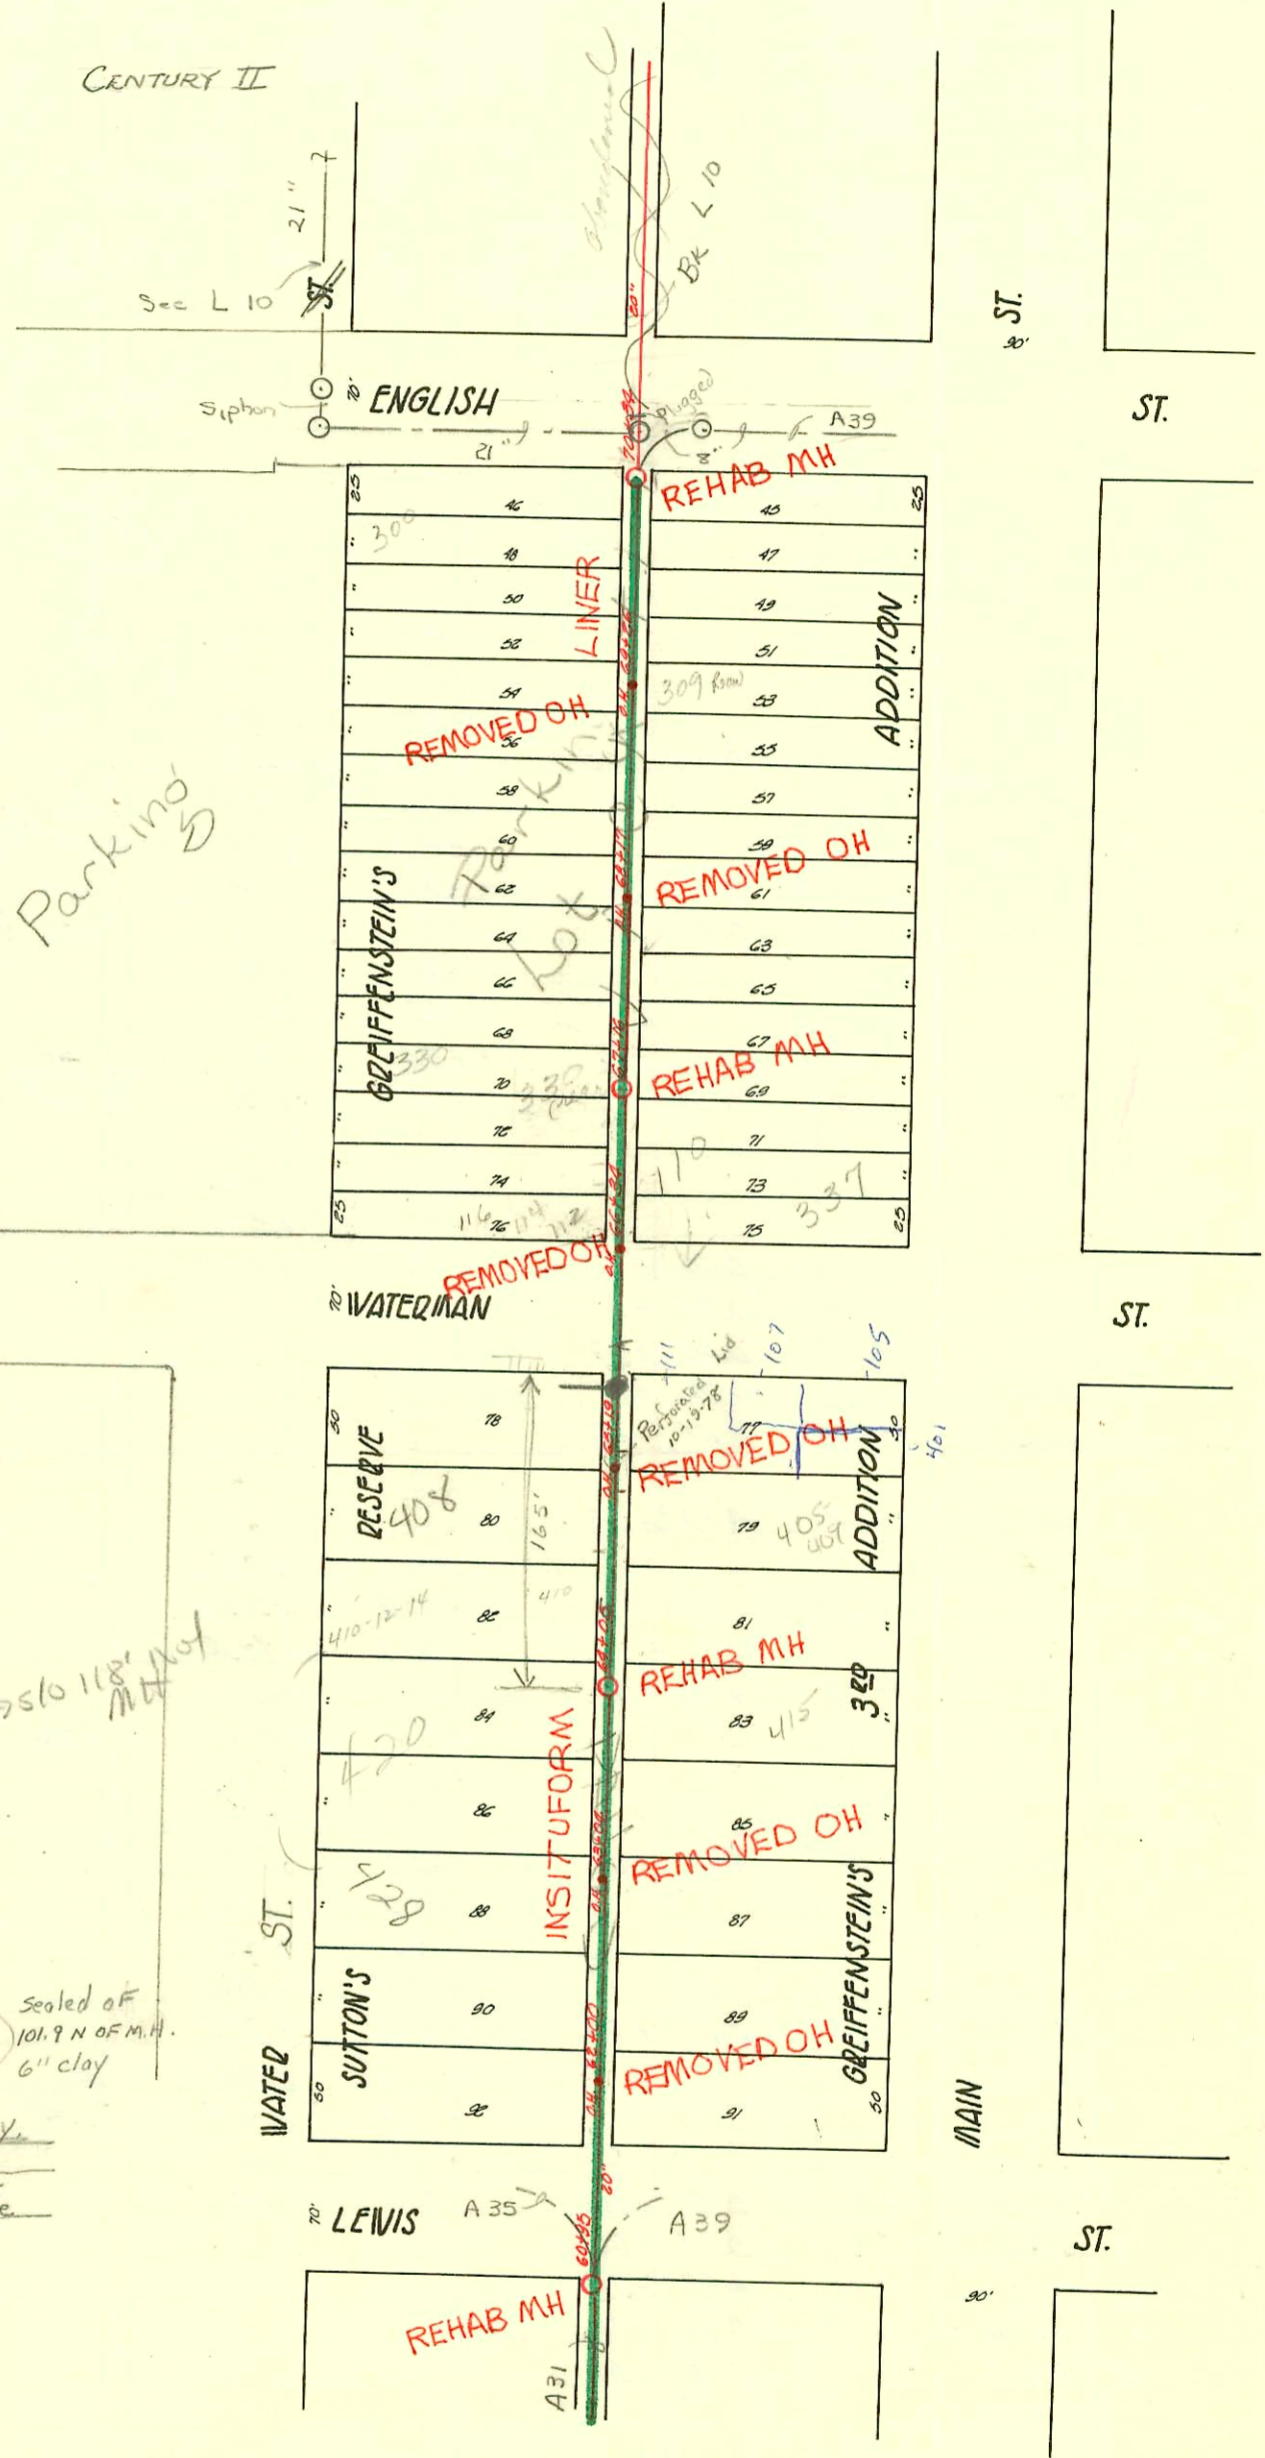

RECONNECTIONS

STATION	ADDRESS	DIRECTION
65+83.7	107 W. Waterman & 401 S. Main	East
65+30.9	105 W. Waterman & 111 W. Waterman	East
65+09.4	409 S. Main	East
63+93.4	420 S. Water	West
63+74.8	415 S. Main	East
62+03.9	120 W. Lewis / 114, 116 & 118 W. Lewis / 436 S. Water	West

94-12860-7 8-12-94 420 S. Water (Bldg just S. of 420) Sealed off 101.9 N of M.H. 6" clay

#94-12859-7 - 8-12-94 - 420 S. Water - Sealed off 103.9 N of M.H. 6" clay.

#94-12858-7 - 8-12-94 - 436 S. Water = TWO Sealed off 6" clay 18' N of A manhole. 6" clay 116' N of A manhole.

RECONSTRUCT SANITARY SEWER NO. 1 + 20
 PROJ. NO. 468-81996 (630541)
 BUILT BY INSITUFORM PLAINS, INC.
 BOOKED 5-16-94 FROM AS BUILTS

CONSTRUCTION RECORD

SERVICE RECORD

STATION	ELEVATION		Depth	MANHOLE	4-INCH "Y" BRANCHES		No. of Permit		House Number		DATE OF PERMITS			
	Ground	Grade			North West	South East	North West	South East	North West	South East	North West	South East	North West	South East
70	110.83	103.64	7.20	+34	+17	+10	# 73	# 5027	115 W. English	301 S. Main	5-27-47	2-3-66		
					+91.4	+89.4	# 1031	# 5028		303 S. Main		2-3-66		
					+67	+65	# 245	# 15009	300 S. Main	307 S. Main	12-20-67	11-16-68		
69	110.64	103.54	7.10	+86 OH	+41.8	+39.8	# 285	# 1775125	308 S. Main	309 S. Main	12-4-06	12-1-61		
					+16.6	+14.6	# 480	# 1904	310 S. Main	311 S. Main		3-8-94		
					+91	+89	# 1548	# 1775125	317 S. Main	319 S. Main		11-6-83		
					+65.9	+63.9	# 875	# 1775125	318 S. Main	319 S. Main		4-15-13		
68	111.12	103.44	7.68	+17 OH	+40.4	+38.4	# 668	# 1775125	319 S. Main	320 S. Main	8-2-09	1-28-11		
					+10.4	+13.4	# 668	# 1775125	320 S. Main	321 S. Main	10-19-83	8-16-83		
					+89.9	+87.9	# 668	# 1775125	322 S. Main	323 S. Main		11-30-37		
					+65	+63	# 668	# 1775125	324 S. Main	325 S. Main		4-15-42		
67	111.21	103.34	7.87	+16	+20.7	+18.7	# 402	# 1775125	328 S. Main	330 S. Main	5-9-17	2-24-67		
					+89.5	+87.5	# 402	# 1775125	331 S. Main	332 S. Main	6-15-17	9-9-01		
					+63.4	+61.4	# 402	# 1775125	333 S. Main	334 S. Main		8-9-09		
66	110.44	103.84	7.20	+34	+37.8	+35.8	# 668	# 1775125	335 S. Main	336 S. Main	3-28-67	11-17-66		
					+48.7	+46.7	# 668	# 1775125	337 S. Main	338 S. Main	5-7-17	5-28-09		
65	110.00	103.14	6.86	+19	+83.7	+81.7	# 340	# 1775125	339 S. Main	340 S. Main	9-4-00	7-3-09		
					+99	+97	# 340	# 1775125	341 S. Main	342 S. Main	2-26-29	7-2-61		
					+73.8	+71.8	# 340	# 1775125	343 S. Main	344 S. Main	6-14-17	11-8-4		
					+48.6	+46.6	# 340	# 1775125	345 S. Main	346 S. Main	2-26-89	11-5-63		
64	109.88	103.04	6.84	+106	+83.7	+81.7	# 46	# 1775125	347 S. Main	348 S. Main	5-25-18	10-5-18		
					+98.7	+96.7	# 46	# 1775125	349 S. Main	350 S. Main		9-23-67		
					+73.5	+71.5	# 46	# 1775125	351 S. Main	352 S. Main	3-24-04	11-6-03		
					+48.8	+46.8	# 46	# 1775125	353 S. Main	354 S. Main	5-24-00			
63	110.08	102.94	7.14	+04	+83.1	+81.1	# 355	# 1775125	355 S. Main	356 S. Main		12-1-06		
					+98	+96	# 355	# 1775125	357 S. Main	358 S. Main		1-6-92		
					+73	+71	# 355	# 1775125	359 S. Main	360 S. Main		7-2-81		
					+48.1	+46.1	# 355	# 1775125	361 S. Main	362 S. Main				
62	110.04	102.84	7.20	+00	+83	+81	# 163	# 1775125	430 S. Main	431 S. Main	7-21-08	11-23-83		
					+97.9	+95.9	# 163	# 1775125	432 S. Main	433 S. Main	7-21-08	5-21-06		
61	109.65	102.74	6.91		+70.6	+70.6	# 165	# 1775125	434 S. Main	435 S. Main	7-21-08	3-13-80		
60				+95							1-29-01			

3570 - 415 S. Main - 7-2-81 - Al Henning
 16768 - 438 S. Water - 7-31-86 - Al Henning - (48' S of OH is 56)
 67473 - 438 S. Water - Al Henning - 7-21-88 (62+18.6)
 C2421 - Seal off 338 S. Water (Rev) 3-28-67 - J. C. Lewis
 #117 - Private Line - 111 W. Waterman - 5-16-31 - F. Hoff & Son
 #119 - Tap - 111 W. English - 623-36 - J. C. Lansdowne
 #134 - 109 W. Waterman - 4-14-37 - Dermody - Tap
 #371 - Private Line - 401 S. Main - Dermody - 7-26-37
 #347 - Tap - 114 W. Waterman - 7-1-48 - Seal off - #1580 112-114 W. Waterman (J. C. Lewis) (66+56.1)
 #3968 - Used old connection - 101 W. English - 8-27-51
 #796 - Tap - 420 S. Water - 4-28-54 - Joe 115 Donald
 #5333 - 409 S. Main - 5-25-53 - Thompson - Used old connection - Seal off
 #6593 - Tap - 420 S. Water - 9-30-53 - Joe 115 Donald
 B1661 - Tap - 420 S. Water - Rob McElroy - 7-19-64 (63+90)