
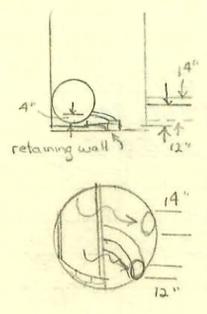


Plat 9-49

TRAP AREA

MAIN "A" FROM DOUGLAS AVE. TO FIRST ST.
EAST SUB MAIN "A" IN ALLEY NORTH OF DOUGLAS & BRANCHES N. & S.
S.S. #1-1889

Scale 1" = 100'

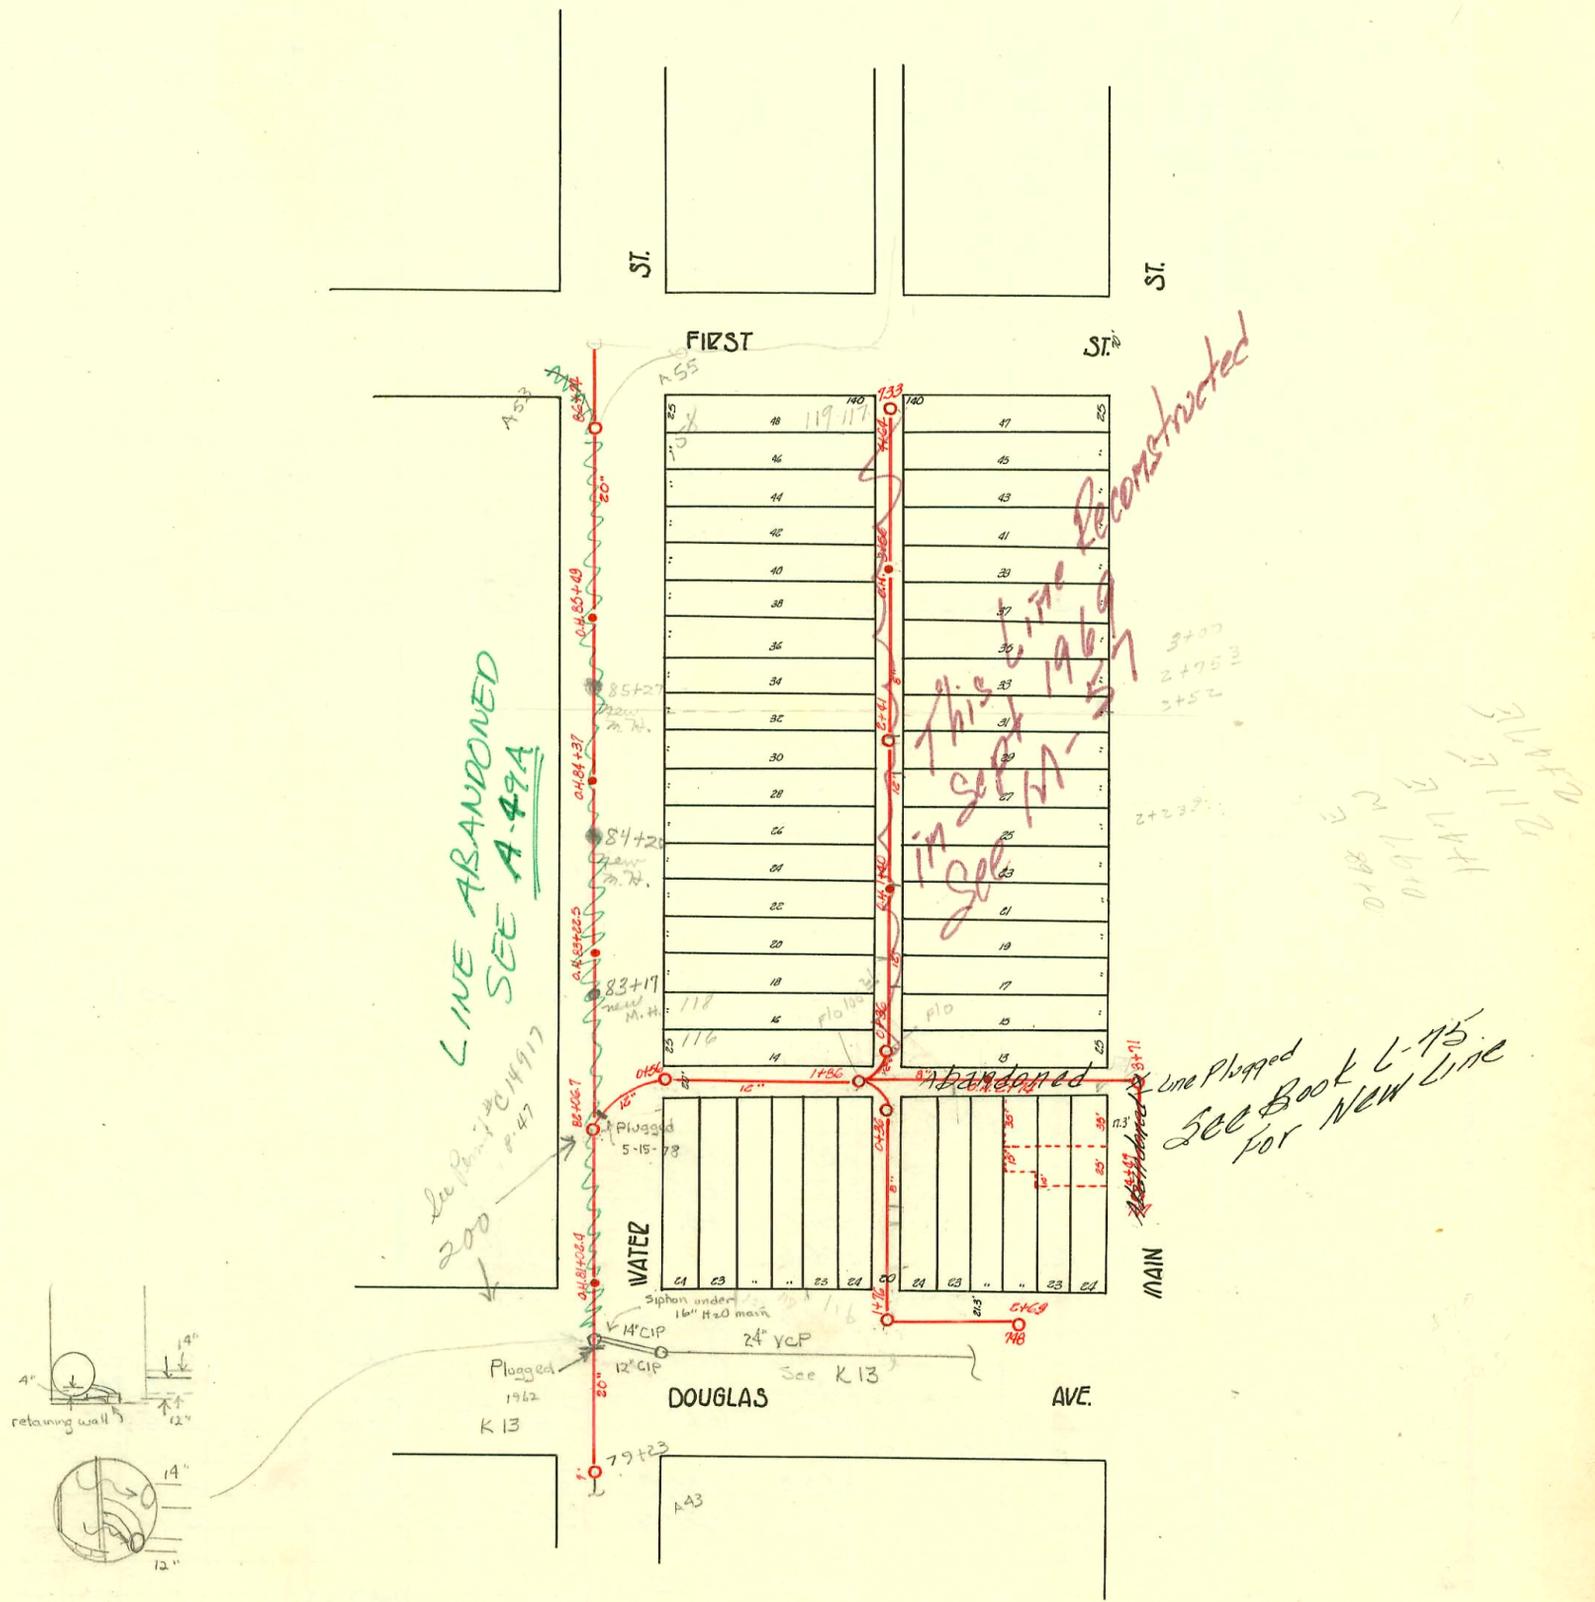

3+00
2+75.3
3+52
2+232.1
0+18
0+94
0+114
0+134
CONSTRUCTION RECORD						SERVICE RECORD						
STATION	ELEVATION		Depth	MANHOLE	4-INCH "Y" BRANCHES		No. of Permit		House Number		DATE OF PERMITS	
	Ground	Grade			North West	South East	North West	South East	North West	South East	North West	South East
	112.76	107.91	4.85	+64 F.T.			#1264 1014		117-9 W 157-5		12-19-66 6-20-19	
4	112.58	107.65	4.93		+54.0 +44.8 +30.4 +23.3 +97		#49 #137		3/2 W. 2nd no record		(11-9-90) 10-31-90	5-26-91
3	112.44	107.25	5.19	+56 O.H.	+78 +76 +54 +50 +26.9 +24.9 +02		#822 #137 #181 #114 #114	11273	no record 149-51 W. Main St		10-9-11	8-28-59 8-24-05
2	112.15	106.85	5.30	+41	+25.9 +01.6	+23.9 +99.6	new #1192 #178		146 N. Water 142 N. Water no record	143 Douglas No record	3-22-17 12-29-03 9-19-90 9-19-90	9-12-93 9-9-90 6-17-90
1	112.13	106.45	5.68	+40 O.H.	+77.2 +53.7 +27.8 +03 +79.1 +58	+75.2 +51.7 +65.8 +4 +77	#135 #326 #60 #227 #1386		124 N. main 118 N. Water 119-121 W. Main		6-3-09 8-10-92 4-6-08 3-17-65	6-3-09 6-3-09
0	112.13	106.21	5.92	+36	+39.7 +36	+36	#209C #13839 #39		116 N. Douglas 116 N. Water		9-13-24 3-9-61	8-22-98 5-23-90
	111.72	107.30	4.42	+69 F.T.		+64.4 +58.2	#57		no record			3-7-92
1	112.04	106.72	5.32	+76		+435 N.	#575		SE CORNER 3 RD EMPLOYER			6-21-11
0	112.06	106.21	5.85	+36	+112 +58.3	+09.2 +56.3	#2019 #5107	#36	116 N. Douglas 112 W. Douglas	119 N. main	9-5-24 8-15-57	3-31-05
	112.30	107.10	5.20	+45.5 F.T.		+42.3 +21.2 +15.1	#72				3-06-02	
4												
3	112.54	106.83	5.71	+71 +74 O.H.	+89.9 S +60.7 S +39.8 S		#848		1st NAT'L BANK		6-8-99	11-17-20
2	111.77	106.05	5.72	+86	+16.8 S +71.5 S +49.8 S +27.8 S	+14.8 N	#150 #377 #81 #440 #112 #112		1031 N. 2nd 116 N. Water 116 N. Water 116 N. Douglas		10-9-90 9-7-61 7-21-90 7-15-14 3-11-66 3-16-96	
1	111.99	105.74	6.25		+06 S +84 S		#586 #6 #126		116 N. Water 124 W. Douglas Douglas		7-29-98 4-23-23 8-14-06	
0	111.93	105.57	6.36	+56	+60 S						6-14-93	
+62	112.78	105.30	7.48									
86	112.79	105.24	7.55	+74								
85	112.48	105.14	7.34	+49 O.H.								
84	112.27	105.04	7.23	+37 O.H.								
83	112.11	104.94	7.17	+22.5 O.H.								
82	111.80	104.84	6.96	+06.7								
81	111.73	104.74	6.99	+08.4 O.H.								
79				+73								

C 22916 - 220 W. Douglas (Kiva) - new M.H. on 20" line 83+17.7 - Kendall Pkg. - 2-12-71
 C 15739 - 250 W. Douglas (Holiday Inn) - new M.H. on 20" line 84+29 - Mid-States Const 9-14-69
 C 15742 - 135 W. Douglas (Theatre) - new M.H. on 20" line 85+27 - Mid-States Const 9-4-69 (6 stub %)
 #15885 - 250 W. Douglas - Central Air Condt. - 250 W. Douglas - 10" line to M.H. 84+20 - 9-12-69 (Stub out of M.H.)

C 1265 - Sealoff (148 + 152 N. Water) - no tapping 12-19-66
 # 988 - 124 W. Douglas - 6-9-19
 # 181 - Tap - 129 N. Main - 61-36 - Moore - Robertson Pkg. Co.
 # 1049 - Private Line - 143 N. Water - 9-8-93 - Harley Diggs
 # 119 - Private Line - 123 W. First - 6-1-48 - Baker Pkg. Co.
 5106 Tap - 112 W. Douglas - Robertson 8-15-57
 5108 Tap - 8-15-57 6" x 8"
 5109 6" x 8" 112 W. Douglas 8-22-57

not sealed by Unbonded