

CONSTRUCTION RECORD


Plat 9-46

WEST SUB MAIN "A" ON WALNUT (NOV 8<sup>TH</sup> ST.) & LAT. N. & S.

S.S. #1-1889

TRAP AREA

Private 6" San. Sewer  
Information from  
Glenn Rousseau  
5-15-58  
S.W.

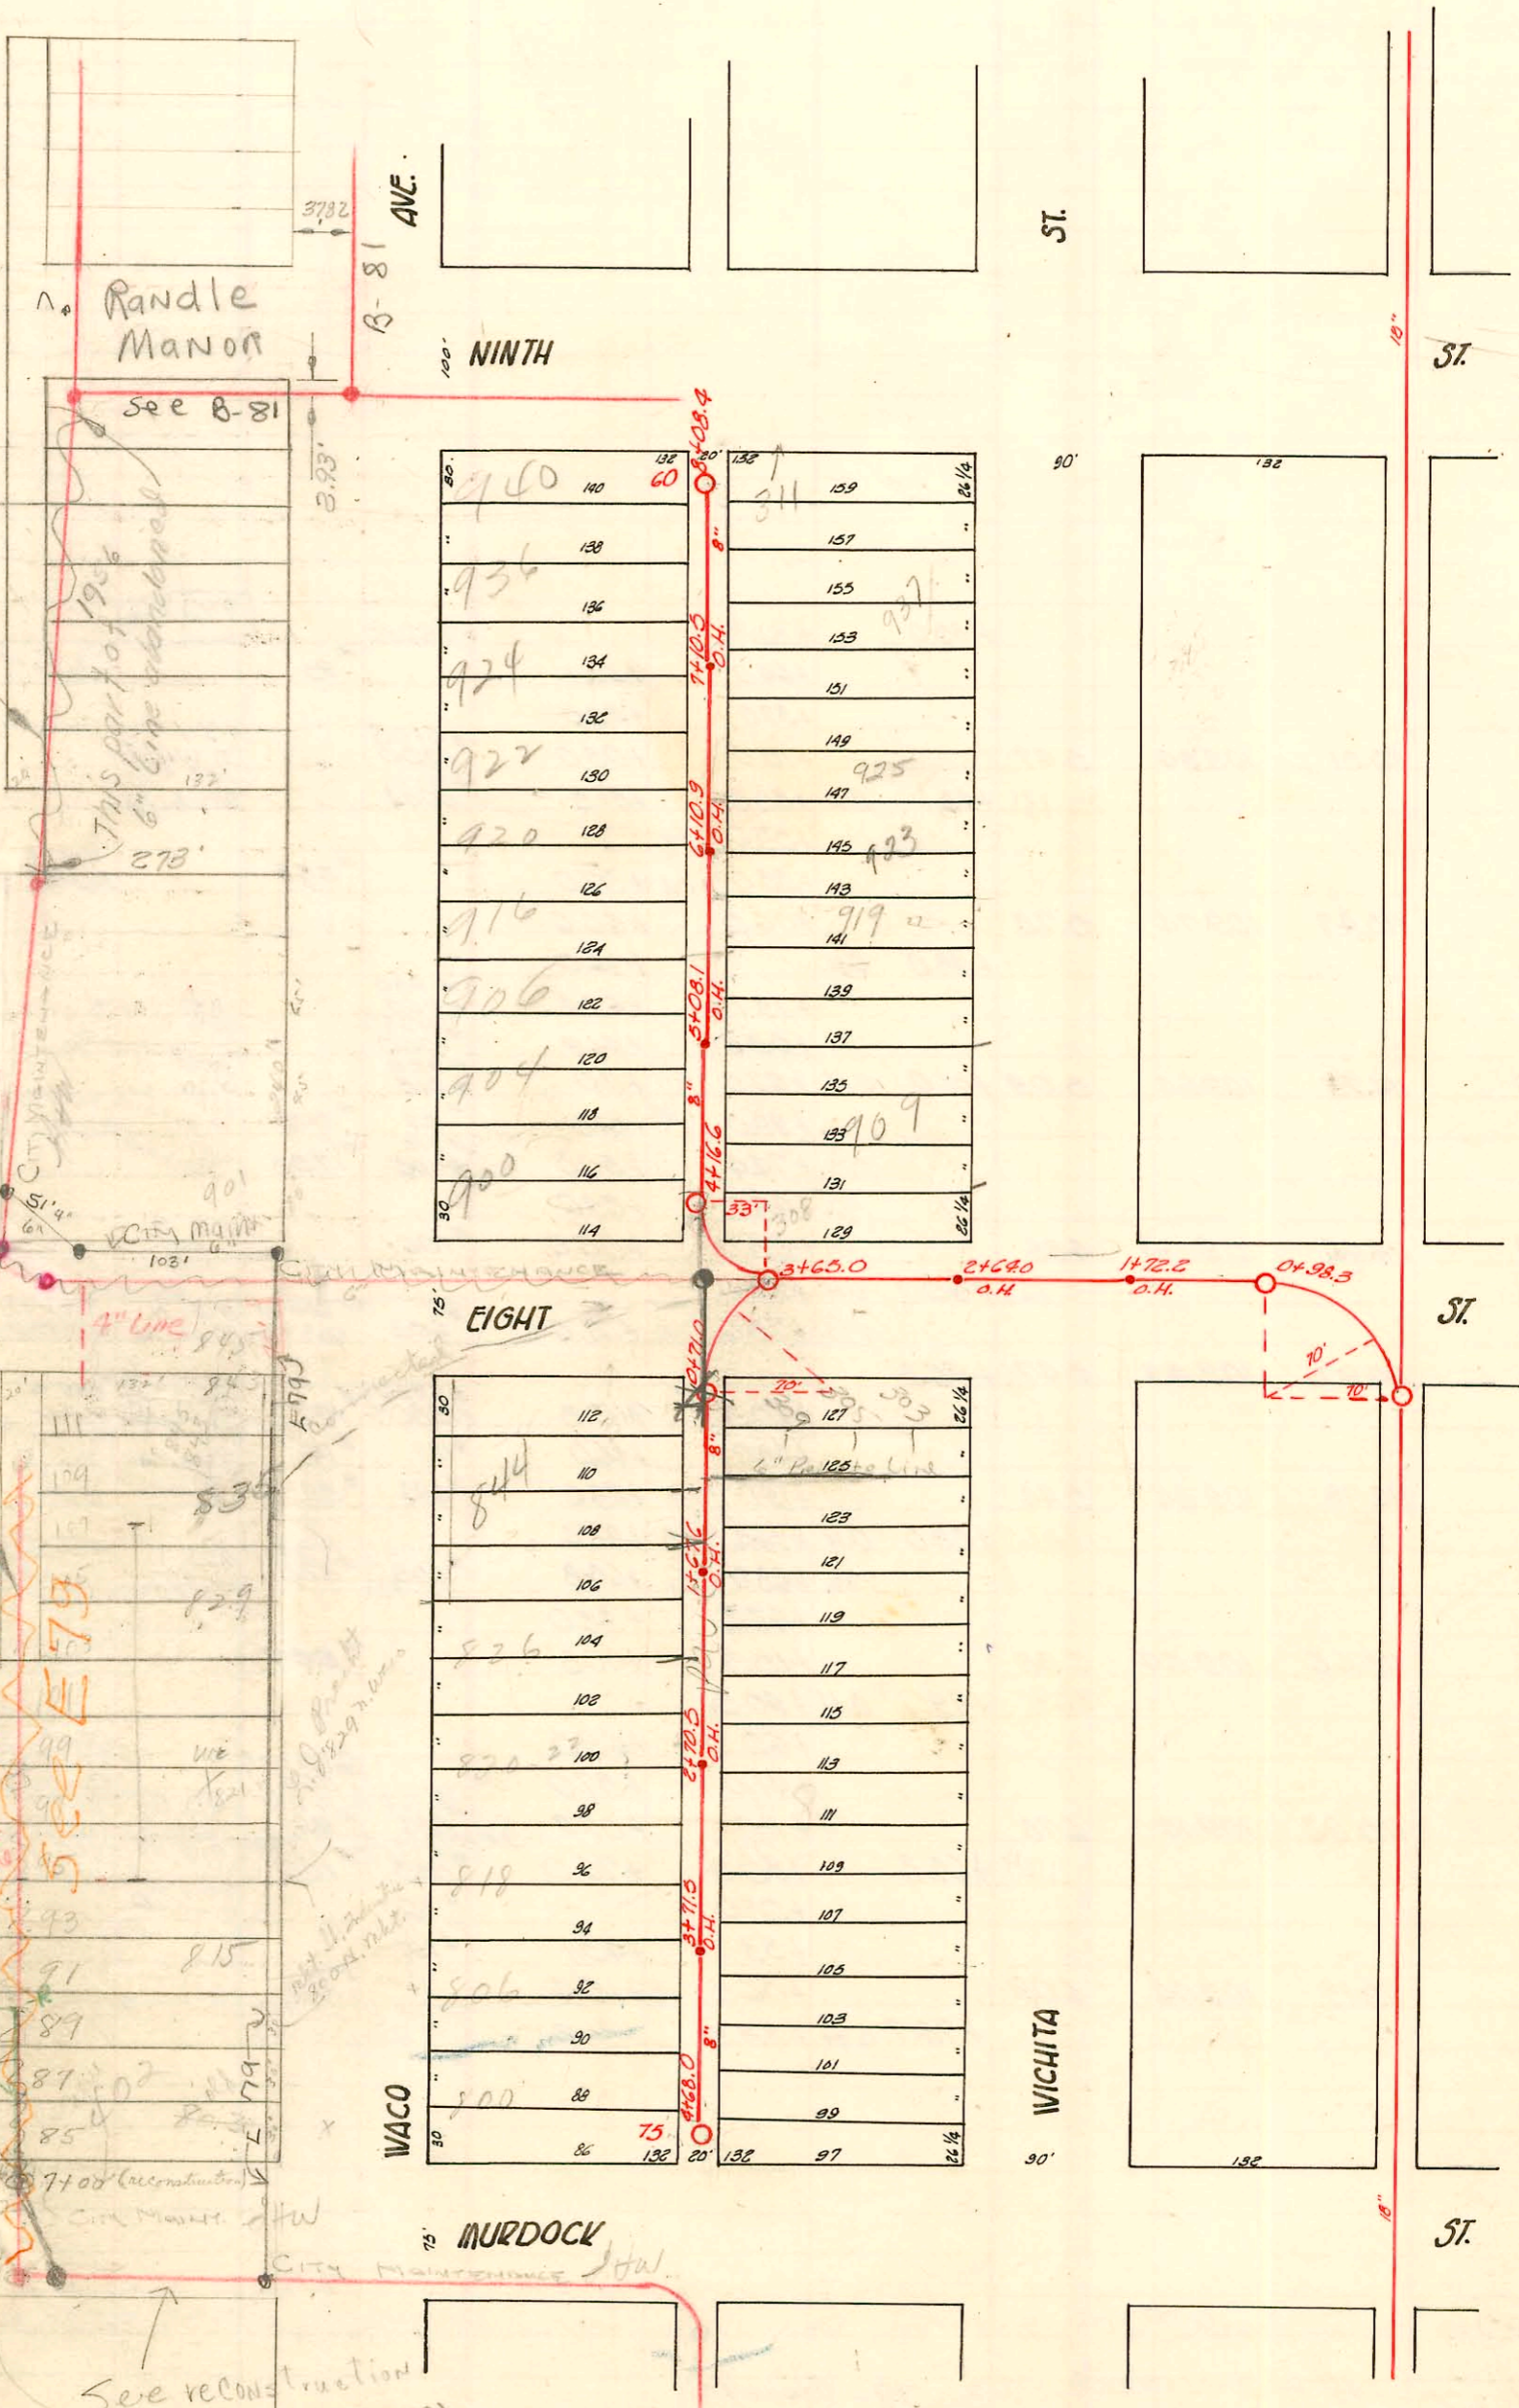

Relocation: 85 N. of M.H. (1+00)  
2.9 m.  
80.6 m.

ABANDONED  
SEE E 79

See reconstruction  
on Park Plaza (M-108)

6482-309 w. 8± Al Henning - 9-3-82 0171.0 S. (303-5-9 tied together on 6" Private line)  
at 1095 3/4 M.H. on Street

8-24-79 - 815 N. Waco - Tie on new line not marked

94-19783-7 12-8-94 404 Back Bay Blvd - Repair - D.L. tied onto Clay tile at Street curb  
at Back Bay Blvd - 33ft West of M.H.  
MH at side walk line of Waco on Back Bay Blvd  
Partial 12/9/94 PVC 40 1/4" Fall Dam

