

MAIN "B" FROM LINCOLN ST. TO GILBERT ST.
S.S.#1-1889


TRAP AREA

Plat 9-54

RECONSTRUCT SANITARY SEWER NO.
1 AND 20 (SOUTH OF DOUGLAS)
PROJ. NO. 468-81996 (630541)
BOOKED 12-4-92 FROM AS BUILTS
BUILT BY INSITUFORM PLAINS INC.

RECONNECTIONS

STATION	ADDRESS	DIRECTION
27+48.2	1144 S. Broadway	West
27+88.2	1142 S. Broadway	West
28+78.2	1130 S. Broadway	West
29+19.4	1130 S. Broadway	West
30+89.1	1130 S. Broadway	West
33+24.9	1045 S. Topeka	EAST
33+40.9	1046 S. Broadway	West
33+63.4	1039 S. Topeka	East
33+65.8	1040 S. Broadway	West
34+13.7	1031 S. Topeka	East
34+34	1030 S. Broadway	West
34+38	1025 S. Topeka	East
34+87.8	1024 & 1026 S. Broadway	West
35+10.3	1021 S. Topeka	East 1-18' on
35+67.4	1015 S. Topeka	East
35+91	1011 S. Topeka	East
35+92.7	1012 & 1014 S. Broadway	West 1-26' on
36+39.1	1006 S. Broadway	West
36+41.3	1007 S. Topeka	East
36+65.8	1003 S. Topeka	East
36+92.4	1001 S. Topeka 321 & 323 E. Gilbert	East
36+94.4	1002 S. Broadway	West

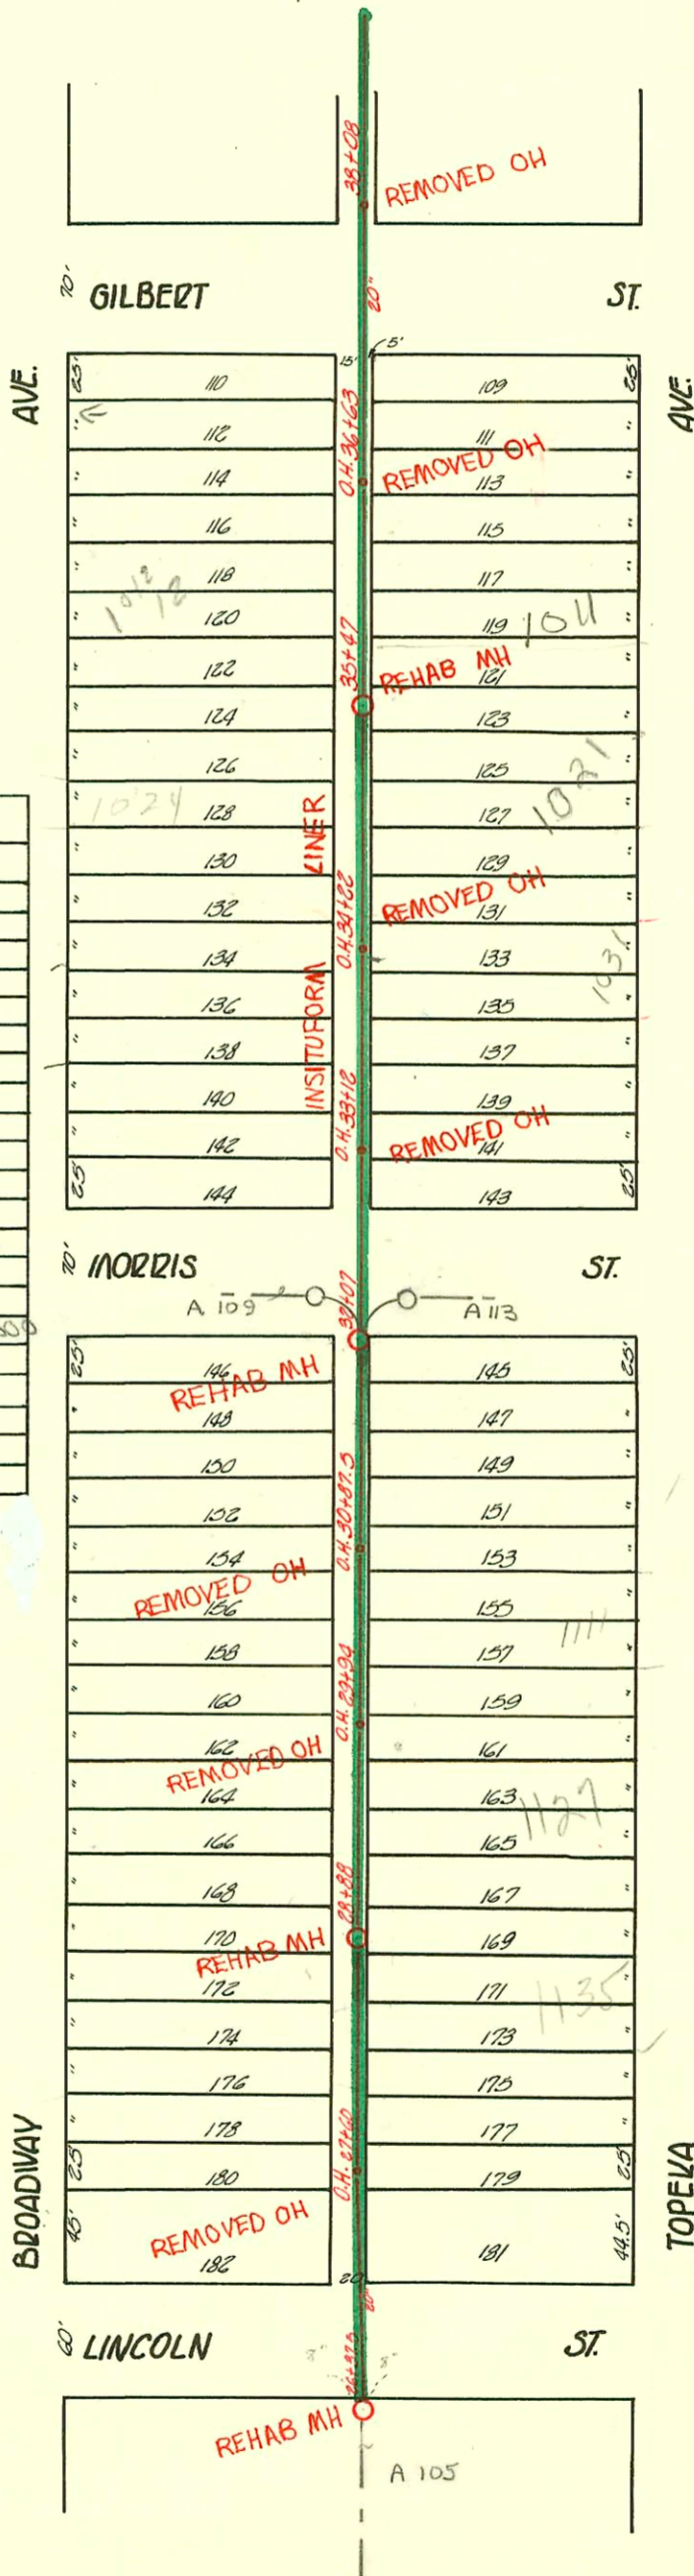

CONSTRUCTION RECORD							SERVICE RECORD						
STATION	ELEVATION		Depth	MANHOLE	4-INCH "Y" BRANCHES		No. of Permit		House Number		DATE OF PERMITS		
	Ground	Grade			North West	South East	North West	South East	North West	South East	North West	South East	
				+08.0 O.H.									
38	108.49	99.74	8.75		+08.0	+00.0							
37	108.16	99.64	8.52		+07.0	+05.0	# 218		1003 S. Topoka			10-13-06	
				+63.0 O.H.	+84.0	+86.0	# 44	# 101	No Record	1003 S. Topoka	5-21-91		8-11-03
					+57.0	+55.0		# 103	1007 S. Topoka				10-8-03
					+36.0	+30.0	# 390		1008 S. Broadway		6-25-09		
36	108.07	99.54	8.53		+07.5	+05.5	# 582	# 151	1044 S. Broadway	1015 S. Topoka	10-2-14		
					+80.5	+78.5	# 75		No Record	1015 S. Topoka	4-28-93		3-26-17
				35	+47.0	+54.5		# 124		1015 S. Topoka	8-26-99		6-8-08
35	107.76	99.44	8.32		+06.5	+04.5							
				34	+86.0	+80.0	# 15124		1024 S. Broadway		2-14-60		
					+57.0	+55.0		# ?	No Record	No Record	4-5-01		11-26-01
34	107.45	99.34	8.11		+07.5	+05.5							
					+83.0	+81.0	# 196		1032 S. Broadway		3-1-04		
					+56.0	+54.0	# 2045	5149	1000 S. Broadway	1039 S. Topoka	4-12-98		2-1-82
				+16.0 O.H.	+31.5	+29.5	# 135		1000 S. Broadway		3-19-31		
33	107.39	99.24	8.15		+06.0	+04.0	# 27		1040 S. Broadway		3-28-03		
32	107.52	99.14	8.38	+07.0	+83.0	+89.0	# 44		100 S. Broadway	1045 S. Topoka	12-4-59		1-28-10
					+85.0	+83.5	# 185	# 186	1106 S. Broadway	1161 S. Topoka	8-5-35		10-3-05
					+58.5	+56.5	# 141	# 190	1106 S. Broadway	1163 S. Topoka	6-30-08		10-6-05
31	107.82	99.04	8.78		+09.0	+07.0	# 60		No Record		6-20-91		
				+87.5 O.H.	+85.5	+83.5	# 131			1105 S. Topoka			7-26-05
					+60.8	+58.8	# 675			1111 S. Topoka			5-11-09
					+36.0	+34.0		# 27	1110 S. Broadway	1119 S. Topoka	5-2-08		5-14-10
30	107.46	98.94	8.52		+10.5	+08.5	# 87	# 679					
				+94.0 O.H.	+83.7	+81.7	# 196	# 4875	1126 S. Broadway	1127 S. Topoka	9-4-06		6-7-51
					+59.0	+57.0	# 230			1157 S. Topoka			12-27-41
					+36.0	+34.0							
29	107.66	98.83	8.83		+10.8	+08.8	# 604		1126 S. Broadway		11-14-10		
				+88.0	+85.8	+83.8	# 852		1125 S. Broadway		11-19-17		
					+60.5	+58.5	# 163			1135 S. Topoka			3-22-67
					+30.5	+33.5	# 204		cont. find		7-10-07		
28	107.44	98.63	8.80		+08.5	+6.5	# 85	# 207	1142 S. Broadway	1137 S. Topoka			9-27-51
				+60.0 O.H.	+82.5	+80.5	# 909		308 S. Lincoln		2-8-22		
					+51.7	+49.7	# 210	# 736		1141 S. Topoka	10-25-26		
27	106.49	98.43	8.05		+07.2	+30.5	# 1659			310 S. Lincoln	5-25-16		11-23-09
26				+37.5									12-5-22

#580 - Tap - 1045 S. Topoka - 5-20-29 - George M. Gruber
 #3218 - Tap at 274.55 - 322 S. Lincoln - 5-21-41 - Vernon Stollenberger
 #2761 - Tap - 1137 S. Topoka - 9-22-28 - Vernon Stollenberger
 #2005 - Used Old Connection - 1028 S. Broadway - 1-25-16
 #2626 - Private Line - 1127 S. Topoka - C.B. Brinnon - Trail Her
 #206 - Used Old Connection - 1034 S. Broadway - 6-3-46 - Harley Riggs
 #2229 - Used Old Connection - 1100 S. Broadway - 8-21-56 - Howard F. Cowan
 #362 - Tap - 1128 S. Broadway - Gary Carter - 2-16-59 - 28+66.5
 #363 - Tap - 1128 S. Broadway - Gary Carter - 2-16-59 - 30+83.5
 #27060 - 2-13-91 - 1021 S. Topoka - Gatti Hook - (wye 35+06)