


Plat 9-52

TRAP AREA

WEST SUB MAIN "B" ON LEWIS ST & LAT. N. & S.
S.S. #1-1889

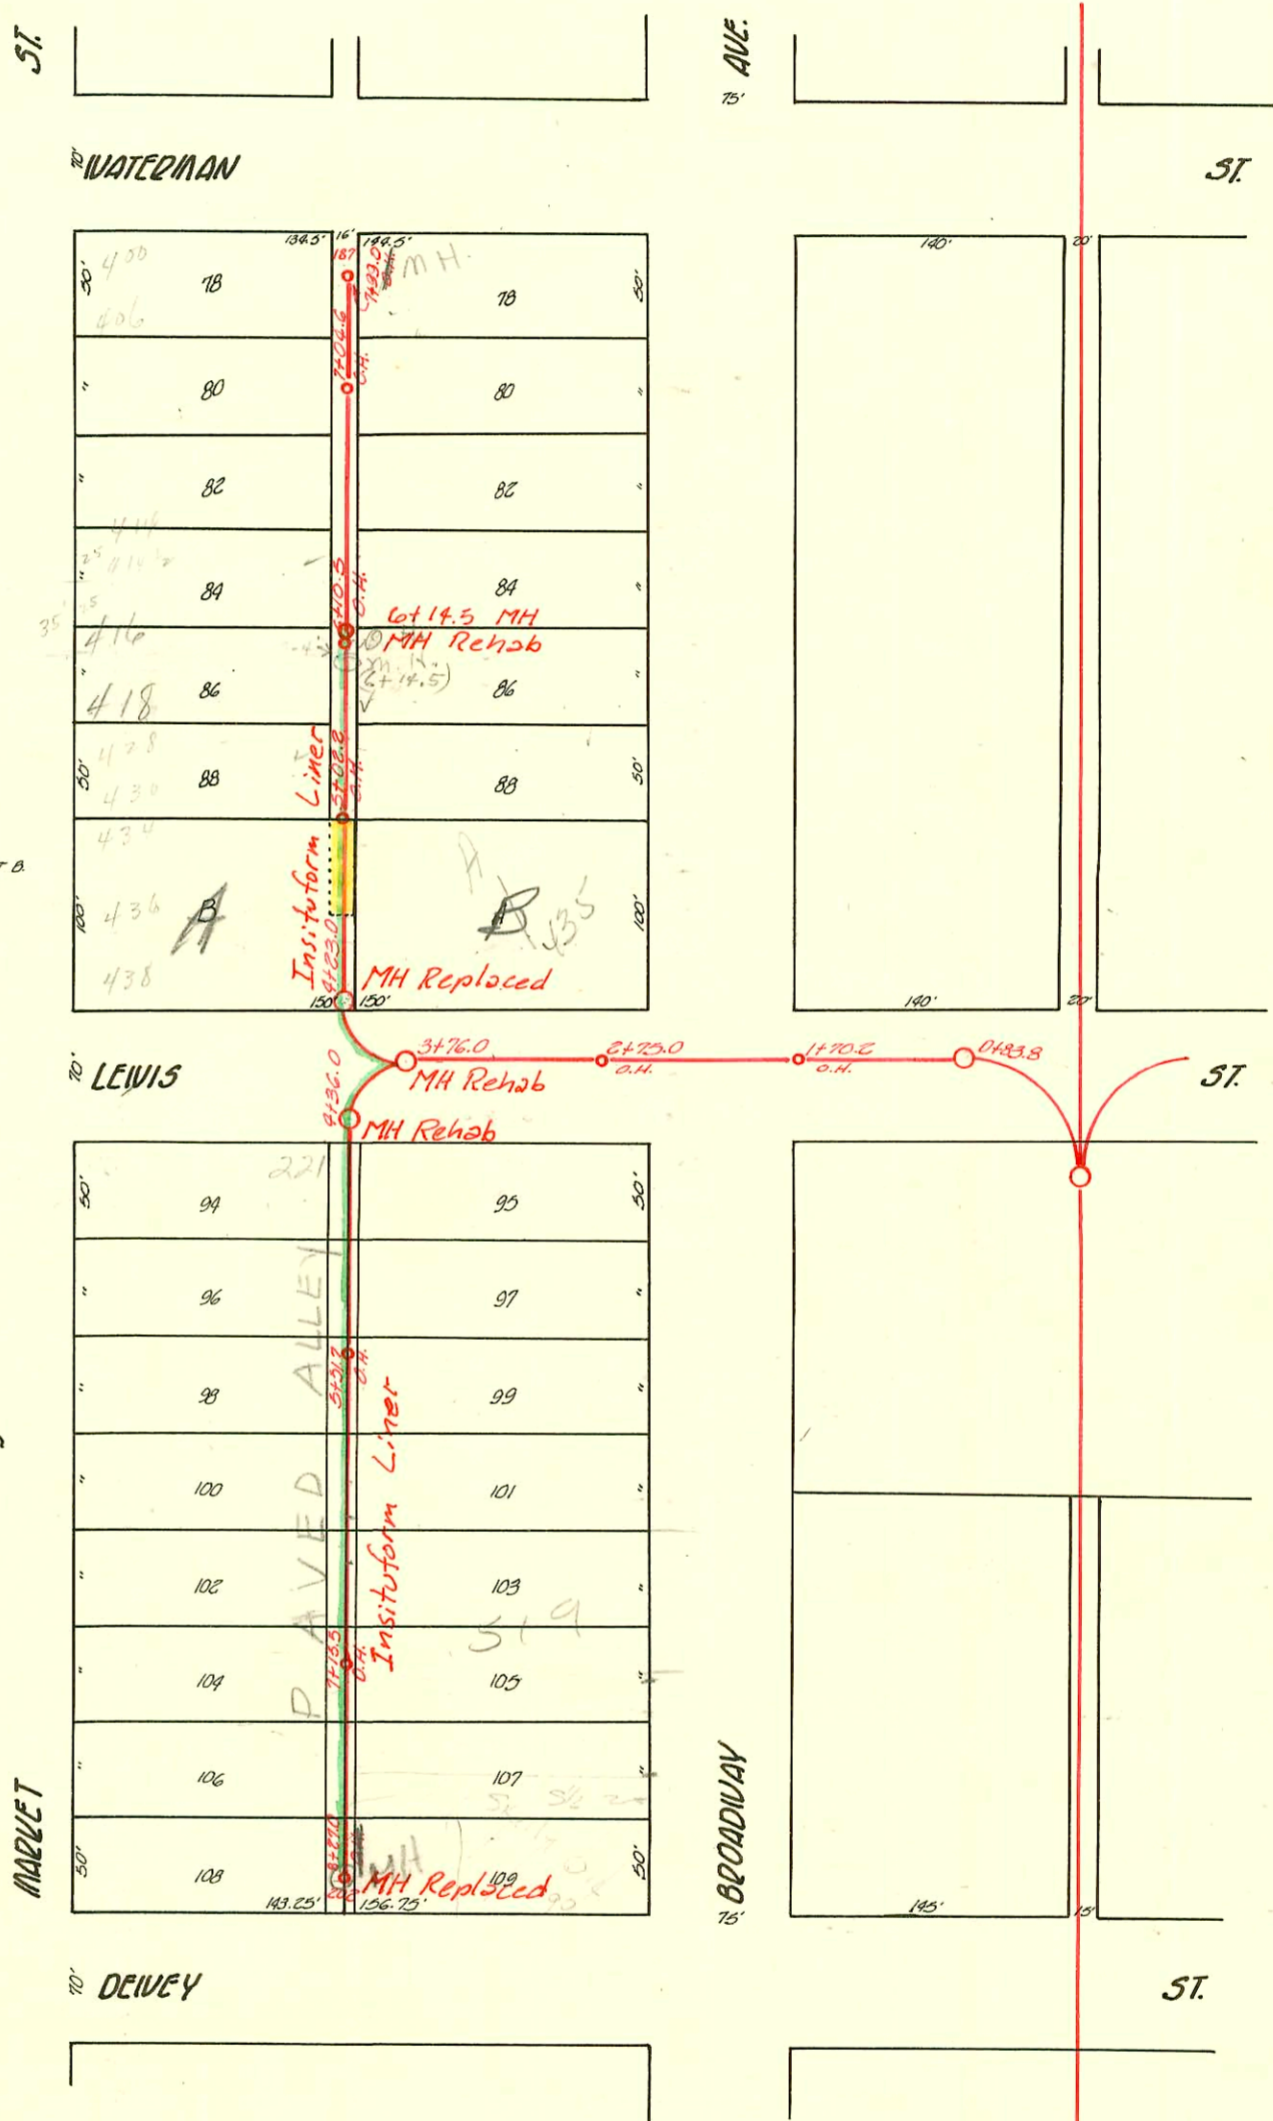

CASEMENT #24: ON EAST END OF N 1/2 OF LOT D

1989 S.S. Reconst. Phs. II
468-82011, (725002)
Built By Insituform
Booked 10-16-90 from Plan

| CONSTRUCTION RECORD | | | | | | | SERVICE RECORD | | | | | |
|---------------------|-----------|--------|-------|--|---------------------------------------|--|---------------------|--|---|-----------------|--------------------------------|---|
| STATION | ELEVATION | | Depth | MANHOLE | 4-INCH "Y" BRANCHES | | No. of Permit | | House Number | | DATE OF PERMITS | |
| | Ground | Grade | | | North West | South East | North West | South East | North West | South East | North West | South East |
| 8 | 109.37 | 105.03 | 4.34 | 8+27.0 ^{FT} OH ¹¹ | +13.0 +89.3 wye +64.7 | +02.0 +00.0 7+65.0 | #293 #313 | 30814 40 53191 31312 | 521 S. Market 700 S. Market 539 S. Broadway | 220 E. Newmyr | 4-22-27 8-22-04 | 3-6-72 6-18-17 12-2-76 7-3-70 |
| 7 | 109.09 | 104.68 | 4.41 | 115.5 O.H. | +40.3 +13.7 +89.0 +64.0 | +42.3 +18.0 +91.0 +66.4 ^{tap} 6+40.0 ^{Alley} | #350 | 132123 93-217467 93-72967 339 | 536 S. Market | 519 S. Broadway | 4-29-26 | 9-23-64 |
| 6 | 109.19 | 104.33 | 4.86 | 6+13.3 | +13.3 +88.9 +51.7 O.H. +37.7 | +15.3 +90.9 +56.1 +39.7 | #? | #2 #2009 #85 3362 | 514 1/2 S. Market | 519 S. Broadway | 4-17-02 | 8-9-01 4-20-45 7-30-91 |
| 5 | 110.16 | 103.98 | 6.18 | 5+15.0 | +15.0 +88.4 +68.2 | +97.0 +90.4 +70.2 | #98 | 72579 #2704 #364 | 500 S. Market | 505 S. Broadway | 6-17-38 | 6-27-79 |
| 4 | 109.40 | 103.75 | 5.65 | 4+36.0 | +36.0 +43.2 | +45.8 | #73 | 211 E. Lewis | 501 S. Broadway | 6-18-06 | 6-5-23 | |
| 7 | 110.01 | 105.17 | 4.84 | 7+10.5 O.H. | +99.0 +94.8 +70.4 +52.0 | +92.8 +68.4 +39.6 | #129 #110 #54 | #1073 | 217 E. Waterman 406 S. Market | 219 E. Waterman | 10-19-03 2-17-28 2-23-98 | 11-14-21 |
| 6 | 109.53 | 104.67 | 4.86 | 6+14.5 O.H. | +10.5 +21.8 +92.8 +68.3 | +19.8 +19.8 +90.8 +66.3 | #28 #116 | #116 | 410 S. Market | 407 S. Broadway | 2-25-98 | 9-1-03 |
| 5 | 109.60 | 104.17 | 5.43 | 5+45.5 O.H. | +106.2 +18.8 +94.0 +69.9 | +16.8 +92.0 +67.9 | #303 | 5302 | 414 S. Market | 411 S. Broadway | 8-9-04 | 3-17-82 |
| 4 | 109.58 | 103.79 | 5.79 | 4+23.0 | +44.9 +17.9 | +42.9 +15.9 | #? | deal off 11985 11983 | 416 S. Market | 418 S. Market | 4-3-70 5-4-03 5-7-07 | 7-24-99 5-22-00 12-11-17 6-22-99 |
| 3 | 108.85 | 103.56 | 5.33 | 3+16.0 | | | | | | | | |
| 2 | 109.34 | 102.93 | 6.41 | 2+15.0 O.H. | | | | | | | | |
| 1 | 108.70 | 102.58 | 6.12 | 1+10.0 O.H. | | | | | | | | |
| 0 | 108.71 | 102.58 | 6.19 | 0+83.8 | | | | | | | | |

N/C #9113 435 S. Broadway (Kishland) 8-31-83 m.x. 4+23 (6'6" N of m.H.) (+89.0)

N/C 5382- 411 S. Broadway 3-17-82 Donald Thompson 6+14.5

C 62606- 555 S. Broadway - top 8-17-77 - Sea Laffer (7+65.3)

C 62156 - (E 14 1/2 S. Broadway) - 7-20-77 - T. Smith

50 C 59192 - 200-02-04-05-06-07-08-09-10-11-12 S. Broadway - July - 12-20-76 (7+79)

C 31310- 539 S. Broadway Randall Kelly 4-3-72 Seal off - (7+09.1)

#5963- Private Line - 625 S. Broadway - 11-3-42 - J. C. Lansdowne

#1401- Used Old Connection - 512 S. Market - 1-7-48 - E. B. Brinnon

#1610- Tap - 406 S. Market - 2-17-48 - Davidson Pkg. Co.

#7060- Used Connection - 515 S. Broadway - 12-15-55 (137.5 South of M.H. 4+36 in Lewis) 4 26156 436 S. Market (Oak Pine Cor Lot) - 12-13-90 - H. Hennings - (510 21' W of m.H. at O.H.) 5+09)

#666 Tap 437 S. Broadway - 1-28-51

#7278 Seal off 424 S. Market - 7-7-58

#11857 Seal off 429 S. Broadway - 11-12-59 (5+60) (50.7 3/4) (5+64.3)

#11984 Seal off 437 S. Broadway - 12-11-59 (4+52.9)

#14612 Seal off 401 S. Broadway - 8-30-61 (7+30)

#B 4512 Seal off 401 S. Broadway - Donald Thompson - 11-10-65 (7+30)