


TRAP AREA

Plant 9-53

MAIN "B" FROM WATERMAN ST. TO WILLIAM ST.
S.S. #1-1889

200 S. Broadway
AKA 204 S Broadway

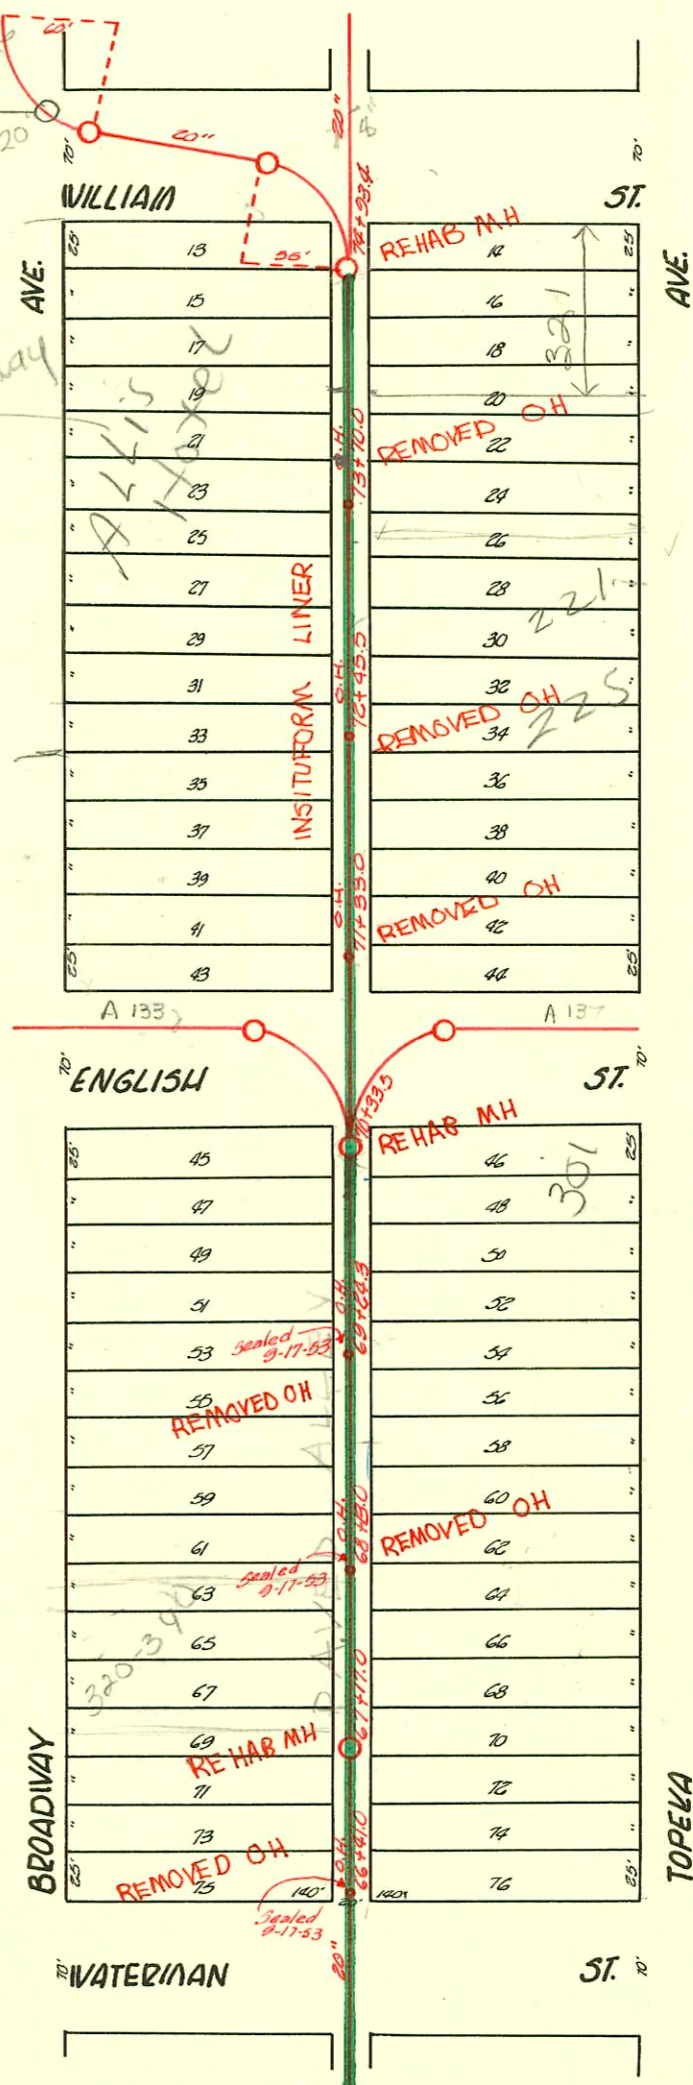

RECONSTRUCT SANITARY SEWER 1 AND 20
(SOUTH OF DOUGLAS)
PROD. NO. 468-81996 (630541)
BUILT BY INSITUFORM PLAINS, INC.
BOOKED 12-4-92 FROM AS BUILTS

RECONNECTIONS

STATION	ADDRESS	DIRECTION
66+92.4	329 S. Topeka	EAST
66+93.6	340 S. Broadway	WEST
67+57.8	340 S. Broadway	West
67+70	322 S. Broadway	West
69+27.8	312 S. Broadway	West
69+42.3	312 S. Broadway	West
70+15	333 E. English	West
70+15	303 S. Topeka	East
71+18	235 S. Topeka	East
72+37.6	235 S. Topeka 2-2-53	East
73+22.3	221 S. Topeka	East
73+90	204 S. Broadway	West
74+28.9	204 S. Broadway	West 1-3-93
74+49.6	321 E. William	East 1-4-94
74+87.5	321 E. William	East 1-4-94

10-3-96
Mike's Hotel
Let Mike G. at sewer
main know when
sewer is done
OK

95-40-7
94-305-7
94-257-7
1/2 74+388 + 5 ft from main - no alley cut

CONSTRUCTION RECORD

SERVICE RECORD

STATION	ELEVATION		Depth	MANHOLE	4-INCH "Y" BRANCHES		No. of Permit		House Number		DATE OF PERMITS	
	Ground	Grade			North West	South East	North West	South East	North West	South East	North West	South East
				74+93.4								
					+83.0	+81.0	# 4	# 55	201 S. Topeka		1-15-90	2-18-01
					+56.0	+60.0	# 117		206 S. Broadway		3-10-10	8-4-98
					+31.0	+39.0			Crawford Opera House			8-4-98
74	107.11	103.34	3.77		+08.0	+06.0	# 367	# 860	208 S. Broadway	207 S. Broadway	8-5-10	9-30-11
				73+70.0 0.4	+83.0	+81.0	# 368	# 239	210 S. Broadway	210 S. Broadway	8-5-10	12-26-93
					+76.0							
					+57.5	+55.5						
					+32.0	+30.0						
73	107.06	103.84	3.82		+07.0	+05.0	# 202	# 6	221 S. Topeka		11-16-90	6-1-99
					+18.5	+19.5						
				72+45.5 0.4	+56.2	+54.2	# 682		226 S. Broadway		12-30-13	
					+31.0	+29.0						
76	109.15	103.14	6.01		+08.0	+06.0	# 608		224 S. Broadway		11-6-13	
					+74.0							
				71+33.0 0.4	+56.0	+54.0	# 339	# 501	238 S. Broadway	245 S. Topeka	6-17-13	8-30-10
					+31.0	+29.0						
71	109.94	103.04	6.90		+06.0	+04.0		# 36	229-239 S. Topeka			2-17-37
				70+33.5								
70	110.60	108.94	7.68		+11.0	+09.0	# 1200	# 107	302 S. Broadway	302 S. Topeka	9-12-19	8-21-00
					+88.0	+86.0	# 304	# ?	302 S. Broadway	302 S. Topeka	5-16-17	6-14-04
					+62.5	+60.5	# 1081		310 S. Broadway		10-11-46	
				69+64.3 9-17-53	+37.0	+35.0	# 467	# 503	305 S. Broadway	305 S. Topeka	8-23-13	8-15-18
69	110.70	108.84	7.88		+12.0	+10.0	# 1076	# 262	310 S. Broadway	310 S. Topeka	12-5-07	5-17-00
					+87.0	+85.0		# 1606				7-11-04
					+61.0	+59.0	# 264	# 221	316 S. Broadway	313 S. Topeka	11-10-08	6-15-17
				68+13.0 9-17-53	+36.5	+34.5	# 17933	# 2947	318 S. Broadway	321 S. Topeka	8-24-04	9-30-08
68	110.36	108.74	7.62		+11.0	+09.0	# 315	# 215	318 S. Broadway	321 S. Topeka	8-24-04	9-30-08
					+88.0	+86.0	# 1019		Top-65' N. of M.H.	67+13.0-10-25-01	325 S. Topeka	
					+63.0	+61.0						
				67+17.0	+38.0	+36.0			no record	no record	5-11-99	11-14-00
67	110.17	108.64	7.53		+08.0	+06.0	# 349		no record	no record		8-29-01
					+89.0	+87.0	# 946		331 S. Topeka		3-2-01	9-4-08
66				sealed 9-17-53	+41.0	+60.0	# 96	# ?	no record	no record	7-7-91	8-17-01

96-16855-7 10-4-96 200 S. Broadway (AKA 204 S. Broadway) Allis Hotel -
 96-16856-7 10-4-96 200 S. Broadway (AKA 204 S. Broadway) Allis Hotel -

20946 (319 S. Topeka) 6-24-01 Henning (24' S of M.H. in Alley)
 # 853-Top-Allis Hotel-5.5 Corner William & Broadway-9-18-30 Johnson Pibg.
 # 829-Allis Hotel-9-15-30 Used Old Connection - Johnson Pibg.
 # 31-Top-229-239 S. Topeka-2-17-37 Mure & Davidson Pibg.
 # 1082-Top-310 S. Broadway-12-11-46 Davidson Pibg.
 # 532-Top-301 S. Topeka-17-49 Davidson Pibg.
 # 748-Top-340 S. Broadway-Ray Bros.-5-11-56
 # C12210-Sub off-232 S. Broadway-Al Henning 2-24-69 (Crawford Uniform Co.)
 Sub off # C17933-318 S. Broadway-Al Henning-2-9-70 (68+22)

20947 6-24-01 381 S. Topeka sealed 56.5' S of M.H. in Alley