


EAST SUB-MAIN "B" on FIRST ST. and LAT. NORTH
EAST SUB-MAIN "B" on SECOND ST. and LAT. NORTH
S.S. No. 1 - 1889

TRAP AREA

Plat 9-50

2+94.7 4" Service South 10-19-84

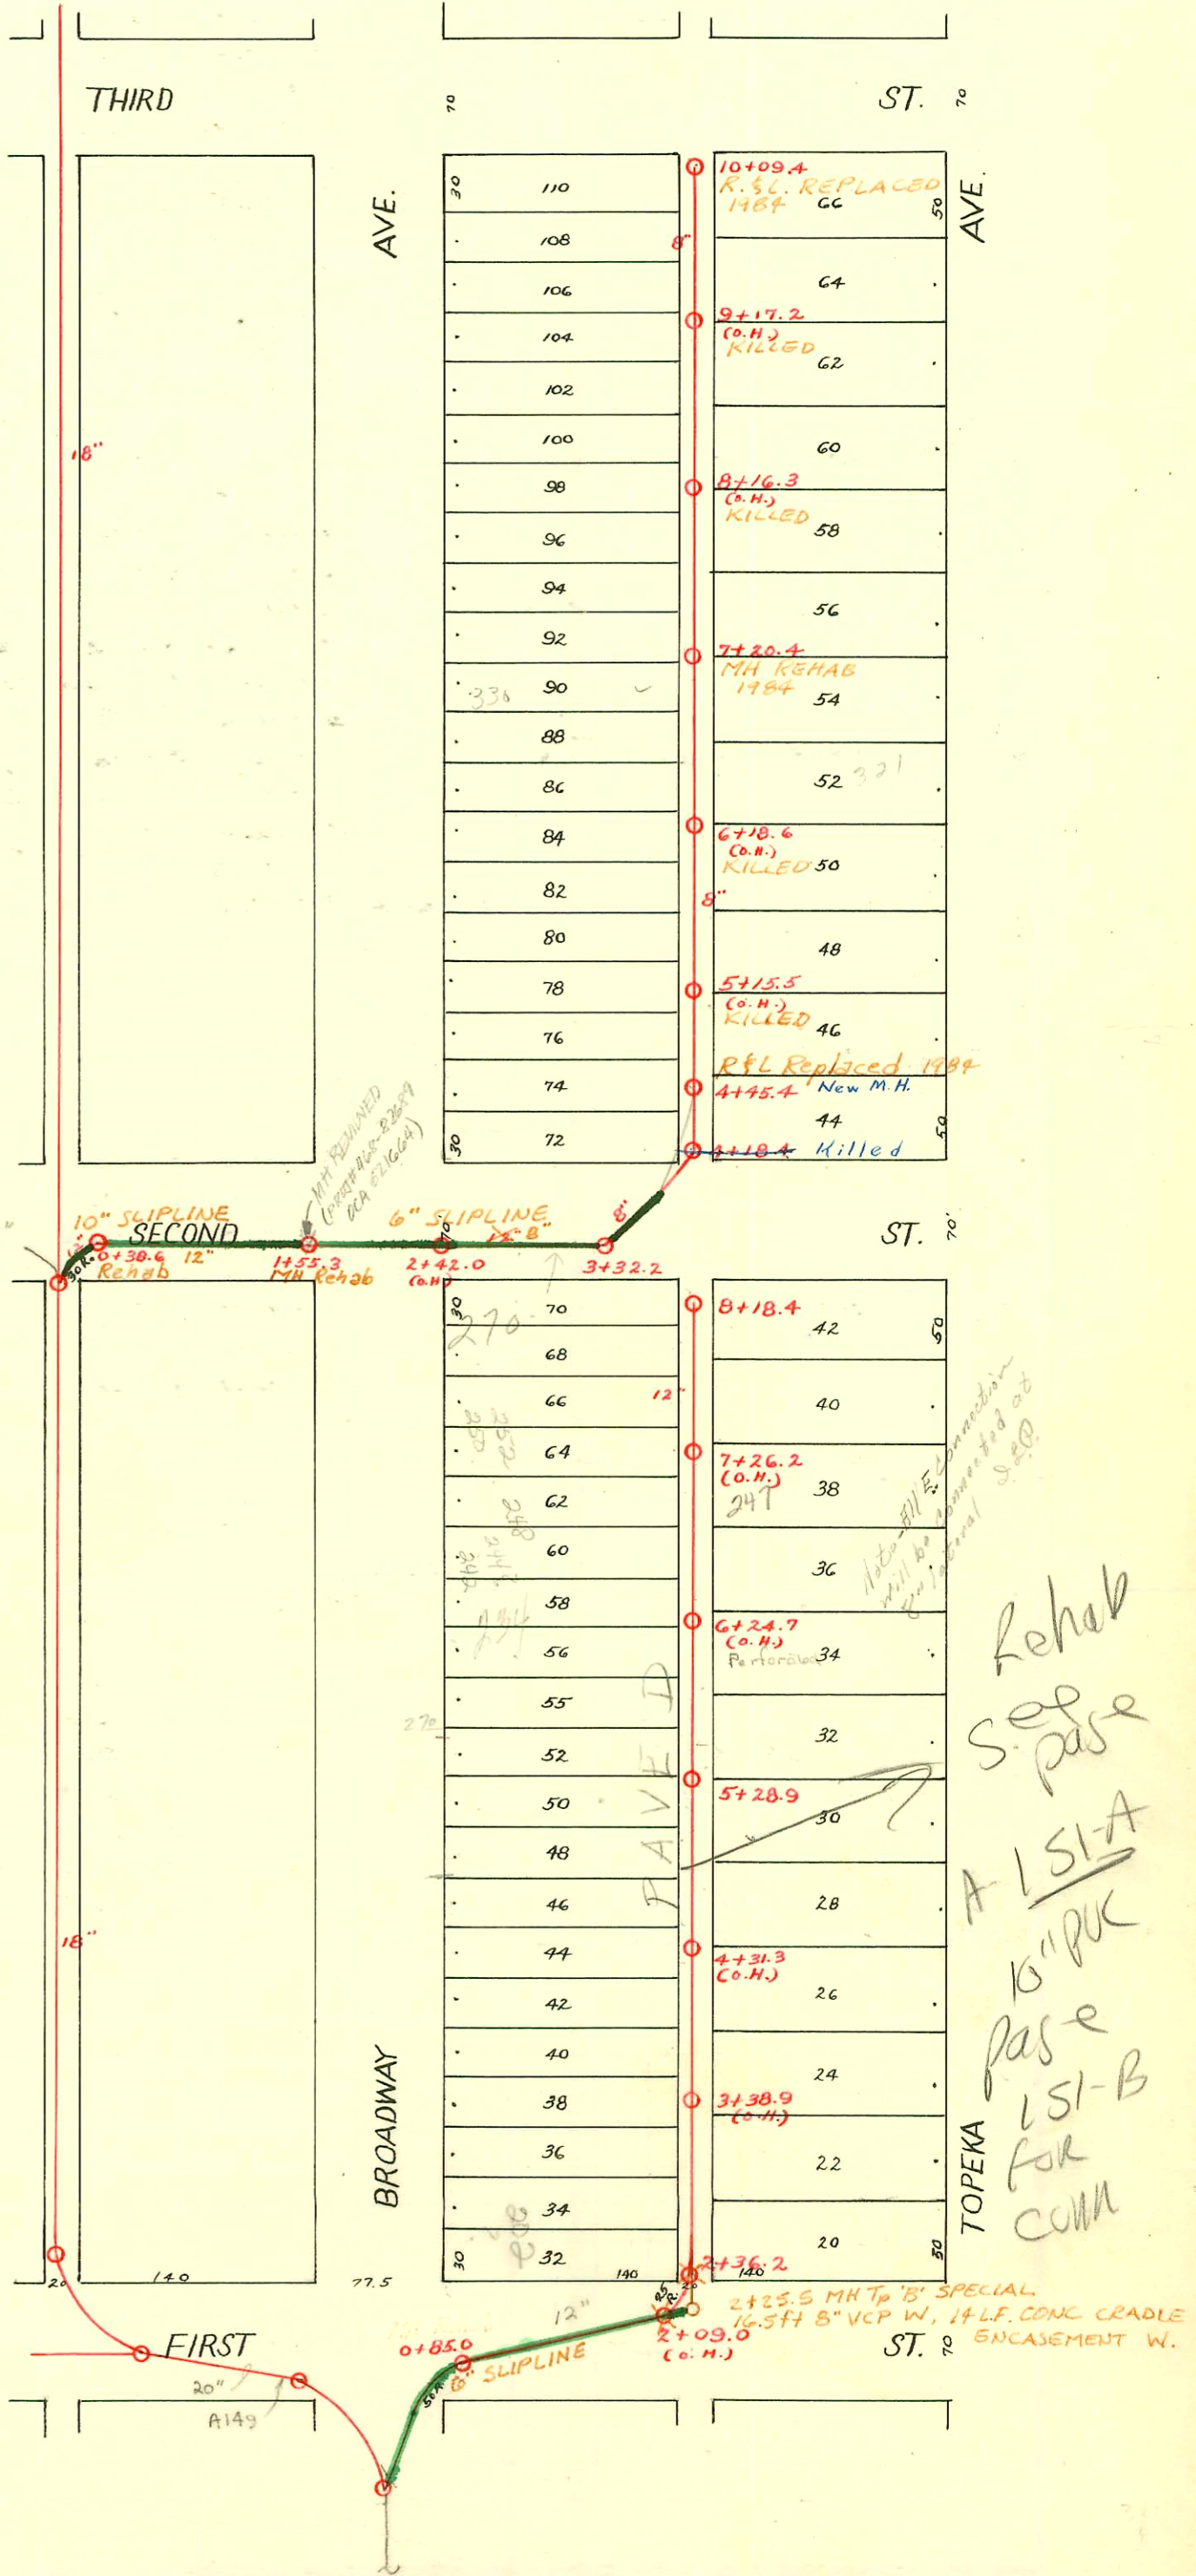

Sewer Rehab & Mosley Relief Sewer
Dist. 1 & 20, North of Douglas
468-80-990-80271-000-000-001
Built By Stannard Const.
Booked 7-26-85 From As Built

CONSTRUCTION RECORD							SERVICE RECORD					
STATION	ELEVATION		Depth	MANHOLE	4-INCH "Y" BRANCHES		No. of Permit		House Number		DATE OF PERMITS	
	Ground	Grade			North West	South East	North West	South East	North West	South East	North West	South East
10	112.16	108.40	3.76	10+09.4	10+05.0	10+03.0						
					9+74.0	9+72.0						10-9-00
					9+59.5	9+57.5		#385			5-12-99	6-24-09
					9+36.0	9+34.0		#63				4-28-92
9	112.25	108.15	4.10	9+11.7 <i>Infiltration says clay</i>	9+09.7	9+09.7	#932		330 N. Broadway		7-20-49	
					8+87.6	8+85.5	14280		330 N. Broadway		7-18-85	
					8+62.5	8+60.5						6-11-01
					8+38.4	8+36.4					6-1-99	2-17-71
8	112.36	107.90	4.46		8+14.0	8+12.0	#931	#22965	330 N. Broadway	335 N. Topeka	7-20-49	3-2-04
					7+89.5	7+87.5	#739		330 N. Broadway		2-11-19	
					7+65.0	7+63.0	#740	#19	330 N. Broadway		2-11-19	3-8-93
				7+20.4	7+40.5	7+38.5		#798				3-28-19
7	112.13	107.65	4.48		7+15.7	7+13.7	#197	#303			12-2-01	5-18-14
					6+91.0	6+89.0		#130				8-1-92
					6+66.0	6+64.0	#543				6-13-11	
					6+41.7	6+39.7						
6	111.88	107.40	4.48		6+16.9	6+14.9		#74	312 N. Lawrence		3-24-10	6-12-01
					5+93.0	5+91.0	#165				6-19-02	5-5-92
					5+68.0	5+66.0	#318					
					5+44.3	5+42.3		#68				2-5-14
5	112.05	107.15	4.90		5+20.0	5+18.0	#1989	#67	312 N. Broadway	B.T. Co.	11-25-39	2-5-14
					4+96.0	4+94.0	#97	#549			7-31-03	5-14-29
					4+72.0	4+70.0	#296	#66			4-20-20	2-5-14
					4+48.3	4+40.3	#145		302 N. Broadway		9-5-94	
					4+24.0	4+22.0	#753				4-22-57	
4				New m.h. → 4+45.4 Killed → 4+18.4								
3	111.07	106.73		3+32.2								
2	110.58	106.40	4.18									
1	109.03	106.15	2.88	1+55.3								
0	109.13	106.00	3.13	0+38.6								
8	112.40	107.63	4.77	8+18.4 T. Joint	8+07.5	8+11.5						
						7+87.1						
					7+77.0	7+62.9						
					7+46.0	7+36.3	#210	#17	350 N. Broadway	251 N. Topeka	11-10-93	9-5-98
7	112.02	107.23	4.79		7+12.1	7+16.1	#202	#202	247 N. Topeka		10-17-05	
					6+87.9	6+85.9			242 N. Topeka		9-29-81	
					6+57.1	6+61.2						
					6+27.0	6+37.1						3-28-98
6	109.99	106.83	3.16		5+96.6	5+86.9	#175		293 N. Topeka		3-8-56	
					5+66.4	5+62.4	#389				7-8-02	
				5+28.9	5+38.8	5+36.8						
5	108.89	106.43	2.36		5+06.5	5+10.5	12032		226 N. Broadway		12-4-59	
					4+77.9	4+86.2						
					4+76.1	4+62.3	#205	#128	218 N. Topeka	215 N. Topeka	4-10-84	6-5-42
					4+46.5	4+36.3					6-20-75	
4	108.63	106.03	2.60		4+18.3	4+12.4					7-5-07	
					3+89.9	3+87.9					5-9-01	
					3+57.4	3+61.4	#198	#19			4-6-14	2-28-08
					V set → 3+40.9			#106			6-17-07	
						3+35.5						
3	109.82	105.63	4.19		3+26.6	3+10.2		#76			4-29-93	2-7-08
					2+96.8	2+86.3		#4				
					2+66.1	2+62.2		#729				
					2+39.7	2+37.7	12384	#16	204 N. Broadway	332 E. First	10-24-84	3-5-07
2	110.11	105.38	4.73	2+36.2								
0	109.74	105.02	4.72	0+85.0								

2002-00230 125102-200 N Broadway - Orpheum (mezzanine restrooms) Irwin Pkg - Tied back to 6" clay tile
apx 3' from main 6" sch 40 PVC, trap

70 - 12974 352 N. Broadway
90 - 12973 351 N. Topeka

17077 - 214 N. Broadway Seal off - J.C. Jensen 11-25-69 (5+61.9 x 10' W. of main sewer)

- #22-2 Tops - Orpheum - 1-9-22
- #22- Top - 255 N. Topeka - 2-2-25
- #5390 #5391 - Tap - 215 N. Topeka - 6-28-55 - Moore - Robertson
- #1351 - Tap - 330 N. Broadway - 10-26-48 - Pray Bros.
- #1194 - Used old conn. - 233 N. Topeka - 11-24-47 - Brodie Pkg. Co.
- #973 - Used old conn. - 321 N. Topeka - 9-22-48 - Moore - Robertson Pkg. Co.
- #13921 Top - 330 N. Broadway - Ripstein - 3-3-61 (6+92.4)
- 16422 Seal off 327 N. Topeka - 2nd June 11-30-62
- 16551 Seal off 315 E. Broadway - 1-10-63
- 17427 - tap - 321 N. Topeka - Vernon Lippoldt - 7-22-63 (6+30.4)
- #1670 - tap - 270 N. Broadway - Buckley Inc. 7-17-64 (2+94.5)