

WEST SUB - MAIN "B" on ELEVENTH ST and A & S
S.S.No.1-1889

TRAP AREA

Plot 9-43

TRAP AREA

1993 SANITARY SEWER REHABILITATION PROGRAM - PHASE II
PROJ. NO. 468-82348 (632000)
BUILT BY W.B. CARTER CONST. CO.
BOOKED 6-1-95 FROM AS BUILTS

Easement #323
lots 288-304 even inclusive

371
395
440
464

Easement #274 - lot 278
Easement #47 - On E. line of lot 276

1210 N Main
Letter Ord 222/02
from Pac. Kennedy
1202 N Main 9' grant
per mission for 1202 N Main
line to cross. pay of 1202
to connect to
8" BRU. Main
UNHTZ Lease
for 1210 N Main
4/2/02

Easement #324 - lots 1 & 2

Easement #322 - lots 3 & 4

Easement #271 - lots 8 & 9

Easement #295 - lots 10 & 11

Easement #312 - lots 12 & 13


Easement #320 - lots 14, 15 & 7

Easement #321 - lots 18 & 19

Easement #249 E.L. lots 25-20 incl.

RECONNECTIONS

STATION	ADDRESS	DIRECTION
8+58.5	No Address	East
8+06.5	No Address	East
7+77.5	No Address	East
5+45.5	No Address	West
5+17.5	No Address	West
4+69.5	No Address	West

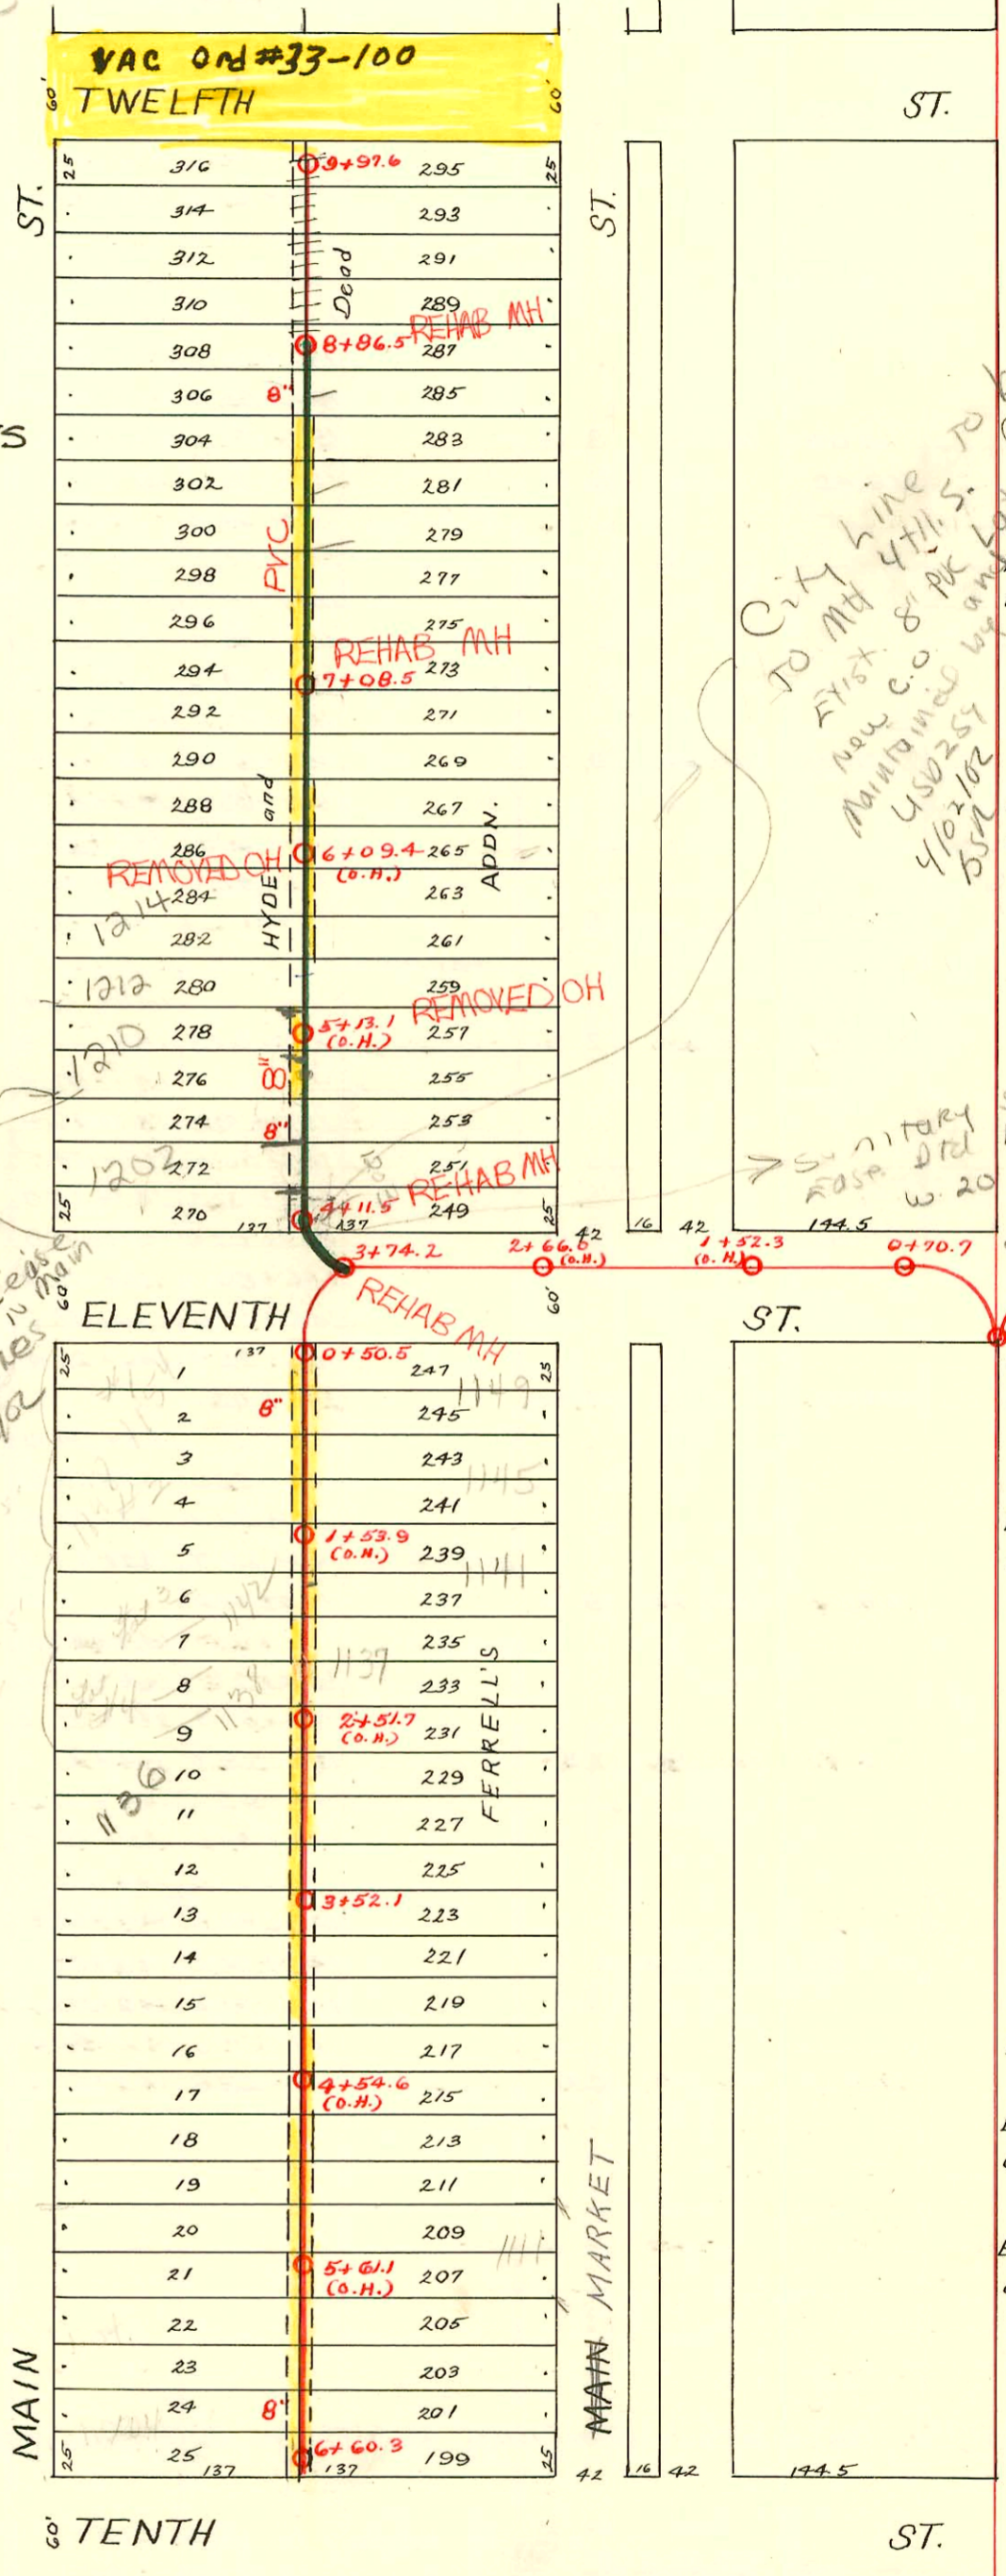

2003-02549 1012103 1210 N Main - USD 259 slo with
54140 cap 10' from MH 4' from prop line

