

MAIN "B" on FOURTEENTH ST. to FIFTEENTH ST. and SPUR on E. SIDE of R.R.  
S.S. No. 1- 1889


Plot 9-40

TRAP AREA

Easement No. 74, along W. Line & parallel  
with R.R. R/W of lot G, Plummer's Adda.  
Easement # 346 - lot D & No. 1/2 of lot E.

Private easement parallel  
with and 62' E. of Market  
to pt. 105' No. of 14<sup>th</sup> St.

Y 74' No. of P.L.

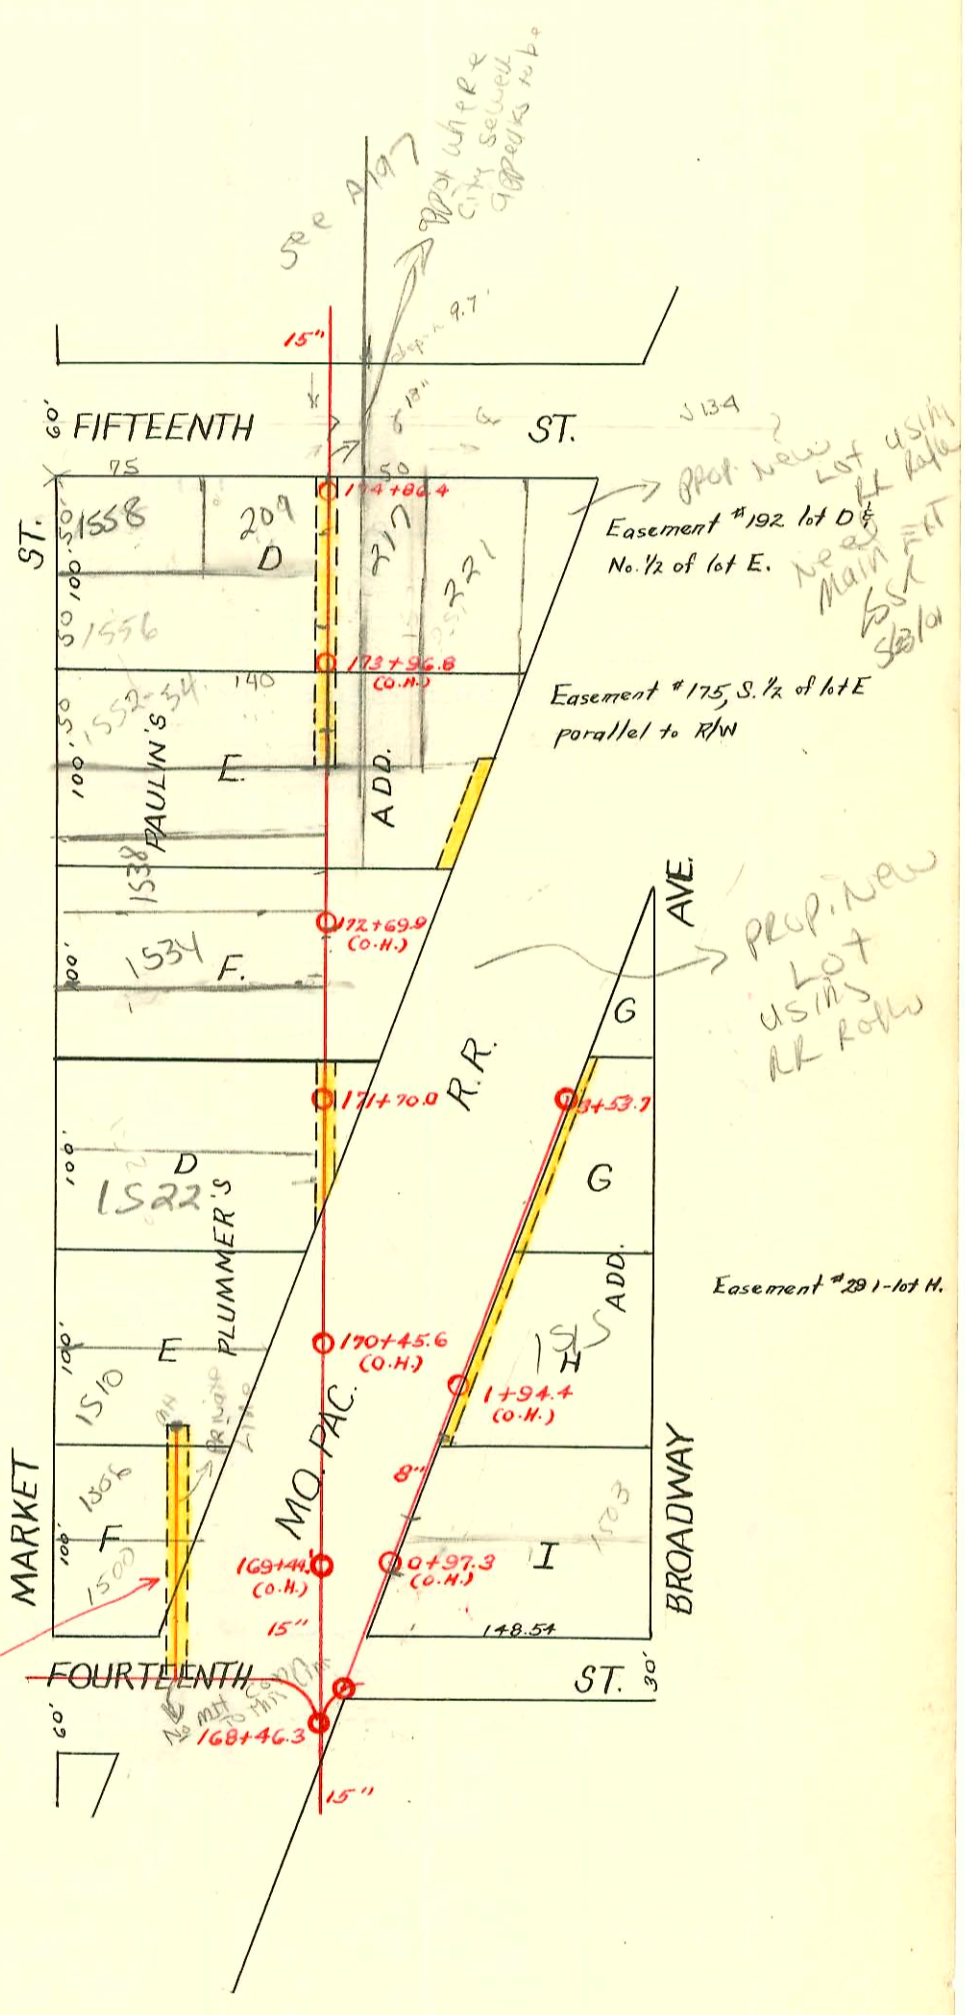

Prop. New Lot using RR R/W  
Main ENT  
1534  
1531  
1530  
1529  
CONSTRUCTION RECORD						SERVICE RECORD						
STATION	ELEVATION		Depth	MANHOLE	4-INCH "Y" BRANCHES		No. of Permit		House Number		DATE OF PERMITS	
	Ground	Grade			North West	South East	North West	South East	North West	South East	North West	South East
	119.24	114.13	5.11	3+53.7								
3	119.00	114.00	5.00					#759	1519 N. Broadway			12-2-09
2	119.05	113.75	5.30									
								11239	1503 N. Broadway			6-18-81
1	118.86	113.50	5.36					5026 #2088	1509 N. Broadway			3-2-66 6-11-45
								#237	1501 N. Broadway			12-7-05
0	118.52	113.25	5.27									
				174+86.4								
					174+64.4	174+62.4		#1136				8-8-19
					174+39.9	174+37.9						
174	119.58	113.34	6.24		174+15.8	174+13.8		#503	#157	1556 N. Market		5-7-29 3-20-14
					173+92.1	173+90.1		#385	#7560107	1552 N. Market	221 E 15th	11-5-91 8-20-12 5-9-95 5-15-17
					173+39.0	173+60.2						
173	119.34	113.24	6.10		173+12.6	173+37.0		#1108		1504 N. Market		8-20-29
					172+88.8	172+86.8		#214				5-13-12
					172+60.0							
					172+34.4	172+58.0		#76		1534 N. Market		2-15-10
172	118.79	113.14	5.65		172+08.0			#40		1530 N. Market		2-4-11
				171+70.0	171+84.0							
					171+57.6			#332		1516 N. Market		1-21-09
					171+31.8			#101		1522 N. Market		4-6-12
171	118.61	113.04	5.57		171+06.0			#208		1520 N. Market		4-20-09
					170+84.1							
					170+58.3							
170	120.16	112.94	7.22		170+35.0							
169	118.30	112.84	5.46									
168				168+46.3								

95-060107 5-9-95 221 E 15th - Ks Ditching - 96.3 S of M.H. w/4" trap (173+90.1)

96-19911-7 11-27-96 1506 N Market - Henning

90 #7925 1518 N Market (Someone built new frame) (wagner) 4-26-83 (Hull House in Rear) to be wrecked (3' S of N. Pl. + 52.5 E of House)

# 02222 1527 N. Broadway 12-24-50 M.H. - 3453.7 (Dancy)

See # 033325 - 1500 N. Market - Work done 4/30/72 (33' N. + 12' E of M.H. in 14')

#1577 - Trailer - 209 E. 15th - G-11-52 - R. LaFoy - Private line

#1221 - Tap - 1504 N. Market - 9-19-22