


EAST SUB-MAIN "C" and LAT'S N. and S.
S. S. No. 1-1889

Plat 9-59

TRAP AREA

1989 S.S. Reconst. Phs II
468-82011 (725002)
Built By Insituform Plains
Booked 10-16-90 from Plan

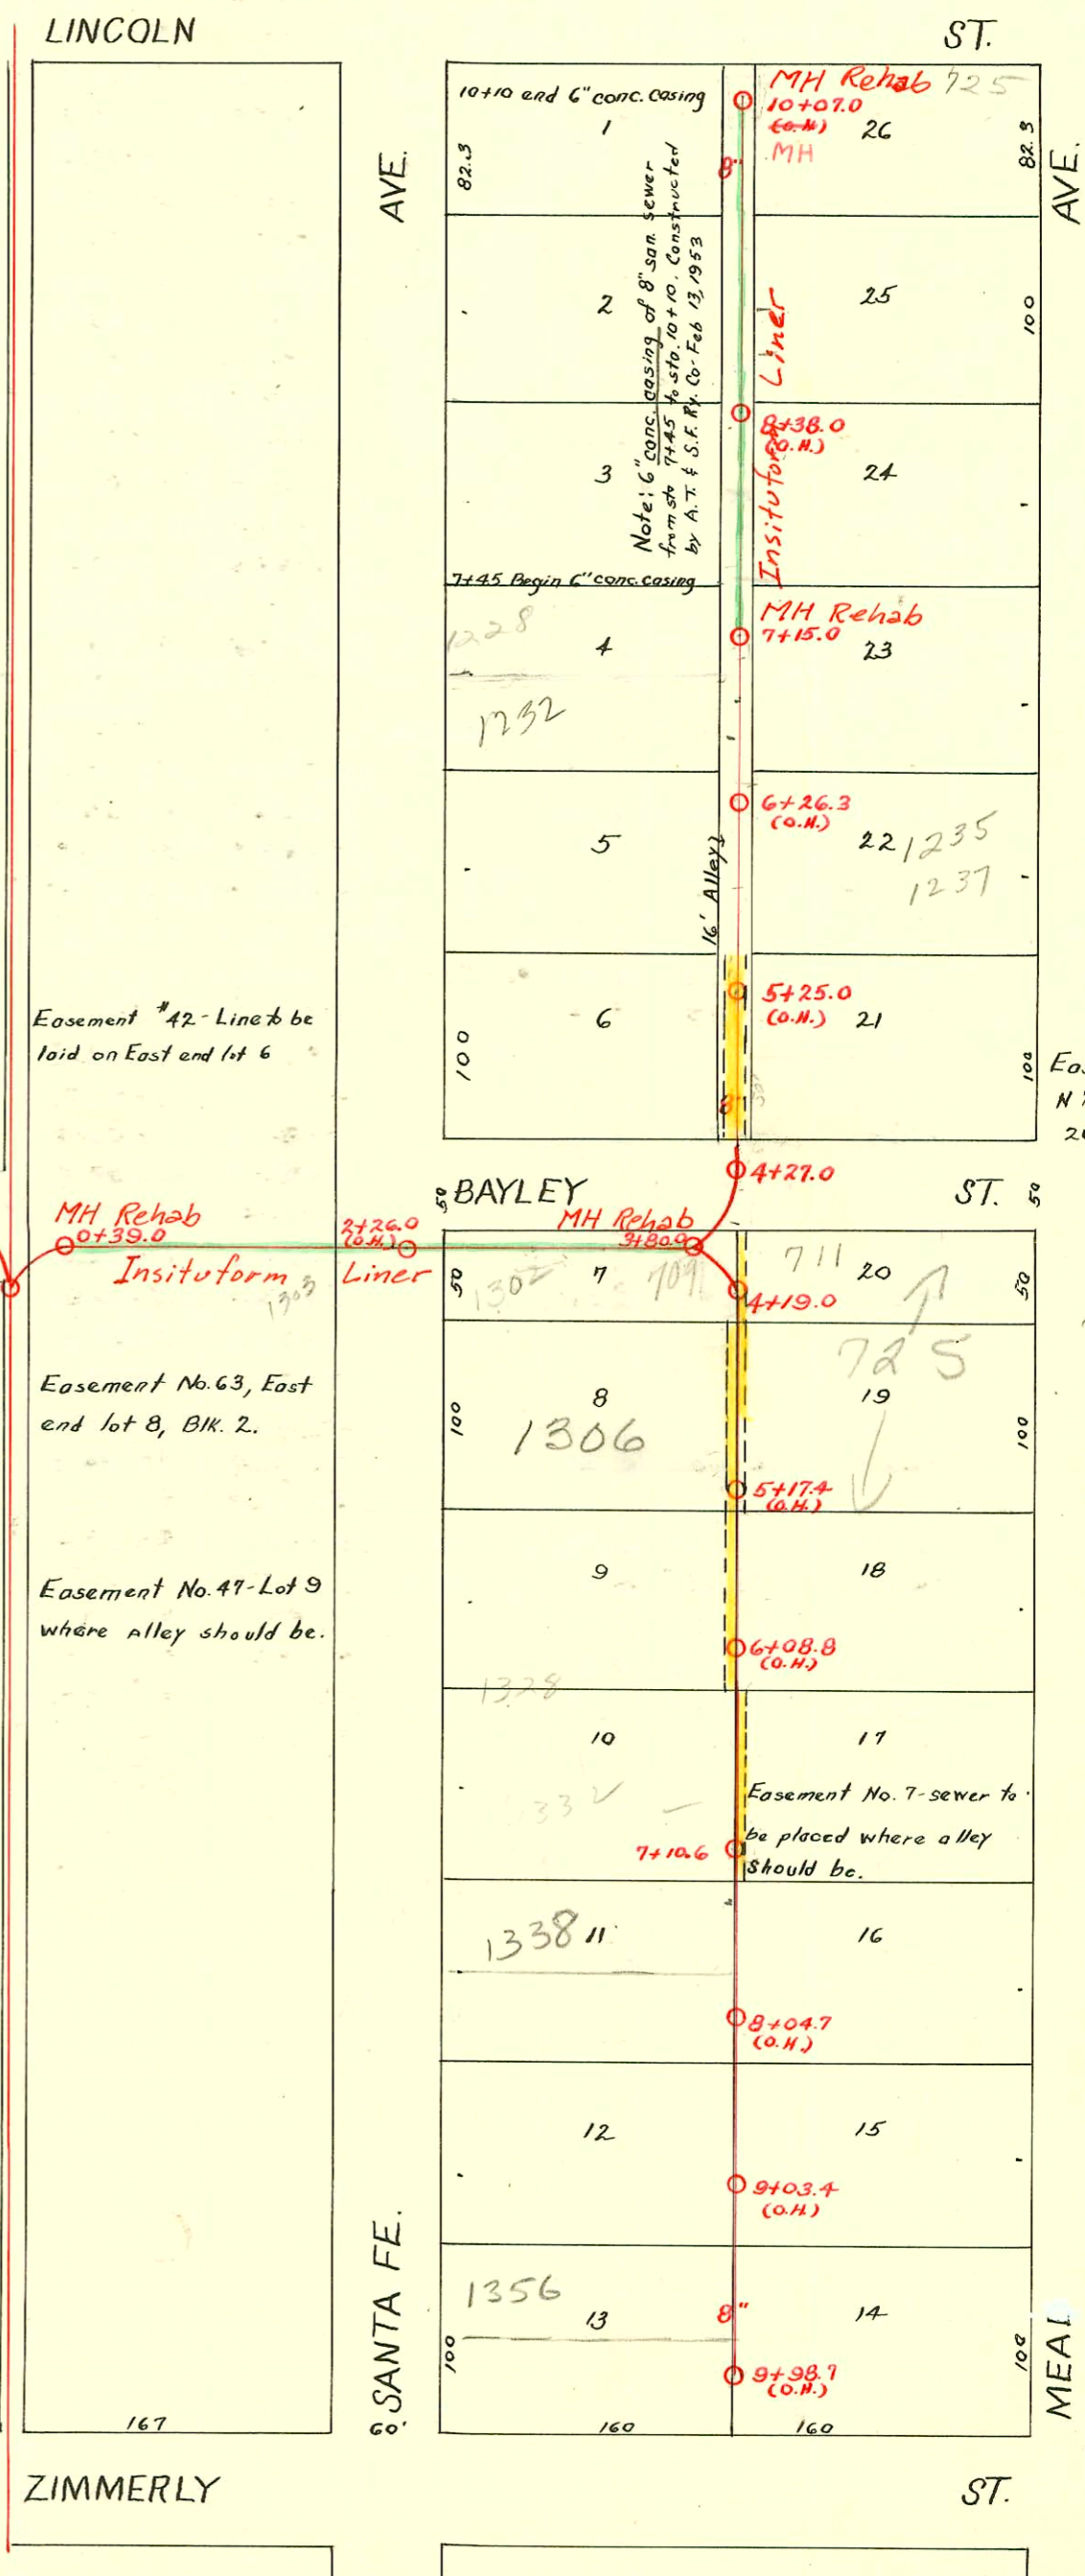

TRAP Area

