

MAIN "C" on GILBERT ST. to ORME ST.
S.S. No. 1 - 1889

Plat 9-56

TRAP AREA

N


SCALE: 1" = 100'

RECONSTRUCT SANITARY
SEWER NO. 1+20
PROJ. NO. 468-8196 (630541)
BUILT BY INSITUFORM PLAINS, INC.
BOOKED 5-16-94 FROM AS BUILTS

RECONNECTIONS

STATION	ADDRESS	DIRECTION
42+09.3	902 S. St. Francis	West
41+57.7	908 S. St. Francis	West
41+32.8	910 S. St. Francis	West
40+58.3	914 S. St. Francis	West
39+61.2	920 S. St. Francis	West
38+35.3	940 S. St. Francis	West

99-68537

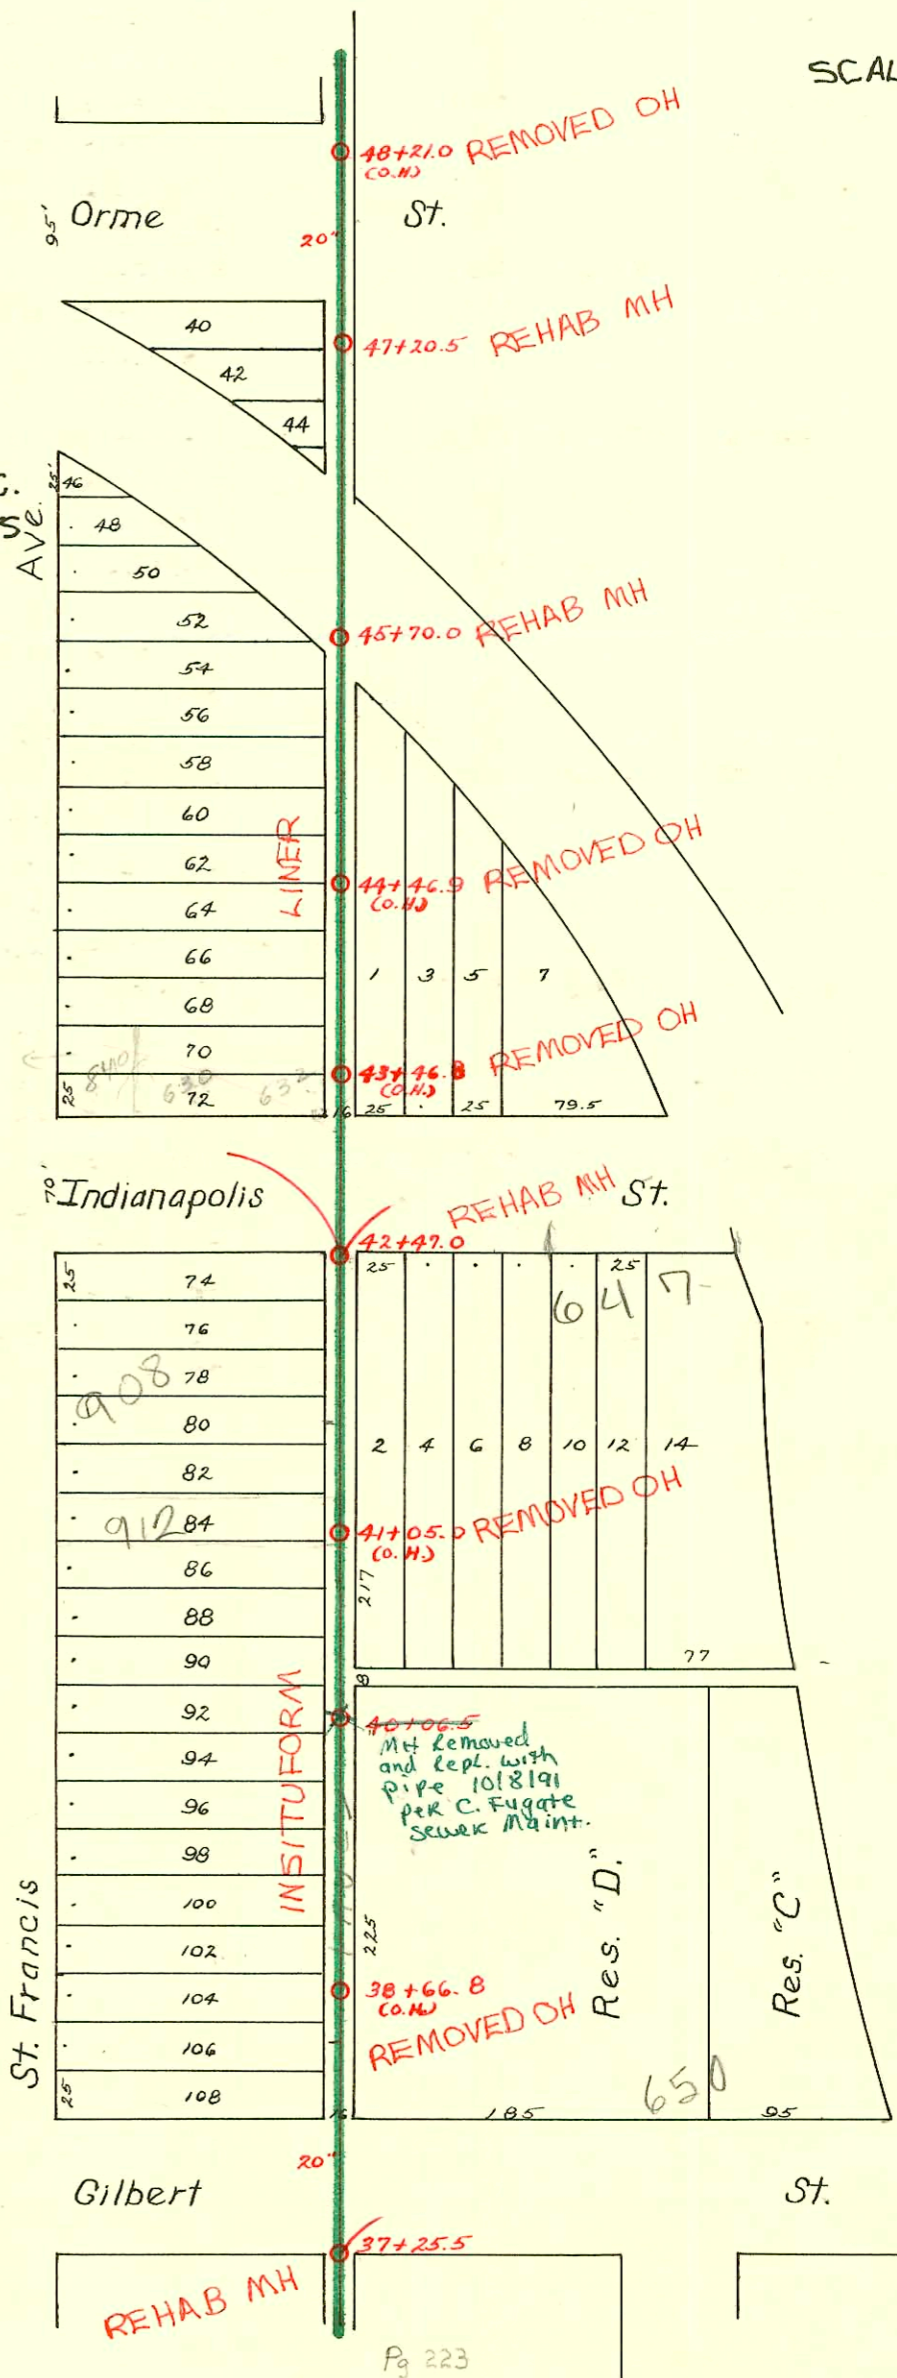

CONSTRUCTION RECORD						SERVICE RECORD						
STATION	ELEVATION		Depth	MANHOLE	4-INCH "Y" BRANCHES		No. of Permit		House Number		DATE OF PERMITS	
	Ground	Grade			North West	South East	North West	South East	North West	South East	North West	South East
48	102.57	99.40	8.17	48+21.0(6#)								
						47+89.0						
				47+20.5								
47	106.87	99.30	7.57		47+16.0		#552		800 S. St. Francis		10-21-37	
						46+64.5						
46	107.10	99.20	7.90		46+18.4	46+16.4			810 S. St. Francis		11-29-22	
				45+70.0			#1634					
45	106.93	99.10	7.83		45+20.8				826 S. St. Francis		1-5-26	
					44+95.9	44+93.9	#6					
					44+68.2							
					44+45.0	41+93.0	#1540				11-14-22	
44	106.86	99.00	7.86		44+20.1		#732		838 S. St. Francis		11-23-09	
					43+94.8	43+92.8						
					43+68.2							
					43+44.7							
43	106.84	98.90	7.94		43+19.8	43+42.7	#733				5-15-23	
				42+47.0	42+95.0	42+93.0						
					42+25.5	42+23.5						
42	107.53	98.80	8.73		42+00.0		#1600				11-23-22	
						41+98.1						
					41+75.0	41+73.0						
					41+51.4	41+49.4	#1773				12-28-22	
					41+26.7	41+24.7	#1906				2-9-45	
41	106.57	98.70	7.87		41+01.2		#1762		910 S. St. Francis 912 S. St. Francis		12-27-22	
						40+99.2						
					40+76.0	40+74.0						
					40+50.4	40+48.4	#636		916 S. ST FRANCIS		4-30-23	
				40+06.5	40+25.4	40+23.4						
40	105.93	98.60	7.33		40+00.0		#1239		920 S. ST. FRANCIS		5-29-24	
						39+98.0						
					39+76.9	39+74.9	#23586 108		650 S. Gilbert	501 Baldwin	7-24-89 1-22-23	
					39+51.5	39+49.5						
39	106.07	98.50	7.57		39+25.9	39+23.9	#800		Mexican Colony		7-17-25	
					38+99.0	38+97.0						
					38+75.5	38+73.5						
					38+50.1	38+48.1	#39	#1918	N.E. Co. Bellefontaine Jr.		3-21-06	12-28-23
38	105.95	98.40	7.55		38+22.6	38+20.6						
37				37+25.5	37+97.5	37+95.5						

See 2002-01981 7/18/02 650 E Gilbert (new warehouse) CMW:
4" PVC, Housetrap, 1045, TWIN CO. CITY TAP 245.6' N of MH 37+25.5 (39+71.1)

#859 Tap - 11-23-20 - 618 E. Gilbert (no meas. given)
#4248 Tap - 922 S. St. Francis - Joe McDonald - 2-26-53
E-27712 - 840 S. St. Francis - Al. Huming 9-7-71
Sealoff