


EAST SUB-MAIN "C" on INDIANAPOLIS ST. and LAT<sup>s</sup> N. and S.  
S.S. No. 1 - 1889

TRAP AREA

Plat 9-50

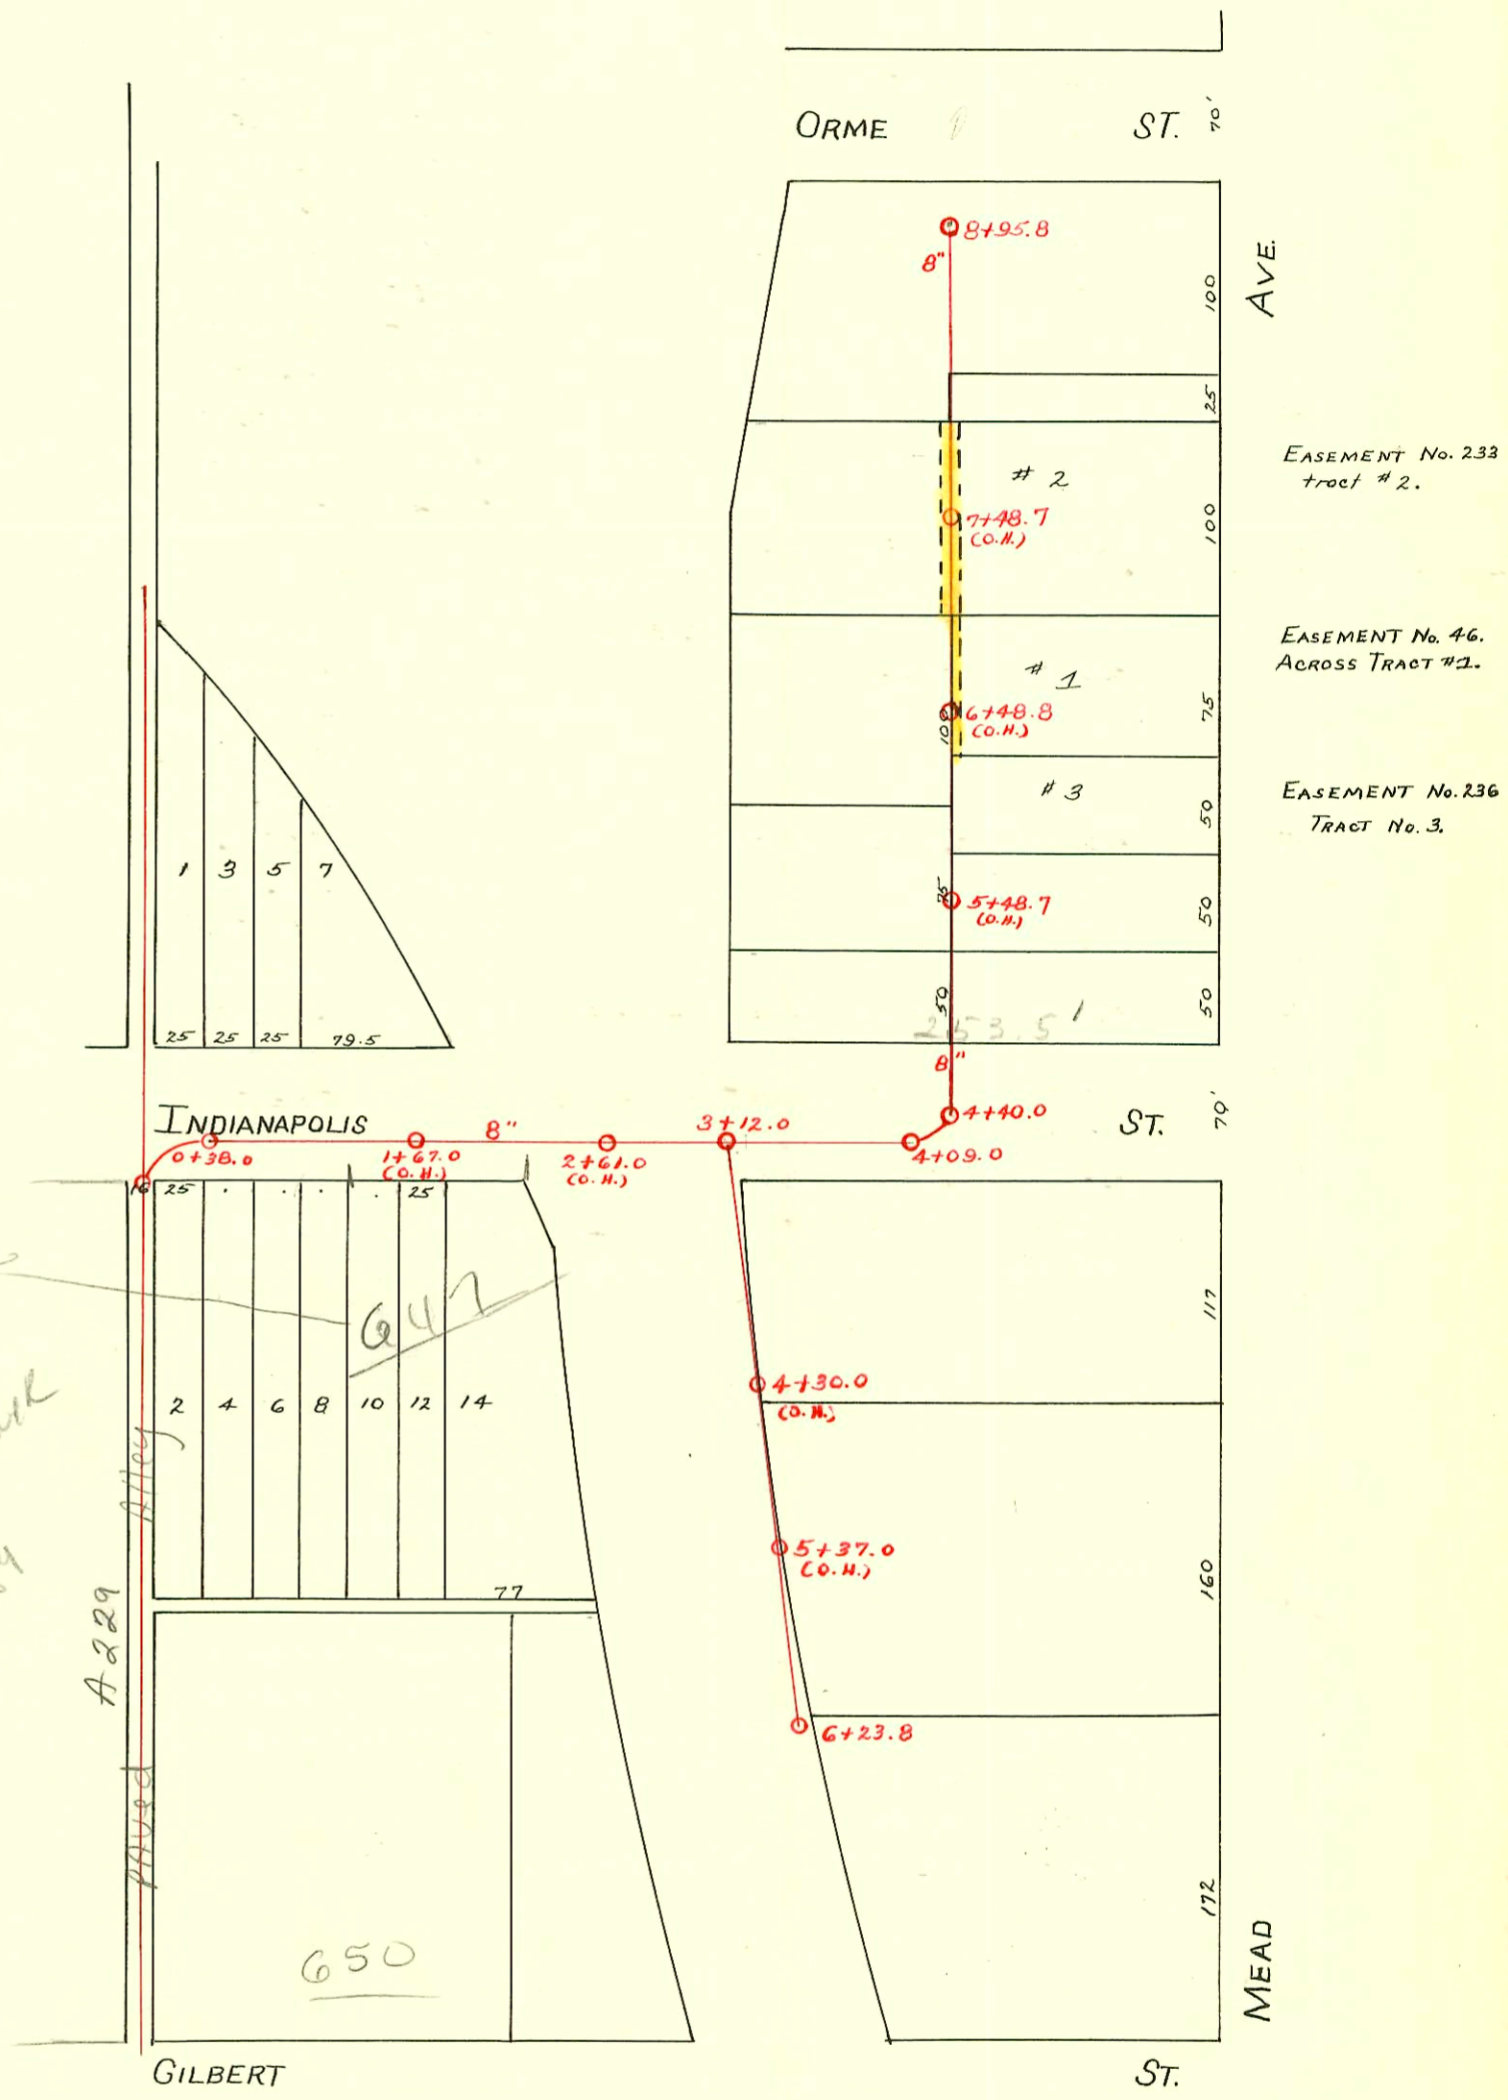

Need SIO  
water records  
shows this  
address was  
billed for  
water sewer  
by 12/169

