



MAIN "C" from ENGLISH ST. to DOUGLAS AVE.
EAST SUB-MAIN "C" IN ALLEY SOUTH of DOUGLAS AVE.
S.S. No. 1 - 1889

Plat 9-53

E.S. 1/2

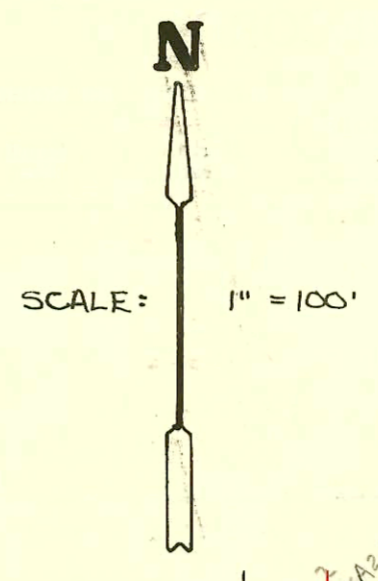

TRAP AREA

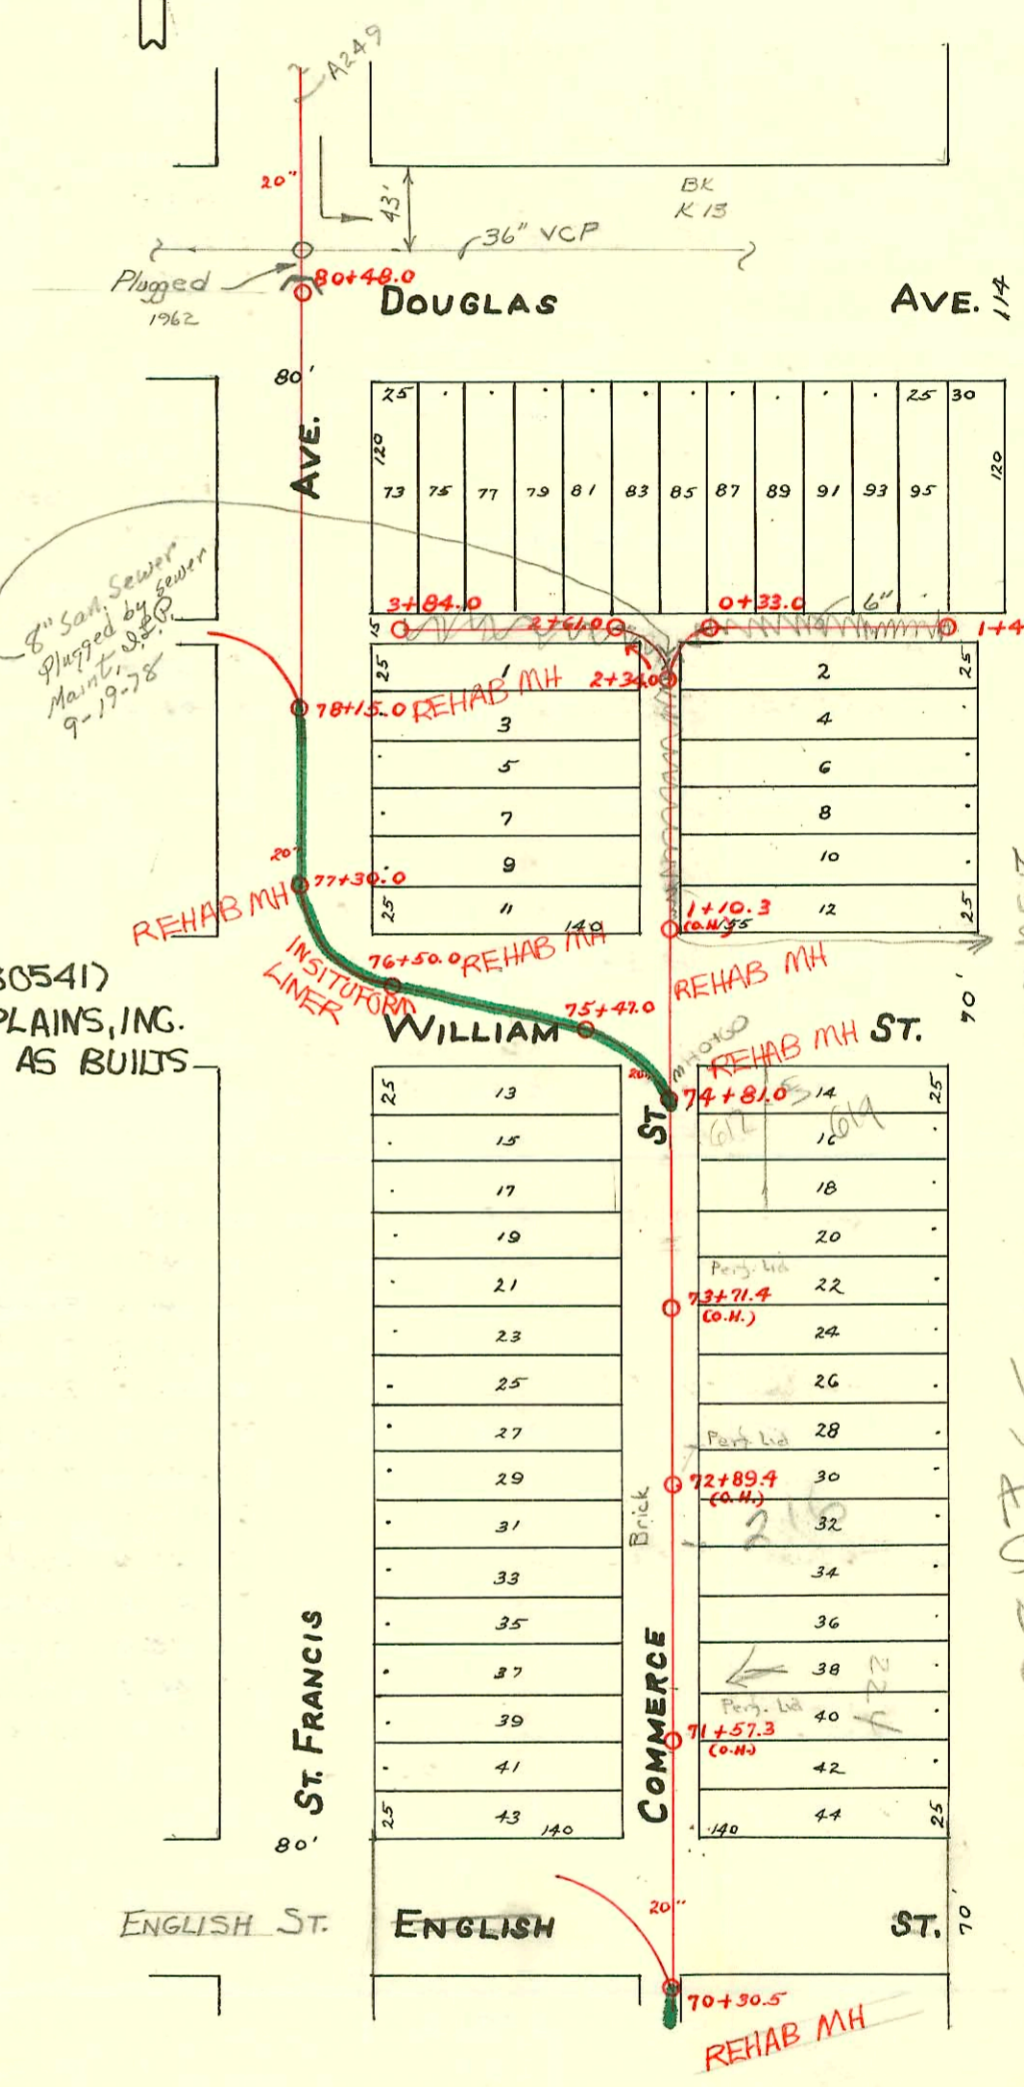

RECONSTRUCT SANITARY
SEWER NO. 1 + 20
PROJ. NO. 468-81996 (630541)
BUILT BY INSITUFORM PLAINS, INC.
BOOKED 5-16-94 FROM AS BUILTS

Note:
West wye
set at 104'
East wye
set at 109'
by sewer
main
10-31-97

This line
being repl
with
ARAY line
See below
NO COMS
W. of
Williams
of ST 45
1-22-05
BK

