



Plat 9-50


TRAP AREA

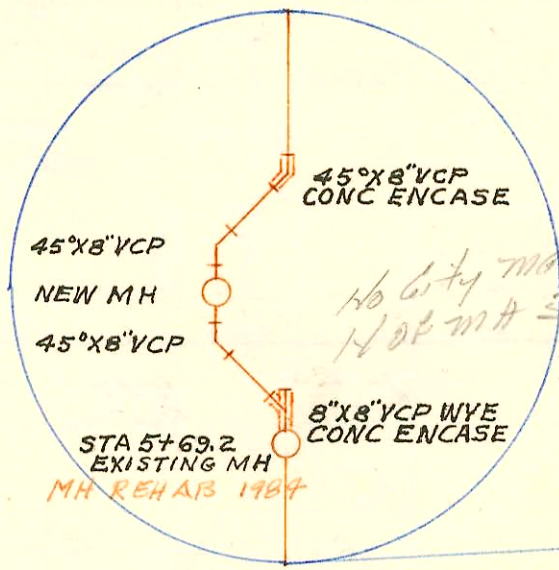

RECONSTRUCTION
 BUILT BY: MID STATES CONST CO
 PROJ N°DBKW 704025
 BOOKED 10-23-74 FROM INSP REPT

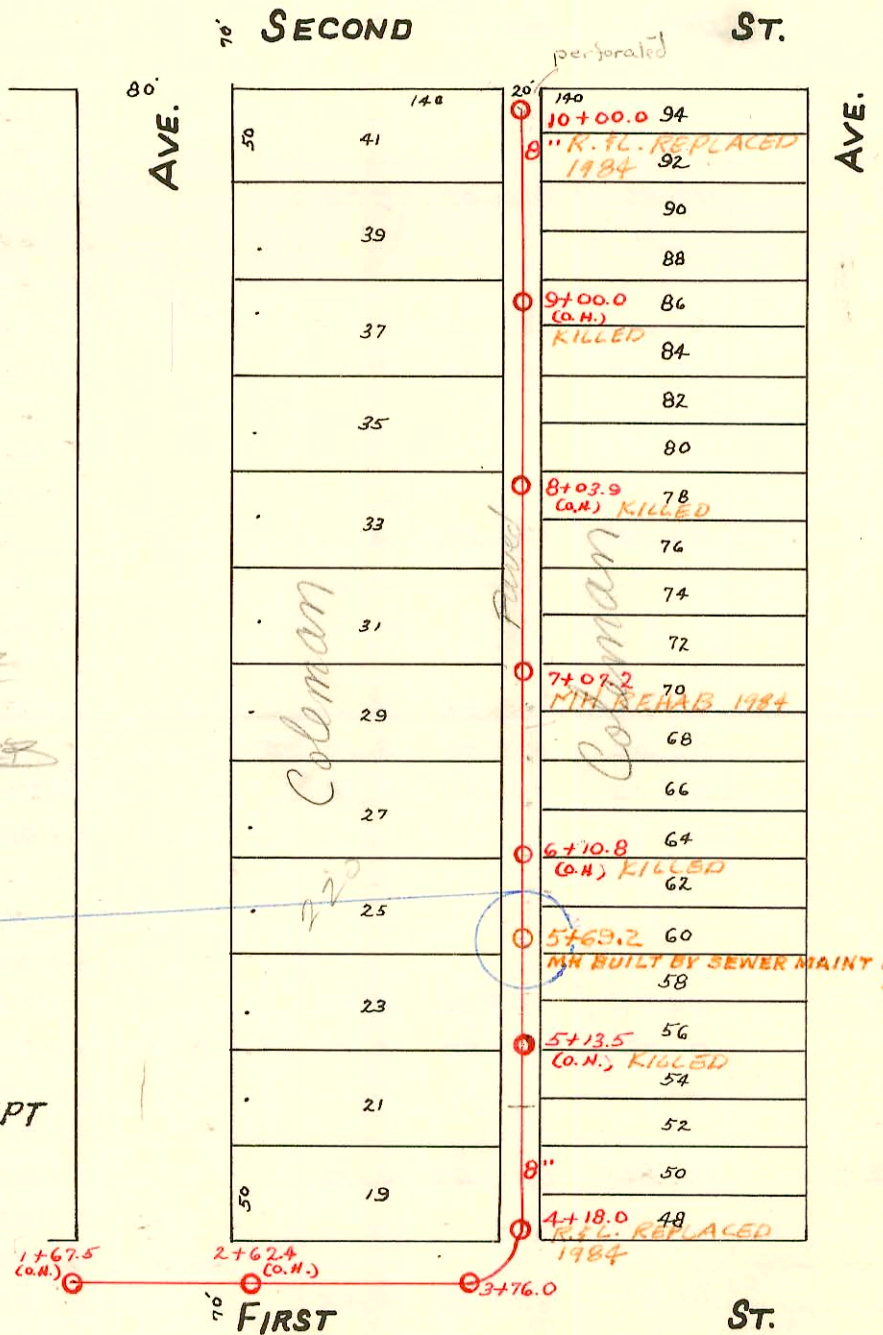

- 2+16 6" Service West 7-9-84
- 2+00 6" Service West 7-9-84
- 0+75 6" Service West 7-9-84
- 0+28.5 6" Service West 7-9-84
- 1+13.5 6" Service West 7-10-84
- 3+13 6" Service East 8-3-84
- 3+82.5 6" Service West 8-3-84

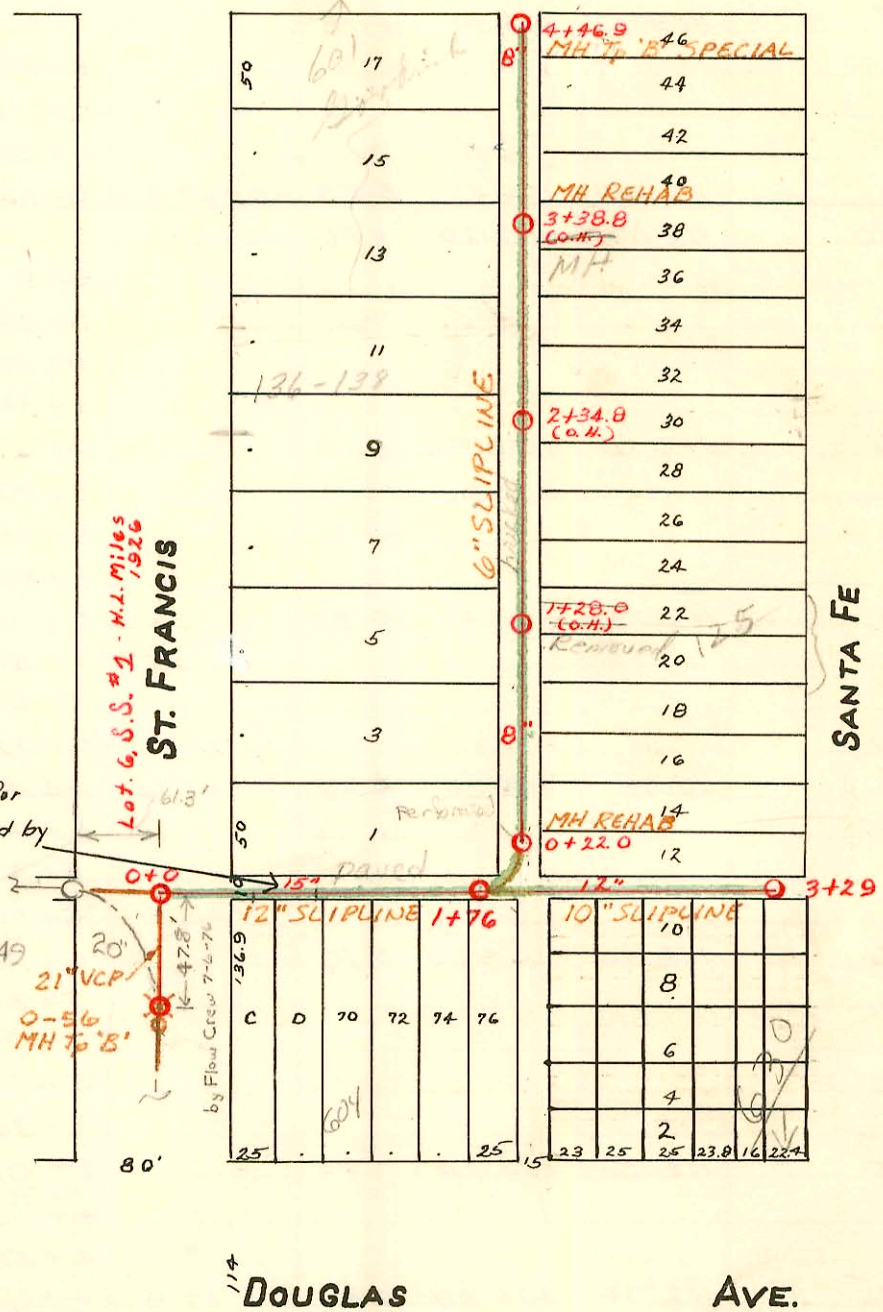

Sewer Rehab & Mosley Relief Sewer
 Dist. 1 & 20, North of Douglas
 468-80-990-80271-000-000-001
 Built By Stannard Const.
 Booked 7-31-85 From As Built

- 3+11 6" Service South 7-7-84
- 1+51.5 6" Service South 7-7-84
- 1+07 6" Service South 7-9-84
- 0+86.5 6" Service South 7-9-84
- 2+25 6" Service South 7-10-84
- 2+79.5 6" Service South 7-10-84
- 2+55 6" Service South 7-11-84
- 2+31 6" Service South 7-11-84
- 1+18 6" Service South 7-11-84

See old sewer book for info. on line replaced by

ST. FRANCIS

SANTA FE

DOUGLAS

AVE.

