


MAIN "D" FROM LINCOLN ST. TO GILBERT ST.
S.S. No. 1-1889

Plat 9-56

TRAP AREA

see pg. 331

Sewer Abandoned
see bk. K-203

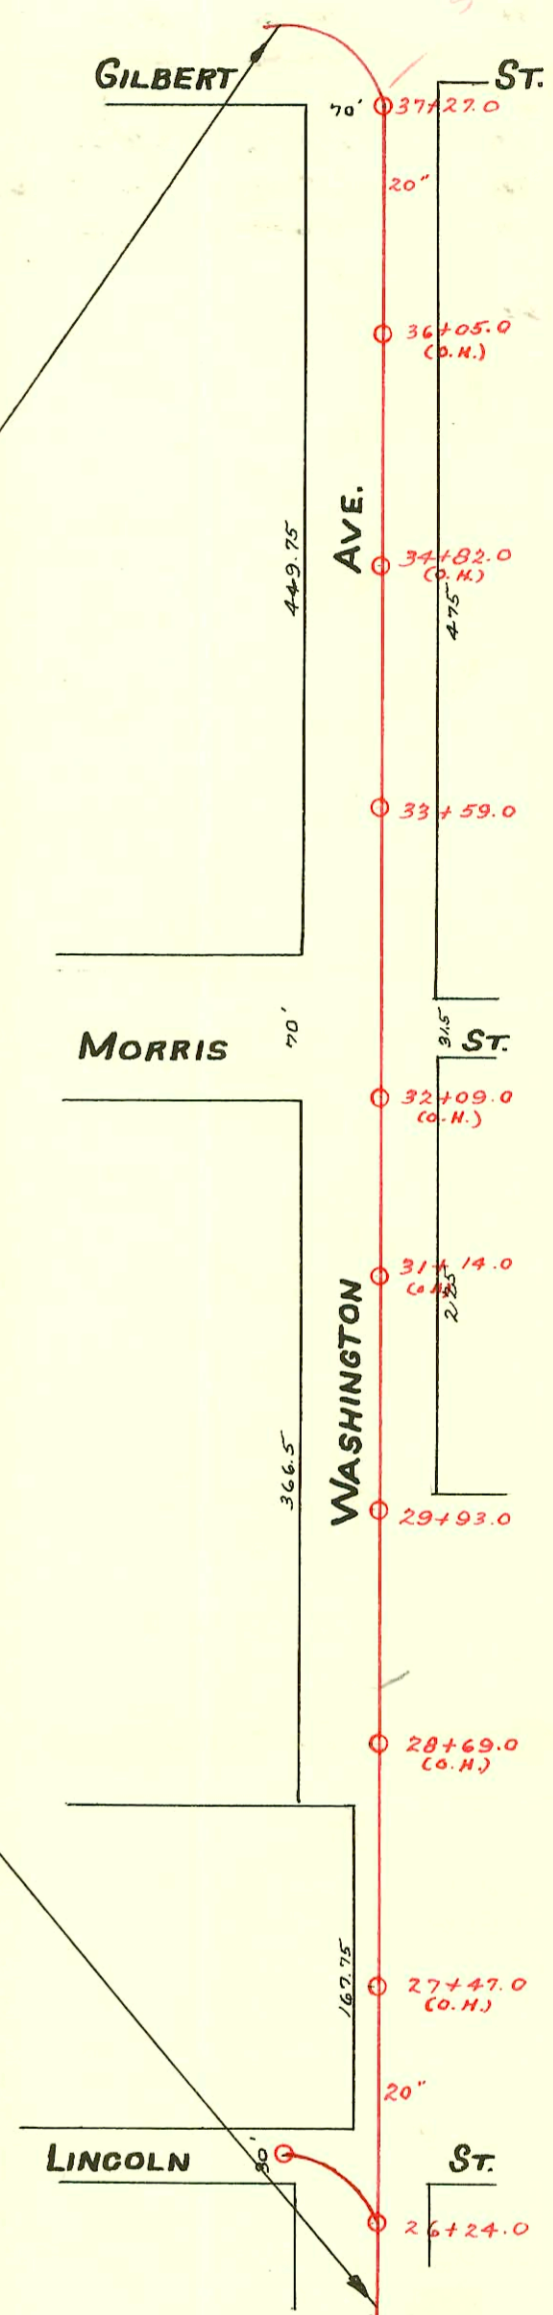

see pg. 316

