

MAIN "D" FROM GILBERT ST. TO ORME ST.
S.S. No. 1-1889


Plat 9-56



SCALE: 1" = 100'

TRAP AREA

RECONSTRUCT SANITARY SEWER
NO. 1 & 20
PROJ. NO. 468-81996 (630541)
BUILT BY INSITUFORM PLAINS, INC.
BOOKED 5-16-94 FROM AS BUILTS

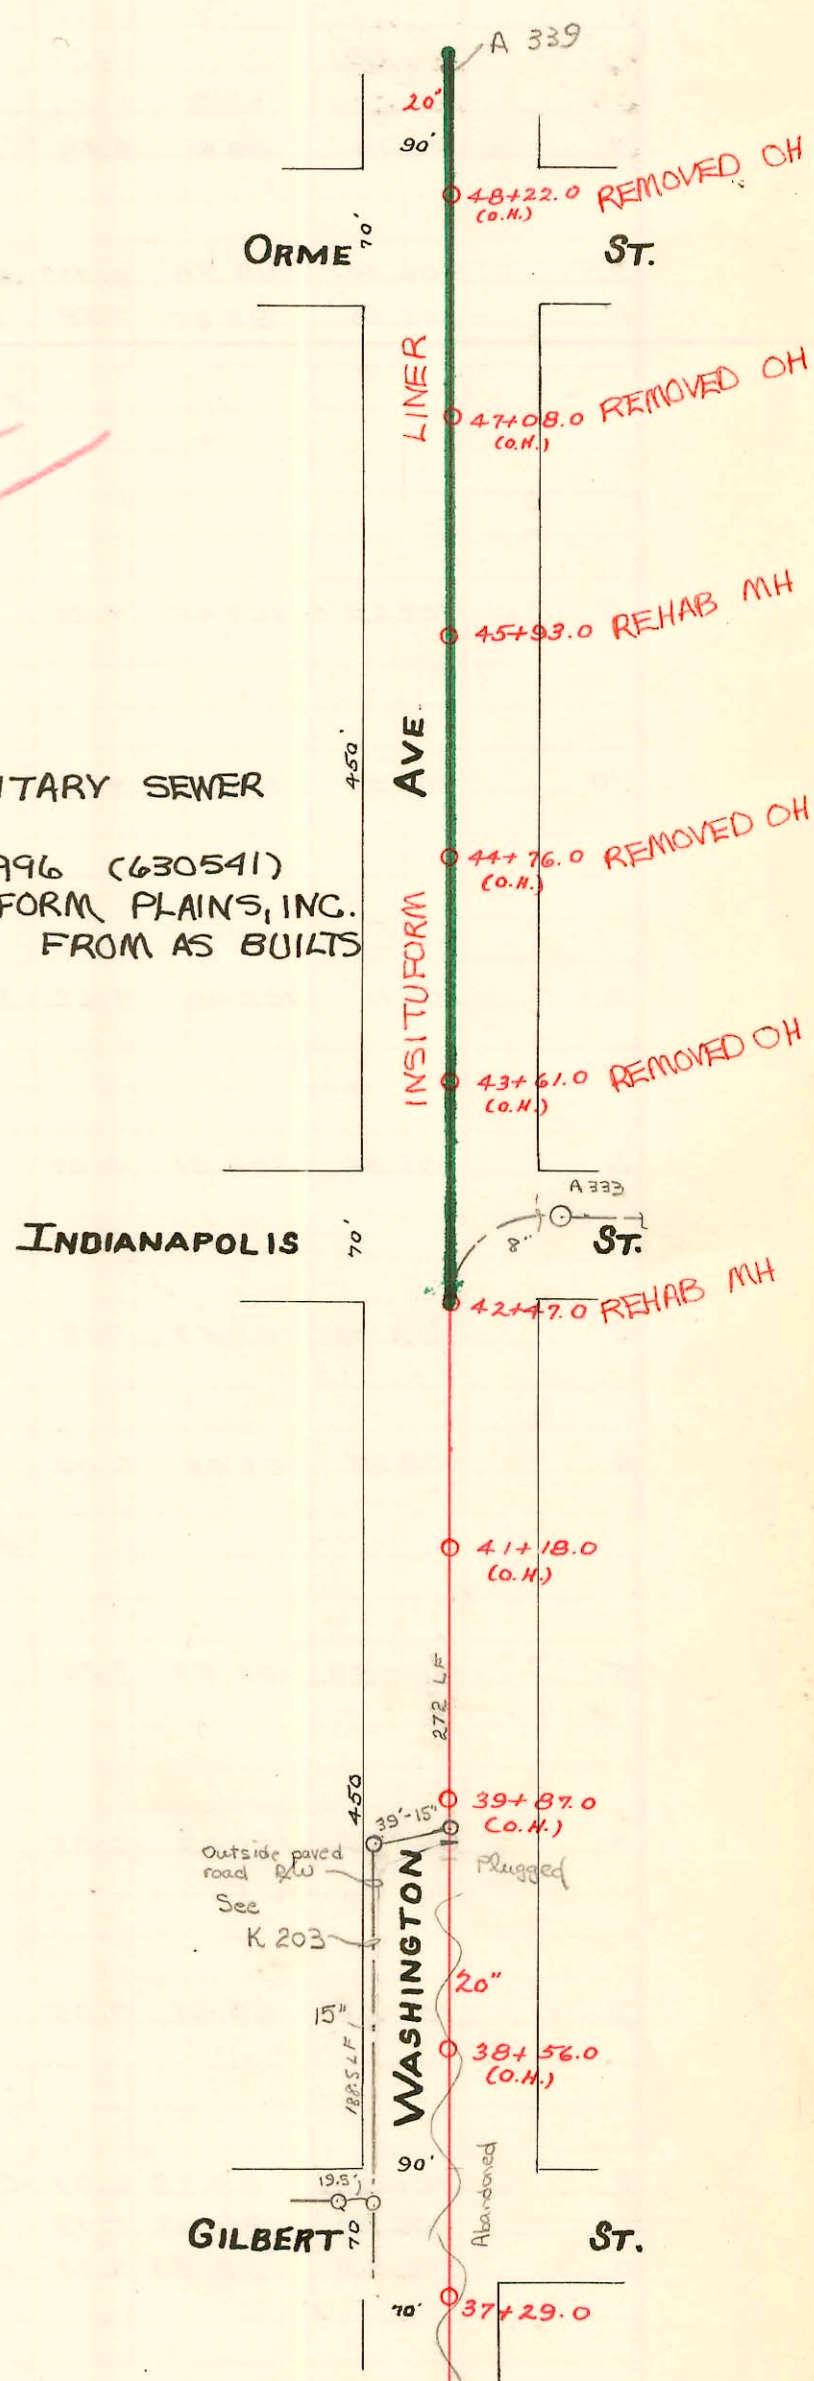

See 19. 325

