


MAIN "D" FROM ENGLISH ST. TO NORTH SIDE OF DOUGLAS AVE.  
S.S. No. 1 - 1889

Plat 9-53

TRAP AREA

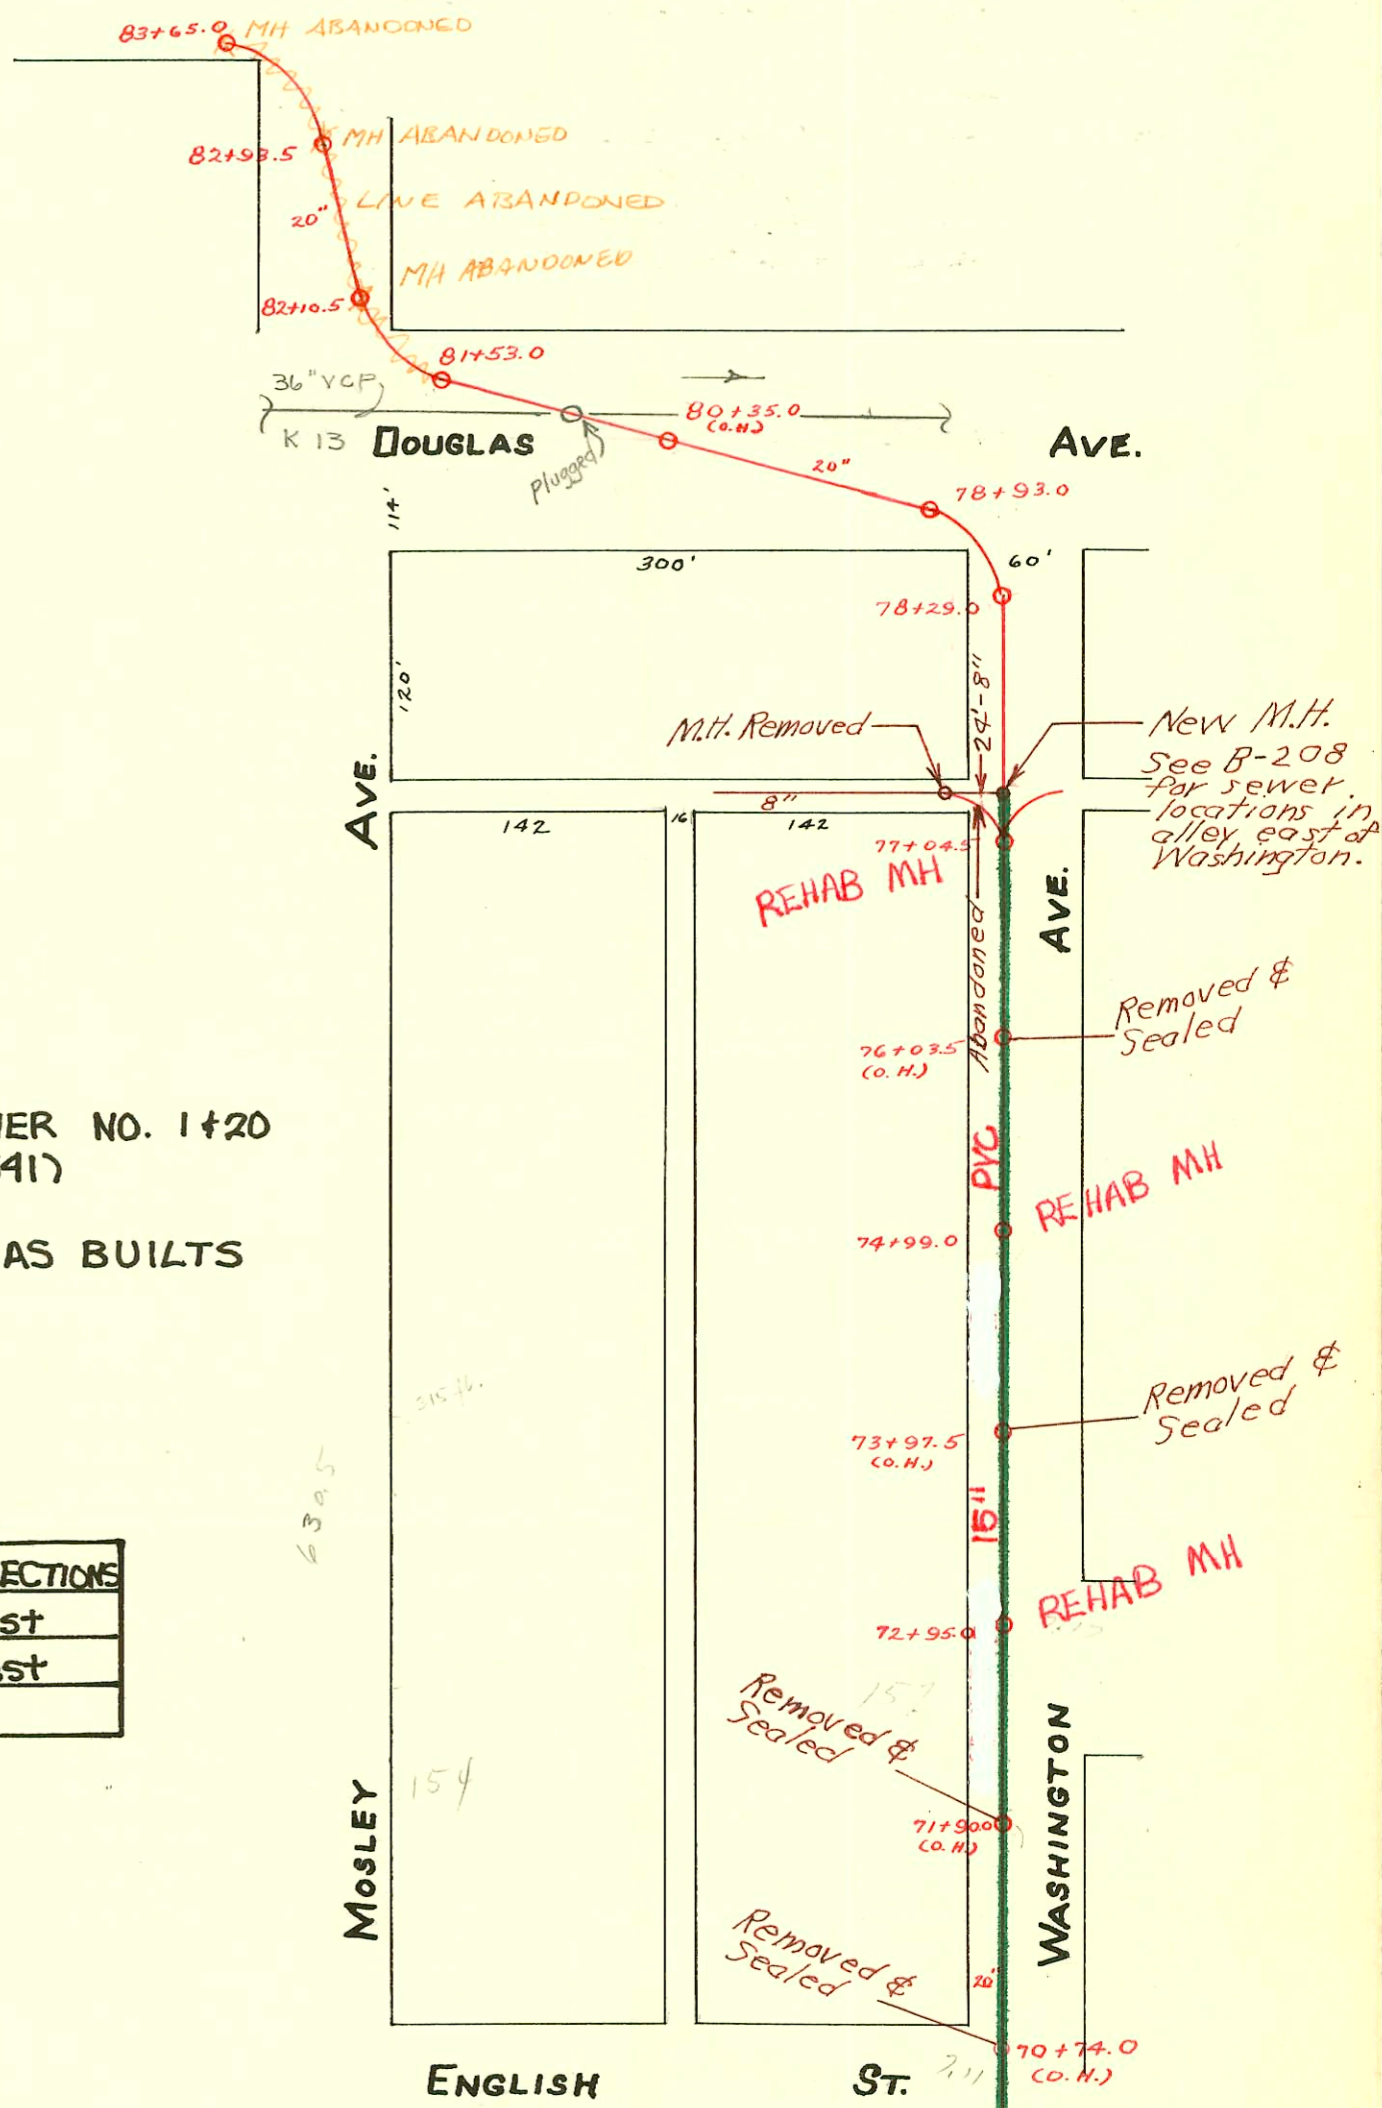

RECONSTRUCT SANITARY SEWER NO. 1420  
PROJ. NO. 468-81996 (630541)  
BUILT BY W. B. CARTER CO.  
BOOKED 4-28-95 FROM AS BUILTS

RECONNECTIONS

STA.	ADDRESS	DIRECTIONS
72+56	157 S. Washington	West
71+46	157 S. Washington	West

\* 147 S. Washington address changed to 149 S. Wash. off Mosley

CONSTRUCTION RECORD					SERVICE RECORD							
STATION	ELEVATION		Depth	MANHOLE	4-INCH "Y" BRANCHES		No. of Permit		House Number		DATE OF PERMITS	
	Ground	Grade			North West	South East	North West	South East	North West	South East	North West	South East
83	108.80	101.78	7.02	83+65.0								
	108.50	101.71	6.79	82+93.5								
82	107.12	101.63	5.49	82+10.5								
81	107.46	101.57	5.89	81+53.0								
80	109.10	101.42	7.68									
				78+93.0								
78	108.92	101.25	7.67	78+29.0								
77	107.99	101.12	6.87	77+04.5								
76	107.92	101.02	6.90									
74	107.55	100.92	6.63	74+99.0								
73	108.40	100.72	7.68									
72	107.79	100.62	7.17	72+95.0								
71	107.83	100.52	7.31									
70	107.53	100.42	7.11	70+74.0 (o.H.)								

# 892-Tap - 167 S. Washington - 6-1-38 - Plummer & Skinnell (A. Measure) (C. Wash)

# 2828-Tap - 163 S. Washington - 10-23-50 - Cowan P/bq. Co.

C16692 - Seal off - 167 S. Washington - 11-12-69 - J. Hamming