


Plat 9-50

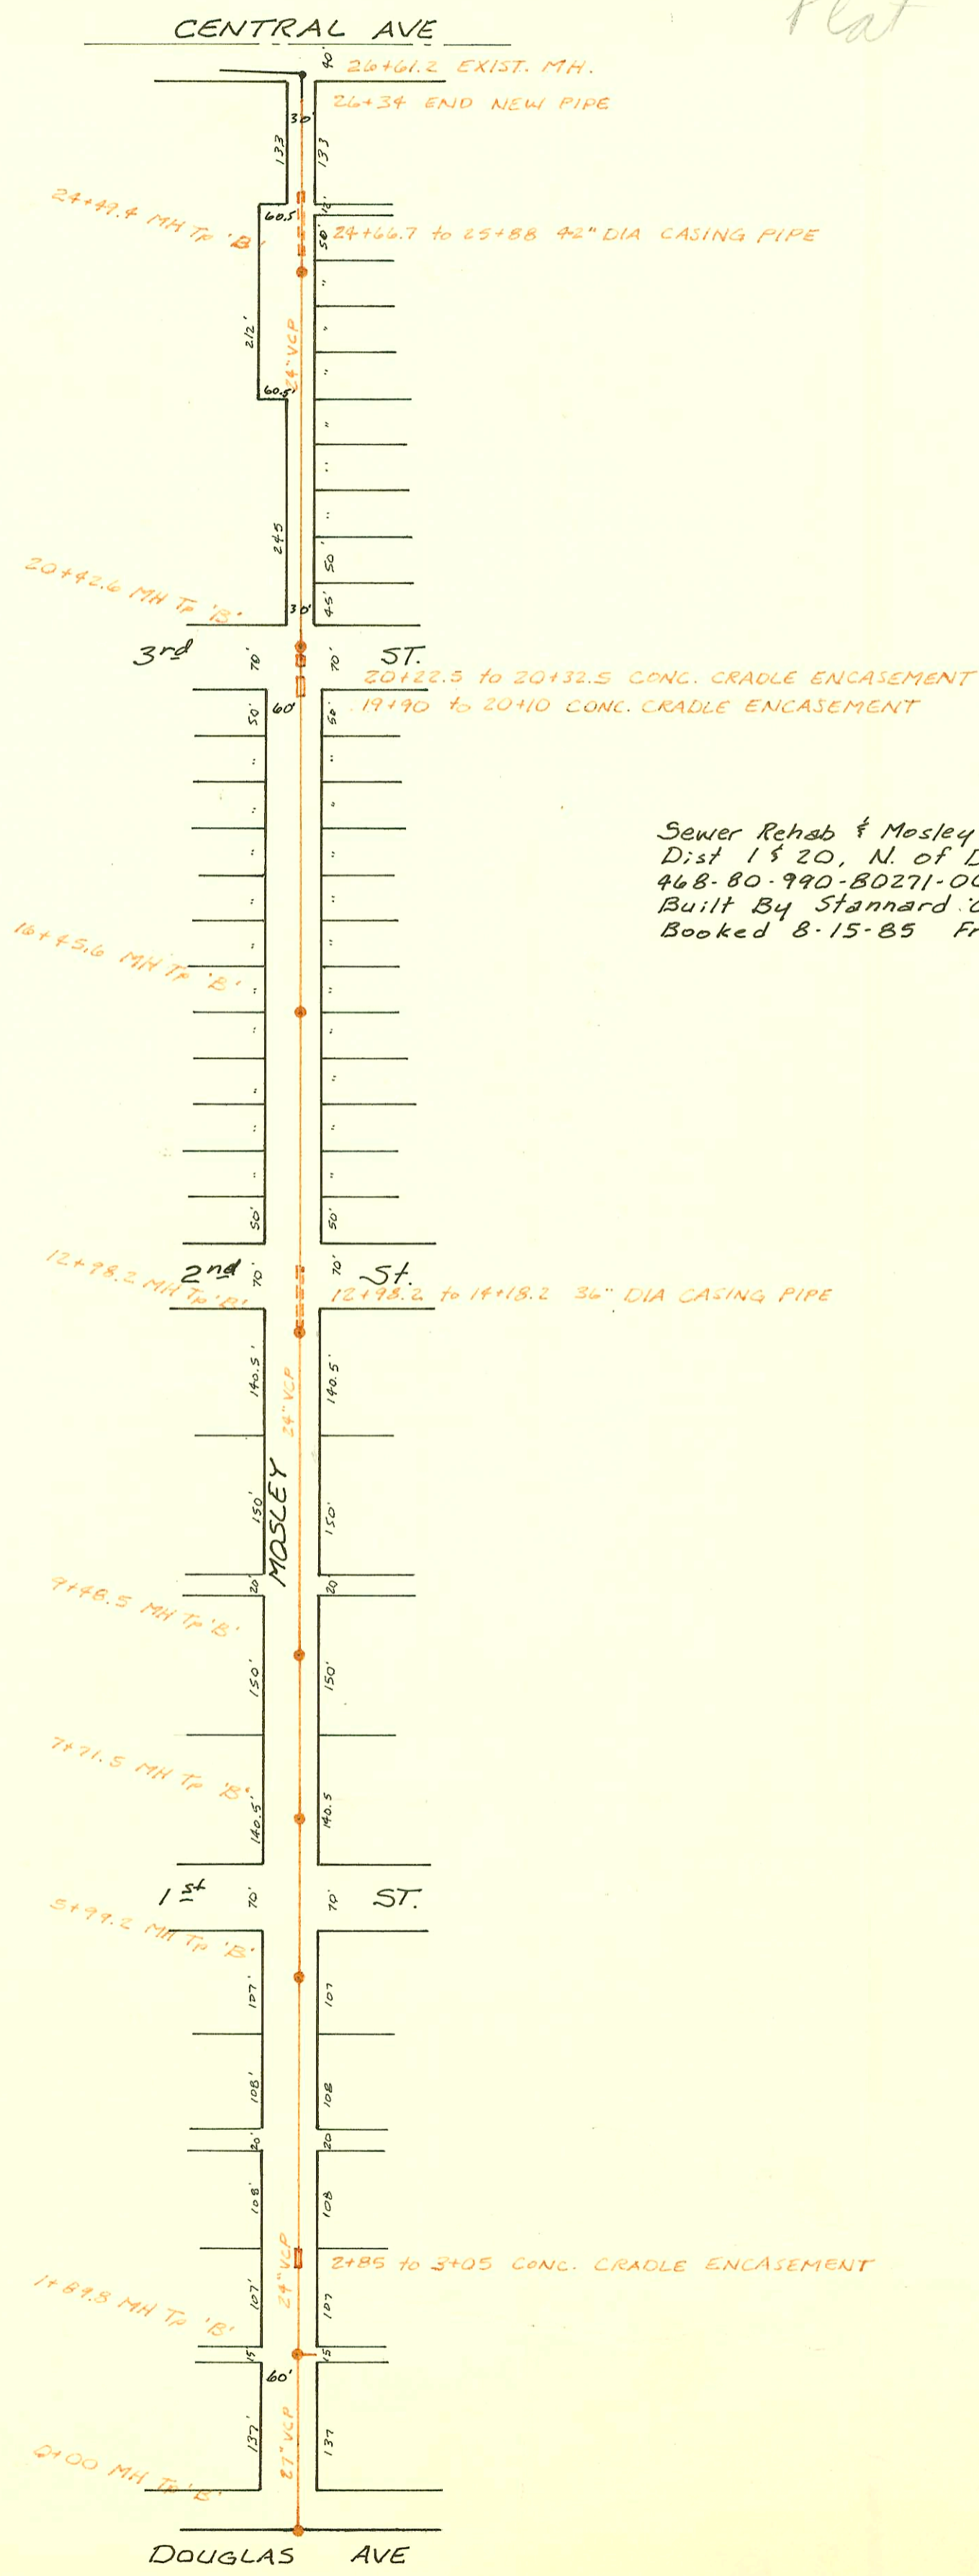

Sewer Rehab & Mosley Relief Sewer  
 Dist 1 & 20, N. of Douglas  
 46B-80-990-B0271-000-000-001  
 Built By Stannard Const.  
 Booked 8-15-85 From BR-117 & As Built



CONSTRUCTION RECORD						SERVICE RECORD						
STATION	ELEVATION		Depth	MANHOLE	4-INCH "Y" BRANCHES		No. of Permit		House Number		DATE OF PERMITS	
	Ground	Grade			North West	South East	North West	South East	North West	South East	North West	South East
SEWER REHAB & Mosley Relief Sewer												
SEWER IN Mosley, Douglas to Central												
0+00	109.87	100.19	9.7	0+00								
1+00		100.30										
	109.33	100.40 OUT 100.61 IN	8.9	1+89.8								
2+00		100.62										
3+00		100.71										
4+00		100.81										
5+00		100.91										
	109.05	101.00 OUT 101.14 IN	8.1	5+99.2								
6+00												
7+00		101.30										
	109.27	101.41 OUT 101.42 IN	7.9	7+71.5			98-1167		930 E (Hotel at Old Town)		6-8-98	
8+00		101.43										
9+00		101.47										
	109.69	101.49 OUT 101.64 IN	8.2	9+48.5								
10+00		101.70										
11+00		101.81										
12+00		101.93										
	111.19	102.04 OUT 102.21 IN	9.2	12+98.2								
13+00												
14+00		102.32										
15+00		102.44										
16+00		102.55										
	111.50	102.60	8.9	16+45.6								
17+00		102.65										
18+00		102.73										
19+00		102.82										
20+00		102.90										
	110.89	102.94 OUT 103.09 IN	8.0	20+42.6								
21+00		103.11										
22+00		103.15										
23+00		103.19										
24+00		103.23										
	111.80	103.25 OUT 103.42 IN	8.6	24+49.4								
25+00		103.58										
26+00		103.90										
26+34		104.00										
	111.51	104.09 OUT 104.29 IN	7.4	26+61.2 EXIST MH								
Slo SWR 2000-01489 (920 E 1st ST N) - Todd Plumbo - No record of orig. conn. Slo 16' S of MH 790 (774)												