


WEST SUB-MAIN "D" ON THIRD ST AND LAT. NORTH - ALSO
TWO LAT'S WEST IN HINTON'S SUB.
S.S. No. 1-1889

Plat 9-50

TRAP AREA

- Easement #164 - on So. line - 104' 10 3/4" E. of Santa Fe.
- Easement #163 - on N. line of lots 21, 23, 25, 27 Hinton Ave.
- Easement #186 - on N. line of lots 13 & 15, Hinton Ave.
- Easement #220 - on N. Line lots 33 & 35.
- Easement #243 - on N.L. lots 17 & 19, Hinton Ave.

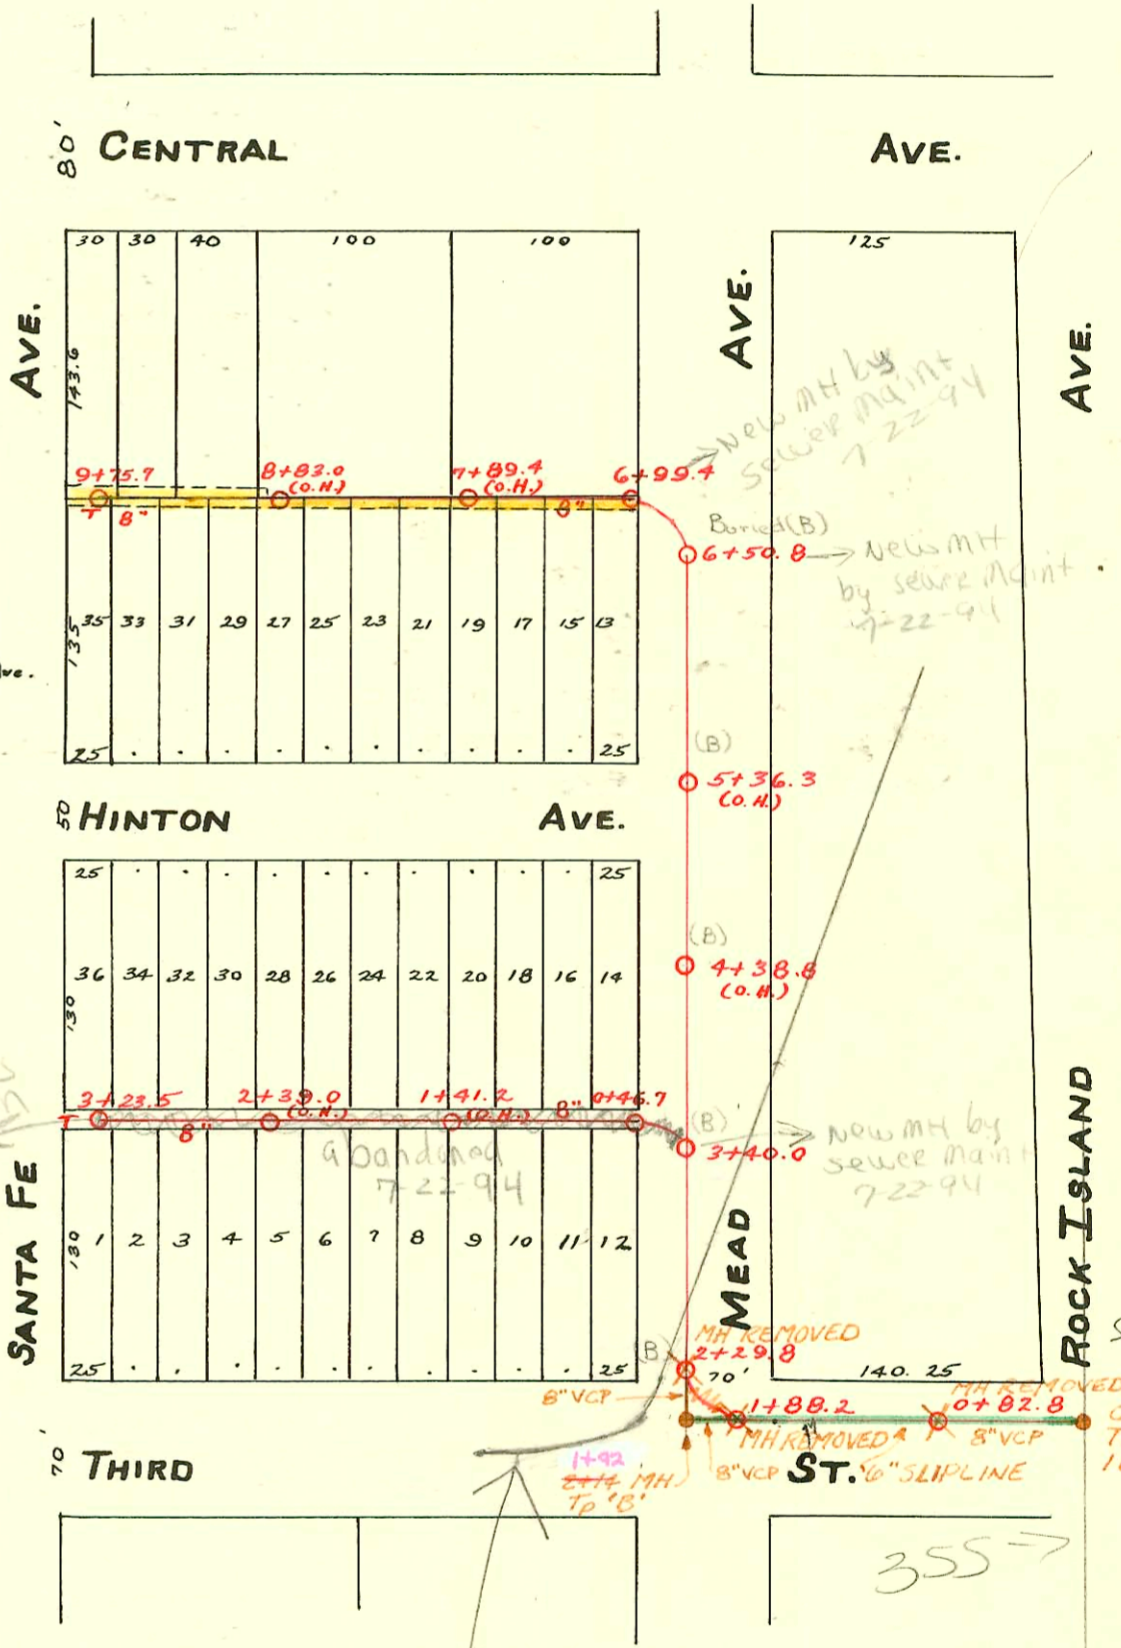

Sewer Rehab & Mosley Relief Sewer.
Dist 1 & 20, North of Douglas
468-80-990-80271-000-000-001
Built By Stannard Const.
Booked 8-7-85 From As Built

K&E Transmission line
do not issue any sewer
permits near this line
until K&E has been
notified. 10-12-70
Rbd.

CONSTRUCTION RECORD						SERVICE RECORD						
STATION	ELEVATION		Depth	MANHOLE	4-INCH "Y" BRANCHES		No. of Permit		House Number		DATE OF PERMITS	
	Ground	Grade			North West	South East	North West	South East	North West	South East	North West	South East
				3 + 23.5								
3	112.03	107.25	4.78		3 + 19.2	3 + 21.2						
					2 + 97.4	2 + 99.4						
					2 + 73.0	2 + 75.0						
					2 + 49.1	2 + 51.1						
					2 + 25.0	2 + 27.0	#293		725 Hinton		10-7-41	
2	112.15	106.70	5.45		2 + 01.0	2 + 03.0						
					1 + 76.1	1 + 78.1						
					1 + 43.4	1 + 45.4						
1	112.07	106.15	5.92		1 + 19.2	1 + 21.2						
					0 + 95.7	0 + 97.7						
					0 + 71.1	0 + 73.1						
0	112.37	105.82	6.55	0 + 46.7	0 + 51.0	0 + 53.0						
				9 + 75.7								
					9 + 73.5	9 + 71.5	#26		703 E Central		1-8-23	
					9 + 47.4	9 + 45.4	#1596		705 E Central		11-23-22	
9	113.07	107.30	5.77		9 + 21.3	9 + 19.3	#2129		725 E Central		6-29-45	
					8 + 97.0	8 + 95.0	#1597				11-23-22	
					8 + 70.9	8 + 68.9						
					8 + 46.1	8 + 44.1	#1644		711 E Central		11-1-22	
8	112.20	107.00	5.20		8 + 21.5	8 + 19.5						
					7 + 97.5	7 + 95.5	#1636		715 E Central		12-1-22	
					7 + 73.4	7 + 71.4						
					7 + 49.5	7 + 47.5	#1637		717 E Central		12-1-22	
					7 + 25.3	7 + 23.3	#16					
					7 + 04.8	7 + 02.8	#1638		759 E Central 719 E Central		3-21-33 12-1-22	
7	111.33	106.68	4.65	6 + 99.4								
6	111.20	106.56	4.64	6 + 50.8								
5	111.43	106.10	5.53									
4	111.01	105.80	5.21									
3	111.47	105.60	5.87	3 + 40.0								
2	111.11	105.28	5.83	2 + 29.8								
1	111.12	105.16	5.96	1 + 88.2		1 + 68.2	#580		802 E 3rd		10-27-10	
0	110.23	104.85	5.38	0 + 82.8								

Book D Page 71

#1146 - Tap - 625 E. Central - Chester Davidson - 3-11-42
 #6158 - Tap - 810 E. Third - Pray Bros. 10-17-51