


# MAIN "D" FROM NINTH ST. TO ELEVENTH ST. AND SPUR ON NINTH STREET

S.S. No. 1-1889

Plat 9-44

TRAP AREA

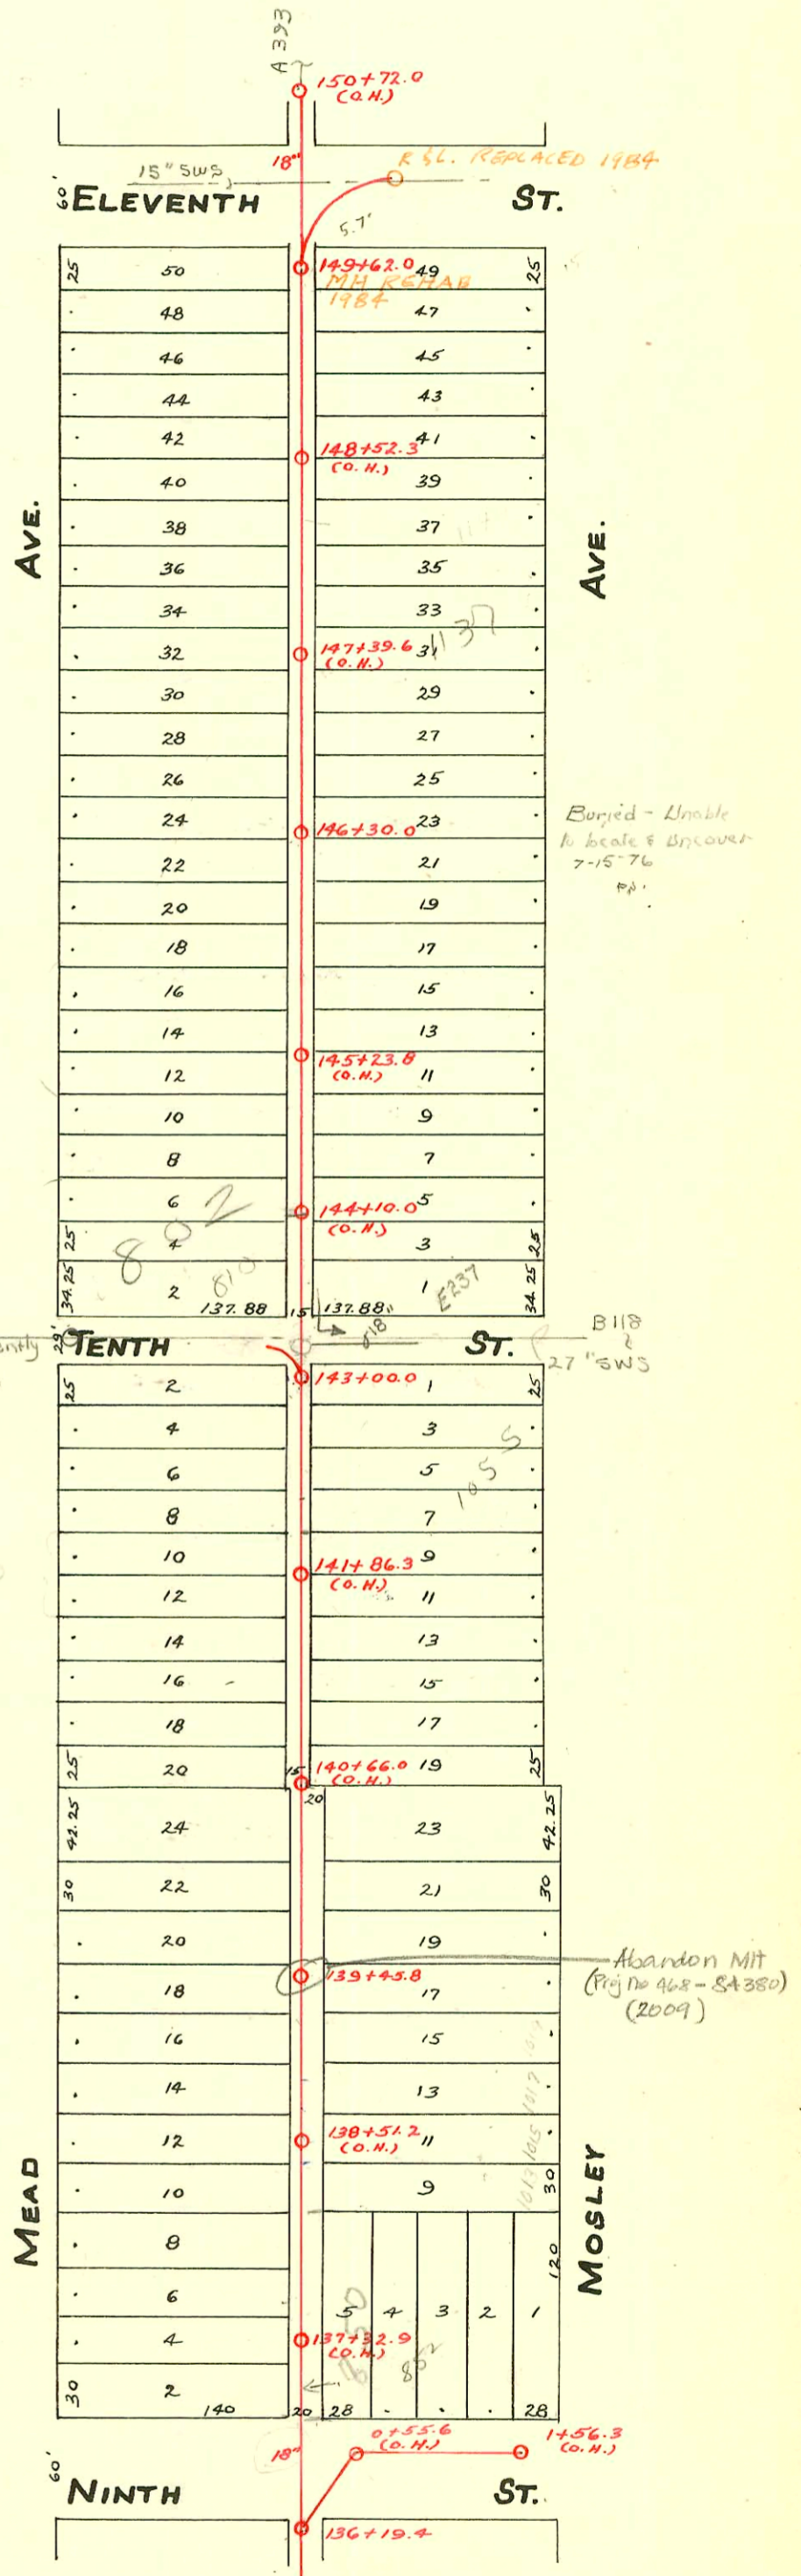

NOTE: MH at sta. 143+00.0 apparently buried under concrete slab. Flow crew unable to locate positively. Feel approx 5' bet. MH's

107 1/2" N. V. 100' D

2081

CONSTRUCTION RECORD						SERVICE RECORD						
STATION	ELEVATION		Depth	MANHOLE	4-INCH "Y" BRANCHES		No. of Permit		House Number		DATE OF PERMITS	
	Ground	Grade			North West	South East	North West	South East	North West	South East	North West	South East
	114.52	109.71	4.82	1+56.3(O.H.)								
					1+54.5							
					1+29.8							
1	114.58	109.17	5.44		1+05.5							
					0+81.0							
0	114.92	108.67	6.25	0+55.6(O.H.)	0+56.5							
				150+72.0 (O.H.)								
					150+70.3	150+68.3		#914				
					150+45.9	150+43.9		#1980	1211 N. Mosley			9-2-24
150	115.10	109.02	6.08		150+20.9	150+18.9						
				149+62.0								
					149+45.0	149+43.0	#1590	#1146	1162 N. Mead		7-10-24	
149	114.65	108.92	5.73		149+16.4	149+14.4	#306	#2249	801 E. 11th	1157 N. Mosley	3-11-52	11-3-65 10-3-24
					148+91.5	148+89.5		#1908		1155 N. Mosley		10-18-73 8-20-24
					148+66.8	148+64.8						
					148+42.5	148+40.5						
148	114.55	108.82	5.73		148+18.0	148+16.0		#2320	1149 N. Mosley	1140 N. Mosley		7-28-73 10-15-24
					147+93.3	147+91.3		#2660		1147 N. Mosley		12-5-24
					147+68.3	147+64.3				1139 N. Mosley		12-12-73
					147+44.0	147+42.0		#5034		1137 N. Mosley		5-1-53
147	114.45	108.72	5.73		147+19.6	147+17.6						
					146+95.0	146+93.0						
					146+70.0	146+68.0						
				146+30.0	146+45.7	146+43.7	#565	#2697	1120 N. Mead	1125 N. Mosley	3-26-24	12-12-24
146	114.55	108.62	5.93		146+20.5	146+18.5		#3244		1123 N. Mosley		1-25-55
					145+95.8	145+93.8		#5033		1123 N. Mosley		5-1-53
					145+71.0	145+69.0						
					145+46.9	145+44.9		#45213		1115 N. Mosley		6-12-74
145	115.36	108.52	6.84		145+22.0	145+20.0	#564	#2202	1114 N. Mead	1113 N. Mosley	3-26-24	9-27-24 3-15-62
					144+96.9	144+94.9						
					144+72.2	144+70.2	#1084	#863	1108 N. Mead	1111 N. Mosley	4-17-24	8-28-75 9-15-24
			6.10		144+48.0	144+46.0						
144	115.84	108.42	7.42		144+22.8	144+20.8		#393		1105 N. Mosley		11-18-81 3-5-24
					143+98.0	143+96.0		#1973	802 E. 10th		3-1-94 8-30-24	
					143+73.3	143+71.3		#679		1103 N. Mosley		11-10-51 5-7-23
143	115.25	108.32	6.93	143+00.0	143+37.0	143+35.0		#2070		1101 N. Mosley		5-22-45
					142+81.0	142+79.0						
					142+58.7	142+56.7						
					142+34.5	142+32.5						
142	115.66	108.22	7.44		142+09.8	142+07.8	#2739	#3262	811 E. 10th	1055 N. Mosley	10-1-52	12-30-91 2-9-50
					141+84.5	141+82.5		#894				4-21-24
					141+60.2	141+58.2						
					141+35.7	141+33.7		#1612				11-2-23
141	115.26	108.12	7.14		141+11.1	141+09.1						
					140+86.2	140+84.2						
					140+62.0	140+60.0						
					140+38.2	140+36.2		#1880				8-25-78 12-20-23
140	115.38	108.02	7.36		140+16.0	140+14.0		#1860				8-15-24
					139+89.1	139+87.1	#459	#2552		1031 N. Mosley	3-12-24	11-17-24
					139+56.7	139+54.7		#1153		1027 N. Mosley		8-2-23
			8.58	139+45.8								
					139+28.5		#3563		811 E. 10th (Add.)		5-13-66	
139	115.42	107.92	7.50		139+00.0	139+26.5						
					138+69.2	138+98.0	#165	#1286	1020 N. Mead	1019 N. Mosley	6-12-78 2-12-24	8-29-23
						138+67.2		#657		1015 N. Mosley		11-22-41
					138+39.2	138+37.2	#1925	#162	1015 N. Mead	1015 N. Mosley	2-9-70 12-28-23	1-28-24 7-20-23
138	115.25	107.82	7.43		138+08.7	138+06.7		#1075				
					137+80.0		#200		1008 N. Mead		9-20-76 2-15-24	
					137+49.8	137+78.0						
137	115.23	107.72	7.51		137+18.8							
136	115.59	107.62	7.97	136+19.4	136+88.4							

Tap #1259-6-2-24-814 E. 9th  
 Tap #67-1129-31 N. Mosley-2-11-54-Kendall Pkwy.  
 Tap #1397-818 E. 10th-2-16-44-H.P. Dunaway 11-10-81-A1 Henning (143+66.0 +/-) (66' x 22" MH)  
 Tap #3961-800 E. 11th-3-23-55  
 Rec #48341-Gon 8 wye-1135 N. Mosley-Reynolds-2-20-57  
 C43923-850 E. 9th-Ad 078-3-12-74-Servis (50' N. of 71' curb line)  
 C48057-852 E. 9th-11/16/75-Henning  
 #20560-1137 N. Mosley-4/20/81-NK N. Servis Bldg add (148+10.0)