


EAST SUB-MAIN "D" ON ELEVENTH ST. AND LAT'S N. & S.

S.S. No. 1- 1889

RECON PORTION OF EAST SUBMAIN D SAN SEWER No. 1  
BTW MOSLEY & WASHINGTON - 11TH ST TO 12TH ST  
BUILT BY: MID STATES CONST. CO.  
PROJ. No 468-76-245-B1200-000-000-001  
BOOKED 3-16-83 FROM AG 13

Plat 9-4A

TRAP AREA

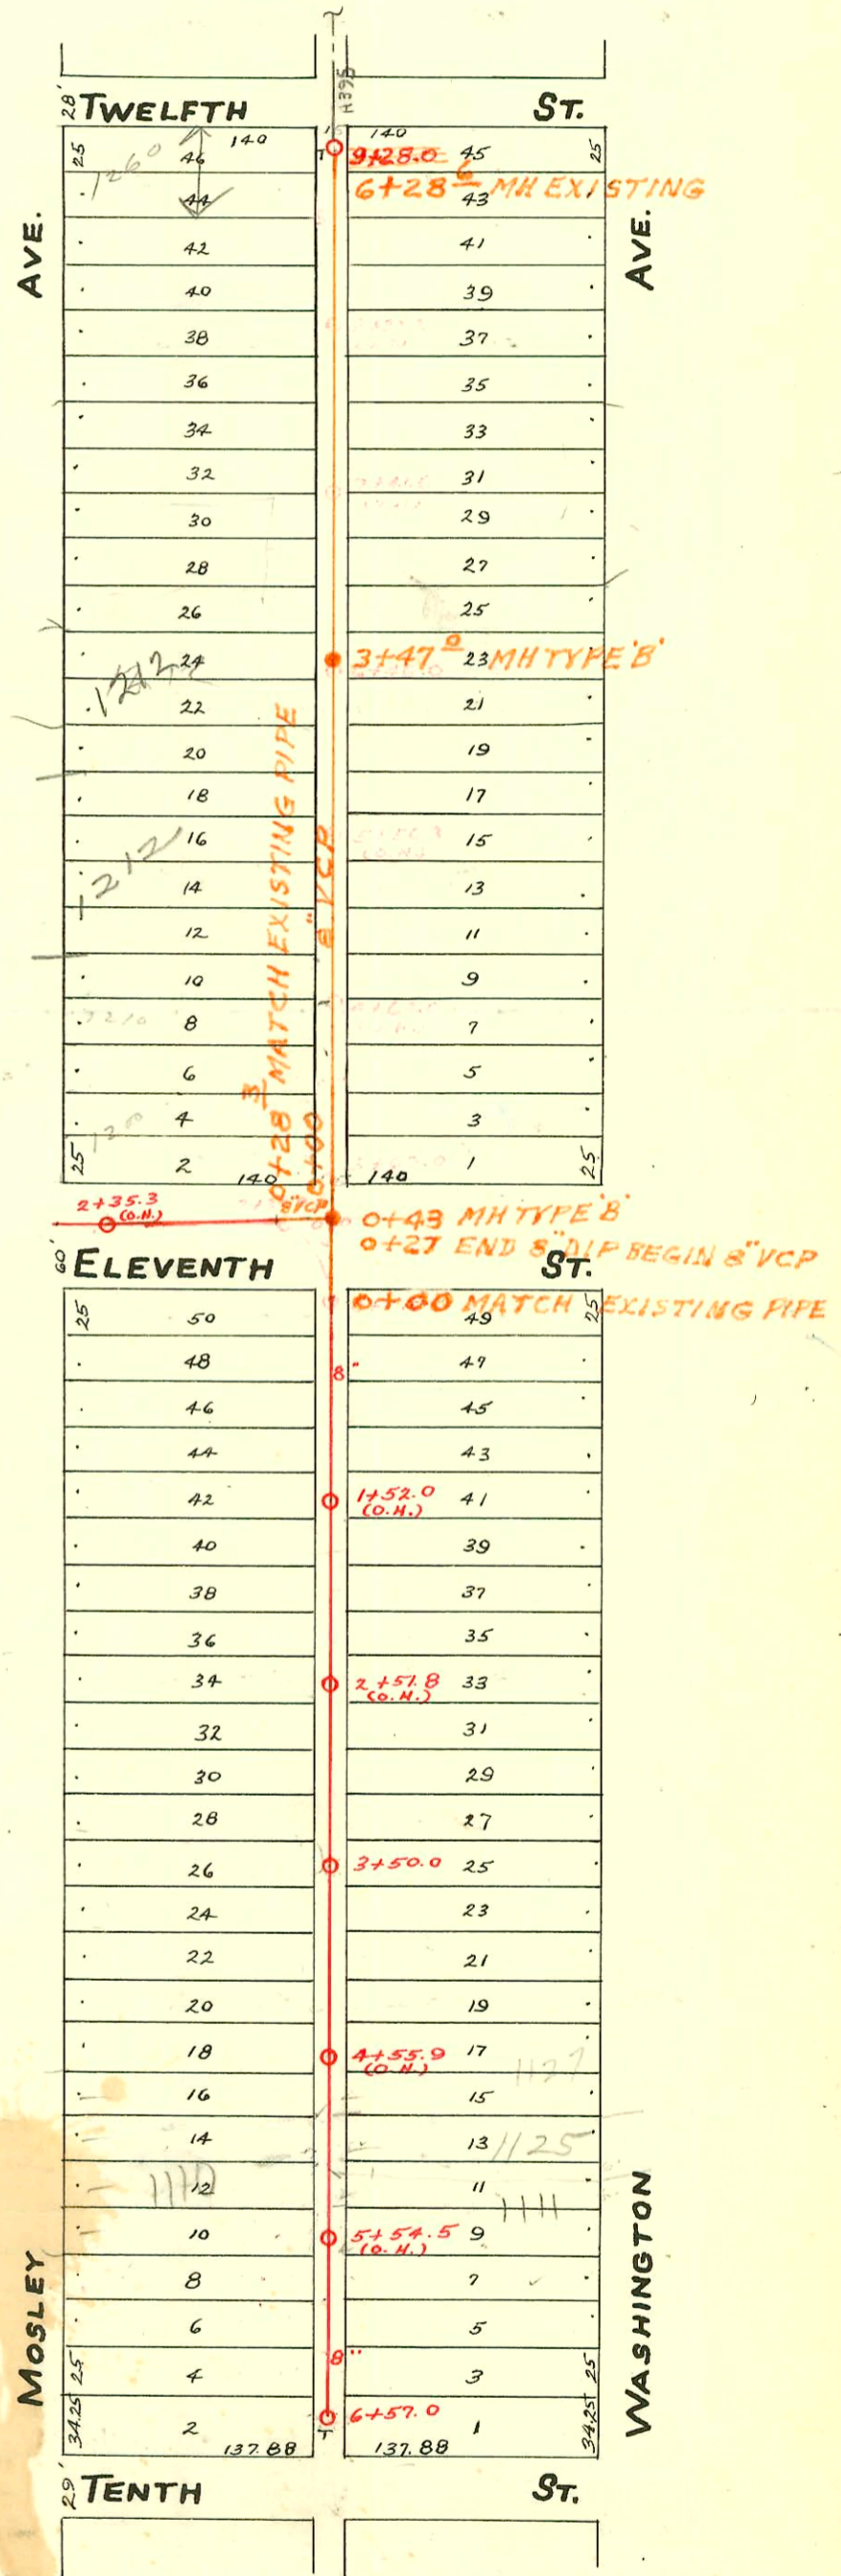

CONSTRUCTION RECORD

SERVICE RECORD

STATION	ELEVATION		Depth	MANHOLE	4-INCH "Y" BRANCHES		No. of Permit		House Number		DATE OF PERMITS	
	Ground	Grade			North West	South East	North West	South East	North West	South East	North West	South East
				6 + 57.0	slo 6" clay 6 + 50.7	6 + 52.7	92-8727-7 #2444		1102 N Mosley		6-16-92 11-19-45	
6	113.19	111.80	1.39		6 + 25.7 6 + 01.0 5 + 75.6 5 + 57.2 5 + 27.0	6 + 27.7 6 + 03.0 5 + 77.6 5 + 53.2 5 + 29.0	#3378 #2117 #2251 #2709		1101 N Washington 1112 N Mosley 1111 N Washington 1117 N Washington 1126 N Mosley		2-9-55 9-15-24 2-16-60 12-15-24	10-3-22 7-31-58 10-20-24
5	115.11	111.55	3.56		5 + 02.0 4 + 77.0 4 + 52.5 4 + 28.2	5 + 04.0 4 + 79.0 4 + 54.5 4 + 30.2	#2709 #660 #49642 #3529		1125 N Washington 1129 N Washington 1110 N Mosley		5-23-75 2-17-55	6-18-25
4	115.97	111.30	4.67		4 + 03.5 3 + 78.0 3 + 53.8	4 + 05.5 3 + 80.0 3 + 55.8	#778 #2147 #702		1134 N Mosley 1136 N Mosley		7-14-25 6-26-25	1-29-68 7-19-24
3	115.96	111.05	4.91	3 + 50.0	3 + 29.2 3 + 04.5 2 + 79.0 2 + 56.5 2 + 29.2	3 + 31.2 3 + 06.5 2 + 81.0 2 + 54.5 2 + 31.2	#2282 #4041 #311		1135 N Washington 1140 N Mosley 1140 N Mosley		10-9-24 4-4-55 3-11-52	11-25-70 5-18-25 10-24-24
2	115.99	110.80	5.19		2 + 04.3 1 + 79.0 1 + 54.0 1 + 29.0	2 + 06.3 1 + 81.0 1 + 56.0 1 + 31.0	#7213 #173 #951		1148 N Mosley 1147 N Mosley 1150 N Mosley		1-10-56 3-7-25 8-27-25	10-24-24 10-27-24
1	115.51	110.55	4.96		1 + 04.3 0 + 79.3 0 + 55.3	1 + 06.3 0 + 81.3 0 + 57.3	#16169 #181		1156 N Mosley		10-6-69 2-72-28	8-1-66 2-25-26
0	115.38	110.43	4.95	0 + 00 0 + 57.0			#1299		1157 N Washington			
6+00	116.18	111.70	4.5	6 + 28.6 9 + 28.0	4" SCH 40 9 + 25.0	6 + 25 9 + 23.0	99-13048-7 54821		1260 N Mosley	see below	6-22-99 4-13-76	
9	115.48	111.73	3.75		9 + 09.3 8 + 85.5 8 + 61.5	9 + 07.3 8 + 83.5 8 + 59.5	#2293 #2987		1248 N Mosley 1250 N Mosley		3-15-67 10-11-24 4-29-46	
8	115.66	111.45	4.18		8 + 37.5 8 + 13.5 7 + 89.0 7 + 64.5	8 + 35.5 8 + 11.5 7 + 87.0 7 + 62.5	#2205 #1144 #1962		1242 N Mosley 1240 N Mosley		9-29-24 10-16-25 8-9-66 8-28-24	
7	116.38	111.26	5.15		7 + 39.7 7 + 15.0 6 + 89.5 6 + 66.0	7 + 37.7 7 + 13.0 6 + 87.5 6 + 64.0	#2947 #322 #4002 #60		1230 N Mosley 1239 N Washington 1241 N Washington		12-13-54 3-11-54 8-29-79 2-12-25	
6	115.67	110.98	4.69	3 + 47.0 6 + 46.0	6 + 42.0 6 + 16.8 5 + 93.0	6 + 40.0 6 + 14.8 5 + 91.0	#8086 #1901 #1902		1234 N Mosley 1220 N Mosley		1-17-75 8-20-24 11-24-77 8-20-24	2-12-25
5	114.96	110.73	4.23		5 + 68.5 5 + 45.0 5 + 20.0	5 + 66.5 5 + 43.0 5 + 18.0	#554 #2503 #1105		1216 N Mosley 1211 N Washington 1209 N Washington		7-9-65 5-21-25 10-6-25	10/14/66 11-8-24
4	114.99	110.48	4.51		4 + 96.0 4 + 71.2 4 + 47.0 4 + 22.7	4 + 94.0 4 + 69.2 4 + 45.0 4 + 20.7	#314 #2543 #278		1207 N Washington 1207 N Washington 1203 N Washington		4-26-60 3-3-43 9-15-24	9-25-24
3	115.26	110.56	4.7	9 + 43 3 + 69.0	3 + 98.5 3 + 74.5	3 + 96.5 3 + 72.5	#5737 #173		910 E. 11th		4-26-60 4-12-18	7-7-53
2	115.08	110.30	4.78	9 + 28.3 3 + 30.0	116.32	109.98	6.34	2 + 35.3 (O.H.)				

99-13048-7 - 6/22/99 - 1260 N Mosley - McClurgs - 4" SCH 40 Tied back to wye - Twin Co, TRAP, 1H22 - no msmt

#10990 - 1110 N Mosley - 5-22-84 - Jim Mosley 6+57.0 (90) (5+67.0)

C67018 - 1212 N Mosley - 6-22-78 (6+53)

C42423 - 1212 N Mosley - 11-27-73 - B. Keller (5+56.3 O.H.)

#778 - 1110 N Mosley - 11-8-66 - George Pibg (addr)

C73153 - 1110 N Mosley - 9-2-78 - Ronald Thompson (by 4+50.5)

Tap - 1210 N Mosley - H.P. Dunaway - 2-4-44

Tap - 1106 N Mosley - Baker Pibg - 7-9-51

Tap - 1137 N Washington - 8-29-51 - Baker Pibg

Tap - 1135 N Washington - 11-5-56 - Reynolds Pibg

2002-D1718-C 73134 - 1200 N Mosley - 7-20-79 (Tap 1+58) 61212 - Wichita Exc - Concrete alley cut, New trap, Predeo Saddle 115' N

5/0 #00161 - 1223 N Washington - 4-25-80