


NORTH BLOCK OF LAT. NTH FROM EAST SUB-MAIN "D" ON 15TH.
S.S. No. 1 - 1889

Plat 9-41

TRAP AREA

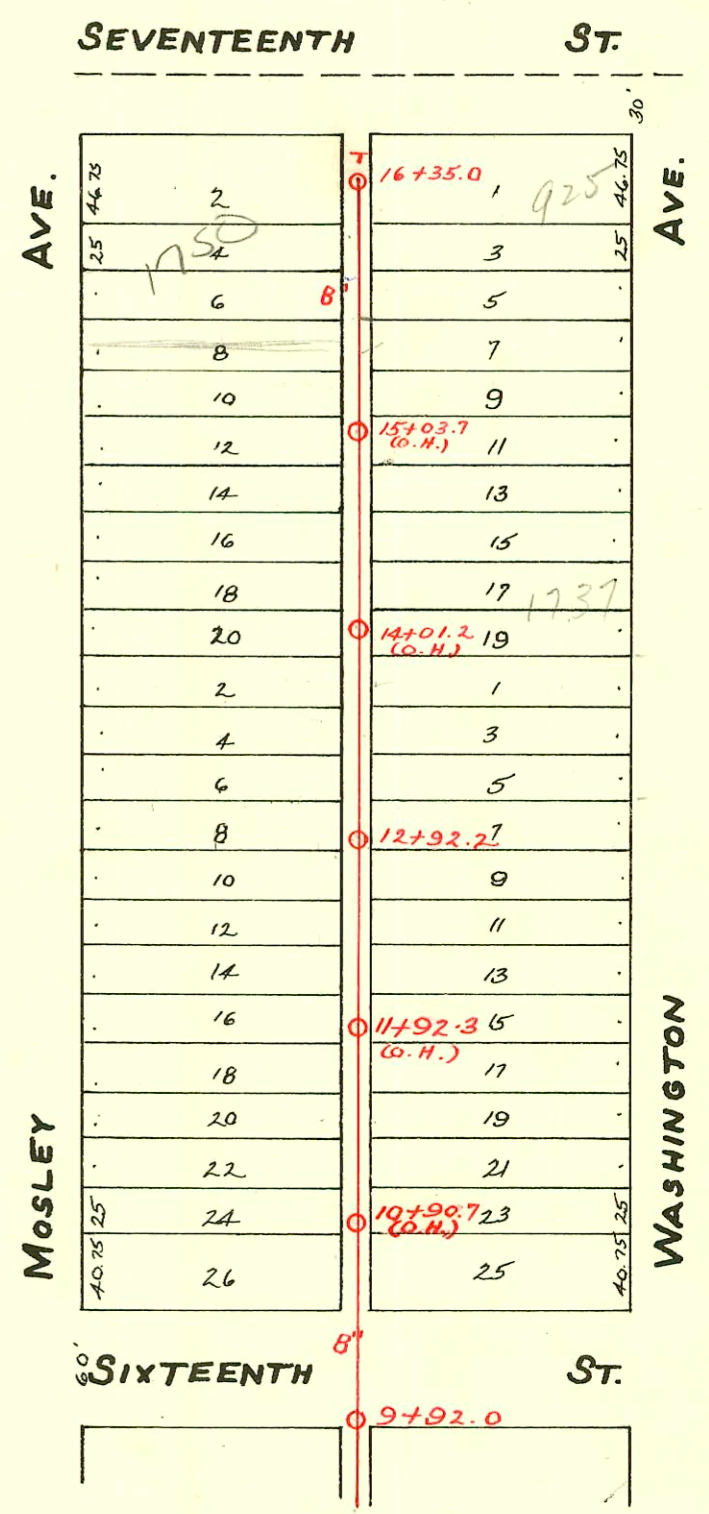

| CONSTRUCTION RECORD | | | | | | SERVICE RECORD | | | | | | |
|---------------------|-----------|--------|-------|---------|---------------------|----------------|---------------|------------|------------------|----------------------------|-----------------|------------|
| STATION | ELEVATION | | Depth | MANHOLE | 4-INCH "Y" BRANCHES | | No. of Permit | | House Number | | DATE OF PERMITS | |
| | Ground | Grade | | | North West | South East | North West | South East | North West | South East | North West | South East |
| | | | | 16+35.0 | | | | | | | | |
| 16 | 118.38 | 116.11 | 2.27 | | 16+32.5 | 16+30.5 | | | | 925 E. 1726 St | | 10-9-68 |
| | | | | | 16+10.5 | 16+08.5 | | C10860 | | | | |
| | | | | | 15+86.5 | 16+84.5 | | | | 1752 N Masley | | 7-12-50 |
| | | | | | 15+62.0 | 15+60.0 | #1600 | | | 815 E. 17 th | | 7-21-76 |
| | | | | | 15+37.8 | 15+35.8 | C56818 | #352 | | | | 7-15-37 |
| | | | | | 15+13.8 | 15+11.8 | | | | | | |
| 15 | 118.23 | 115.86 | 2.37 | | | | | | | | | |
| | | | | | 14+89.5 | 14+87.5 | | | | | | |
| | | | | | 14+65.7 | 14+63.7 | | | | | | |
| | | | | | 14+41.8 | 14+39.8 | #2683 | | 1738 N Masley | | | 12-5-49 |
| | | | | | 14+17.7 | 14+15.7 | | | | | | |
| 14 | 118.41 | 115.61 | 2.80 | | | | | | | | | |
| | | | | | 13+93.5 | 13+91.5 | | | | | | |
| | | | | | 13+69.5 | 13+67.5 | #1736 | | | 1737 N Washington | | 9-20-49 |
| | | | | | 13+46.0 | 13+44.0 | | | | | | |
| 13 | 118.28 | 115.36 | 2.92 | | 13+22.0 | 13+20.0 | | | | | | |
| | | | | 12+92.2 | 12+98.0 | 12+96.0 | #1544 | | 1718 N Masley | | | 7-3-24 |
| | | | | | 12+75.0 | 12+73.0 | | | | | | |
| | | | | | 12+57.3 | 12+49.3 | | | | | | |
| | | | | | 12+27.0 | 12+25.0 | #1729 | | 1716 N Masley | | | 9-11-44 |
| 12 | 118.34 | 115.11 | 3.32 | | 12+02.8 | 12+00.8 | #4909 | | 1716 N Masley | | | 4-20-53 |
| | | | | | 11+78.7 | 11+76.7 | | | | | | |
| | | | | | 11+54.5 | 11+52.5 | | | | | | |
| | | | | | 11+28.5 | 11+26.5 | #2077 | | 1706 N Masley | | | 9-12-24 |
| 11 | 118.23 | 114.86 | 3.37 | | 11+05.0 | 11+03.0 | #1573 | | 1706 Masley | | | 7-3-24 |
| | | | | | 10+81.5 | 10+79.5 | #4425 | | 1702 N Masley | | | 3-12-53 |
| | | | | | 10+57.2 | 10+55.2 | #1359 | | 1700 N Masley | | | 12-29-25 |
| 10 | 117.79 | 114.61 | 3.18 | | 10+33.0 | 10+31.0 | | | | | | |
| 9 | | | | 9+92.0 | | | | | | | | |

988770-7 5/28/98 1730 N Masley - Hennings
 C 28732 - 1718 N Masley - Sealoff 10-26-71
 #1855 - Top at 16+15.0 - 925 E. 17th - Johnson Oil Co. - 12-19-44 - W.B. Carter
 #4086 - Setting Conb wye 2-9-53 - C.G. Coleman - 1702 N. Masley.
 #17346 - 1733 N Washington - Dr. Luffin - 7-3-63 - Cap (14+33.2)