


# INDIANA LATERAL S.S. No. 2-1900- DIST. Y- S.S. No. 20-1920.

Plat 9-51

TRAP AREA

See  
Plan  
H  
17-23

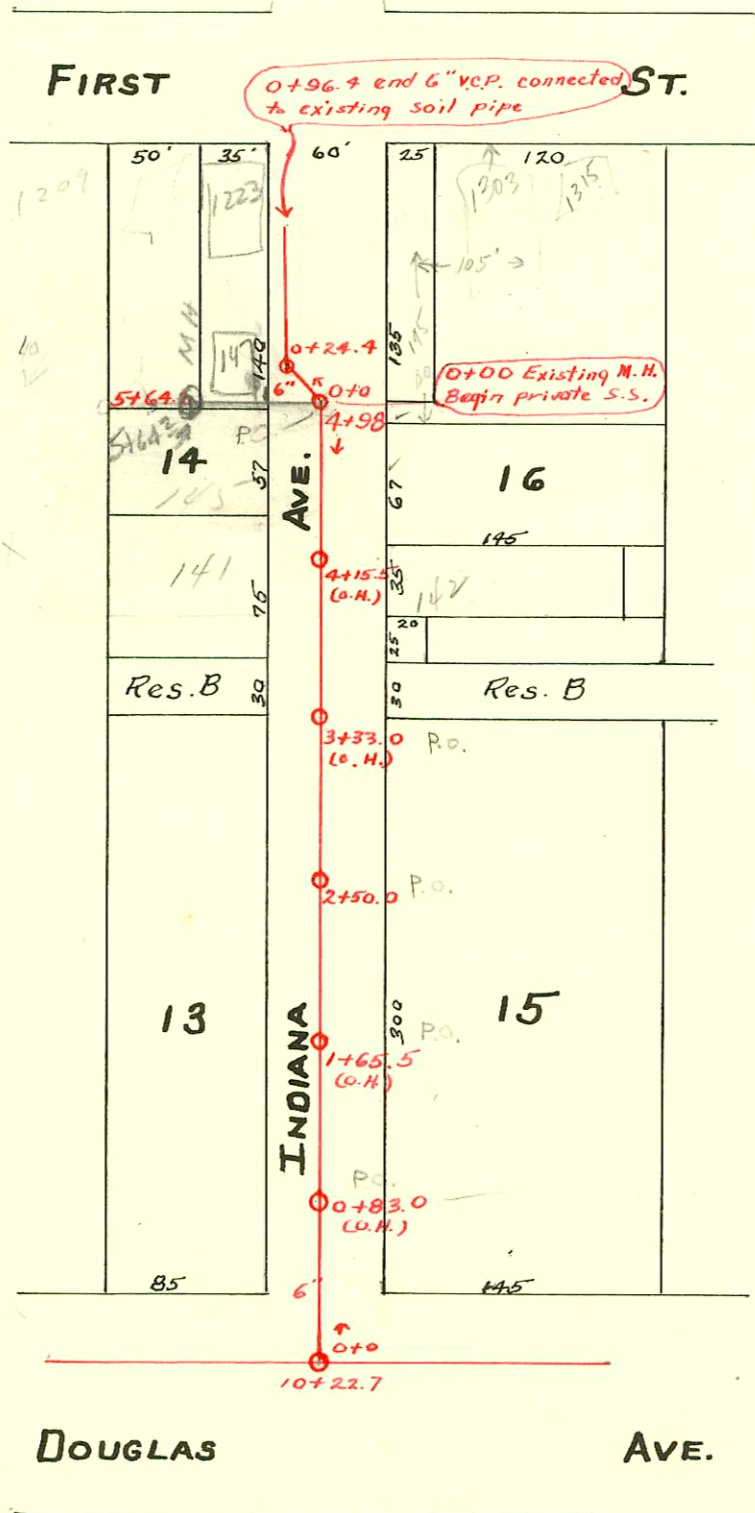

P.O. Paused Over

CONSTRUCTION RECORD

SERVICE RECORD

STATION	ELEVATION		Depth	MANHOLE	4-INCH "Y" BRANCHES		No. of Permit		House Number		DATE OF PERMITS		
	Ground	Grade			EAST	WEST	North West	South East	North West	South East	North West	South East	
PRIVATE SANITARY SEWER BK. JT. 66, July 20, 1953													
0			3.0	0+00									
			3.0	0+24.4									
0+96.4	End 6" VCP		3.0										
				5+64.2									
	108.65	105.16	3.49		5+58.0N		#845		1218			11-17-17	
5					5+44.0S				147 house			8-6-2	
	108.33	104.92	3.41		5+22.0N		#248		Indiana 515			5-7-13	
				4+98.0									
					EAST	WEST							
					4+90.0		#385		1301 C. list			12-13-04	
					4+72.5		#679		Record			9-12-17	
					4+70.5								
					4+49.0								
									145 Indiana			5-26-14	
							#326		141 Indiana			7-2-65	
							Sept. 13 3732 (mid) 3350					7-31-65	
4	107.80	104.52	3.28		4+22.0								
					3+97.5	3+95.5	#502	#613	140 Indiana	135 Indiana			8-24-14
					3+72.0	3+70.0	#931		138 Indiana				8-23-17
					3+47.5	3+45.5							10-4-21
3	107.81	104.12	3.68		3+21.5	3+19.5	#793	#188	135 Indiana				10-30-17
					2+96.5	2+94.5		#877	126 Indiana				4-14-09
					2+70.5	2+68.5							7-17-29
				2+50.0									
					2+47.0								
					2+22.5								
2	107.99	103.72	4.27					#361	121 Indiana				9-9-06
					1+96.5	1+94.5							
					1+70.0	1+68.0							
					1+43.5	1+41.5							
1	107.70	103.32	4.38		1+19.0	1+17.0							
					0+93.0	0+91.0							
					0+67.0	0+65.0	#281		1502 E Douglas				11-27-08
0	106.94	102.92	4.02		0+40.0	0+38.0							

#417 Tap at 4+98 - 5-11-21 (52 Indiana)  
 #1411 - Seal off - 1303 E. 1st at Henning - 3-28-61 (Private Line Conn)  
 B960 - Seal off - 142 Indiana - at Henning 3-3-64  
 #24474 - Seal off - 1313-15 E. 1st - at Henning 8-16-67 (Private Line Conn)