


S.S. No. 8 - 1908

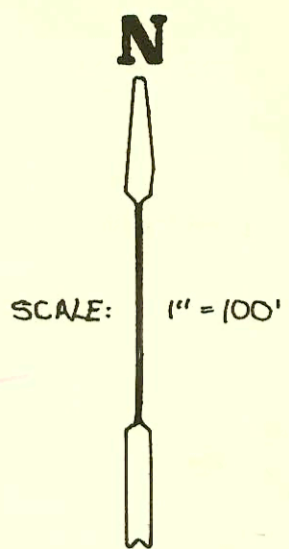

TRAP AREA


1995 SANITARY SEWER REHABILITATION PROGRAM - PHASE III
 PROJ. NO. N/A (621078)
 BUILT BY INSITUFORM PLAINS, INC.
 BOOKED 9-25-95 FROM AS BUILTS

RECONNECTIONS

STA.	ADDRESS	DIRECTION
10+25.5	116 S. Handley	West
9+90.8	810 W. Texas	East
9+73.5	818 W. Texas	West
9+58.6	118, 122 & 122 1/2 S. Handley	West
8+40.1	811 W. Texas	East
8+04.8	203 S. Osage	East
7+53.7	207 S. Osage	East
6+96.5	215 S. Osage	East
6+74	211 S. Osage	East
6+71.2	220 S. Handley	West
5+44.4	302 S. Handley	West
4+95.5	303 S. Osage	East
4+70.4	817 W. Burton	West
4+41.8	819 W. Burton	West
4+24.8	309 S. Osage	East
3+83.5	817 1/2 W. Burton	West
3+74	311 S. Osage	East
3+60.8	316 S. Handley	West
3+35.9	318 S. Handley	West
3+14	315 S. Osage	East
2+67.1	320 S. Handley	West
2+64.6	321 S. Osage	East
2+35.5	334 S. Handley	West

RECONNECTIONS

STA.	ADDRESS	DIRECTION
1+50	812 W. Maple	SOUTH
1+04.9	822 W. Maple	SOUTH
0+57.3	830 W. Maple	SOUTH
1+09.7	800 W. Maple	SOUTH
0+12.3	808 W. Maple	SOUTH
4+52.7	123 S. Osage	South
4+40.4	801 W. Douglas	North
3+75.2	811 & 813 W. Douglas	North
2+83.3	825 W. Douglas	North
2+69.5	112 & 114 S. Handley	South

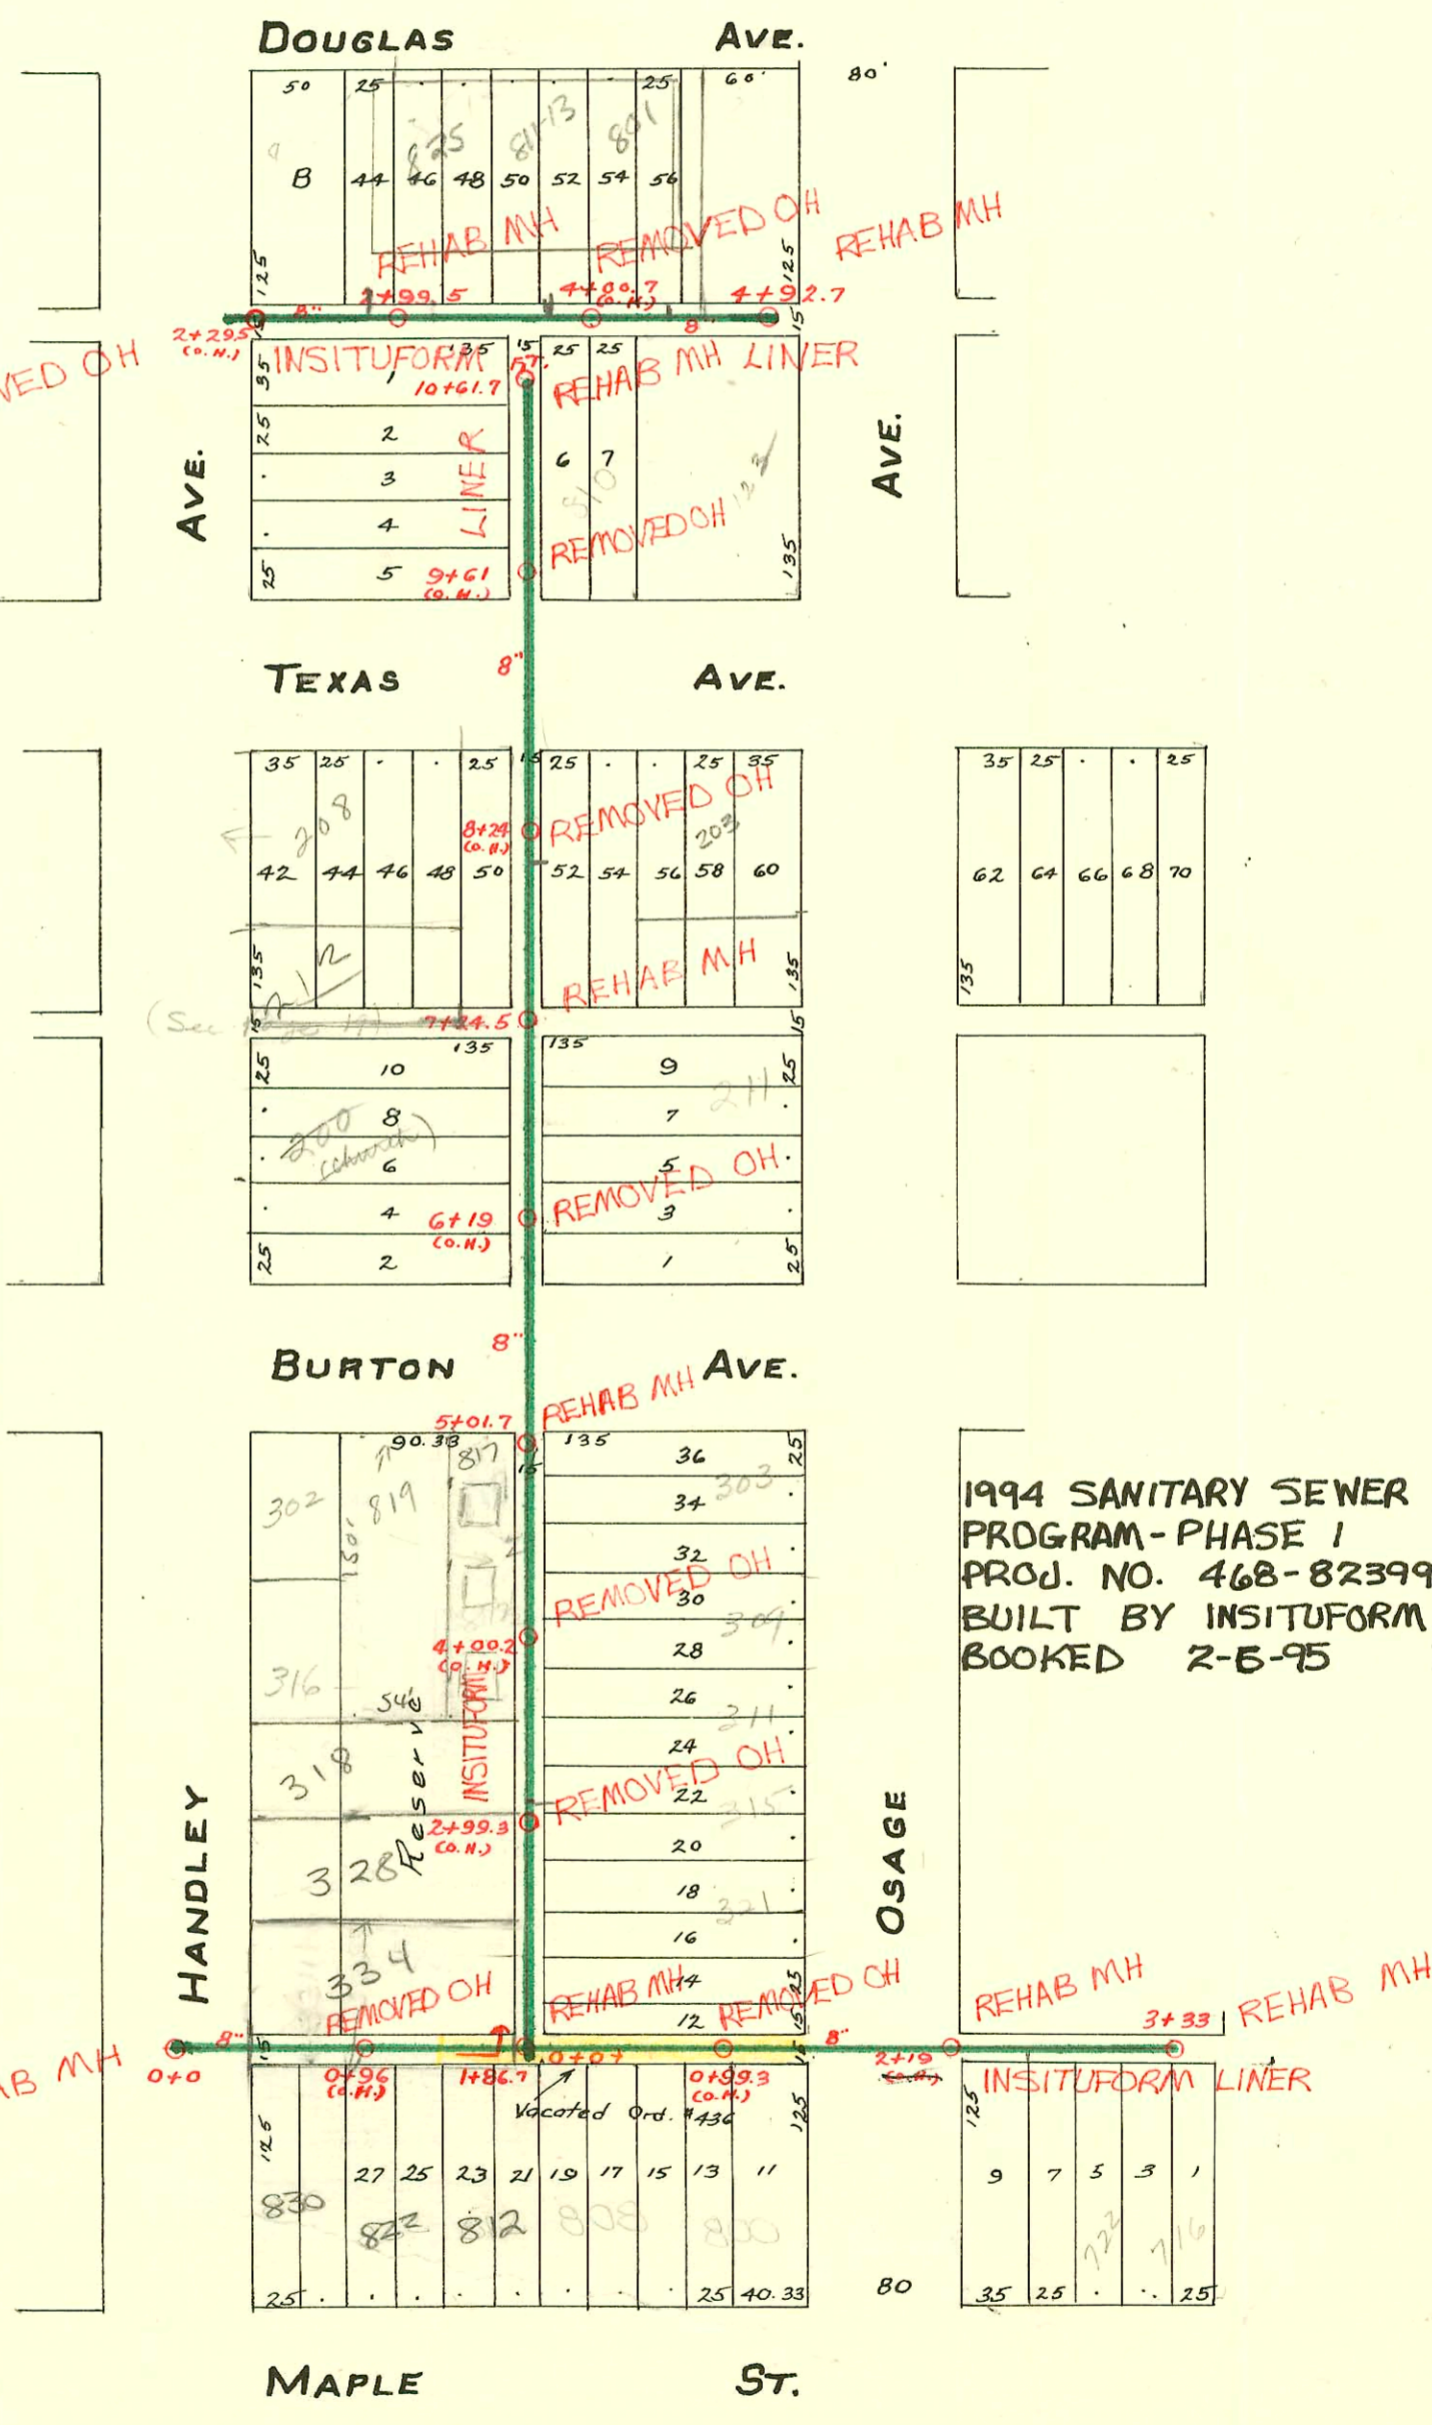

1994 SANITARY SEWER REHABILITATION PROGRAM - PHASE I
 PROJ. NO. 468-82399 (623124)
 BUILT BY INSITUFORM PLAINS INC.
 BOOKED 2-6-95 FROM AS BUILTS

1993 SANITARY SEWER REHABILITATION PROGRAM - PHASE I
 PROJ. NO. 468-82343 (632000)
 BUILT BY INSITUFORM PLAINS, INC.
 BOOKED 5-12-94 FROM AS BUILTS

2 Fernco, trap, twin co, 4" x 4" PVC, Replaced to 6' from main - Wichita Exc

CONSTRUCTION RECORD

SERVICE RECORD

Sub Lot. 5 of 49

Sub Lot. 1 of 47

STATION	ELEVATION		Depth	MANHOLE	4-INCH "Y" BRANCHES		No. of Permit		House Number		DATE OF PERMITS	
	Ground	Grade			North West	South East	North West	South East	North West	South East	North West	South East
				4+92.7	4+87	4+84.5	#42		803 W. Douglas			7-8-09
					4+62	4+59.5	#209	#316	127 S. Osage			8-14-23
					4+37	4+27	#795	#797	809 W. Douglas	308 Osage		9-28-11
4	112.69	108.19	4.5									
					3+95.5		#3096		809 W. Douglas			2-5-41
					3+70		#122		813 S. Douglas			3-11-10
					3+45							
3	112.56	107.99	4.57		3+21.5		#196		815 W. Douglas			10-31-17
				2+99.5	2+94.5		#1997		821 23 W. Douglas			11-26-09
					2+80.5		#742					
					2+73.5				125 W. Douglas			6-21-85
2	111.56	107.79	3.77		2+27		#1908		825-27 W. Douglas			7-1-70
							#244					5-3-09
				3+33		3+28						
3	112.37	107.50	4.87			3+07						6-13-77
						2+80						
						2+84						12-22-86
						2+58.5						11-20-13
						2+30.5						
2	112.93	107.00	5.93									
1	112.67	106.50	6.17			20-Sch 40 WC						6-10-92
						1+07.5			800 W. Maple			2-11-10
					0+94		#654					11-21-18
					0+72	0+54.5	#777					12-28-09
0	112.29	106.00	6.29	0+0		0+08						
				10+61.7 FT.	10+51							
					10+23	10+30.5						9-4-79
10	113.03	107.96	5.07		10+05				810 S. Texas			8-31-20
					9+79.5	9+86.75						
					9+57							12-15-86
9	111.29	107.66	3.63				#1123					8-4-19
8	109.58	107.36	2.22			8+50.5						
						8+22						
					7+99	7+96.5	#608	#45	817 S. Texas	203 S. Osage		8-11-71
					7+70	7+67.5						2-23-09
7	109.30	107.09	2.21	7+24.5	7+46.5	7+44	#1132	#542				9-30-13
					7+15	7+12.5						11-17-21
					6+97	6+94.5						
					6+73.5	6+71	#1341	#299				8-12-18
					6+48							9-10-23
						6+27.5						3-28-72
6	112.10	106.89	5.21			6+04	#977		221 S. Osage			7-3-23
					5+96.5		#374		222 S. Handley			6-18-09
5	112.24	106.69	5.55	5+01.7								
						4+94						8-31-22
						4+71						
					4+47.5	4+45	#842		817 Burton			10-6-27
					4+43		#126		819 Burton			2-24-20
						4+22						7-30-17
4	112.34	106.49	5.85			4+03						
					3+69.7	3+70	#305					10-20-19
					3+36	3+33.5	#882					11-17-11
3	112.27	106.29	5.98		3+09.5		#38					1-20-94
					2+85							2-13-09
					2+60.5	2+58	#220	#664				7-26-11
					2+26	2+31	#394					11-21-19
2	112.36	106.09	6.27			2+04	#727					8-22-11
				1+86.7		1+78						
						1+73.5						
						1+71						
						1+50						1-15-13
					1+32	1+29.5						
1	112.51	105.89	6.62			1+04.5	#20					5-6-12
					0+81	0+78.5						
						0+55	#438					5-13-11
0	111.77	105.69	6.08	0+0	0+32	0+29.5						

S.O. 22263 - 208 S Handley - 12-21-88 - Al Henry (8+00.5 top 6 clay) - 95-8367-7 6-15-95 501 W Douglas - REP

S.P. C61178 - 325 S Osage - 8-17-77 (0192.2)

S.P. C58693 - 223 S Osage - 11-16-76 6+06.6

S.P. C39275 - 220 S Handley - 5/30/73 - Col Kennedy (6+67.5) Church

Tap 342 - 4-27-21 316 S Handley

#420 - N.W. Cor. Osage & Maple - 10-14-36 - Brodie P/bq. - Used old Connection. C 72779 - 123 S Osage - 7-5-79 (448.7)

#457 - 112 S Handley - 7-25-46 - Dermody P/bq. - Tap

#6042 - 810 Texas - Private line conn. - 10-8-51 - Roy McCoy - Trailer #1

#6063 - 810 Texas - Top - 10-8-51 - Roy McCoy - Trailer #2

#7074 - Tap - 818 Texas - 1-16-52 - Joe McDonald 9-4-79

#2249 - Con 8 Wye - 810 Texas - Lee Layton - 10-11-54

#2250 - Trailer - 810 Texas - 10-11-54 - Lee Layton.

#5949 - Seal off - 315 S Osage - Al Henning - 6-2-66

#66964 - Seal off - 323 S Osage - Al Henning - 6-15-79

#26670 - 12-5-90 - 212 S Handley (slat wye 55' E of MH.)

#19699 - 4-5-91 - 801 W. Douglas - (slat 42' west of MH. of Alley)