



S.S. No. 8-1908

1993 SANITARY SEWER REHABILITATION PROGRAM - PHASE I  
 PROJ. NO. 468-82348 (632000)  
 BUILT BY INSITUFORM PLAINS, INC.  
 BOOKED 5-11-94 FROM AS BUILTS

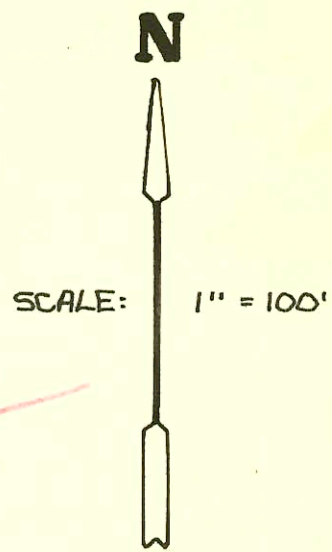

TRAP AREA

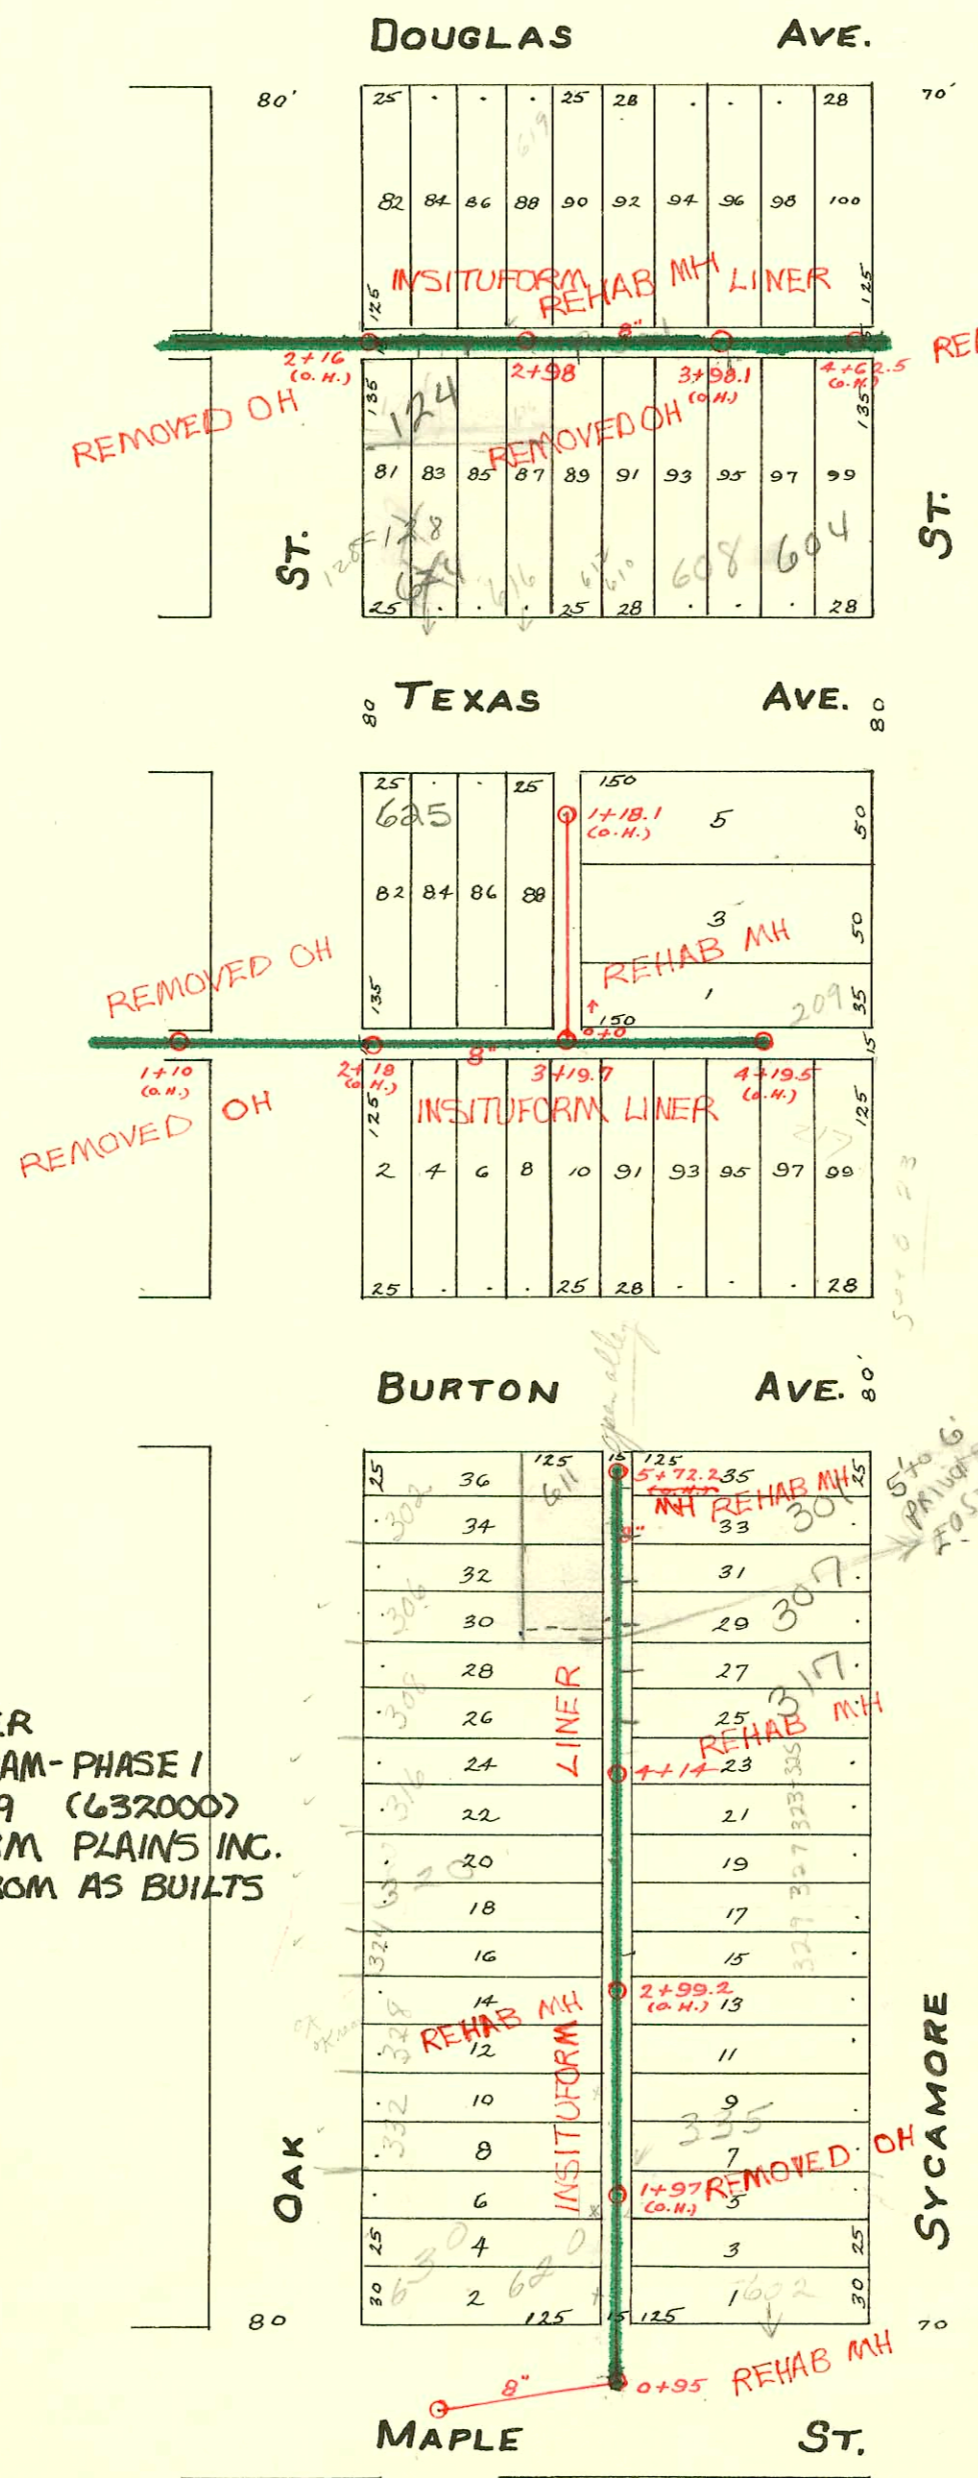

RECONNECTIONS

STATION	ADDRESS	DIRECTION
2+23.3	623 W. Douglas	North
2+43.8	124 & 128 S. Oak / 624 W. Texas	South
2+46.3	621 W. Douglas	North
2+71.7	619 W. Douglas	North
3+20.8	615 & 615 1/2 W. Douglas	North
3+24.5	610 & 612 W. Texas	South
3+46.3	609, 611 & 613 (A & B) W. Douglas	North
4+04.6	608 W. Texas	South
4+21.7	607 W. Douglas	North
4+44.6	601 & 605 W. Douglas	North
5+69	611 W. Burton	West
5+46	301 S. Sycamore	East
5+18	302 S. Oak	West
4+98	306 S. Oak	West
4+76	315 S. Sycamore	East
4+52	308 S. Oak	West
4+30	316 S. Oak	West
4+27	323 S. Sycamore	East
4+00	316 1/2 S. Oak	West
3+98	327 S. Sycamore	East
3+38	324 S. Oak	West
3+23	329 S. Sycamore	East
3+00	328 S. Oak	West
2+73	330 S. Oak	West
2+70	333 S. Sycamore	East
2+50	332 S. Oak	West
2+22	602 W. Maple	East
1+99	620 W. Maple	West
1+89	602 W. Maple	East
4+16	209 S. Sycamore	North
4+13.5	217 S. Sycamore	South
3+78.2	217 S. Sycamore	South
3+67.2	606 W. Burton, 217 S. Sycamore	South
3+34.1	608 W. Burton	South
2+72.6	619 W. Texas, Apts. 1, 2, 3, & 4	North
2+63.4	625 W. Texas	North

1994 SANITARY SEWER REHABILITATION PROGRAM - PHASE I  
 PROJ. NO. 468-82399 (632000)  
 BUILT BY INSITUFORM PLAINS INC.  
 BOOKED 2-7-95 FROM AS BUILTS

95-5098-7 4-12-95 (28 S Oak and 624 W Texas (Duplex) - 510 56' W of 6 MH and 54' from main  
 Note: 124 S. Oak at rear of 2st West to alley  
 stays connected at 2+43.8

CONSTRUCTION RECORD						SERVICE RECORD							
STATION	ELEVATION		Depth	MANHOLE	4-INCH "Y" BRANCHES		No. of Permit		House Number		DATE OF PERMITS		
	Ground	Grade			North West	South East	North West	South East	North West	South East	North West	South East	
4	112.34	107.85	4.69	4+62.5(O.H.) SEE RECONNECT ON NEXT PAGE	4+71	4+68.5							
					4+45	4+42.5	#1401	1865			10-23-22	1-21-92	
					4+21.5	4+19.5	#1402	492			10-23-22	5-31-11	
						4+07.5		215				5-17-68	
						3+95						4-19-17	
3	112.71	107.75	4.96	2+98	3+70.5	3+68							
					3+45	3+42.5	#644	613 W. Douglas			6-15-24		
					3+19.7	3+17.2	#206	511			4-29-15	10-21-15	
					2+70.5	2+68	#198	619 W. Douglas			8-22-11	1-29-24	
					2+44.5	2+42	#24	313			3-27-23	5-31-10	
2	111.44	107.65	3.79	2+16(O.H.)	2+21.5	2+19	#726				1-31-19		
1	112.31	107.65	4.66	1+18.1(O.H.)		1+16		#97				3-5-13	
						0+91		#750			613 TEXAS		10-5-46
						0+65		#77			207 -		2-15-10
						0+40							
						0+14.5							
7	112.38	107.45	4.93	4+19.5(O.H.)		4+15.5		#1620		211 S. Sycamore		7-29-54	
						4+00.7		#748		614 Sycamore		4-9-24	
						3+81		#3848		211 S. Sycamore		7-7-67	
						3+45				604 W. BURTON		3-27-81	
						3+19.7		#02965					
2	111.35	107.05	4.30	2+97	2+99.5	2+99.5		#733				6-26-22	
					2+71.5	2+74	#1656	#1287			11-10-23	10-14-19	
					2+46	2+54							
1	112.05	106.85	5.20	1+10(O.H.)	2+23	2+20.5		#368		626 BURTON	6-16-09		
5	112.48	107.74	4.74	5+72.2(O.H.)		5+65.5		#175		611 BURTON		4-9-09	
						5+45.5	5+43	#897		303 S. Sycamore		9-24-30	
						5+19.5	5+17	#1781	#113	306 S. OAK		3-16-48	3-3-14
						4+97.2	4+94.5	#323	#584	302 S. OAK		6-2-10	6-10-30
						4+73.5	4+71		#540	321 S. Sycamore		5-28-30	
4	112.72	107.34	5.38	4+14		4+46.5		#787	#605	316 S. OAK		8-30-21	
						4+22	4+19.5	#372	#67	325 OAK		1-30-09	3-1-09
						4+00.5		#922		316 S. OAK		10-31-11	
						3+98							
						3+72.5	3+70	#92	#12			2-26-17	1-11-11
3	112.48	107.04	5.44	3+23		3+43		#664				7-29-21	
						3+20.5		#68		328 S. OAK		3-1-09	
						2+95.5	2+93	#126		328 S. OAK		8-6-32	
						2+69.5	2+67	#259	#490	328 S. OAK (REAR)		2-27-53	8-5-09
						2+46.5	2+44	#282				4-10-11	
2	112.18	106.74	5.44	2+20.5		2+18		#802		335 S. Sycamore		7-10-22	
						1+92.5	1+92.5	#255	#477	334 S. OAK		9-17-78	5-21-11
						1+69.5	1+67	#482		330-30 W. MAPLE		8-26-71	9-28-31
1	110.52	106.44	4.08	1+41.5	1+39		#589		338 S. OAK		11-2-10		
0	110.82	106.14	4.68	0+95									

2000-02729-12/18/00-625 W Texas - BTL Exc-4" SCH 40 - EXIST TAP repaired by city 59.5 W of MH 3+71.7(2+60.2) Wye was never used - 4" Trap Installed, Replaced Lower 14' of sewer

98-15326-7 811498 604 W TEXAS - David Lefler Olby - NYC -

92-820-7 1-21-92 604 W TEXAS Henning - 5' 4" clay 56.5' w. of a MH 2' off main

97-713-7 1-17-97 301 S. Sycamore AR4 601 W BURTON - Henning -  
 97-714-7 1-17-97 307 S. Sycamore AR4 303-305-309 - Henning -  
 97-715-7 1-17-97 317 S. Sycamore AR4 311-313-315 - Henning -

045934-608 7-29-74 -  
 #16168 Deal off 124 S. Oak - Henning - 10-6-69 (Conn with 604 main) No Measure

#4851 - Setting wye - 606 Burton - 4-15-53 - Davidson Pkg. Co.  
 #1853 - 616 1/2 Texas - Callison Pkg. - 12-15-44  
 #1442 - 612 Texas - P.C. Fish Pkg. - Private line - 2-15-47  
 #1441 - Tap - 610 Texas (Rear) - 2-14-47 - Brodie Pkg. Co.  
 #1453 608 Wye 608 W. Burton - Deal 11-5-51 31317  
 #17178 - Deal off - 608 Maple - 5-27-63 at Henning 5-27-63  
 #17441 - 602 Maple - 9-15-63 - Basin Hutching - Tap (1+83)  
 #92-7328-7 614 W Texas 5-21-92 Alvin Henning 4" clay 41' from main E 15' east of RPL  
 #94-17654-7 - 316 S. Oak - 10-31-94 - 6" SCH 35 - 6" Wye repaired - 9' north - replaced lower 10' of line - 6" Tap installed shallow.  
 #94-17653-7 - 316 S. Oak - 10-31-94 - 4" RVC 40 - old Mans Whang - 4" Wye Repair - 15' S. of MH. 14' PE shallow - Replaced entire line 4" Trap Installed.  
 92-17775-7 81492 320 S. Oak - TIM LUDWIGS 3+72.5 6" clay  
 91-21213-7 4-26-91 303 S. Oak - (Wye 455' W. of MH 4 1/2' S)  
 93-238-7 1-6-93 302 S. Oak - Bunting - permit expired No Insp Record