


LAT. Q - S.S. No. 22
 W.B. CARTER - 1952
 PROJ. No. C21-85
 BK. JT. 64
 3-12-52

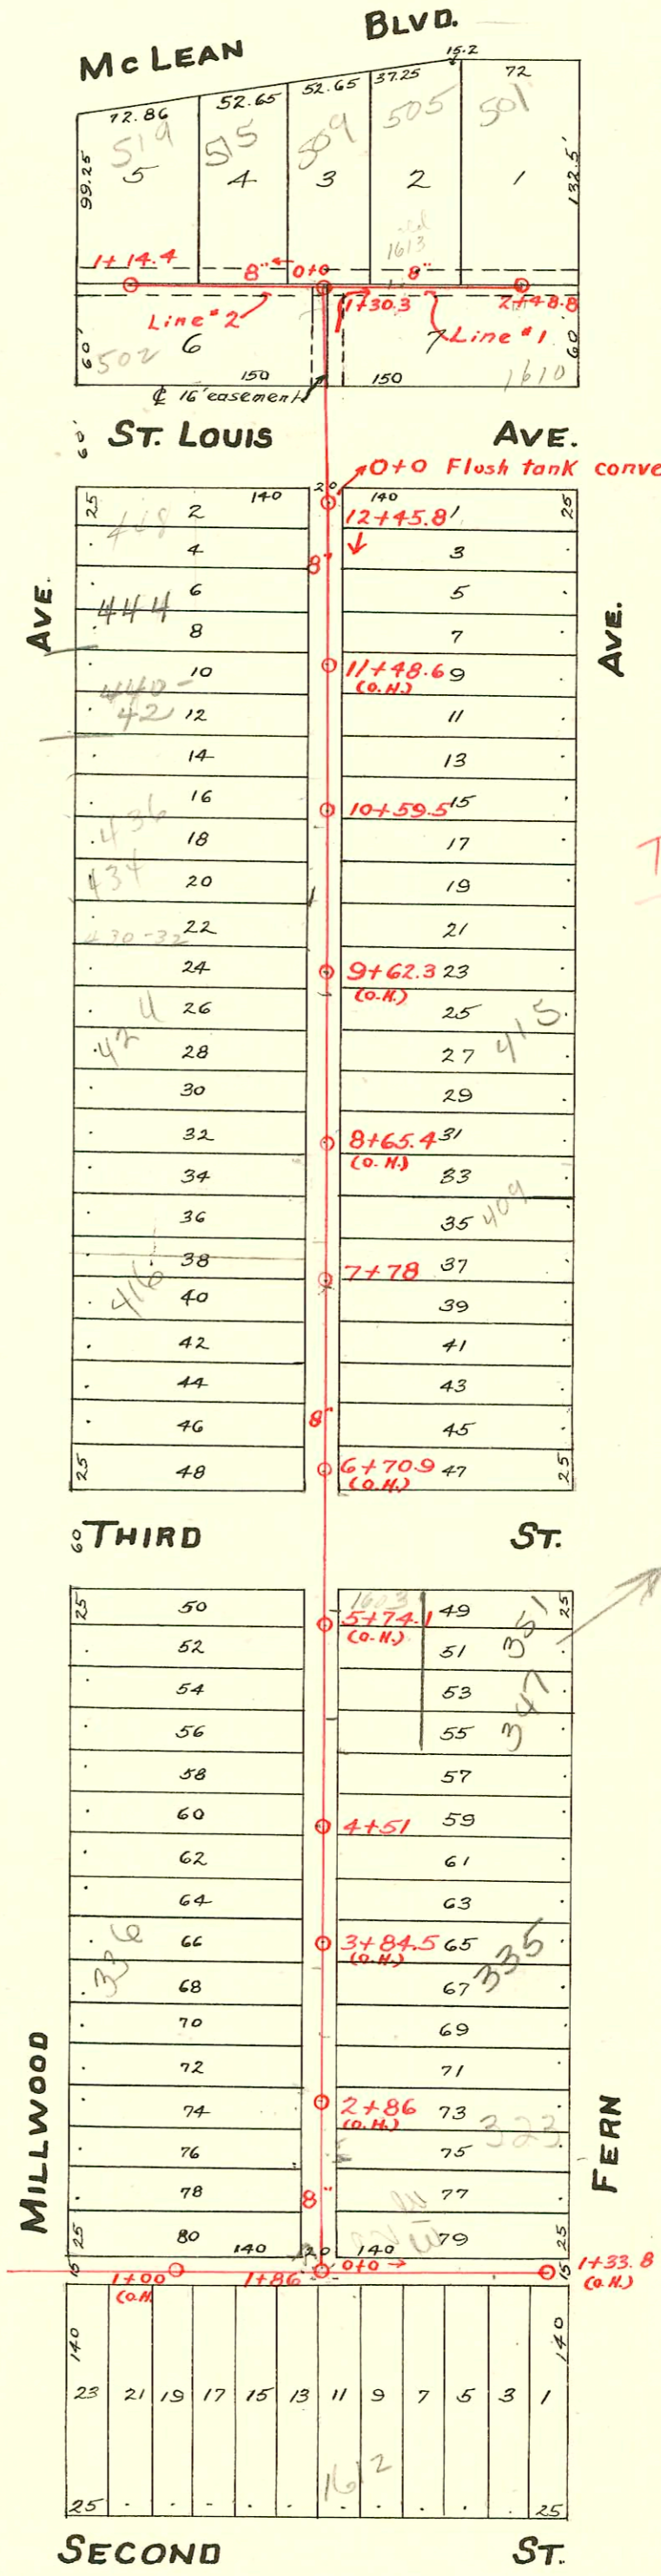

TRAP AREA

No record of
 any easement
 app. to Fern
 9/10/03
 BK

S.S. No. 8-1908

2002-00549 - 335 N Fern - 2/28/02 Dutchmans
 1-4X2 bush, 1-2" Fernco @ house, TWIN CO,
 Fernco to clay
 d/o Saw 2005-03216 - 305 N Fern - 4' clo at mill (1) 2/21
 Ruto Roster 12-28-05

CONSTRUCTION RECORD

SERVICE RECORD

Line #1
#8
-5.5

Line #2

| STATION | ELEVATION | | Depth | MANHOLE | 4-INCH "Y" BRANCHES | | No. of Permit | | House Number | | DATE OF PERMITS | | |
|---------|--------------------|-------------------------|------------|--|----------------------|------------|---------------|------------|---------------------------|--------------------|------------------------|------------|---------|
| | Ground | Grade | | | North West | South East | North West | South East | North West | South East | North West | South East | |
| 0+0 | 115.9 | 111.37 | 4.5 | 0+0 | | | | | | | | | |
| 1+0 | 115.6 | 111.47 | 4.1 | | | | | | | | | | |
| 1+30.3 | 115.0 | 111.51 in 111.61 out | 3.5 3.4 | 1+30.3 | 1+44.0 | | #840 | | 509 167754-9 McLean | | 4-8-52 | | |
| | | | | | 1+76.8 | | #839 | | 167850-7 McLean | | 1-3-95 4-8-52 | | |
| 2+0 | 114.2 | 111.67 | 2.5 | | 2+19.6 | | #1061 | | 509 1607510 McLean | | 1-20-45 4-30-52 | | |
| 2+48.8 | 114.7 | 111.72 | 3.0 | 2+48.8 | | | | | | | | | |
| 0+0 | 114.4 | 111.61 | 2.8 | 0+0 in Line #1 | 0+34.0 | | #1257 | | 1627515-30 McLean | | 12-21-95 5-14-52 | | |
| | | | | | 0+30.7 | | | | | | | | |
| | | | | | 510 at wye 0+91.9 | 0+46.1 | #838 | | 502 N Millwood | | 4-8-52 | | |
| 1+00 | 114.6 | 111.71 | 2.9 | | | | #1254 | | 1627519-50 McLean | | 2-17-95 5-13-52 | | |
| 1+14.4 | 114.5 | 111.72 | 2.8 | 1+14.4 | | | | | | | | | |
| | | | | 1+33.8 (C.M.) | | | | | | | | | |
| 1 | | | | | 1+01.5 | | #916 | | | | | 4-23-24 | |
| | | | | | 0+76 | | | | | | | | |
| | | | | | 0+51 | | #1530 | | 1606 W. 2nd | | | 2-26-47 | |
| 0 | Cent. of M.H. 1+86 | | | | 0+26 | | #644 | | | | | 6-9-22 | |
| | | | | 12+45.8 | | | | | | | | | |
| | | | | | 12+40.4 | 12+37.9 | #1212 | #6534 | 448 Millwood | 459 N. Fern | 5-29-68 5-26-24 | 9-23-53 | |
| | | | | | 12+27.8 | 12+25.3 | | | | | 3-24-69 | | |
| 12 | 114.6 | 111.07 | 3.6 | | 12+05 | 12+02.5 | | | | | | | |
| | | | | | 11+79.2 | 11+76.7 | #1213 | #1702 | 440 Millwood | 445 N. Fern | 5-26-24 | 7-23-24 | |
| | | | | | 11+53.9 | 11+51.4 | #41078 | | 440 N. Millwood | | 9-5-73 | | |
| | | | | | 11+28.3 | 11+25.8 | #1103 | | | 443 N. Fern | 8-19-29 | | |
| 11 | 114.0 | 110.87 | 3.2 | | 11+03.2 | 11+00.7 | | #4902 | | | | 6-7-51 | |
| | | | | | 10+77.8 | 10+75.3 | | | | | | | |
| | | | | | 10+59.5 | 10+54.5 | 10+52 | #3189 | 434-36 N. Millwood | | 3-31-65 | | |
| | | | | | | 10+20.5 | | #3303 | 437 N. Fern | | | 12-8-50 | |
| 10 | 113.8 | 110.67 | 3.2 | | 10+03.5 | 10+01 | | | | | | | |
| | | | | | 9+77.9 | 9+74.5 | #3624 | | 432-32 N. Millwood | 415 N. Fern | 5-18-65 | | |
| | | | | | 9+52.5 | 9+50 | #1217 | #703 | 424 N. Millwood | 415 N. Fern | 4-3-75 6-30-95 | 7-23-24 | |
| | | | | | 9+25.5 | 9+23 | | | | | | | |
| 9 | 113.7 | 110.47 | 3.3 | | 9+01.3 | | | #483 | 422 N. Millwood | | 6-10-26 | | |
| | | | | | | 8+98.8 | | #773 | | | | 4-10-24 | |
| | | | | | 8+76 | 8+73.5 | | #321 | | | | 2-28-24 | |
| | | | | | 8+50.5 | 8+48 | #593 | | 420 N. Millwood | | 6-1-25 | | |
| 8 | 113.4 | 110.27 | 3.2 | | 8+25.0 | 8+22.5 | | | 418 N. Millwood | 407 N. Fern | 9-17-52 | 8-5-85 | |
| | | | | | 7+99.5 | 7+97 | #2572 | | | | | | |
| | | | | | 7+78 | 7+72.0 | 7+69.5 | #824 | #169 | 418 N. Millwood | 407 N. Fern | 9-28-26 | 5-27-46 |
| | | | | | 7+47 | 7+44.5 | | | | | | | |
| 7 | 113.4 | 110.07 | 3.4 | | 7+19.5 | 7+17 | #102 | #1051 | 408 N. Millwood | 403 N. Fern | 12-9-42 | 9-28-25 | |
| | | | | | 6+94 | 6+91.5 | | | | | | | |
| | | | | | 6+68.5 | 6+66 | #48 | | 402 N. Millwood | | 11-23-42 | | |
| | | | | | 6+44.5 | 6+42 | | | | | | | |
| 6 | 113.20 | 109.87 | 3.4 | | 6+19.5 | 6+17 | | | | | | | |
| | | | | | 5+84.5 | 5+82 | | #764 | | 1603 W. 3rd | | 6-21-43 | |
| | | | | | 5+59.0 | 5+56.5 | | | | | | | |
| | | | | | 5+33.5 | 5+31 | #662 | | | | 8-30-20 | | |
| 5 | 113.4 | 109.67 | 3.8 | | 5+02.8 | 5+00.3 | #1298 | | | | 6-4-24 | | |
| | | | | | 4+80.1 | 4+77.6 | | #259 | | 345 N. Fern | | 5-3-10 | |
| | | | | | 4+51 | 4+59.8 | 4+57.3 | | | | | | |
| | | | | | 4+33.2 | 4+30.7 | #655 | | | | 4-2-24 | | |
| 4 | 113.2 | 109.47 | 3.8 | | 4+04.9 | 4+02.4 | | #1292 | | | | | |
| | | | | | 3+82.3 | 3+79.8 | | #2411 | 00549 335 N. Fern | | see next pg 7-28-02 | 6-4-24 | |
| | | | | | 3+66.9 | 3+64.4 | #849 | | 336 N. Millwood | | 1-10-00 9-12-30 | 6-12-40 | |
| | | | | | 3+31.5 | 3+29 | | | | | | | |
| 3 | 113.3 | 109.27 | 4.1 | | 3+06.3 | 3+03.8 | | #369 | 333 N. Fern | | | 3-4-24 | |
| | | | | | 2+83.5 | 2+81 | #1719 | | 326 N. Millwood | | 7-25-24 | | |
| | | | | | 2+58.2 | 2+55.7 | #308 | | 320 N. Millwood | 323 N. Fern | 2-25-24 | 2-24-00 | |
| | | | | | 2+32.7 | 2+30.2 | #148 | | 312 N. Millwood | 313 N. Fern | 2-9-24 | 2-24-00 | |
| 2 | 113.4 | 109.07 | 4.4 | | 2+07.5 | 2+04.9 | | #659 | | | | 4-2-24 | |
| | | | | | 1+86 | | | #1747 | | | | 12-26-22 | |
| | | | | | | 1+66.5 | | | | | | | |
| 1 | 112.9 | 108.87 | 4.1 | | 1+38.6 | | | #645 | | | | 6-9-22 | |
| | | | | | 1+15.8 | | | #141 | | | | 2-8-24 | |
| | | | | | 0+88 | | | #84 | 1640 anderson | | | 2-28-10 | |
| | | | | | 0+68 | | | | | | | | |
| | | | | | 0+42.7 | | | | | | | | |
| 0 | 112.9 | 108.67 | 4.3 | 0+0 - Center of M.H. 13+62.1 on Lat. 35. | | | | | | | | | |

#3228 - Tap - 351 N. Fern - 11-14-52 - Jack Durham. 95-12-7 1-26-95 509 N McLean BL - 510' w of MH and 3' off main

5245-2 V - 1610 St. Louis - 9-5-57 - Geo. Justice

C13398 - 347 N. Fern (Repair Permit) 3-28-69 (5+15.6)