


# MAIN 1 S.S. No. 8-1908

*TRAP AREA*

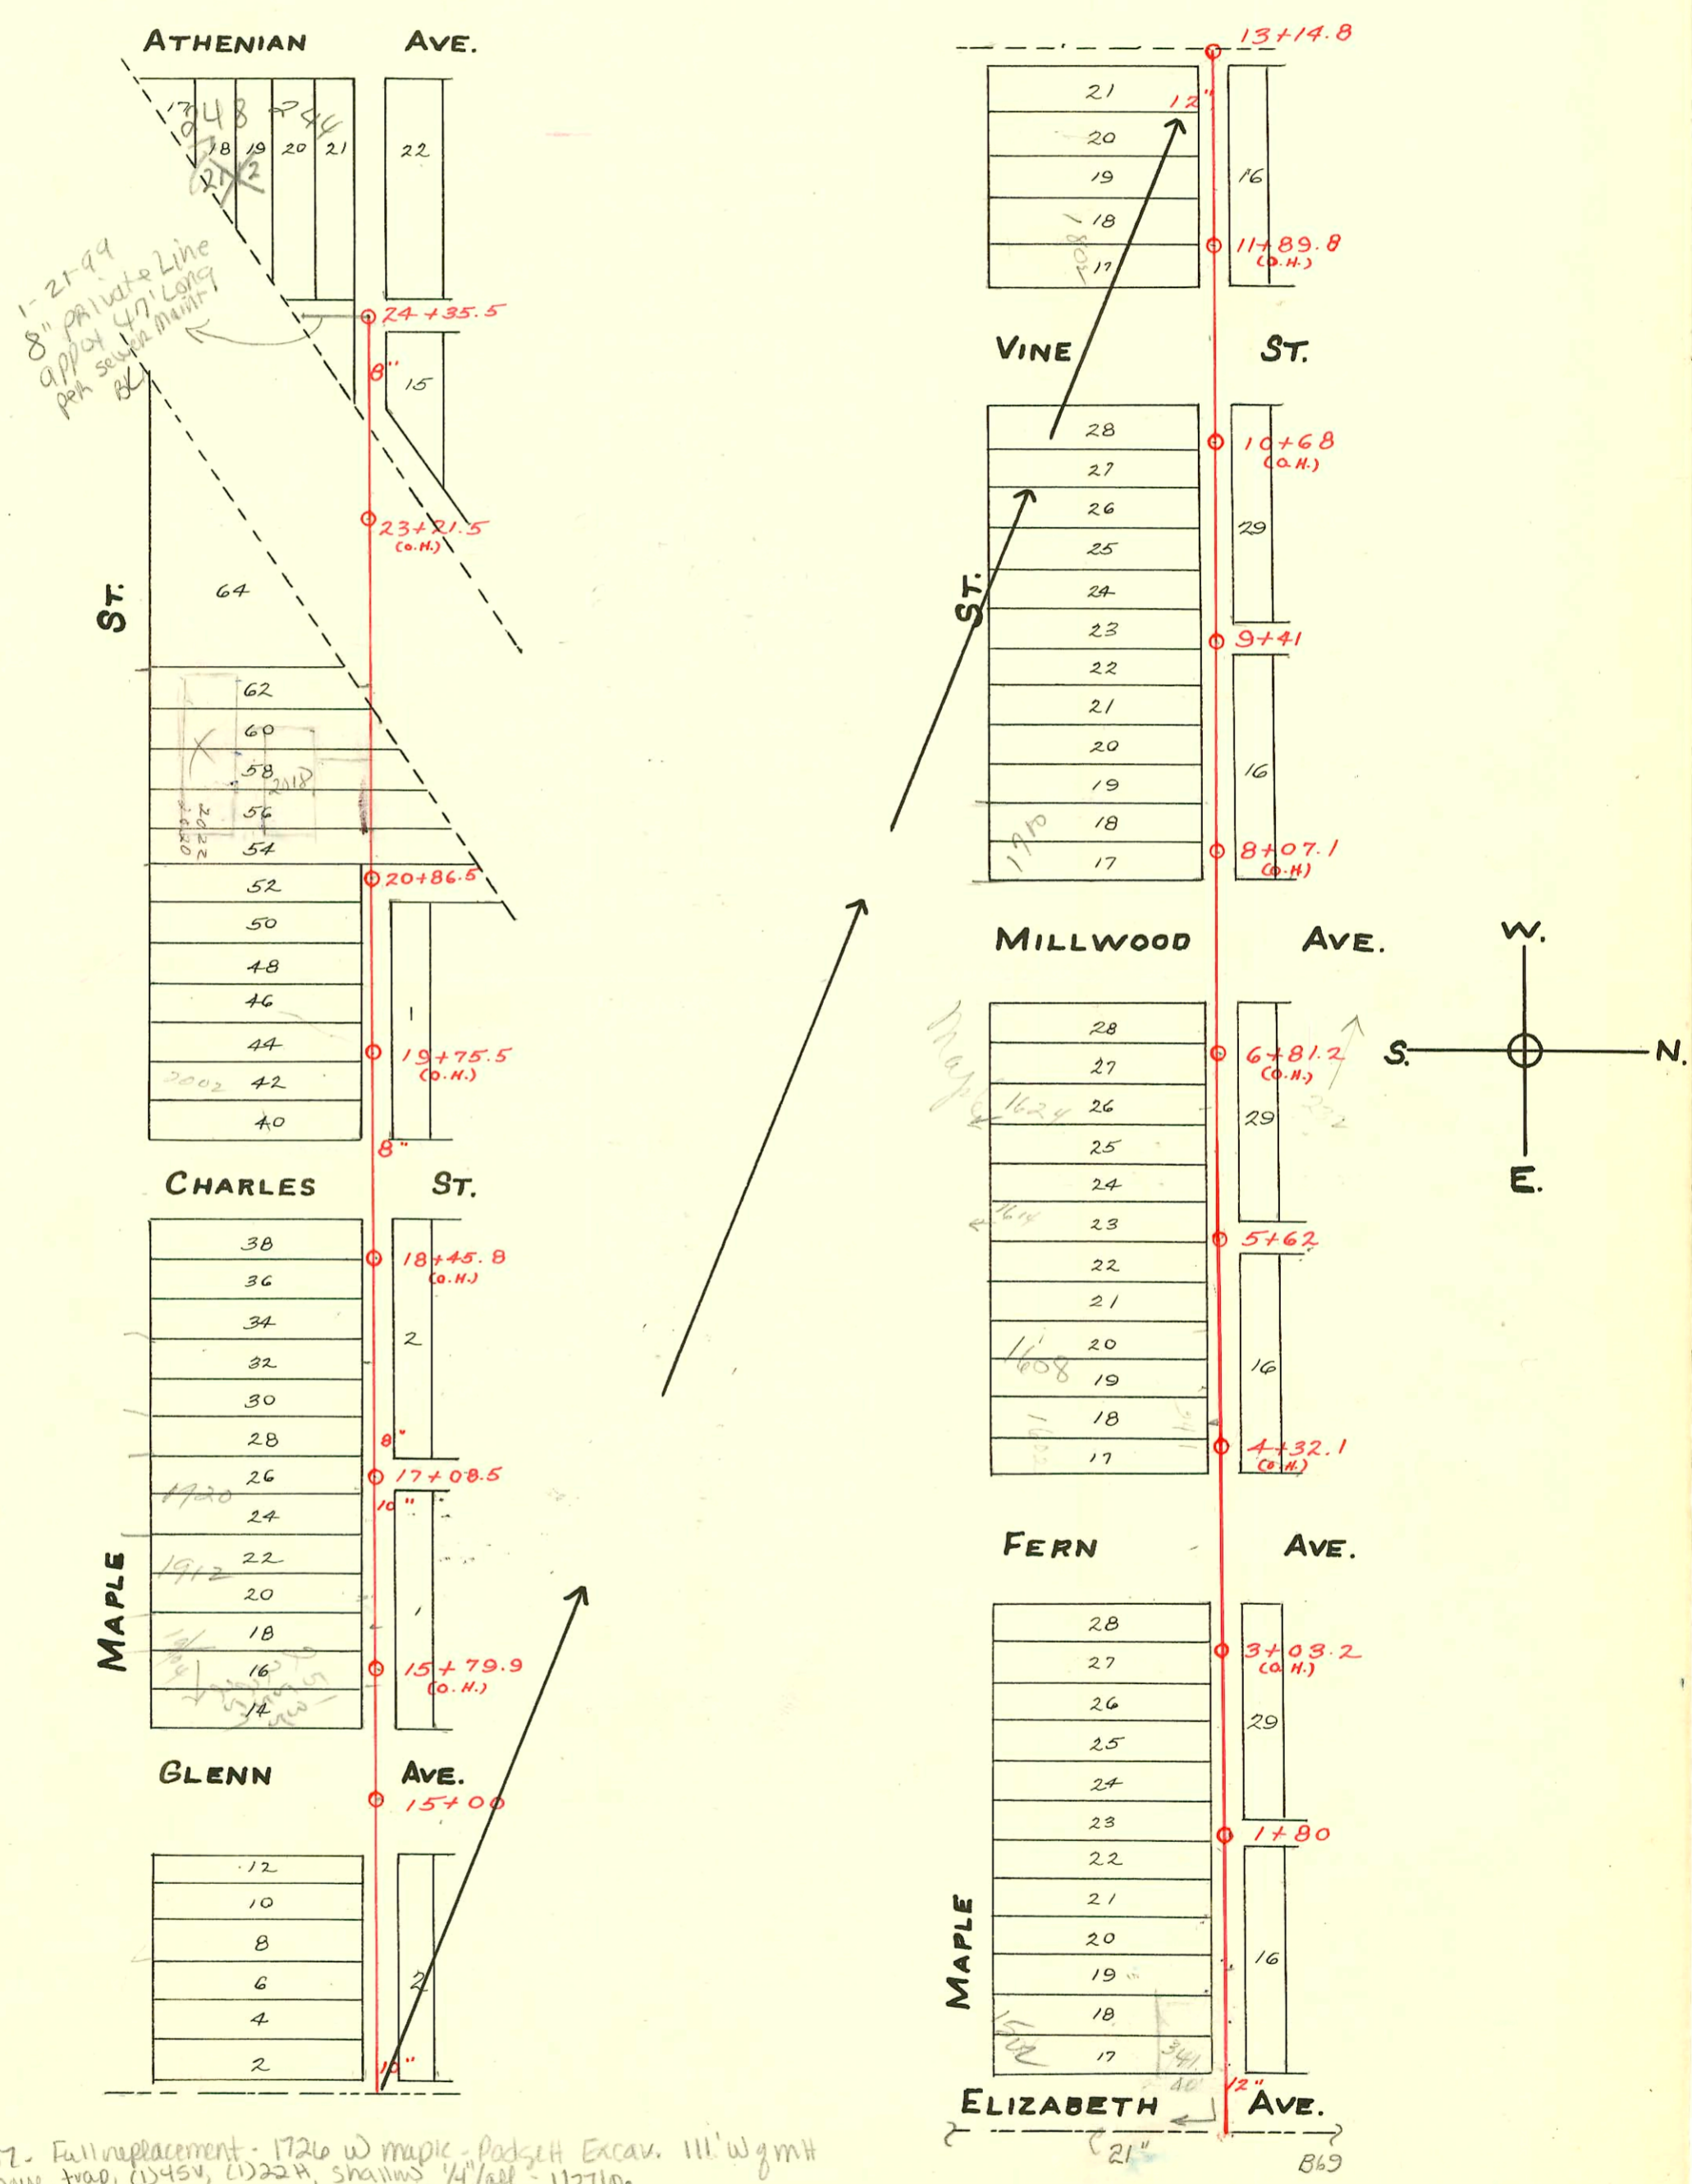

2006-00257 - Full replacement - 1726 w Maple - Padgett Excav. Ill. Wym H  
4" c/d @ house, trap, (1) 45', (1) 22', shallows, 1/4" fall - 1/27/06

### CONSTRUCTION RECORD

### SERVICE RECORD

| STATION | ELEVATION |        | Depth | MANHOLE | 4-INCH "Y" BRANCHES                           |            | No. of Permit  |            | House Number      |            | DATE OF PERMITS |            |
|---------|-----------|--------|-------|---------|---|------------|----------------|------------|-------------------|------------|-----------------|------------|
|         | Ground    | Grade  |       |         | North West                                    | South East | North West     | South East | North West        | South East | North West      | South East |
| 24      | 112.06    | 106.96 | 5.1   | 24+35.5 | From this M.H. running So. is a pipe 2' long. |            | #778 97-3055-7 |            | 247 S. Athenia Dr |            | 3-3-97          |            |
| 23      | 111.56    | 106.81 | 4.7   |         |   |            |                |            |                   |            |                 | 7-30-24    |
|         |           |        |       |         |   | 22+53      |                |            |                   |            |                 |            |
|         |           |        |       |         |   | 22+34      |                | #726       |                   |            |                 | 4-7-24     |
| 22      | 111.06    | 106.66 | 4.4   |         |   | 22+10      |                | #929       | 2028              | Maple      |                 | 5-10-50    |
|         |           |        |       |         |   | 21+97      |                | 92-2174-7  | 2022 W.           | Maple      |                 | 6-4-92     |
|         |           |        |       |         |   | 21+71      |                |            | 2018 W            | Maple      |                 | 6-4-92     |
| 21      | 111.36    | 106.51 | 4.8   |         |   | 21+44      |                | #14786     | 2020              | Maple      |                 | 7-7-69     |
|         |           |        |       |         | 20+86.5                                       | 21+17.5    |                | #792       |                   |            |                 | 6-11-79    |
|         |           |        |       |         |   | 20+93.5    |                |            |                   |            |                 |            |
|         |           |        |       |         |   | 20+63.5    |                | #330       |                   |            |                 | 6-6-10     |
|         |           |        |       |         |   | 20+37      |                |            |                   |            |                 |            |
| 20      | 110.16    | 106.36 | 3.8   |         |   | 20+10.5    |                | #797       |                   |            |                 | 5-28-23    |
|         |           |        |       |         |   | 19+84      |                |            |                   |            |                 |            |
|         |           |        |       |         |   | 19+66.5    |                |            |                   |            |                 |            |
| 19      | 110.10    | 106.21 | 3.9   |         |   | 19+41.5    |                | #157       |                   |            |                 | 4-6-18     |
|         |           |        |       |         |   | 18+59      |                |            |                   |            |                 |            |
|         |           |        |       |         |   | 18+33      |                | #225       |                   |            |                 | 3-29-20    |
| 18      | 109.90    | 106.06 | 3.9   |         |   | 18+07      |                | #404       |                   |            |                 | 4-26-22    |
|         |           |        |       |         |   | 17+80.5    |                | ?          |                   |            |                 | 9-20-10    |
|         |           |        |       |         |   | 17+57      |                |            |                   |            |                 |            |
|         |           |        |       |         |   | 17+33.5    |                |            |                   |            |                 |            |
| 17      | 109.70    | 105.91 | 3.8   | 17+08.5 |   | 17+01      |                | #136       | 1920 (R)          | W. Maple   |                 | 3-16-10    |
|         |           |        |       |         |   | 16+80.5    |                |            |                   |            |                 |            |
|         |           |        |       |         |   | 16+55      |                |            |                   |            |                 |            |
|         |           |        |       |         |   | 16+29.5    |                | #632       | 1918              | Maple      |                 | 10-24-14   |
| 16      | 109.70    | 105.76 | 4.0   |         |   | 16+03.5    |                | #1194      | 1901              | Maple      |                 | 5-23-24    |
|         |           |        |       |         |   | 15+75      |                |            |                   |            |                 |            |
| 15      | 109.80    | 105.61 | 4.2   | 15+00   |   | 15+52      |                |            |                   |            |                 |            |
|         |           |        |       |         |   | 14+42.5    |                |            |                   |            |                 |            |
|         |           |        |       |         |   | 14+19      |                | #1350      | 1826              | Maple      |                 | 9-23-29    |
| 14      | 109.70    | 105.46 | 4.3   |         |   | 14+08.4    |                | 263017     | 1826              | Maple      |                 | 9-12-77    |
|         |           |        |       |         |   | 13+83      |                |            |                   |            |                 |            |
|         |           |        |       |         |   | 13+57.5    |                |            |                   |            |                 |            |
| 13      | 109.50    | 105.31 | 4.2   | 13+14.8 |   | 13+31.5    |                | #1044      | 1822              | Maple      |                 | 8-17-71    |
|         |           |        |       |         |   | 12+96.5    |                |            |                   |            |                 | 10-29-21   |
|         |           |        |       |         |   | 12+78.5    |                | #522       |                   |            |                 | 8-26-18    |
|         |           |        |       |         |   | 12+57.5    |                |            |                   |            |                 |            |
|         |           |        |       |         |   | 12+28.5    |                | #586       |                   |            |                 | 10-28-10   |
| 12      | 109.70    | 105.16 | 4.6   |         |   | 12+00.5    |                | #196       | 1802              | Maple      |                 | 4-29-80    |
| 11      | 110.24    | 105.01 | 5.2   |         |   | 11+75      |                | #78        | 1802              | Maple      |                 | 4-28-90    |
|         |           |        |       |         |   | 10+78      |                |            |                   |            |                 | 2-78-10    |
|         |           |        |       |         |   | 10+53.5    |                | #753       |                   |            |                 | 6-29-22    |
|         |           |        |       |         |   | 10+27.5    |                | #1421      |                   |            |                 | 10-25-22   |
| 10      | 110.64    | 104.86 | 5.8   |         |   | 10+02      |                |            |                   |            |                 |            |
|         |           |        |       |         |   | 9+76       |                |            |                   |            |                 |            |
| 9       | 110.44    | 104.71 | 5.7   | 9+41    |   | 9+50       |                | #29        |                   |            |                 | 1-12-22    |
|         |           |        |       |         |   | 8+21       |                | #1361      |                   |            |                 | 10-23-23   |
|         |           |        |       |         |   | 8+85       |                |            |                   |            |                 |            |
|         |           |        |       |         |   | 8+59.5     |                |            |                   |            |                 |            |
|         |           |        |       |         |   | 8+31       |                | #978       | 1910 W.           | Maple      |                 | 10-17-21   |
| 8       | 109.54    | 104.56 | 5.0   |         |   | 8+05       |                | #156       | 1700 W.           | Maple      |                 | 3-8-22     |
| 7       | 109.74    | 104.41 | 5.3   |         |   | 6+97       |                | 668114     | 1700 W.           | Maple      |                 | 8-29-78    |
|         |           |        |       |         |   | 6+64       |                | #579       | 232 S. 9th        | Millwood   |                 | 5-8-28     |
|         |           |        |       |         |   | 6+38.5     |                |            |                   |            |                 |            |
| 6       | 109.44    | 104.26 | 5.2   |         |   | 6+12.5     |                |            |                   |            |                 |            |
|         |           |        |       |         | 5+62  | 5+82       |                | #91        |                   |            |                 | 4-2-14     |
|         |           |        |       |         |   | 5+23       |                | #698       | 2001-00767        | 1610 R     | Maple           | 41501      |
| 5       | 109.04    | 104.11 | 4.9   |         |   | 5+02.5     |                | #266       |                   |            |                 | 11-25-14   |
|         |           |        |       |         |   | 4+76.5     |                | #676       |                   |            |                 | 4-3-22     |
|         |           |        |       |         |   | 4+45.5     |                | #363       |                   |            |                 | 12-9-10    |
| 4       | 109.38    | 103.96 | 5.4   |         |   | 4+22.5     |                |            |                   |            |                 | 6-16-09    |
| 3       | 109.68    | 103.81 | 5.8   |         |   | 3+16.3     |                |            |                   |            |                 |            |
|         |           |        |       |         |   | 2+98.5     |                |            |                   |            |                 |            |
|         |           |        |       |         |   | 2+75.5     |                | #834       |                   |            |                 | 6-1-23     |
|         |           |        |       |         |   | 2+46.5     |                | #101       |                   |            |                 | 3-3-10     |
| 2       | 110.48    | 103.66 | 6.8   | 1+80    |   | 2+23       |                | #109       |                   |            |                 | 3-5-10     |
|         |           |        |       |         |   | 1+95       |                | #329       |                   |            |                 | 7-6-15     |
|         |           |        |       |         |   | 1+67.5     |                |            |                   |            |                 |            |
| 1       | 110.48    | 103.51 | 6.9   |         |   | 1+17       |                |            |                   |            |                 |            |
|         |           |        |       |         |   | 0+90.5     |                | #268       | #997              |            |                 | 6-6-12     |
|         |           |        |       |         |   | 0+66.5     |                |            | #251              |            |                 | 10-19-21   |
|         |           |        |       |         |   | 0+46.5     |                |            | #252              |            |                 | 5-8-13     |
| 0       | 109.88    | 103.36 | 6.5   | 0+0     |   |            |                |            |                   |            |                 | 5-8-13     |

Tap at 2+88 - # 998 - 10-19-21  
 #5913 - Used old connection - 251 S. Glenn - 9-26-51 - Wichita Pibg. Co.  
 #6670 - Tap - 251 S. Glenn - 12-1-51 - Wichita Pibg. Co.  
 #5282 - 6 on 8 wye - 2020 W. Maple - 6-22-52 - Farrell Pibg. Co.  
 #2200 - 6 on 8 wye - 2002 W. Maple - 9-4-56 - Callison Pibg.  
 #3904 - 6 on 8 wye - 1932 Maple - Trailers - 2-21-57 - Riggs Pibg.  
 #23908 - 241 S. Fern - Seal off - at Henning 4-22-71

#21203 - 7/24/68 - 232 S. Millwood - R.P. Co. -  
 92-7542-7 (Chuan) 5/21/92 2018 W Maple (Sunkis) - 4" PVC 40  
 Reused existing sewer. Tied on 4" behind  
 new bldg.