


S.S. No. 8-1908

Douglas

TRAP AREA

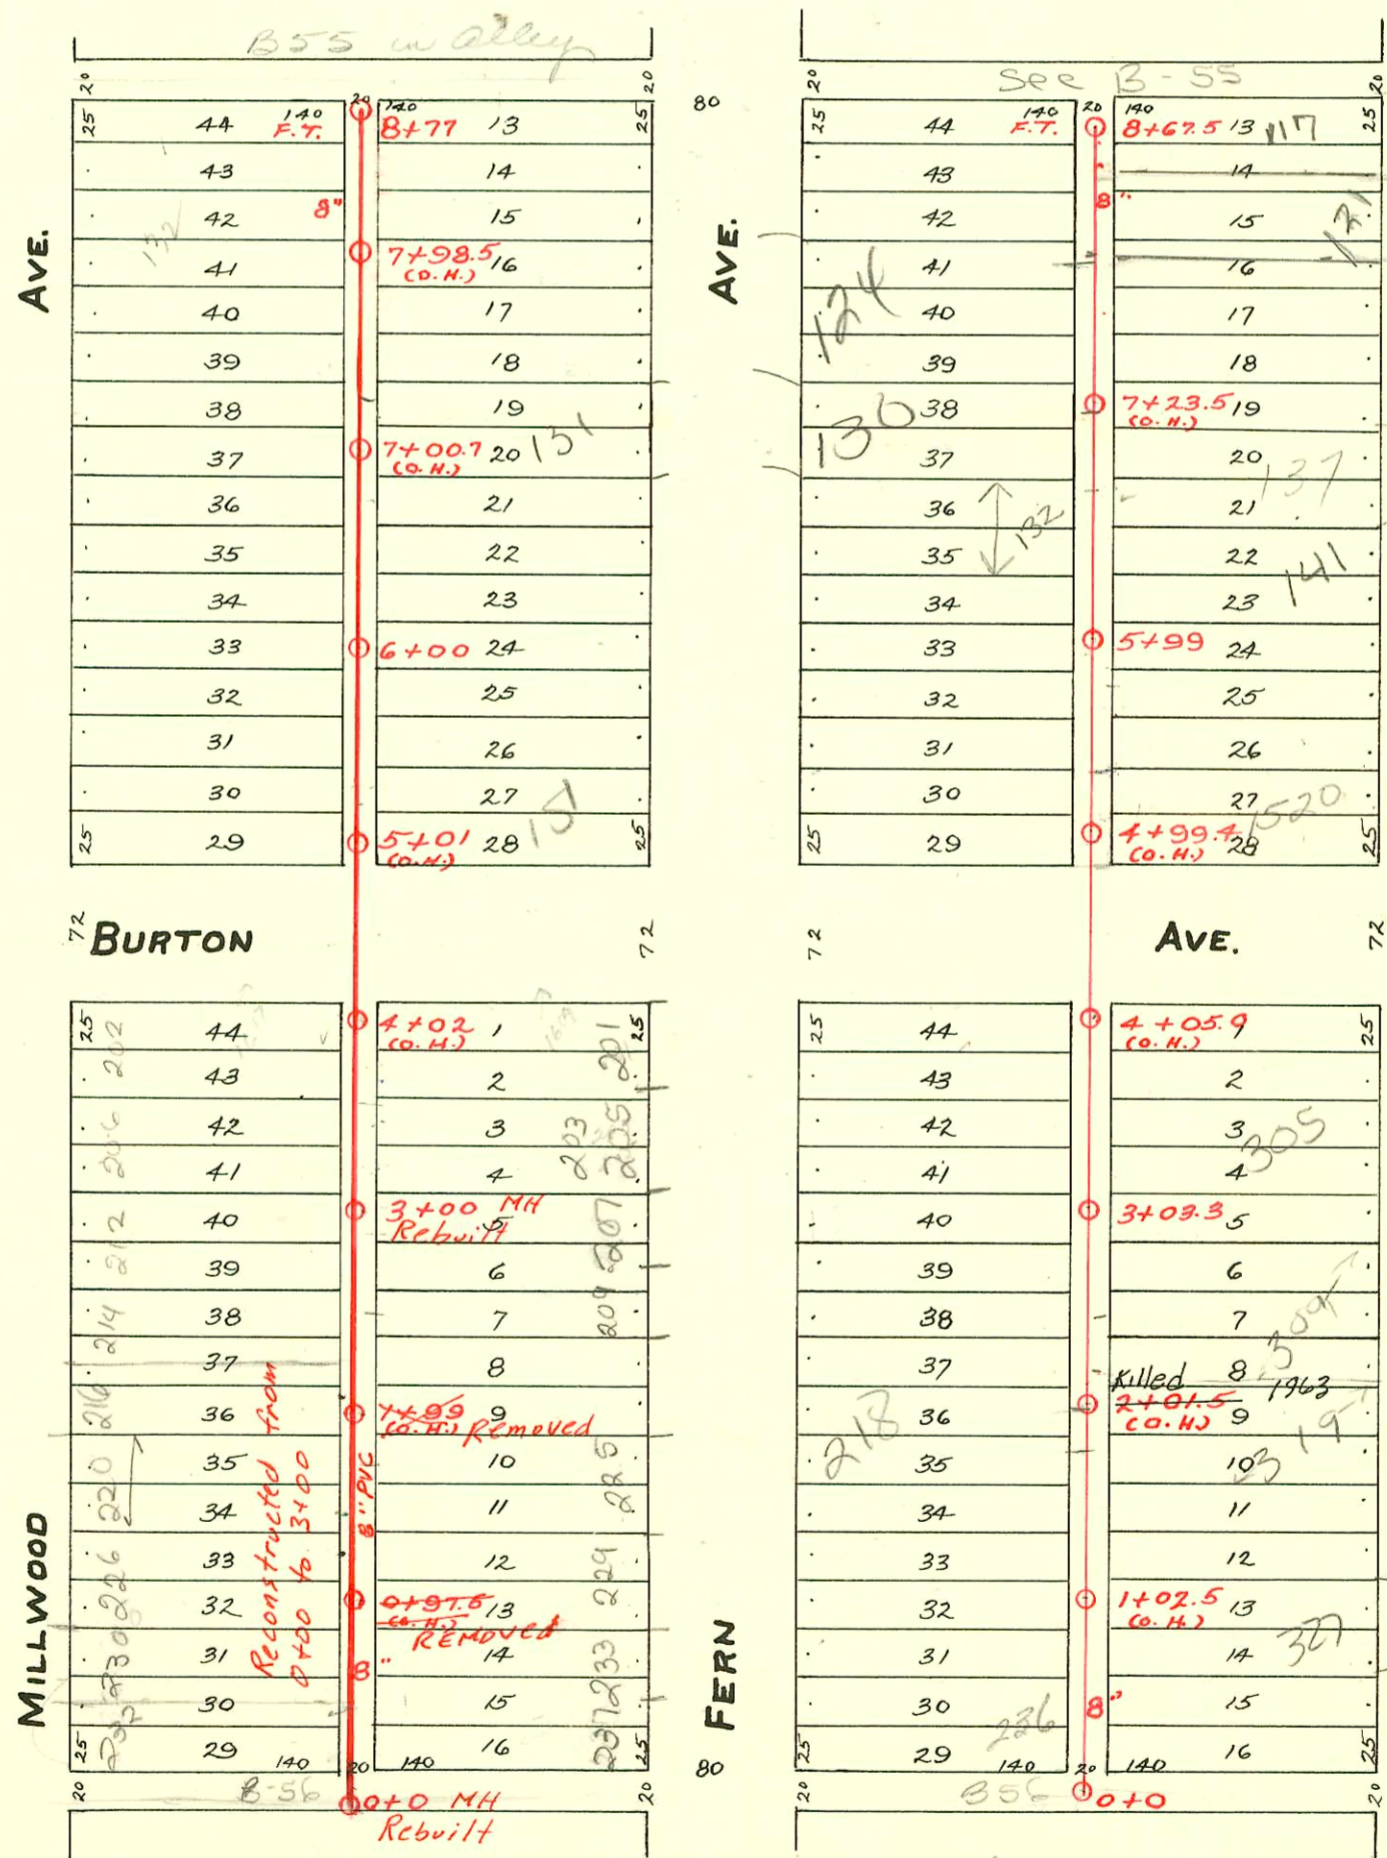

2001-00910-4/17/61- 205 S Fern- Brand- 4" SCH40 - ITWIN CO, 2H45 - installed 4" CO @ house
 2001-00555- 3/15/61- 216 S Millwood- Lubbers Exc - 4" SCH40- Replaced all but lower 3' - 1-way co, ITWIN CO
 Alter, Repair or Reconstr. S.S. in alley
 E. of Millwood & S. of Burton
 468-76-245-81787-000-000-001
 Built By Utility Contr.
 Booked 1-4-89 from MG-7

- Re. con 7/24/88
- # 21166 220 S Millwood (1+54.0 top)
 - # 21181 226 S Millwood (1+14.0 top)
 - # 21188 232 S Millwood (0+57.0 top)
 - # 21803 232 S Millwood
 - # 21804 167 W Burton

2263 3-12-92 218 S FERN SKANNAN (1+76.3 top 4" PVC 40)
 Jul 2001 02285 9-13-01 151 S FERN 1000/1000

