

S.S. No. 8-1908

AVE.

199	
197	
195	
VACATION ORDINANCE #33-304

ABANDONED SEE N-268

BONN ST.

171	175	172
169		170
167		168
165		166
163		164
161		162
159		160
157		158
155		156
153		154
151		152
149		150
147		148
145		146
143		144
141		142
139		140

ST.

HIRAM AVE.


137	135	138
135		136
133		134
131		132
129		130
127		128
125		126
123		124
121		122
119		120
117		118
115		116
113		114
111		112
109		110
107		108
105		106
103		104

LAT. 4.

LAT. No. 1

SUB.

SUB. No. 2

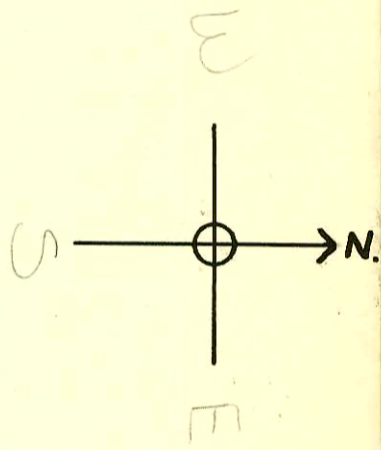

TRAP AREA
Map 855

2004-00362 2112104 4275 Glenn - Overnight 4" 40 PVC 4" DLTP 93' W of MH 2138(3132) shallow, 114" all 2H22, 2H45, replaced 60' section of line that goes thru property at 425 Glenn.

2004-00285 425 Glenn overnight - 4" DLTP 91' W of 2138(3129) dirt alley cut, new trap, replaced entire line (top in new section of 8" 50K35 main) 6H22, new trap, shallow, 4" co @ house

2002-00478-1936 W Mentor Ave - 2/22/02 Kansas Ditch - 4" PVC - Replace all but lower 4', new trap, 2 stubouts, 2-twin oo @ house, 2H45, 3H22

LAT. No. 4.

47	45	43	41	39	37	35	33	31	29	27
48	46	44	42	40	38	36	34	32	30	28

VINE

MENTOR

102	
100	
98	
96	
94	
92	
90	

ST.

MAPLE

94-200277 12-15-94 1933 R Maple - NO WORK DONE PERMIT voided

SW 2004-00477-510 S Glenn - 5/10 @ 85' North of MH

SW 2004-00474-520 S Hiram - 5/10 @ 30' North of MH

CONSTRUCTION RECORD

SERVICE RECORD

STATION	ELEVATION		Depth	MANHOLE	4-INCH "Y" BRANCHES		No. of Permit		House Number		DATE OF PERMITS	
	Ground	Grade			North West	South East	North West	South East	North West	South East	North West	South East
				14+66 F.T		14+56						
14	111.80	107.52	4.28		14+37 14+11							
					13+82 13+56 13+31	13+84.5 13+58.5 13+33.5						
13	111.23	107.42	3.81		13+05 12+79.5 12+54	13+07.5 12+82 12+56.5	96-4880-7 C46036 #1295		2107 W Maple		4-9-94 8-1-79 6-4-24	
12	111.53	107.32	4.21	11+91.9 MH	12+02.5	12+05	#4395	#783	2111 Maple		5-2-57	12-29-09
11	111.13	107.22	3.91		11+01 10+89.5	11+03.5 10+77.5	94-151157 #427		2035 Maple		9-19-94 5-24-26	
					10+75 10+47.5 10+49	10+51.5 10+26.5	94-15175 #527		2035 Maple		9-19-94 3-21-24	
10	112.34	107.12	5.22		10+24 10+01	10+01	#324		2035 Maple		3-21-24	8-20-71 6-2-10
					9+78.5 9+59.5 9+48 9+33.5 9+22.5	9+81 9+50.5 9+25	94-15147 #372 67		2027 W Maple		9-19-94 11-10-24 7-6-15 2-21-26	
9	111.34	107.02	4.32		8+97.5 8+72 8+49	8+74.5 8+51.5	10266 #1758		2015 W Maple		8-20-26 8-1-24	9-19-94
					8+23.5 8+11.5 7+98	8+26 8+00.5 7+75	#189 94-15110-7 #465		2000 W Mentor		2-13-24 9-19-94	8-15-75 8-4-10
8	110.14	106.92	3.22		7+72.5 7+75	7+75	#1410		423 S Mentor		9-25-23	9-19-94
7	109.54	106.82	2.72	7+43.5	6+23.5 6+26	6+26	#950		1931-32 Maple		6-27-23	3-29-68
6	108.84	106.72	2.12		6+03 5+77 5+79.5 5+51.5 5+35	6+05.5 5+79.5 5+75 5+27.5	#17530 #1652 #535 #47		1929 W Maple		3-26-68 11-20-29 8-30-18 3-20-14	4-1-85 2-20-02 5-4-21
5	109.34	106.62	2.72	5+40	5+25 5+27.5	5+02	#517 #871		1930 Mentor		9-12-10 9-21-21	
					4+99.5 4+74 4+49	4+76.5 4+51.5	#136 #791		1923 W Maple		3-19-31 1-12-10	7-1-12 9-15-09
4	109.36	106.52	2.84		4+23.5 4+26 4+00.5 3+75.5 3+50.5 3+22.5	4+26 4+03 3+78 3+53 3+25	#340 #825		1916 S/O Mentor		6-10-18 4-9-19	8-30-91 8-23-09
3	109.06	106.42	2.62		3+17.2 2+97.5 2+72 2+45 1+22 0+97 0+74 0+49	3+17.2 2+72 2+74.5	#992 #617 #99		1920 Mentor		6-12-19 7-10-11 2-13-20	
2	109.46	106.32	3.14	2+38	0+49 0+24	0+24	#724 #797		1819 W R Maple		10-7-03 11-18-09	
1	109.36	106.22	3.14		0+24	0+24	#797 #741		1801 Maple		1-17-10 3-17-10	
0	109.06	106.12	2.94	0+0	0+24	0+24	#797 #741		1801 Maple		1-17-10 3-17-10	
				1+34.5 (O.H.)	1+32.5 1+17 0+99.5 0+74.5 0+52 0+23.5	1+17 0+99.5 0+74.5 0+52 0+23.5	#321 #49		1807 Maple		6-1-09 2-23-09	
				5+52.5	5+31.5 5+29	5+29	#895				12-10-17	
5	109.13	105.94	3.19		5+06 4+77.5 4+52.5	5+03.5 4+75 4+50	#290		427 S Mentor		4-7-22	10-23-81 9-3-86
4	109.53	105.74	3.79		4+05 4+21	4+21	#4720 #351		1818 Mentor		5-23-51	1-23-09
3	109.02	105.54	3.48	3+17.2	3+89.5 3+87 2+59.5 2+57 2+34.5 2+32	3+87 3+87 2+57 2+57 2+32	#625 #525				6-6-22	4-12-23
2	109.00	105.34	3.66		2+09.5 2+07	2+07	#1088				8-25-22	
1	108.90	105.14	3.76		1+83.5 1+31 1+07.5 1+05 0+87.5 0+80 0+57.5 0+55 0+29.5 0+27	1+81 1+49 1+05 1+05 0+80 0+55 0+27	#5 #76 #208 #572		516 S Glenn		1-5-20 2-5-20 3-13-25	5-12-20 6-8-15 6-28-10
0	108.49	104.94	3.96	0+0	0+24	0+24	#44 #572		520 Glenn		3-6-12	9-10-09

Sub. Lat. No. 1 of Lat. No. 4.

Sub. 2 of Lat. 4

Lat. No. 4.

Tap # 1053 - 10-31-21 - of 1+00-4505 - 21000-01555
 #1108 - Tap - 421 S. Glenn - 7-26-23 - 7/5/00 - Wichita Exc. - 4" SCH40 - Repl All BUT Lower. 7/1933
 #921 - Tap - A14 S. Glenn - 6-13-38 - C. Frank Mc Coy
 #773 - Tap - 2013 W. Maple - Tess Harro - 9-22-47
 #1184 - Tap - 2001 W. Maple - 8-15-49 - Thompson Pibq. Co.
 #976 - #977 - Trailer - Private line - 1925 W. Maple - 5-18-54 - Davidson Pibq. Co.
 #1819 - 9/0-309-11-13-15 & Harro - 4-23-87 - Al Henning - 8124.5
 1916 Mentor 91-31787-7 8-30-91 (Temp. 510. 12.5 W. of chain link fence 54.5. of garage)