


S.S. No. 8-1908

MAIN A.

SCALE 1" = 200'

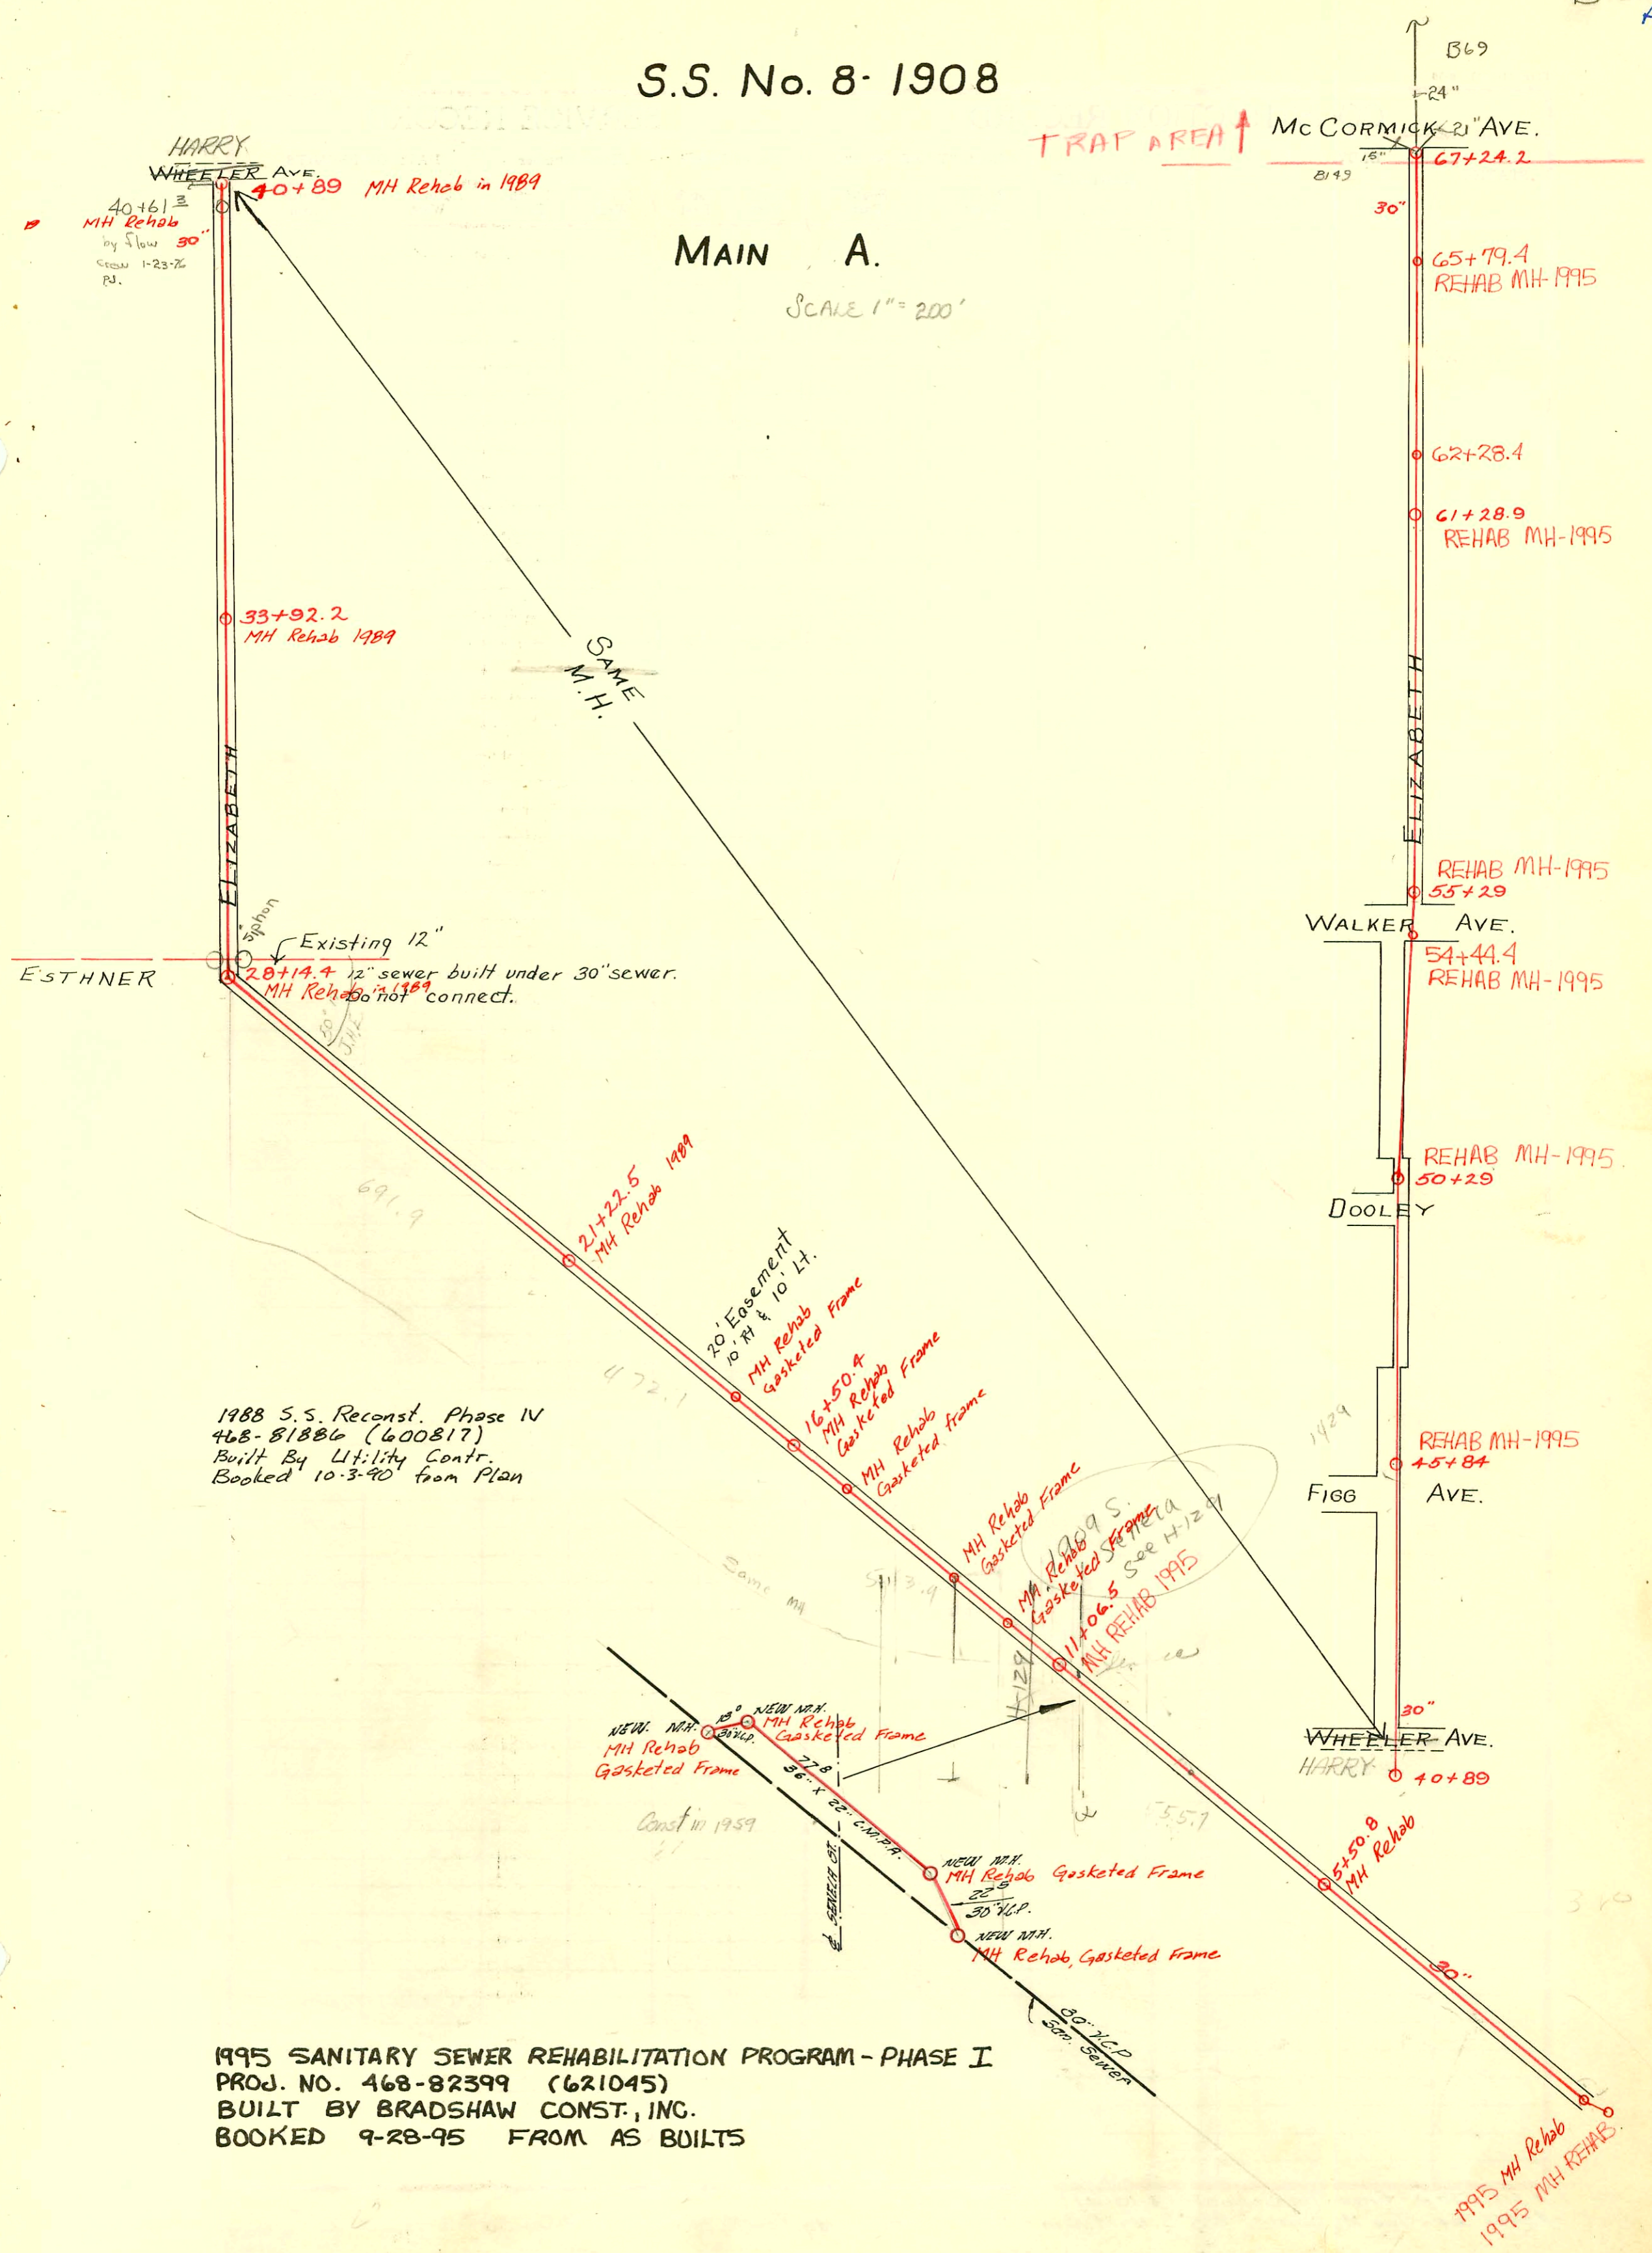

1988 S.S. Reconst. Phase IV
 468-81886 (600817)
 Built By Utility Contr.
 Booked 10-3-90 from Plan

1995 SANITARY SEWER REHABILITATION PROGRAM - PHASE I
 PROJ. NO. 468-82399 (621045)
 BUILT BY BRADSHAW CONST., INC.
 BOOKED 9-28-95 FROM AS BUILTS

1995 MH Rehab
 1995 MH REHAB

