

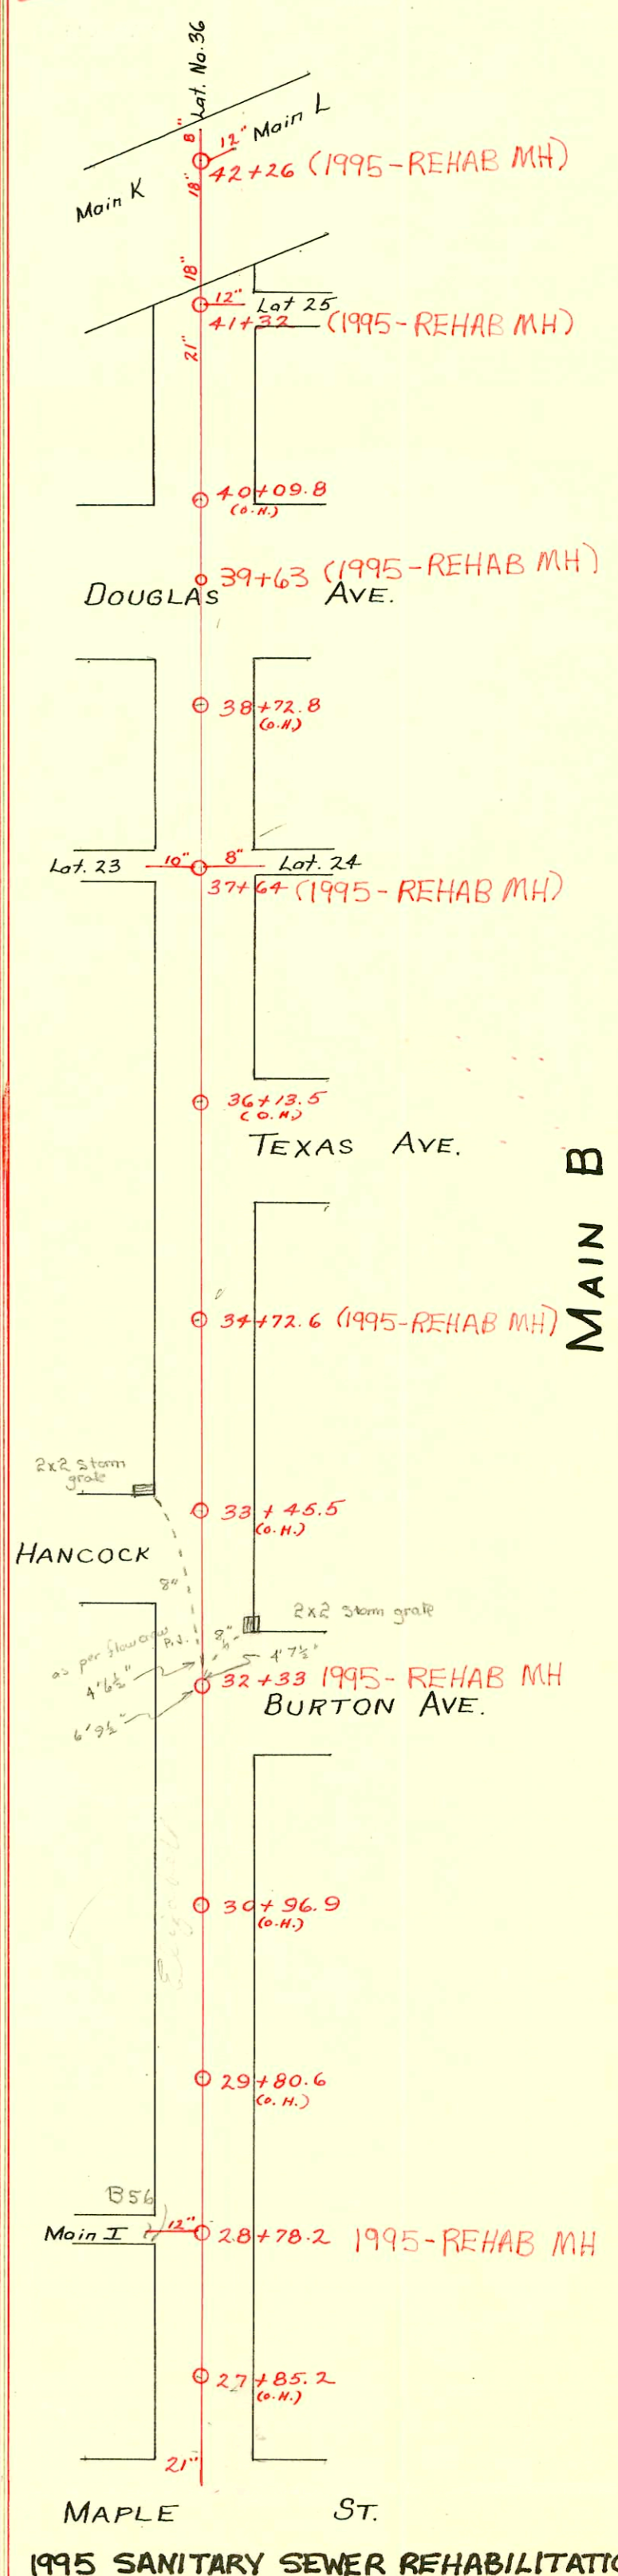


TRAP AREA

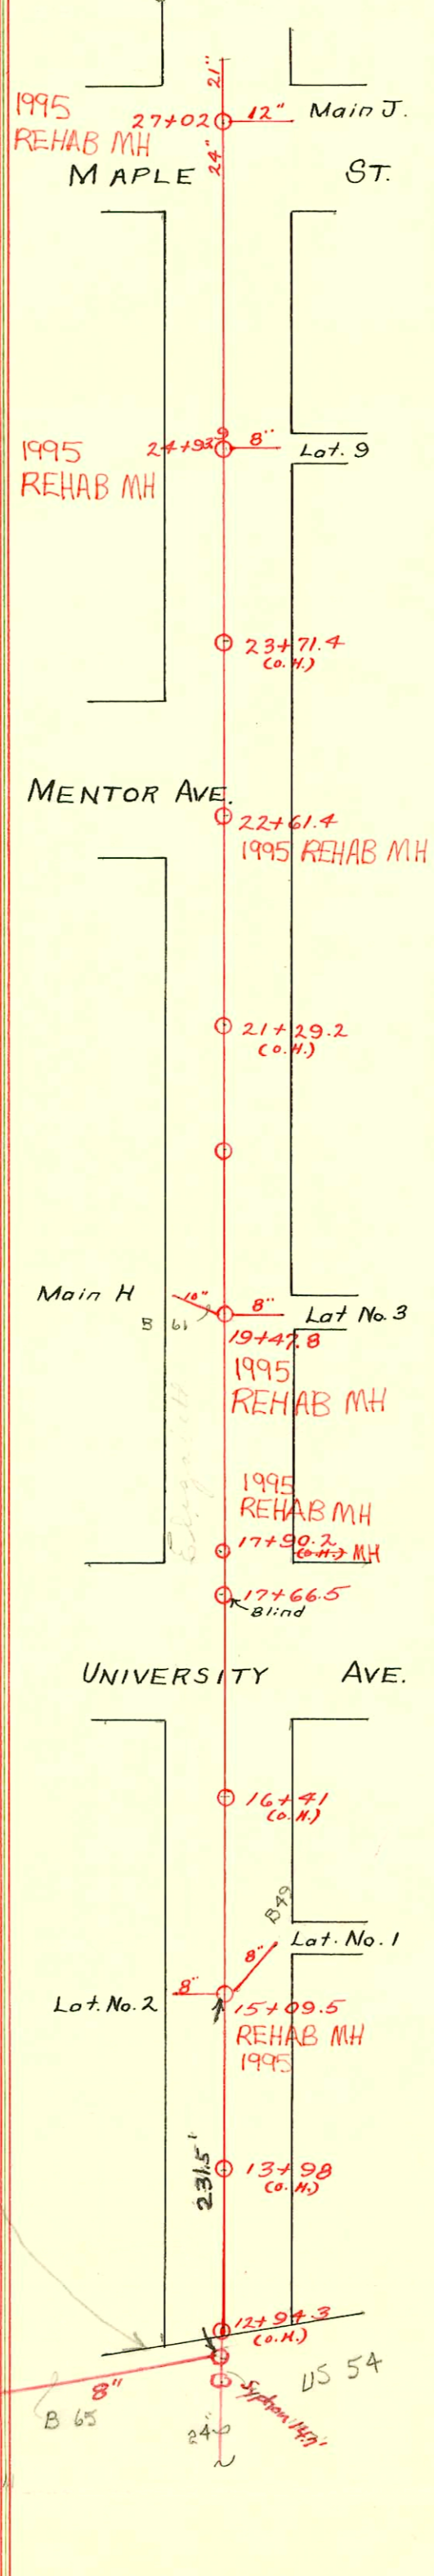

MAIN B
S.S. No. 8-1908

1995 SANITARY SEWER REHABILITATION PROGRAM - PHASE I
 PROJ. NO. 468-82399 (621045)
 BUILT BY BRADSHAW CONST., INC.
 BOOKED 9-28-95 FROM AS BUILTS

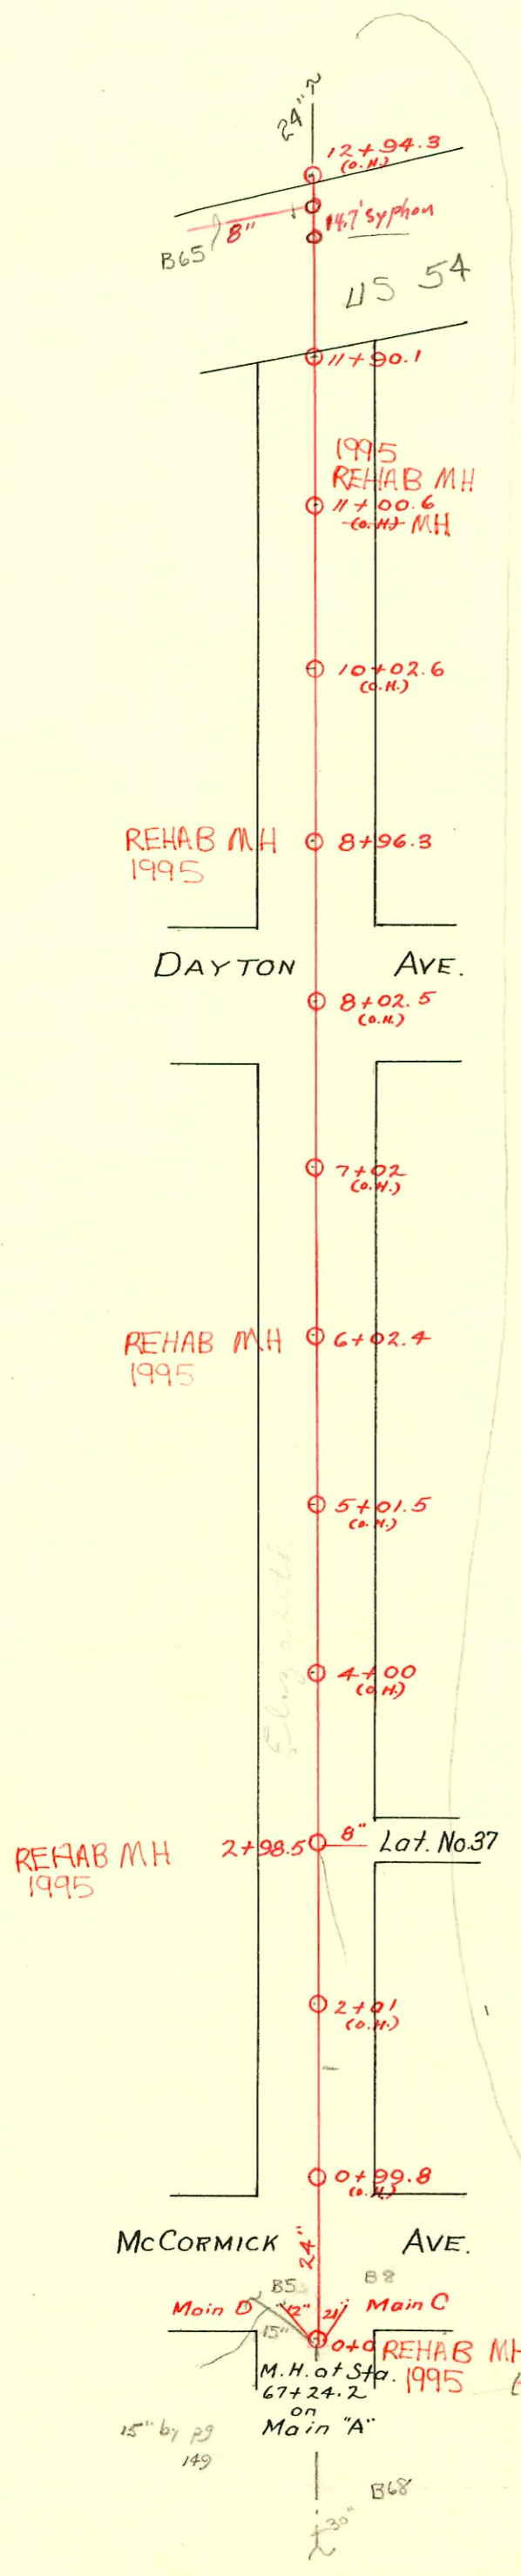